




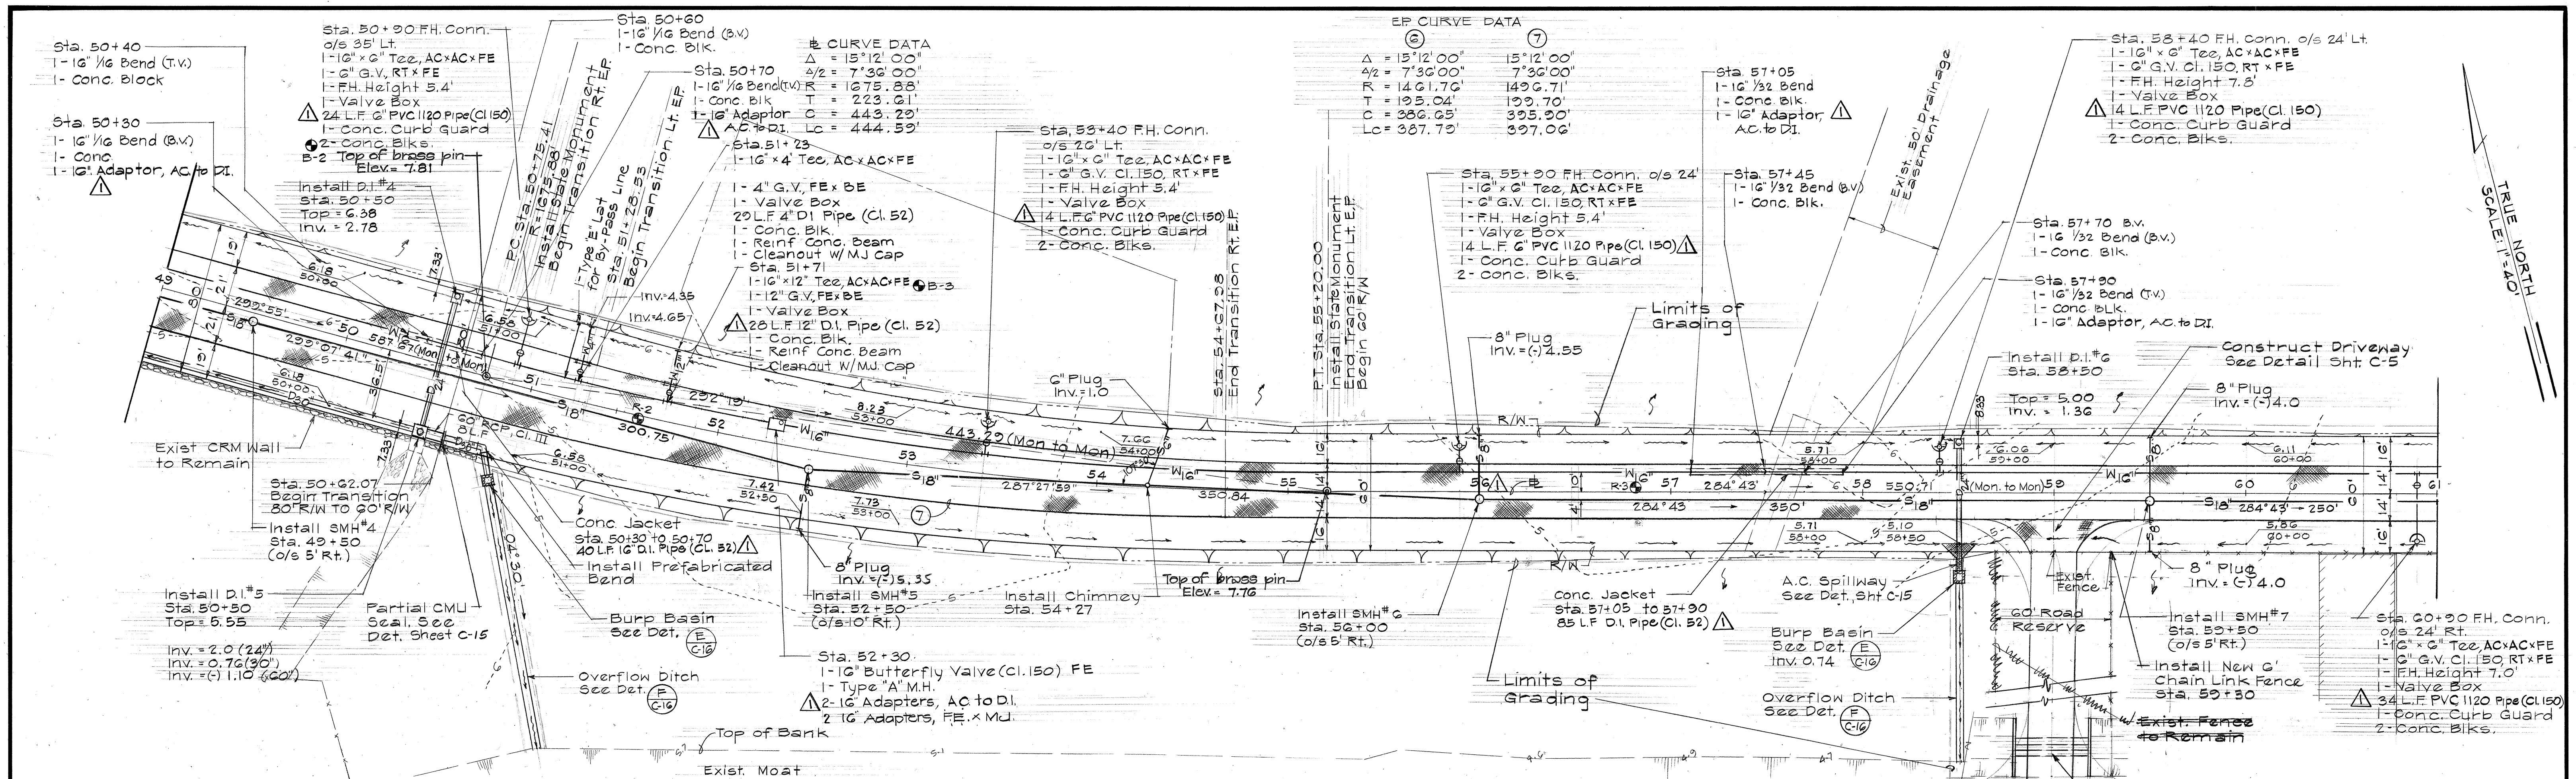


PLAN

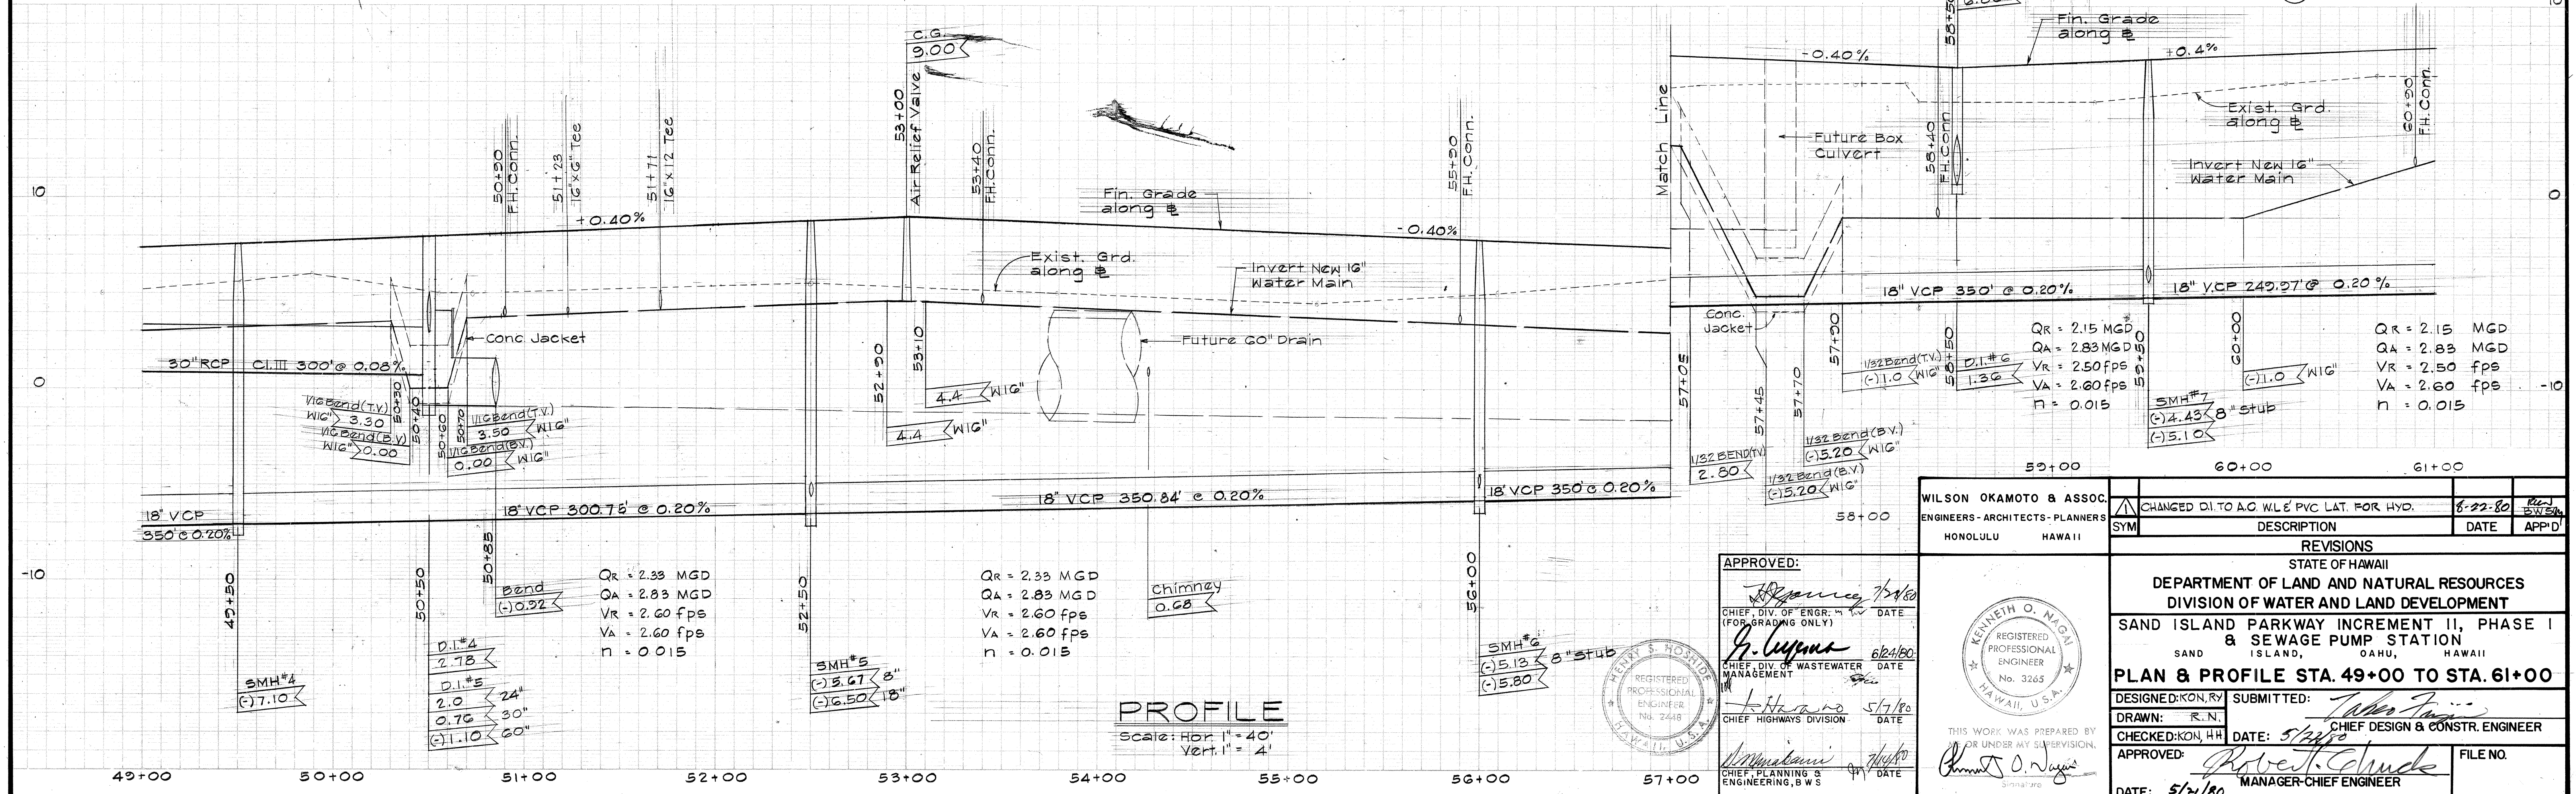


PROFILE

WILSON OKAMOTO & ASSOC. ENGINEERS - ARCHITECTS - PLANNERS HONOLULU HAWAII		CHANGED DI. TO AC W/ 6\"/>	
APPROVED: <i>[Signature]</i> CHIEF DIV. OF ENGR. & CON. (FOR GRADING ONLY) DATE: 6/24/80		APPROVED: <i>[Signature]</i> CHIEF DIV. OF WASTEWATER MANAGEMENT DATE: 5/17/80	
APPROVED: <i>[Signature]</i> CHIEF HIGHWAYS DIVISION DATE: 5/17/80		APPROVED: <i>[Signature]</i> CHIEF PLANNING & ENGINEERING, BWS DATE: 5/21/80	
REVISIONS STATE OF HAWAII DEPARTMENT OF LAND AND NATURAL RESOURCES DIVISION OF WATER AND LAND DEVELOPMENT SAND ISLAND PARKWAY INCREMENT II, PHASE I & SEWAGE PUMP STATION SAND ISLAND, OAHU, HAWAII PLAN & PROFILE STA. 49+00 TO STA. 61+00 DESIGNED: KON, RY SUBMITTED: <i>[Signature]</i> DRAWN: R.N. CHIEF DESIGN & CONSTR. ENGINEER CHECKED: KON, HH DATE: 5/14/80 APPROVED: <i>[Signature]</i> MANAGER-CHIEF ENGINEER DATE: 5/21/80 FILE NO.			

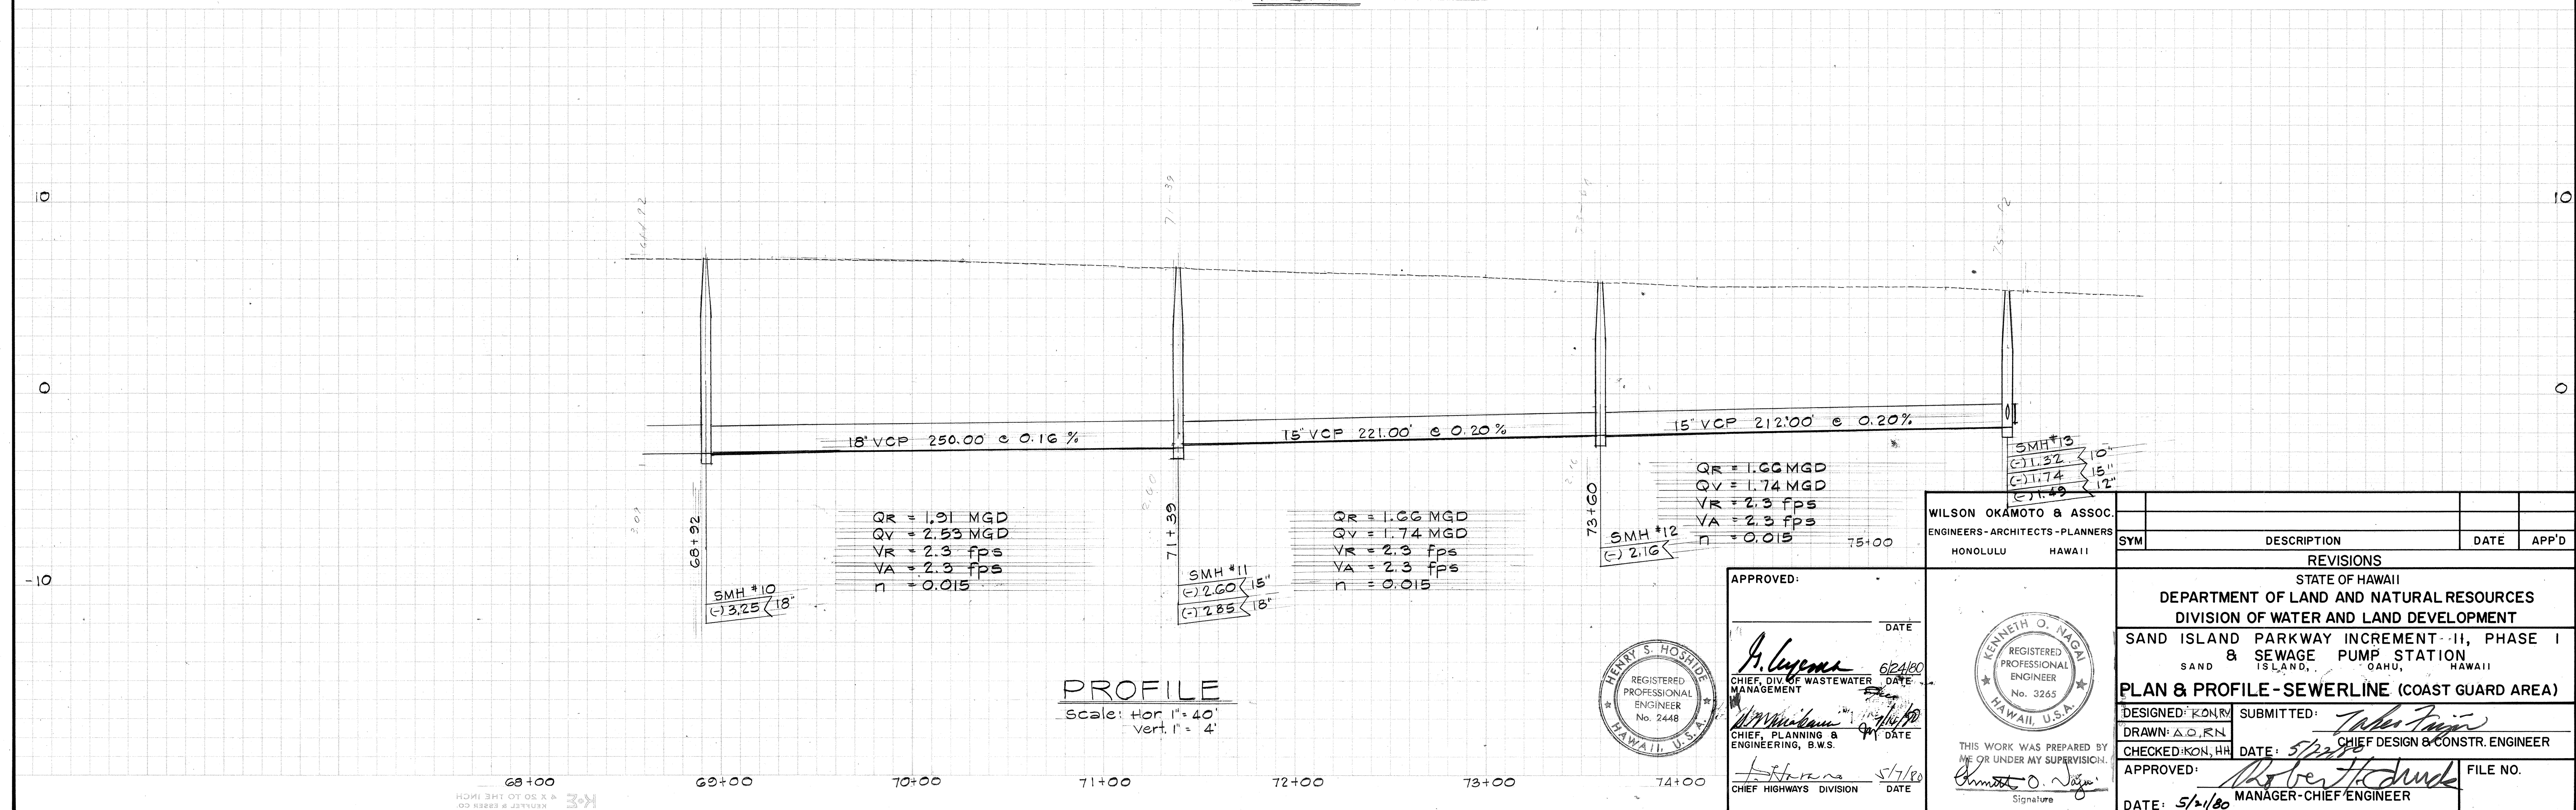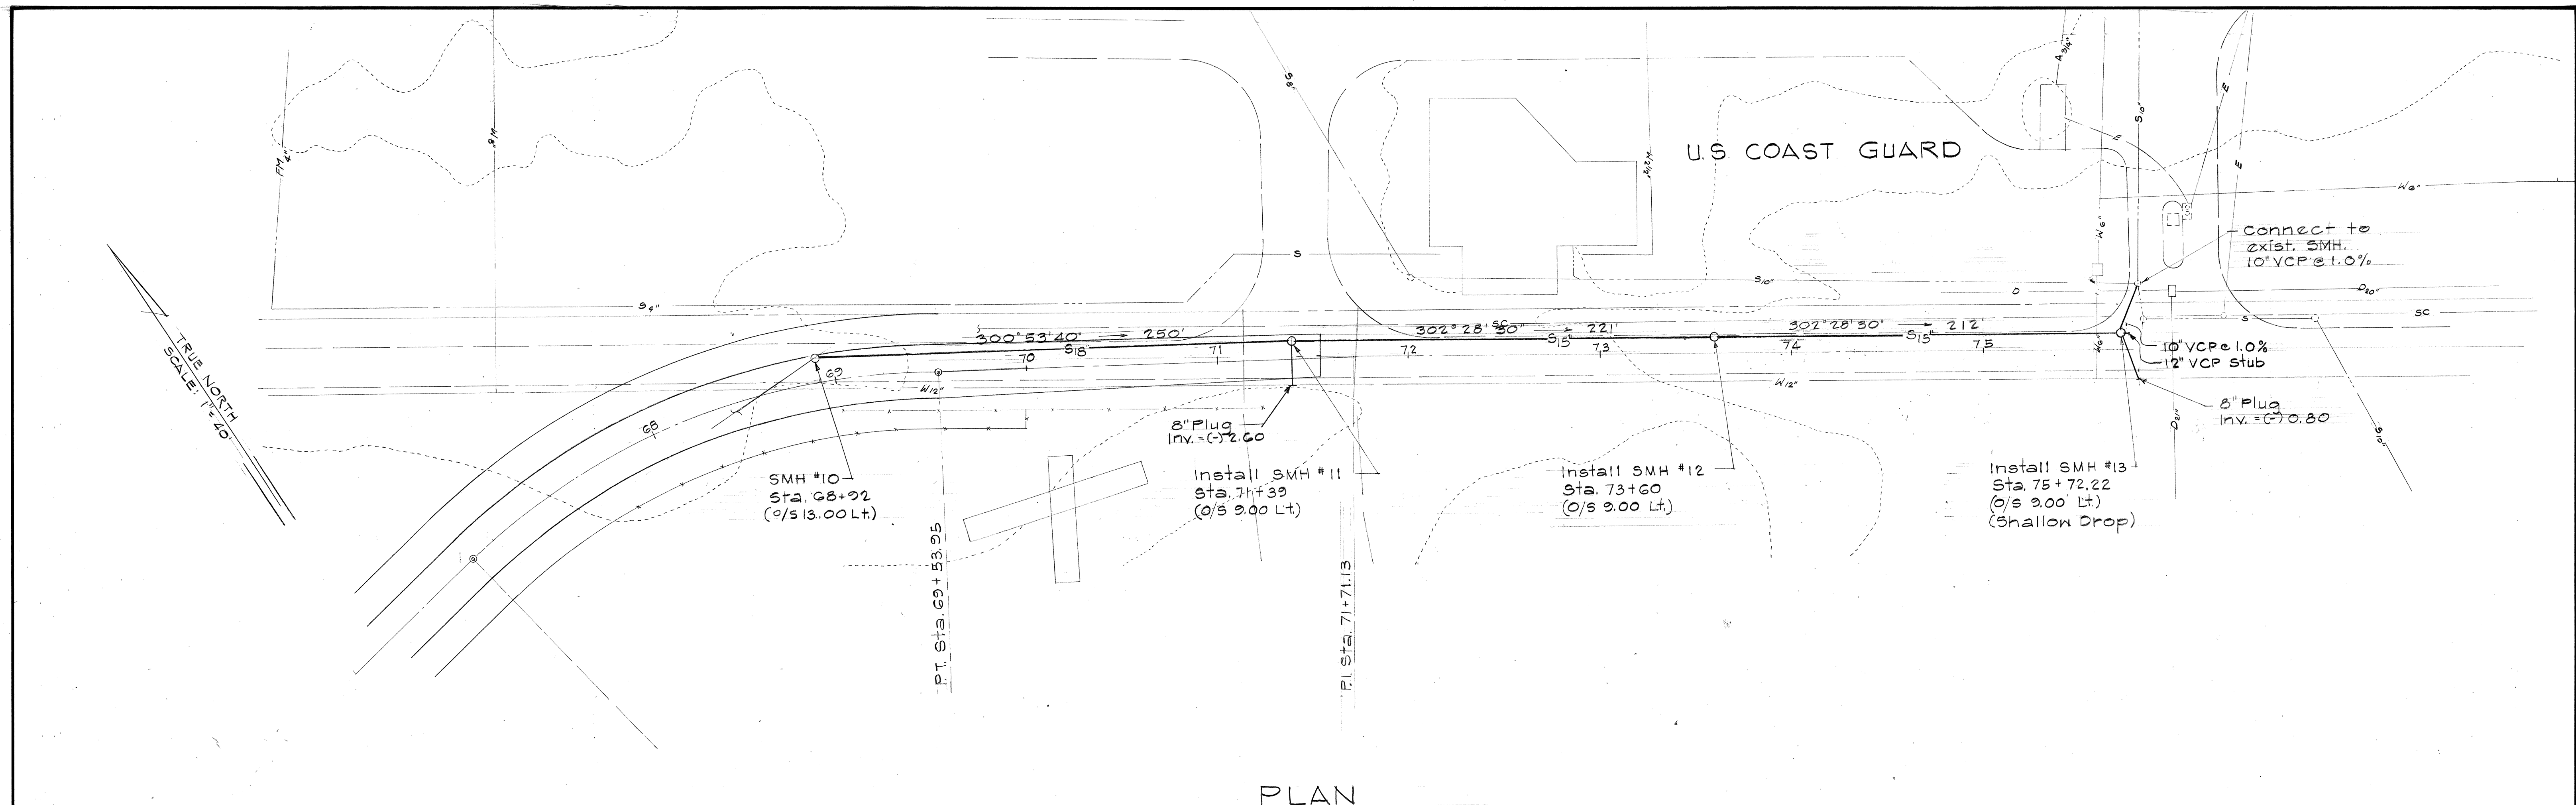

PROFILE
Scale: Hor 1" = 40'
Vert 1" = 4'

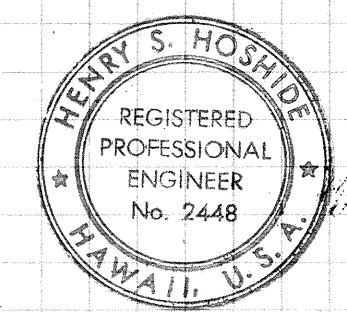

APPROVED: *[Signature]* DATE: 6/24/80
CHIEF, DIV. OF WASTEWATER MANAGEMENT
[Signature] DATE: 5/1/80
CHIEF, PLANNING & ENGINEERING, B.W.S.
CHIEF HIGHWAYS DIVISION

WILSON OKAMOTO & ASSOC.
ENGINEERS-ARCHITECTS-PLANNERS
HONOLULU HAWAII



THIS WORK WAS PREPARED BY ME OR UNDER MY SUPERVISION.
[Signature]
Signature

SYMBOL	DESCRIPTION	DATE	APP'D
REVISIONS			
STATE OF HAWAII			
DEPARTMENT OF LAND AND NATURAL RESOURCES			
DIVISION OF WATER AND LAND DEVELOPMENT			
SAND ISLAND PARKWAY INCREMENT-II, PHASE I			
& SEWAGE PUMP STATION			
SAND ISLAND, OAHU, HAWAII			
PLAN & PROFILE - SEWERLINE (COAST GUARD AREA)			
DESIGNED: KON	SUBMITTED: <i>[Signature]</i>		
DRAWN: A.O.R.N.	DATE: 5/2/80	CHIEF DESIGN & CONSTR. ENGINEER	
CHECKED: KON, HH	DATE: 5/2/80	MANAGER-CHIEF ENGINEER	
APPROVED: <i>[Signature]</i>	DATE: 5/2/80	FILE NO.	

As Built

TRUE NORTH
SCALE: 1"=20'

PT. Sta. 38+24.28
For Continuation,
See below

EPPT. Sta. 39+57.58

BENCH MARK
E1. = 8.39 MLLW
(Top of Brass Pin)
Exist. C & C St. Mon.
P.C. Sta. 41+49.25 S.I. Parkway
= (C) 1+67.46 S.I. S.T.P. RD.

R/W

New Edge of
Pavement

Make Smooth Riding
Connection to Exist.
Pavement.

New Edge of
Shoulder

CURVE DATA
 $\Delta = 38^{\circ}29'00''$
 $A/2 = 19^{\circ}14'30''$
 $R = 503.36$
 $T = 175.21'$
 $C = 332.16'$
 $Lc = 338.43'$

Note: For Pavement Curve
Data, See Sht. C-6



APPROVED:
[Signature] 7/28/80
CHIEF, DIV. OF ENGR. & CONSTR. (FOR GRADING ONLY)
DATE
CHIEF HIGHWAYS DIVISION

WILSON OKAMOTO & ASSOC.
ENGINEERS-ARCHITECTS-PLANNERS
P.O. BOX 1000
HAWAII

KENNETH O. NAGA
REGISTERED
PROFESSIONAL
ENGINEER
No. 3263
HAWAII, U.S.A.

THIS WORK WAS PREPARED BY
ME OR UNDER MY SUPERVISION.
[Signature]

SYMBOL	DESCRIPTION	DATE	APP'D
REVISIONS			
STATE OF HAWAII DEPARTMENT OF LAND AND NATURAL RESOURCES DIVISION OF WATER AND LAND DEVELOPMENT			
SAND ISLAND PARKWAY INCREMENT II, PHASE I & SEWAGE PUMP STATION SAND ISLAND, OAHU, HAWAII			
GRADING PLAN STA. 38+24.28 TO STA. 45+00			
DESIGNED: K.N.	SUBMITTED: <i>[Signature]</i>		
DRAWN: R.N.	DATE: 5/2/80	CHIEF DESIGN & CONSTR. ENGINEER	
CHECKED: K.N.	DATE: 5/2/80		
APPROVED: <i>[Signature]</i>	MANAGER-CHIEF ENGINEER	FILE NO.	
DATE: 5/2/80			

As Built