
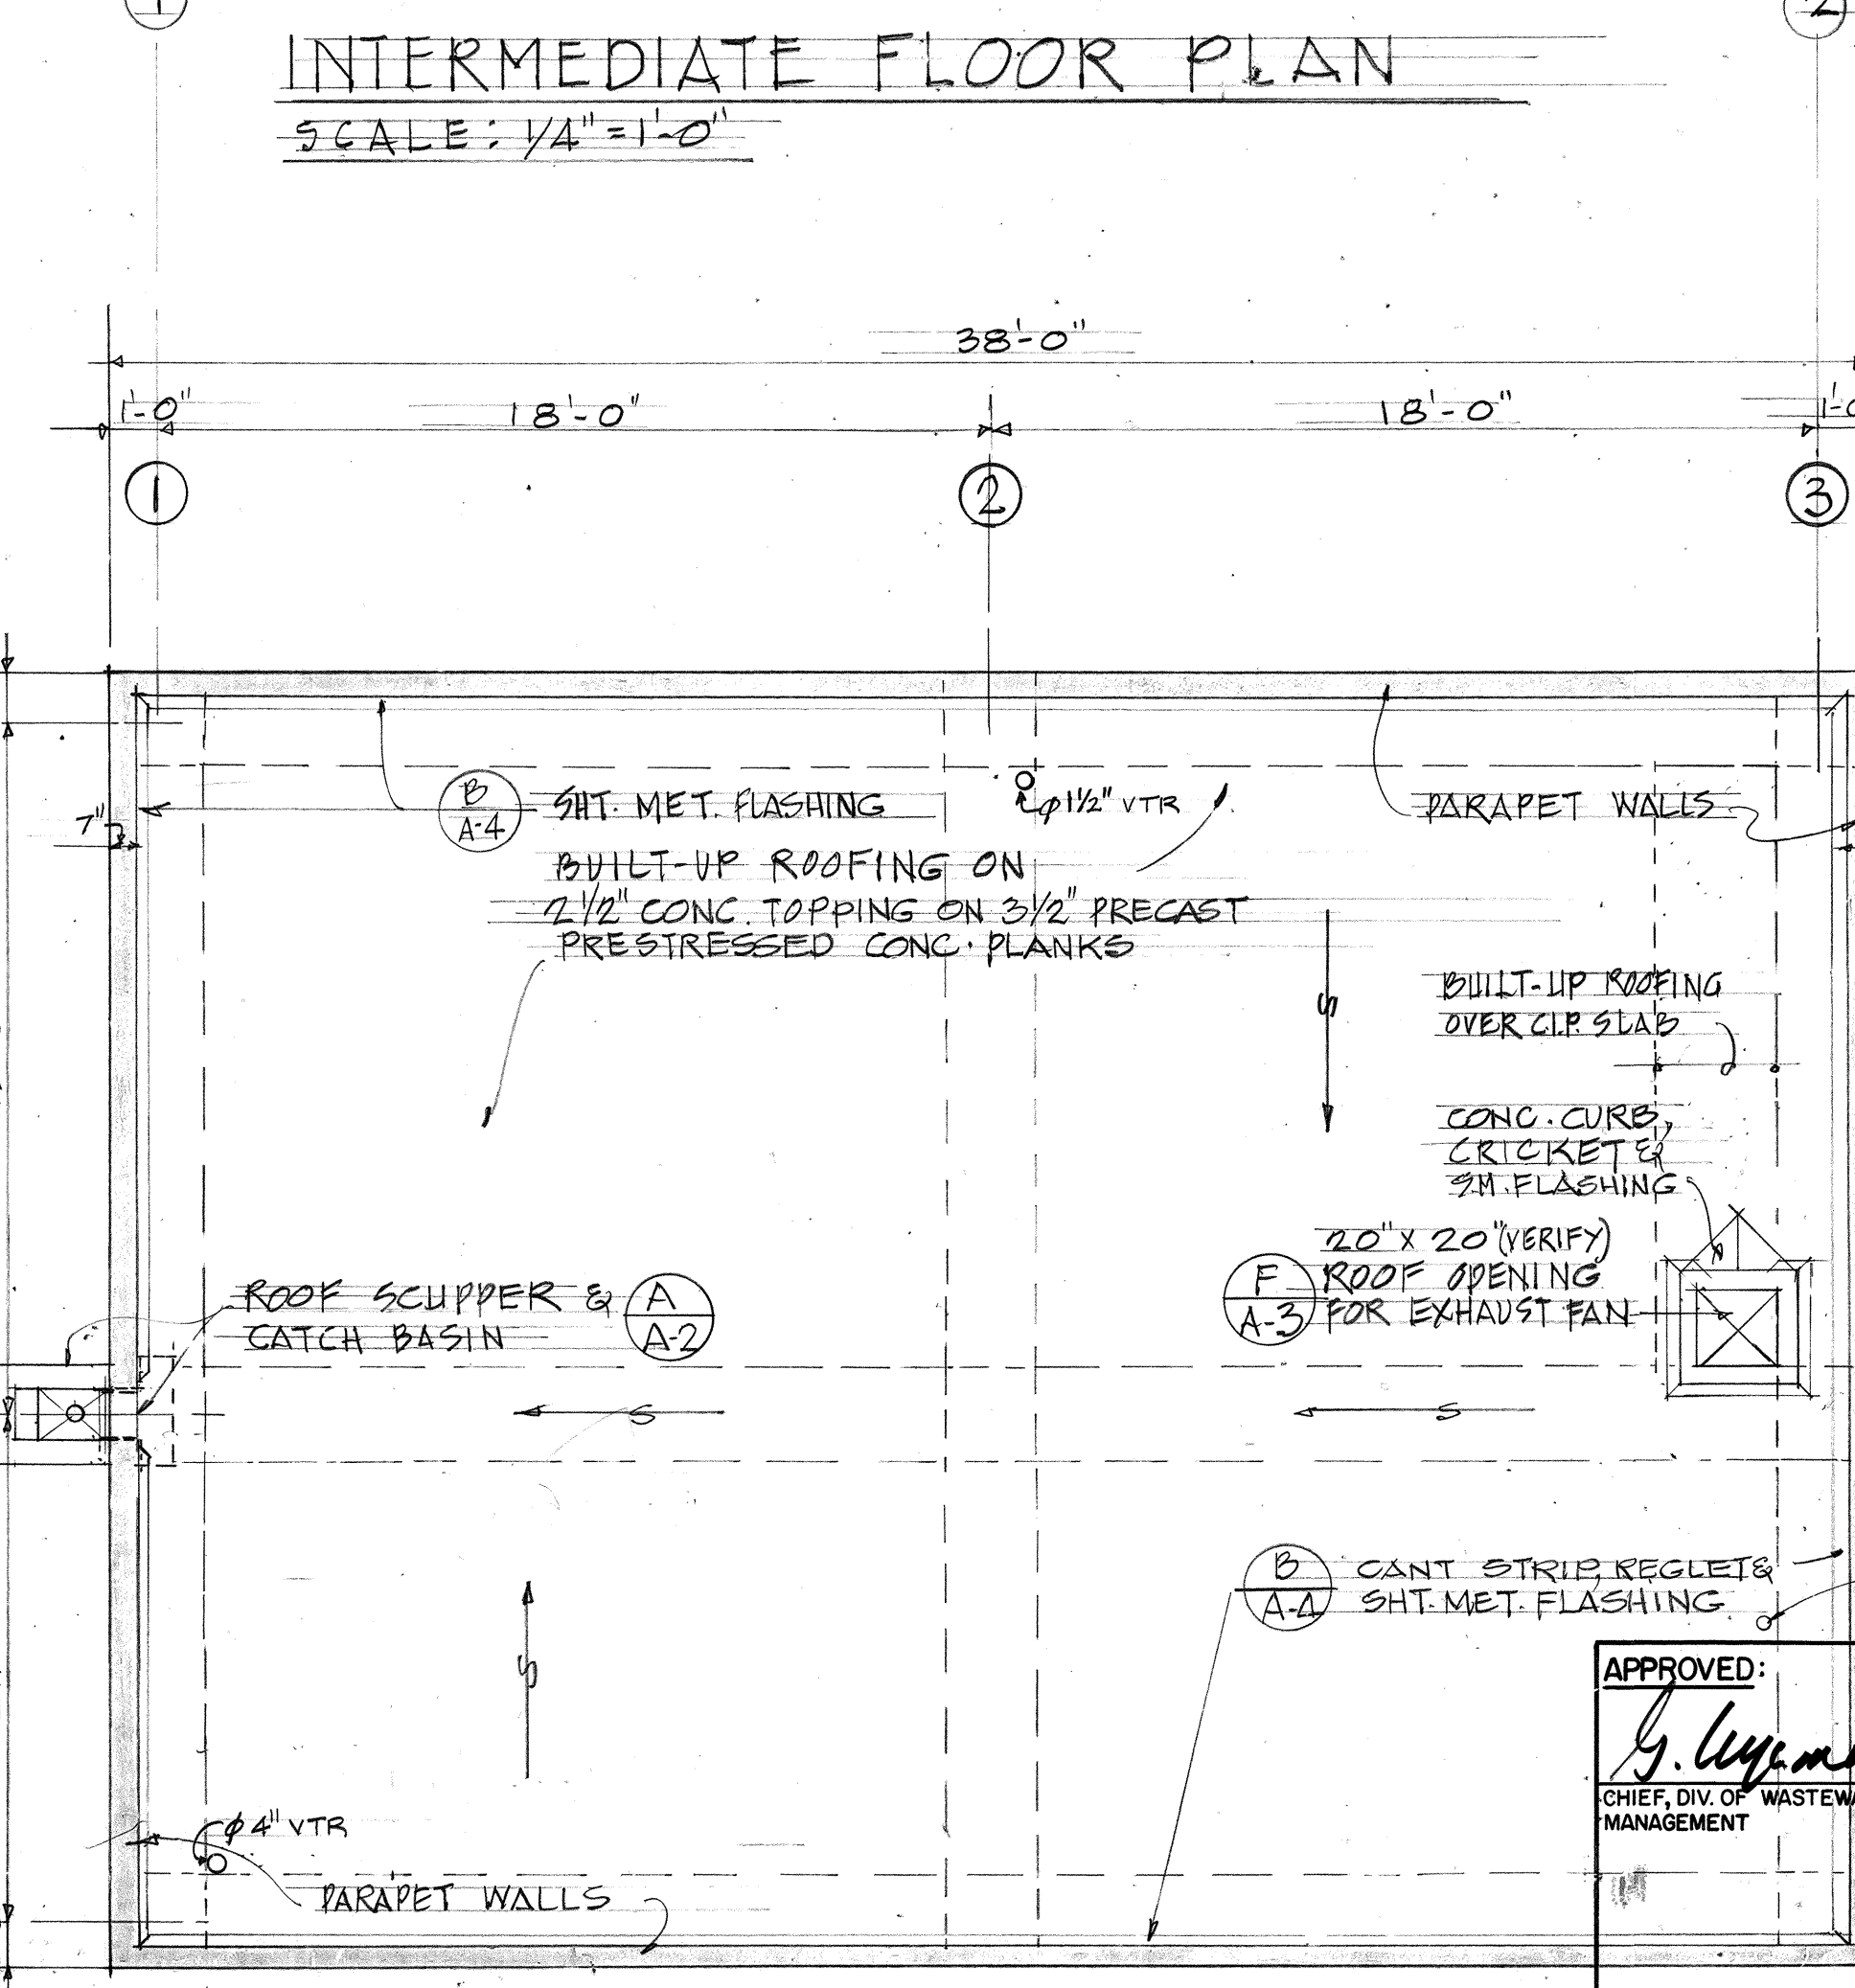
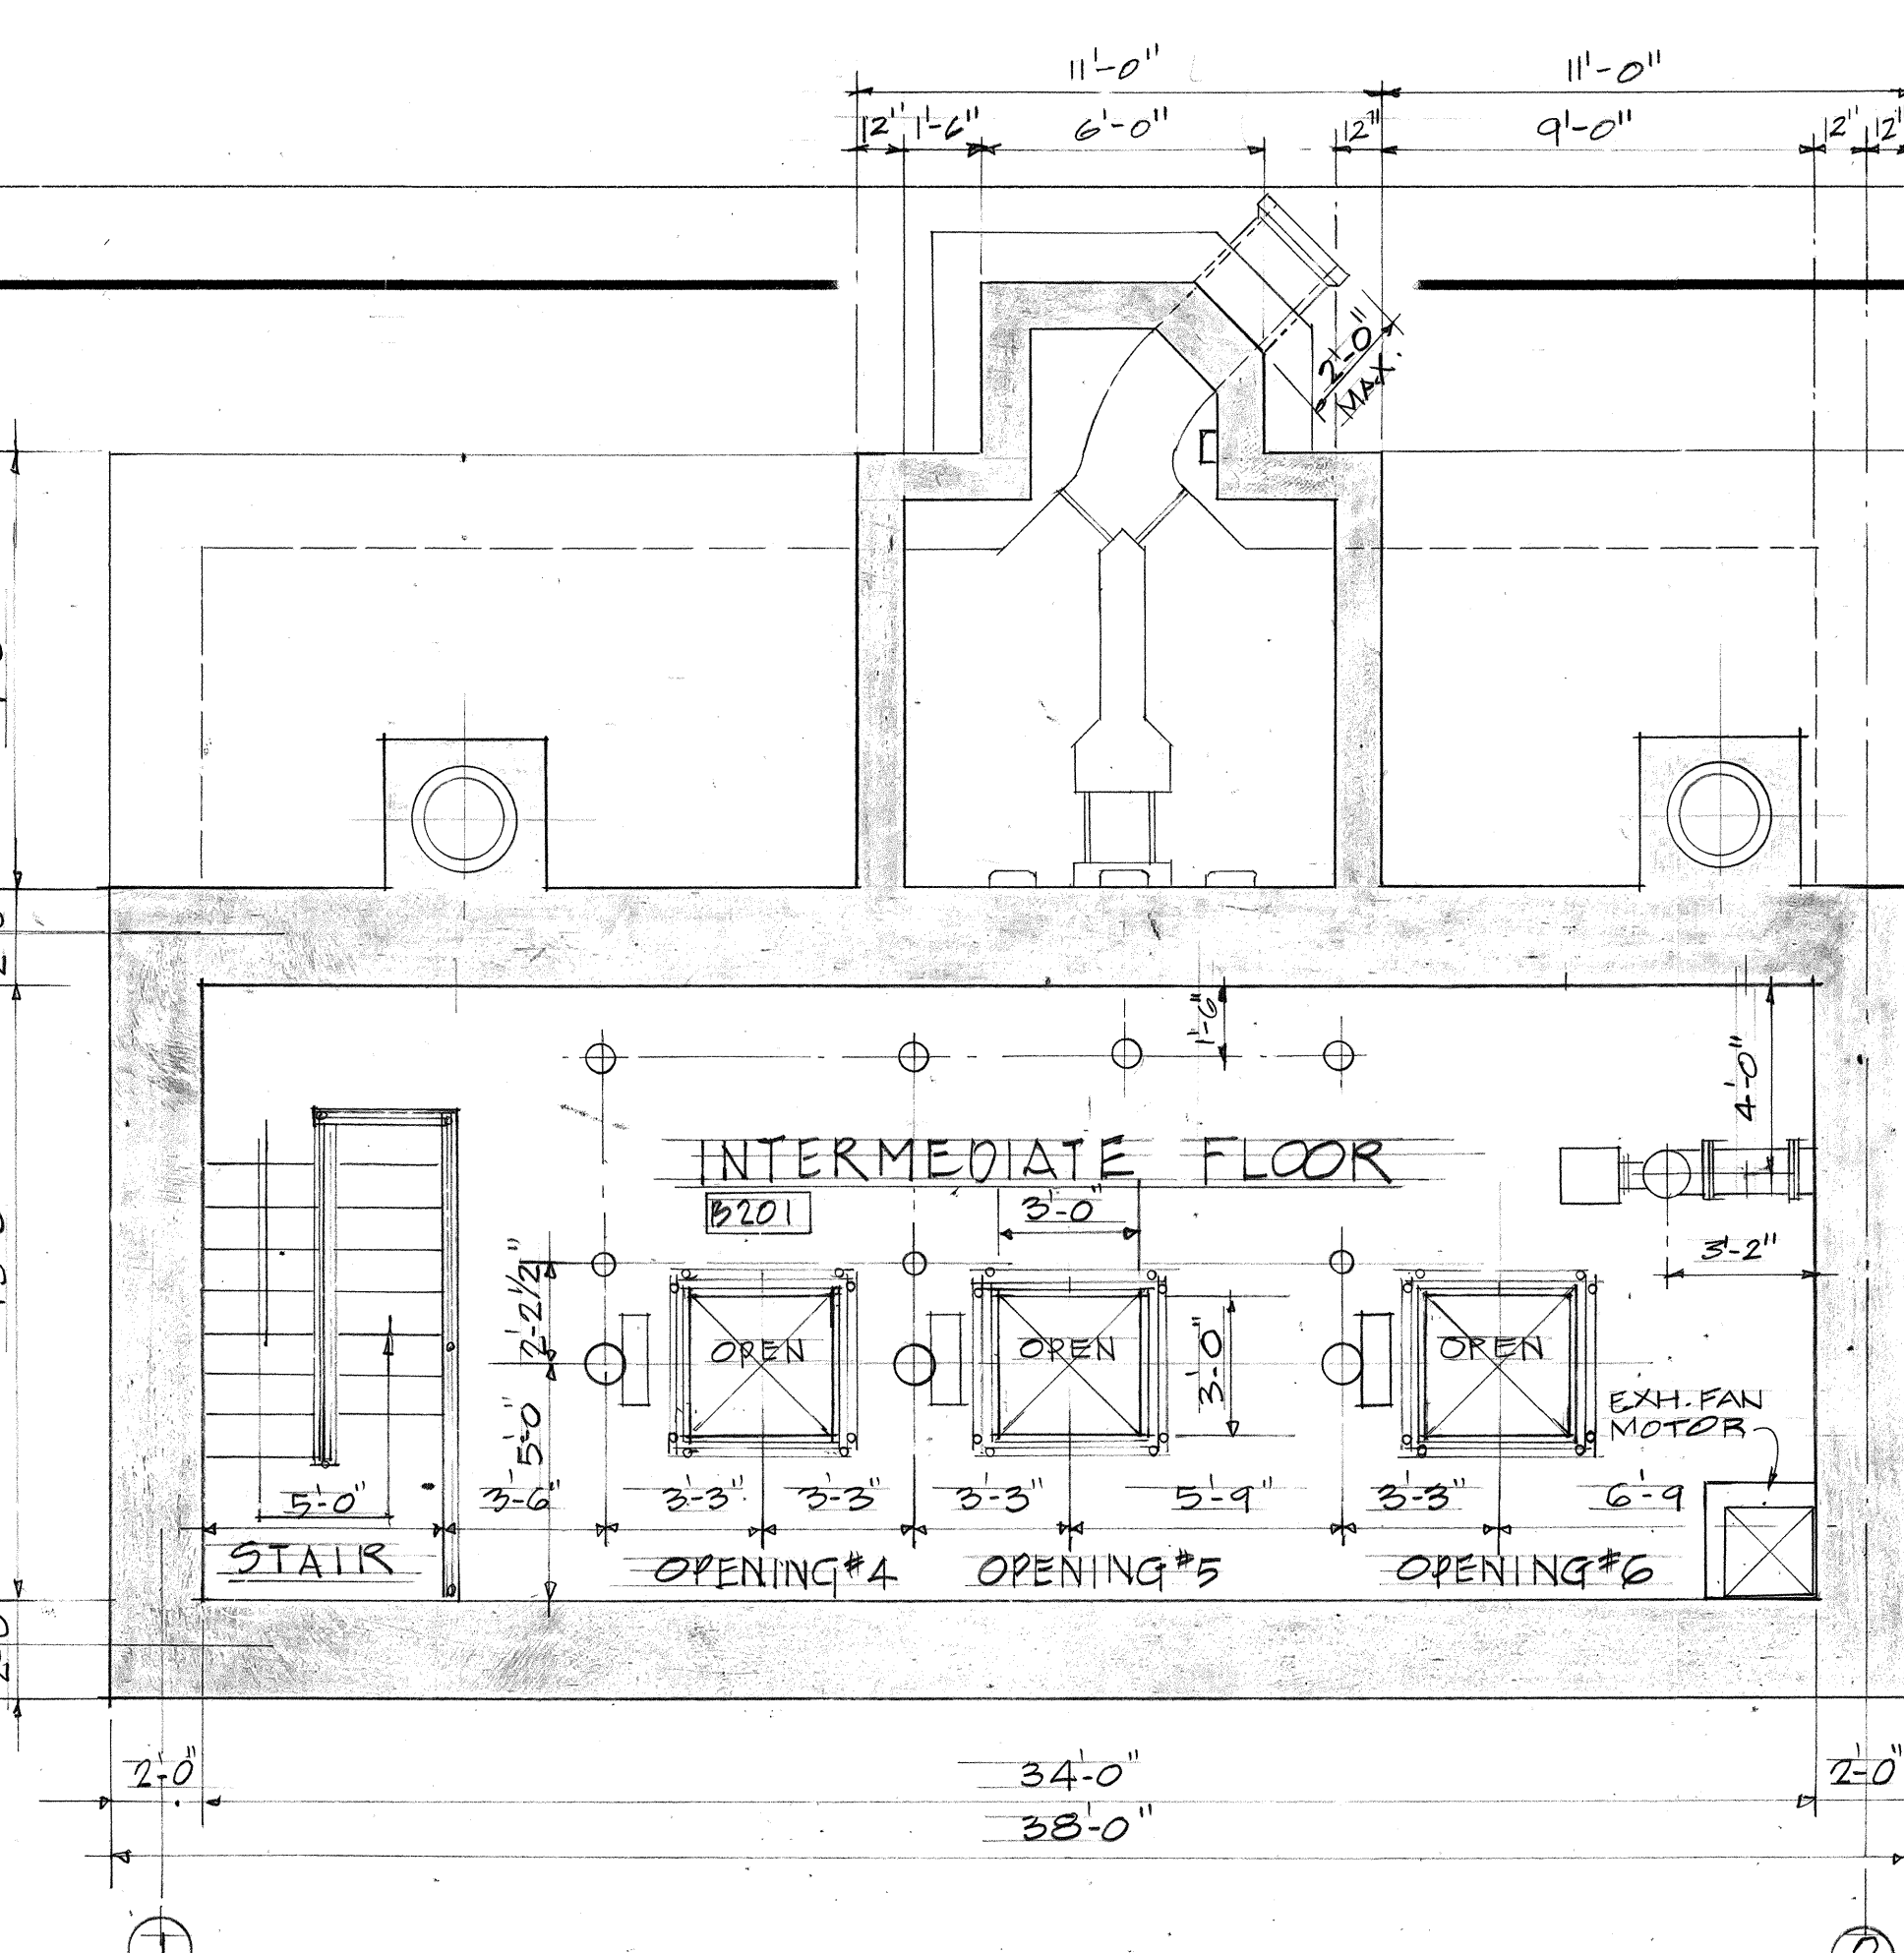
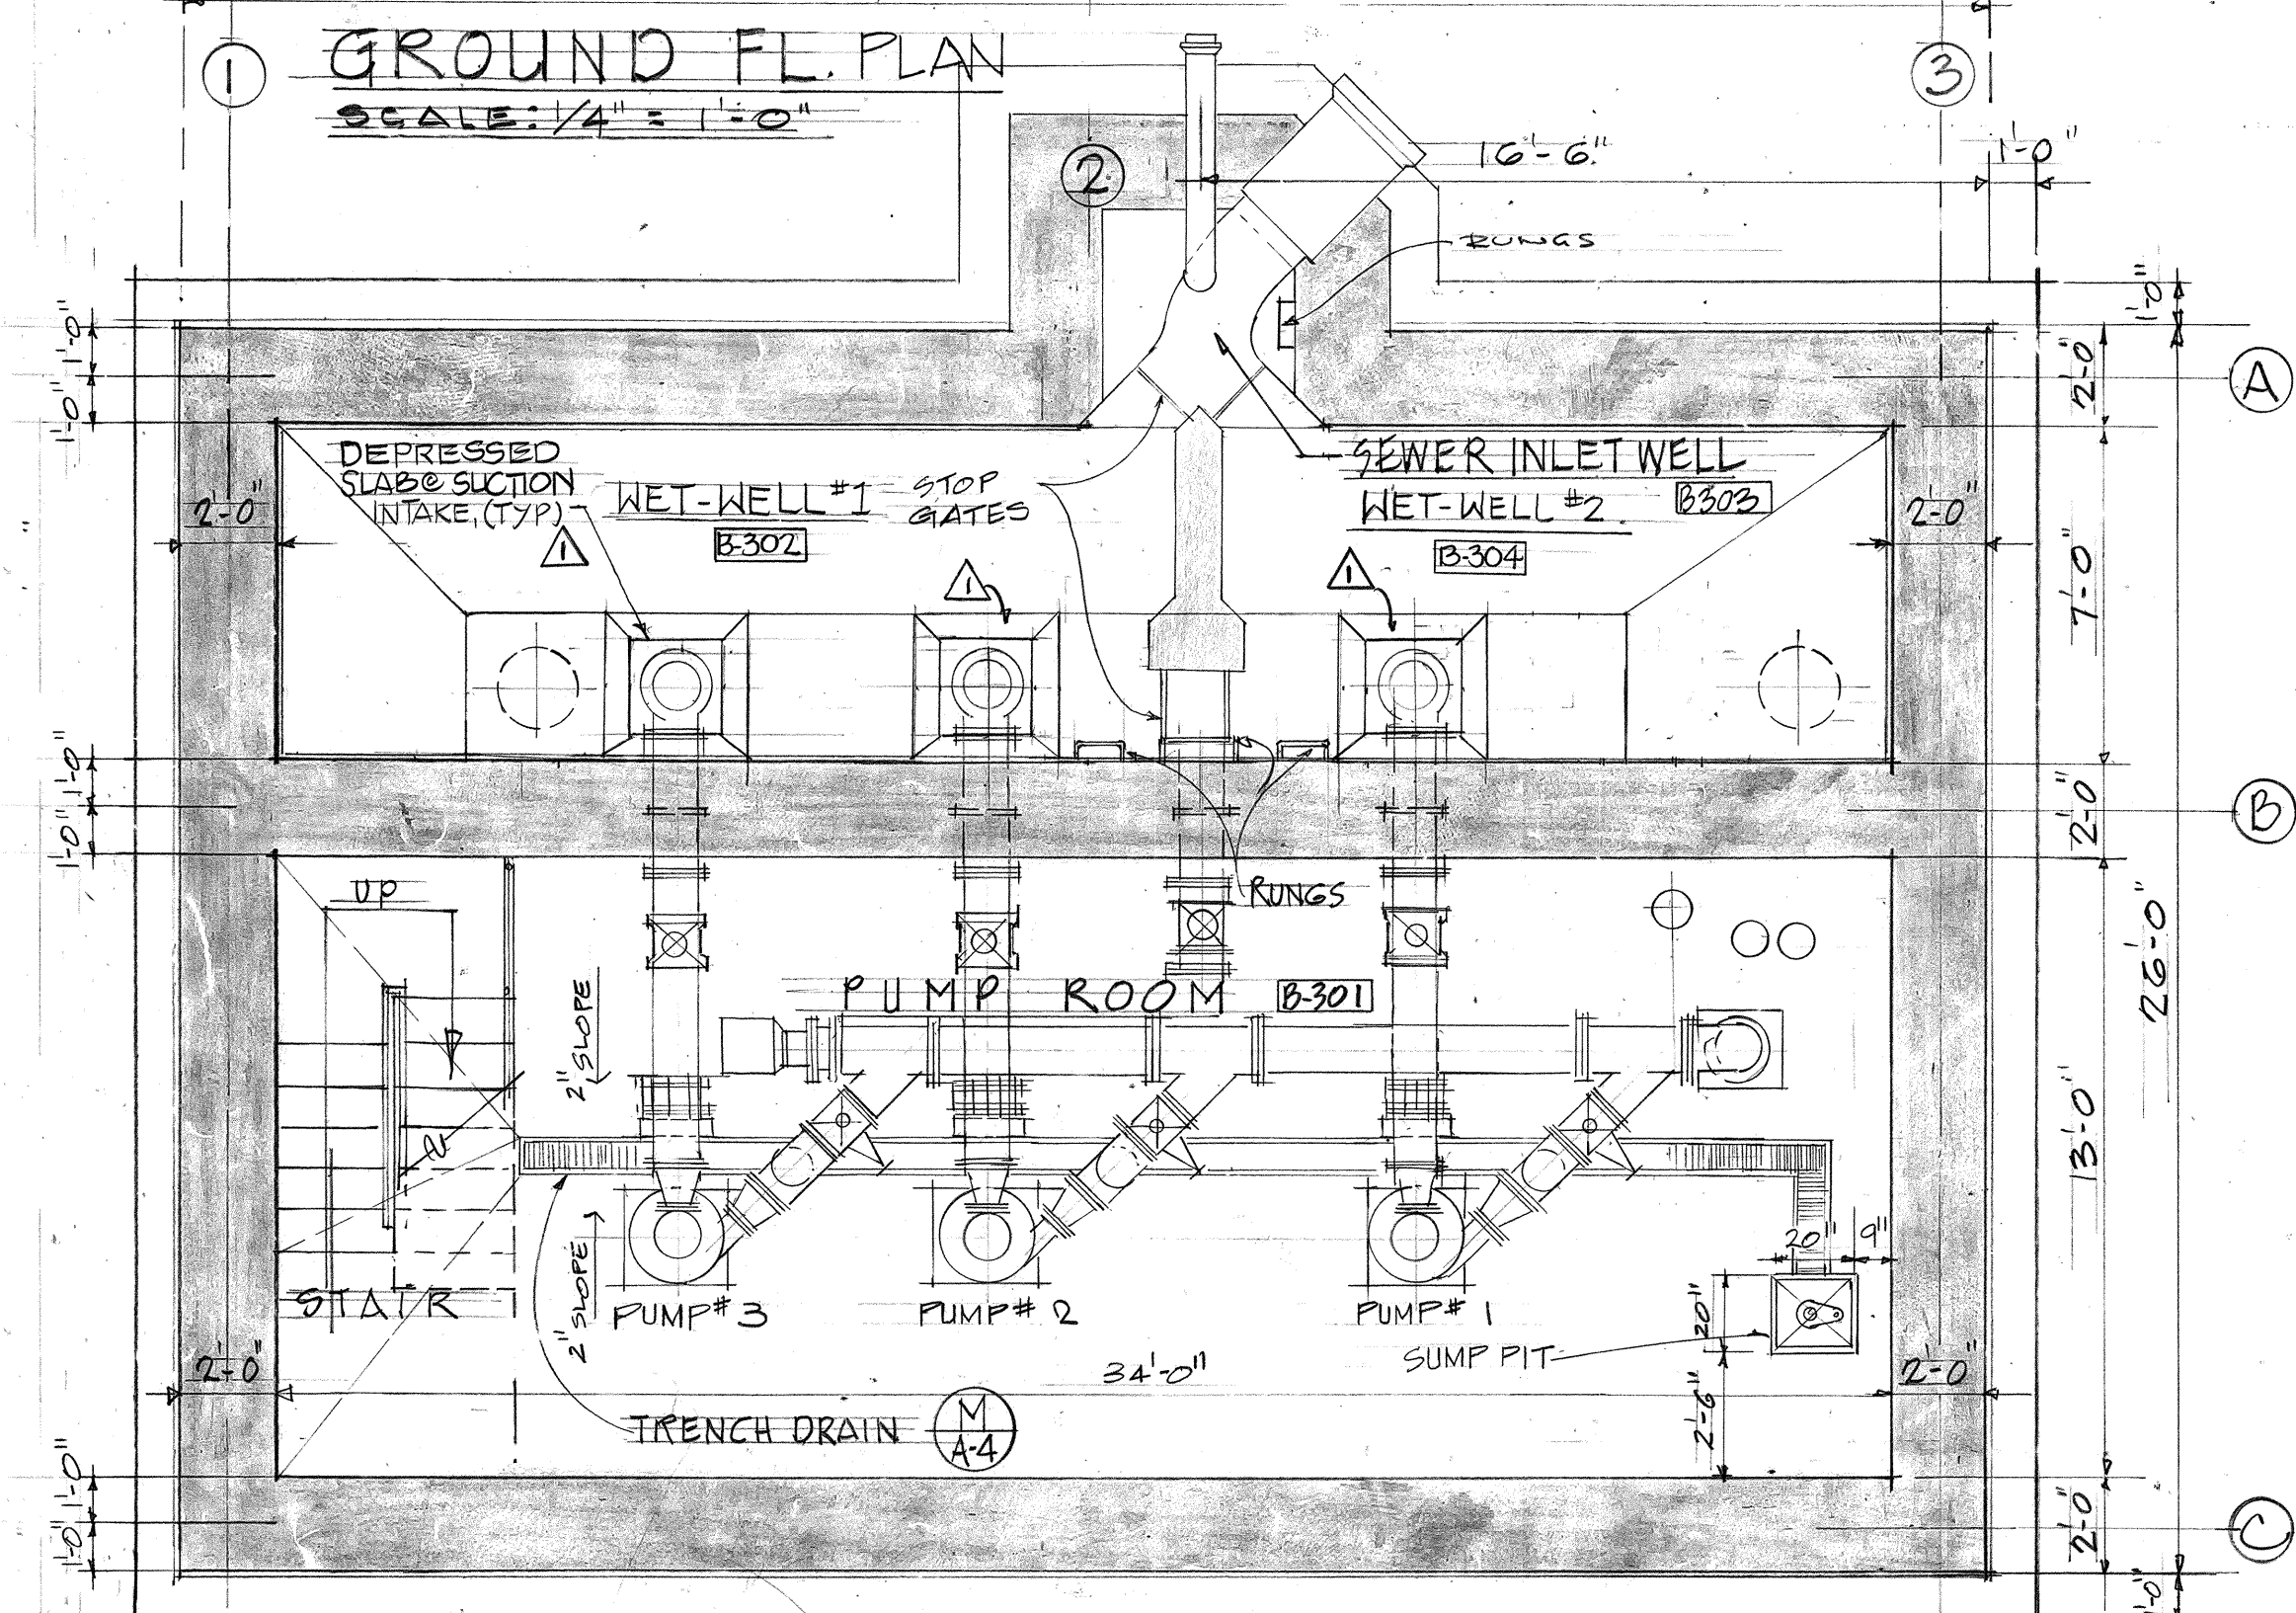


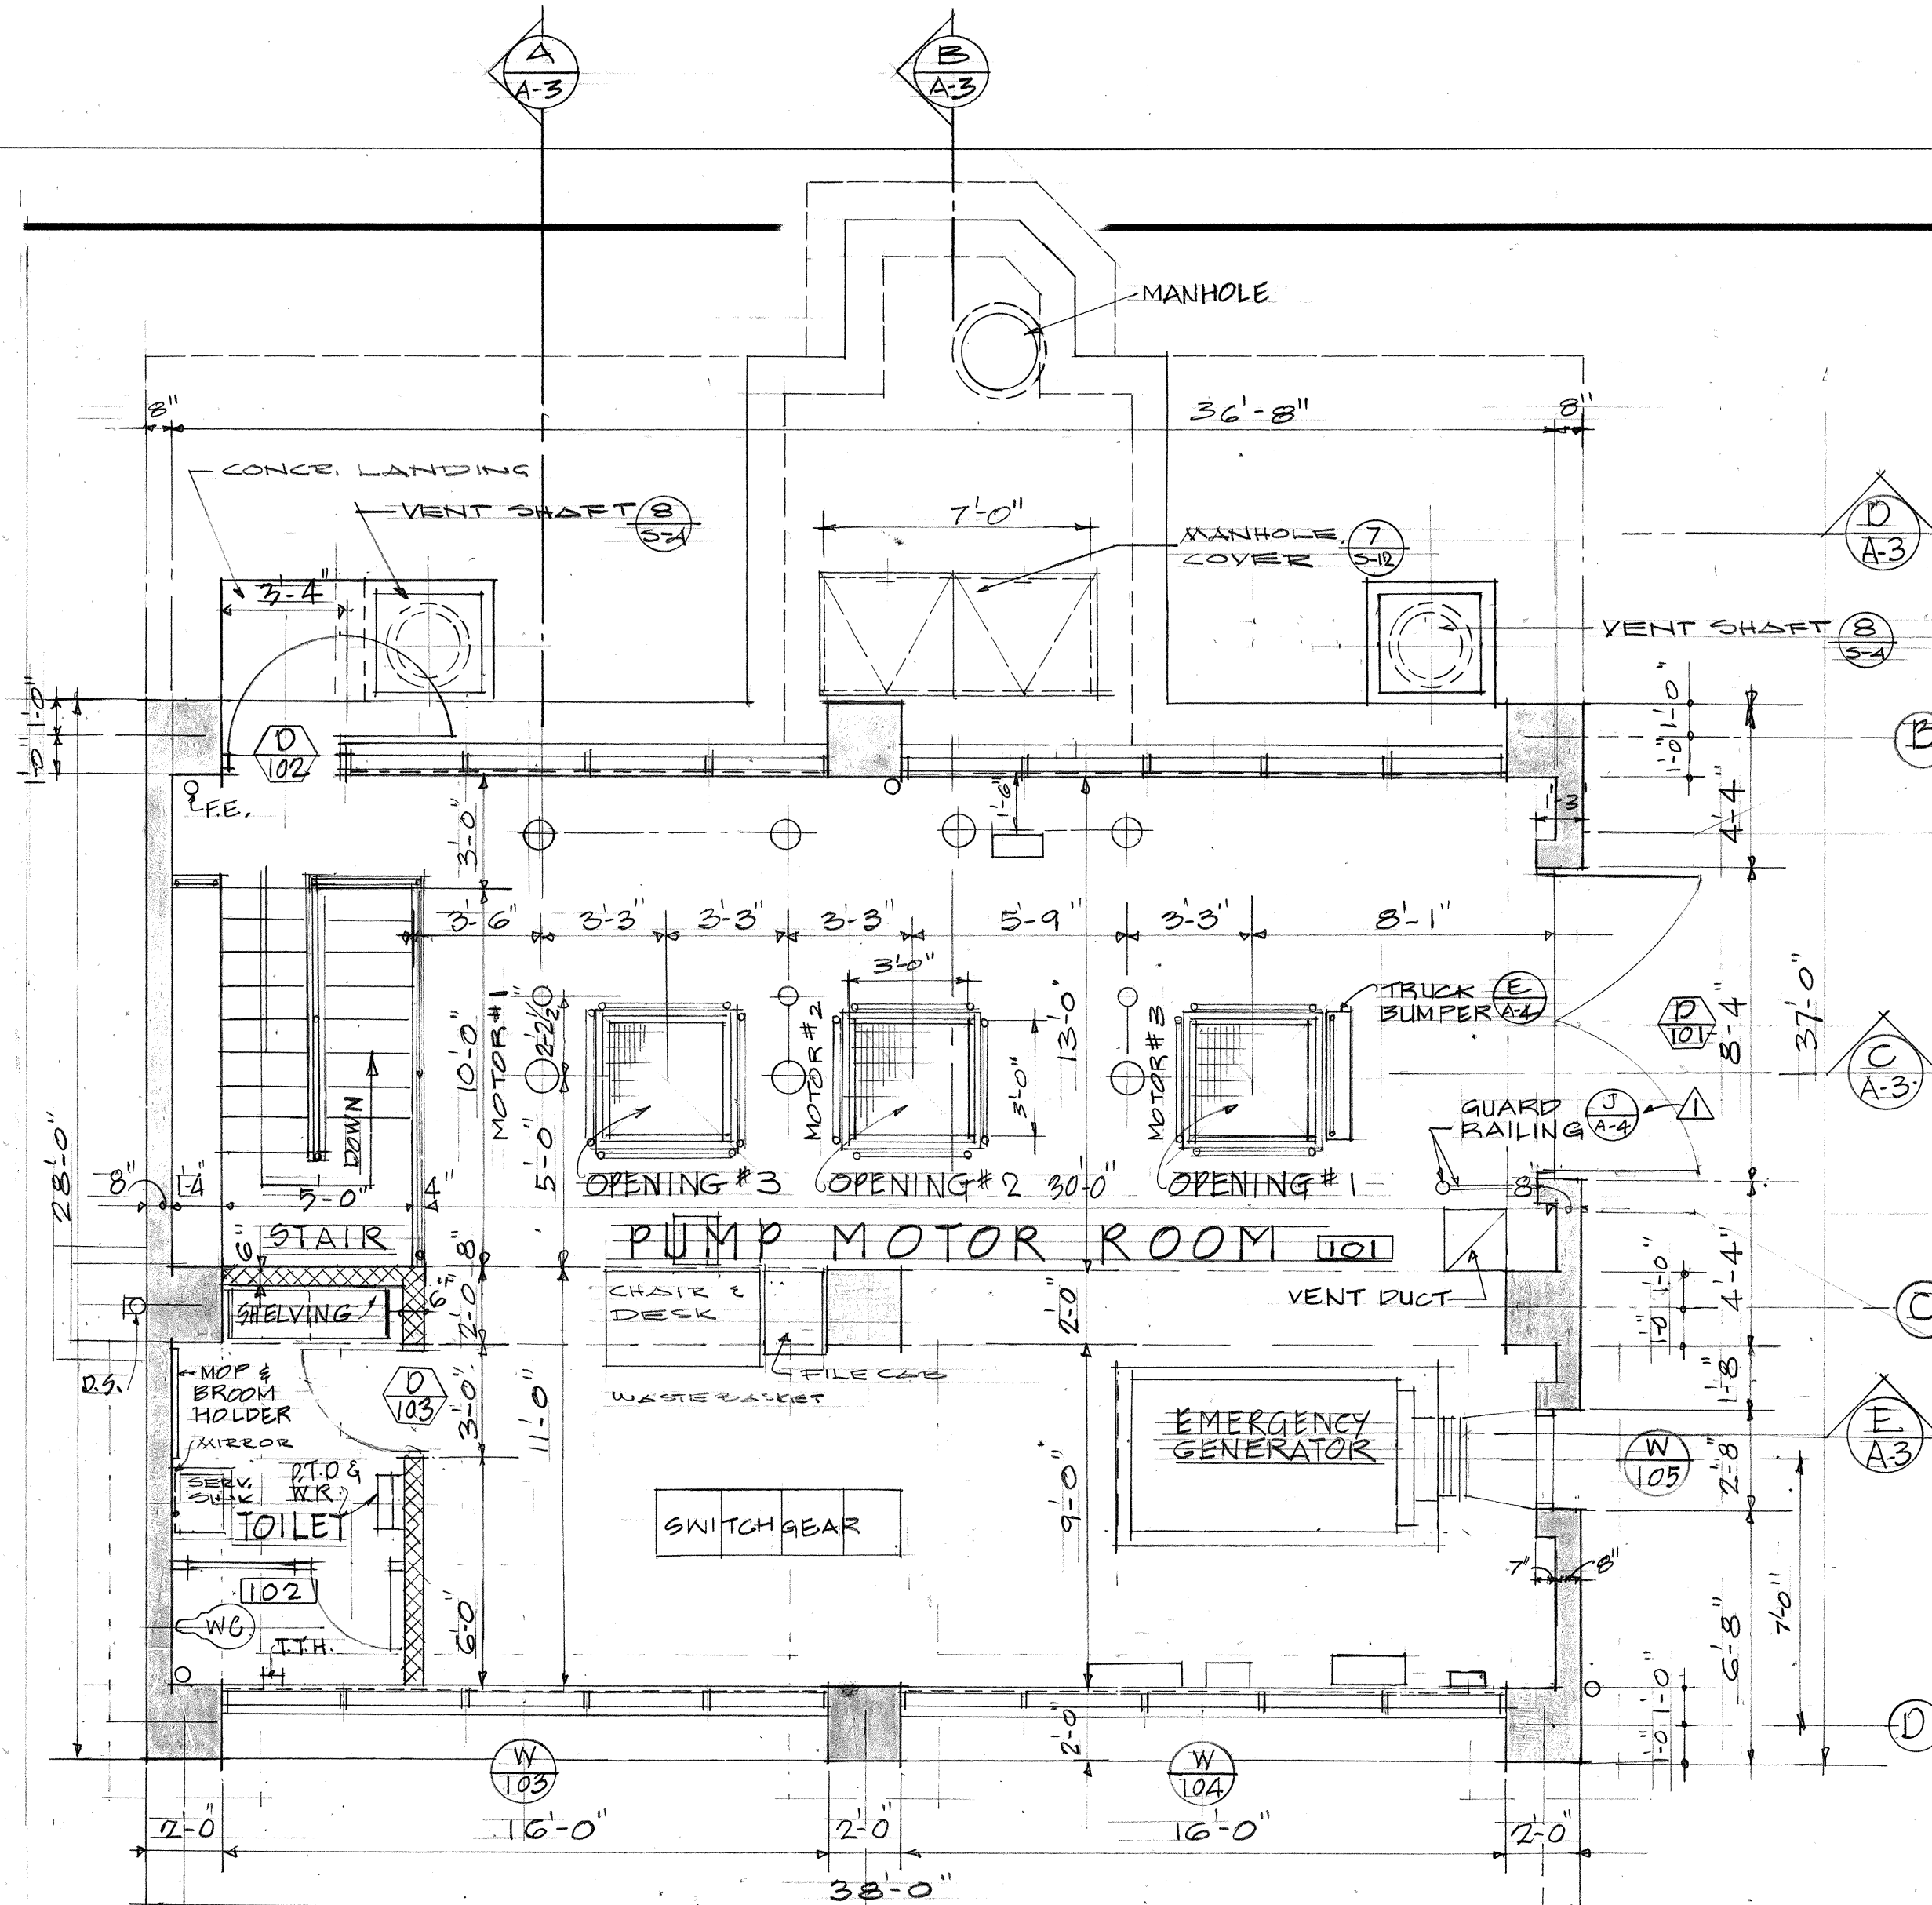

ROOM NO.	NAME	REL. AREA	FLOOR	BASE	WALL	MAIN	CILING	SIGN	REMARKS
101	PUMP MOTOR ROOM	800							NE REQUIRED
102	TOILET	63							ARCH CONC. PRE-CAST CONC PANEL PROTECTIVE LINER EPOXY
ALL	STAIR STEPS/LANDINGS								ARCH CONC EXP. CMU PROTECTIVE LINER
0001	INTERMEDIATE FL.	442							NO BASE EPOXY
0001	PUMP ROOM	442							ARCH CONC. COLOR CONC NON-SLIP CONC. EPOXY GRATING
0002	WET WELL NO. 1	119							
0003	SEWER INLET	21							
0004	WET WELL NO. 2	84							







WILSON OKAMOTO & ASSOC.
ENGINEERS - ARCHITECTS - PLANNERS
HONOLULU HAWAII

APPROVED: *[Signature]*
DATE: 6/24/80
CHIEF, DIV. OF WASTEWATER MANAGEMENT

WALTER LEU
REGISTERED PROFESSIONAL ARCHITECT
No. 2709
HAWAII, U.S.A.

STATE OF HAWAII
DEPARTMENT OF LAND AND NATURAL RESOURCES
DIVISION OF WATER AND LAND DEVELOPMENT
SAND ISLAND PARKWAY INCREMENT II, PHASE I
& SEWAGE PUMP STATION
PLANS, ROOM FINISH SCHEDULE

DESIGNED W.L. SUBMITTED *[Signature]*
DRAWN W.L. DATE 5/24/80
CHECKED W.L. DATE 5/24/80
APPROVED *[Signature]* FILE NO.
DATE 5/24/80 MANAGER-CHIEF ENGINEER

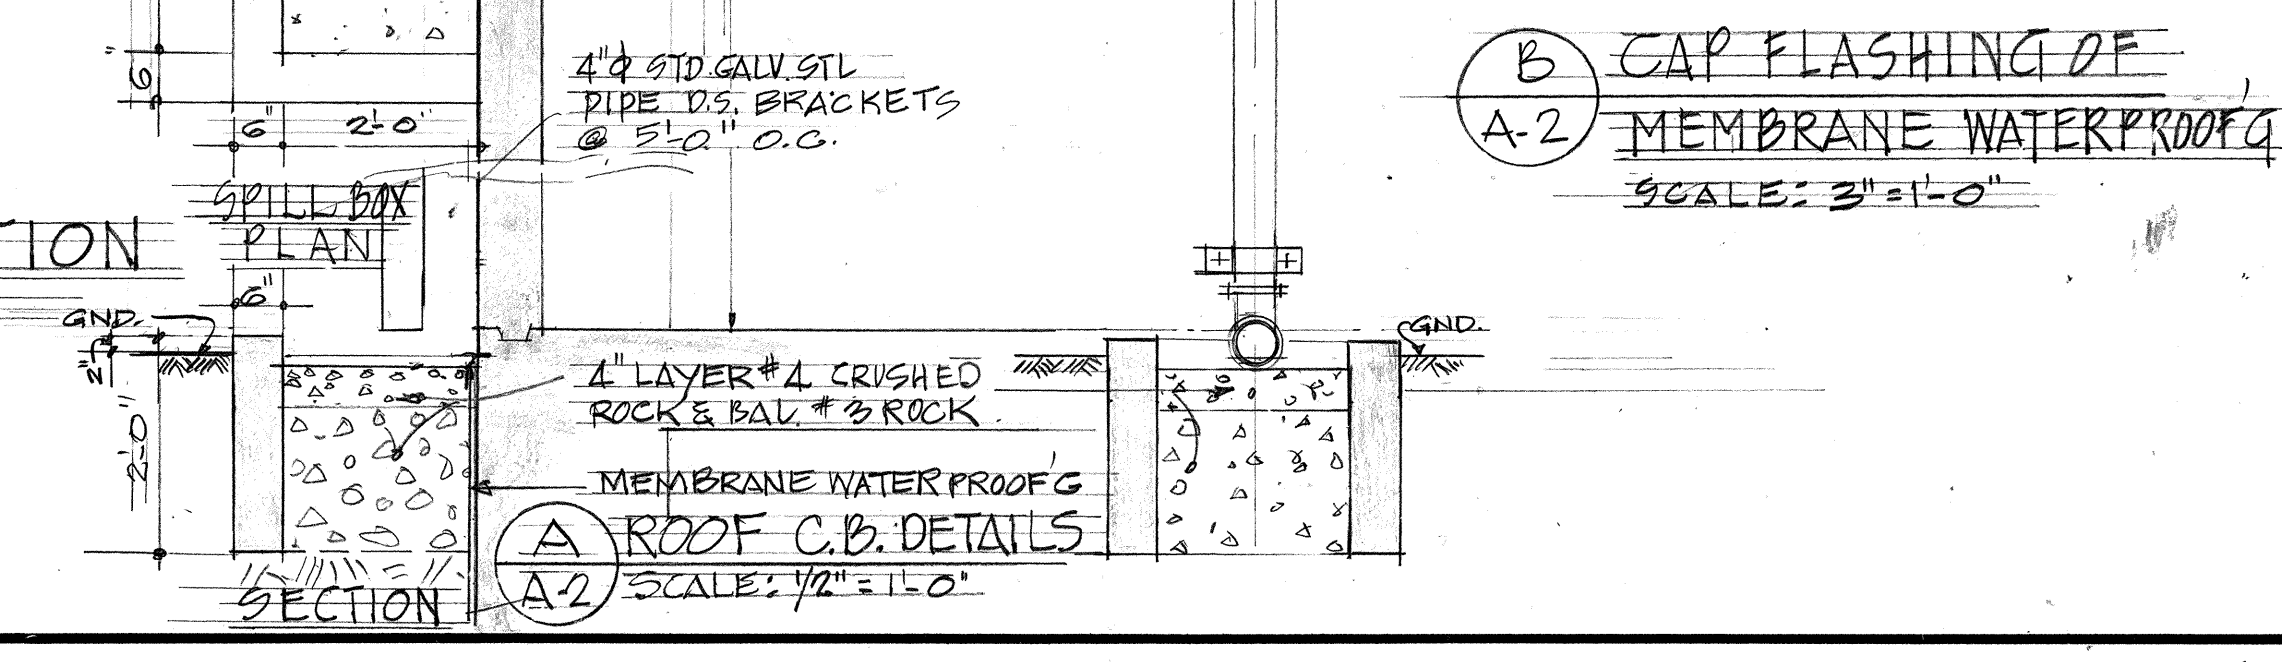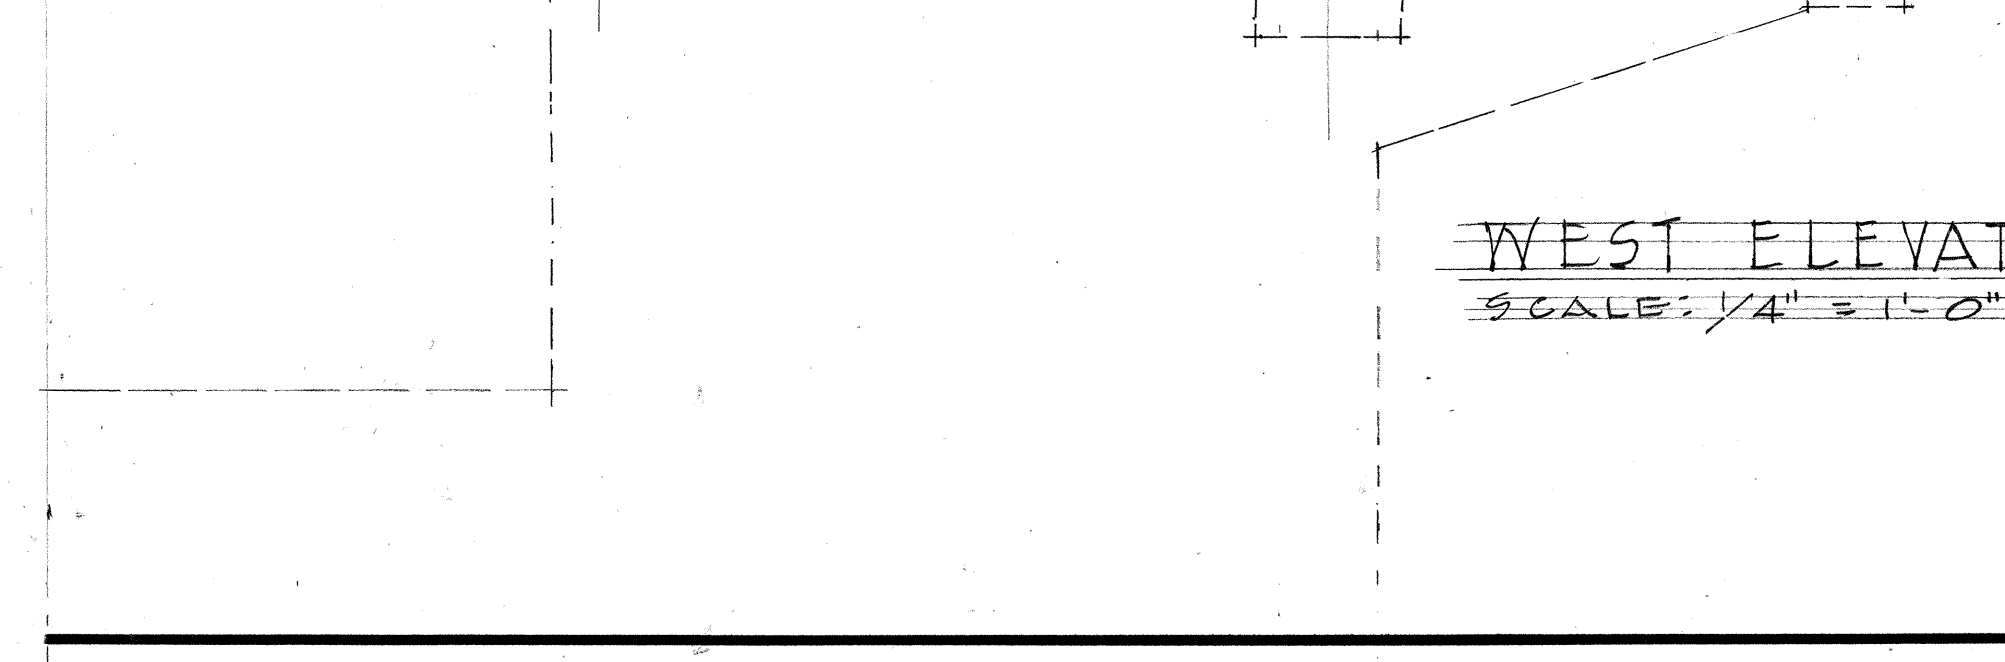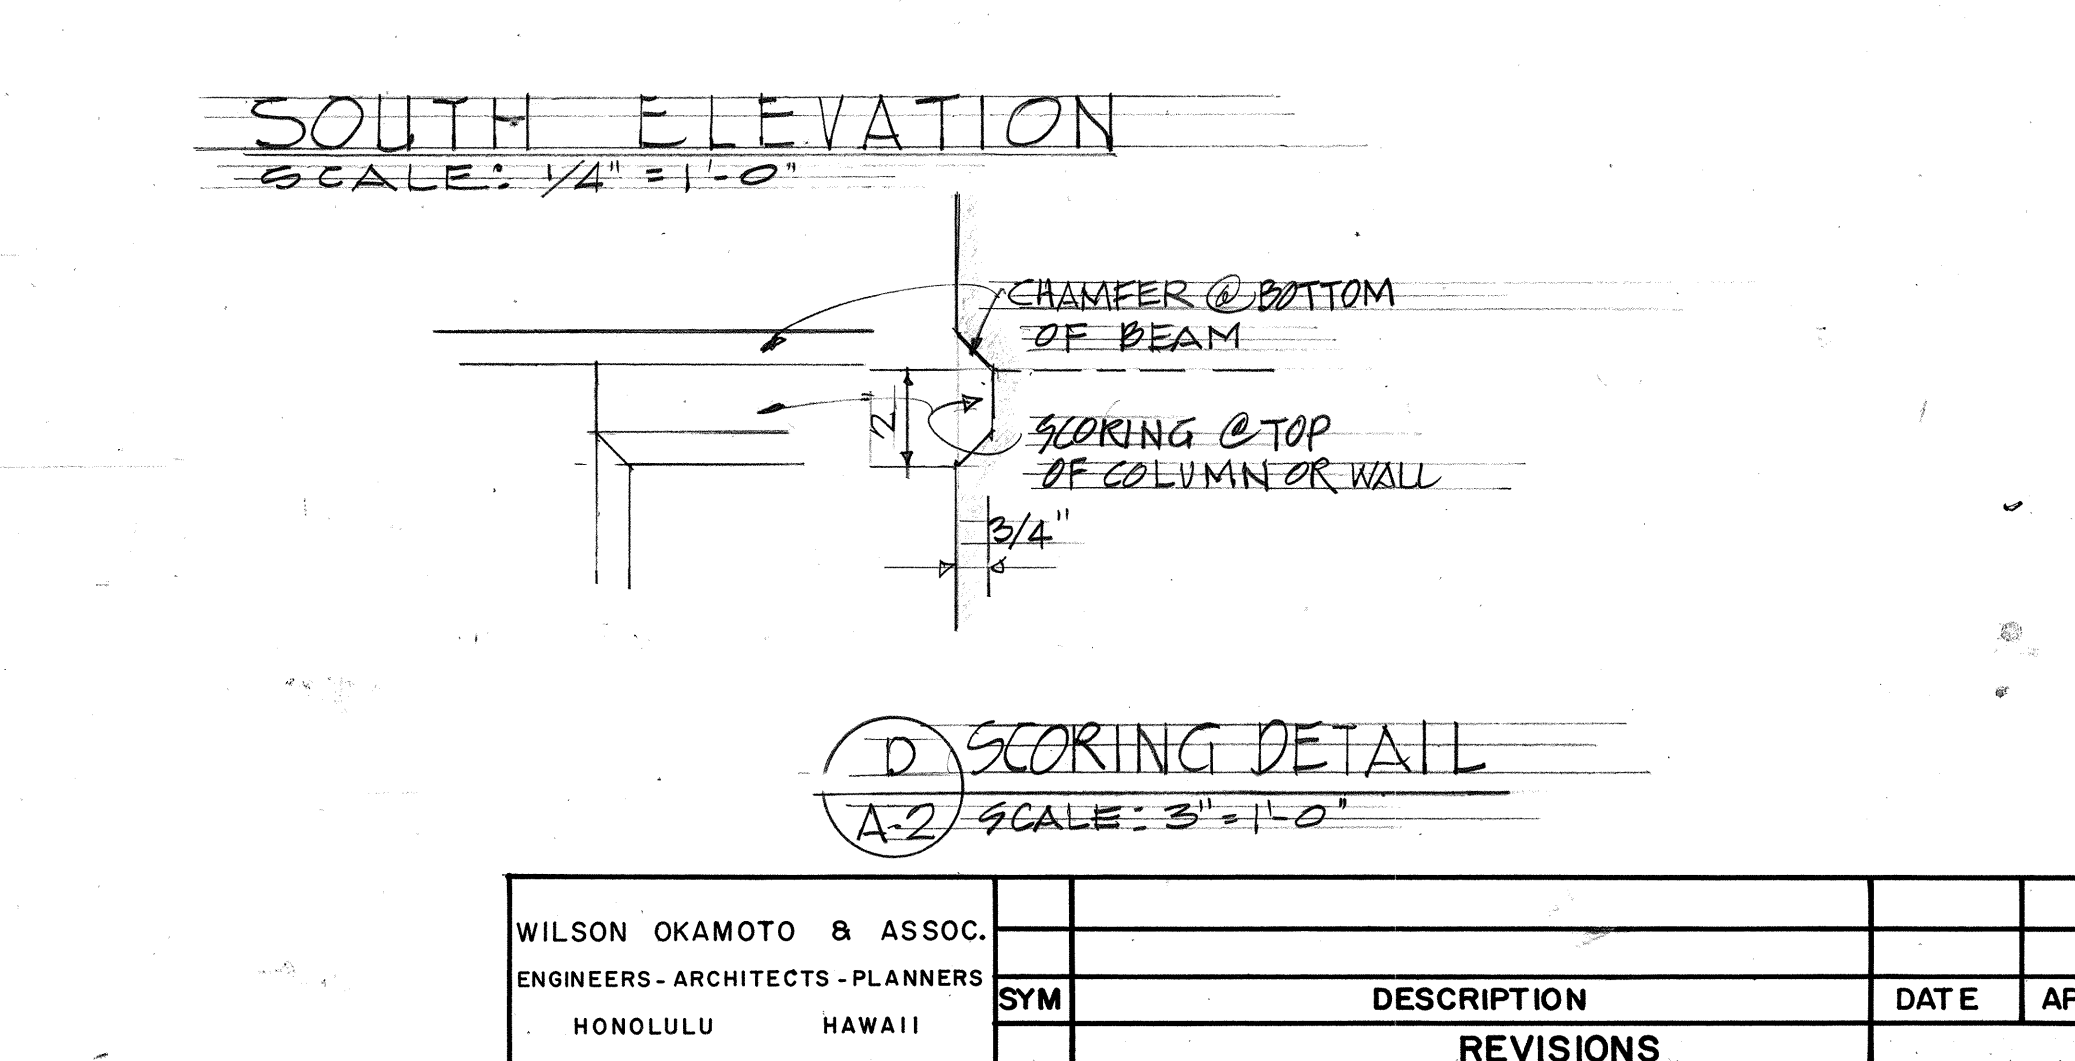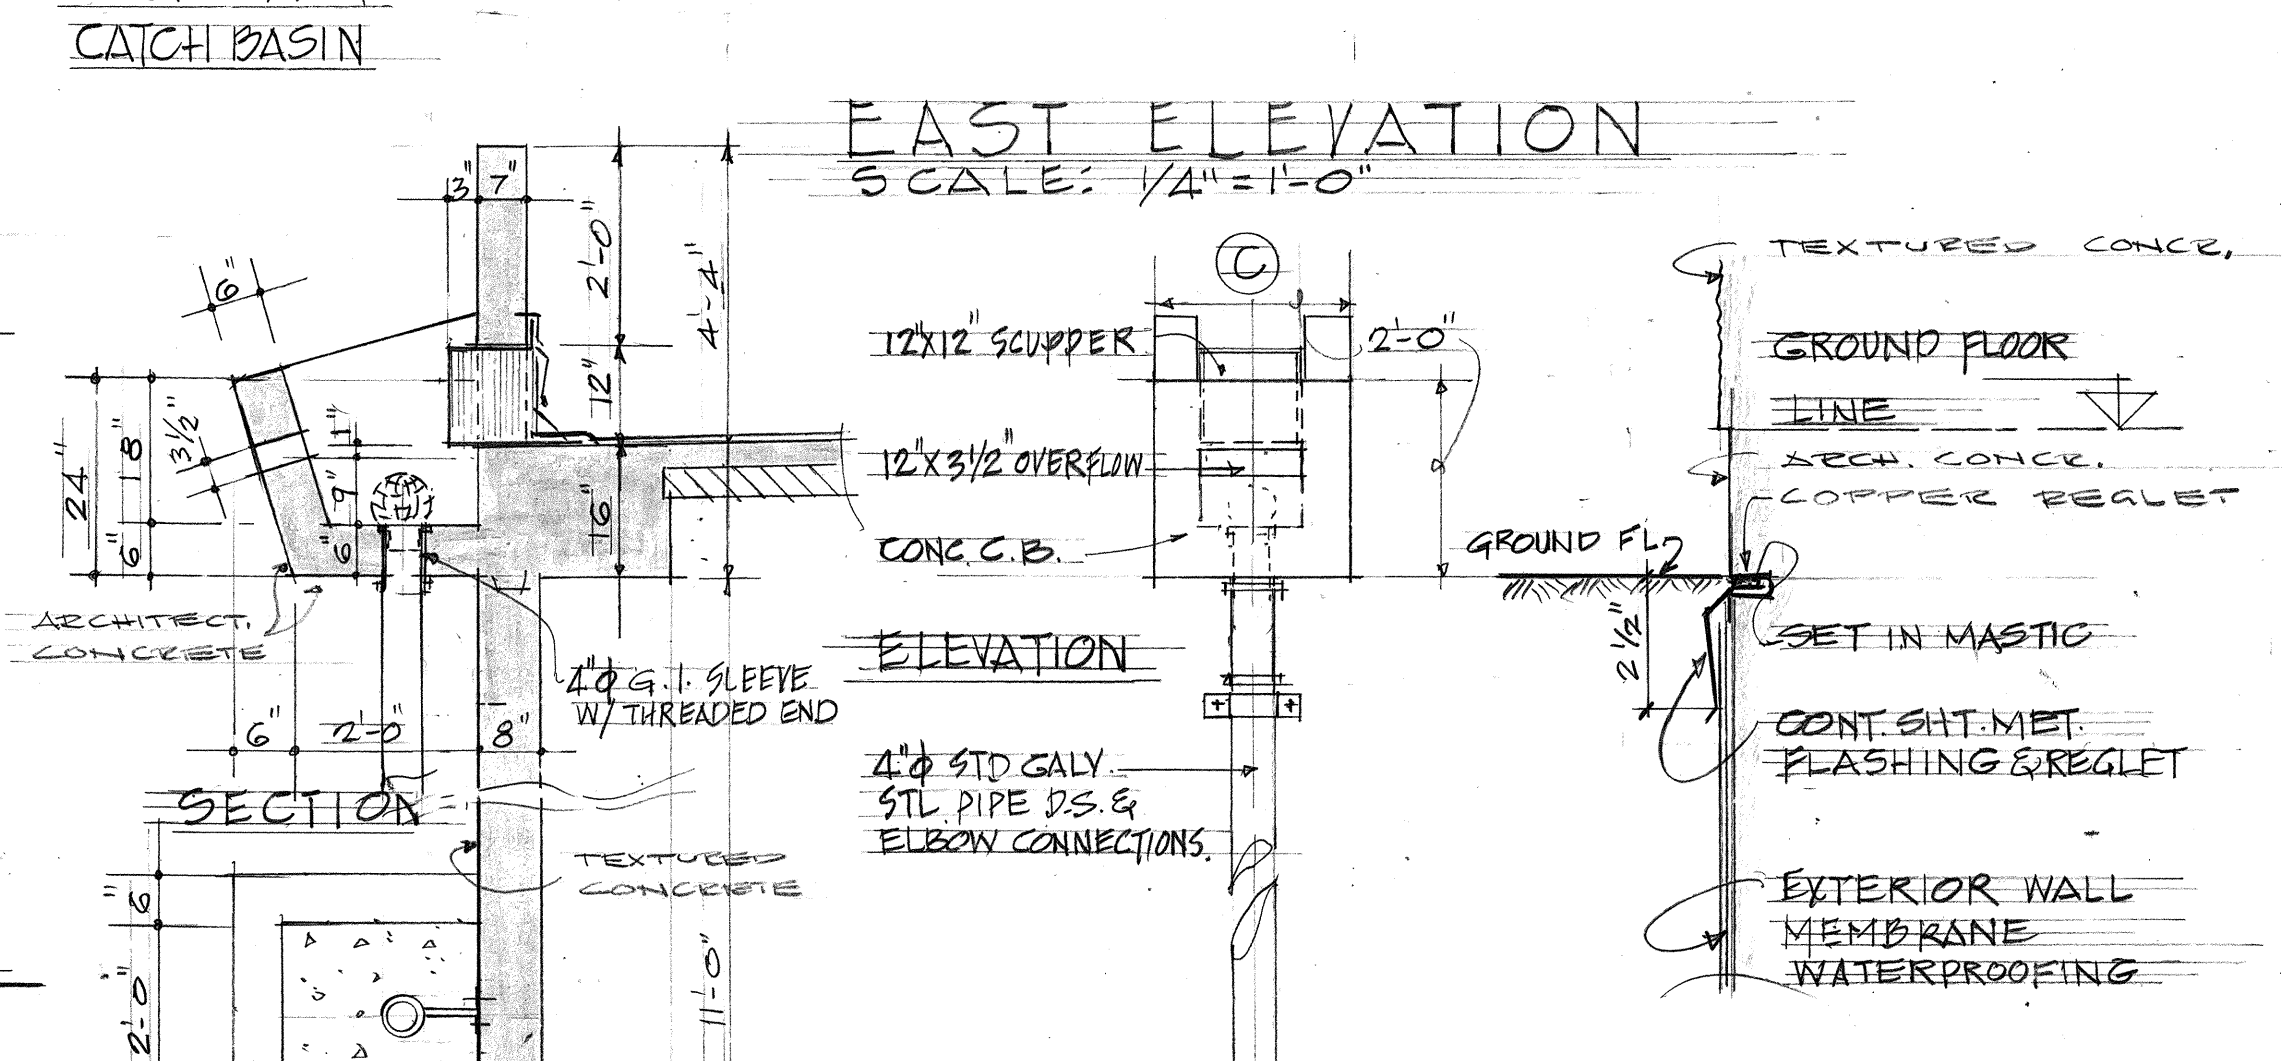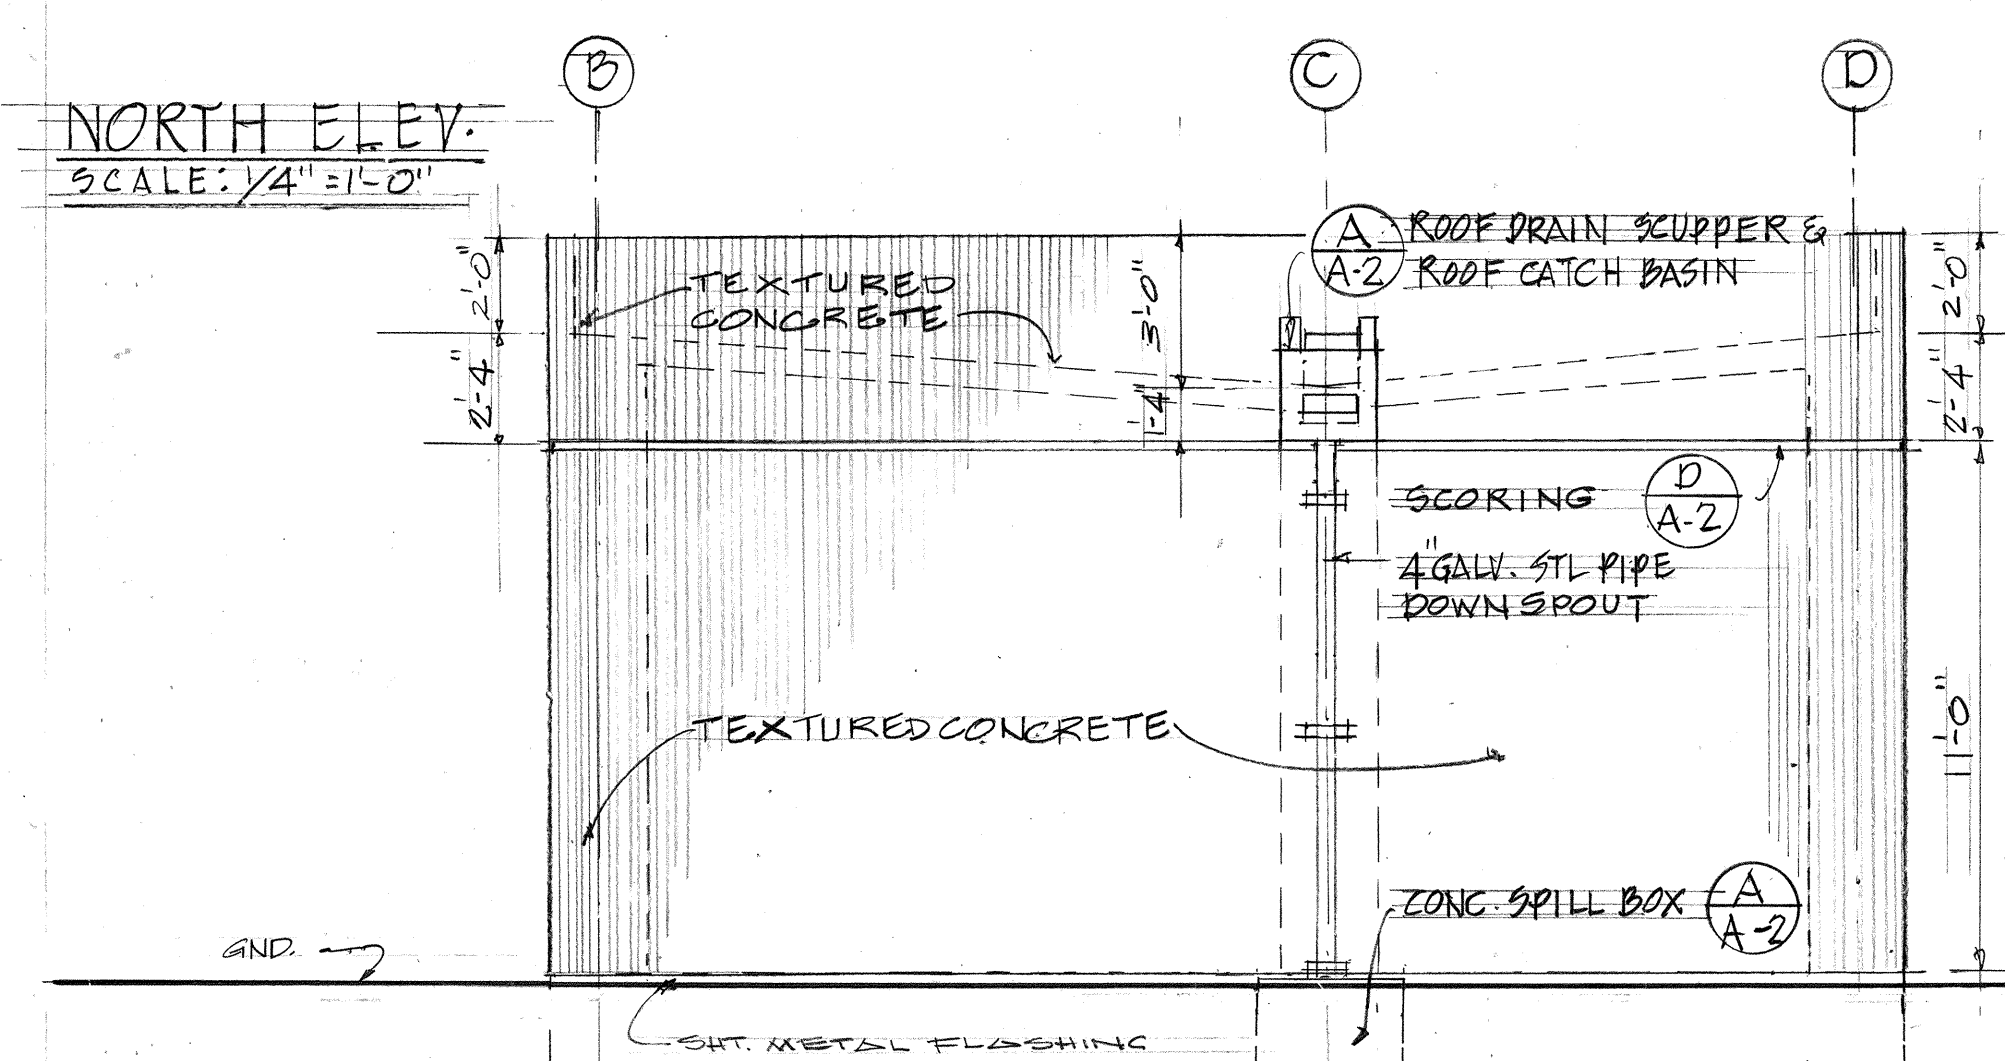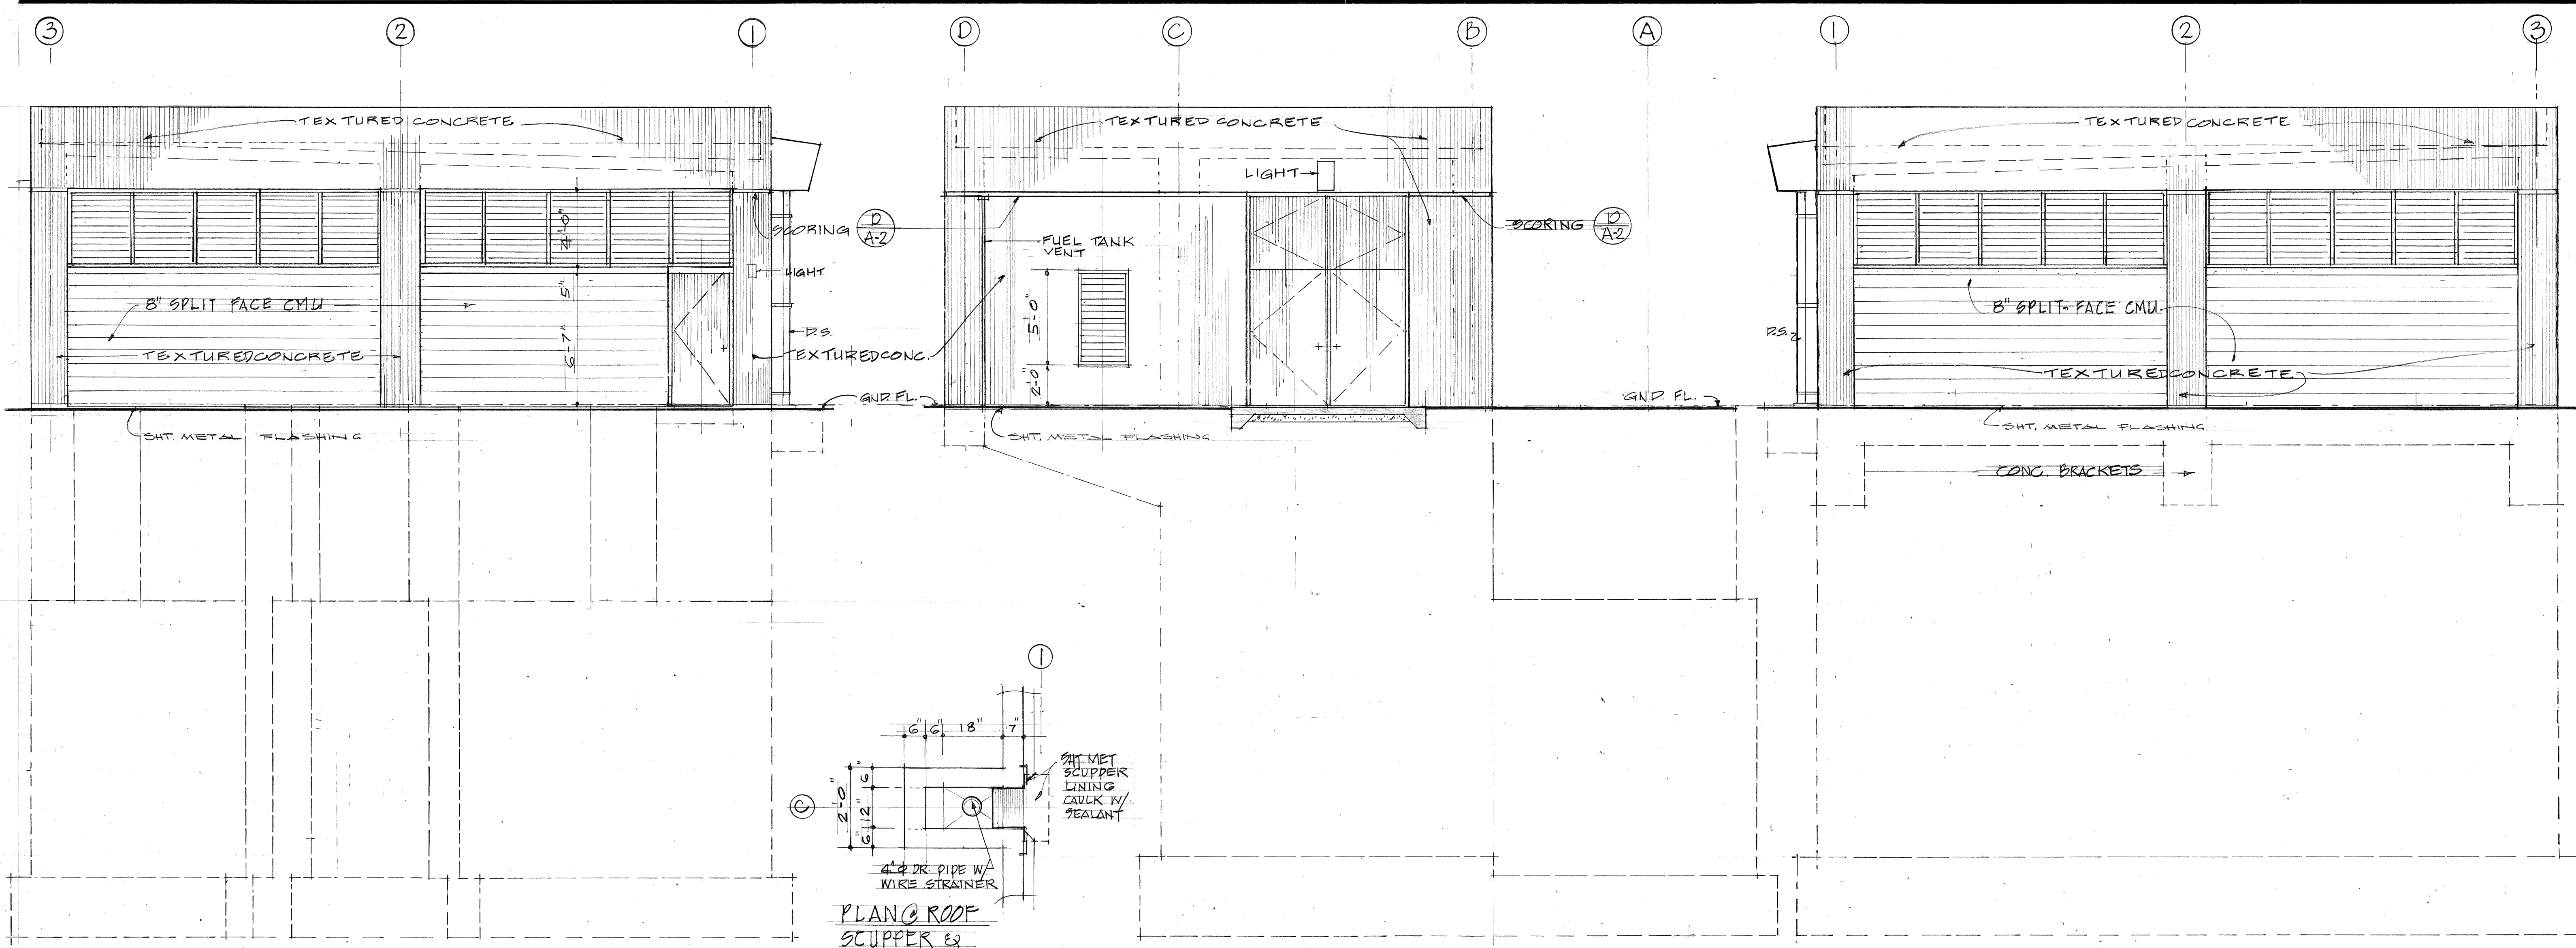

D SCORING DETAIL
SCALE: 3" = 1'-0"

B CAP FLASHING OF MEMBRANE WATERPROOFING
SCALE: 3" = 1'-0"


APPROVED:
6/24/80
DATE

WILSON OKAMOTO & ASSOC.
ENGINEERS - ARCHITECTS - PLANNERS
HONOLULU HAWAII









WALTER LEU
REGISTERED PROFESSIONAL ARCHITECT
No. 2709
HAWAII, U.S.A.

This work was prepared by me or under my supervision.


SYM	DESCRIPTION	DATE	APP'D
REVISIONS STATE OF HAWAII DEPARTMENT OF LAND AND NATURAL RESOURCES DIVISION OF WATER AND LAND DEVELOPMENT SAND ISLAND PARKWAY INCREMENT II, PHASE I & SEWAGE PUMP STATION ELEVATIONS			
DESIGNED: W.L.	SUBMITTED: <i>Walter Leu</i>		
DRAWN: M.K.	DATE: 6/24/80		
CHECKED: W.L.	DATE: 6/24/80		
APPROVED: <i>Robert H. Chumley</i>	FILE NO.		
DATE: 5/1/80	MANAGER - CHIEF ENGINEER		

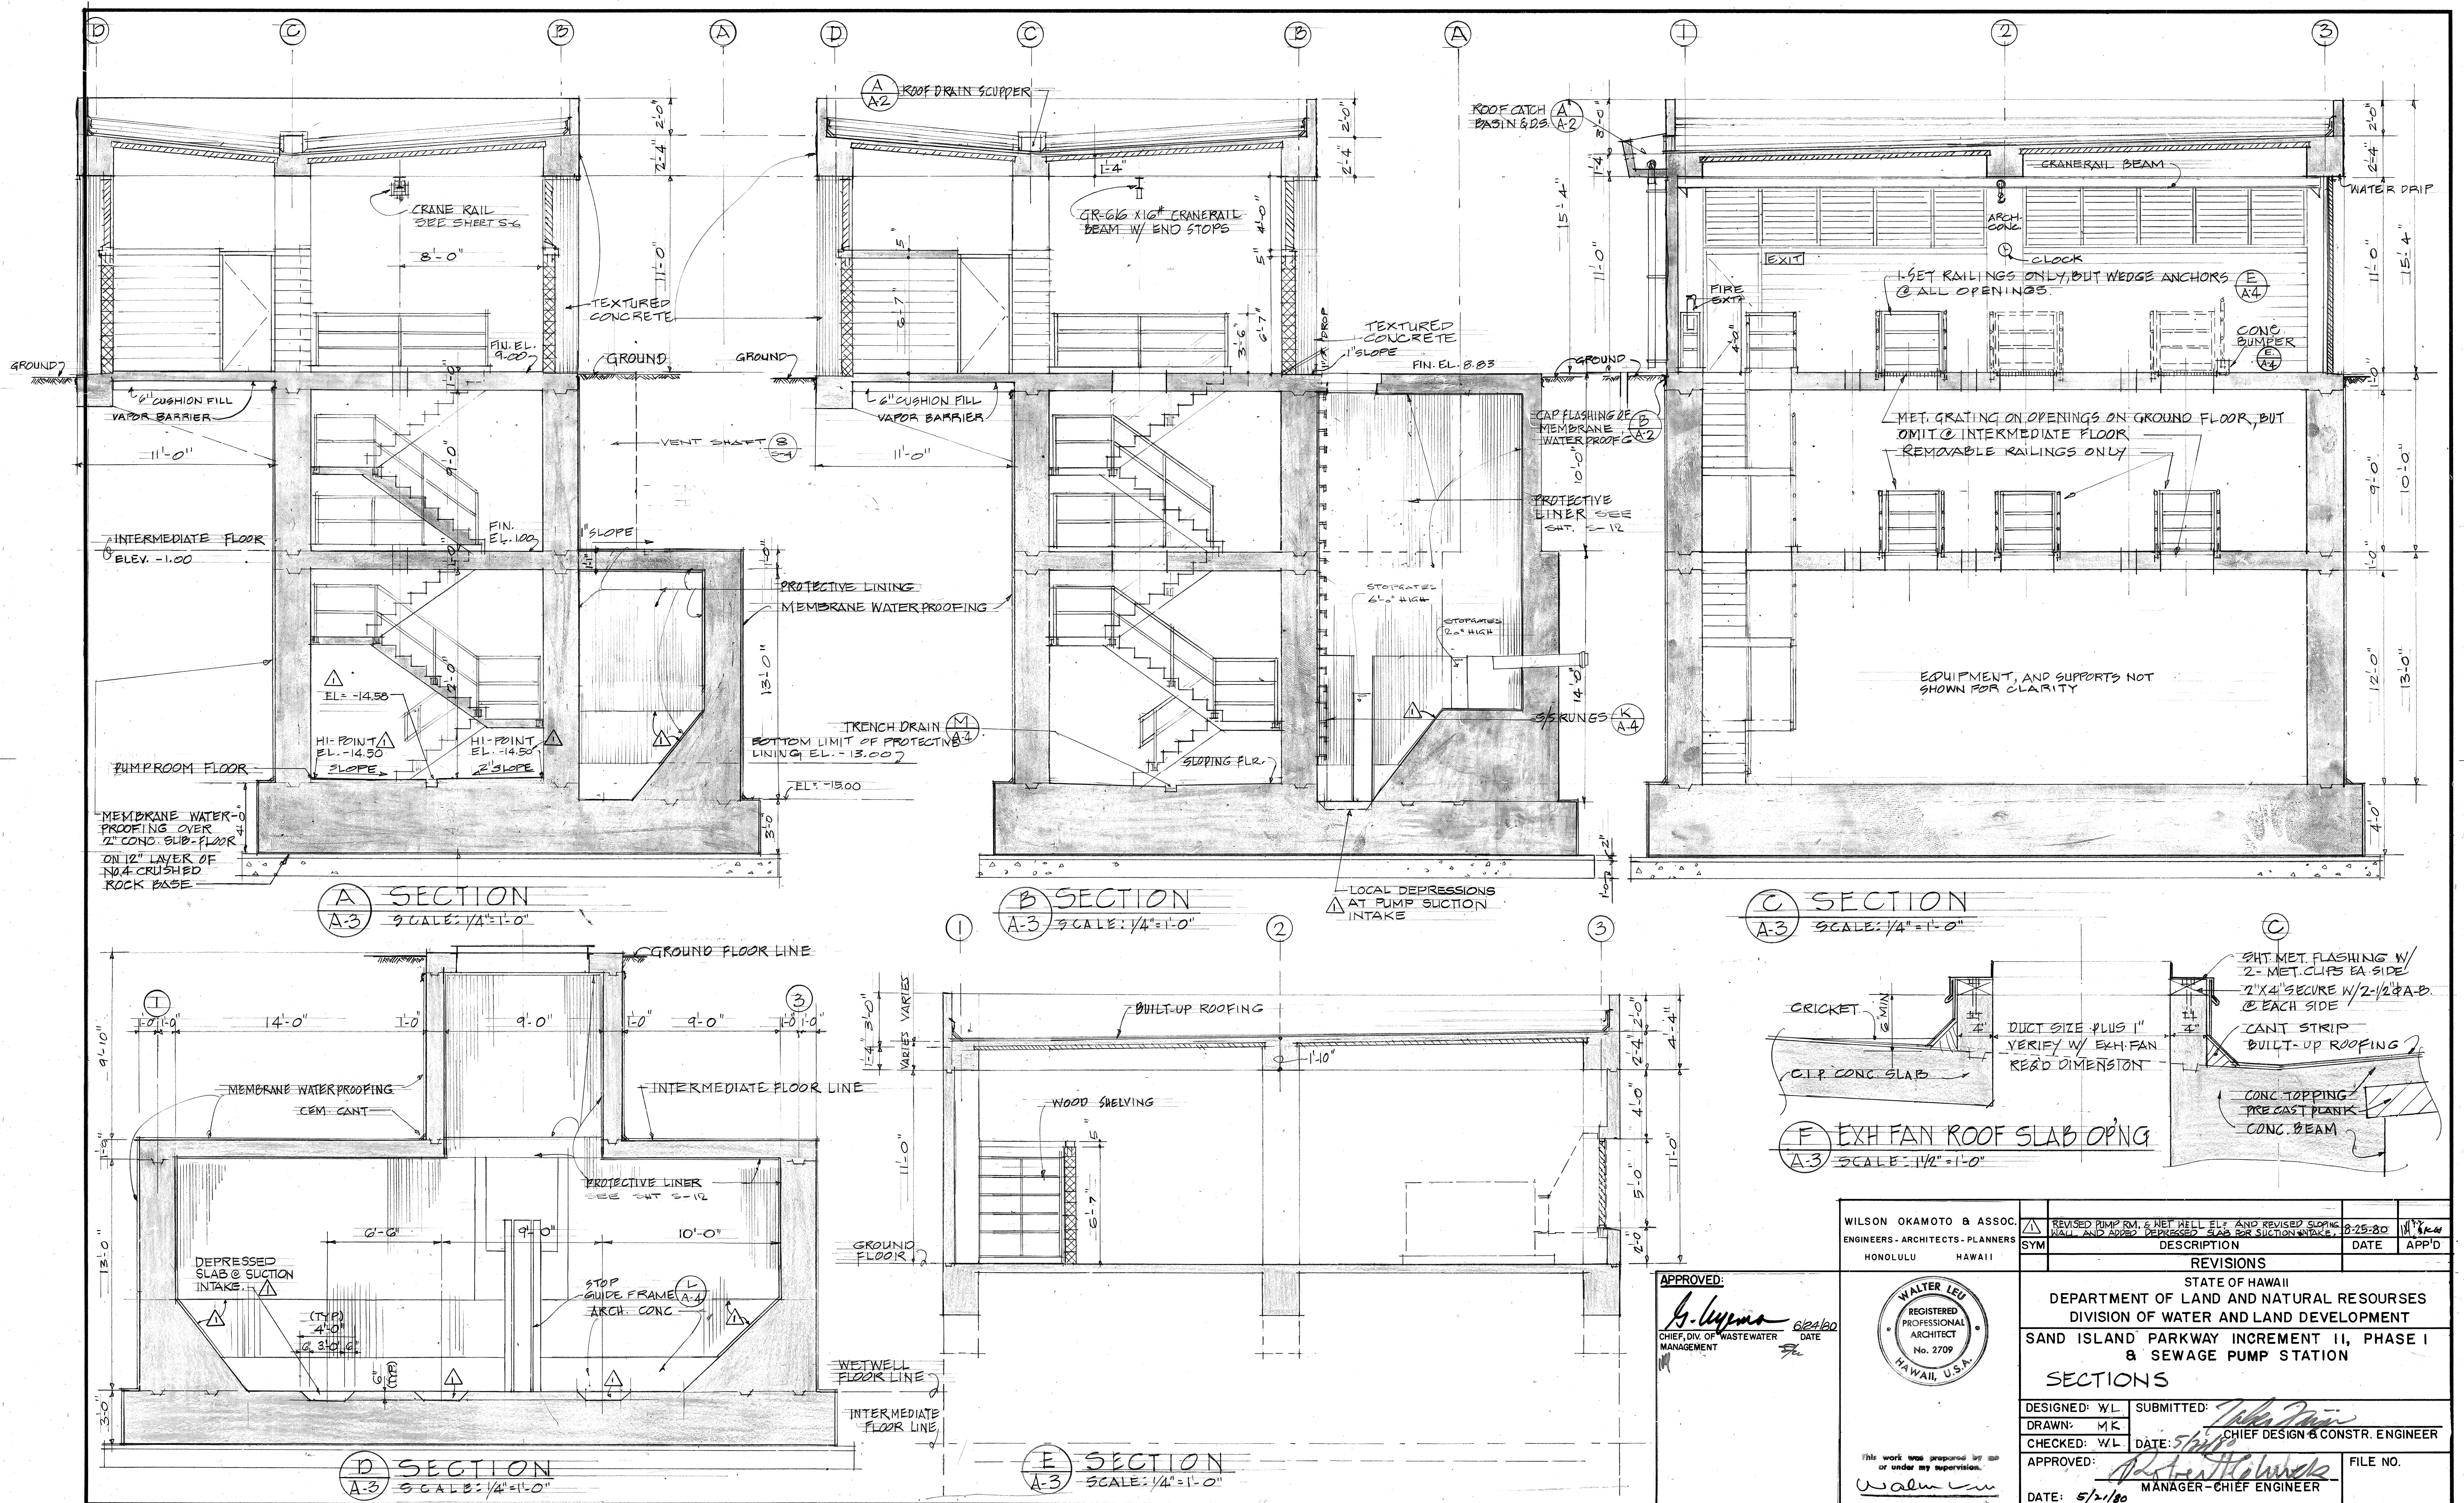

WILSON OKAMOTO & ASSOC. ENGINEERS - ARCHITECTS - PLANNERS HONOLULU HAWAII	REVISIONS STATE OF HAWAII DEPARTMENT OF LAND AND NATURAL RESOURCES DIVISION OF WATER AND LAND DEVELOPMENT SAND ISLAND PARKWAY INCREMENT II, PHASE I & SEWAGE PUMP STATION SECTIONS	REVISED PUMP RM. & MET WELL EL. AND REVISED SLOPING WALL AND ADDED DEPRESSIONED SLAB FOR SUCTION INTAKE. 8-25-80 DATE APP'D	WALTER LEU REGISTERED PROFESSIONAL ARCHITECT No. 2709 HAWAII, U.S.A.
APPROVED: <i>K. Uyama</i> CHIEF, DIV. OF WASTEWATER MANAGEMENT DATE 6/24/80	DESIGNED: W.L. DRAWN: M.K. CHECKED: W.L. APPROVED: <i>Robert Holmbeck</i> MANAGER - CHIEF ENGINEER DATE: 5/21/80	SUBMITTED: <i>John J. ...</i> CHIEF DESIGN & CONSTR. ENGINEER	FILE NO.

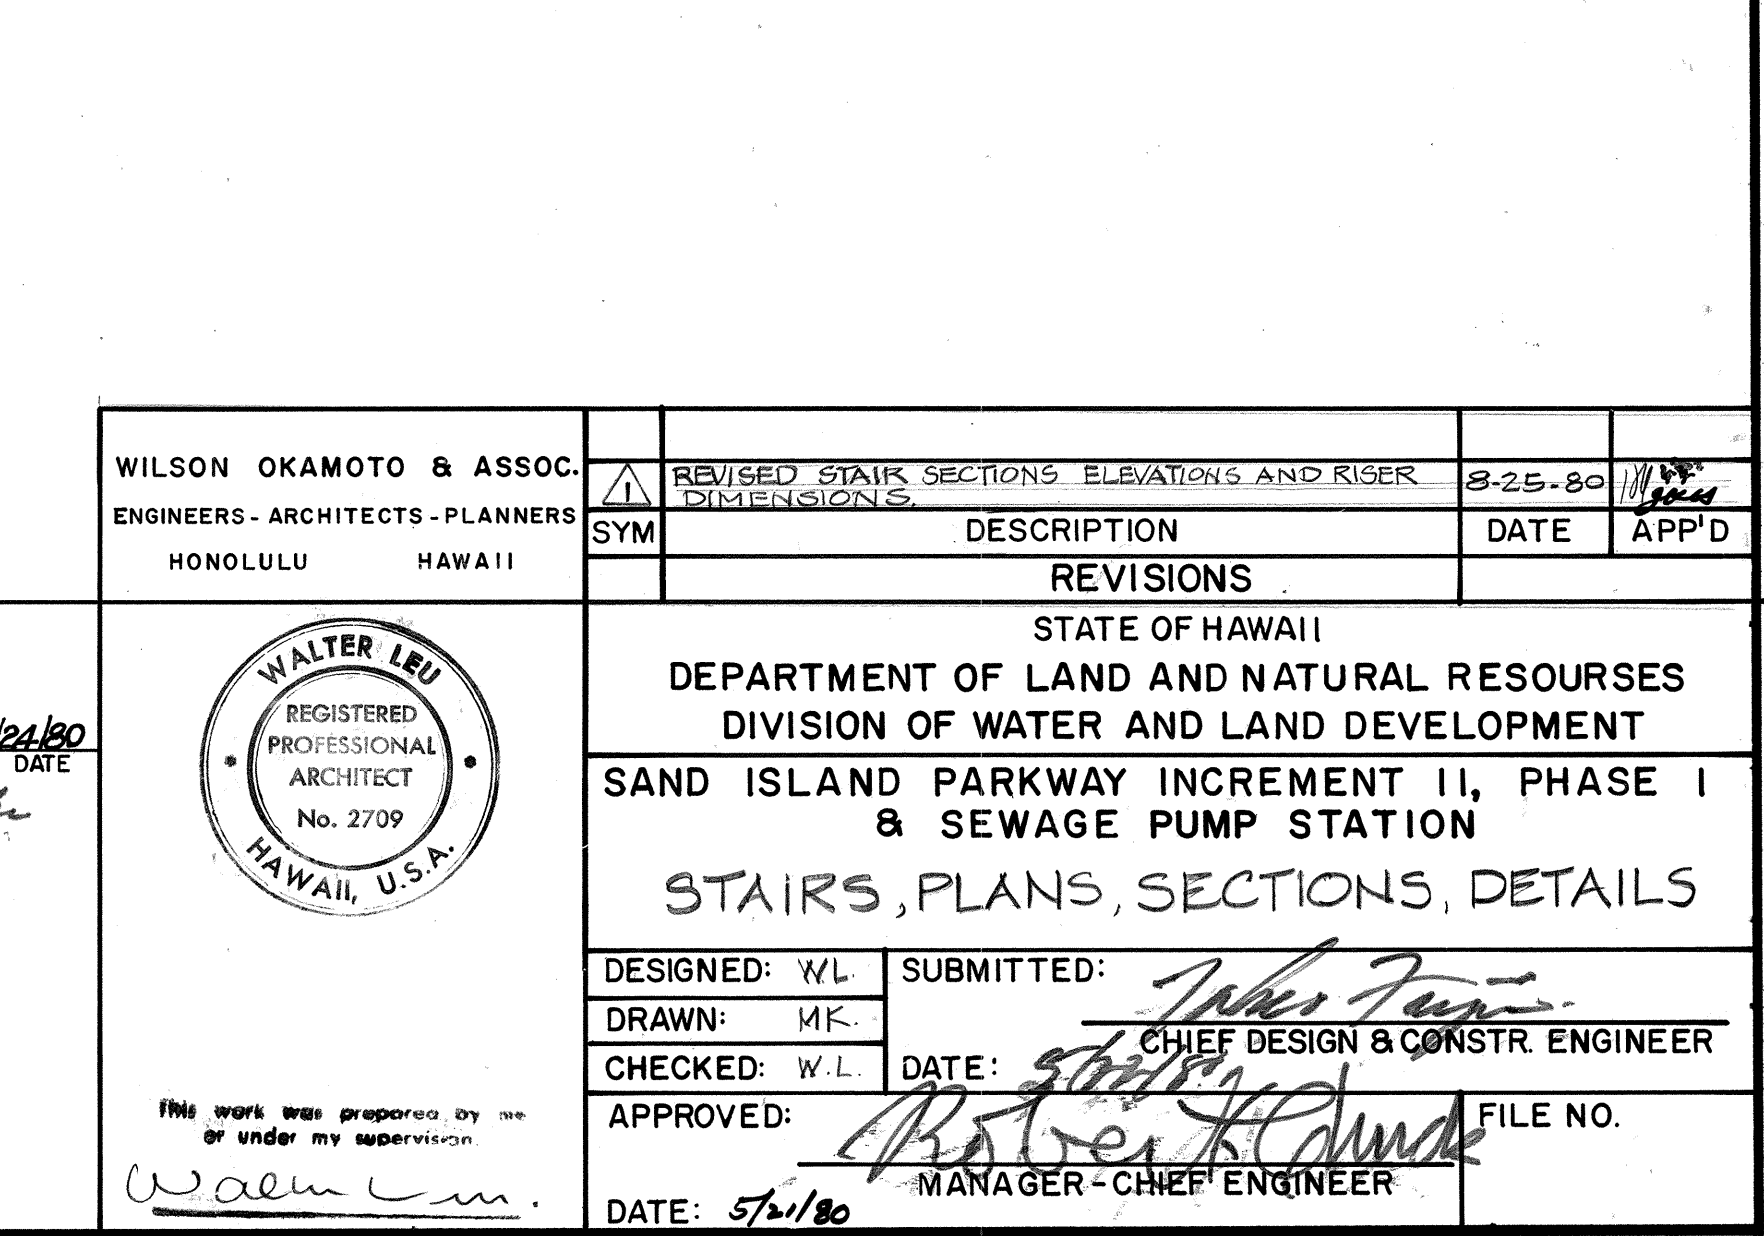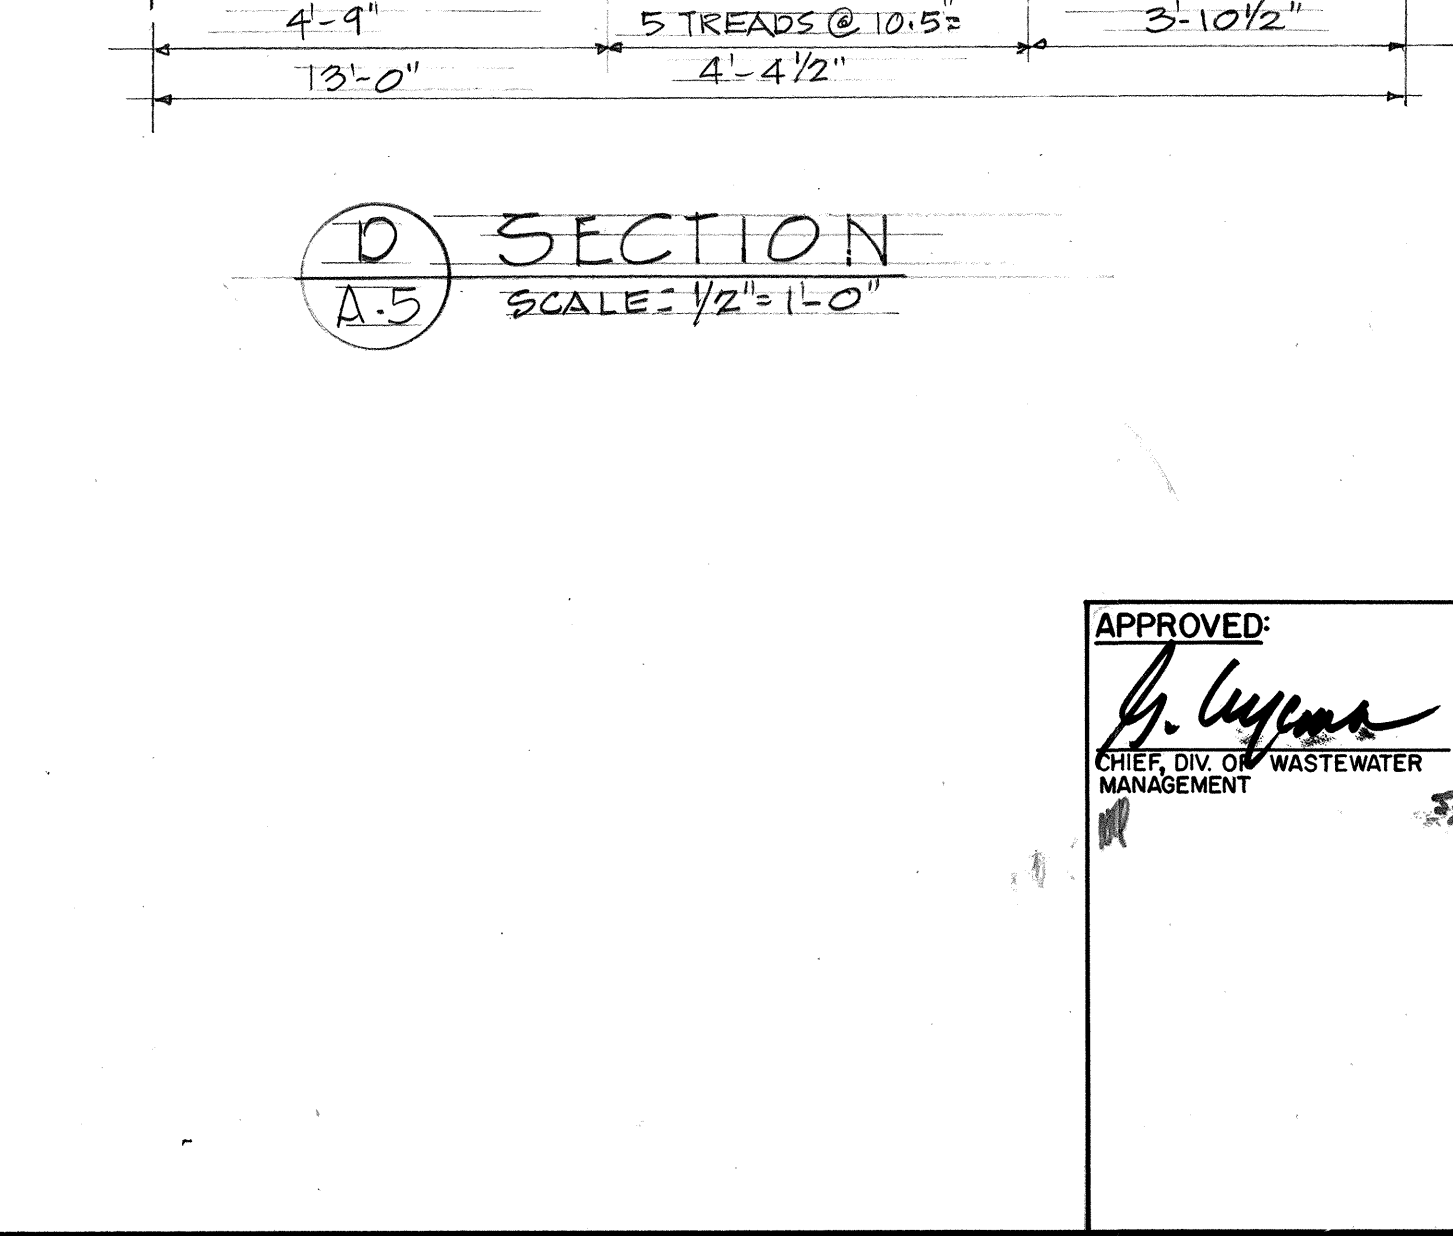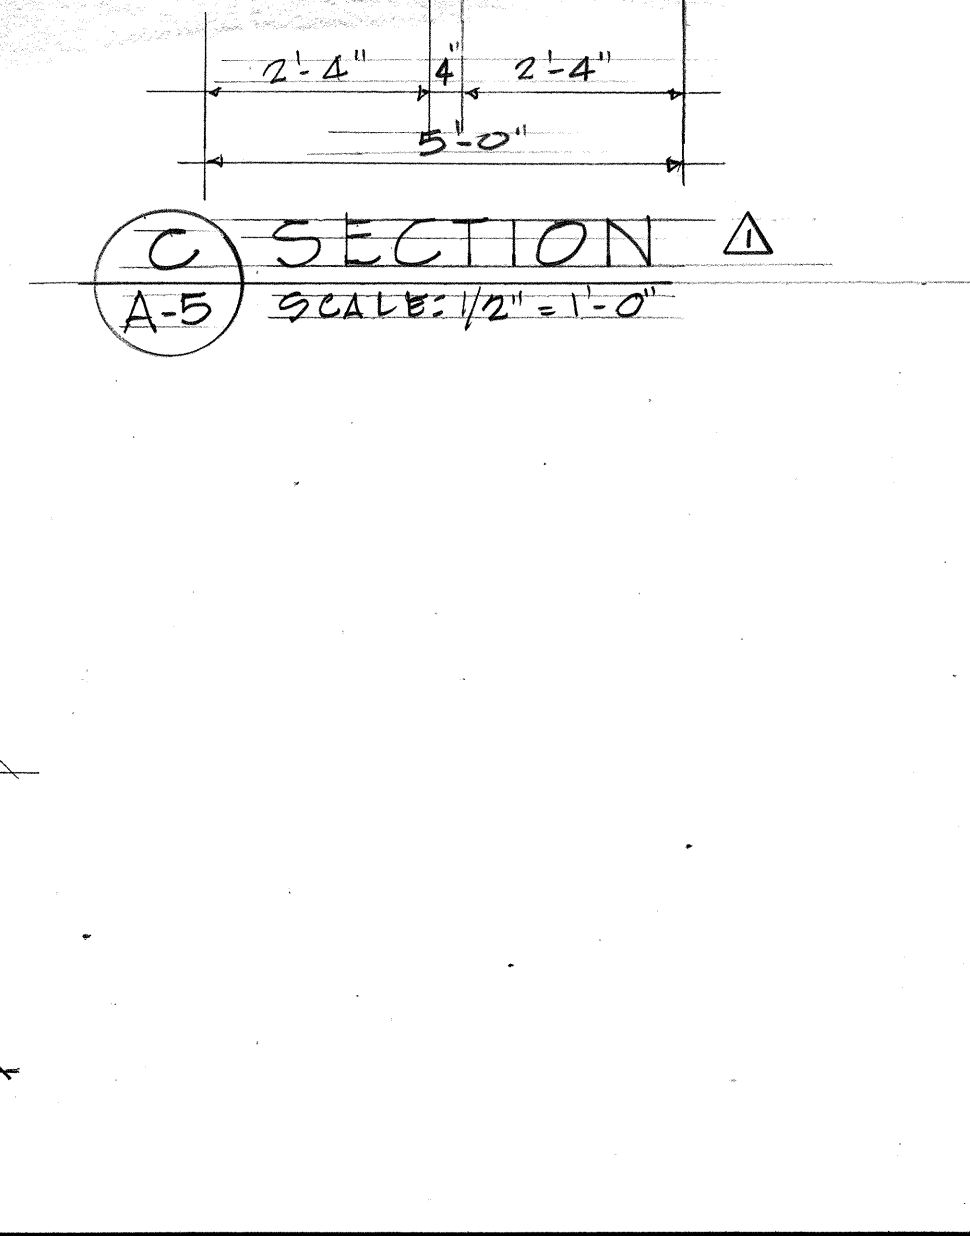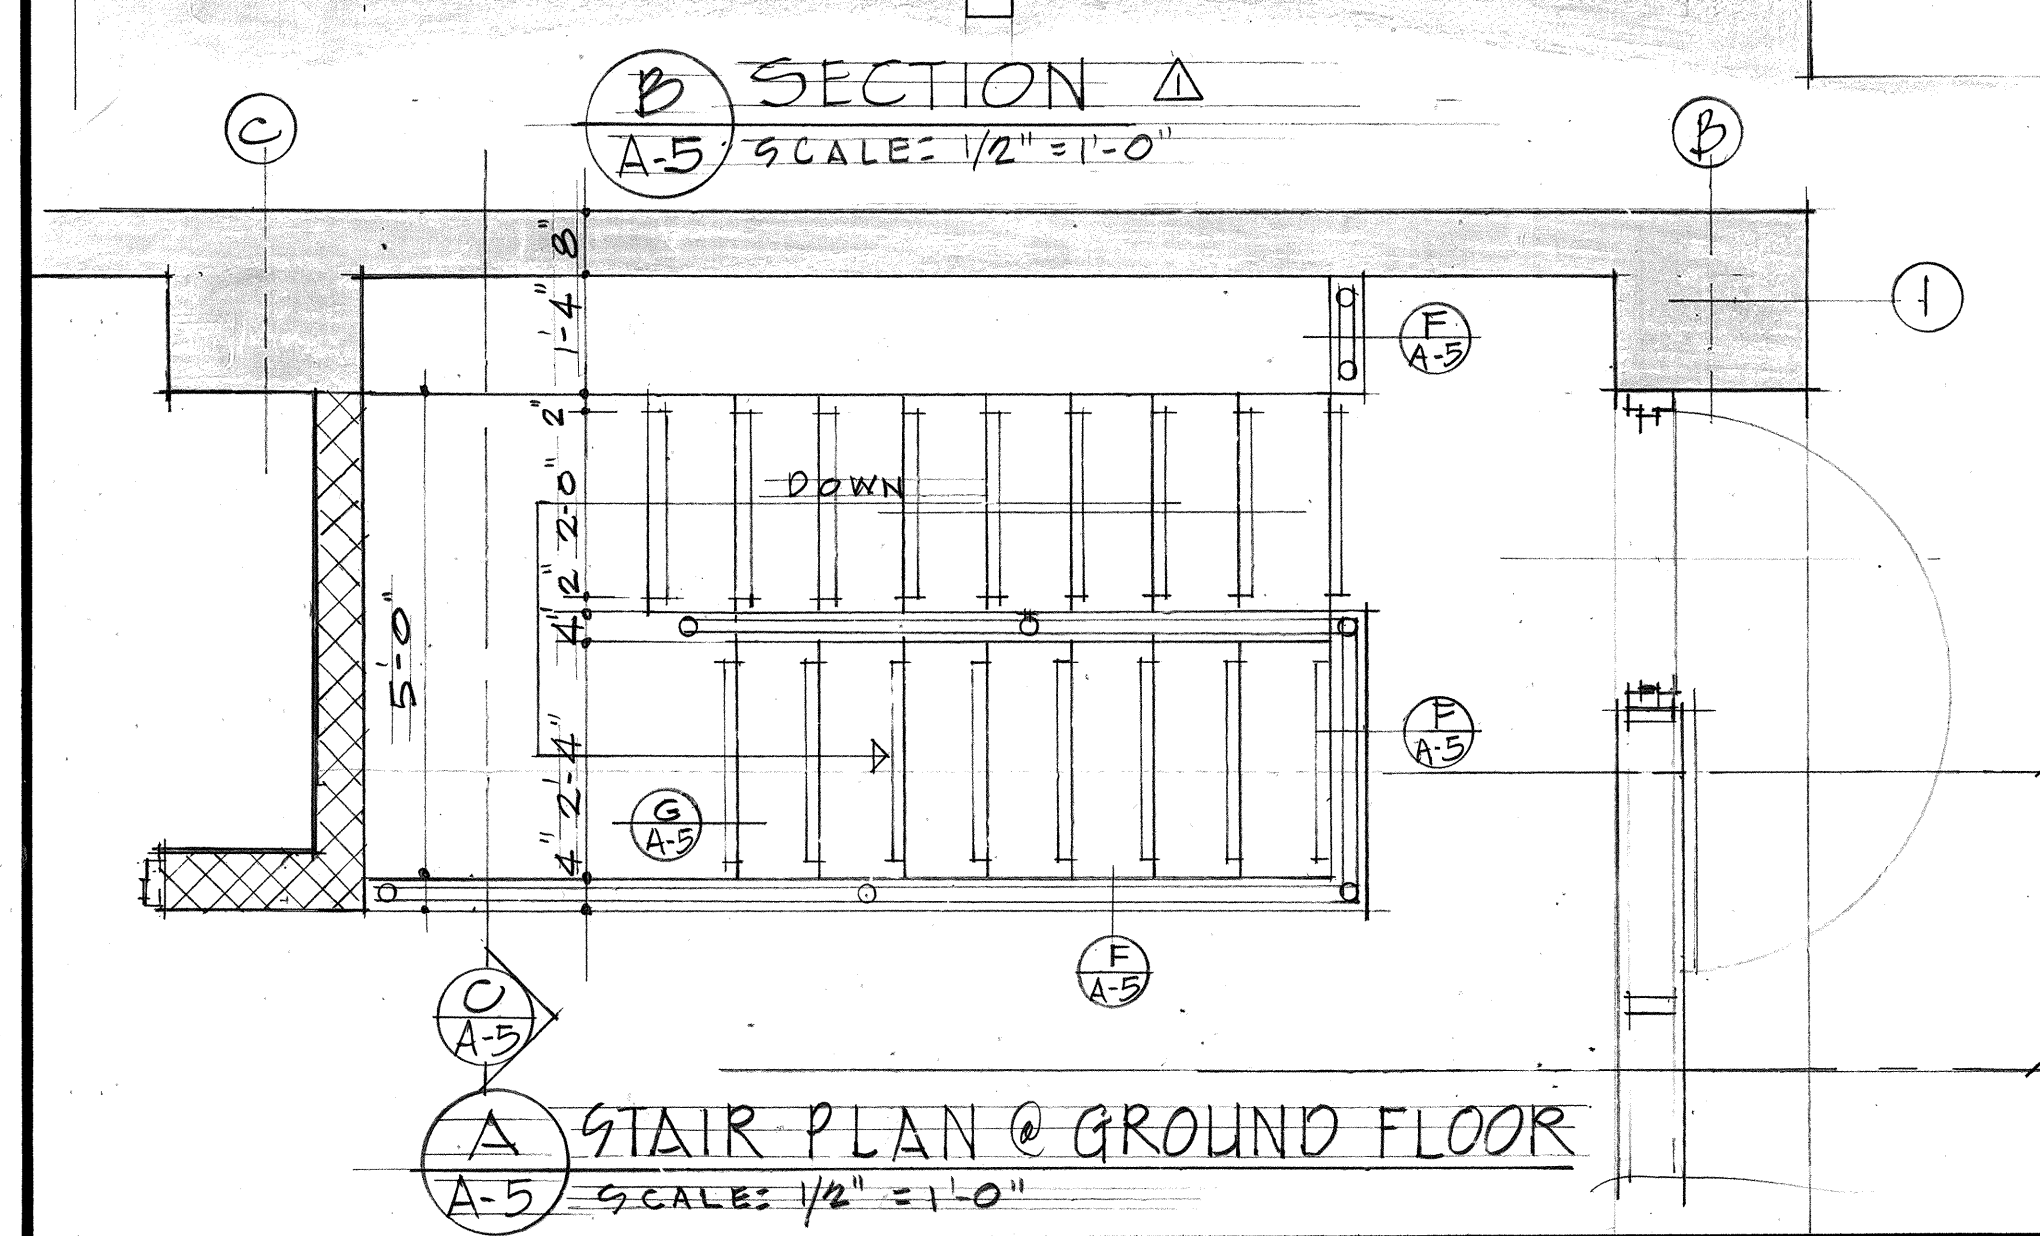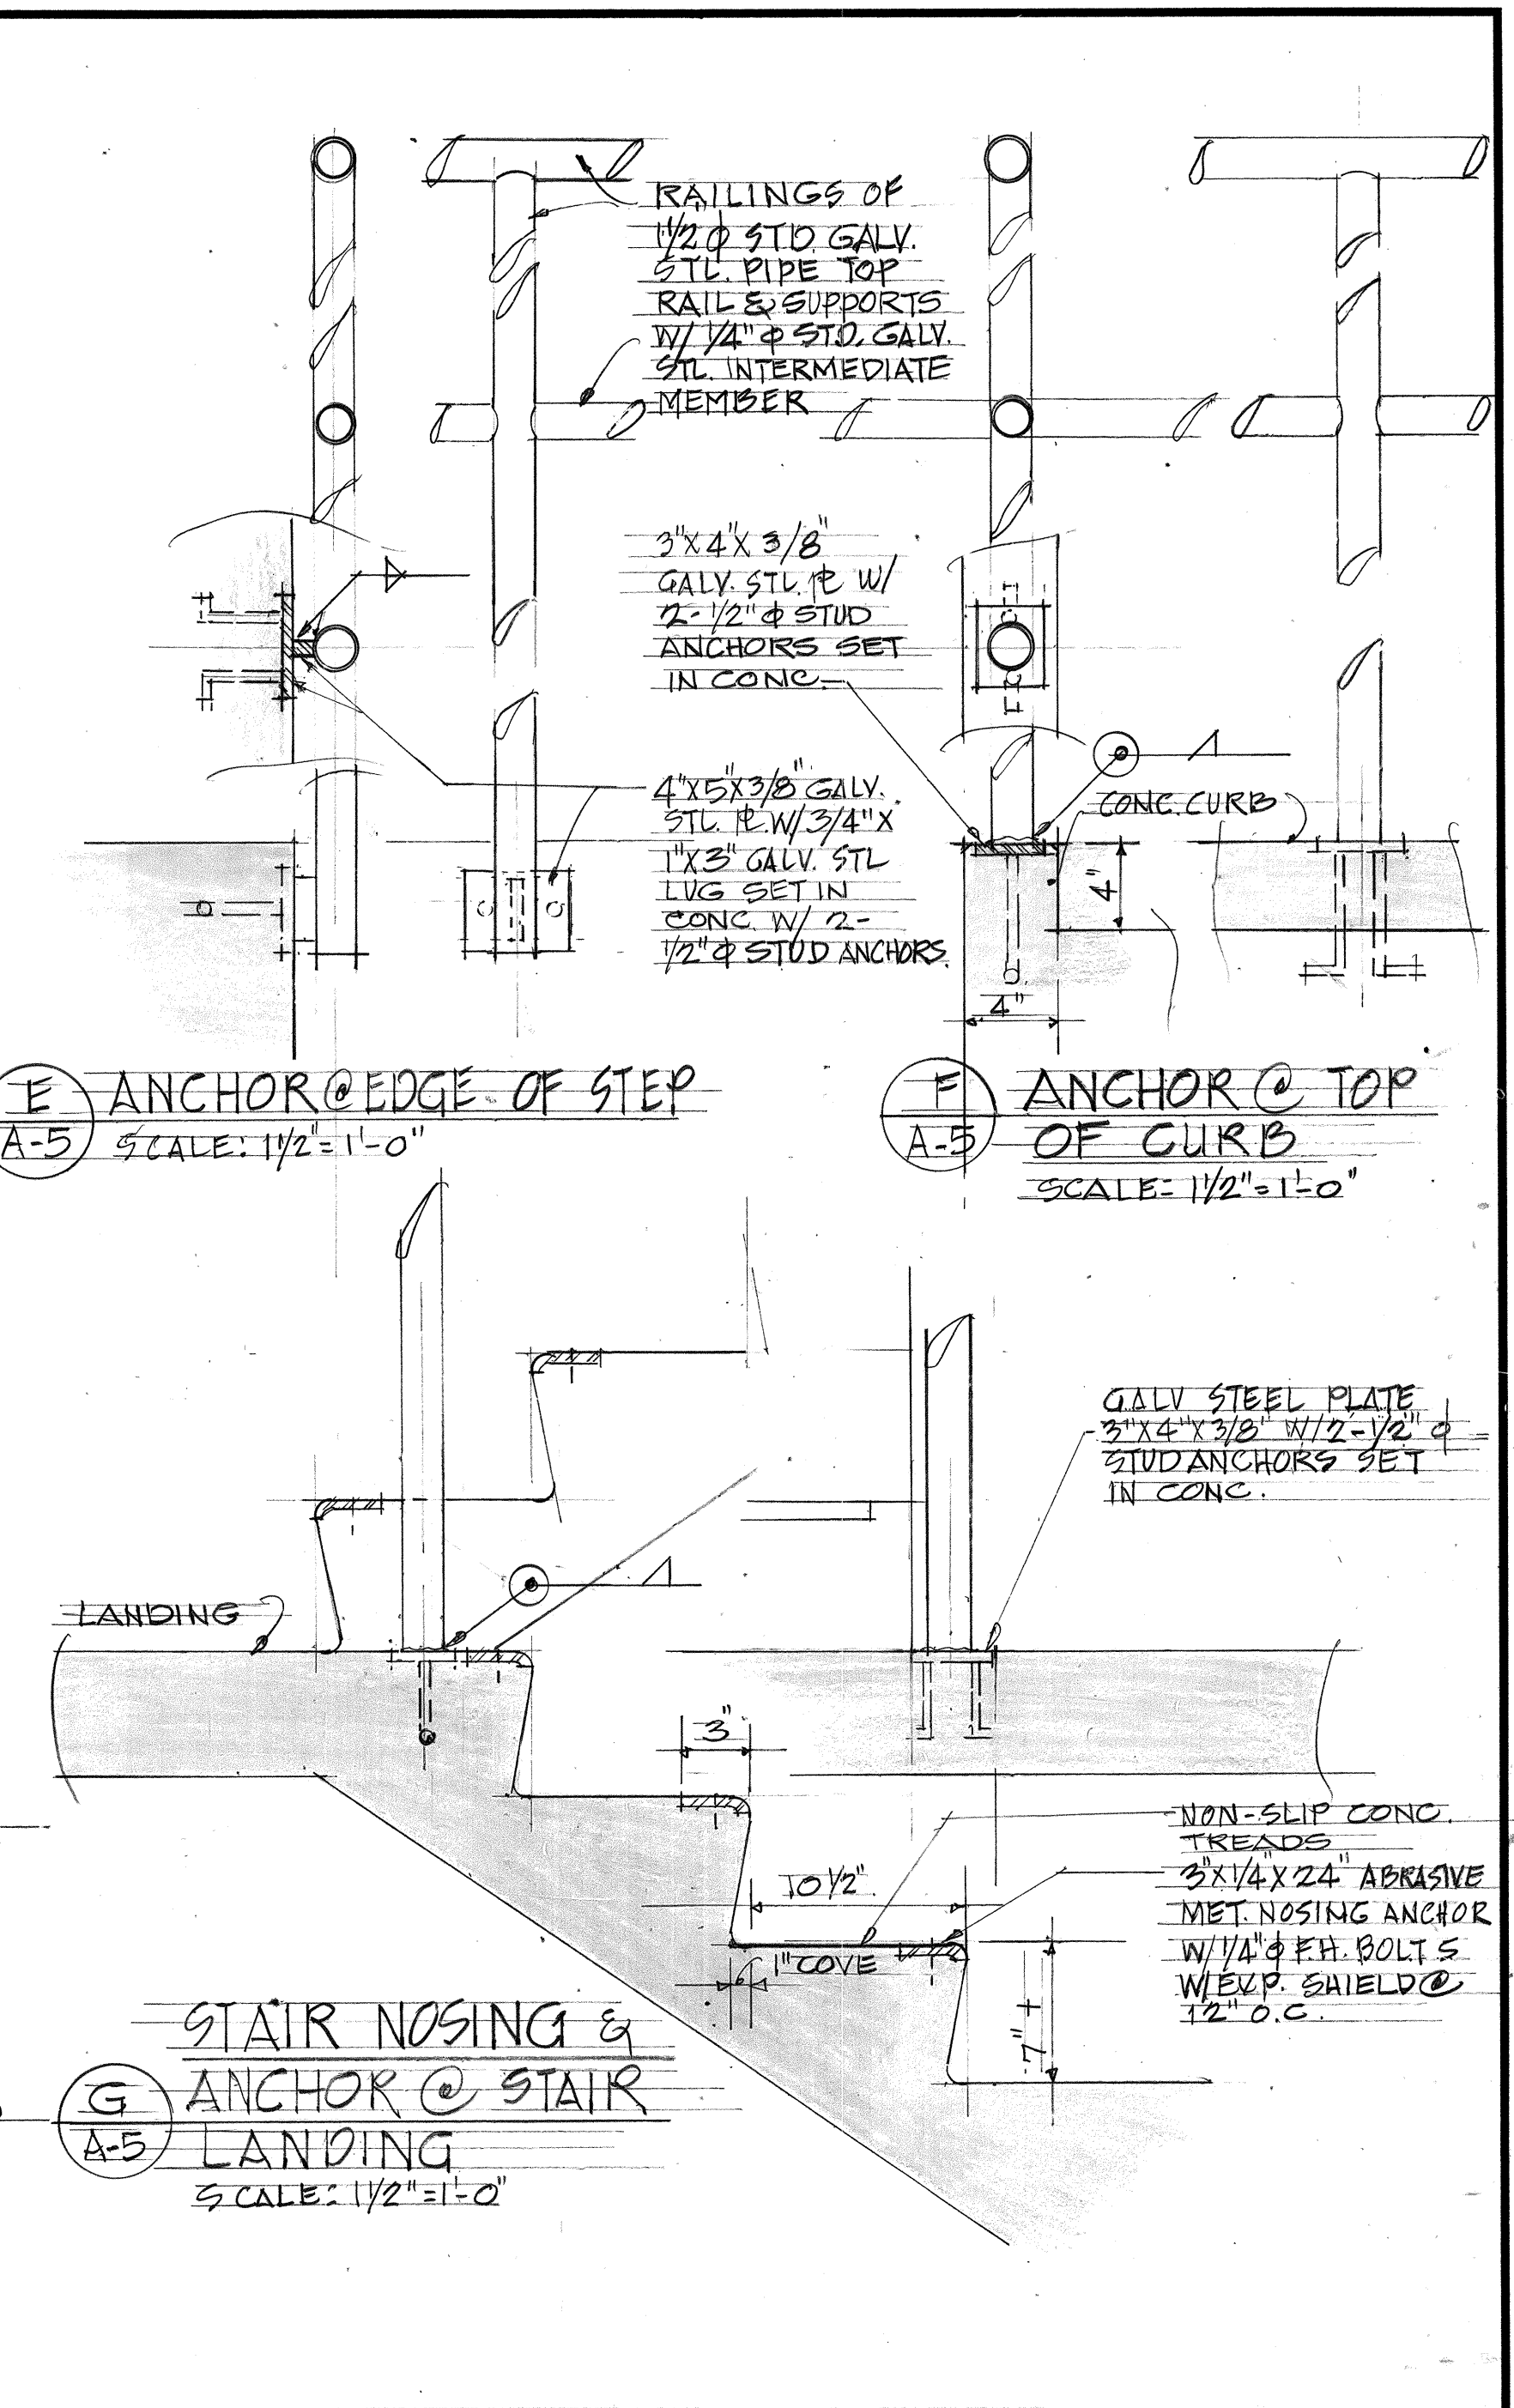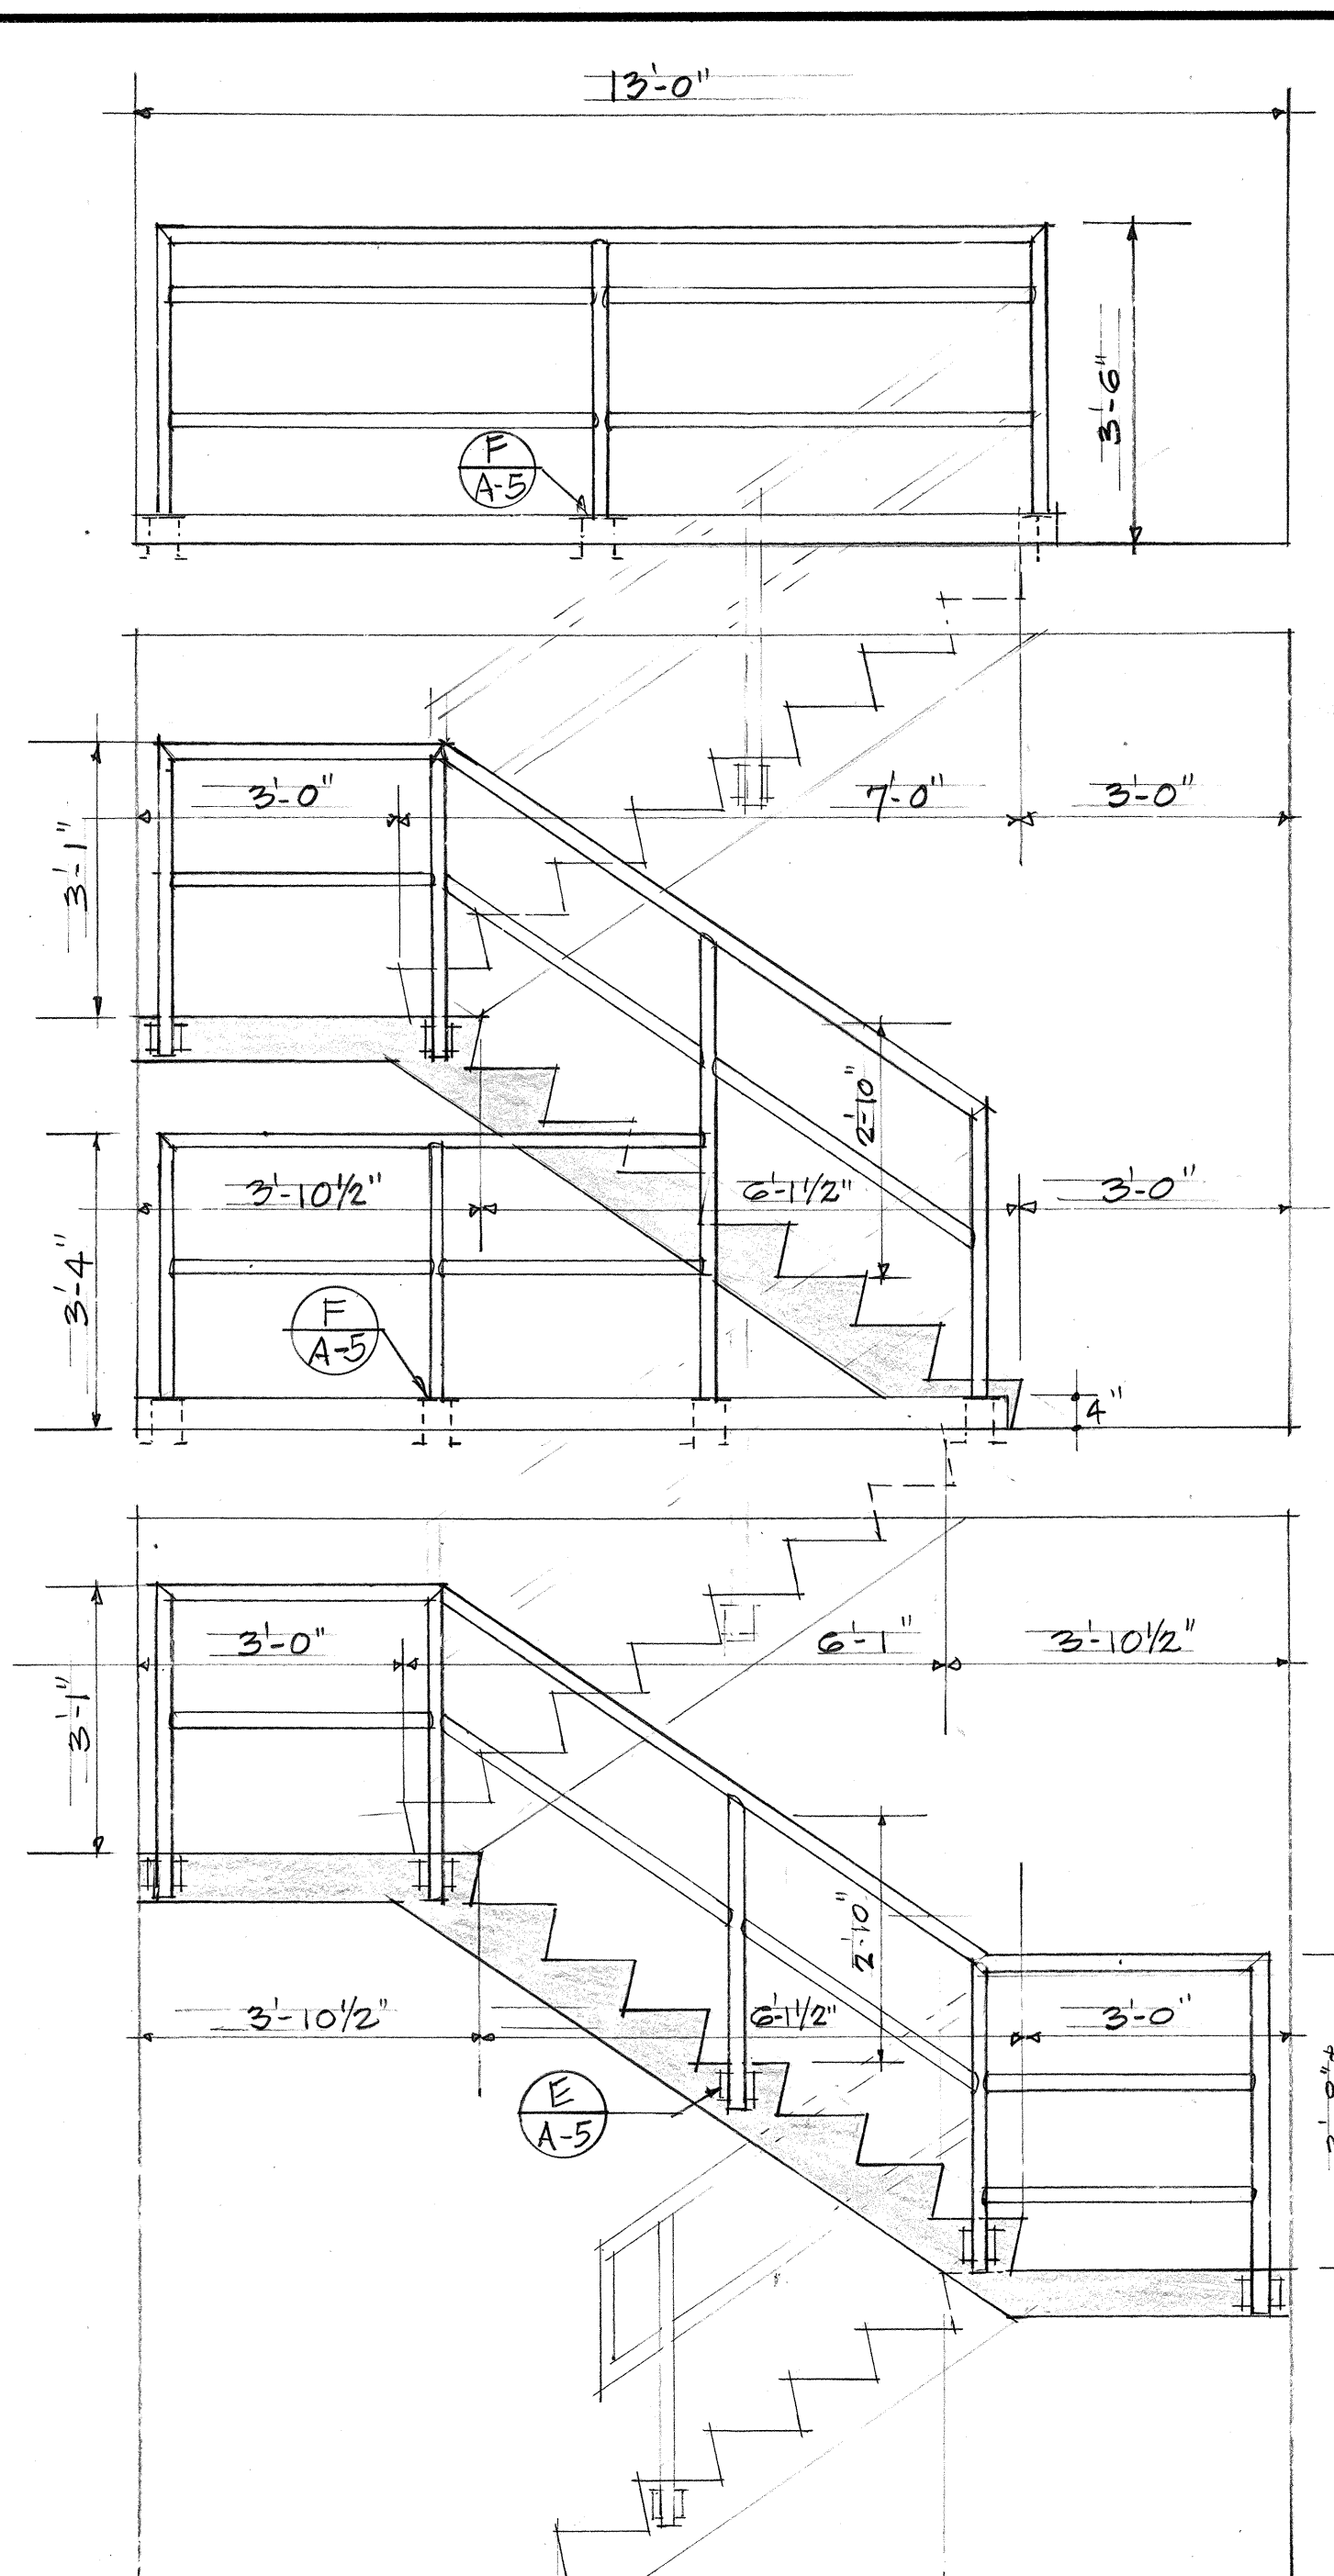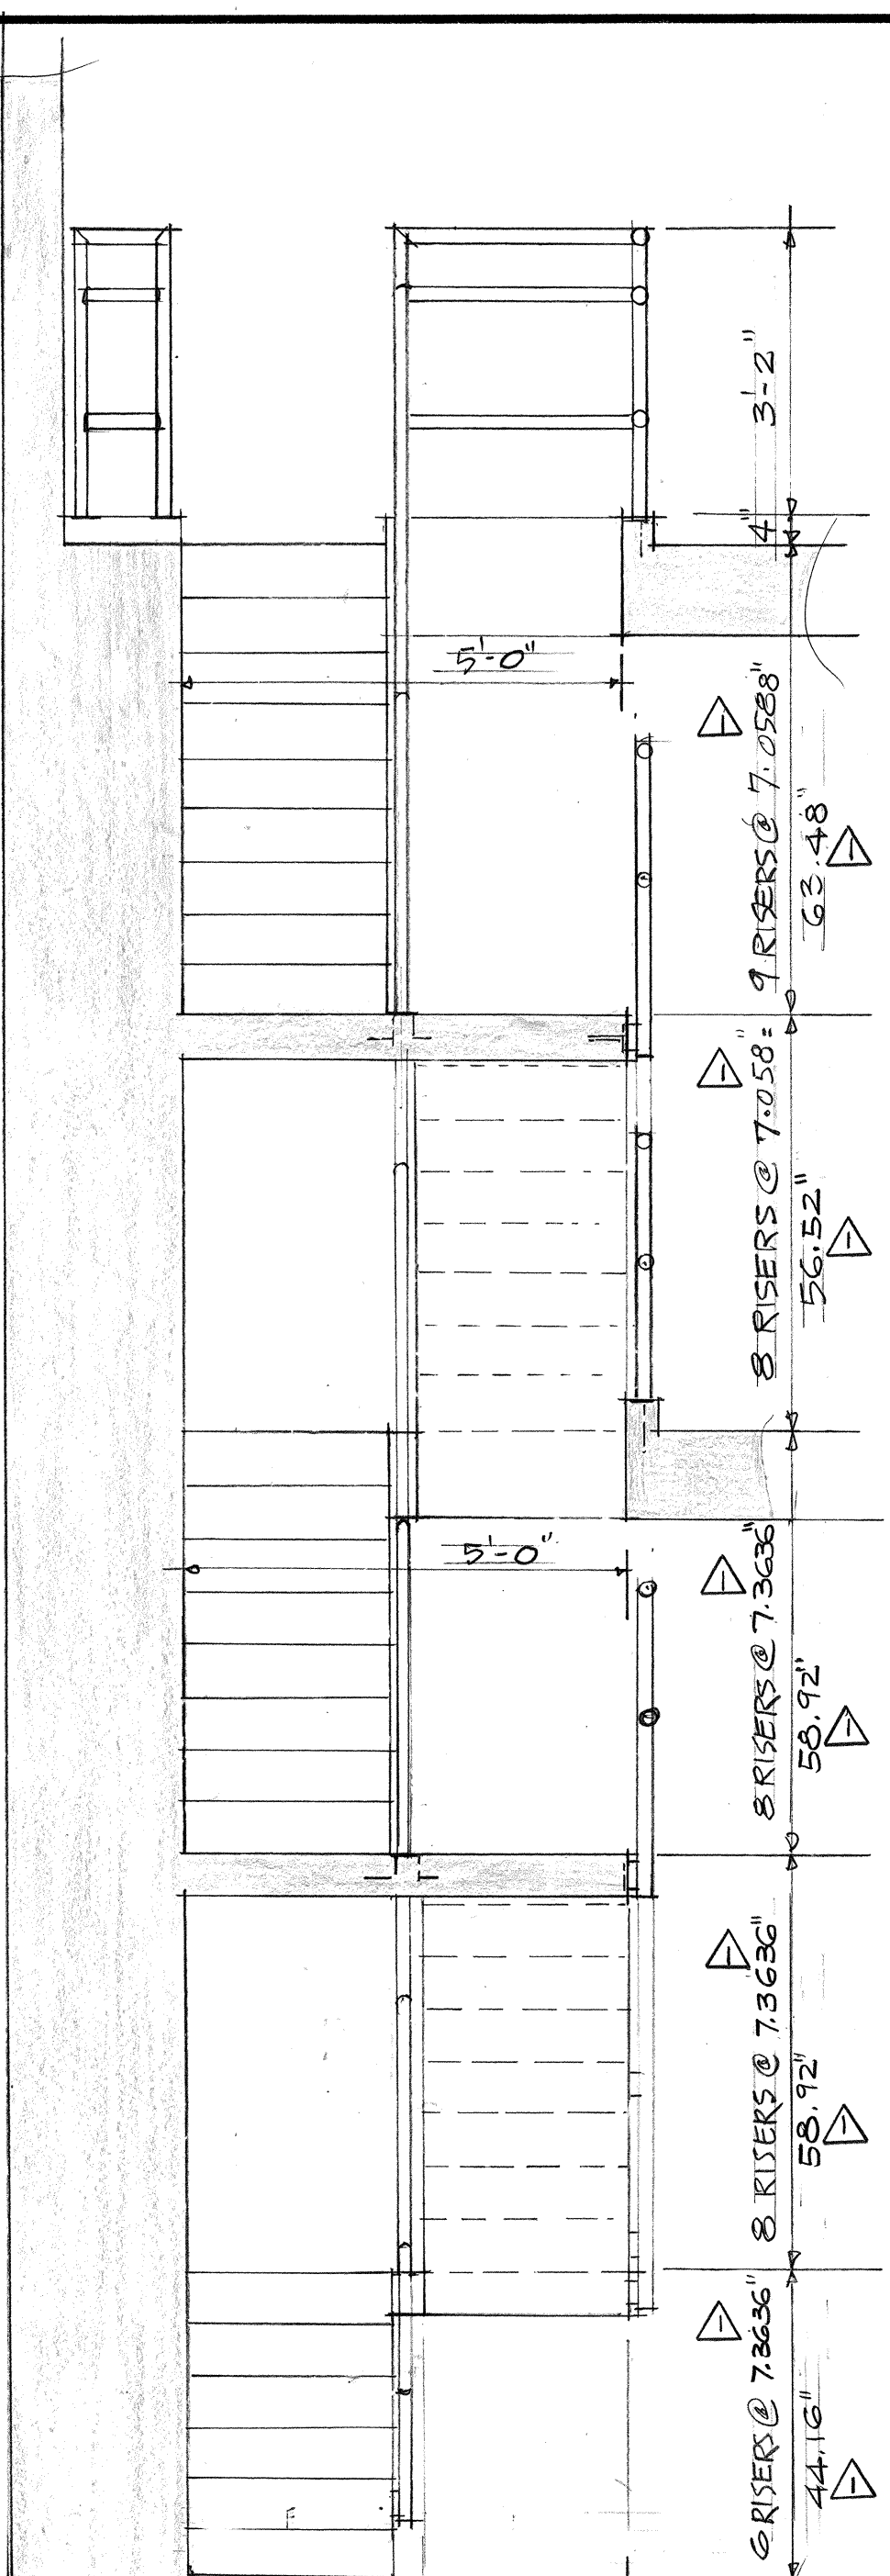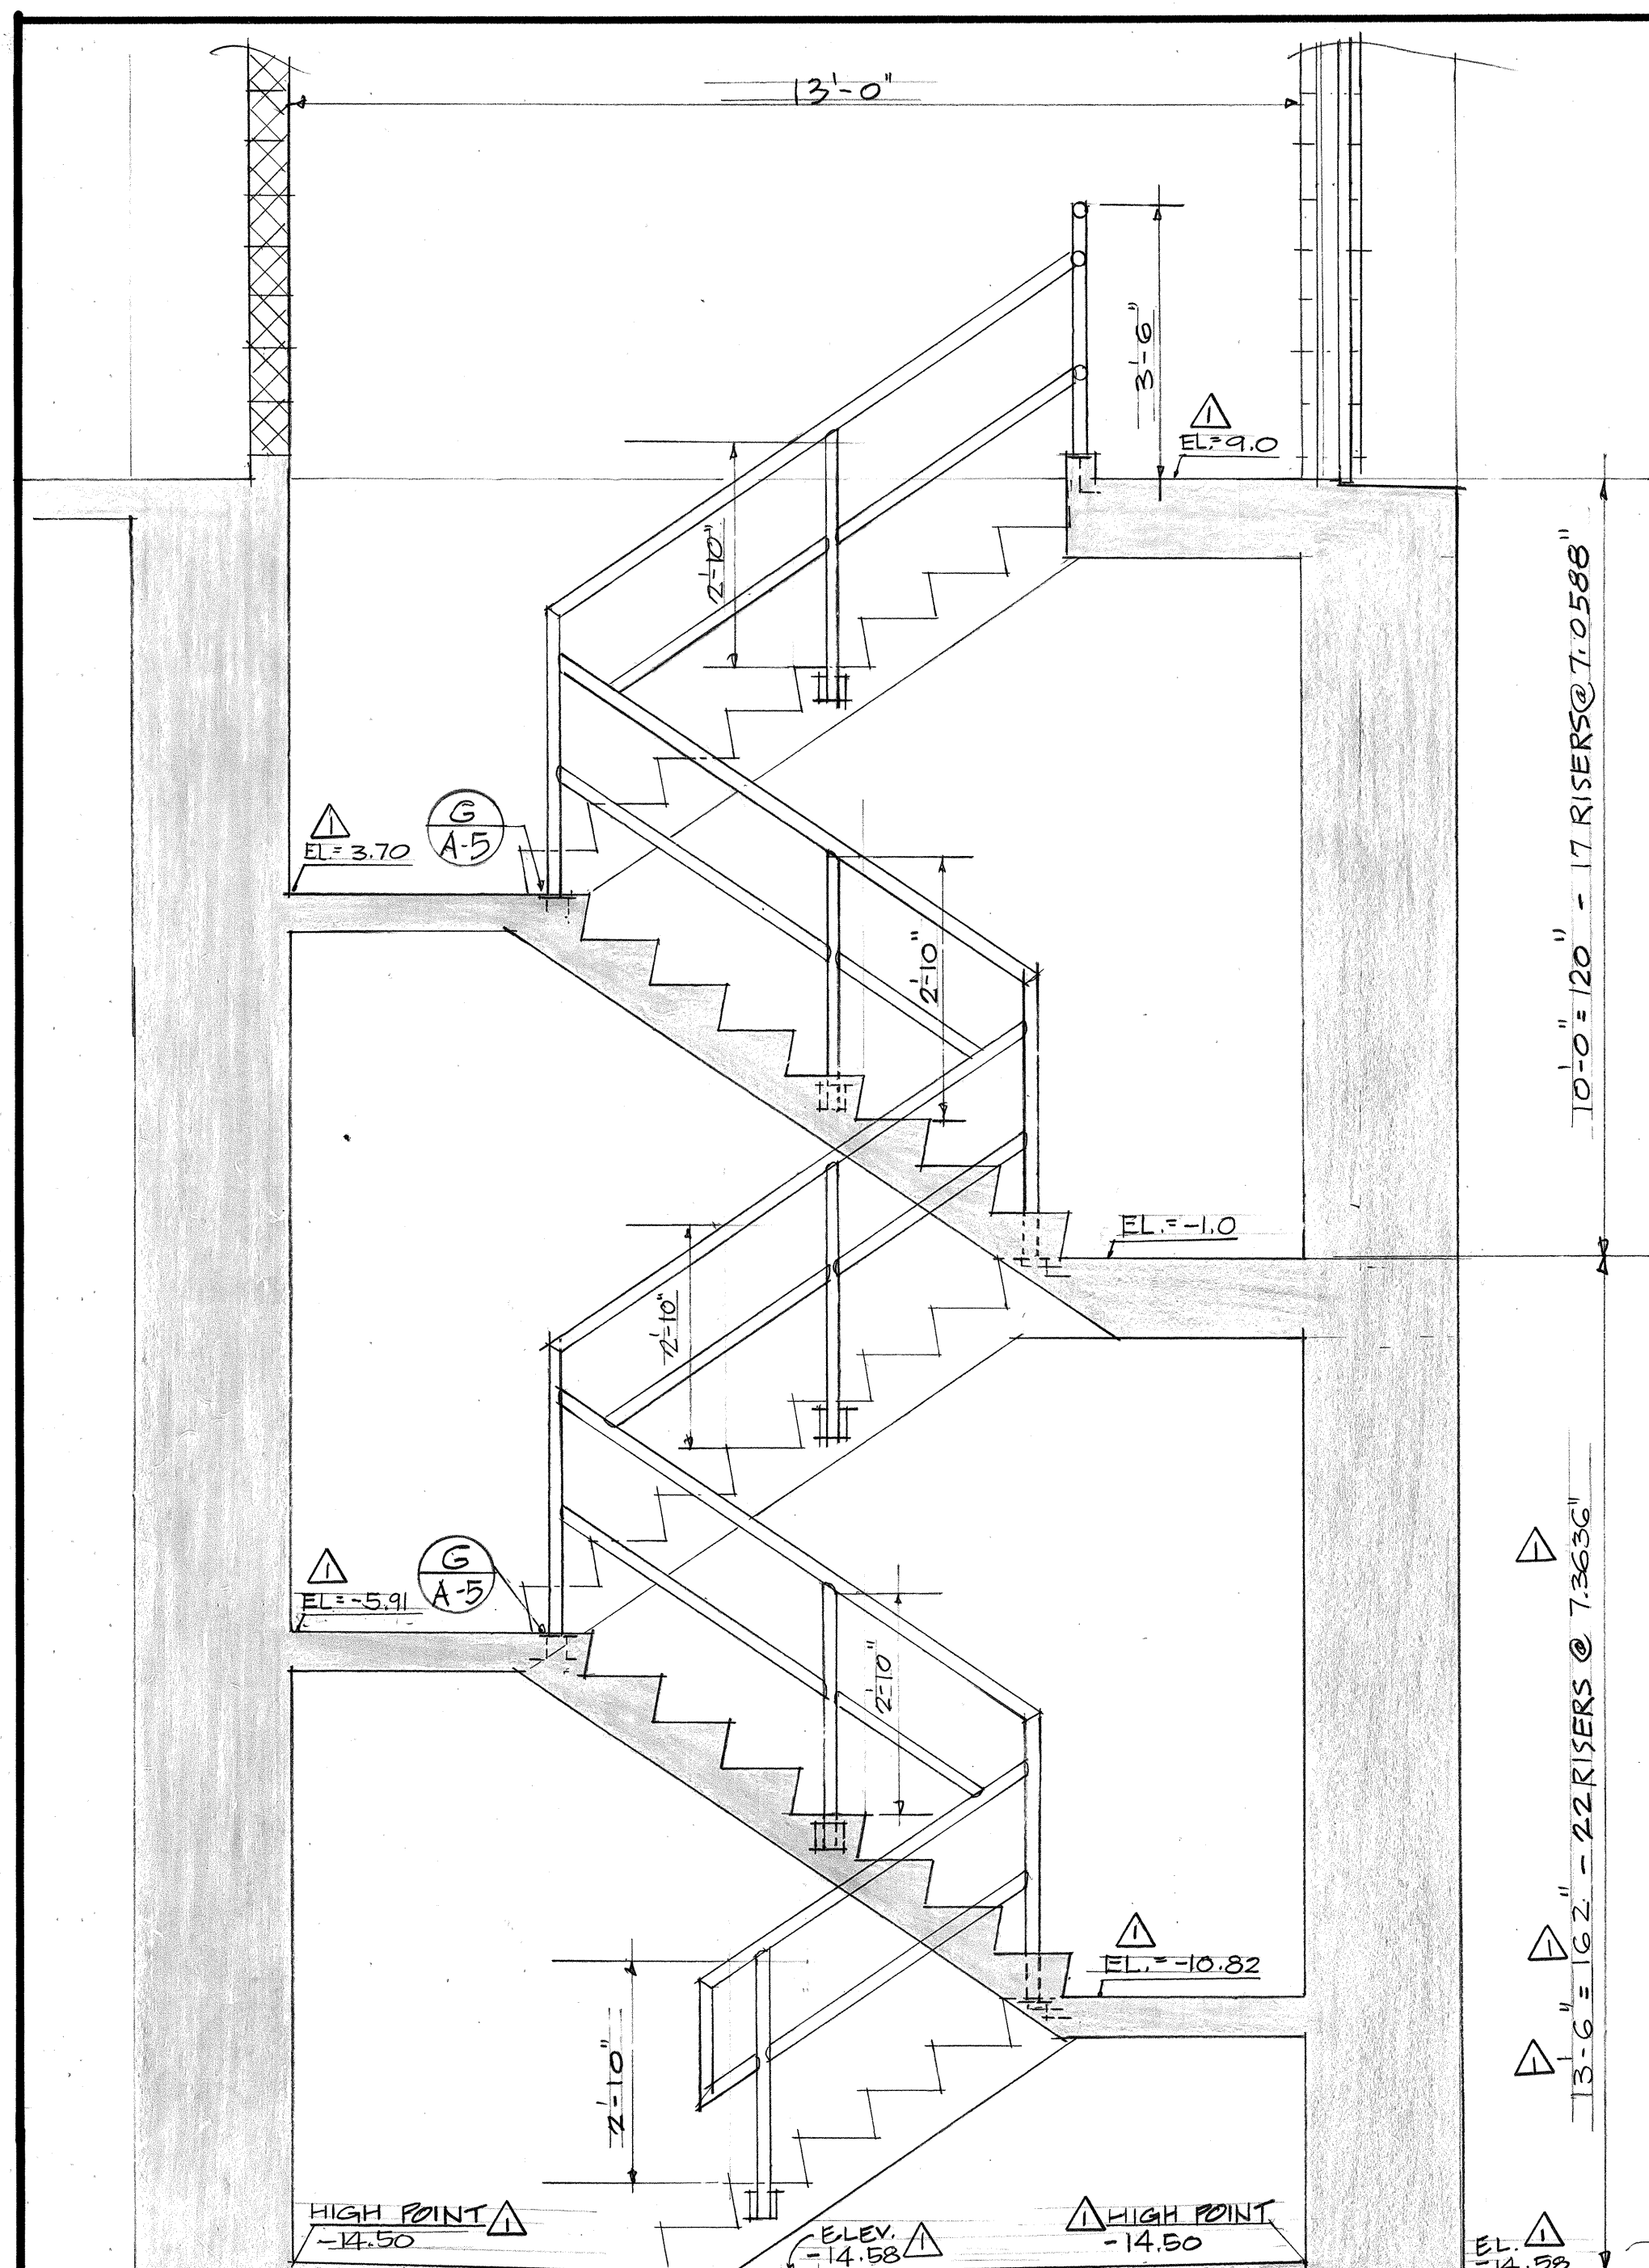


WILSON OKAMOTO & ASSOC. ENGINEERS - ARCHITECTS - PLANNERS HONOLULU HAWAII		SYMBOL REVISED STAIR SECTIONS ELEVATIONS AND RISER DIMENSIONS DESCRIPTION 8-25-80 DATE APP'D	
		REVISIONS	
02/10/80 DATE WALTER LEU REGISTERED PROFESSIONAL ARCHITECT No. 2709 HAWAII, U.S.A. this work was prepared by me or under my supervision. Walter Leu		STATE OF HAWAII	
		DEPARTMENT OF LAND AND NATURAL RESOURCES	
		DIVISION OF WATER AND LAND DEVELOPMENT	
		SAND ISLAND PARKWAY INCREMENT II, PHASE I & SEWAGE PUMP STATION	
		STAIRS, PLANS, SECTIONS, DETAILS	
		DESIGNED: W.L.	SUBMITTED:
		DRAWN: M.K.	CHIEF DESIGN & CONSTR. ENGINEER
CHECKED: W.L.	DATE:		
APPROVED:	FILE NO.		
DATE: 5/1/80	MANAGER - CHIEF ENGINEER		

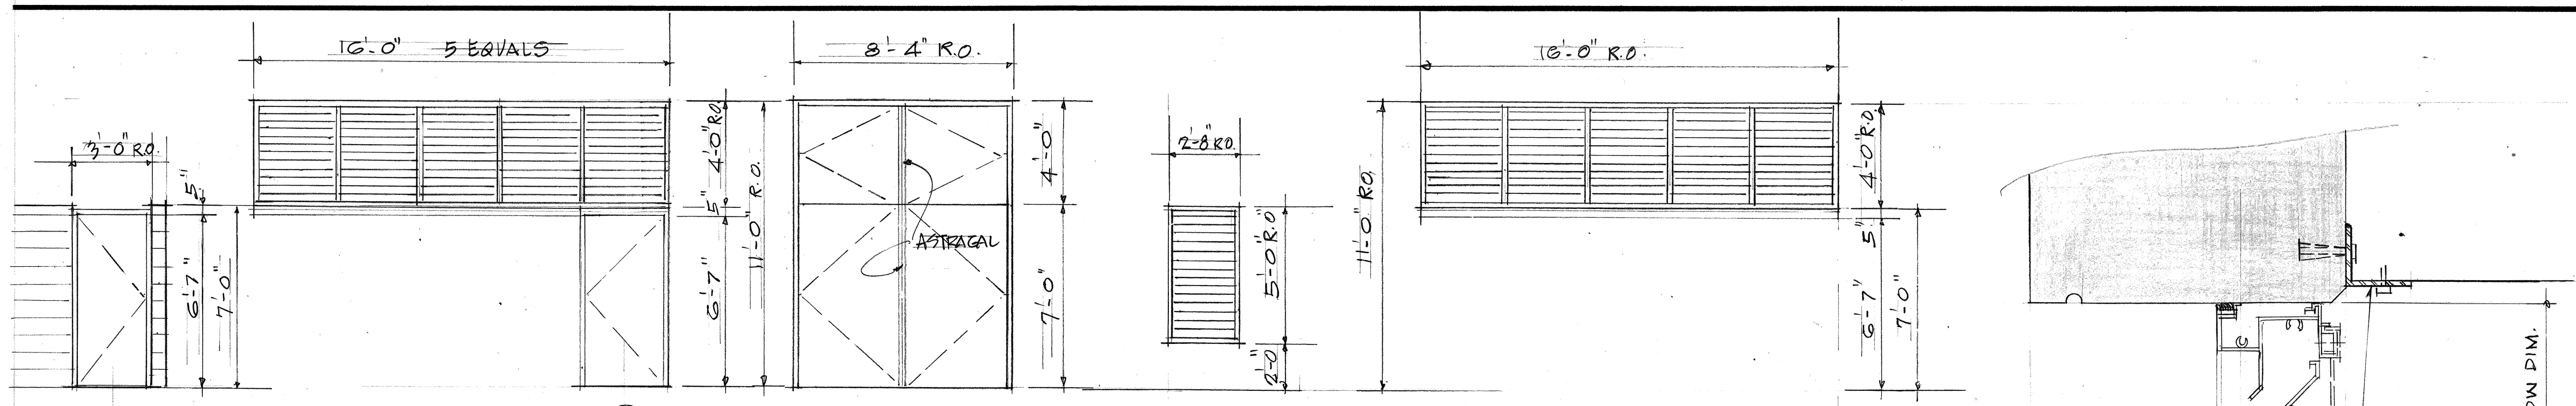

DOOR SCHEDULE						
NO	SIZE (WxH)	THICK	DOOR TYPE	FRAME DETAIL	FRAME MAT'L	REMARKS
101	8'-4" x 11'-0" R.O.	1 3/4"	B	HM	A/G	HM.
102	3'-4" x 7'-0" R.O.	1 3/4"	2	HM	C/A-G	HM
103	3'-0" x 7'-0" R.O.	1 3/4"	1	HM	B/A-G	HM.

DOOR & WINDOW TYPES
SCALE: 1/4" = 1'-0"

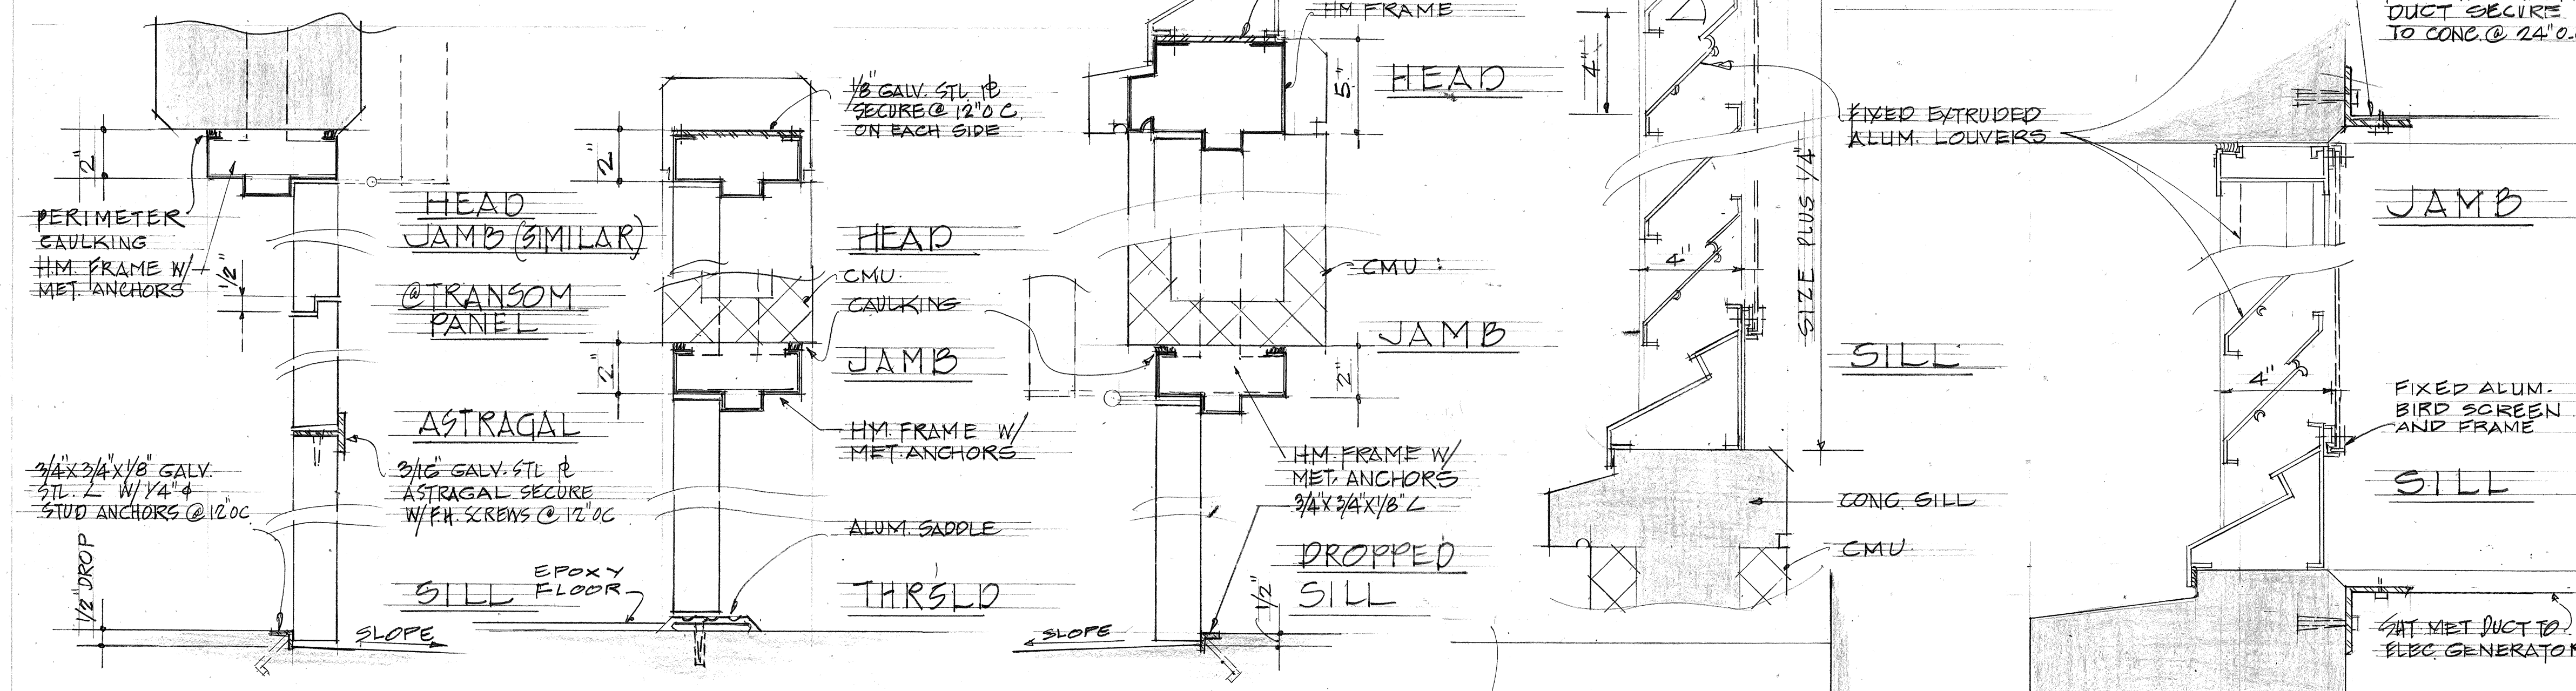

WINDOW SCHEDULE					
NO	SIZE (WXH)	TYPE	DETAIL	FRAME MATERIAL	REMARKS
101	16'-0" x 4'-0" R.O.	B	D/A-G	ALUM	W/ BIRD SCREEN & EXTRUDED ALUM. FRAME
102	16'-0" x 4'-0" R.O.	B	D/A-G	"	DITTO
103	16'-0" x 4'-0" R.O.	B	D/A-G	"	DITTO
104	16'-0" x 4'-0" R.O.	B	D/A-G	"	DITTO
105	2'-8" x 5'-0" R.O.	A	E/A-G	ALUM	DITTO

A HINGED EXT. DOOR
A-G TYPE ③ DOOR
SCALE: 3" = 1'-0"

B HINGED INT. DOOR
A-G FRAME @ TYPE ① DOOR
SCALE: 3" = 1'-0"


C TYPE ② DOOR
A-G SCALE: 3" = 1'-0"

D TYP. FIXED EXTR. ALUM.
A-G LOUVER WINDOW TYPE ⑤
SCALE: 3" = 1'-0"

E FIXED ALUM.
A-G COMBINATION INTAKE
LOUVERS. SCALE: 3" = 1'-0"

WILSON OKAMOTO & ASSOC. ENGINEERS - ARCHITECTS - PLANNERS HONOLULU HAWAII		SYM		DESCRIPTION		DATE		APP'D	
REVISIONS									
STATE OF HAWAII DEPARTMENT OF LAND AND NATURAL RESOURCES DIVISION OF WATER AND LAND DEVELOPMENT SAND ISLAND PARKWAY INCREMENT II, PHASE I & SEWAGE PUMP STATION WINDOW TYPES, SCHEDULE, DETAILS									
DESIGNED: W.L.		SUBMITTED: <i>Takeshi</i>							
DRAWN: M.K.		DATE: 5/2/80		CHIEF DESIGN & CONSTR. ENGINEER					
CHECKED: W.L.		DATE: 5/2/80		APPROVED: <i>Robert H. Hume</i>		FILE NO.			
APPROVED: <i>W. L. Wilson</i>		DATE: 5/2/80		MANAGER - CHIEF ENGINEER					

APPROVED:
W. L. Wilson
CHIEF DIV. OF WASTEWATER
MANAGEMENT
DATE: 6/24/80

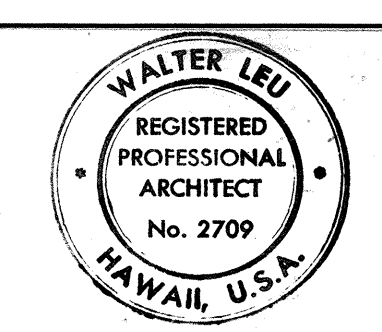

This work was prepared by me
or under my supervision.
W. L. Wilson