


EXISTING SPRINKLER SYSTEM-PARTIAL PLAN


NOTE

✕ Sprinkler Heads to be removed

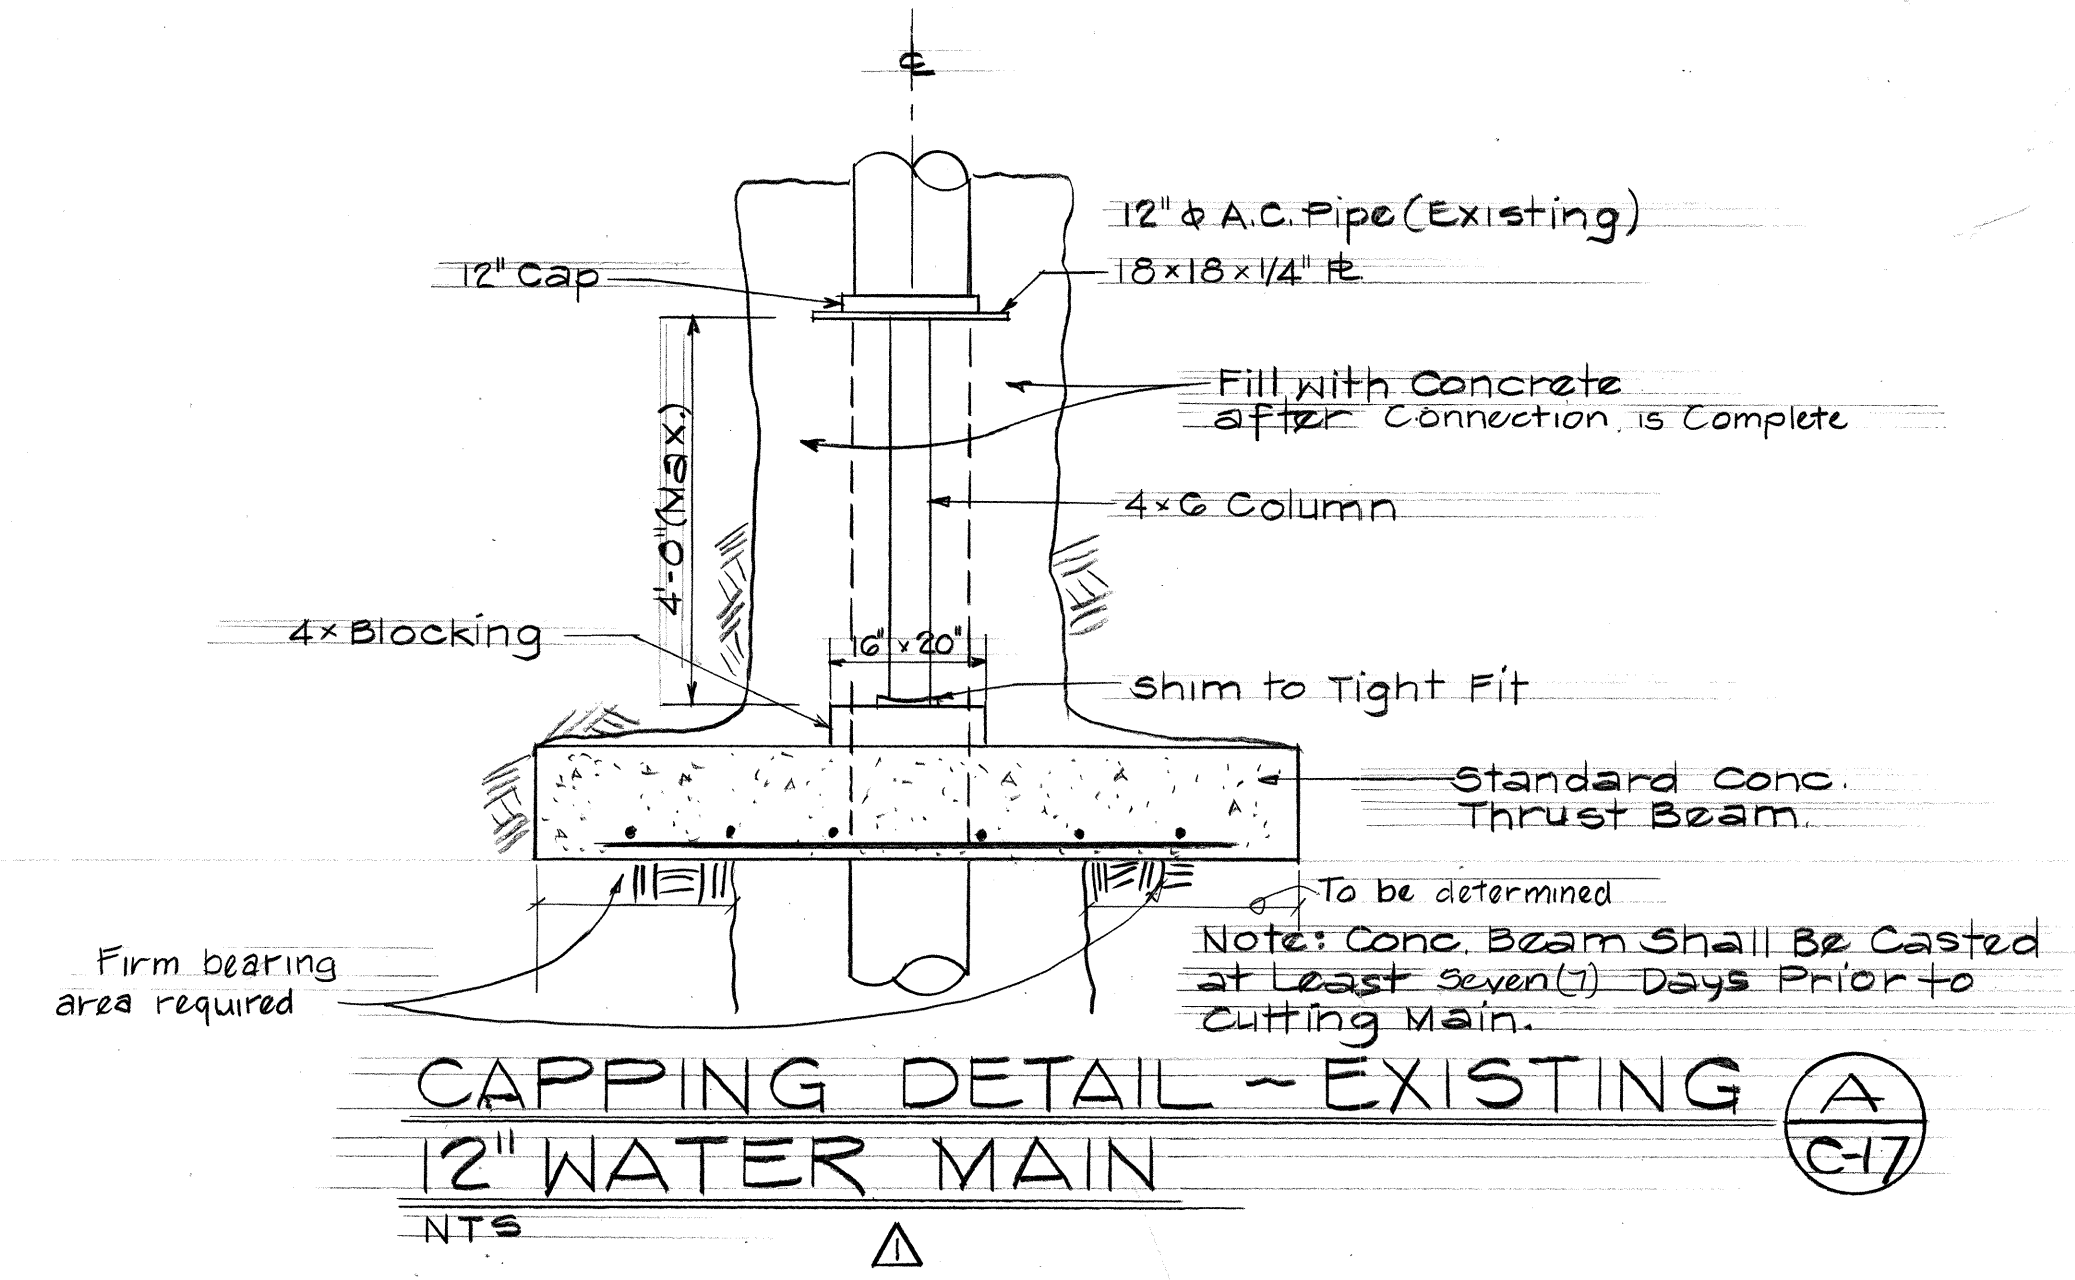

Note:
Detail of actual beam to be used shall be furnished during construction by the engineer who prepared the plans.

BRUNING 44-132-30098

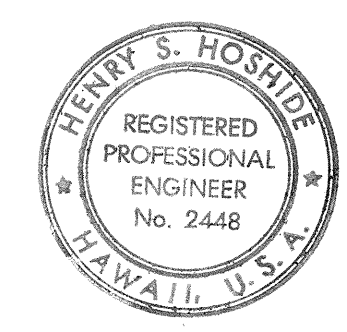

APPROVED:
[Signature] 1/14/89
CHIEF PLANNING & ENGINEERING, BWS

THIS WORK WAS PREPARED BY ME UNDER MY SUPERVISION.
[Signature]
Signature

S		ADDED CAPPING DETAIL			
SYM		DESCRIPTION		DATE	APP'D
REVISIONS					
STATE OF HAWAII					
DEPARTMENT OF LAND AND NATURAL RESOURCES					
DIVISION OF WATER AND LAND DEVELOPMENT					
SAND ISLAND PARKWAY INCREMENT II, PHASE I					
& SEWAGE PUMP STATION					
SAND		ISLAND,		OAHU,	HAWAII
SPRINKLER SYSTEM					
DESIGNED: K. N.		SUBMITTED: <i>Walter B. King</i>			
DRAWN: R. N.		CHIEF DESIGN & CONSTR. ENGINEER			
CHECKED: K. N.		DATE: 5/12/89			
APPROVED: <i>R. B. King</i>		FILE NO.			
DATE: 5/1/89		MANAGER-CHIEF ENGINEER			

As Built