

SAND ISLAND PARKWAY INCREMENT II, PHASE I & SEWAGE PUMP STATION

SAND ISLAND

OAHU

HAWAII

JOB NO. 46-OL-17 TAX MAP KEY I-5-41

STATE OF HAWAII

DEPARTMENT OF LAND AND NATURAL RESOURCES

DIVISION OF WATER AND LAND DEVELOPMENT

ACT 195 SLH 1975 ITEM K-5 (B-75-475-C)

ACT 226 SLH 1976 ITEM K-5 (B-76-437-C)

ACT 243 SLH 1978 ITEM K-4 (B-77-483-C & B-78-491-C)

PREPARED BY

WILSON OKAMOTO & ASSOCIATES

ENGINEERS

ARCHITECTS

PLANNERS

HONOLULU

HAWAII

CONSULTANTS

NAKAMURA, KAWABATA & ASSOC., INC.

ELECTRICAL ENGINEER

HONOLULU, HAWAII

FEWELL GEOTECHNICAL ENGINEERING LTD.

SOILS ENGINEER

HONOLULU, HAWAII

APPROVED:

Robert G. Chuok
Manager-Chief Engineer, Division of Water and Land Development
Department of Land and Natural Resources, State of Hawaii

May 21, 1980
Date

Shing S. Suen
Chief Environmental Protection and Health Services Division
State of Hawaii

May 13, 1980
Date

Ryohichi Higashimura
Director, Department of Transportation
State of Hawaii

May 8, 1980
Date

Wallace Miyahira
Director and Chief Engineer, Department of Public Works
City and County of Honolulu


7/28/80
Date

Fergus Hagan
Manager and Chief Engineer, Board of Water Supply
City and County of Honolulu

7/21/80
Date

INDEX

SHT. NO.	DESCRIPTION
T-1	TITLE SHEET
C-2	NOTES
C-3	GENERAL PLAN
C-4	RIGHT-OF-WAY MAP
C-5	TYPICAL SECTIONS
C-6	PLAN & PROFILE STA. 38+24.29 TO STA. 49+00
C-7	PLAN & PROFILE STA. 49+00 TO STA. 61+00
C-8	PLAN & PROFILE STA. 61+00 TO STA. 69+53.95
C-9	PLAN & PROFILE SEWERLINE COAST GUARD AREA
C-10	PLAN & PROFILE GRADING PLAN STA. 38+24.28 TO STA. 45+00
C-11	SUPERELEVATION DIAGRAMS & DRAIN PROFILES
C-12 TO 13	SIGNING & STRIPING PLAN
C-14	DRAIN DETAILS
C-15	DRAIN & MISCELLANEOUS DETAILS
C-16	MISCELLANEOUS DRAINAGE DETAILS
C-17	SPRINKLER SYSTEM
C-18	EROSION CONTROL PLAN
C-19 TO 36	STANDARD DETAILS
C-37 TO 42	CROSS SECTIONS
C-43	SITE PLAN - NEW PUMP STATION
C-44	FORCE MAIN - PLAN & PROFILE
C-45	CONSTRUCTION DETAIL - JUNCTION BOX
A-1	PLANS - ROOM FINISH SCHEDULE
A-2	ELEVATIONS & SECTIONS
A-3	SECTIONS
A-4	ELEVATION, SECTIONS & DETAILS
A-5	STAIRS, PLANS, SECTIONS & DETAILS
A-6	WINDOW TYPES, SCHEDULE DETAILS
S-1	GENERAL NOTES
S-2	PUMP ROOM & INTERMEDIATE FLOOR PLAN
S-3	GROUND FLOOR & FOUNDATION PLAN & DETAILS
S-4	ROOF FRAMING PLAN AND DETAILS
S-5	SECTIONS
S-6	SECTIONS
S-7	LONGITUDINAL AND TRAVERSE FRAME
S-8	STAIR SECTIONS
S-9	ROOF BEAM ELEVATIONS AND SECTIONS
S-10	TYPICAL SECTIONS
S-11	MCC & GEN. PAD AND PIPE SUPPORT DETAIL
S-12	LINER AND MANHOLE COVER DETAILS
M-1	GROUND FLOOR LAYOUT PLAN
M-2	PUMP ROOM & INTERMEDIATE FLOOR LAYOUT PLAN
M-3	SECTIONS
M-4	DETAILS
M-5	DETAILS
M-6	ELEVATIONS & DETAILS
M-7	DETAILS
M-8	PUMP ROOM, INTERMEDIATE AND GROUND FLOOR - FLOOR PLAN
M-9	VENTURI METER DETAILS & SECTIONS
M-10	SANITARY & COLD WATER PIPING DIAGRAMS
E-1	ELECTRICAL FLOOR PLANS, SCHEDULES, AND SYMBOLS
E-2	GROUND FLOOR POWER PLANS, I-LINE DIAGRAMS & MCC
E-3	EXTERIOR ELECTRICAL PLAN & DETAILS
E-4	CONTROL DIAGRAMS
E-5	CONTROL AND INSTRUMENTATION DIAGRAM

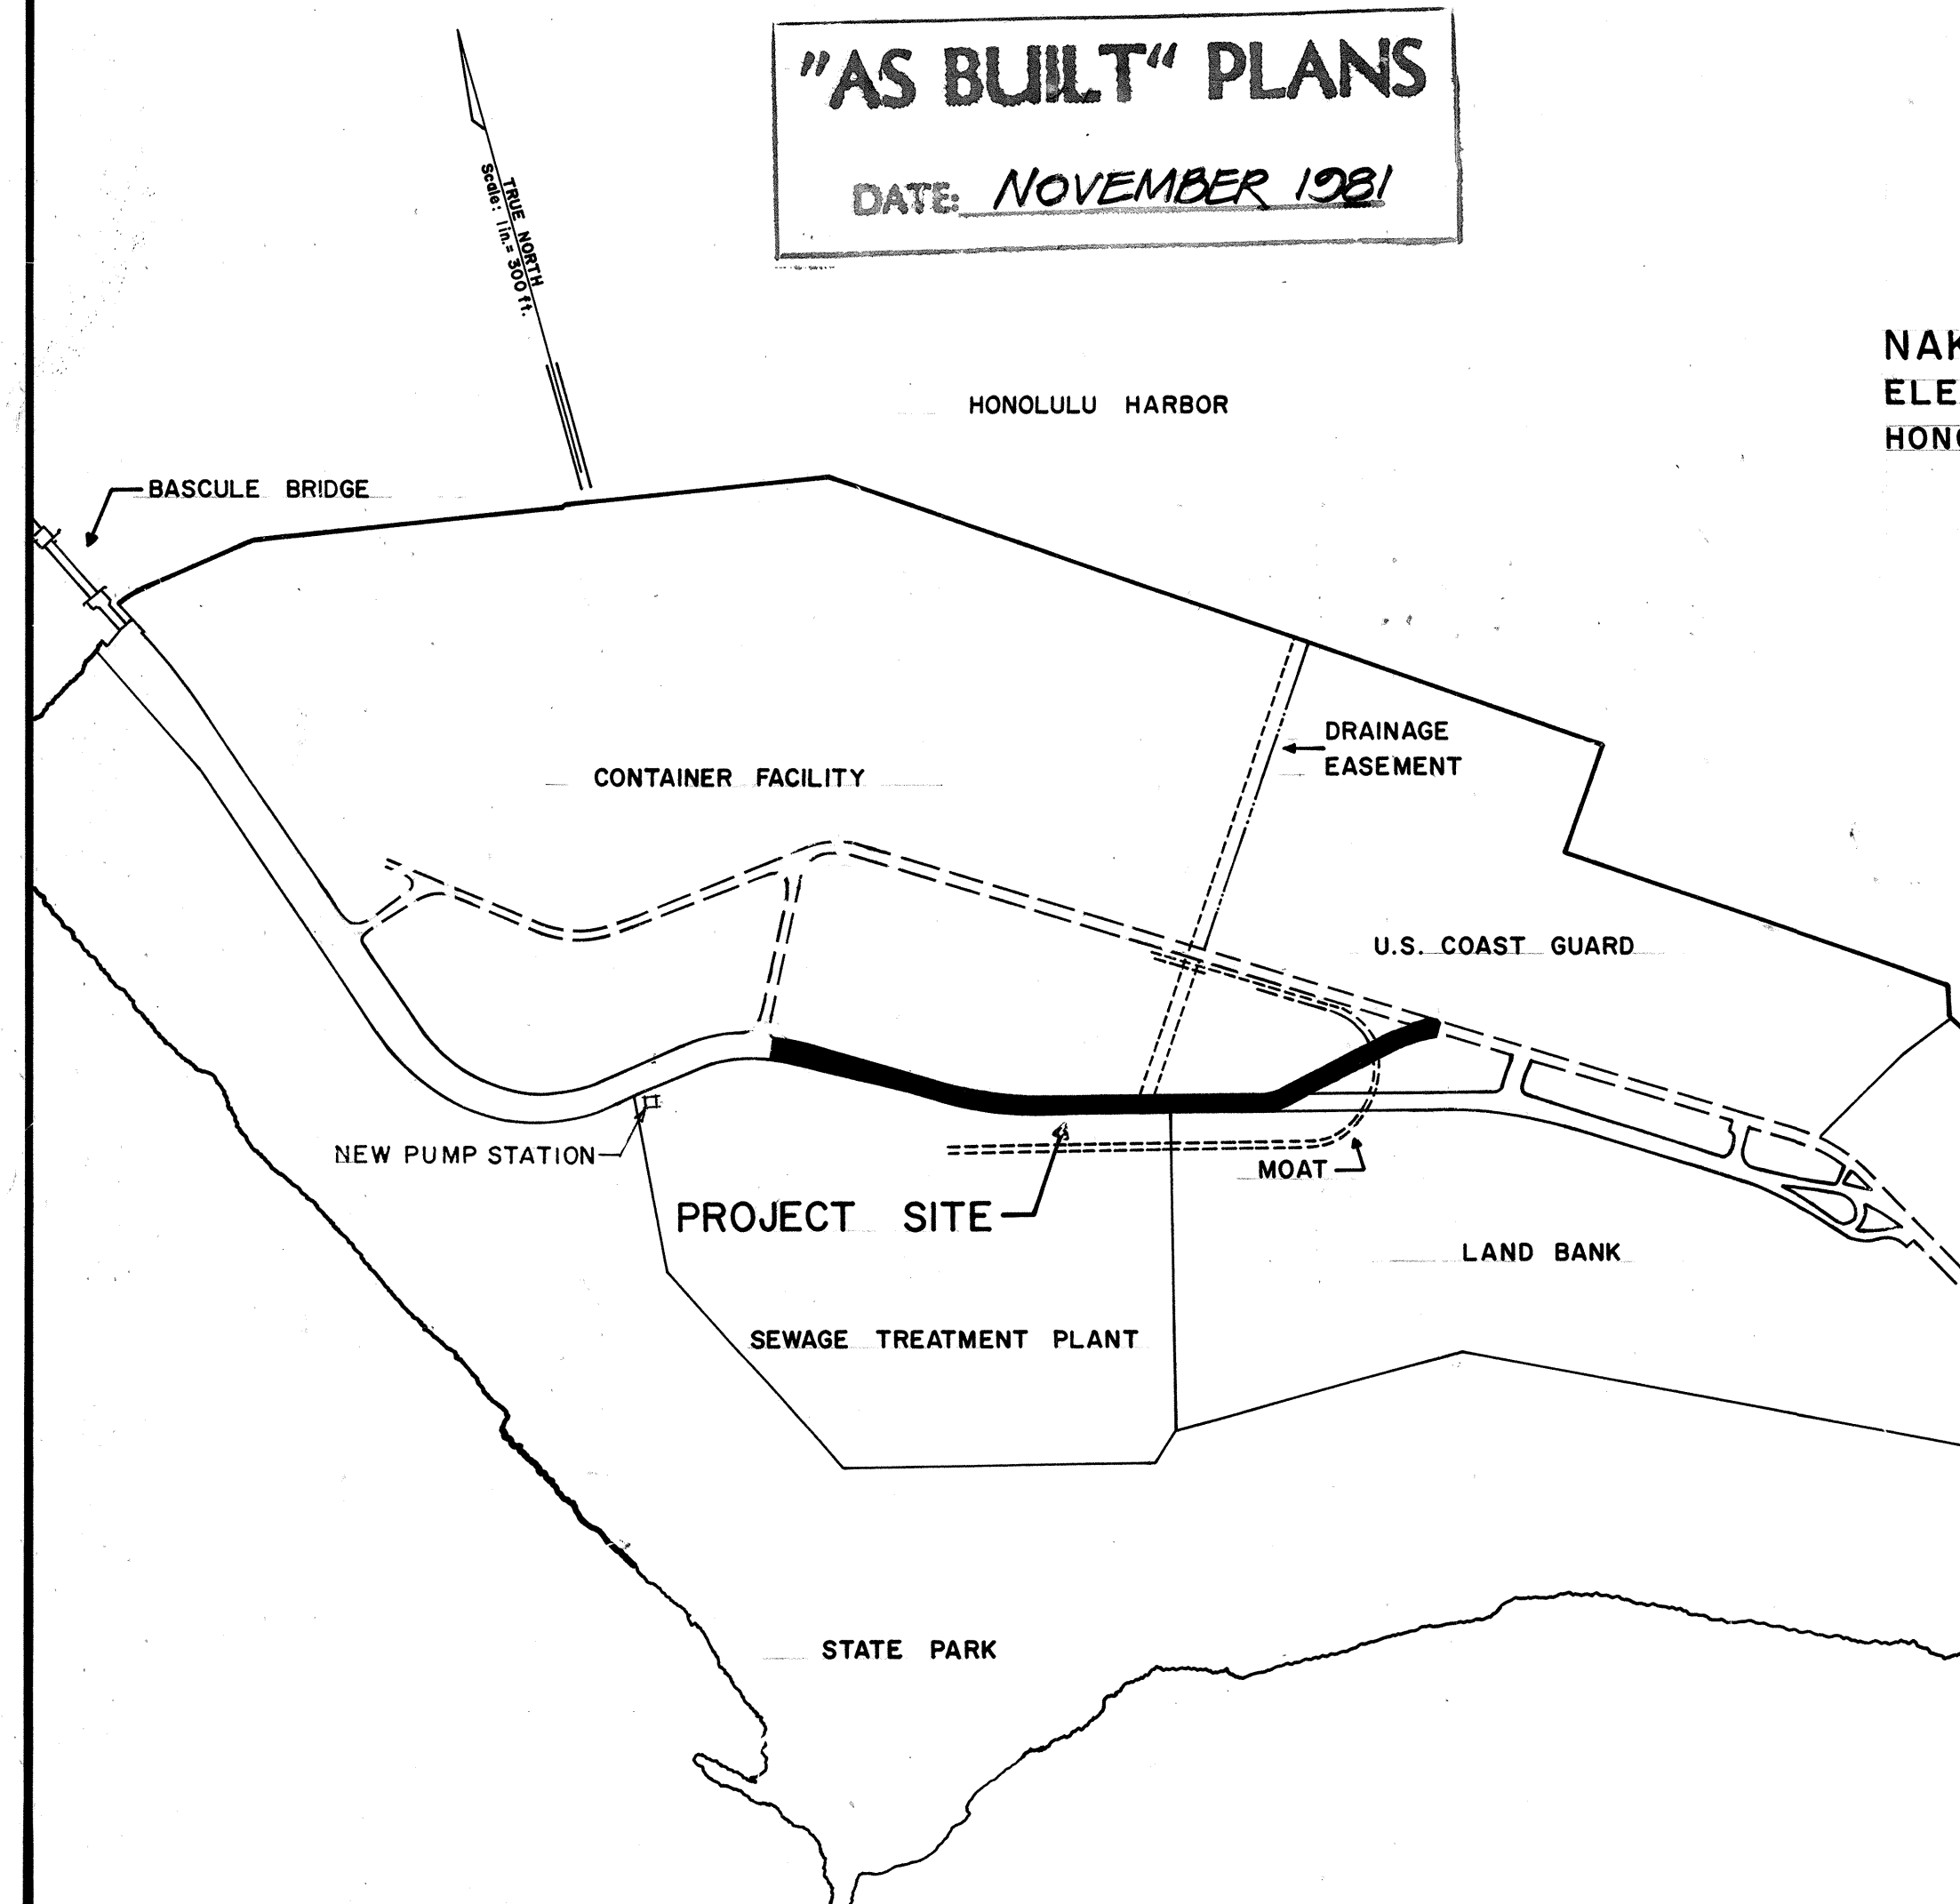

"AS BUILT" PLANS

DATE: NOVEMBER 1981