


FED. ROAD DIST. NO.	STATE	PROJ. NO.	FISCAL YEAR	SHEET NO.	TOTAL SHEETS
HAWAII	HAW.	64A-01-82M	1982	4	14

TRUE NORTH
SCALE: 1"=50'


BEGIN OF PROJ. NO. 64A-01-82M
STA. 0+62±
2 1/2" Mix No. V
BEG. OF PROJ.
STA. 1+58
2 1/2" Mix No. V

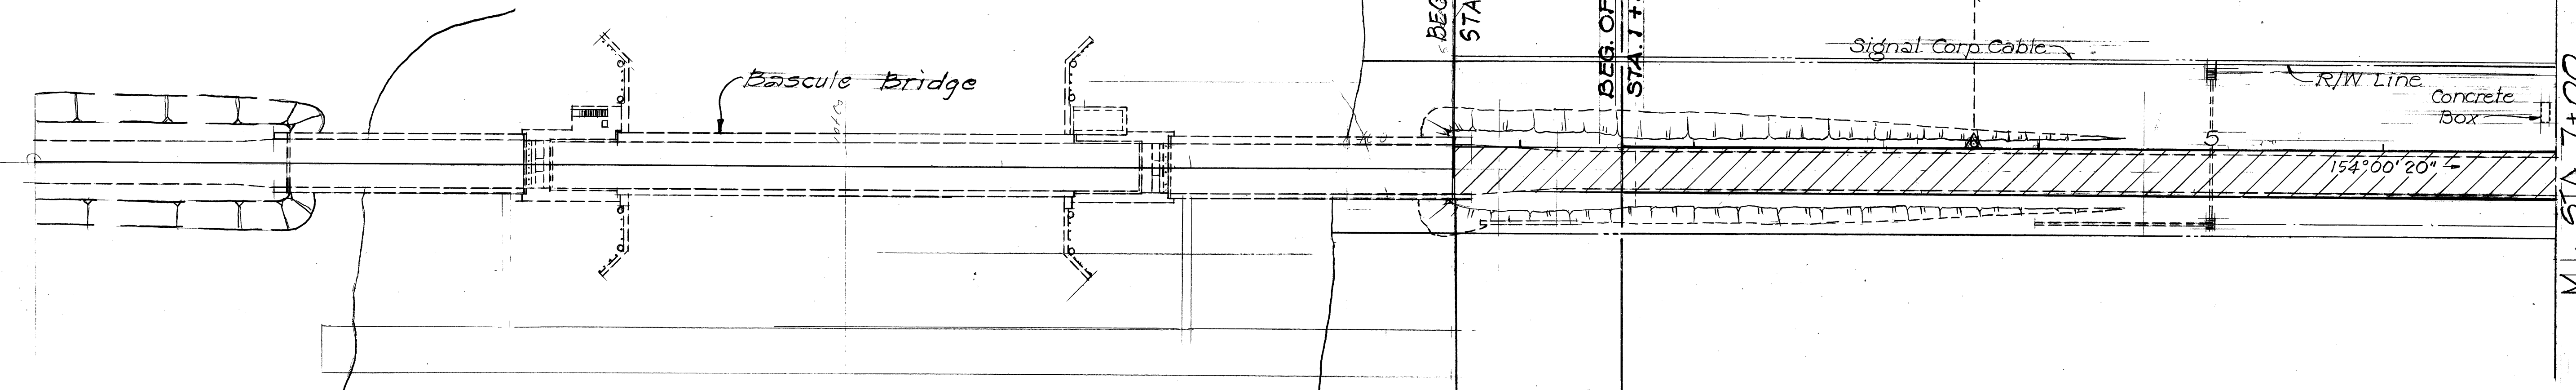

TRUE NORTH
SCALE: 1"=50'

M.L. STA. 7+00

M.L. STA. 20+00

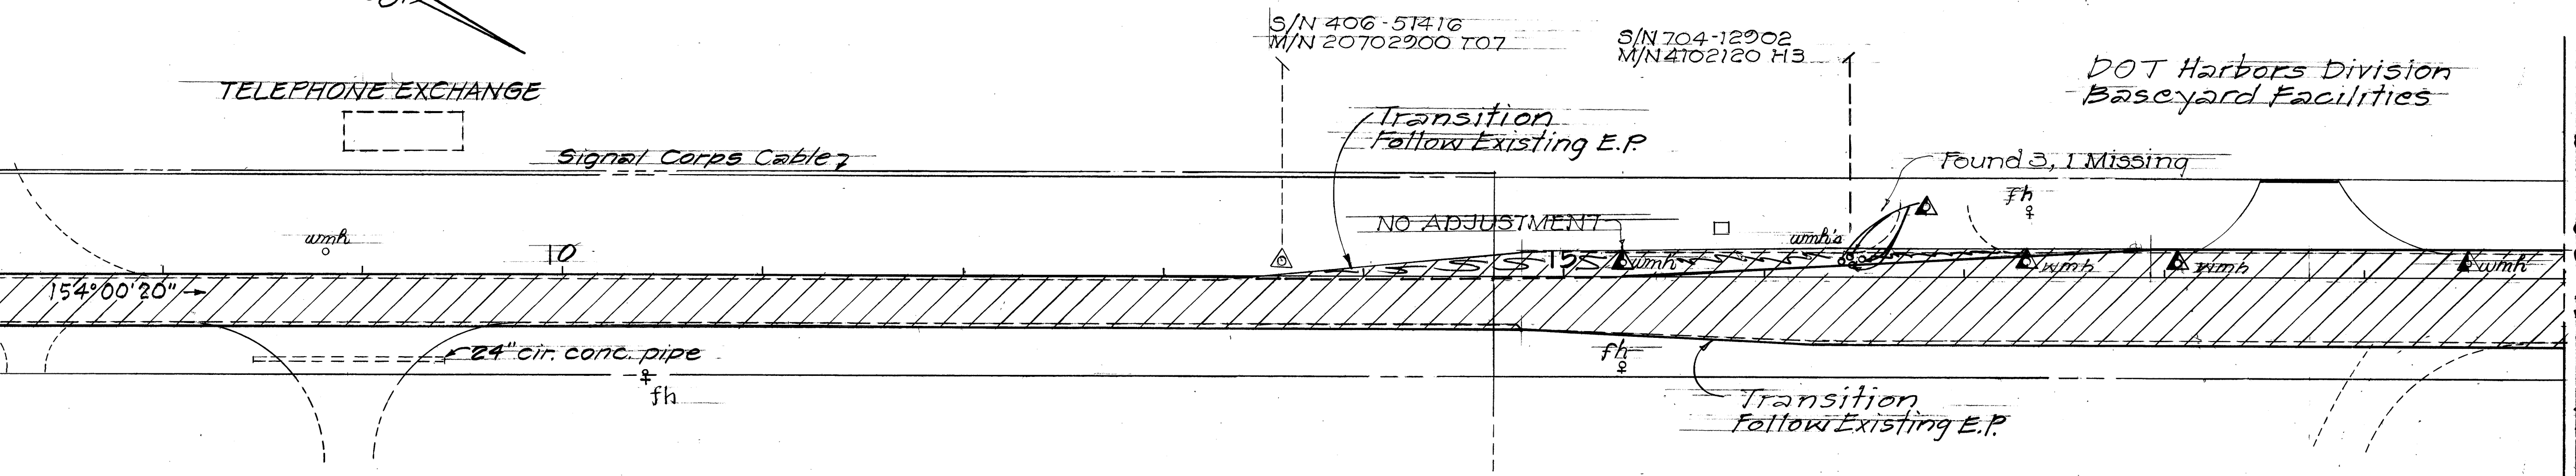

DATE	DESIGNED BY	CHECKED BY
PLAN	DESIGNED BY	CHECKED BY
NOTE BOOK	DESIGNED BY	CHECKED BY
QUANTITIES BY	DESIGNED BY	CHECKED BY
NO.	DESIGNED BY	CHECKED BY

STATE OF HAWAII
DEPARTMENT OF TRANSPORTATION
HIGHWAYS DIVISION

PLAN

**SAND ISLAND ACCESS ROAD
RESURFACING**


Sand Island Park to Nimitz Hwy.
(Bascule Bridge to Nimitz Highway)

PROJECT NO. 64A-01-82M

Scale as noted

SHEET NO. 4 OF 3 SHEETS

FED. ROAD DIST. NO.	STATE	PROJ. NO.	FISCAL YEAR	SHEET NO.	TOTAL SHEETS
HAWAII	HAW.	64A-01-82M	1982	5	14

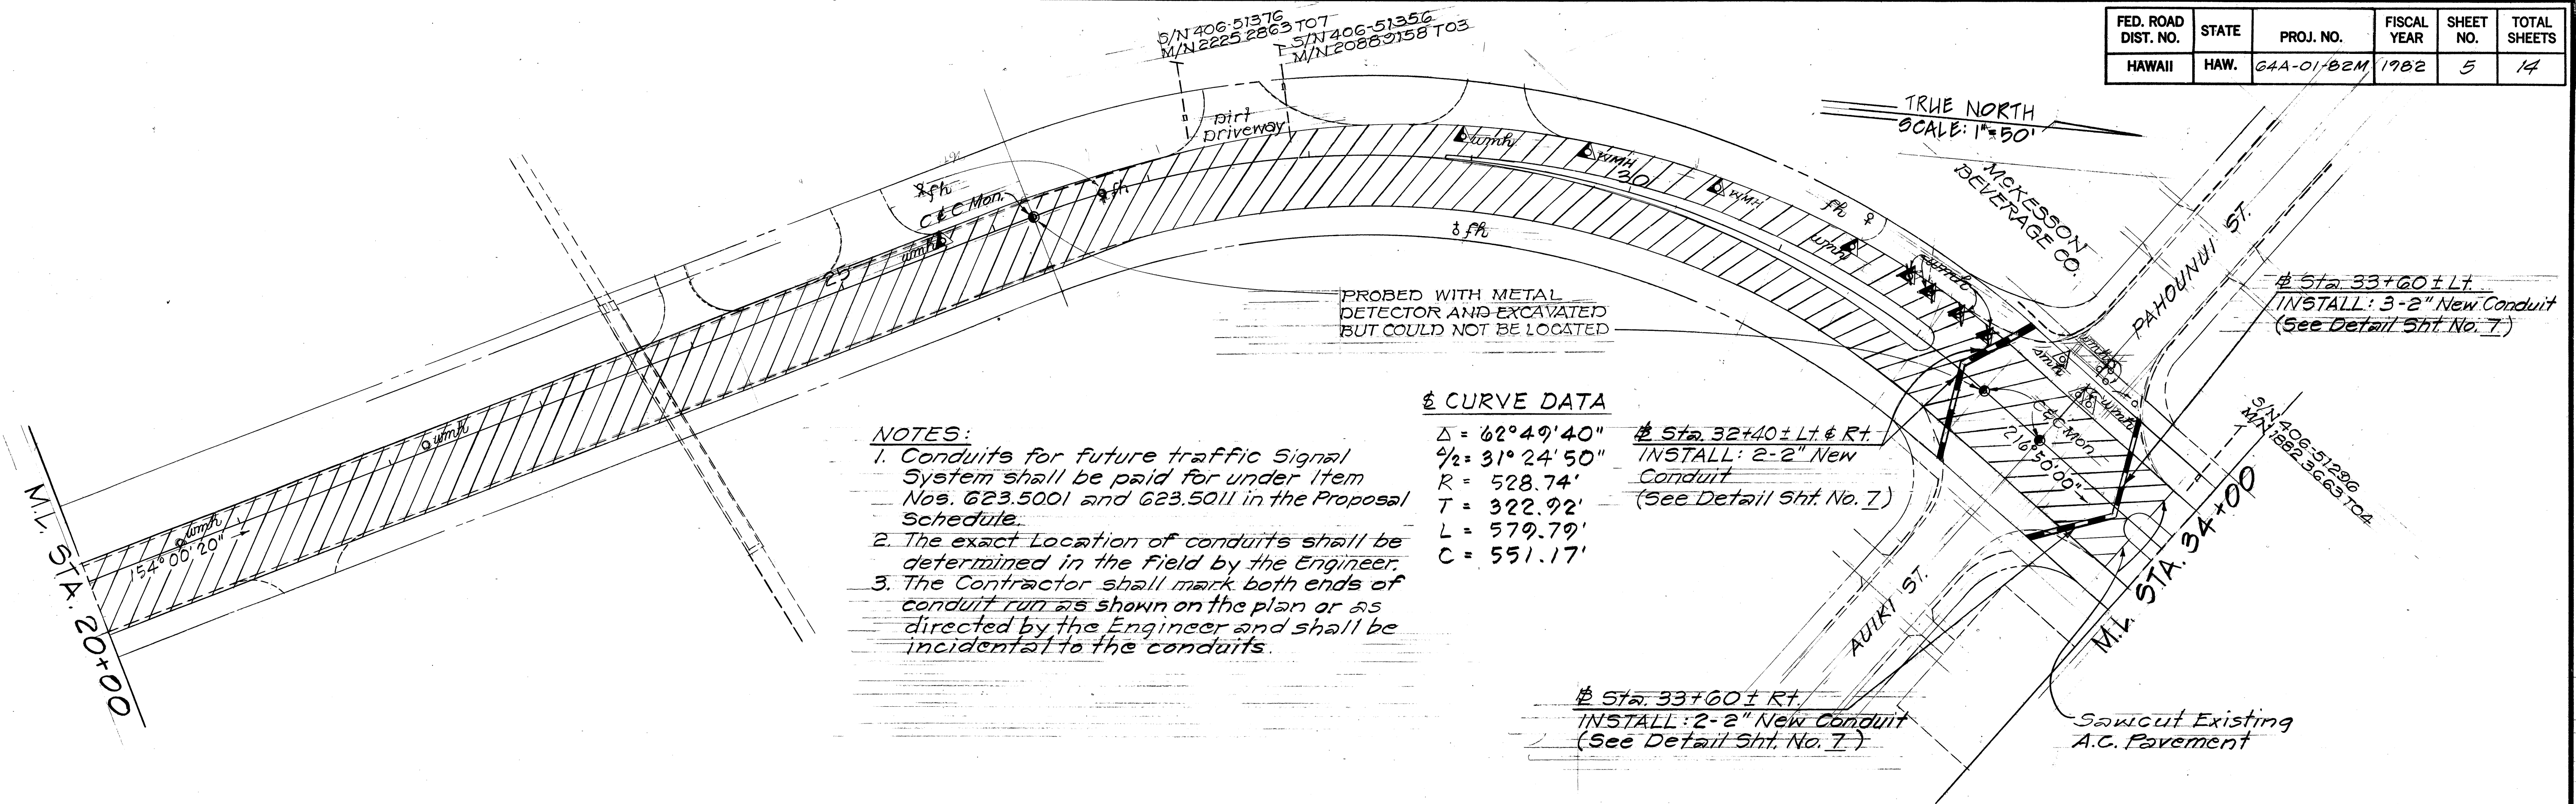

§ CURVE DATA

$\Delta = 62^\circ 49' 40''$
 $\frac{1}{2} \Delta = 31^\circ 24' 50''$
 $R = 528.74'$
 $T = 322.92'$
 $L = 579.79'$
 $C = 551.17'$

NOTES:

1. Conduits for future traffic signal system shall be paid for under item Nos. 623.5001 and 623.5011 in the Proposal Schedule.
2. The exact location of conduits shall be determined in the field by the Engineer.
3. The Contractor shall mark both ends of conduit run as shown on the plan or as directed by the Engineer and shall be incidental to the conduits.


Sta. 33+60 ± L & R
 INSTALL: 2-2" New Conduit
 (See Detail Sht. No. 7)

Sta. 33+60 ± L & R
 INSTALL: 3-2" New Conduit
 (See Detail Sht. No. 7)

FLYNN-LEANER

A.L. KILGO

REGENCY SALES, INC.
 HONOLULU SUPPLY CO.
 COAST ENTERPRISES CERAMIC TILE

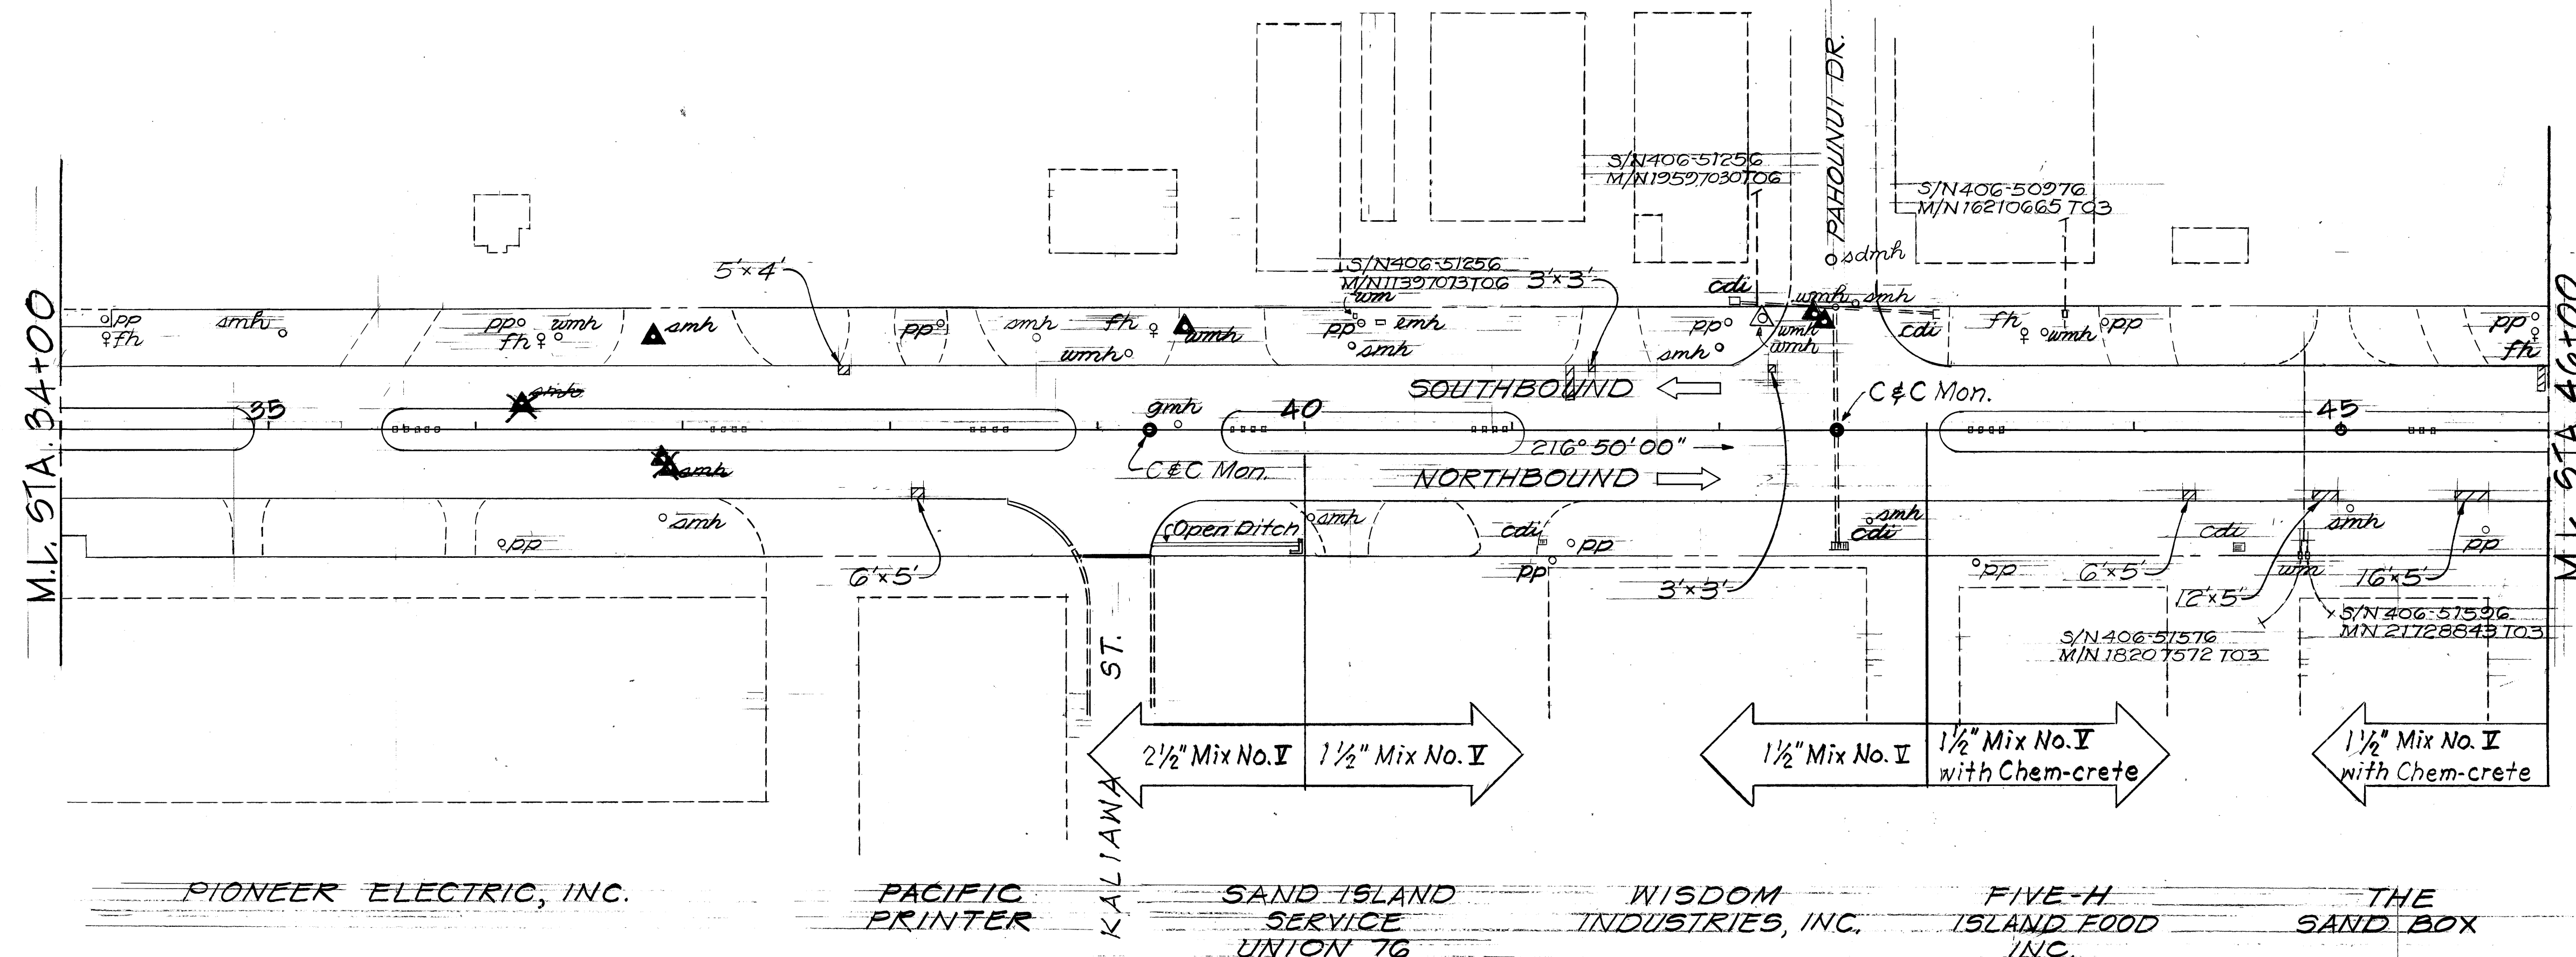

TRUE NORTH
SCALE: 1"=50'

STATE OF HAWAII
 DEPARTMENT OF TRANSPORTATION
 HIGHWAYS DIVISION
PLAN
**SAND ISLAND ACCESS ROAD
 RESURFACING**
 Sand Island Park to Nimitz Hwy.
 (Bascule Bridge to Nimitz Highway)
 PROJECT NO. 64A-01-82M
 Scale as noted
SHEET NO. 2 OF 3 SHEETS

