	INDEX TO DRAWINGS
SHEET NO.	DESCRIPTION
· 1	TITLE SHEET
2	NOTES & LEGEND
3-4	TRAFFIC SIGNAL SYSTEM
. 5	SIGNS, PAVEMENT MARKINGS & MISCELLANEOUS
	IMPROVEMENTS
6	MISCELLANEOUS DETAILS
7-15	STANDARD DETAILS

	the state of the state of



STATE OF HAWAII




DEPARTMENT OF TRANSPORTATION HIGHWAYS DIVISION

"AS BUILT"
PLANS FOR

ON SAND ISLAND ACCESS ROAD

AUIKI STREET & PAHOUNUI DRIVE INTERSECTION FEDERAL AID PROJECT NO. HES-064-I(I)

DISTRICT OF HONOLULU ISLAND OF OAHU

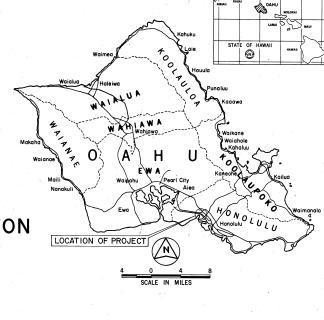

DIST. NO.

PROJECT LOCATION

PAHOLINUI DR.

SAND ISLAND ACCESS ROAD

STREET

THE TOTAL ACCESS ROAD

SCALE IN FEET

TMK:1-2-23 8.24

CHANGES MADE DURING CONSTRUCTION HAVE BEEN INCORPORATED ON THESE PLANS EXCEPT CHANGES IN THE ORIGINAL THEORETICAL QUANTITIES. FOR ACTUAL QUANTITIES, REFER TO PROJECT LEDGER AND/OR COMPUTATION BOOK.

Parid Jamashiro
RESIDENT ENGINEER

3/5/84 DATE

DEPARTMENT OF TRANSPORTATION FEDERAL HIGHWAY ADMINISTRATION

JORUNN 3/22/83
JORON STRATOR DATE



FISCAL SHEET YEAR NO.

1983

HES-064-1(1)