

ORIGINAL	SURVEY PLOTTED BY	DATE
PLAN	DRAWN BY	"
	TRACED BY	"
NOTE BOOK	DESIGNED BY	"
	QUANTITIES BY	"
No.	CHECKED BY	"

FED. ROAD DIST. NO.	STATE	FED. AID PROJ. NO.	FISCAL YEAR	SHEET NO.	TOTAL SHEETS
HAWAII	HAW.	F-064-1(2)	1987	103	151

<u>A</u>		<u>G</u>		<u>R</u>	
Abt. & c	Abutment And At	Ga. Galv.	Gage Galvanize	R=	Radius
<u>B</u>		<u>H</u>		Ref. Reinf.	Reference Reinforcing
B	Baseline	Hex.	Hexagon	R/W	Right of Way
Bm.	Beam	Horiz.	Horizontal	R.P.	Roofing Paper
Brg.	Bearing	<u>I</u>		<u>S</u>	
BLK.	Block	I.D.	Inside Diameter	S.I.	Sand Island
B	Bottom	Inv.	Invert.	Sect.	Section
Bot.	Bottom	<u>J</u>		Sht.	Sheet
<u>C</u>		Jt.	Joint	Sp.	Space
☼	Center line	<u>L</u>		Sta.	Station
Clr.	Clear	L	Lays	Stirr.	Stirrup
Conc.	Concrete	L.F.	Lineal Feet	Symm.	Symmetrical
Constr.	Construction	Longit.	Longitudinal	S.S.	Stainless Steel
C.J.	Construction Joint	L.S.	Lump Sum	<u>T</u>	
Cont.	Continuous	L.g.	Long	Thk.	Thick
C.Y.	Cubic Yard	M		Typ.	Typical
<u>D</u>		Mfg.	Manufacturer	T	Top
Det.	Detail	Max.	Maximum	<u>V</u>	
Diag.	Diagonal	Mech.	Mechanical	Vert.	Vertical
Dia. &	Diameter	Met.	Metal	<u>W</u>	
Dwg.	Drawing	Min.	Minimum	W/	With
<u>E</u>		Misc.	Miscellaneous		
Eq.	Each	<u>N</u>			
E.F.	Each Face	N.T.S.	Not To Scale		
E.W.	Each Way	<u>O</u>			
El.	Elevation	O.C.	On Center		
Elev.	Elevation	O.D.	Outside Diameter		
Eq.	Equal	<u>P</u>			
Exp.	Expansion	Pt.	Point		
Exist.	Existing	Pl.	Plate		
E.J.	Expansion Joint	PJF	Premolded Joint Filler		
<u>F</u>					
Ft.	Foot, Feet				
FM.	Force Main				
FA.	Force Account				



THIS WORK WAS PREPARED BY
ME OR UNDER MY SUPERVISION.

Myron Okubo

STATE OF HAWAII
DEPARTMENT OF TRANSPORTATION
HIGHWAYS DIVISION

INDEX OF BRIDGE DRAWINGS AND ESTIMATED QUANTITIES

SAND ISLAND ROAD WIDENING
2ND. BRIDGE AND APPROACHES
FEDERAL AID PROJECT NO. F-064-1(2)

SCALE: _____ DATE: JUN, 1986

SHEET No. 5-1 OF 30 SHEETS

DATE	REVISION
------	----------

DATE	*****
SURVEY PLOTTED BY	*****
DRAWN BY	*****
TRACED BY	*****
DESIGNED BY	*****
NOTE BOOK	*****
QUANTITIES BY	*****
CHECKED BY	*****
ORIGINAL PLAN	*****
No.	*****

GENERAL NOTES

General Specifications: State of Hawaii, Department of Transportation Standard Specifications for Road and Bridge Construction, 1985 and Special Provisions

Design Specifications: AASHTO Standard Specifications for Highway Bridges, Thirteenth Edition, 1983

Design Loads:

- Dead Load: An allowance of 20 psf for future wearing surface of asphalt concrete has been included in dead load calculations. Concrete unit weight of 160 pcf has been assumed for dead load calculations
- Live Load: HS20-44 or Interstate Loading

Design Stresses: Allowable concrete stresses used in design shall conform to AASHTO Standard Specifications for Highway Bridges, 13th Edition and the following:

Concrete	fc'	fc
Class A	3,000 psi	1,200 psi
Class B	2,500 psi	1,000 psi
Class BD	3,750 psi	1,500 psi
Seal	4,000 psi	1,600 psi
fc' = 4,500	4,500 psi	1,800 psi

Reinforcing Steel

Grade 40 fs = 20000 psi
Grade 60 fs = 24000 psi

Materials:

- Cement used in all bridge concrete elements shall be Type II.
- All concrete shall be Class A unless noted otherwise.
- Concrete for bridge deck shall be Class BD.
- Concrete for pier shafts, pier cap and box girders (deck, soffit, girders) shall have f'c = 4500 psi
- Concrete for Seal Concrete shall have an f'c = 4,000 psi and conform to the Special Provisions.
- All reinforcing steel shall conform to the requirements of ASTM A615 and shall be deformed, Grade 40 unless noted otherwise.
- All structural steel shall be ASTM A36, hot dip galvanized, after fabrication unless noted otherwise.
- All anchor bolts, washers and nuts shall conform to the requirements of ASTM A307, hot dip galvanized, unless noted otherwise.
- Welding electrodes for structural steel shall be E70.
- Welding electrodes for stainless steel shall be E316.
- Elastomeric bearing pads shall be of 60+ 5 Hardness or as noted.
- Concrete for counterweight shall be Class B.

Reinforcement:

- The minimum clear cover for reinforcing steel shall be as follows unless otherwise specified on the plans:
 - Deck slabs for prestressed girders:
 - Top bars.....1-1/2"
 - Bottom bars.....1-1/4"
 - Abutments, and retaining walls.....2"
 - Bridge Piers to ties.....4"
- Concrete cast against and permanently exposed to earth.....3"
- Concrete exposed to abrasion or sea water.....4"
- Concrete piles in sea water.....3"

- Reinforcing bars shall be detailed in accordance with ACI Manual of Standard Practice for Detailing Reinforced Concrete Structures unless noted otherwise.

Construction Methods:

- See Standard Specifications for Road and Bridge Construction and Special Provisions.
- The top of concrete deck slab shall be constructed to attain the roadway vertical and horizontal curves indicated on the plans.
- Except as otherwise noted all vertical dimensions are measured plumb.
- Girder concrete seats receiving elastomeric pads shall be poured monolithically with the supporting structure. Top of concrete seats shall be finished with a steel trowel to a smooth level surface to the elevation shown on the plans. All points on the surface shall be level to within 1/16". The bottoms of elastomeric bearing pads shall be fastened to the concrete seats with adhesives approved by the Engineer.
- Spread footings shall be excavated and poured to neat lines when called for on the plans. In the event of over-excavation, the space between the spread footing and ground shall be filled with a minimum of Class D concrete at the Contractor's expense and as directed by the Engineer. Over-excavated pile footings may be backfilled with soil to attain the proper elevation.
- Abutments shall be backfilled to an elevation no higher than the elevation of the bottom of girders until after the girders are in place.
- Materials, components and structures treated with preservatives such as creosote, paints, anti-rust and anti-fouling compounds should be allowed to dry for at least one week before being placed in contact with sea water.
- Fabrication and assembling of structures shall take place on fast lands to the maximum extent possible.
- Turbidity shall be controlled during dredging by using silt curtains or equivalent means.

Foundation Notes:

- A structure foundation report entitled "Subsurface Investigation Report, Proposed Fixed-Span Bridge, Sand Island Access Road Improvements, Honolulu, Oahu, Hawaii" has been prepared for this project. A copy of this report is available for review at the Department of Transportation.
- Allowable pile capacity:
 - Intermediate piers - 60 tons (16-1/2" octagonal piles)
 - Center piers - 70 tons (20" square piles)
 - Abutments - 75 tons (16-1/2" octagonal piles)
- In general the design, construction and installation of the piles shall be in accordance with Section 505 of the 1985 Standard Specifications for Bridge and Road Construction of the State of Hawaii, Department of Transportation and Special Provisions.
- Concrete blocks and various debris were noted at the Sand Island Abutment. These items shall be removed by the Contractor prior to pile driving operations as directed by the Engineer. (Incidental to Pile Driving Operations).
- In driving each group of piles, the Contractor shall start from the center of the group and proceed outward.
- Concrete in prestressed concrete piles shall have a minimum 28 day compressive strength of 5000 psi.
- Test piles shall be driven at each abutment and intermediate pier locations as indicated in the plans.
- A full-scale pile load test shall be completed at both Pier #4 and Sand Island Abutment. Additional load tests may be required should erratic driving conditions be encountered, subject to approval by the Engineer. Pile load tests shall be in strict accordance with the recommended procedures of Hawaii Test Method HWY-TS6 with the following additional requirements:
 - A total of three independent measuring systems shall be utilized to monitor pile deflections. Dial gages shall be utilized as the primary system.
 - A total of four dial gages shall be utilized to determine any uneven settlement or tilting of the tested pile during loading. A dial gage shall be placed on each alternating corner of the pile.
- Level readings shall be taken on referenced beams and the reaction system.
- The load test shall be completed using the cyclic loading procedure. The load test shall be run to failure to verify the pile capacity.
- Pile load tests shall be performed by the Contractor and monitored by the Engineer. The Contractor shall supply all materials, equipment, tools and incidentals necessary to complete the work except for loading jacks and deflection dials.

Pretensioning (Prestressed Girders) NOTE: PRESTRESSED GIRDERS WERE MANUFACTURED BY WASHINGTON TECHNOLOGY, INC. SEE C.O. 7

- Concrete shall have a minimum ultimate 28 day compressive strength of 6500 psi. Minimum ultimate concrete strength before release of strands is f'ci = 5,000 psi.
- Pretensioned strands shall be 1/2" dia. 7 wire stress relieved steel strands (Area = 0.1531 in²) with an ultimate strength of 270 ksi.
- Total long term losses due to creep, shrinkage, elastic shortening and relaxation of steel = 45 ksi.
- The calculated camber includes the effect of the initial prestress loss and the weight of the girder after immediate removal from forms. The actual camber shall not exceed the calculated camber shown on the plans by more than 100%.
- The dead load deflection indicated accounts for the continued increase in upward camber and the downward deflection due to girder weight, slab and diaphragms.
- Strand pattern shall be symmetrical about the longitudinal centerline of the girder.
- Strands shall be released in such a manner as to minimize lateral eccentricity and strand slippage.
- Contractor shall submit his proposed strand pattern and sequence of release to the Engineer for review.
- Care should be taken during curing to avoid any lateral deflection of the girder and during transporting and erection.
- Lifting devices shall be placed as close as possible to the centerline of bearings of the girder. Details and locations of lifting devices shall be submitted to the Engineer for review. Such review does not relieve the Contractor of his responsibilities should the beam be damaged due to failure of the lifting device.
- Allowable concrete stresses:
 - Temporary compressive stress at release = 3000 psi
 - Compressive stress after losses = 2600 psi
 - Temporary tensile stress at release = 212 psi
 - Tensile stress after losses at service load = 0.
- The minimum clear cover for prestressed and non-prestressed steel shall be 1".


FED. ROAD DIST. NO.	STATE	FED. AID PROJ. NO.	FISCAL YEAR	SHEET NO.	TOTAL SHEETS
HAWAII	HAW.	F-064-1 (2)	1987	104	151

Construction Sequence

1. Install and construct foundation for Abutments and Piers.
2. Construct Pier Shafts, and Abutments. Construct the Box Pier bottom slab and webs for both the Box Girder and Counterweight Box Girder section. Forms for webs shall not be removed for a minimum of 7 days after placing of web concrete and concrete cylinder strength = 3,000 psi.
3. Remove web forms and place concrete for Counterweight.
4. Place top slab of Box Piers. Top slab concrete shall not be placed until the concrete for counterweight has a minimum concrete cylinder strength of 1,500 psi.
5. Falsework and forms shall be designed to support the entire Dead Load of the Box Pier section and counterweight.
6. Release of falsework for the Box Piers shall be a minimum of 28 days after placing concrete for the top slab and the required 28 days strength is obtained. Falsework shall be released evenly on both sides of the Pier Shaft.
7. Girders for Span 1 shall be erected before girders for Span 2 are erected. Girders for Span 5 shall be erected before girders for Span 4 are erected. Erect girders for Span 3 last.
8. Place suspended deck slab for Span 1 before placing suspended deck slab for Span 2. Place suspended deck slab for Span 5 before placing suspended deck slab for Span 4. Place suspended deck slab for Span 3 last.
9. Construct concrete railings, Install deck expansion joints and make closure pours.

General:

- The Contractor shall verify the location of any existing utility lines and notify the respective owners before commencing the work of excavation or the driving of piles. Damages to utility lines, that are to remain, caused by the Contractor shall be repaired at his expense.
- Construction joints shall be located as shown on the plans unless otherwise approved by the Engineer.
- Unless otherwise noted, all exposed concrete edges shall have a 3/4" chamfer.

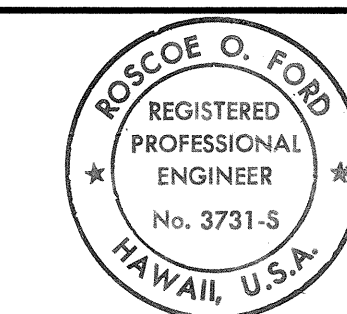

THIS WORK WAS PREPARED BY ME OR UNDER MY SUPERVISION

Roscoe O. Ford

STATE OF HAWAII
DEPARTMENT OF TRANSPORTATION
HIGHWAYS DIVISION

GENERAL NOTES

SAND ISLAND ROAD WIDENING
2ND. BRIDGE AND APPROACHES
FEDERAL AID PROJECT NO. F-064-1(2)


SCALE: AS NOTED DATE: JUN, 1986

SHEET NO.S-2 OF 30 SHEETS

DATE REVISION

"AS-BUILT"


FED. ROAD DIST. NO.	STATE	FED. AID PROJ. NO.	FISCAL YEAR	SHEET NO.	TOTAL SHEETS
HAWAII	HAW.	F-064-1(2)	1987	106	151

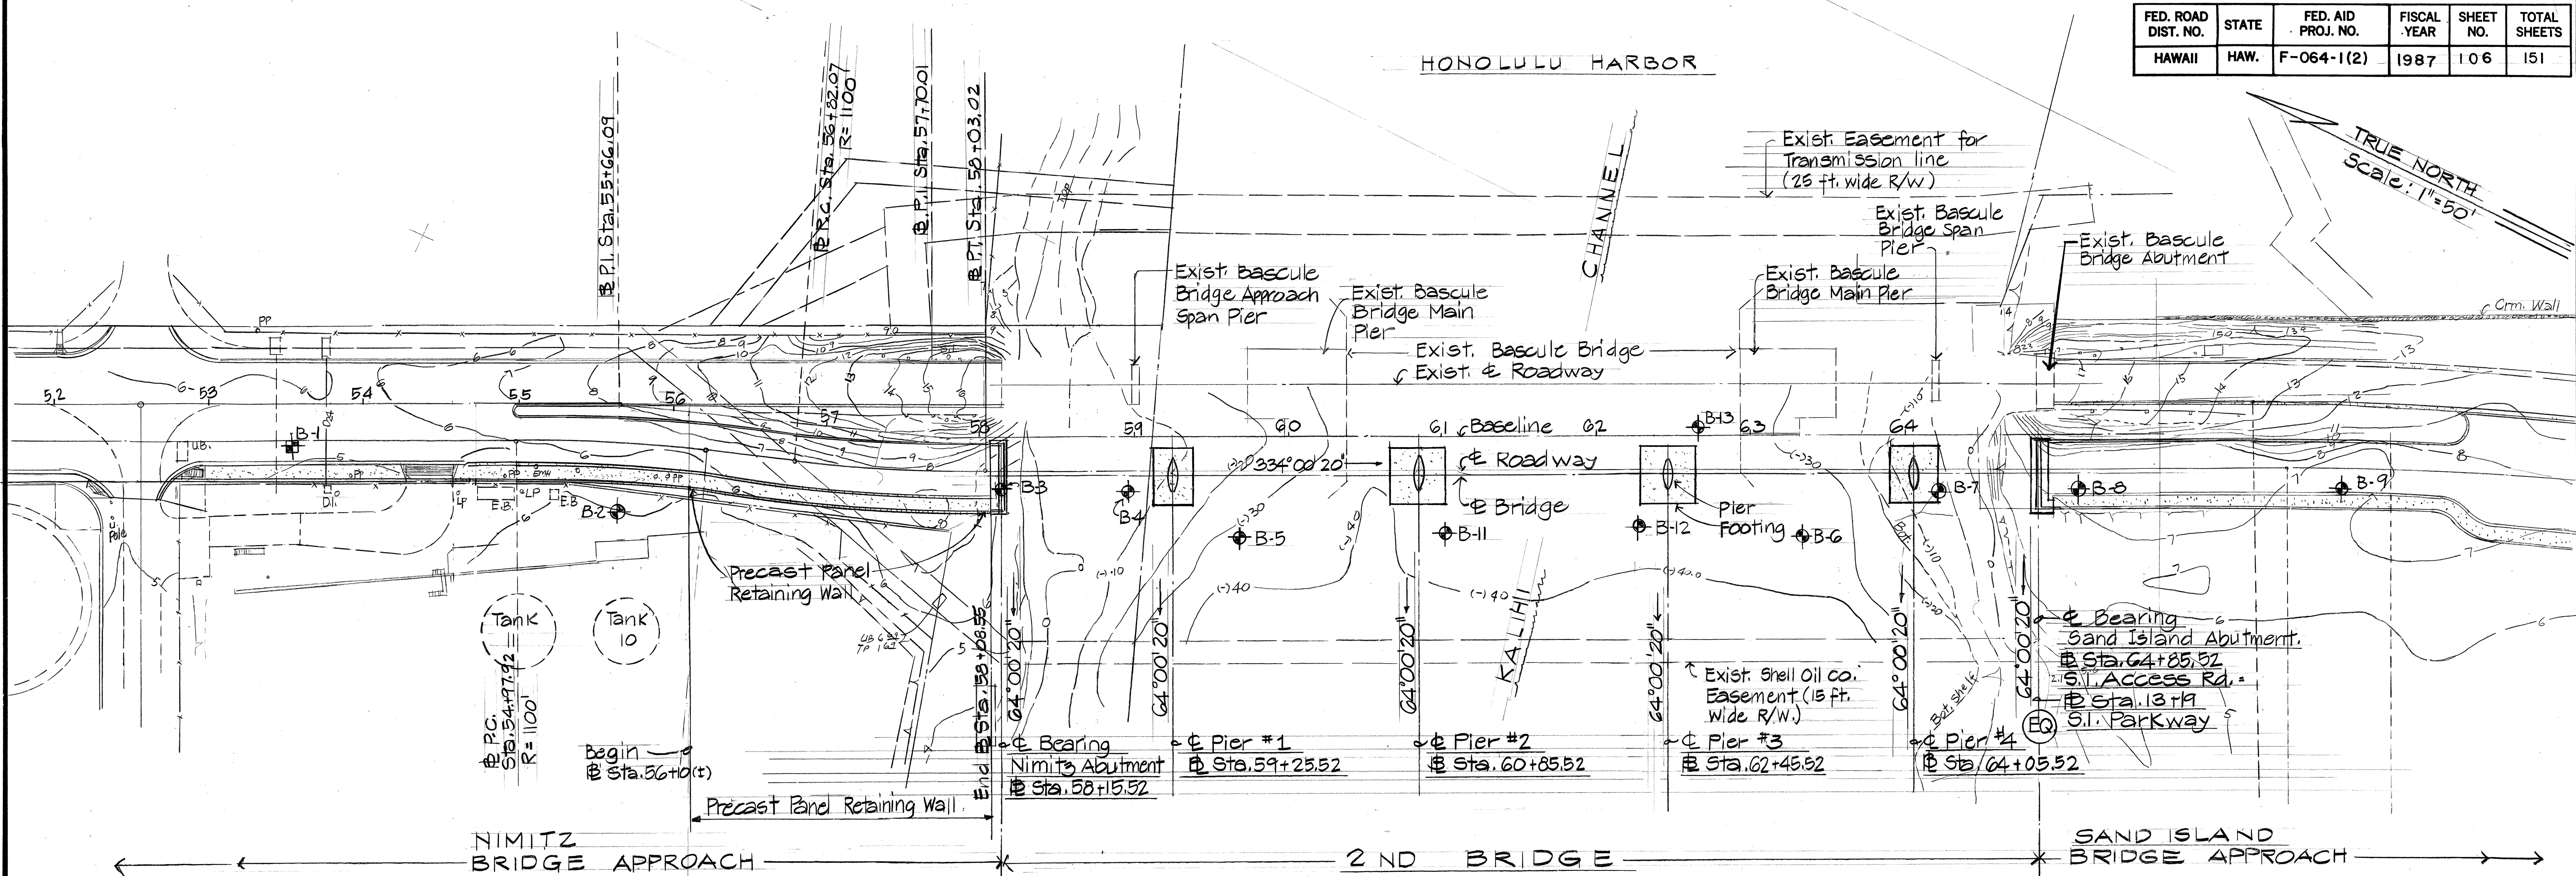

2ND. BRIDGE FOUNDATION PLAN
Scale: 1" = 50'

- Notes**
1. All Elevations are referenced to Mean Sea Level (M.S.L.)
 2. All Stations are referenced to Roadway Baseline (BL), unless otherwise noted.
 3. B-3 Denotes Boring #3, See Boring Logs on Sheets BL-1, BL-2, BL-3, & BL-4.
 4. Pier Footing: For Details see Sheet S-10
 5. Nimitz Abutment: For Plan and Sections see Sheet S-6.
 6. Sand Island Abutment: For Plan and Sections see Sheet S-7.
 7. B-1 Denotes Test Pit, see Sheet BL-2.

DATE	
DESIGNED BY	
TRACED BY	
QUANTITIES BY	
CHECKED BY	
ORIGINAL PLAN	
NOTE BOOK	
NO.	

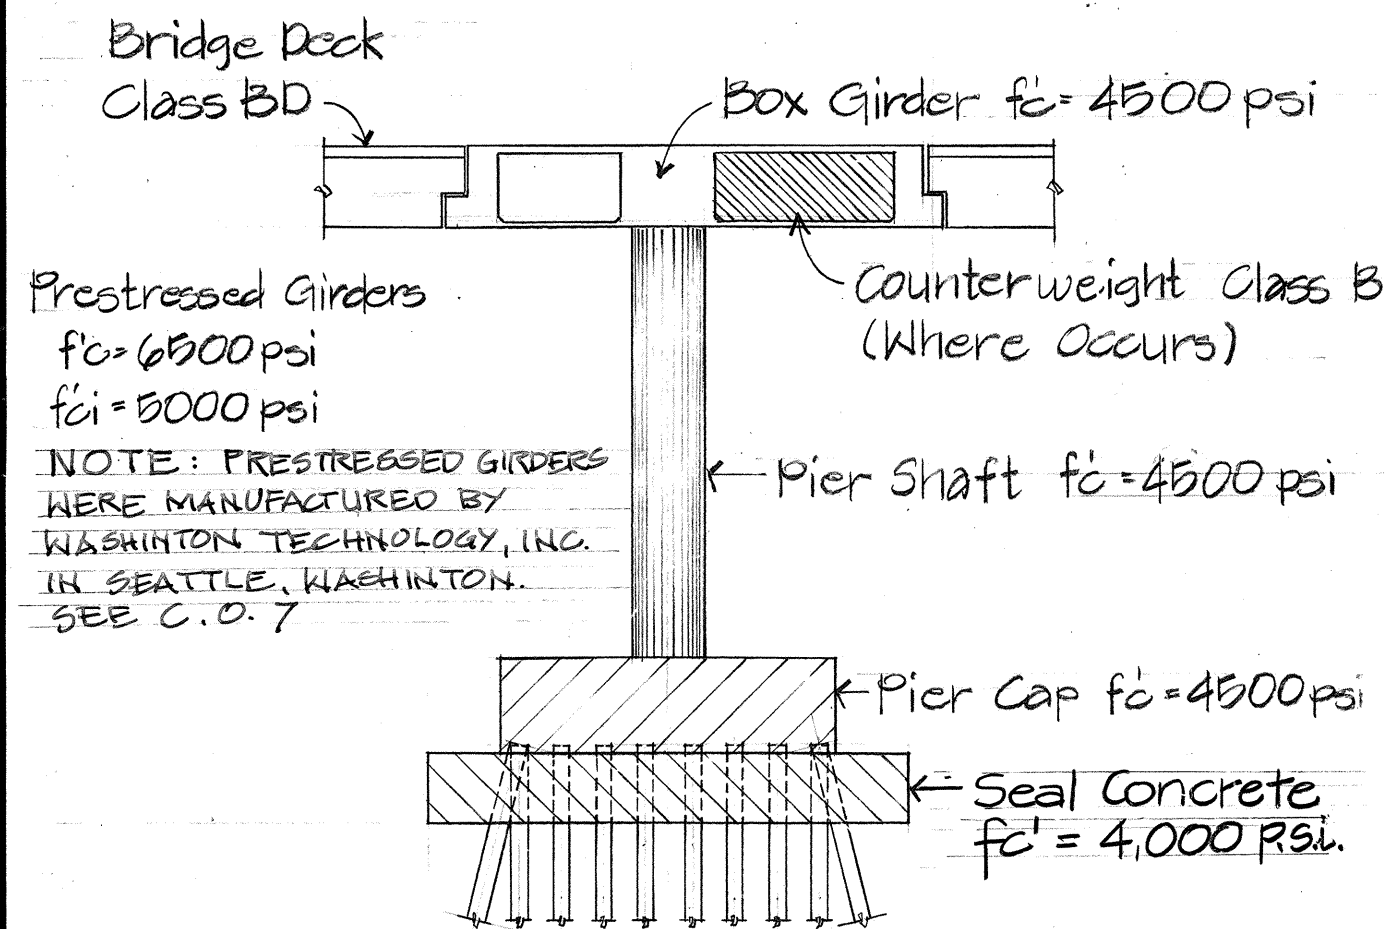


CONCRETE STRENGTH OF BRIDGE COMPONENTS
Not To Scale



THIS WORK WAS PREPARED BY ME OR UNDER MY SUPERVISION
Myron Okubo

STATE OF HAWAII DEPARTMENT OF TRANSPORTATION HIGHWAYS DIVISION FOUNDATION PLAN SAND ISLAND ROAD WIDENING 2ND. BRIDGE AND APPROACHES FEDERAL AID PROJECT NO. F-064-1(2)	
SCALE: 1" = 50' DATE: JUN, 1986 SHEET NO. 5-4 OF 30 SHEETS	DATE REVISION

FED. ROAD DIST. NO.	STATE	FED. AID PROJ. NO.	FISCAL YEAR	SHEET NO.	TOTAL SHEETS
HAWAII	HAW.	F-064-1(2)	1987	107	151

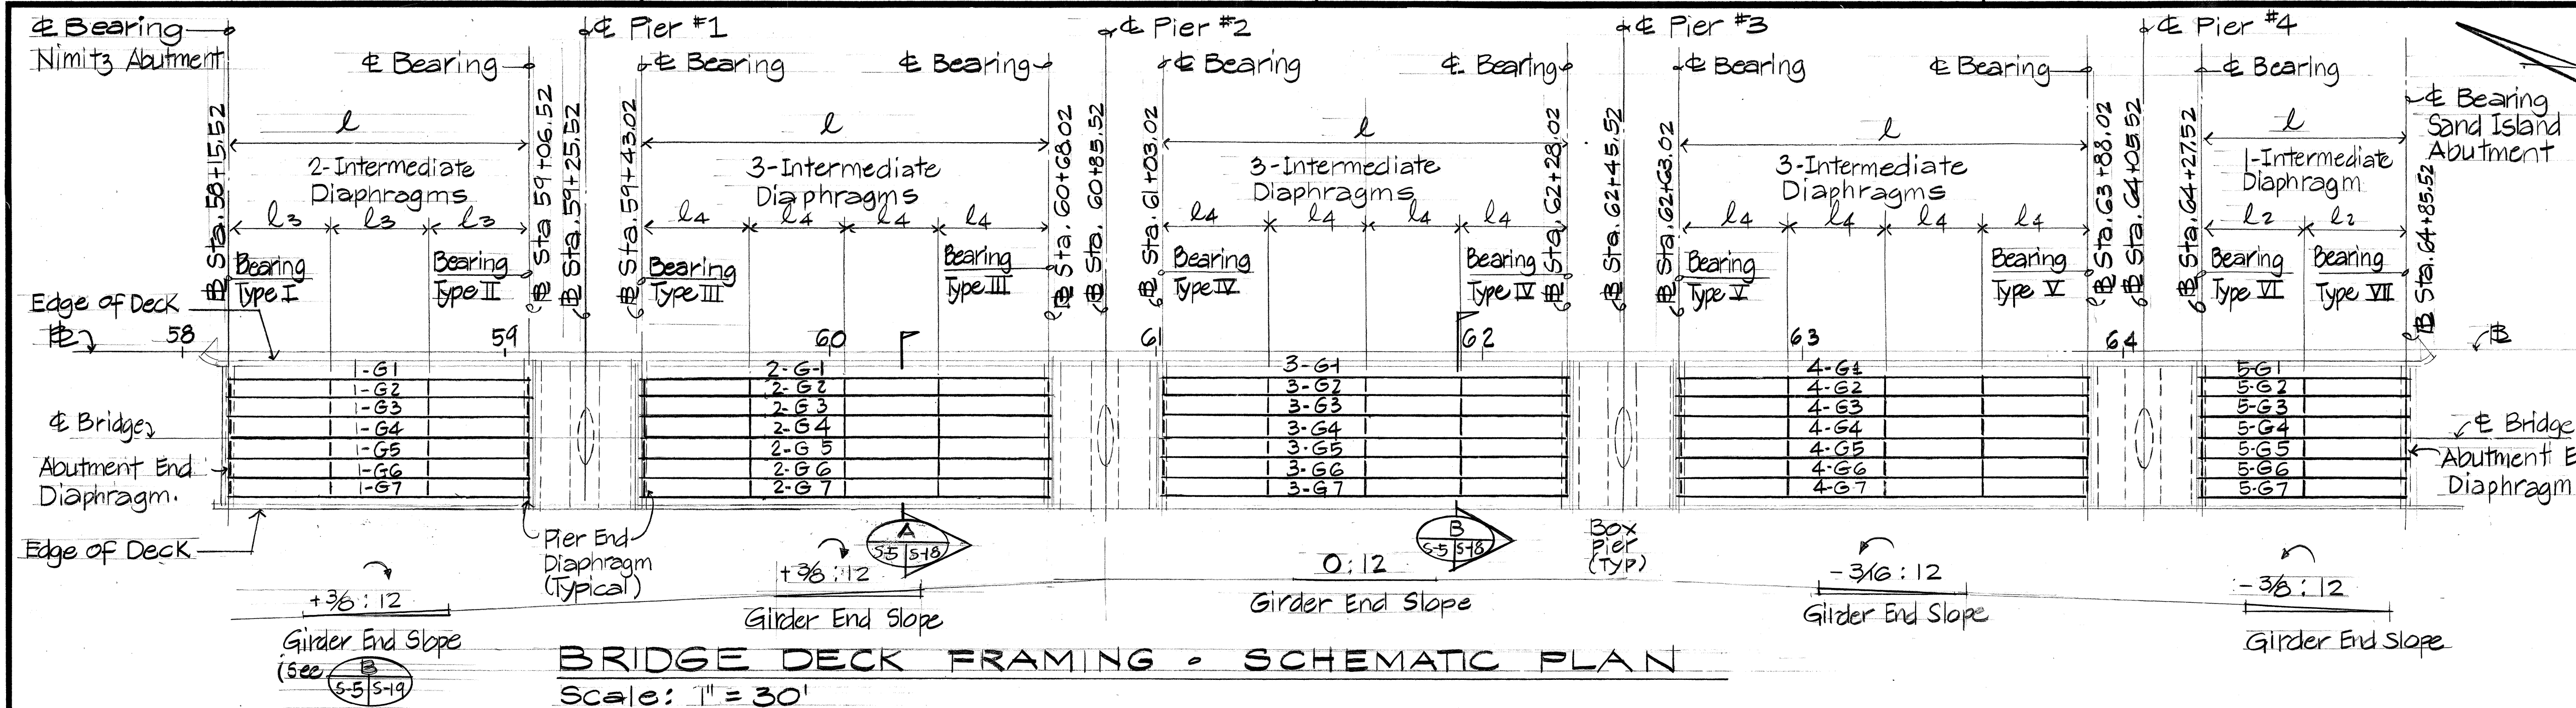

- Notes:
- Bridge Deck: For Reinf. and Details, see Typical Deck Section on Sheet S-18
 - Box Pier: For Reinf. and Details, see Sheet S-12, S-13, S-14 & S-15.
 - Abutment End Diaphragm: For Details, see Sheet S-8
 - End Diaphragm at Box Pier: For Details, see Sheet S-17
 - Intermediate Diaphragm: For Details, see Sheet S-18

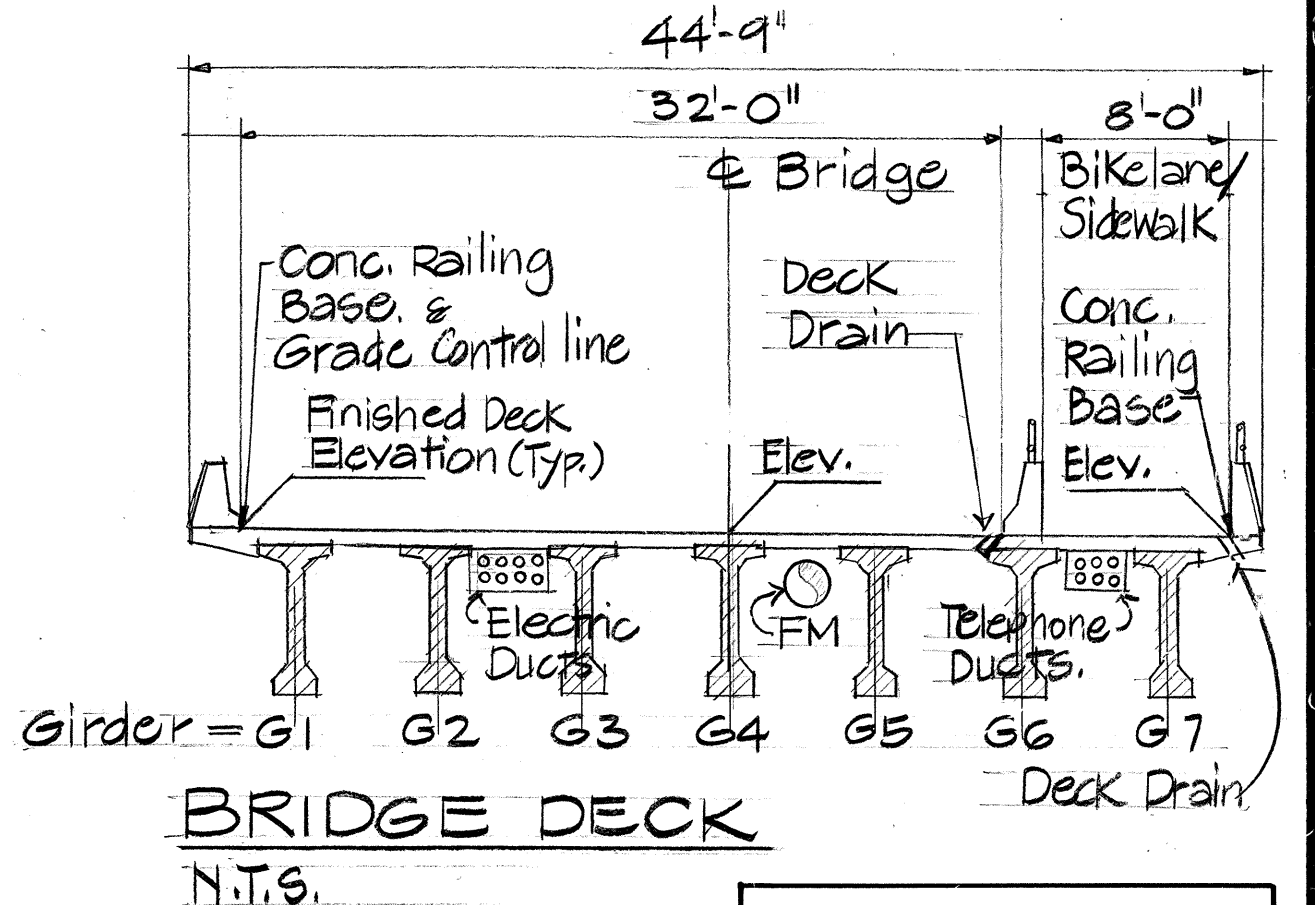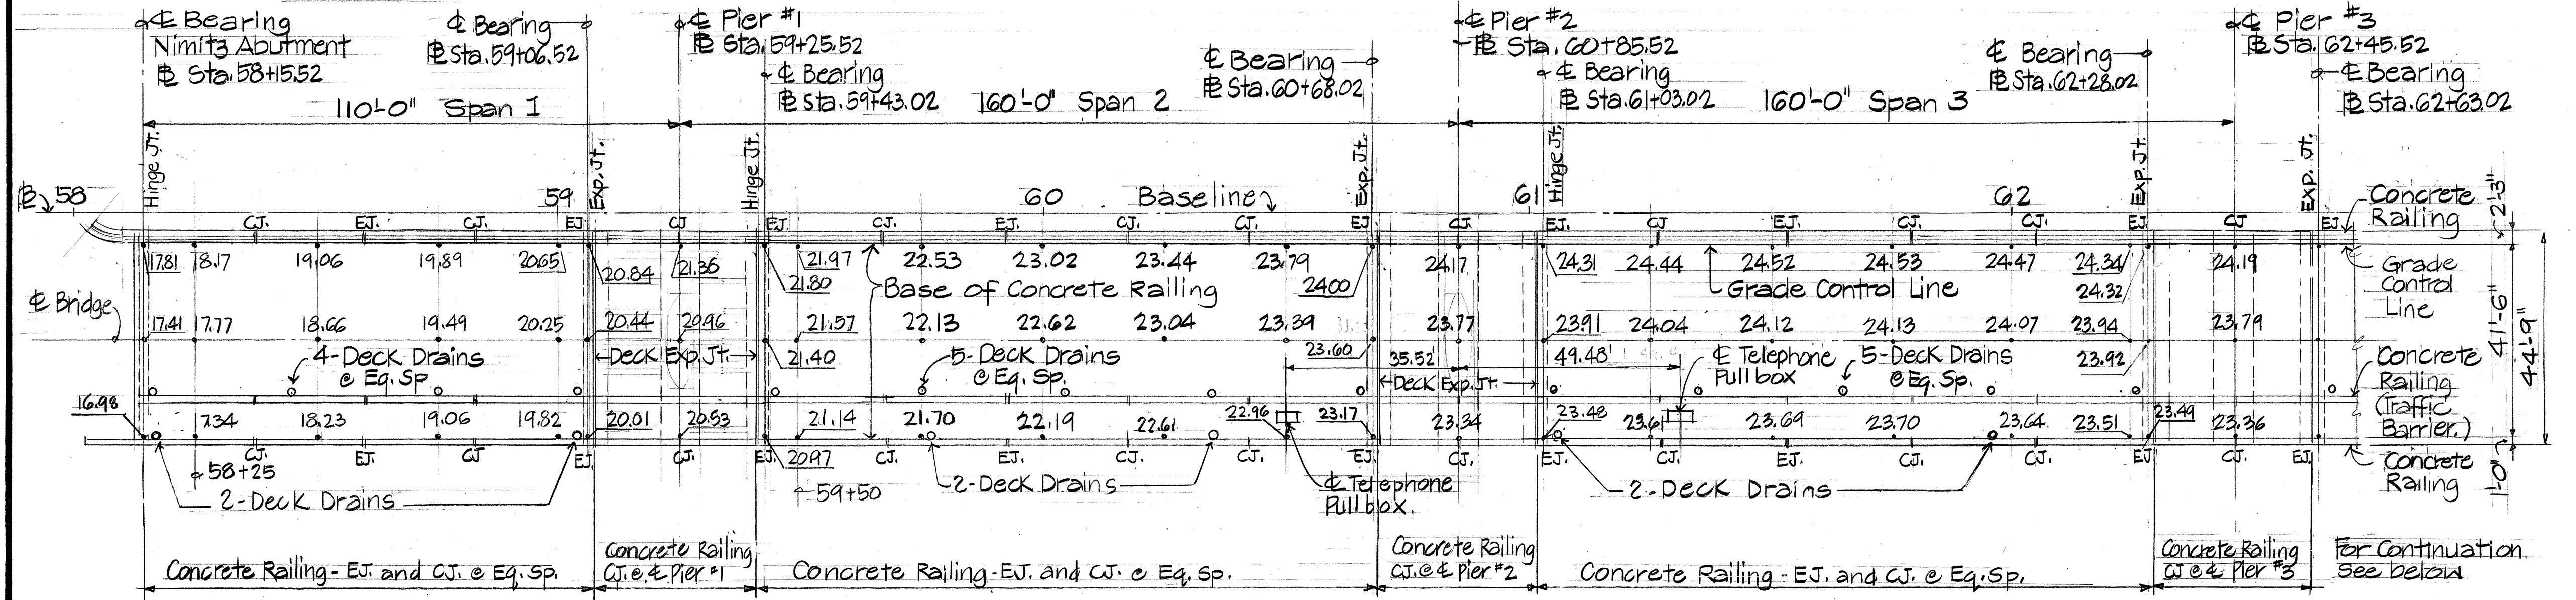

- Notes:
- Finished Deck Elevations: Given at 25' intervals along Baseline unless noted otherwise.
 - Deck Drains: As shown. See Details on Sht. S-120
 - For Concrete Railing Joints Details see Sht. S-23

Symbol/Abbreviation	Description
6"p Deck Drain, Typ.	
Finish Deck Elevation	
Construction Joint at Concrete Railing	
Expansion Joint at Concrete Railing	



THIS WORK WAS PREPARED BY ME OR UNDER MY SUPERVISION


Myron Okubo

STATE OF HAWAII
DEPARTMENT OF TRANSPORTATION
HIGHWAYS DIVISION
DECK FRAMING PLAN & DECK ELEVATIONS
SAND ISLAND ROAD WIDENING
2ND. BRIDGE AND APPROACHES
FEDERAL AID PROJECT NO. F-064-1(2)

SCALE: AS NOTED. DATE: JUN, 1986
SHEET NOS. 5 OF 30 SHEETS

DATE	REVISION
9/1/87	Rev. Finished Deck Elev. Plan. Deck Drain Size callout

FED. ROAD DIST. NO.	STATE	FED. AID PROJ. NO.	FISCAL YEAR	SHEET NO.	TOTAL SHEETS
HAWAII	HAW.	F-064-1(2)	1987	108	151

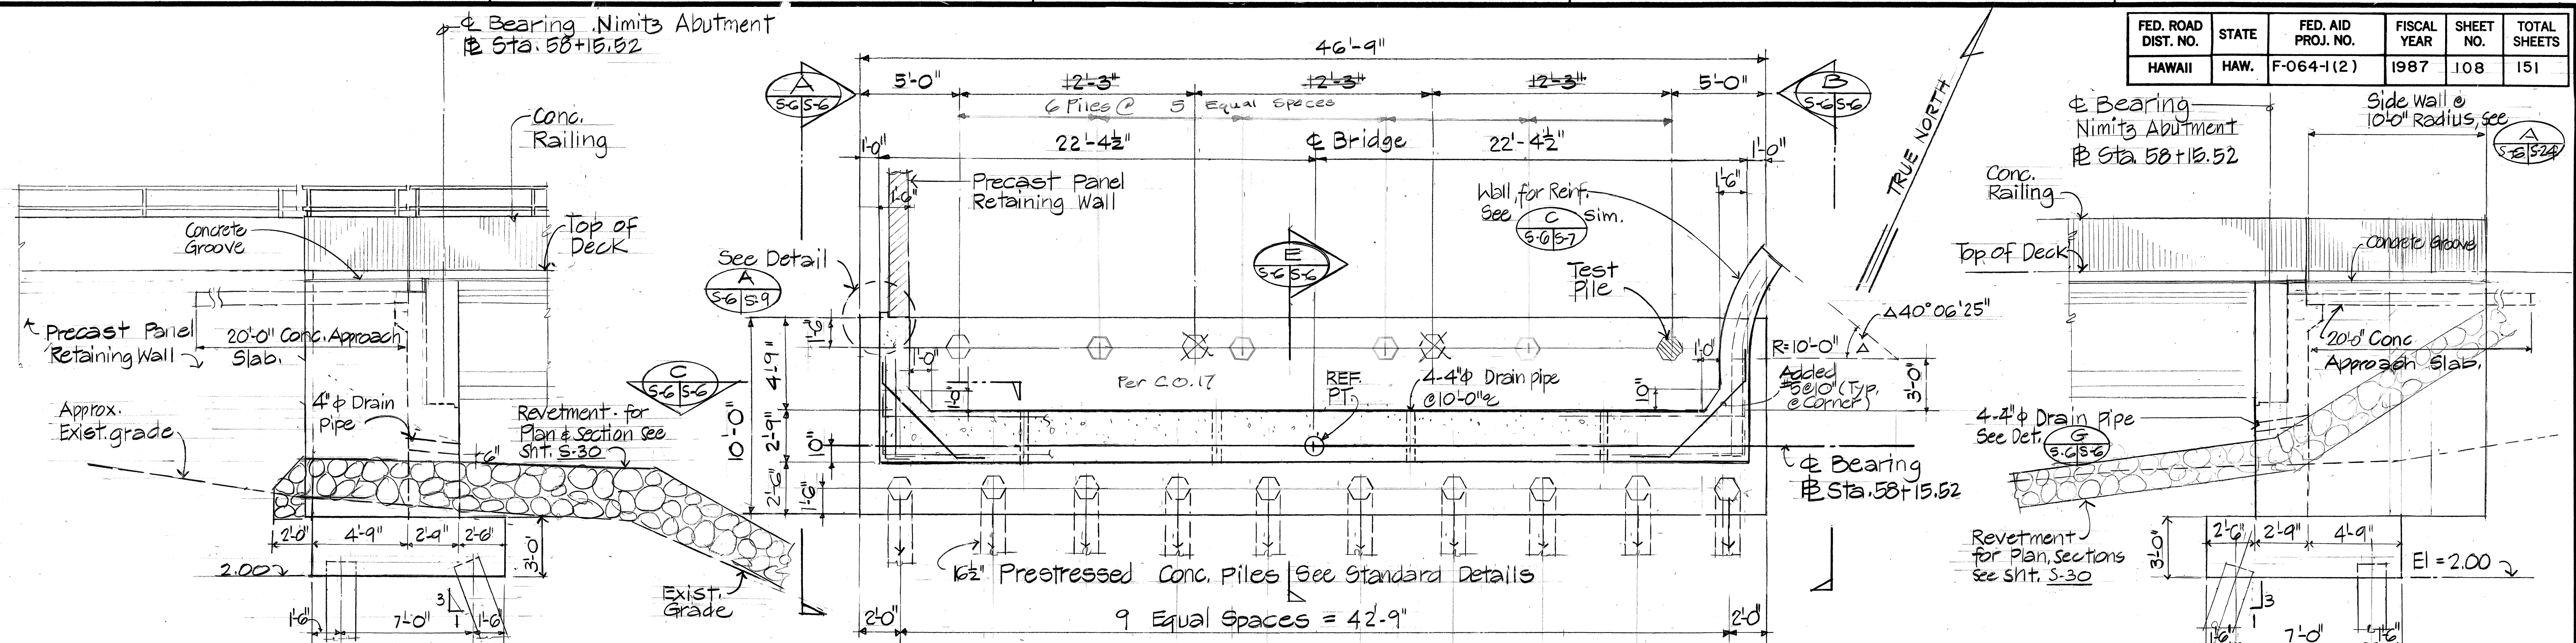

SIDE WALL ELEVATION A


Scale: 1/4" = 1'-0"

NIMITZ ABUTMENT FOUNDATION PLAN

Scale: 1/4" = 1'-0"

SIDE WALL ELEVATION B

Scale: 1/4" = 1'-0"

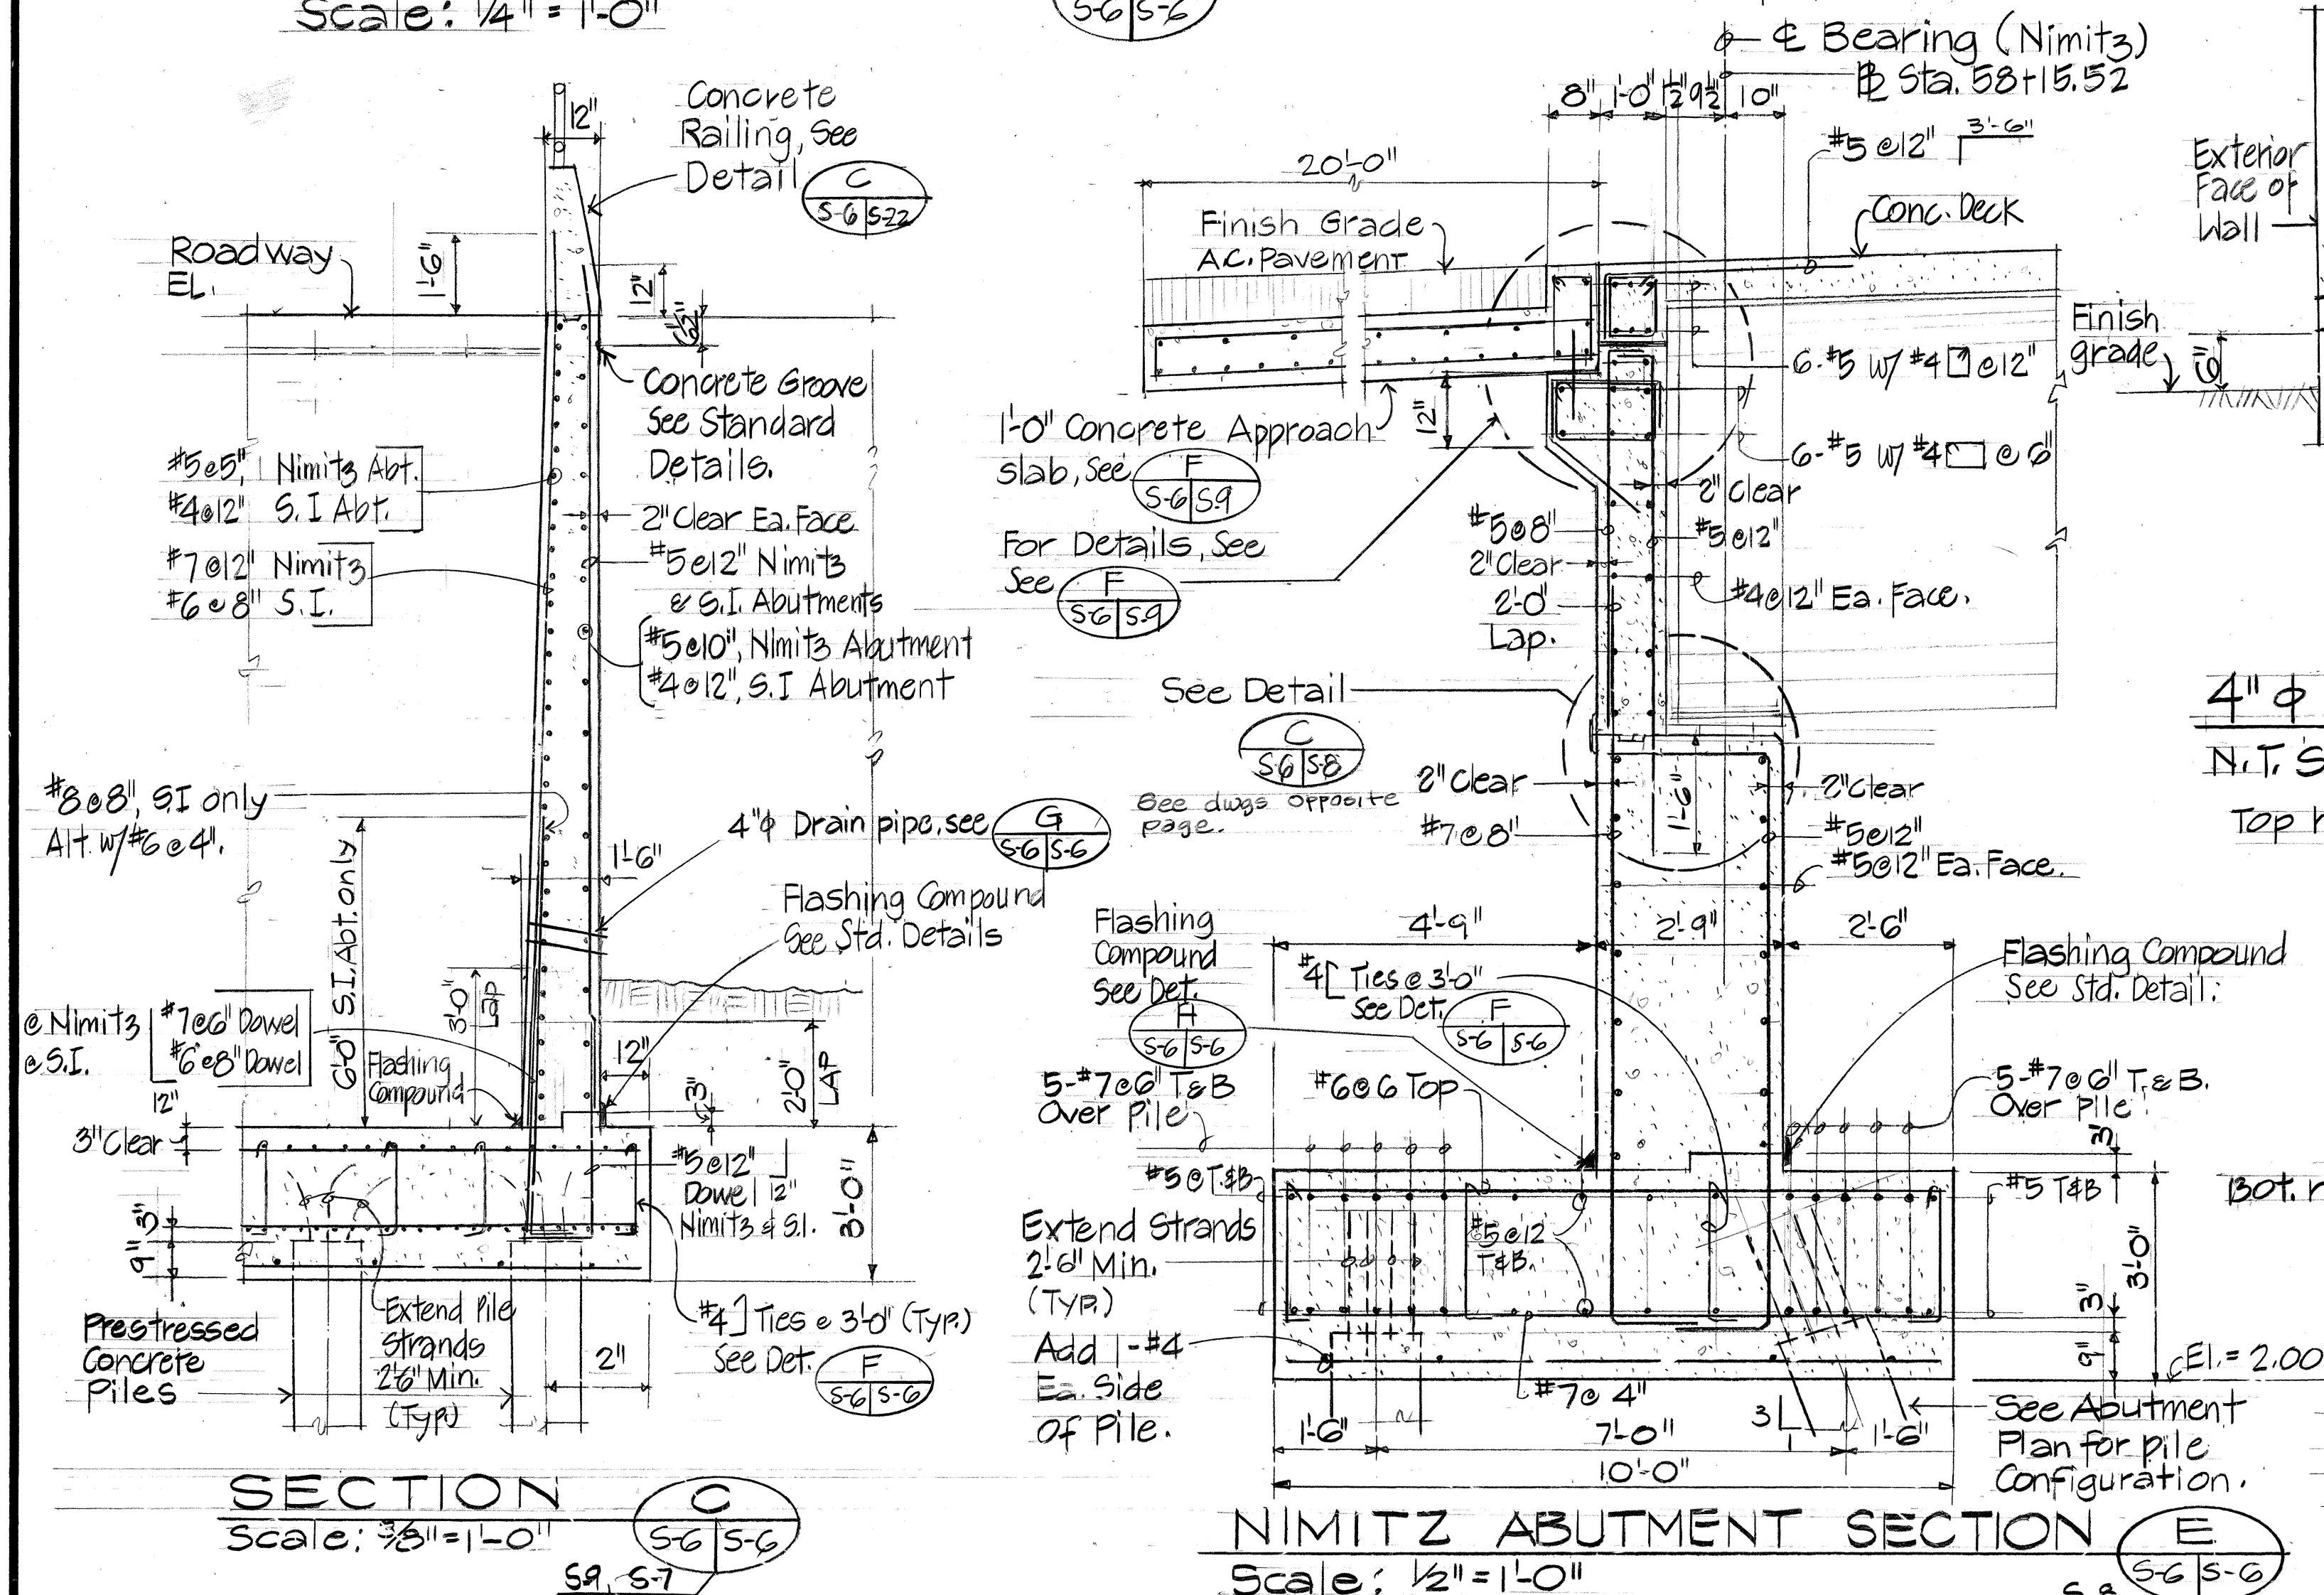


SECTION C

Scale: 3/8" = 1'-0"

NIMITZ ABUTMENT SECTION E

Scale: 1/2" = 1'-0"

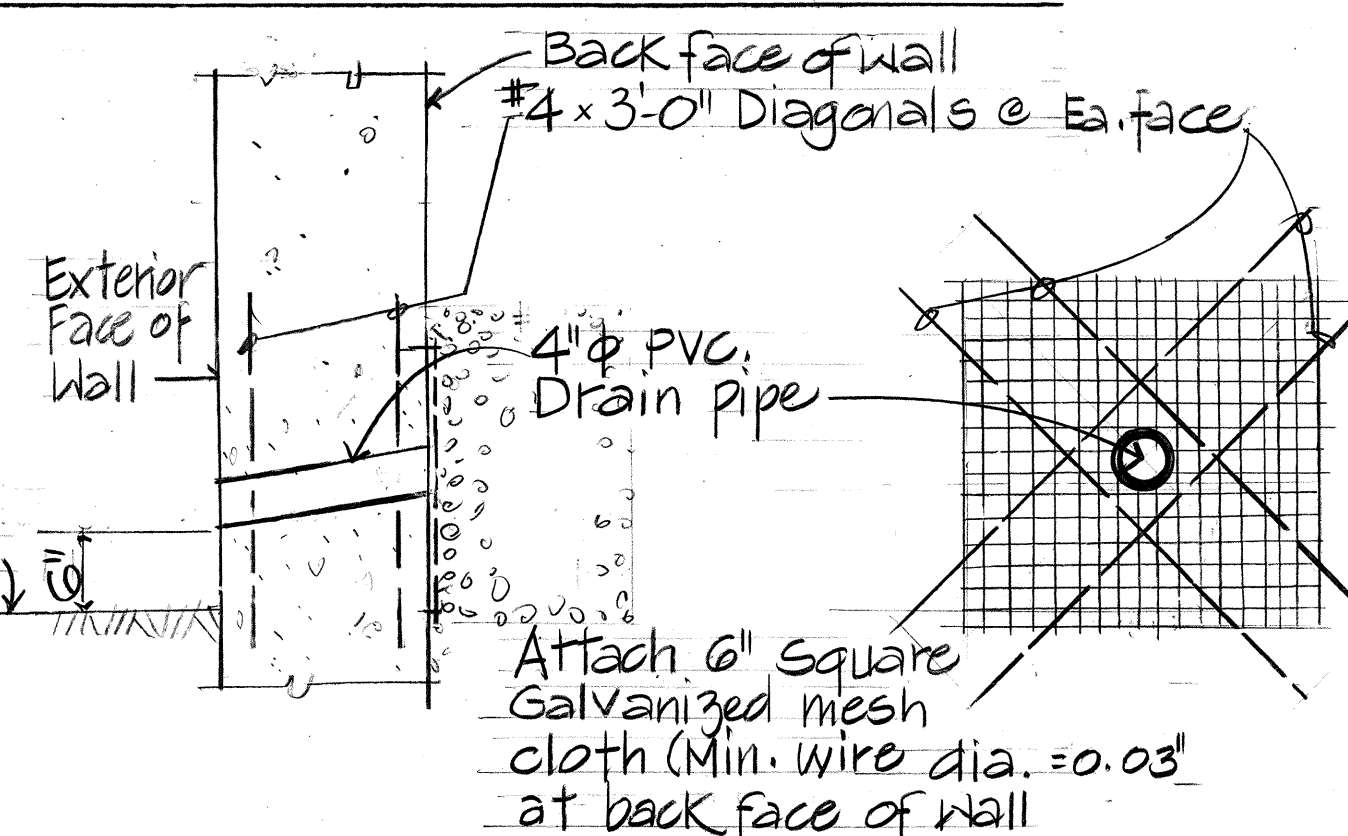

4\"/>

N.T.S.

S-7 S-6 S-6

FLASHING COMPOUND AT CORNER DETAIL



N.T.S.

S-9 S-6 S-6

TIE BAR DETAIL F

N.T.S.

S-10 S-7 S-6 S-6

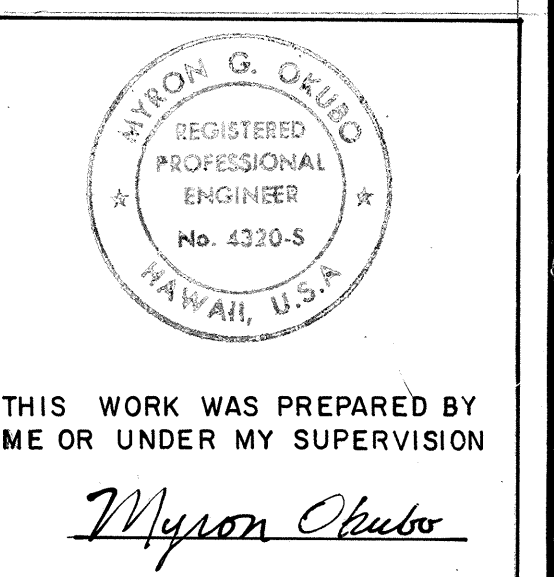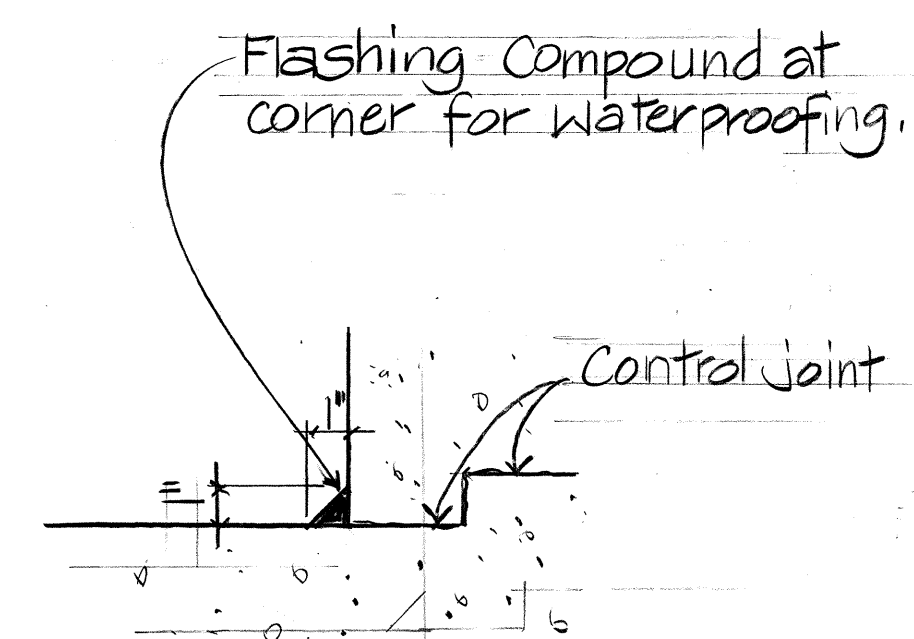

STATE OF HAWAII
DEPARTMENT OF TRANSPORTATION
HIGHWAYS DIVISION


NIMITZ ABUTMENT

SAND ISLAND ROAD WIDENING
2ND BRIDGE AND APPROACHES
FEDERAL AID PROJECT NO. F-064-1(2)


SCALE: AS NOTED. DATE: JUN, 1986
SHEET NO. S-6 OF 30 SHEETS

"AS-BUILT"

FED. ROAD DIST. NO.	STATE	FED. AID PROJ. NO.	FISCAL YEAR	SHEET NO.	TOTAL SHEETS
HAWAII	HAW.	F-064 (2)	1987	109	151

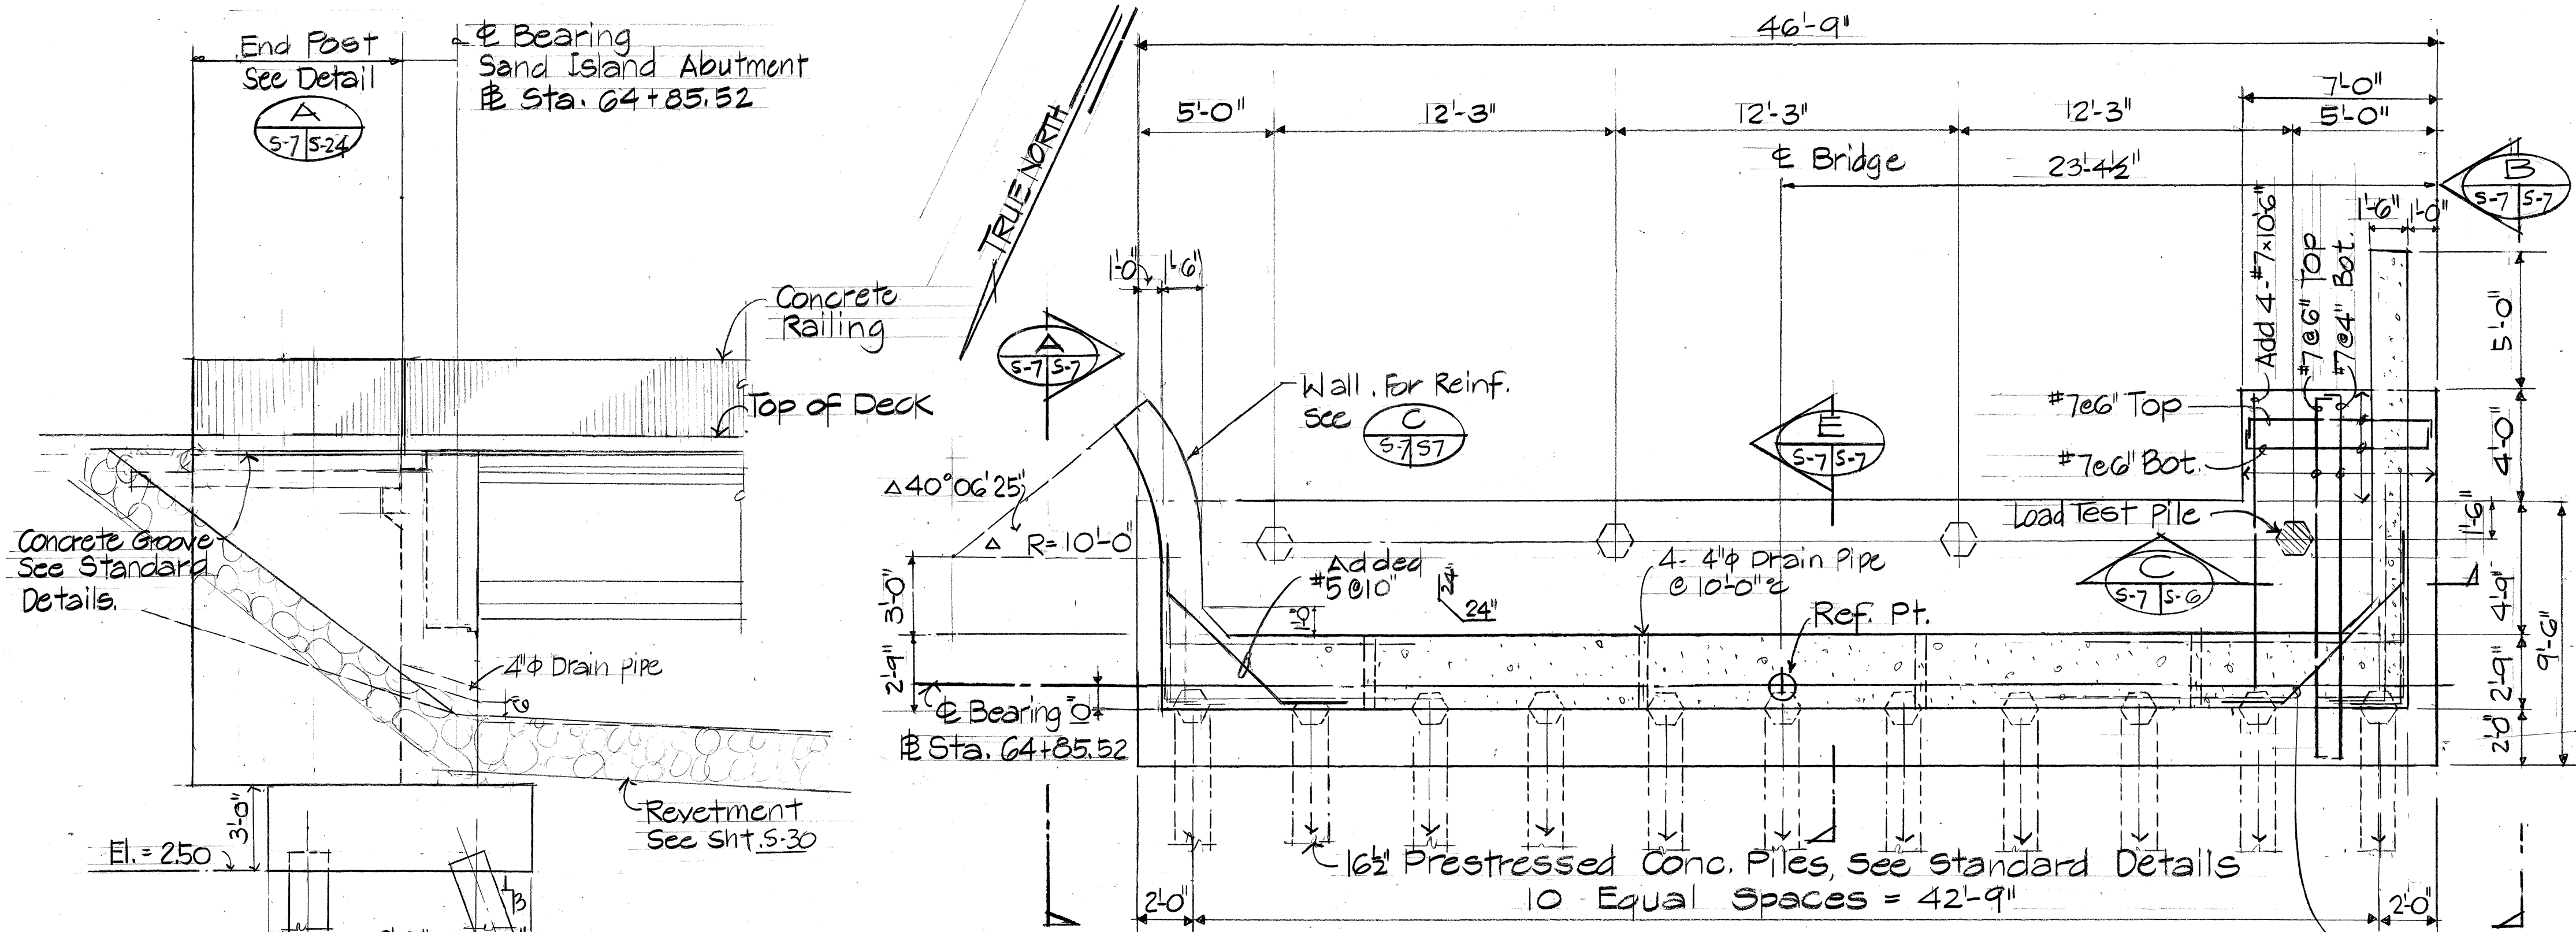


SIDE WALL ELEVATION A
Scale: 1/4" = 1'-0"
S-7/S-7

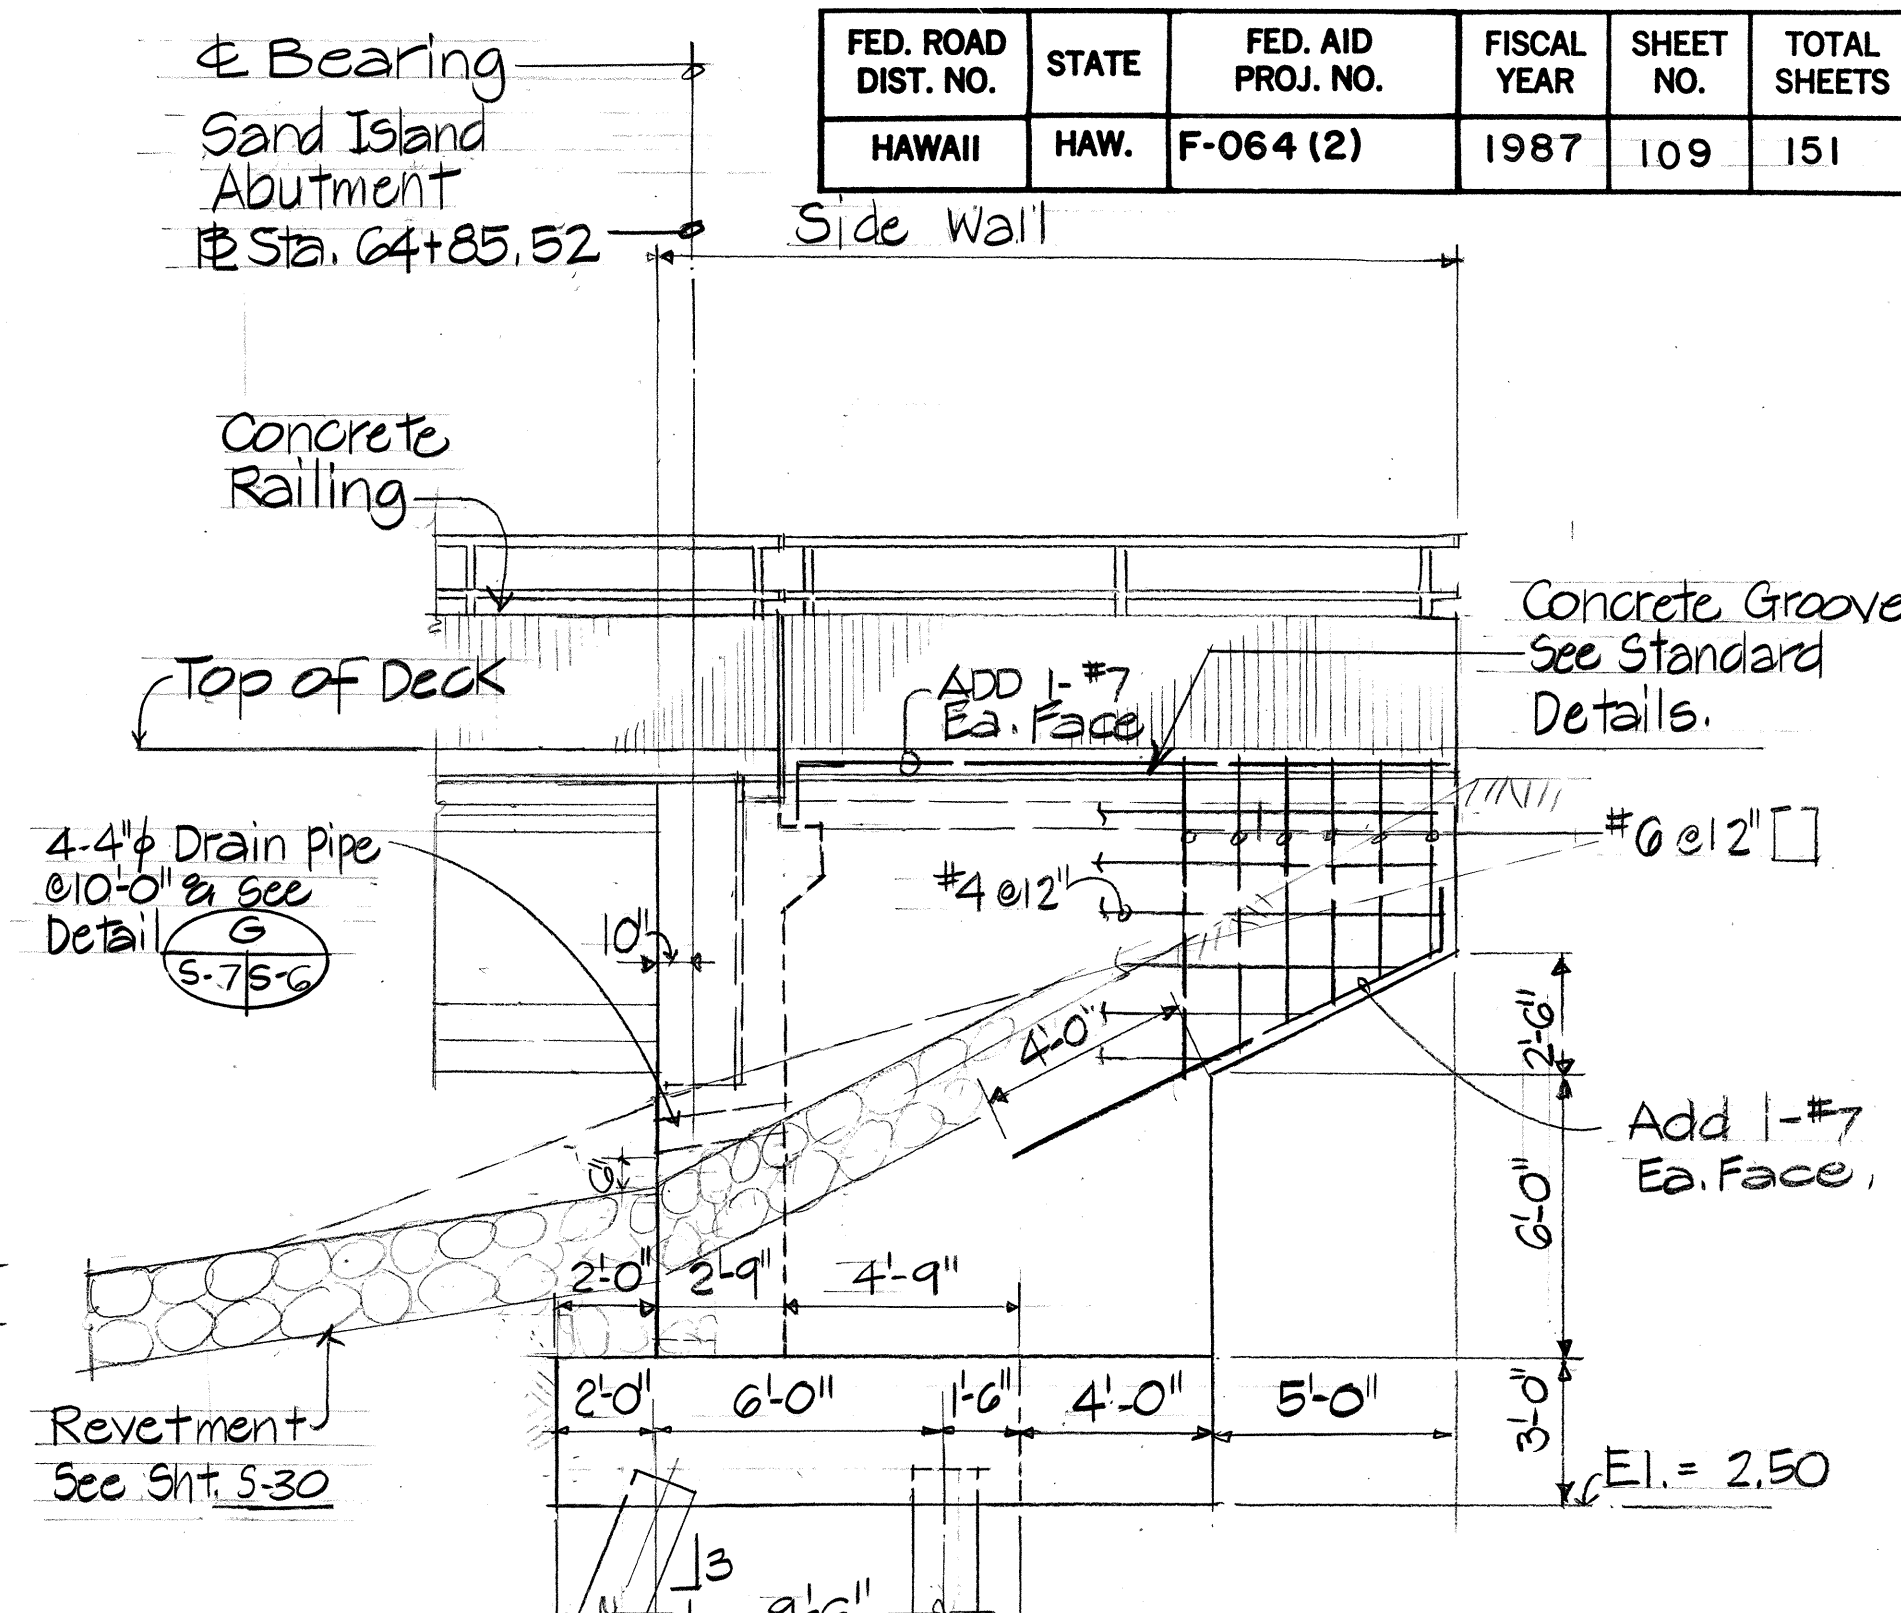


SIDE WALL ELEVATION B
Scale: 1/4" = 1'-0"
S-7/S-7


SAND ISLAND ABUTMENT FOUNDATION PLAN
Scale: 1/4" = 1'-0"

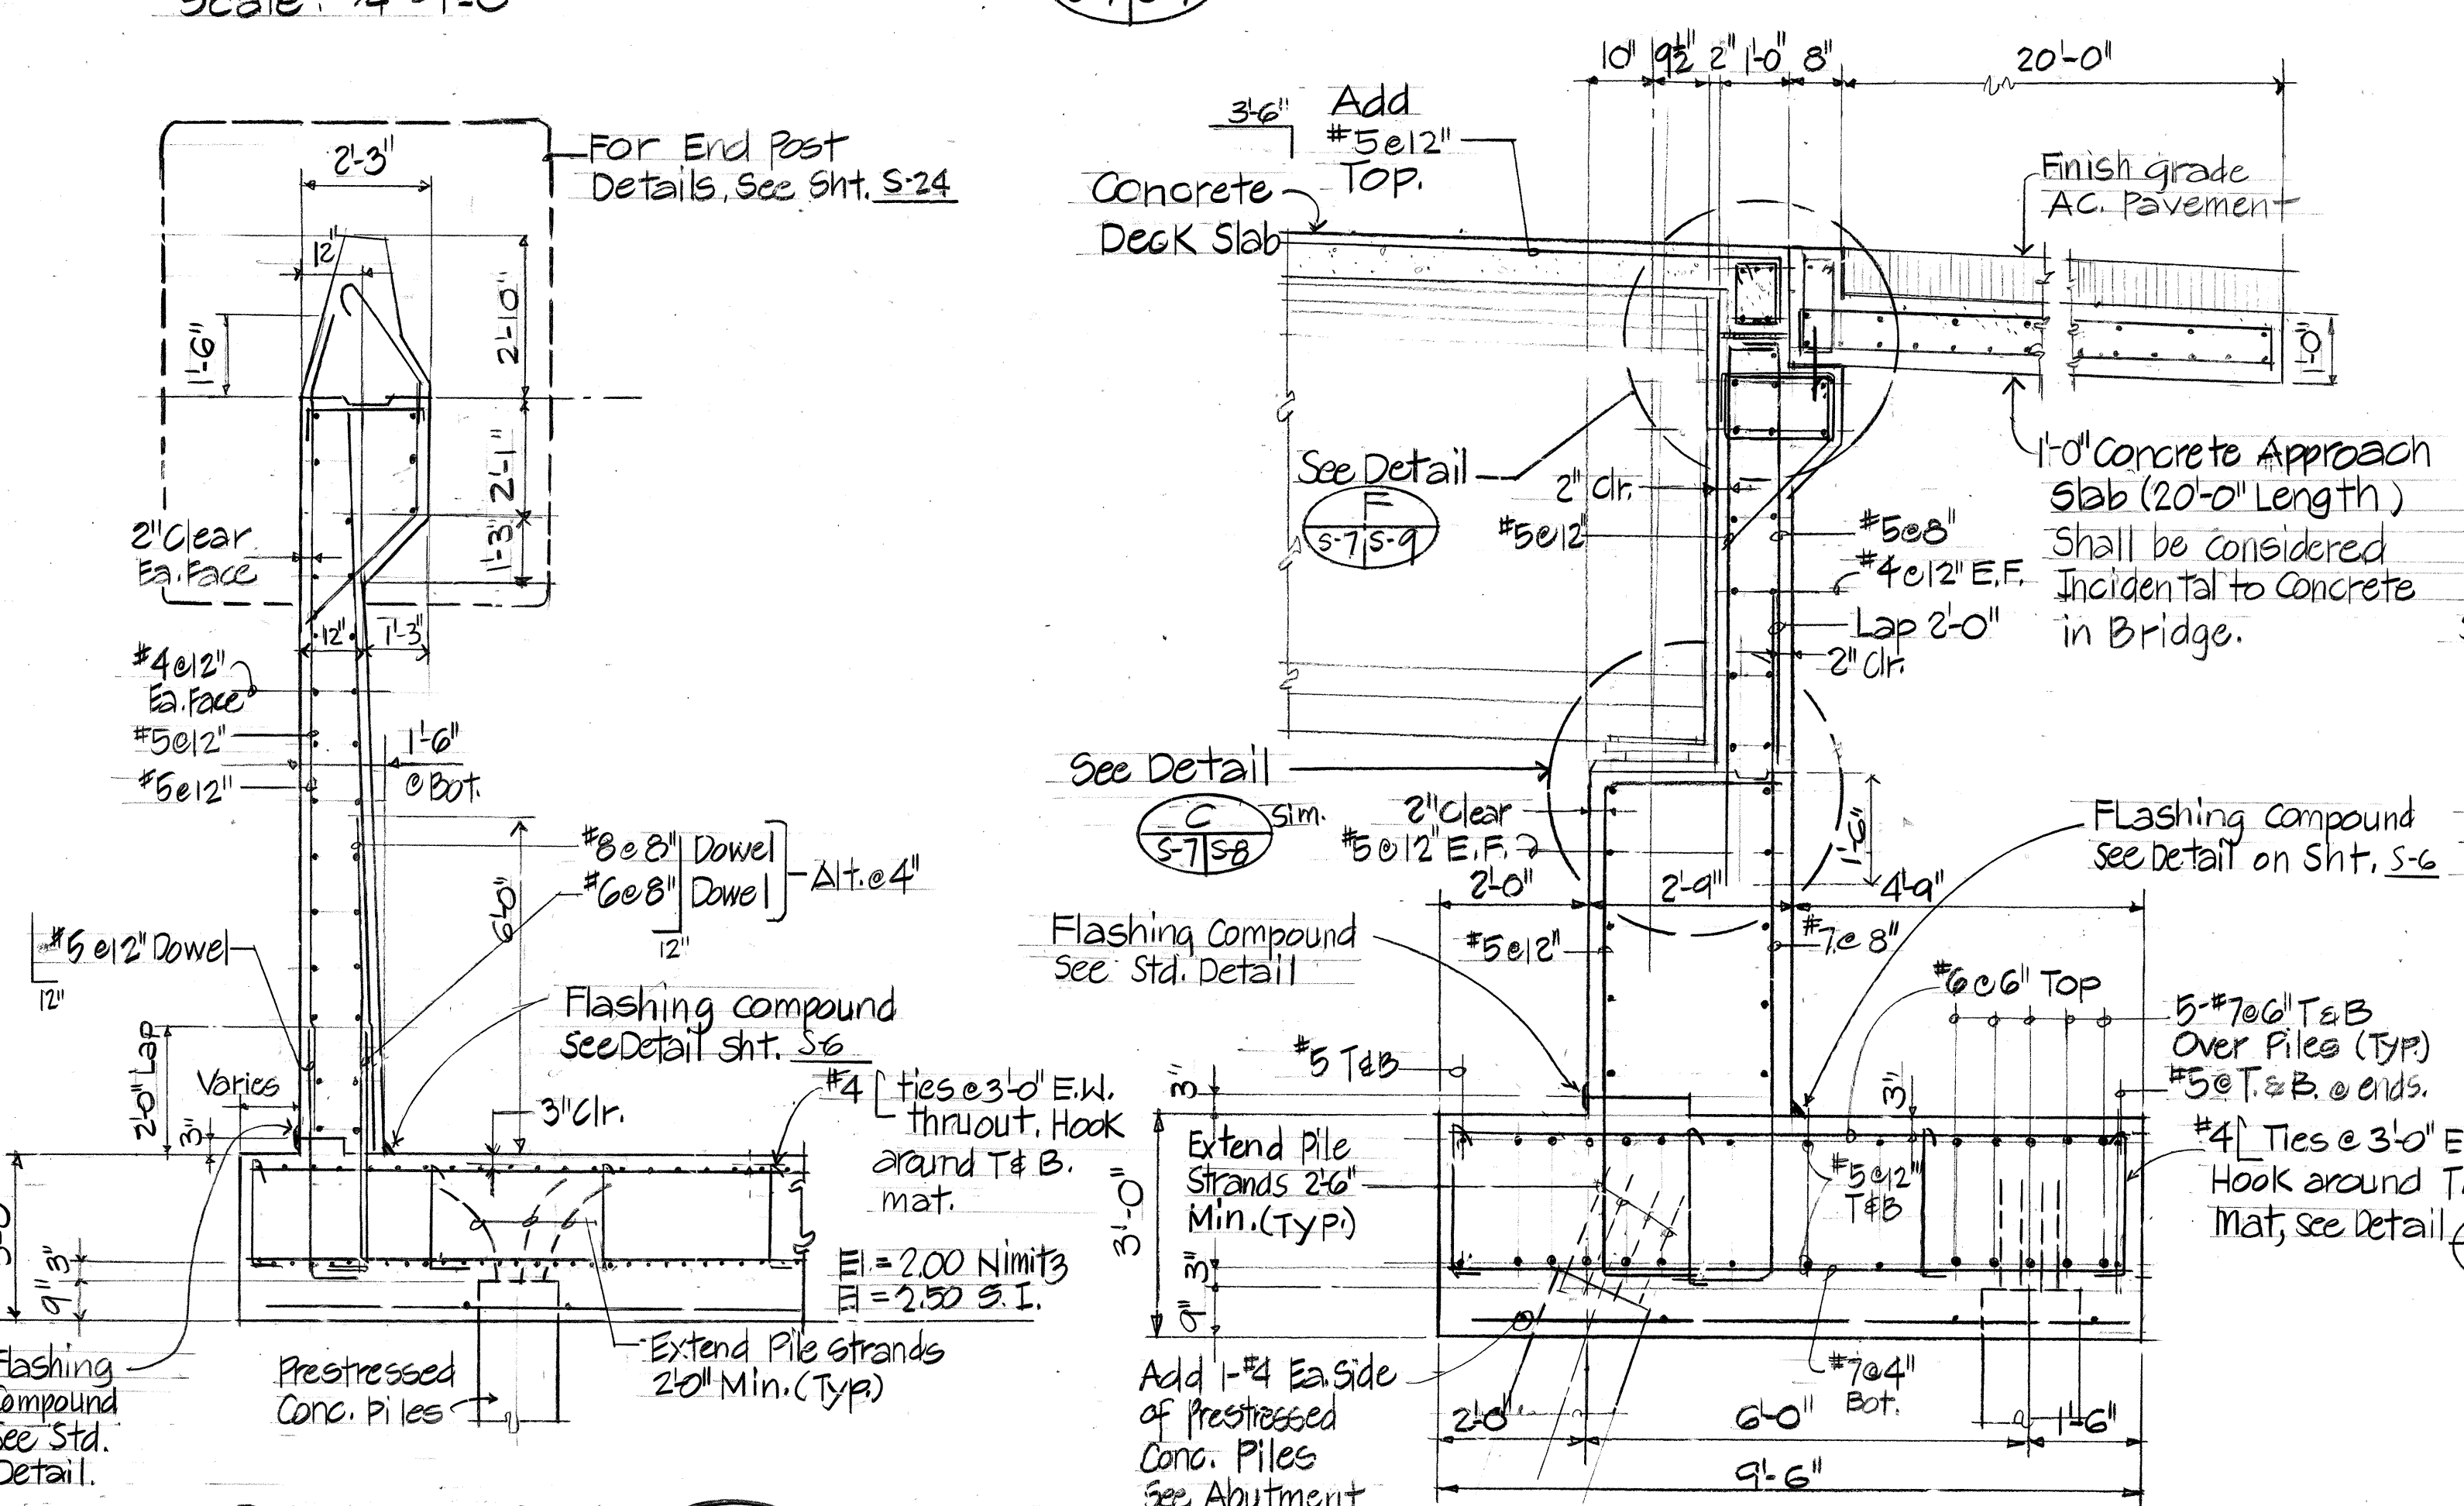

SECTION C
Scale: 3/8" = 1'-0"
S-7/S-7

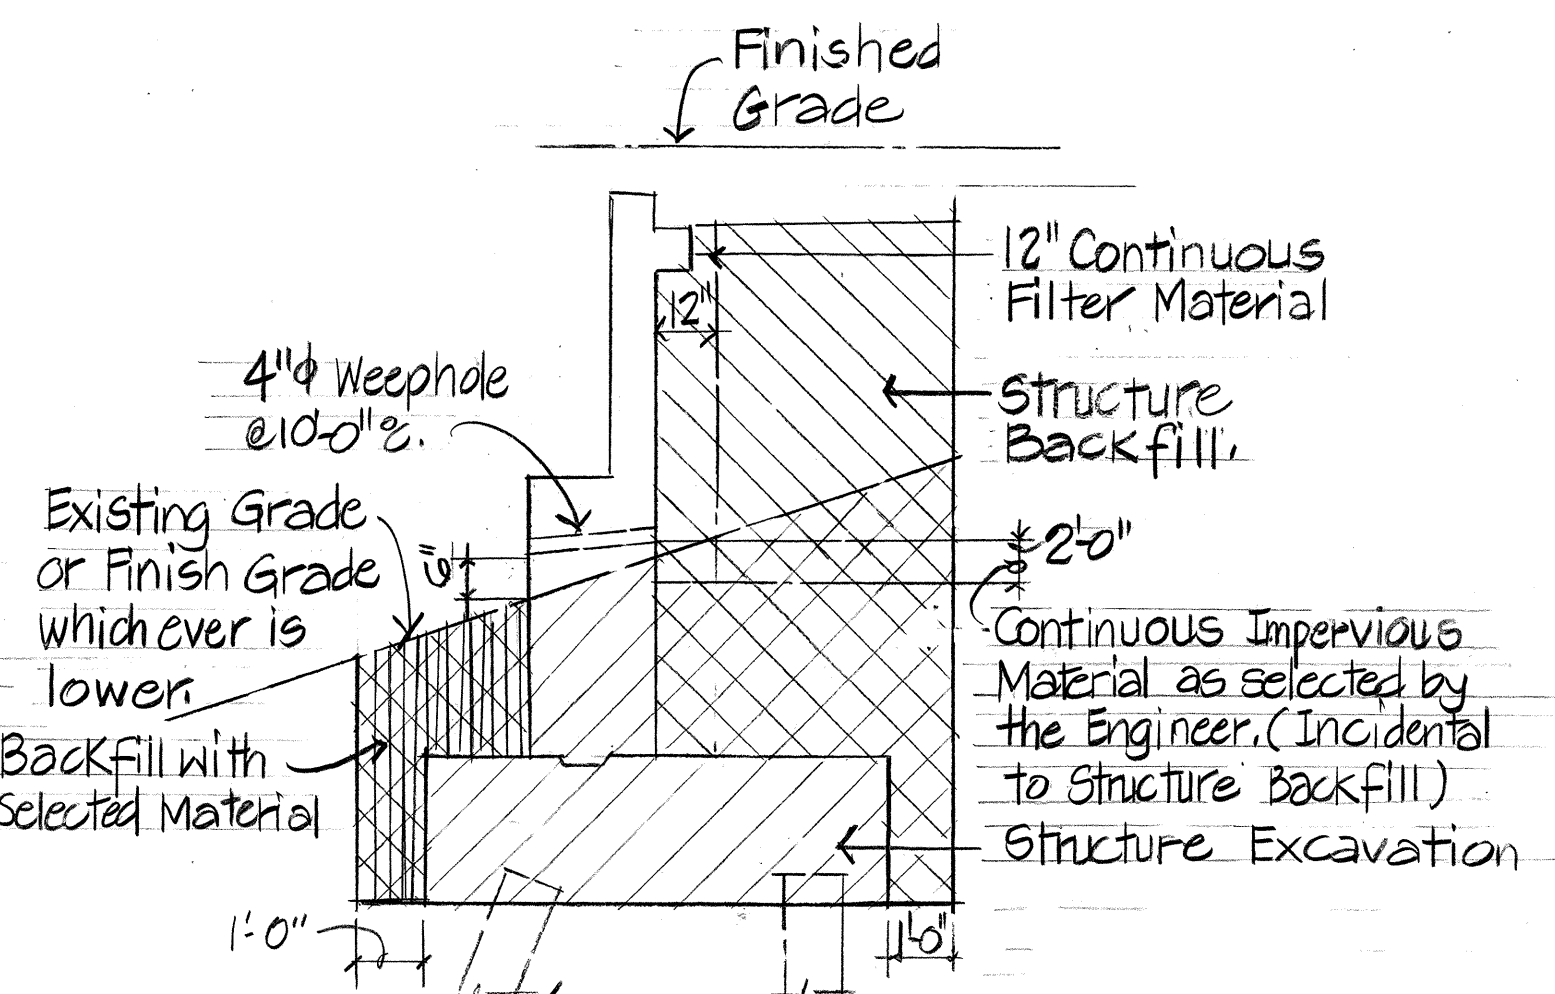

EXCAVATION/BACK FILL PAY LINE
No Scale:
For Nimitz and Sand Island Abutment
S-7/S-7

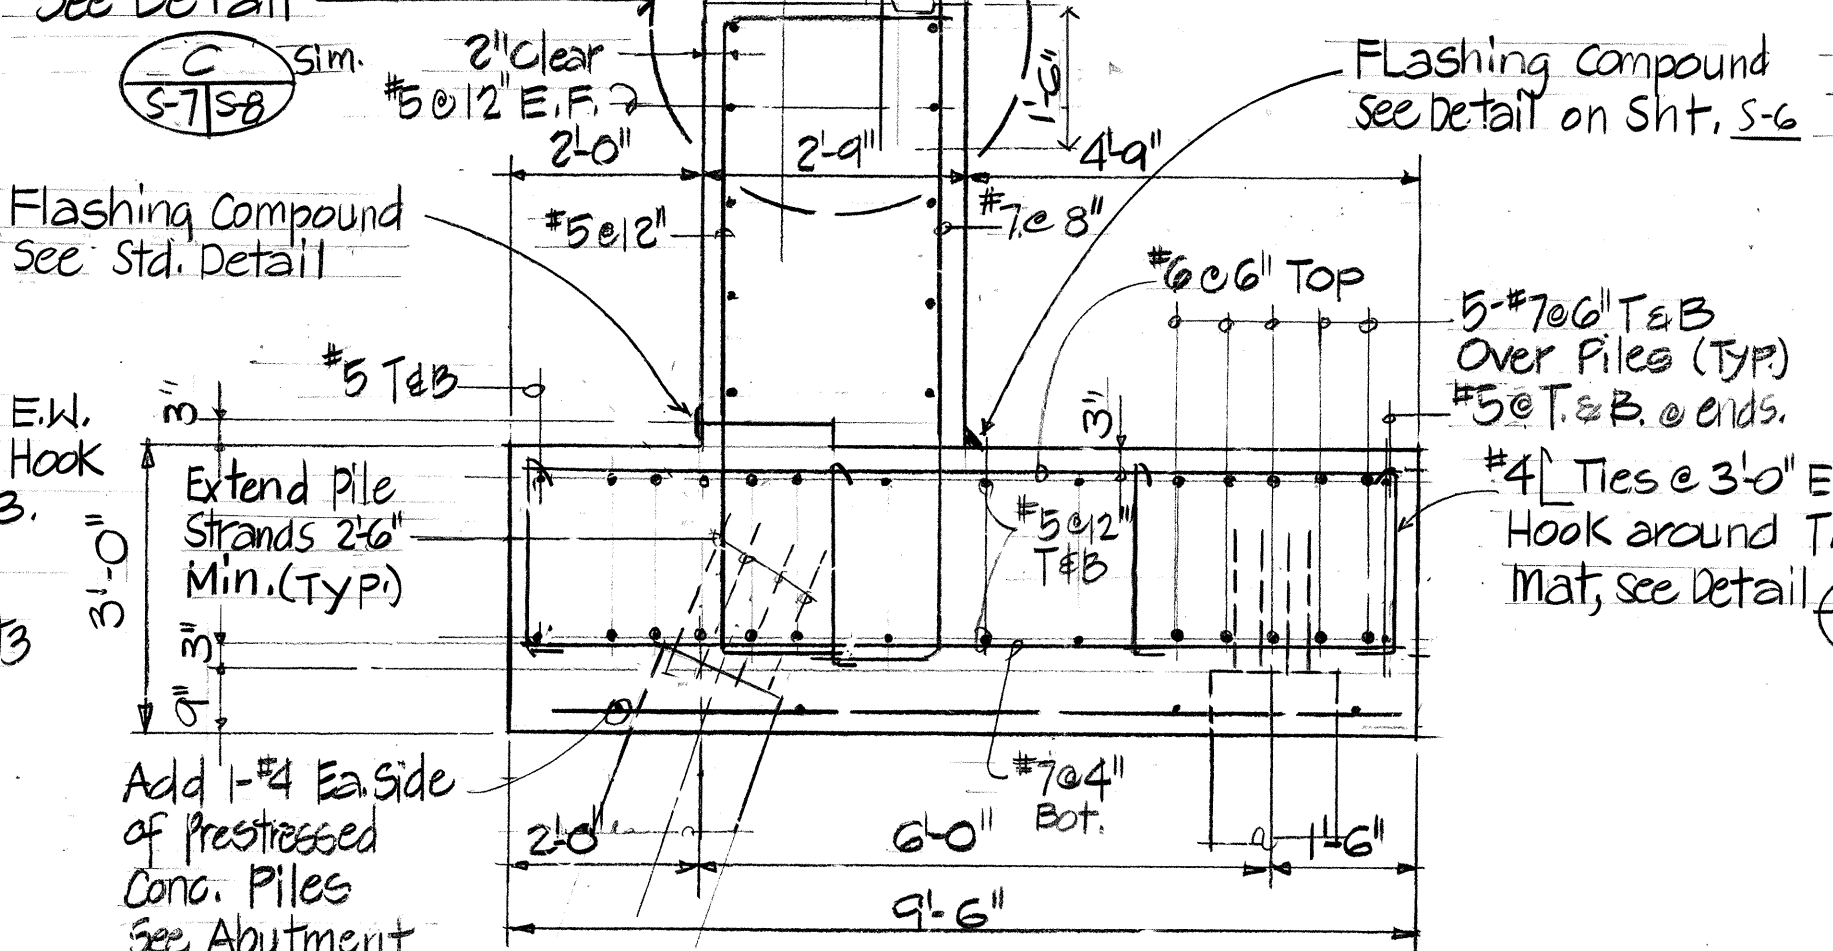

SAND ISLAND ABUTMENT SECTION E
Scale: 1/2" = 1'-0"
S-7/S-7


MYRON G. OKUNO
REGISTERED PROFESSIONAL ENGINEER
No. 4320-S
HAWAII, U.S.A.
THIS WORK WAS PREPARED BY ME OR UNDER MY SUPERVISION
Myron Okuno

STATE OF HAWAII
DEPARTMENT OF TRANSPORTATION
HIGHWAYS DIVISION
SAND ISLAND ABUTMENT
SAND ISLAND ROAD WIDENING
2ND BRIDGE AND APPROACHES
FEDERAL AID PROJECT NO. F-064(2)


SCALE: AS NOTED. DATE: JUN, 1986
SHEET NO. 5-7 OF 30 SHEETS

DATE REVISION


FED. ROAD DIST. NO.	STATE	FED. AID PROJ. NO.	FISCAL YEAR	SHEET NO.	TOTAL SHEETS
HAWAII	HAW.	F-064-1(2)	1987	110	151

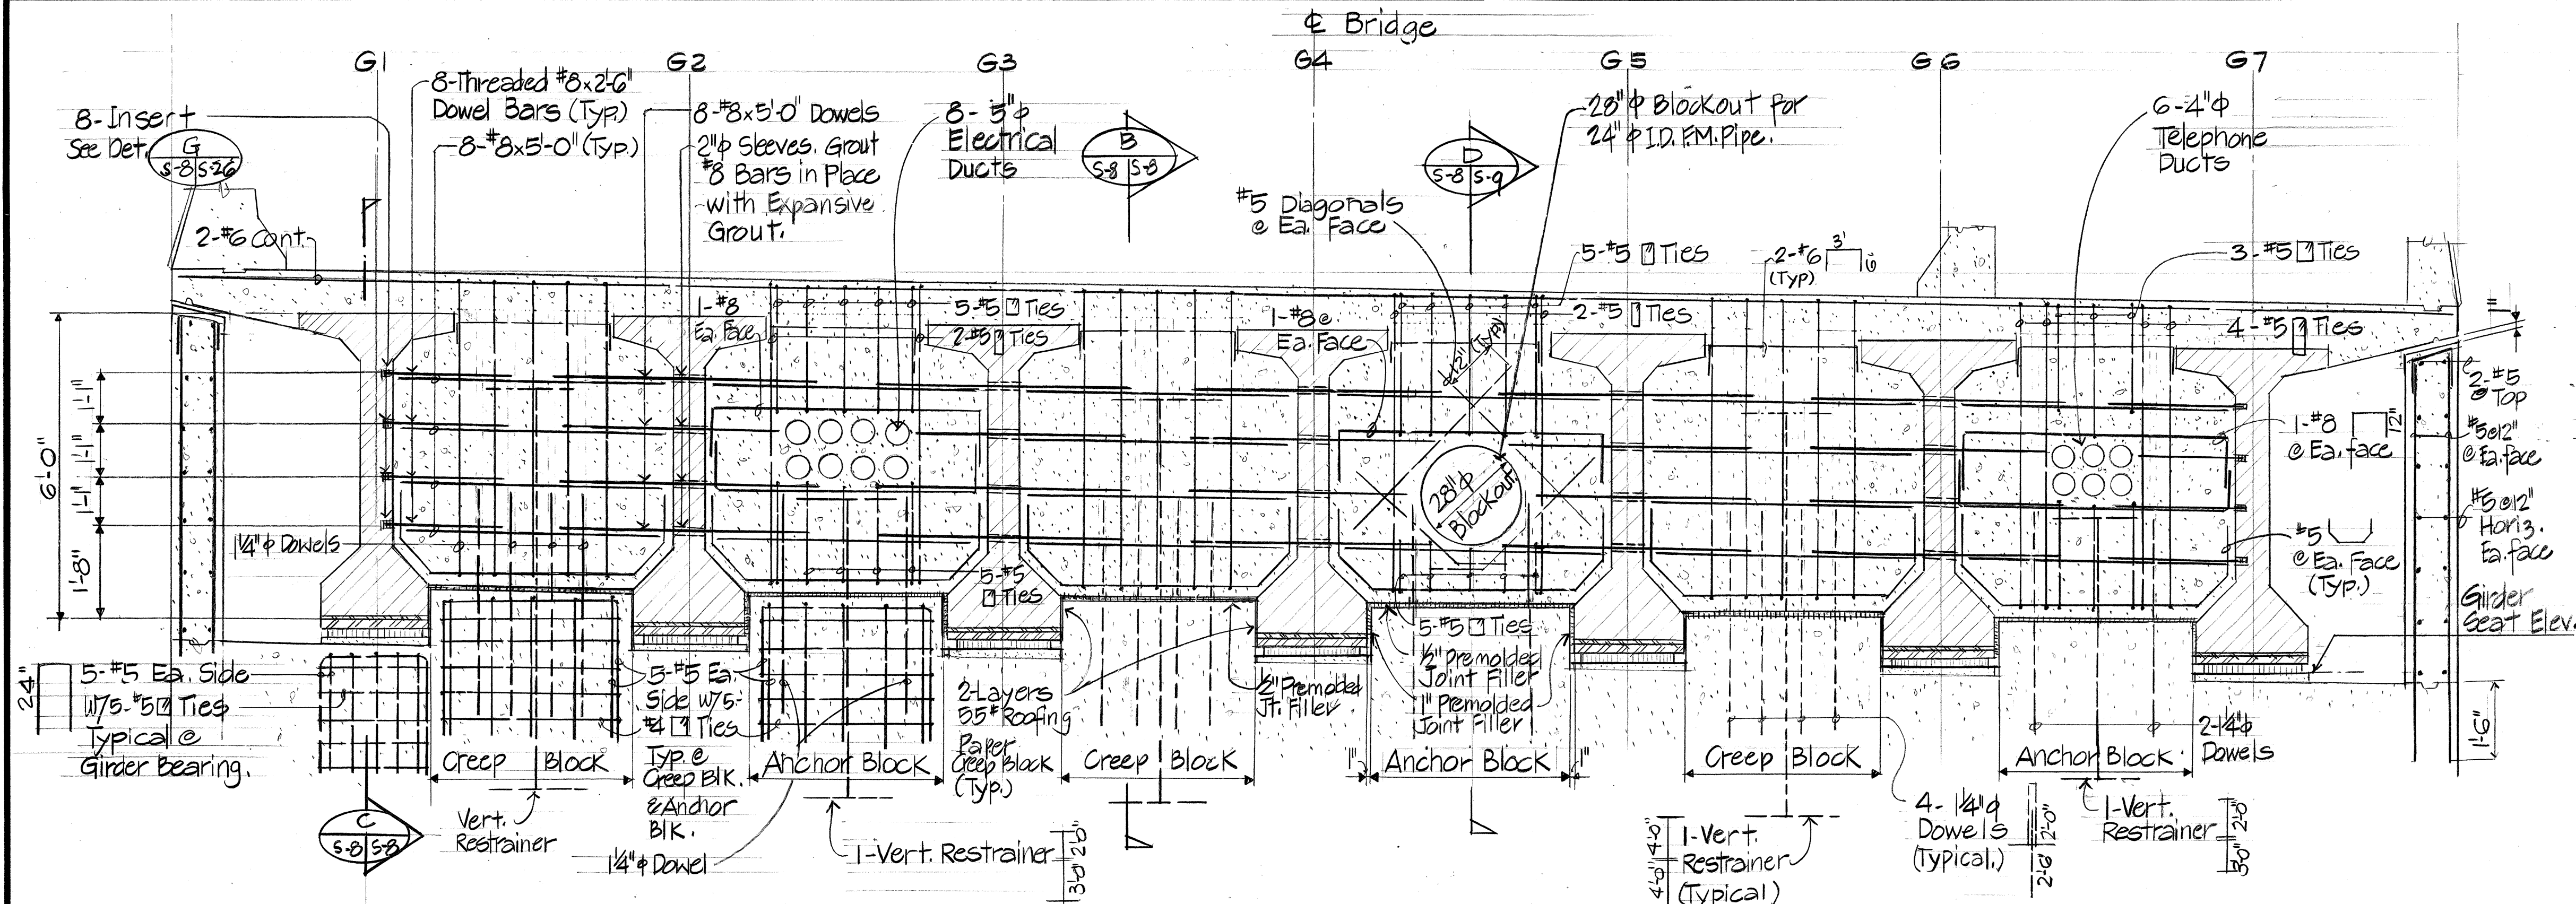


GIRDER BEARING AT ABUTMENT
Scale: 1/2" = 1'-0"

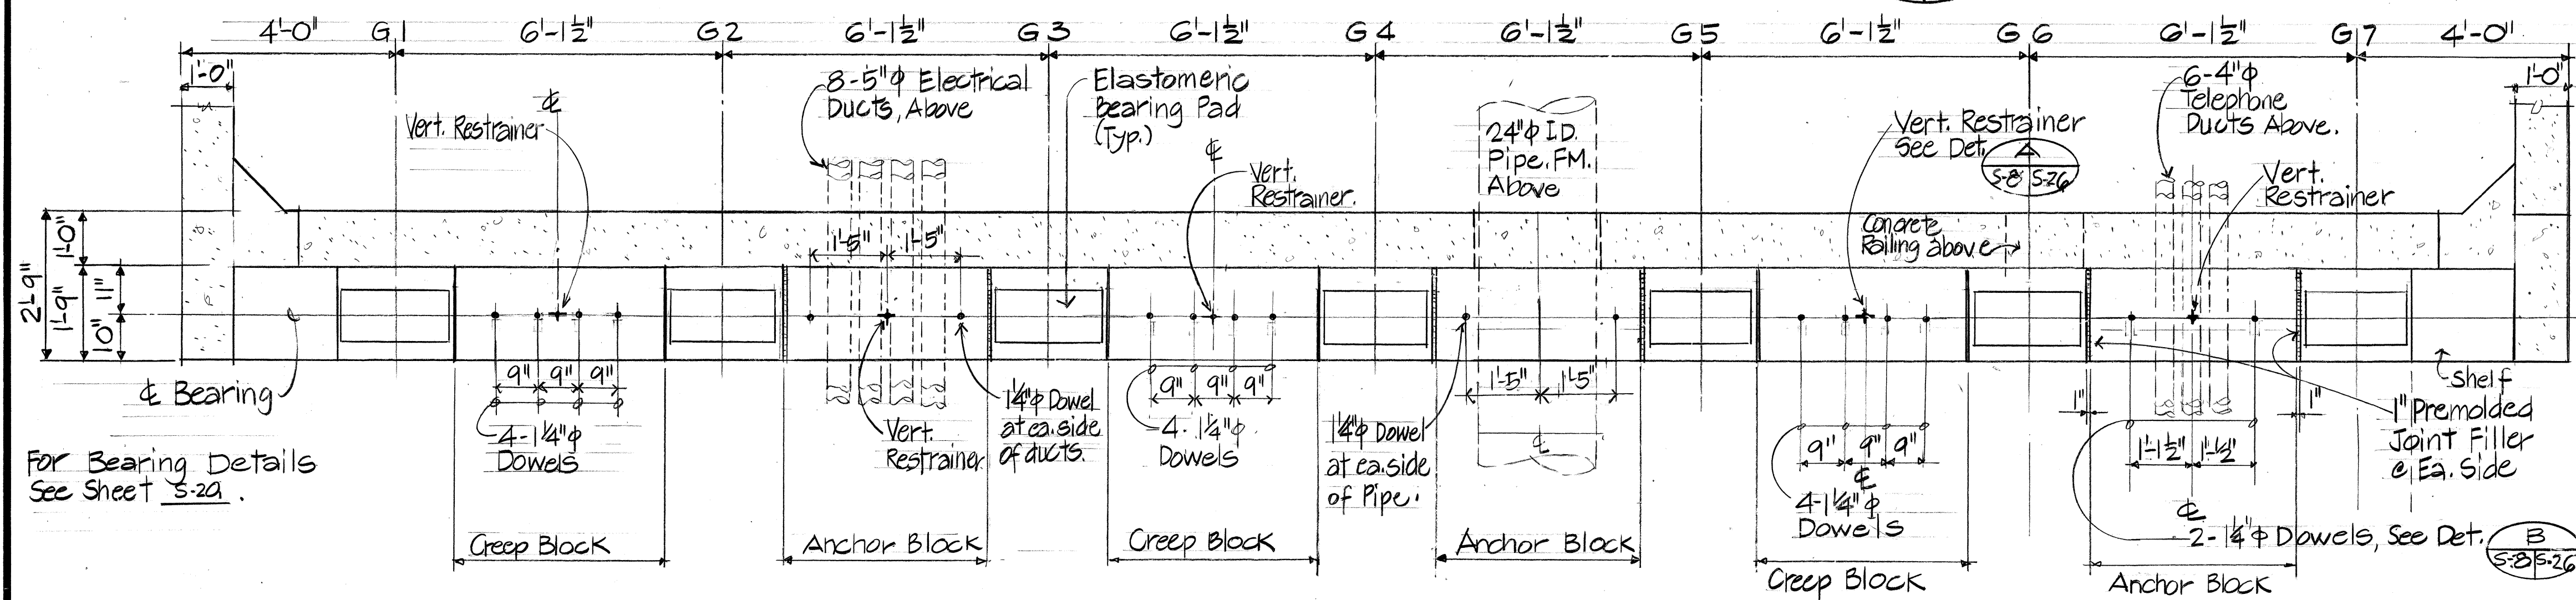

GIRDER BEARING AT ABUTMENT - PLAN
Scale: 1/2" = 1'-0"

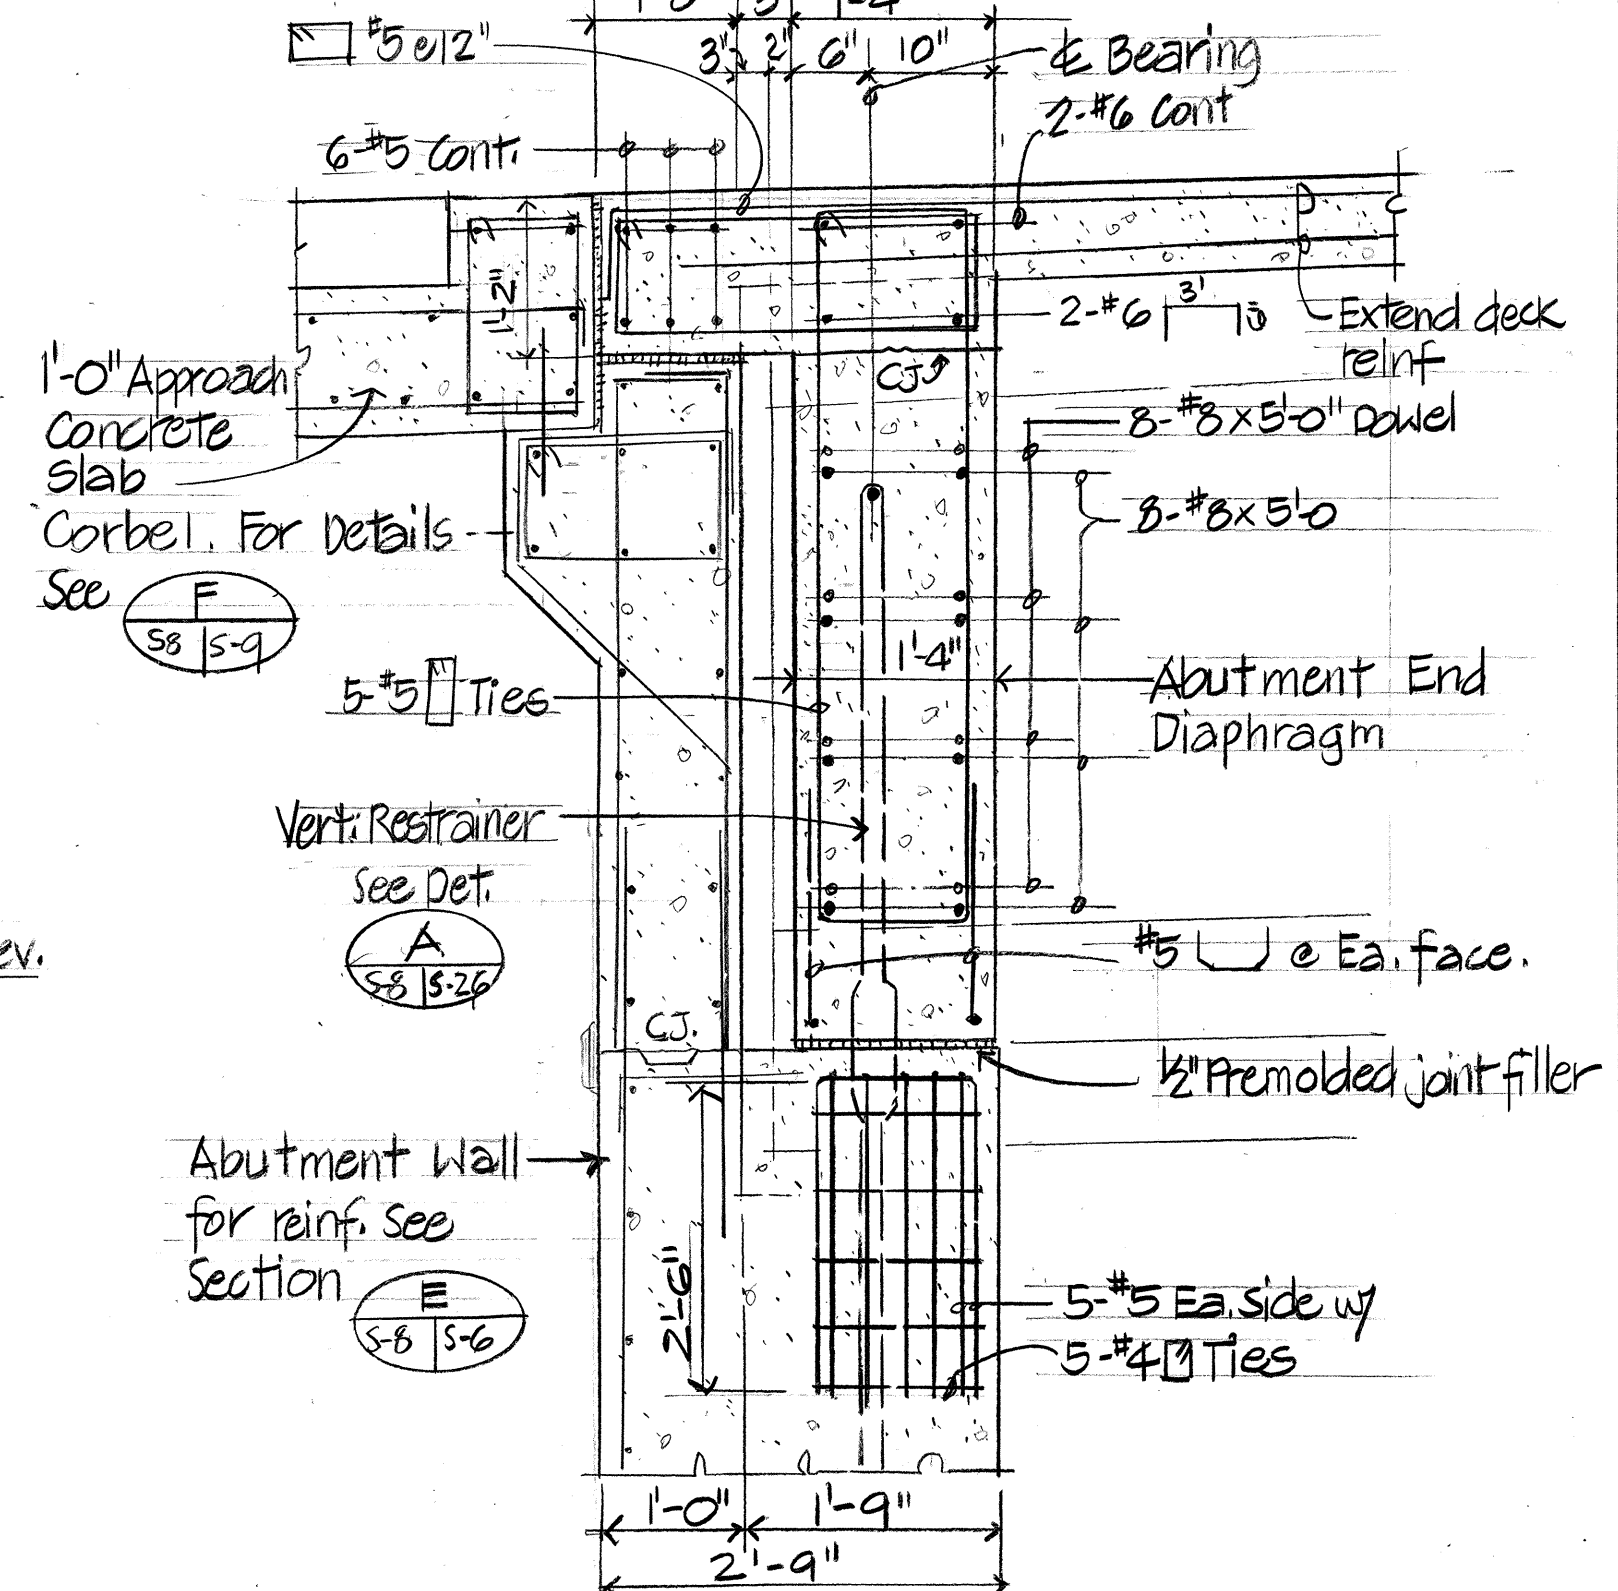

SECTION
Scale: 3/4" = 1'-0"
(Section Typical for Creep Block & Anchor Block)

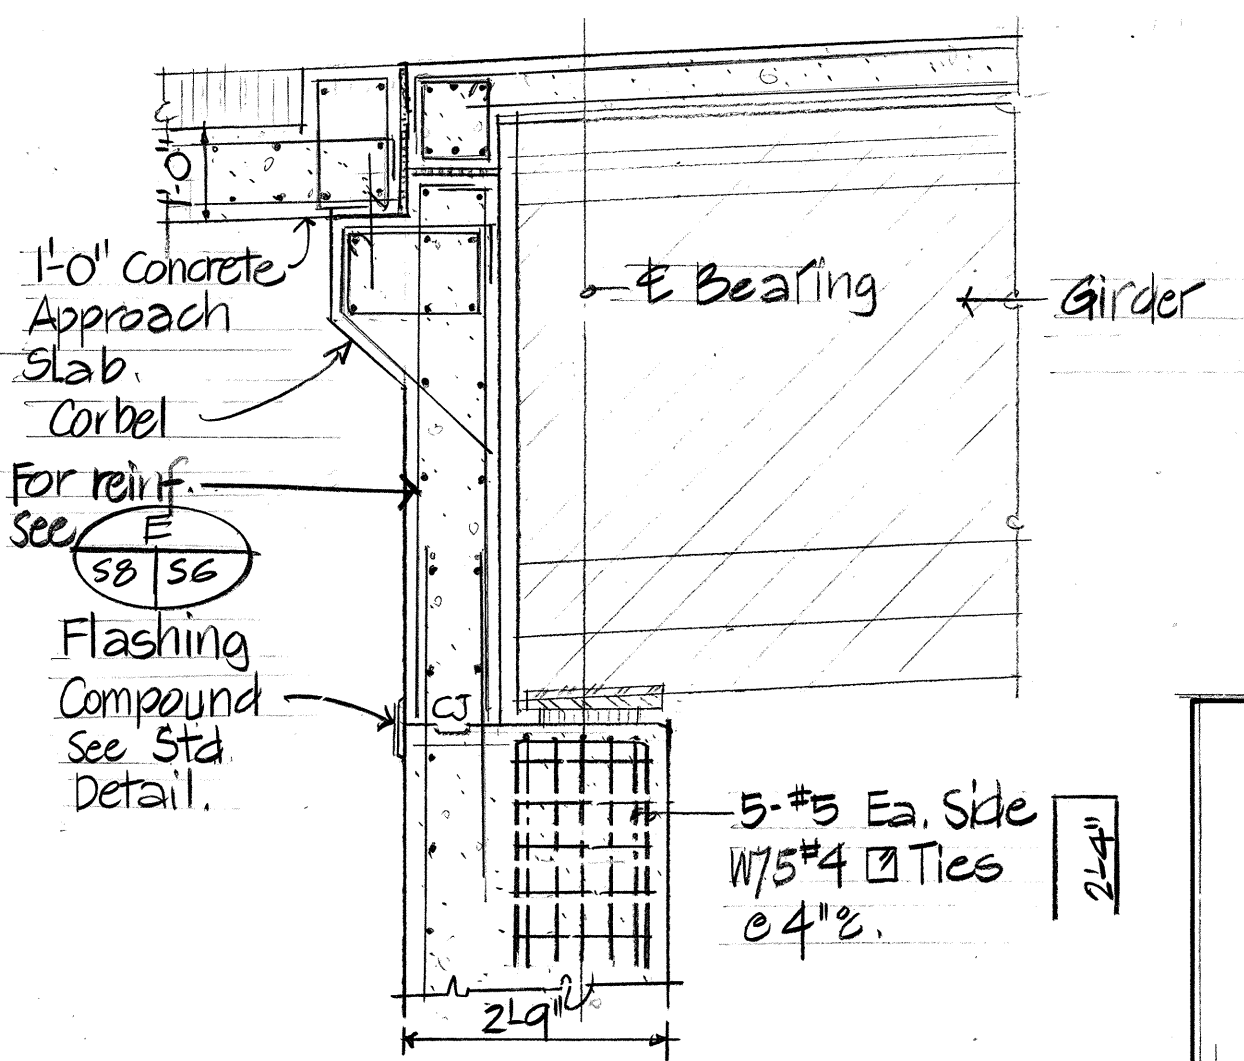

SECTION
Scale: 1/2" = 1'-0"

GIRDER SEAT ELEVATION			
NIMITZ		SAND ISLAND	
Girder No.	Seat Elevation	Girder No.	Seat Elevation
1-G1	10.82	5-G1	12.04
1-G2	10.70	5-G2	11.92
1-G3	10.57	5-G3	11.79
1-G4	10.45	5-G4	11.67
1-G5	10.33	5-G5	11.55
1-G6	10.20	5-G6	11.42
1-G7	10.08	5-G7	11.30

DATE	PLOTTED BY
DESIGNED BY	QUANTITIES BY
CHECKED BY	


THIS WORK WAS PREPARED BY ME OR UNDER MY SUPERVISION.
 Myron Okubo

STATE OF HAWAII
 DEPARTMENT OF TRANSPORTATION
 HIGHWAYS DIVISION
ABUTMENT DETAILS
 SAND ISLAND ROAD WIDENING
 2ND BRIDGE AND APPROACHES
 FEDERAL AID PROJECT NO. F-064(12)
 SCALE: AS NOTED. DATE: JUN, 1986
 SHEET NO. 5-8 OF 30 SHEETS

DATE REVISION

FED. ROAD DIST. NO.	STATE	FED. AID PROJ. NO.	FISCAL YEAR	SHEET NO.	TOTAL SHEETS
HAWAII	HAW.	F-064-1(2)	1987	112	151


Note
The Contractor shall submit shop drawings for falsework, cofferdams or other watway obstructions required for construction to the Engineer and to the Commander, Fourteenth Coast Guard District for approval. No Bridge construction shall commence prior to approval. All work shall be conducted so that navigation of the waterway is not unreasonably interfered and that the present navigable depth is not impaired. The Contractor shall coordinate and notify the District Commander of any construction that may affect navigation of the waterway. The Contractor shall promptly clear the channel of any obstructions to the satisfaction of the District Commander when the obstruction is no longer required for the contractors operation.

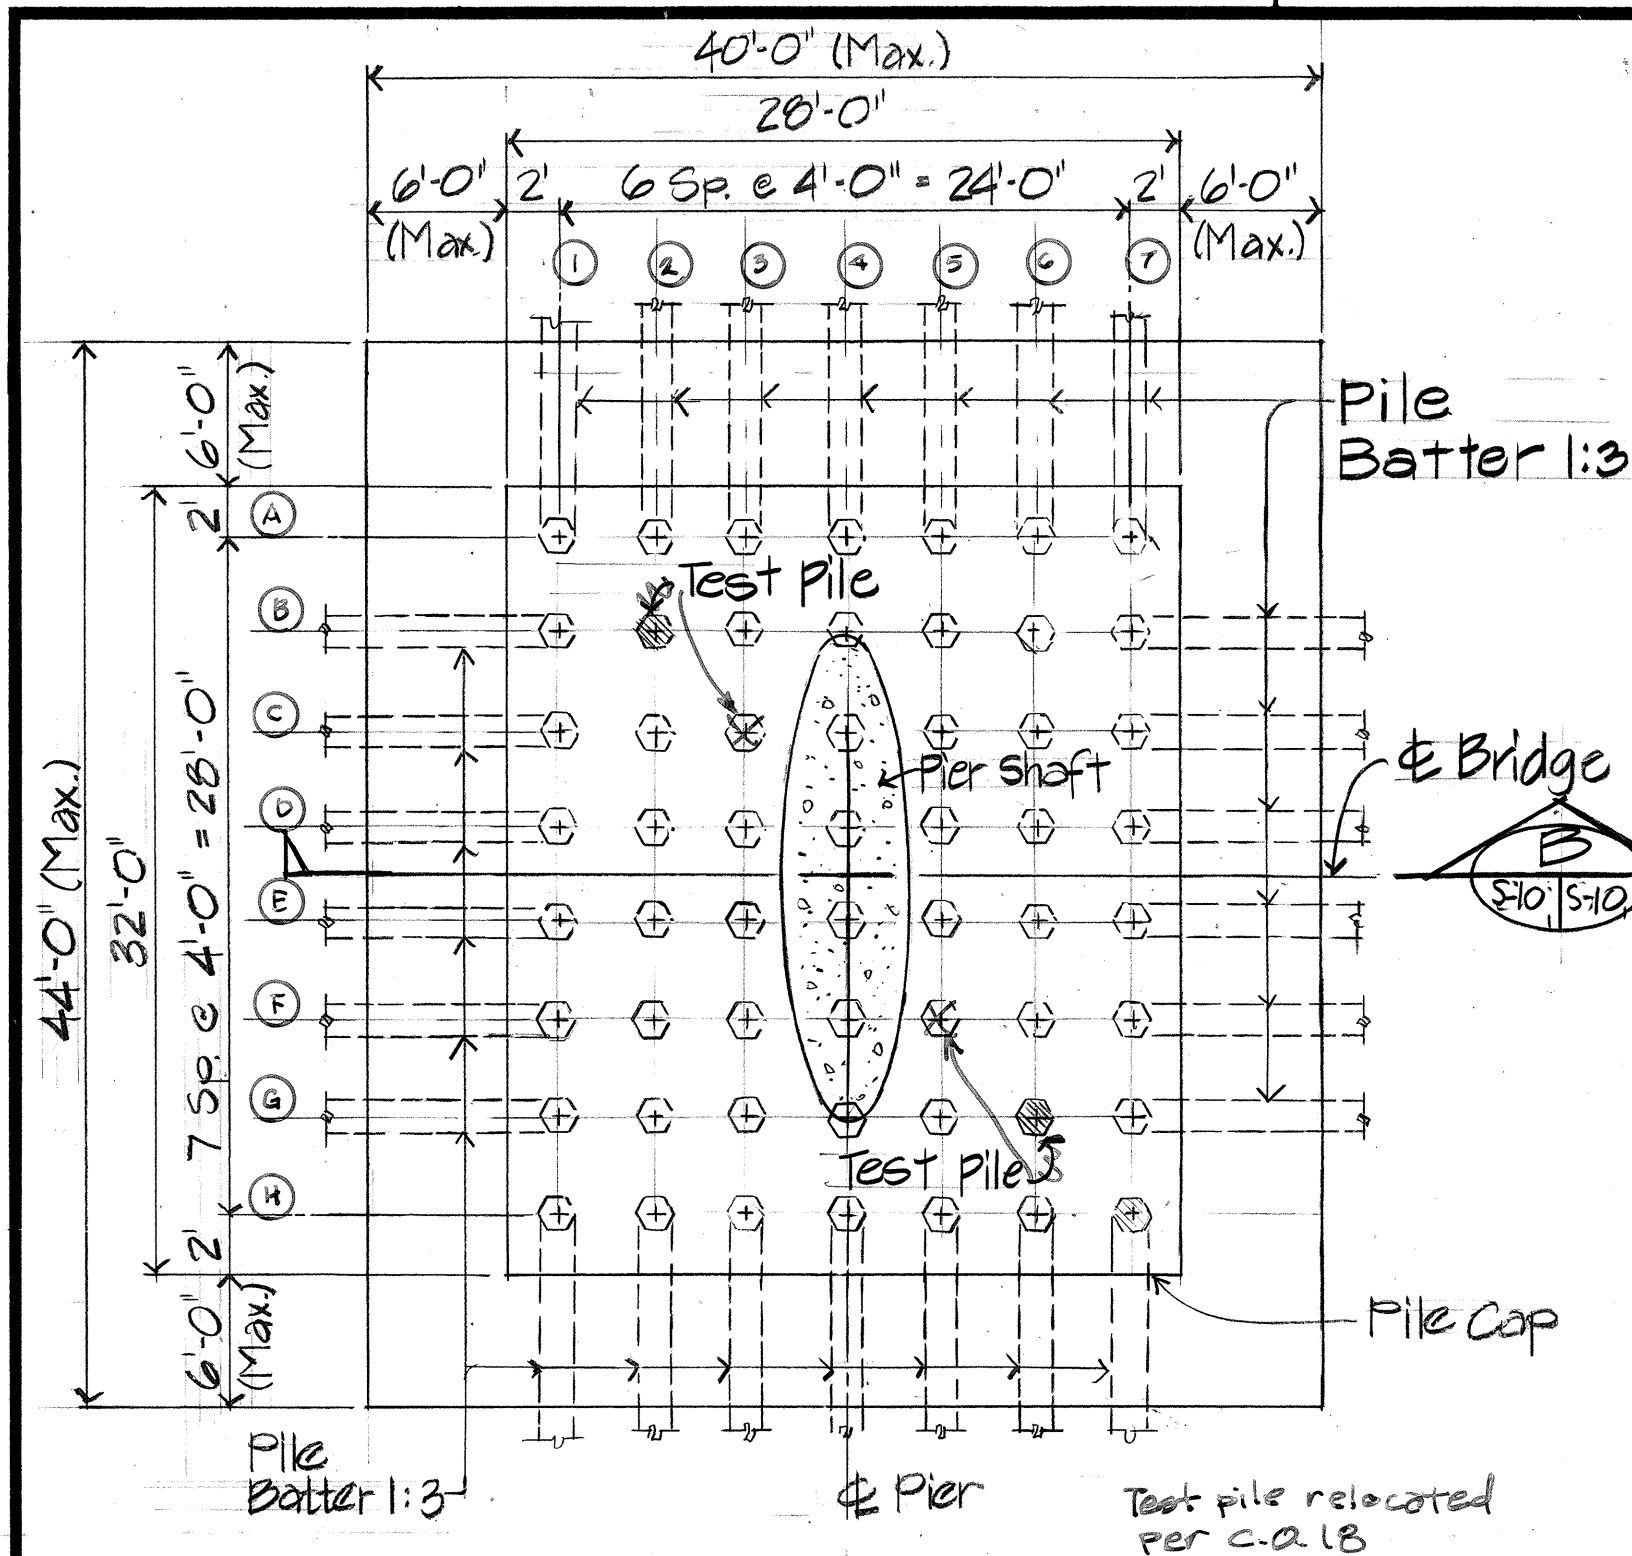

56 - 16 1/2" Octagonal Prestressed Concrete Piles

PLAN


PIER #1 FOOTING (A) S-10/S-10
Scale: 1/8" = 1'-0"

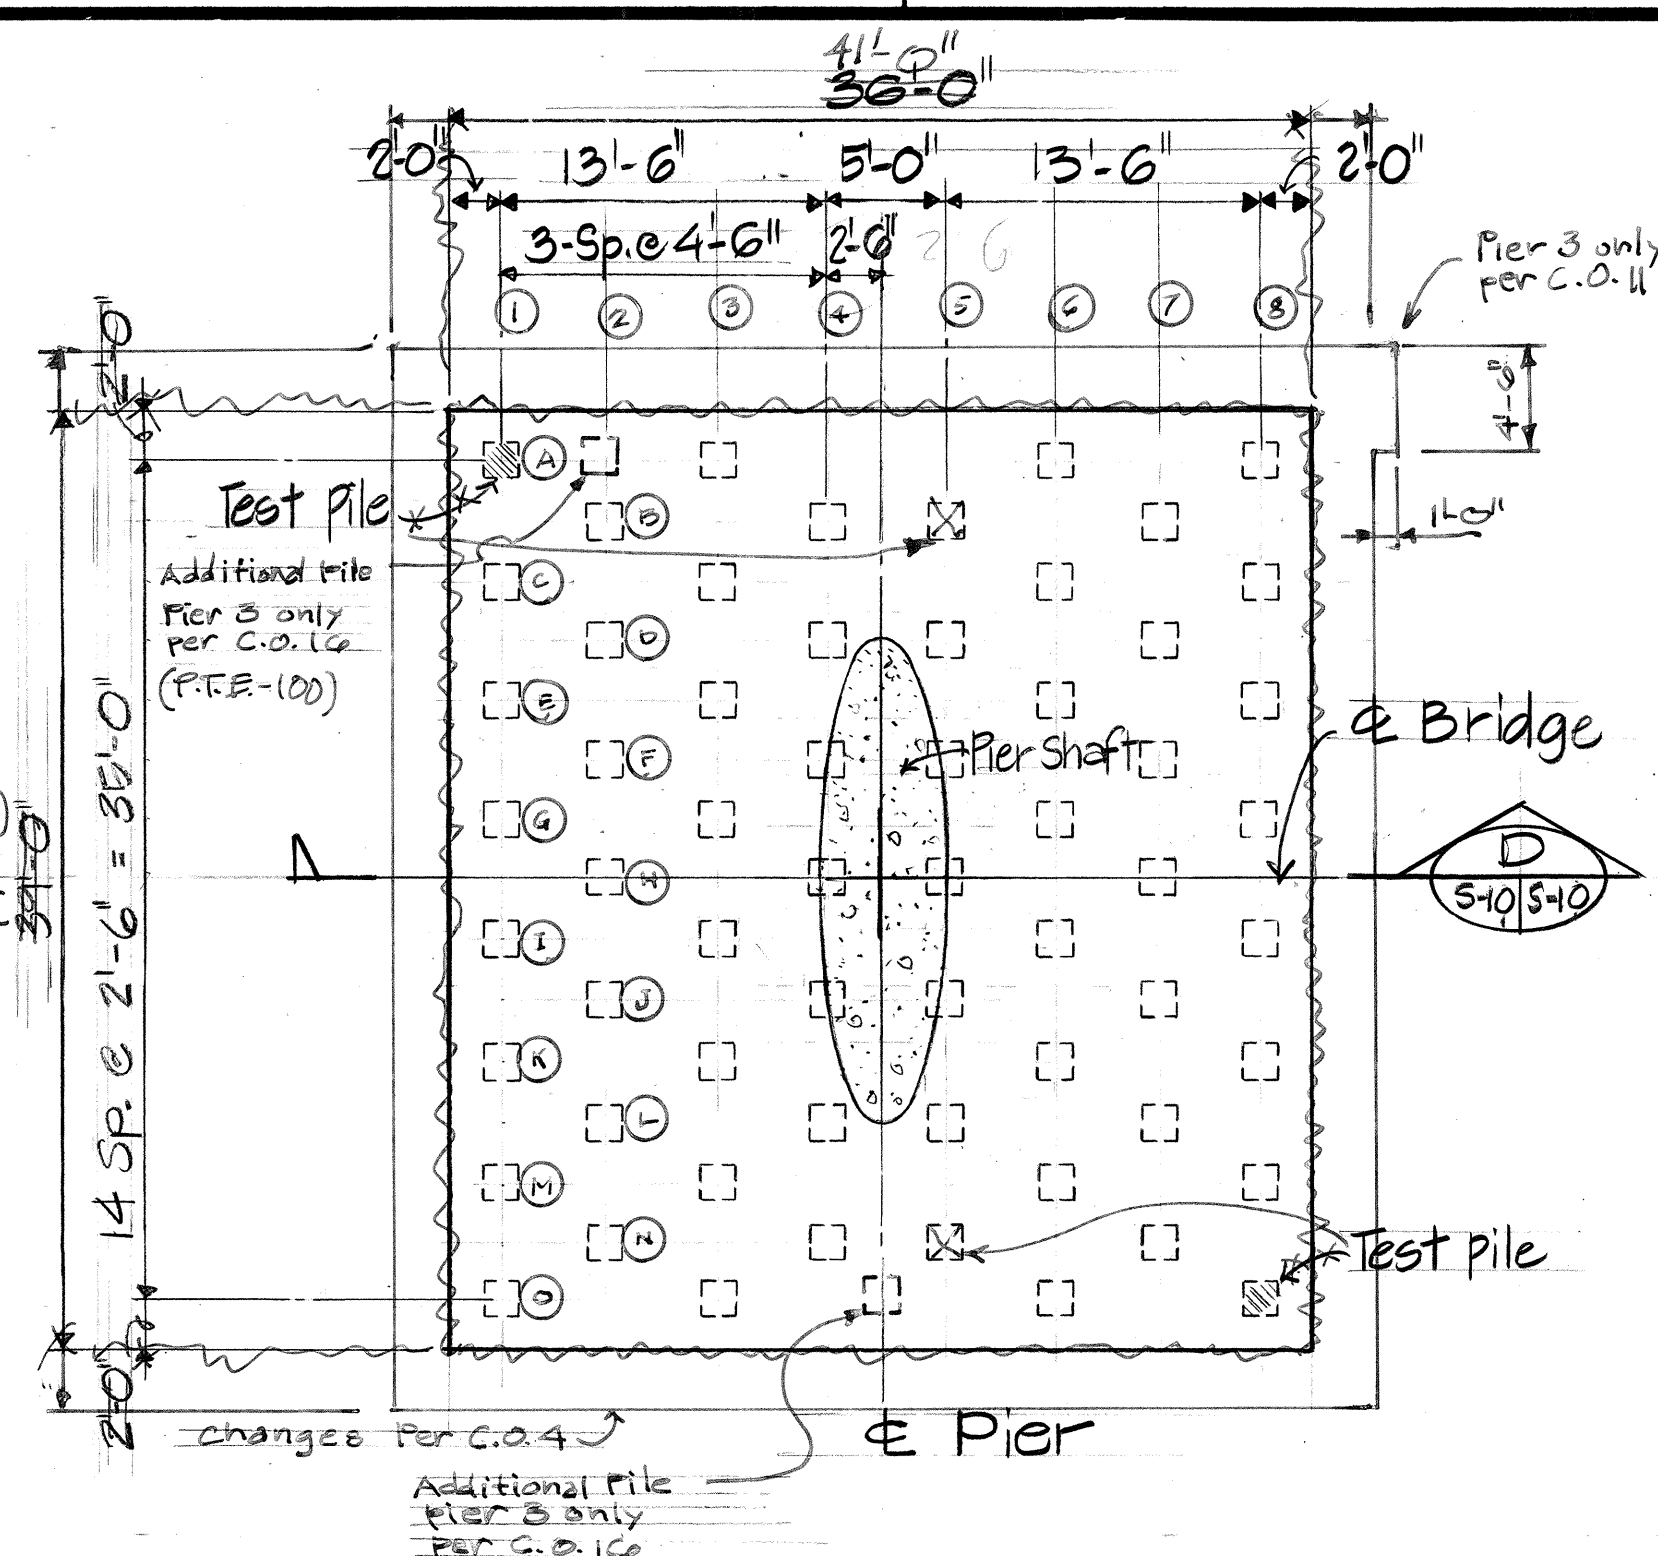

60 - 20" Square Prestressed Concrete Piles.

PLAN


PIERS #2 & #3 FOOTING (C) S-10/S-10
Scale: 1/8" = 1'-0"

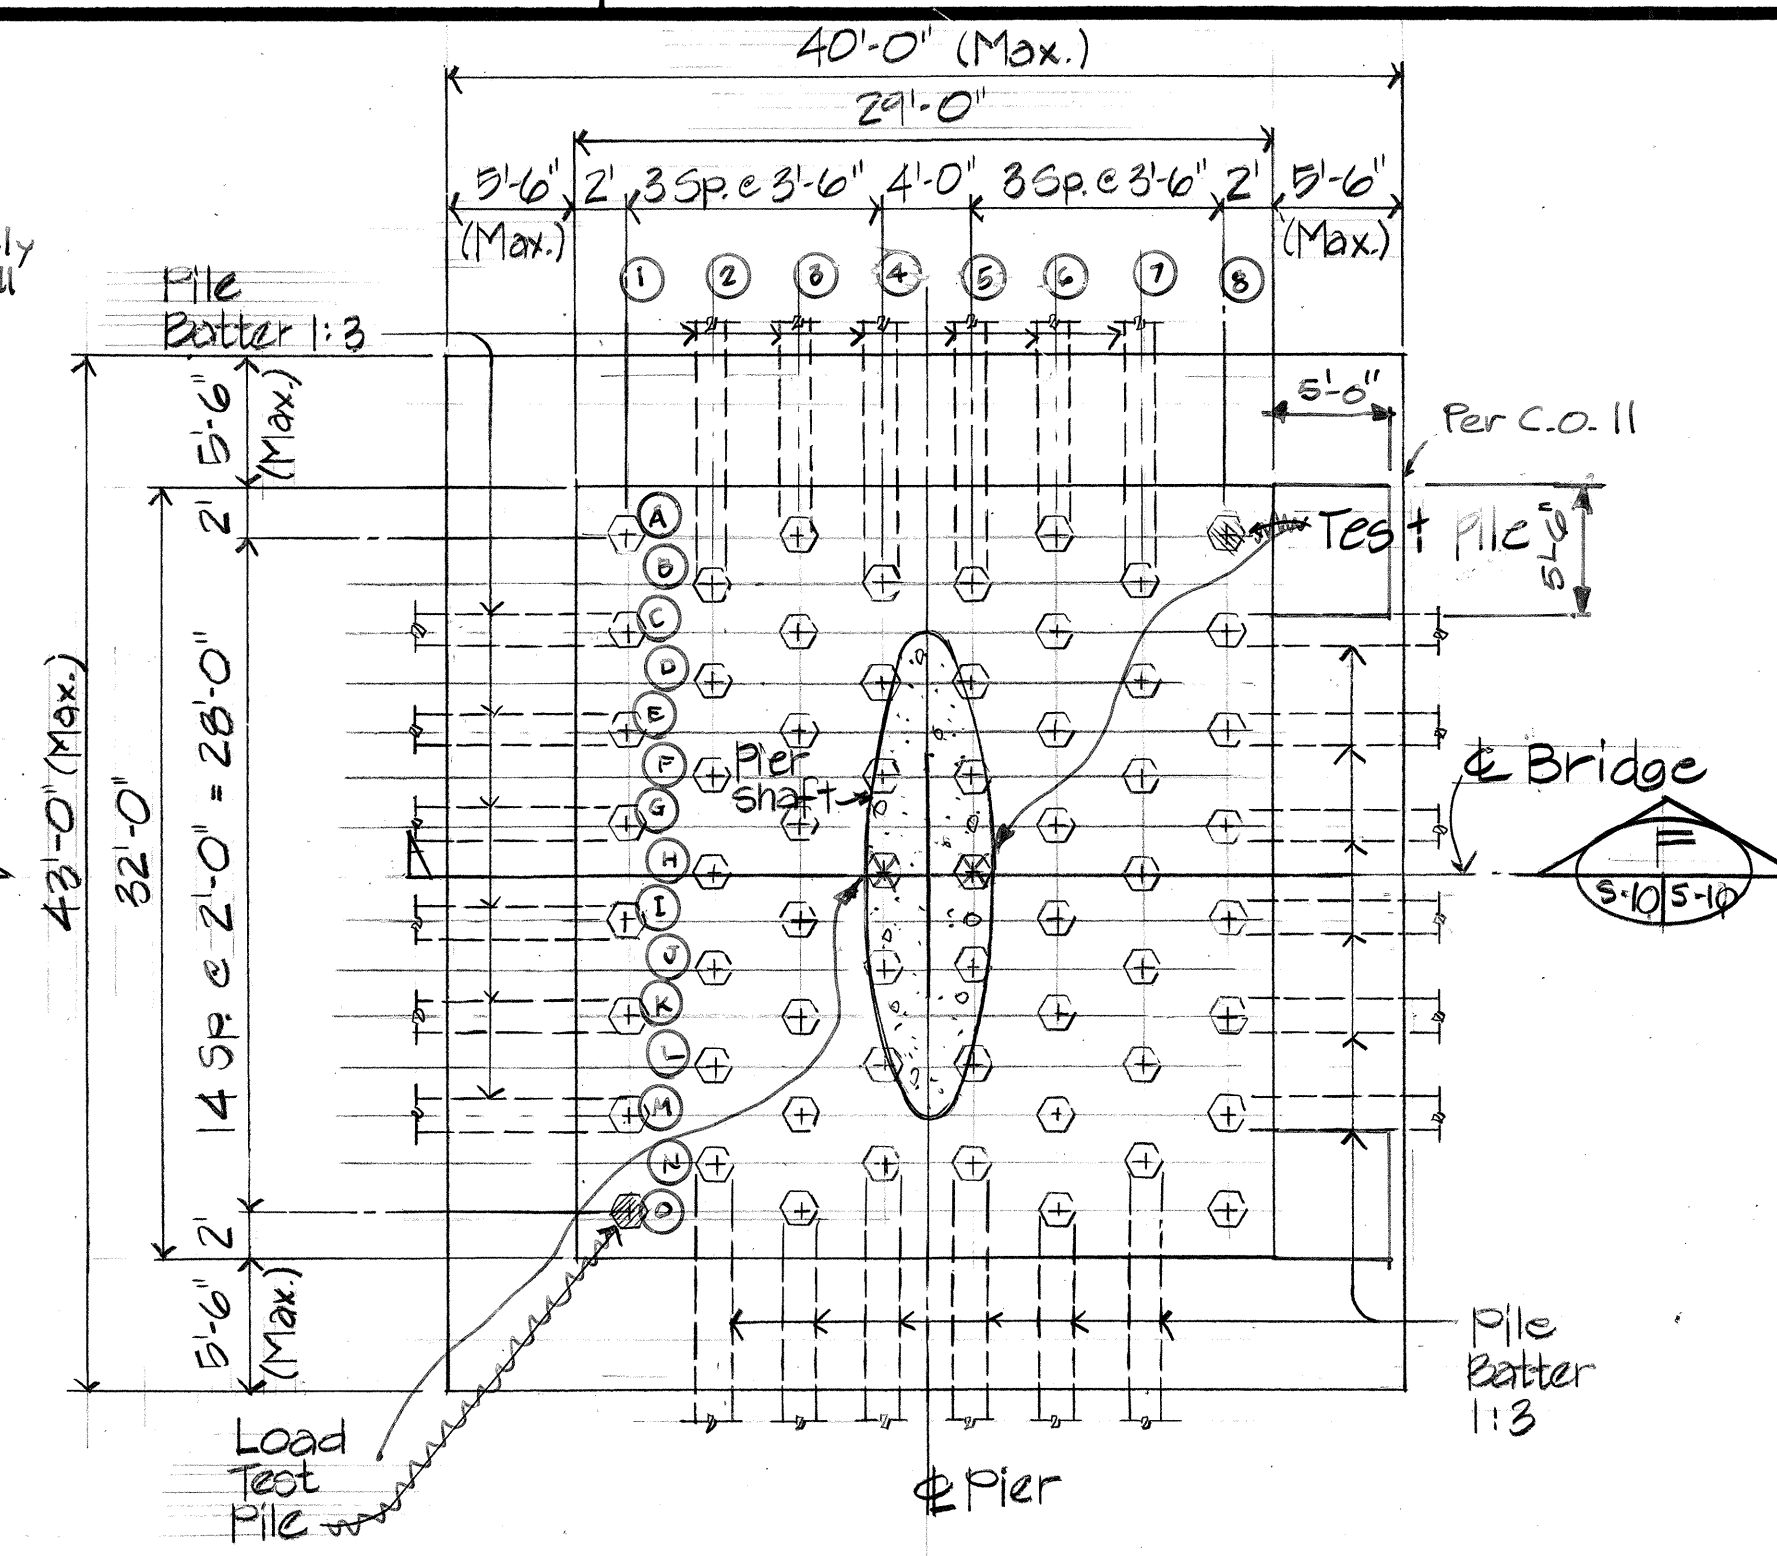


60 - 16 1/2" Octagonal Prestressed Concrete Piles.

PLAN


PIER #4 FOOTING (E) S-10/S-10
Scale: 1/8" = 1'-0"

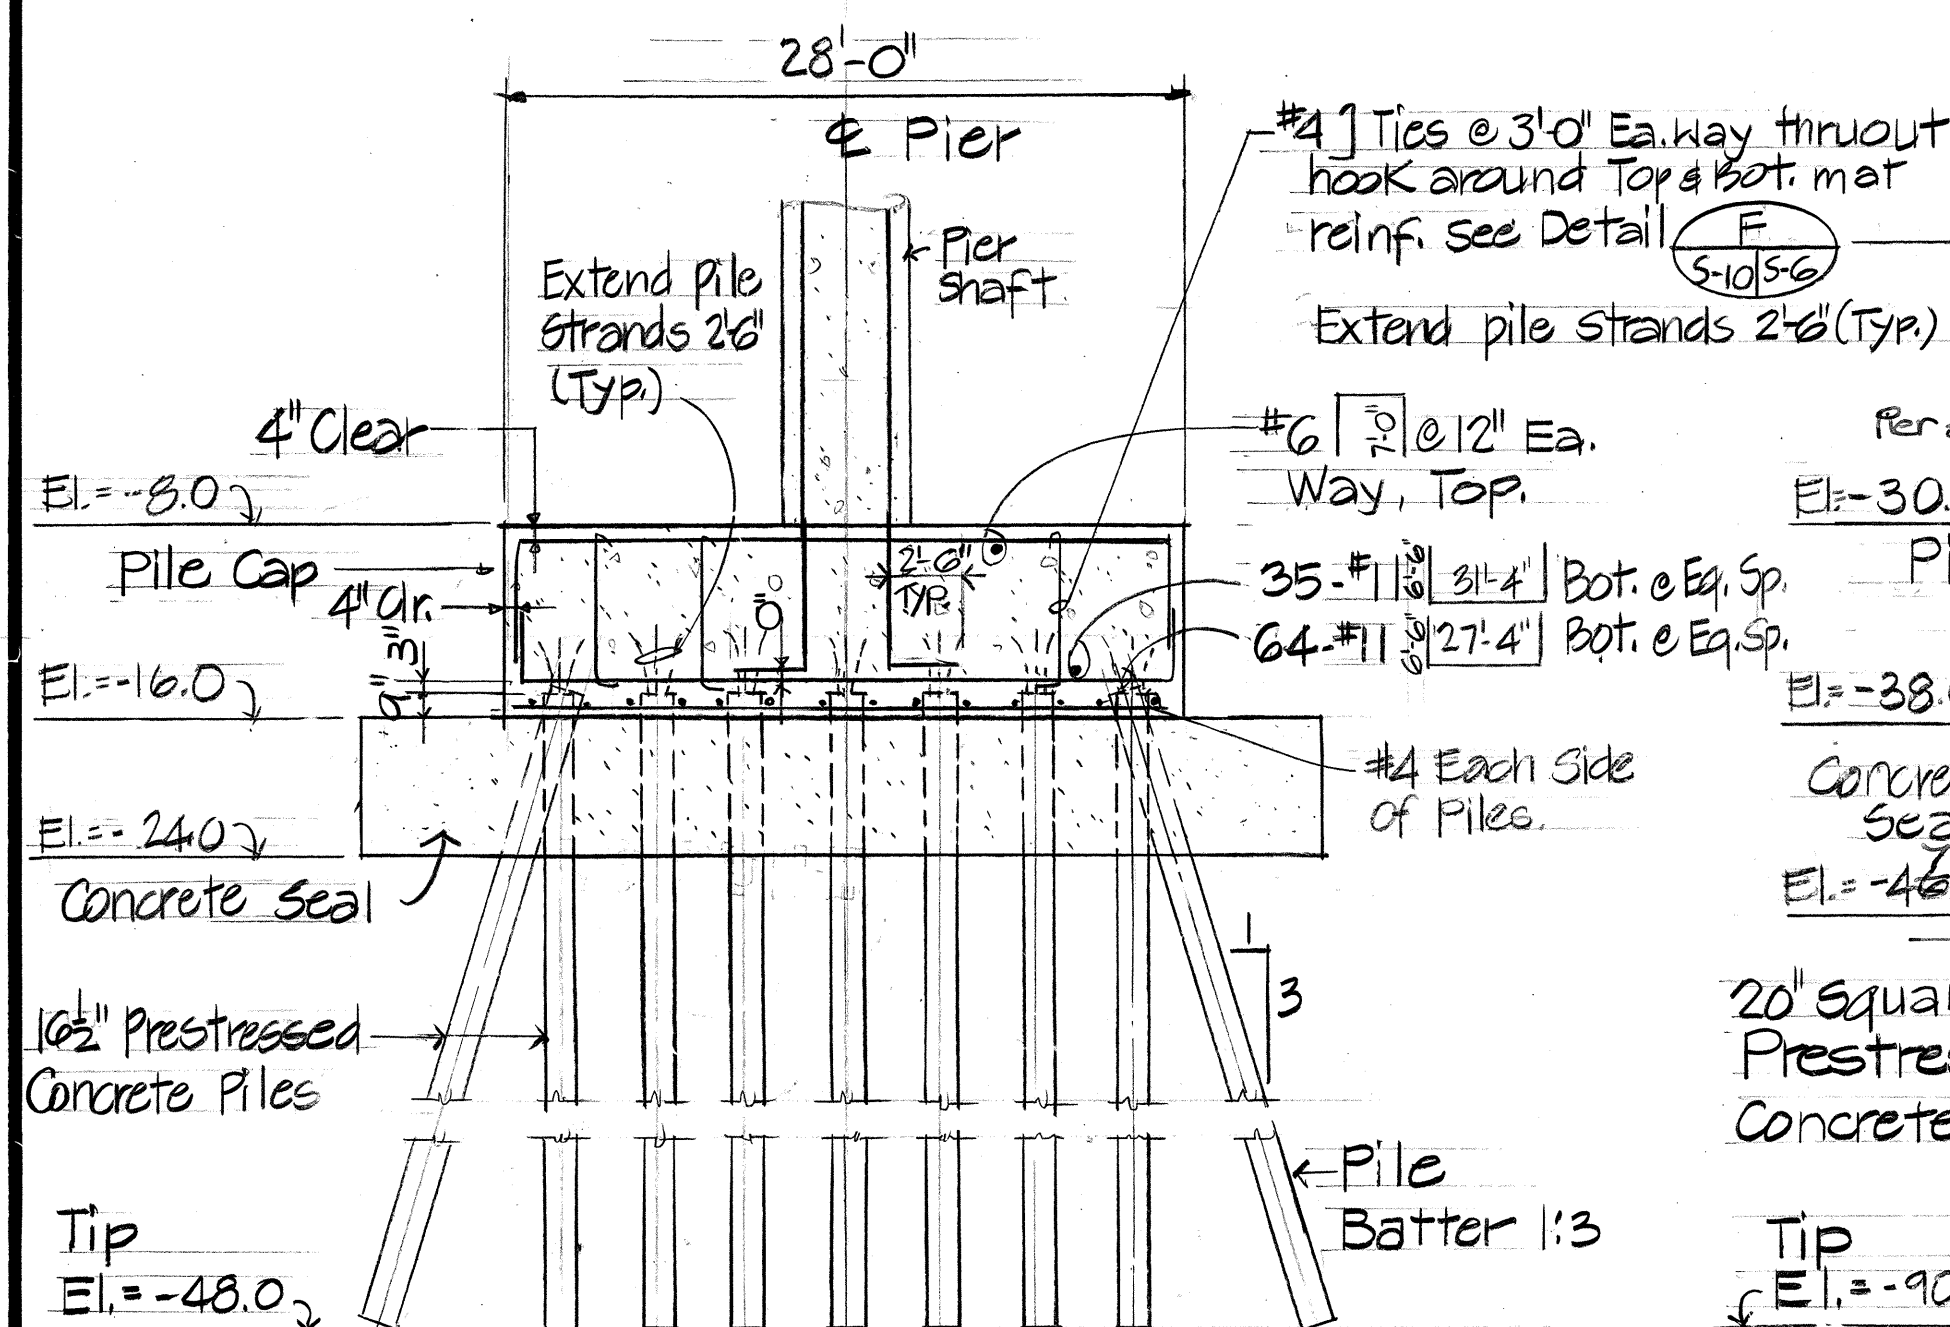


SECTION (B) S-10/S-10
Scale: 1/8" = 1'-0"

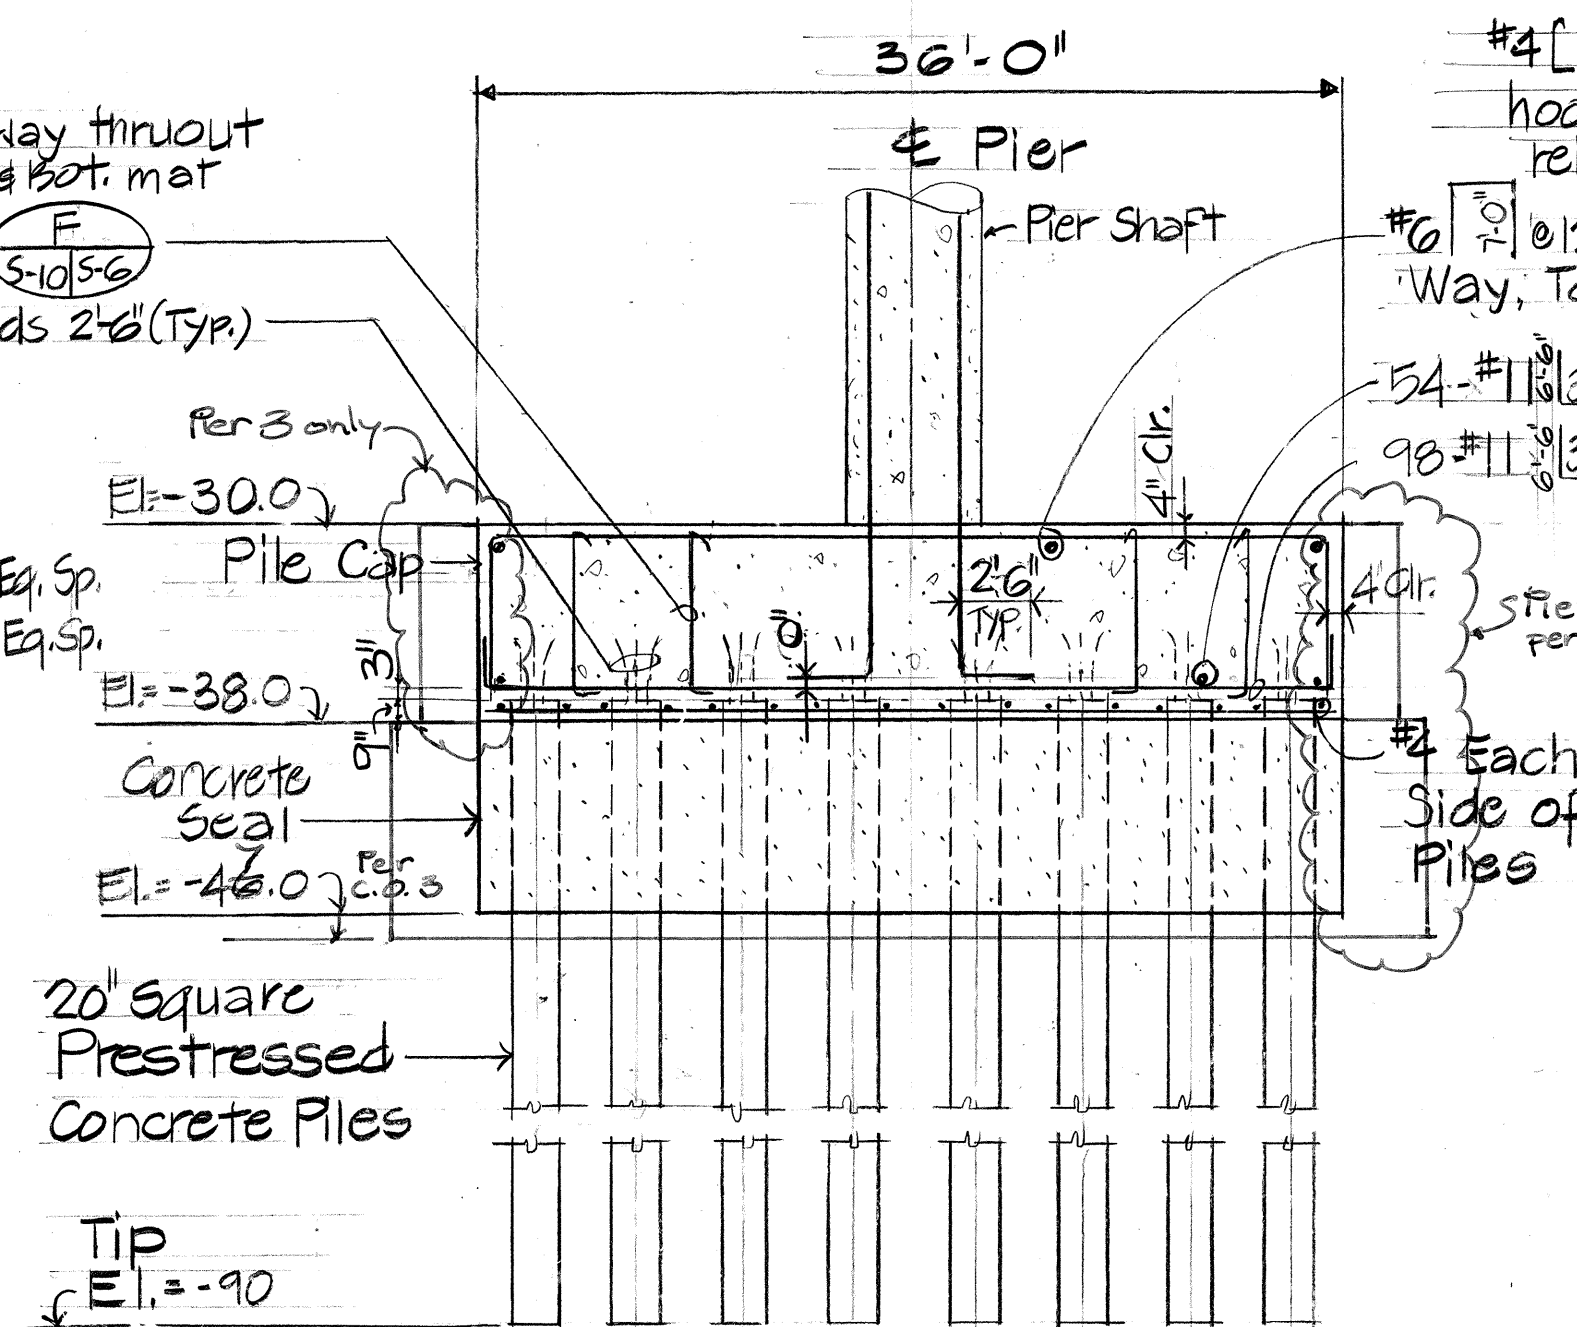


SECTION (D) S-10/S-10
Scale: 1/8" = 1'-0"

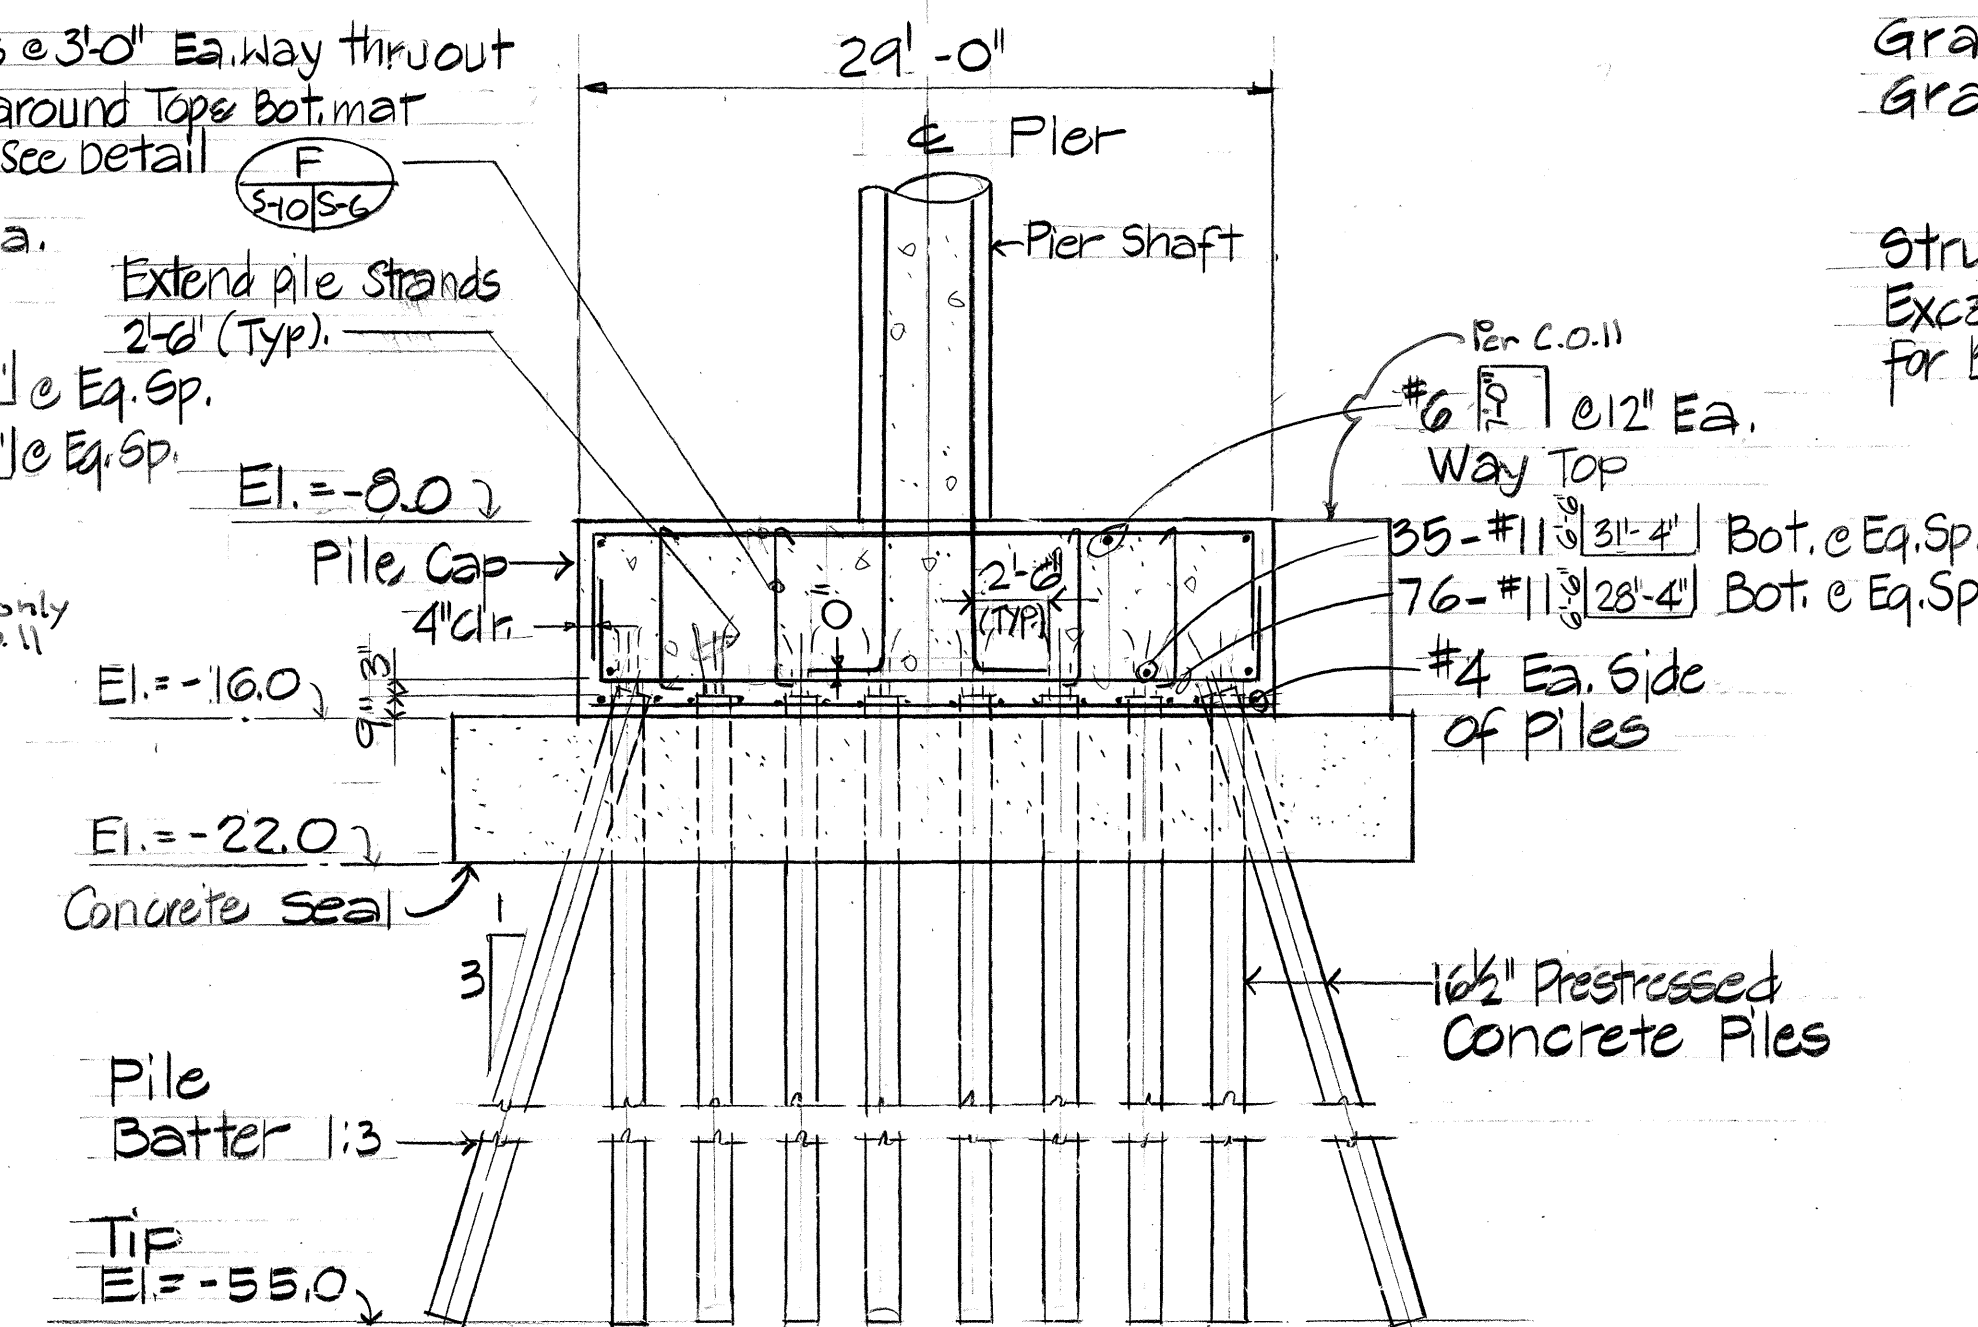

SECTION (F) S-10/S-10
Scale: 1/8" = 1'-0"

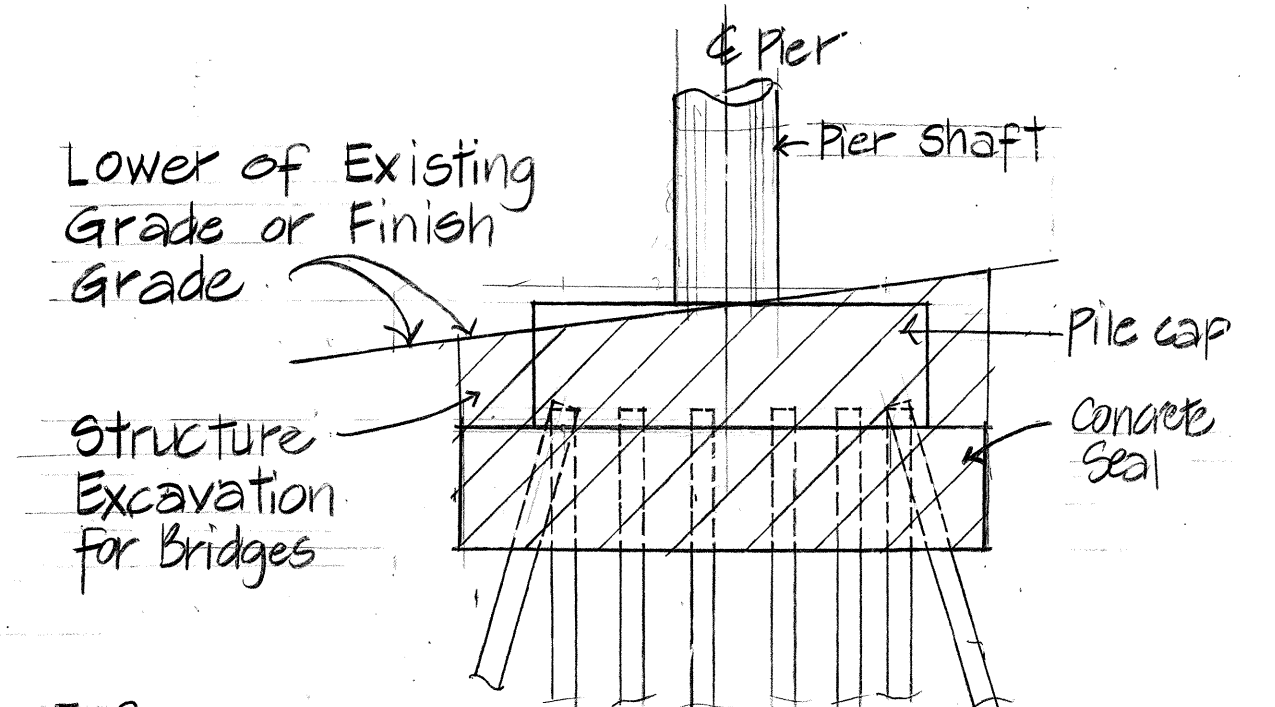

STRUCTURE EXCAVATION DETAIL (G) S-10/S-10
N.T.S.

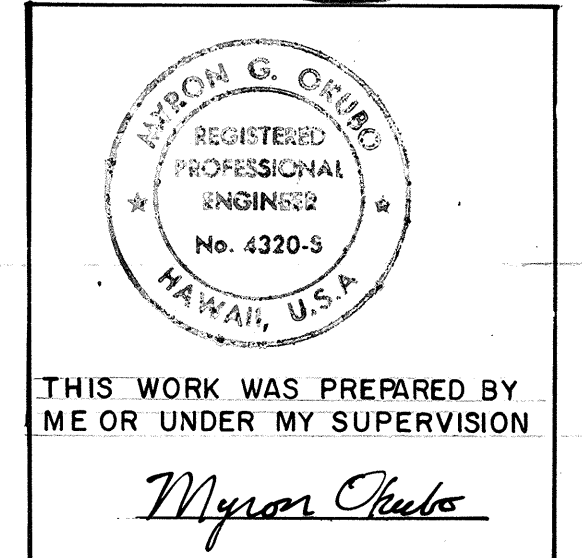





STATE OF HAWAII
DEPARTMENT OF TRANSPORTATION
HIGHWAYS DIVISION
PIER FOUNDATIONS

SAND ISLAND ROAD WIDENING
2ND BRIDGE AND APPROACHES
FEDERAL AID PROJECT NO. F-064-1(2)



SCALE: AS NOTED. DATE: JUN, 1986
SHEET NO. 5-10 OF 30 SHEETS

"AS-BUILT"

FED. ROAD DIST. NO.	STATE	FED. AID PROJ. NO.	FISCAL YEAR	SHEET NO.	TOTAL SHEETS
HAWAII	HAW.	F-064-1(2)	1987	113	151

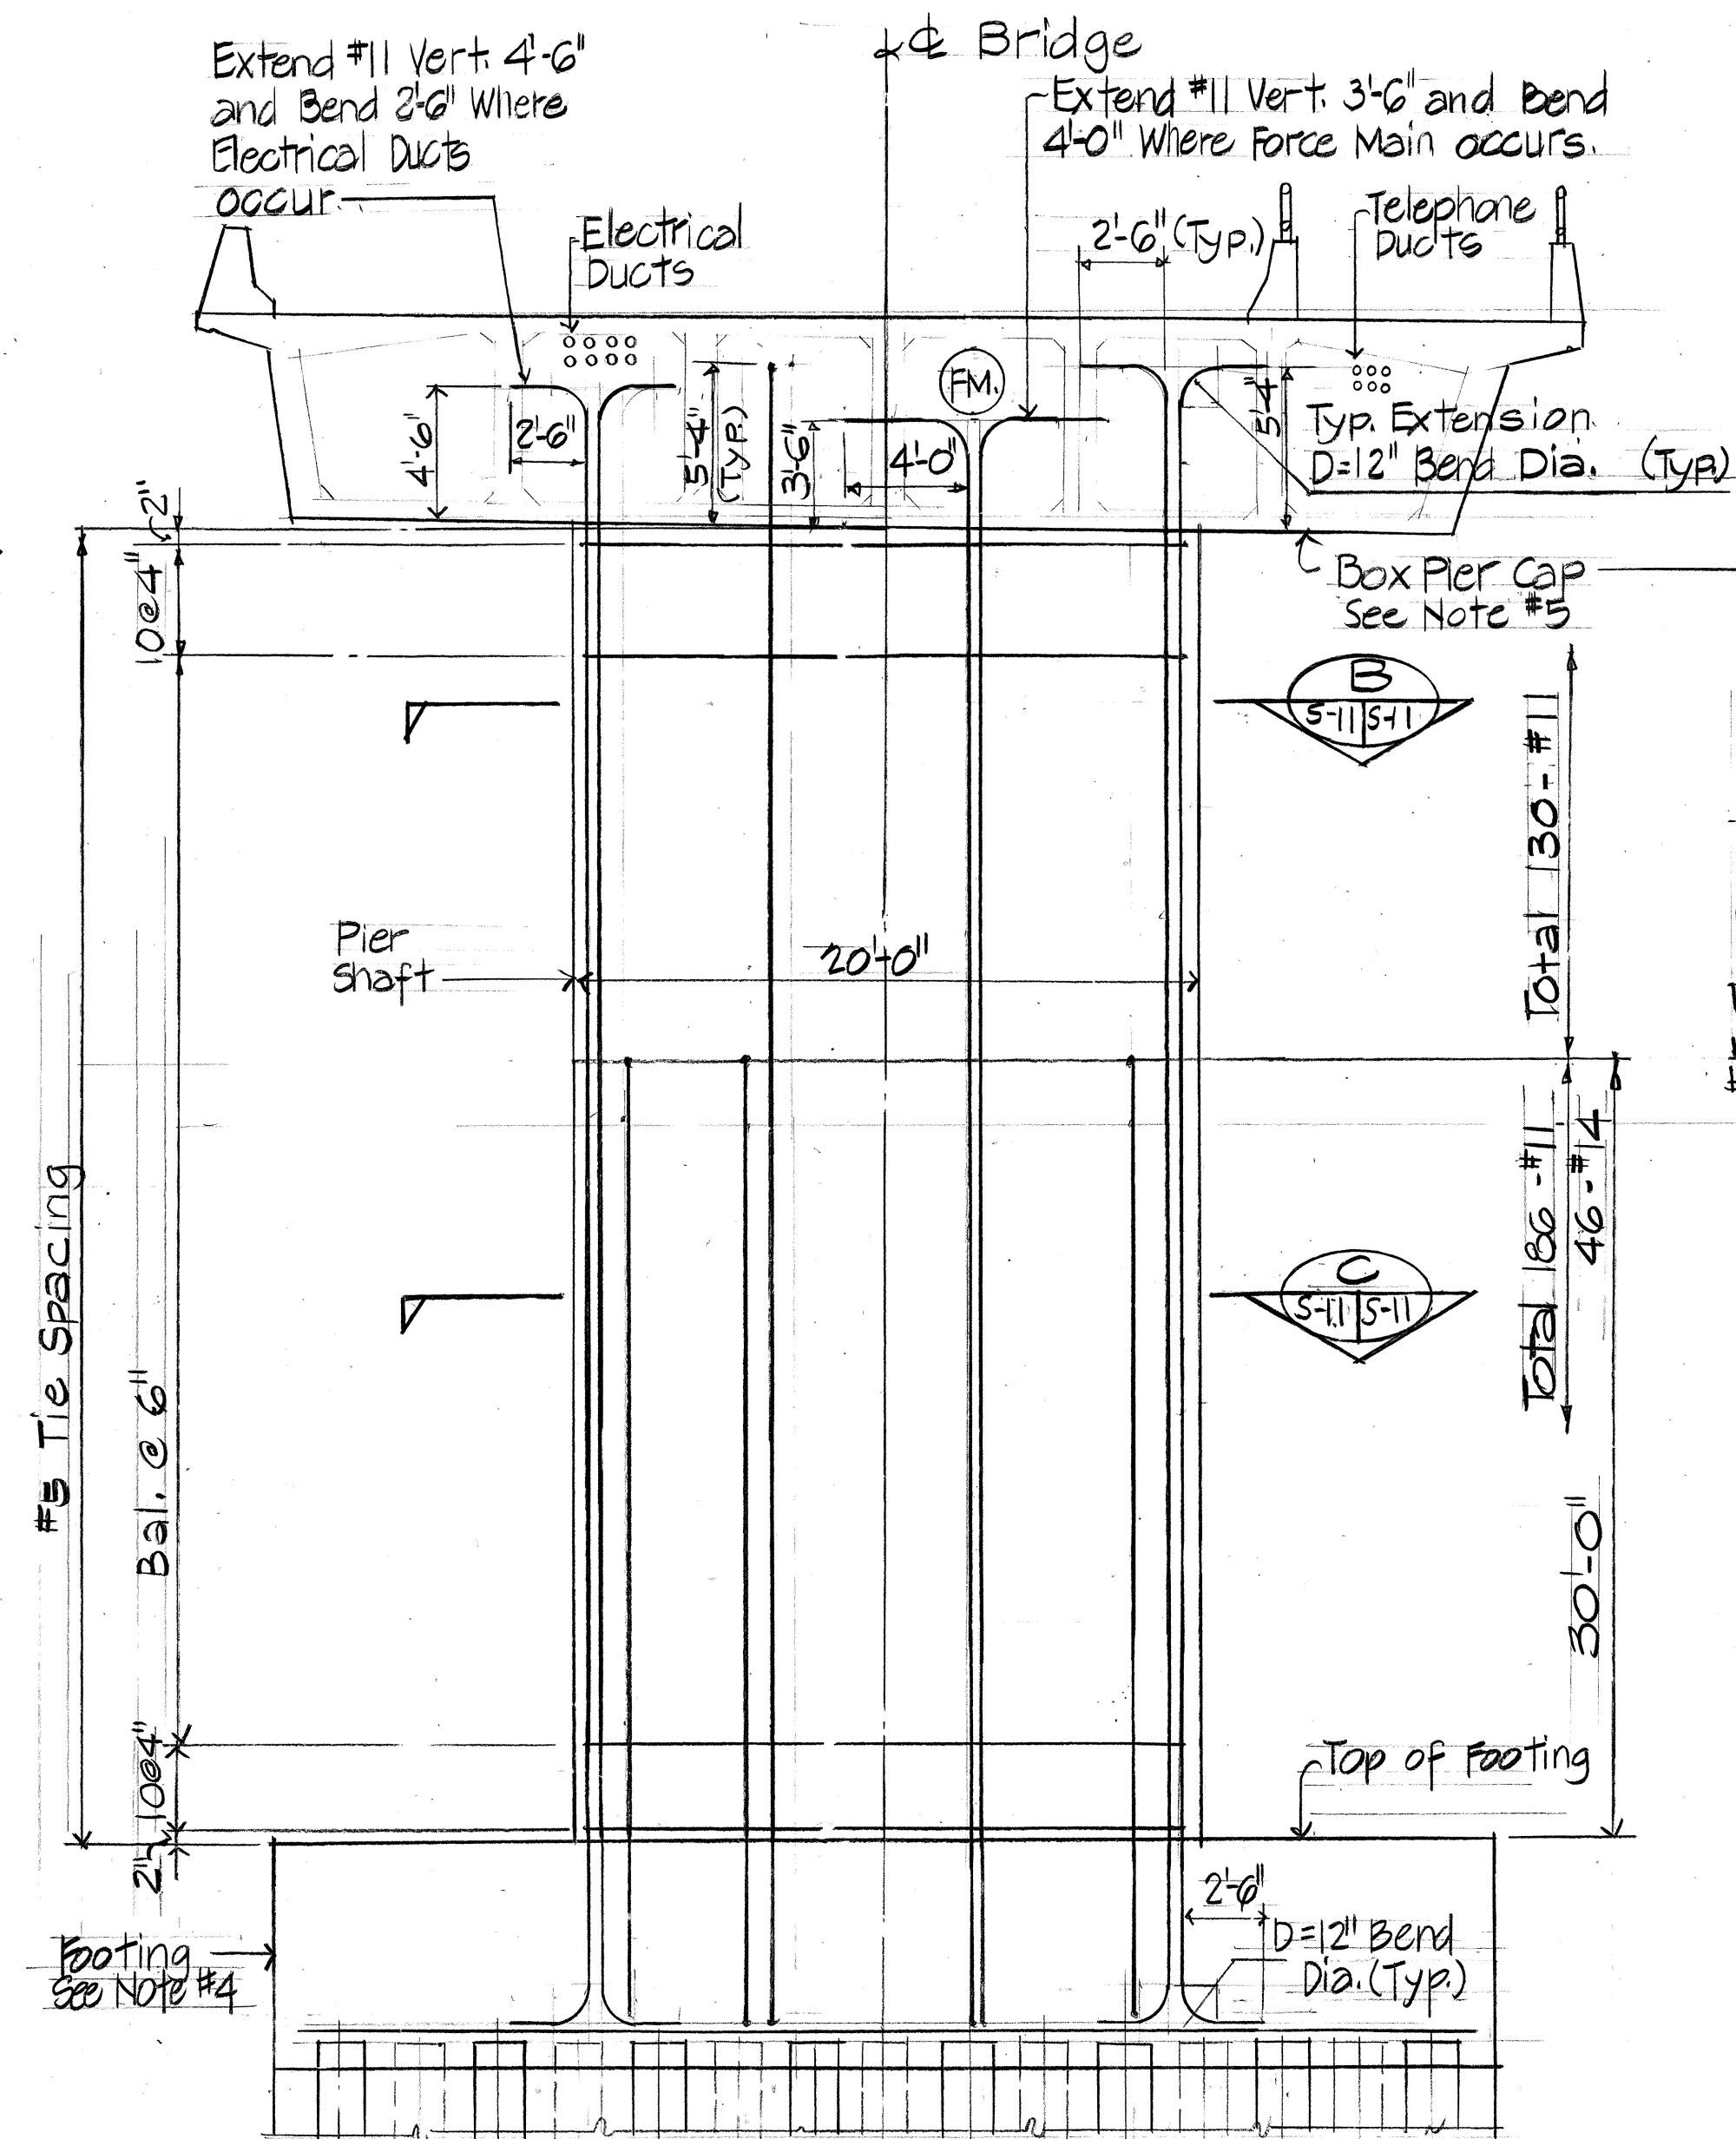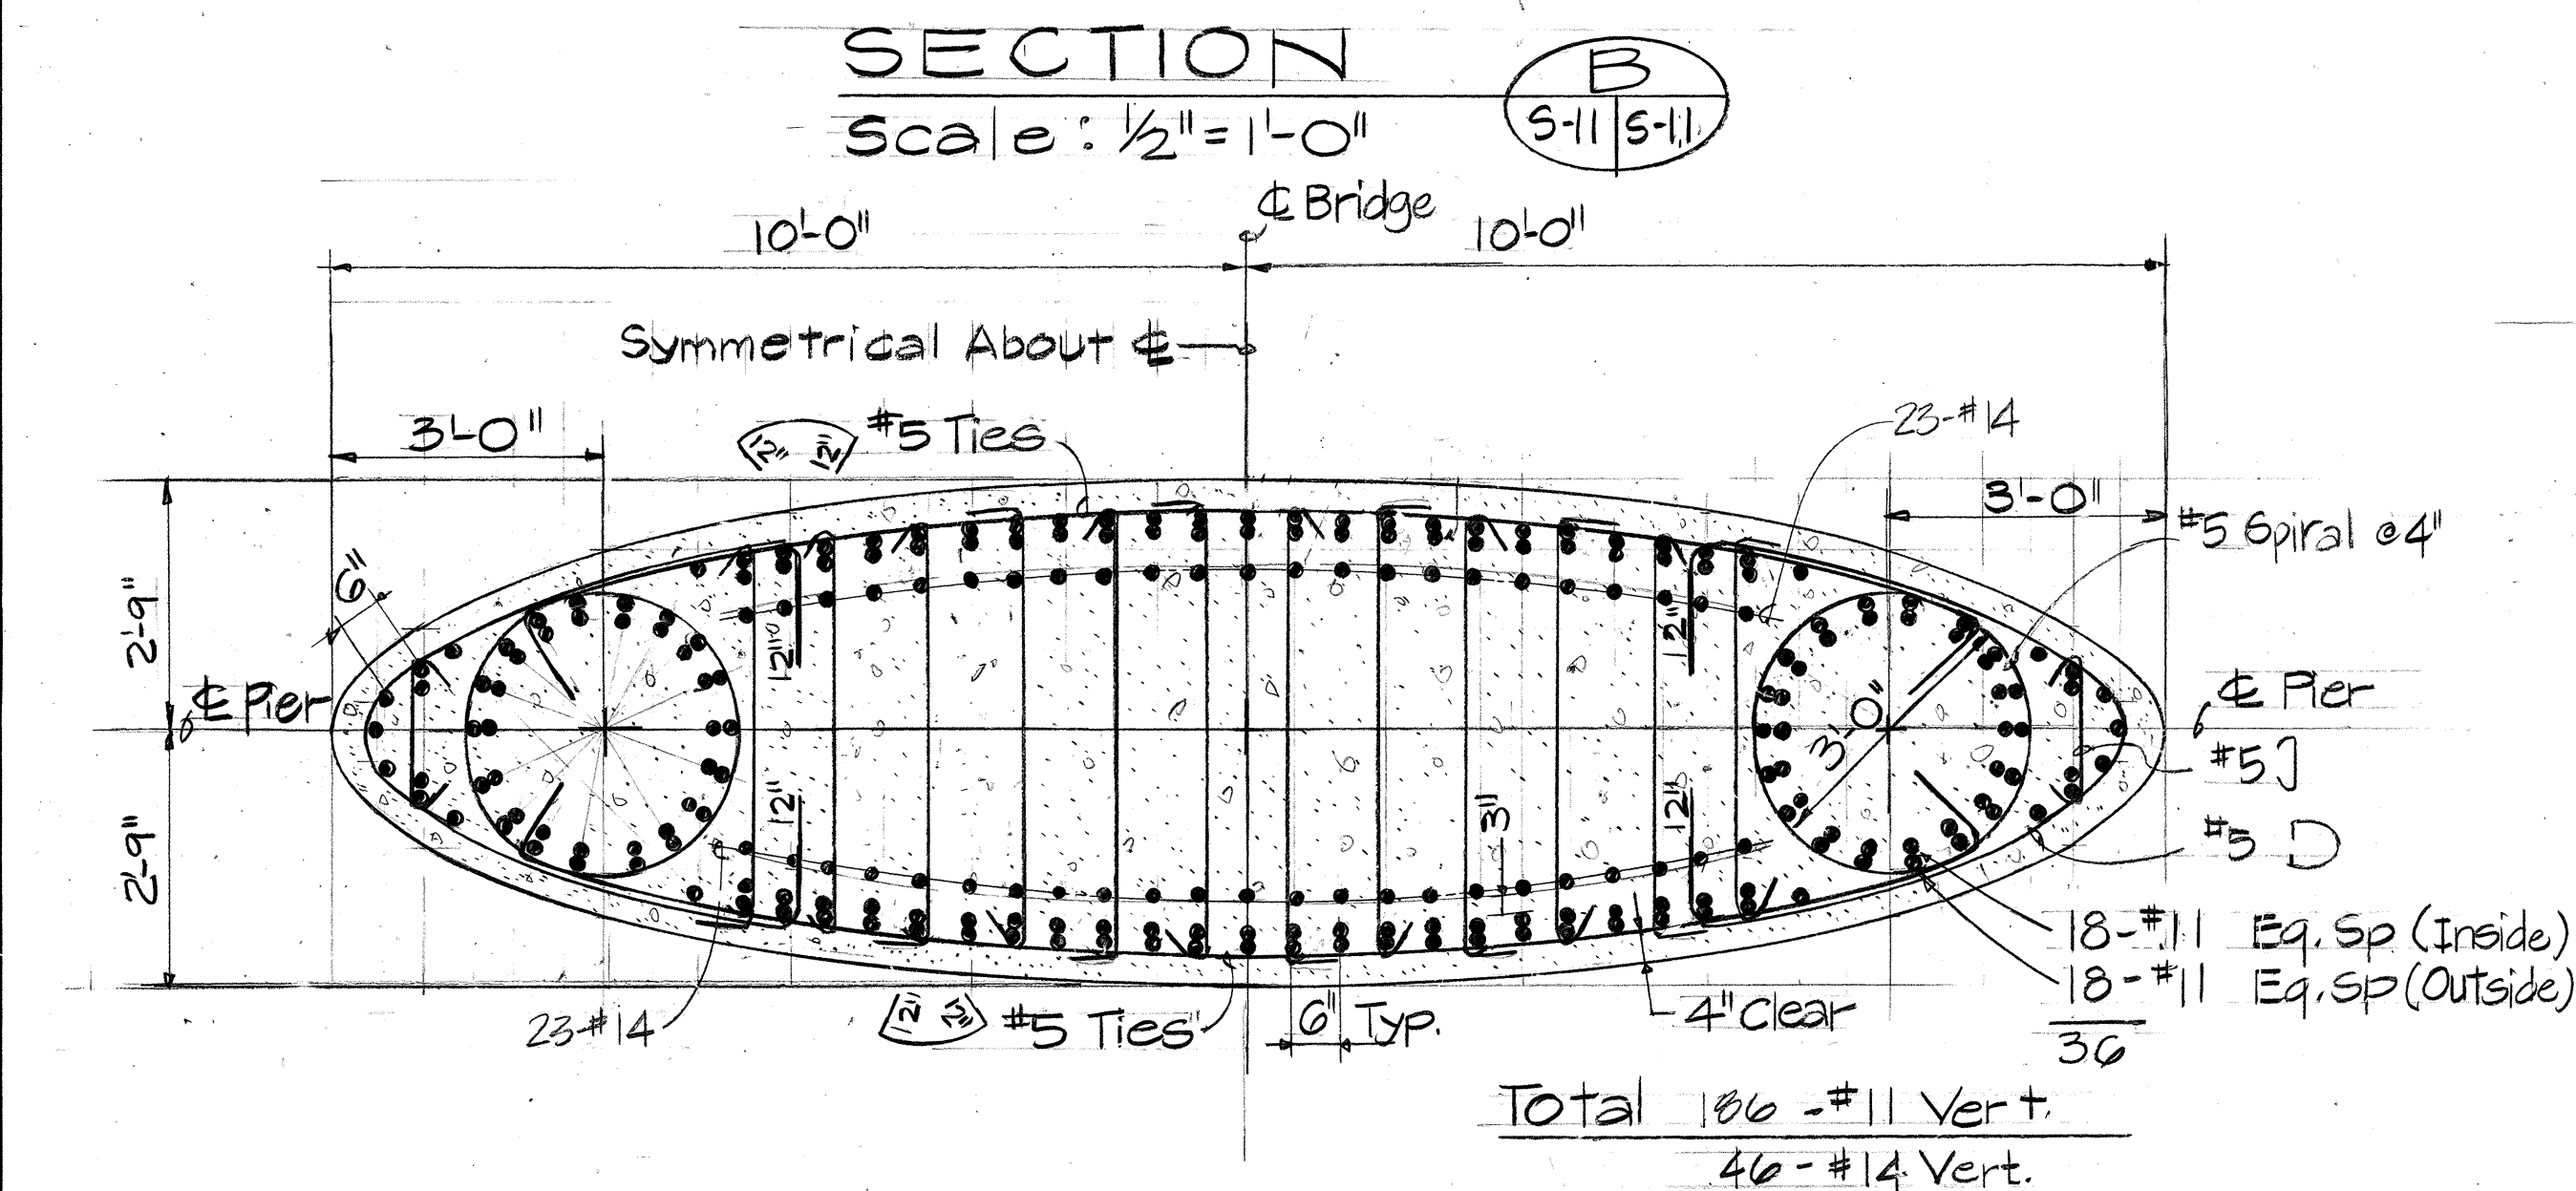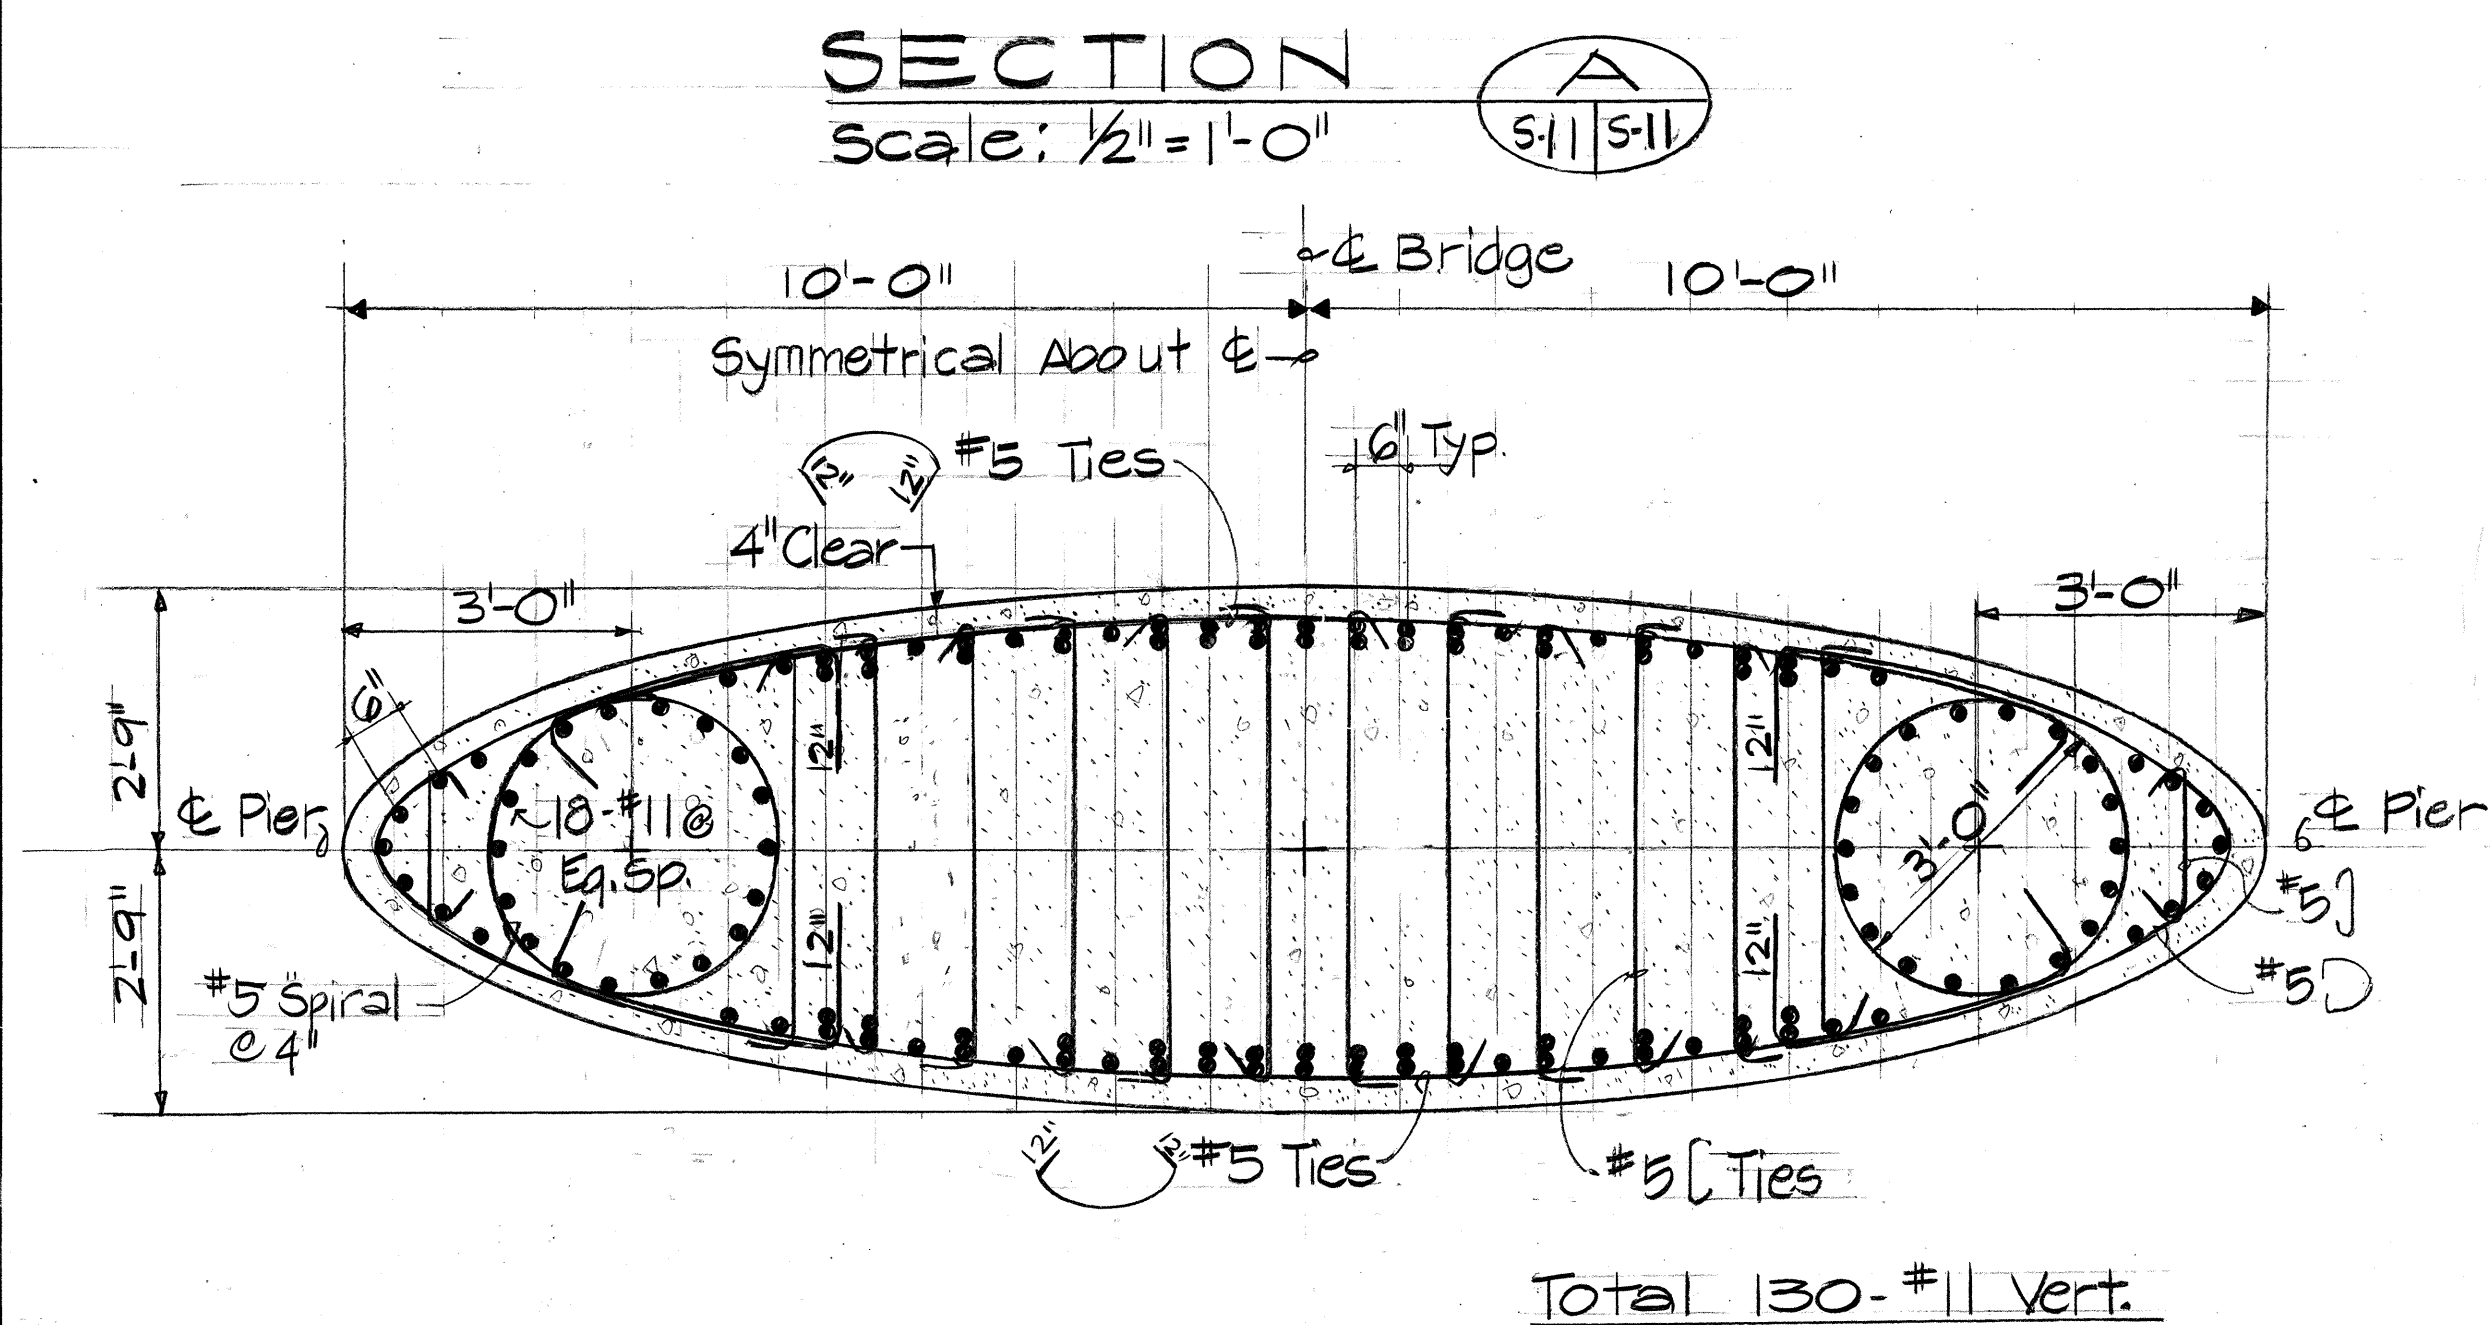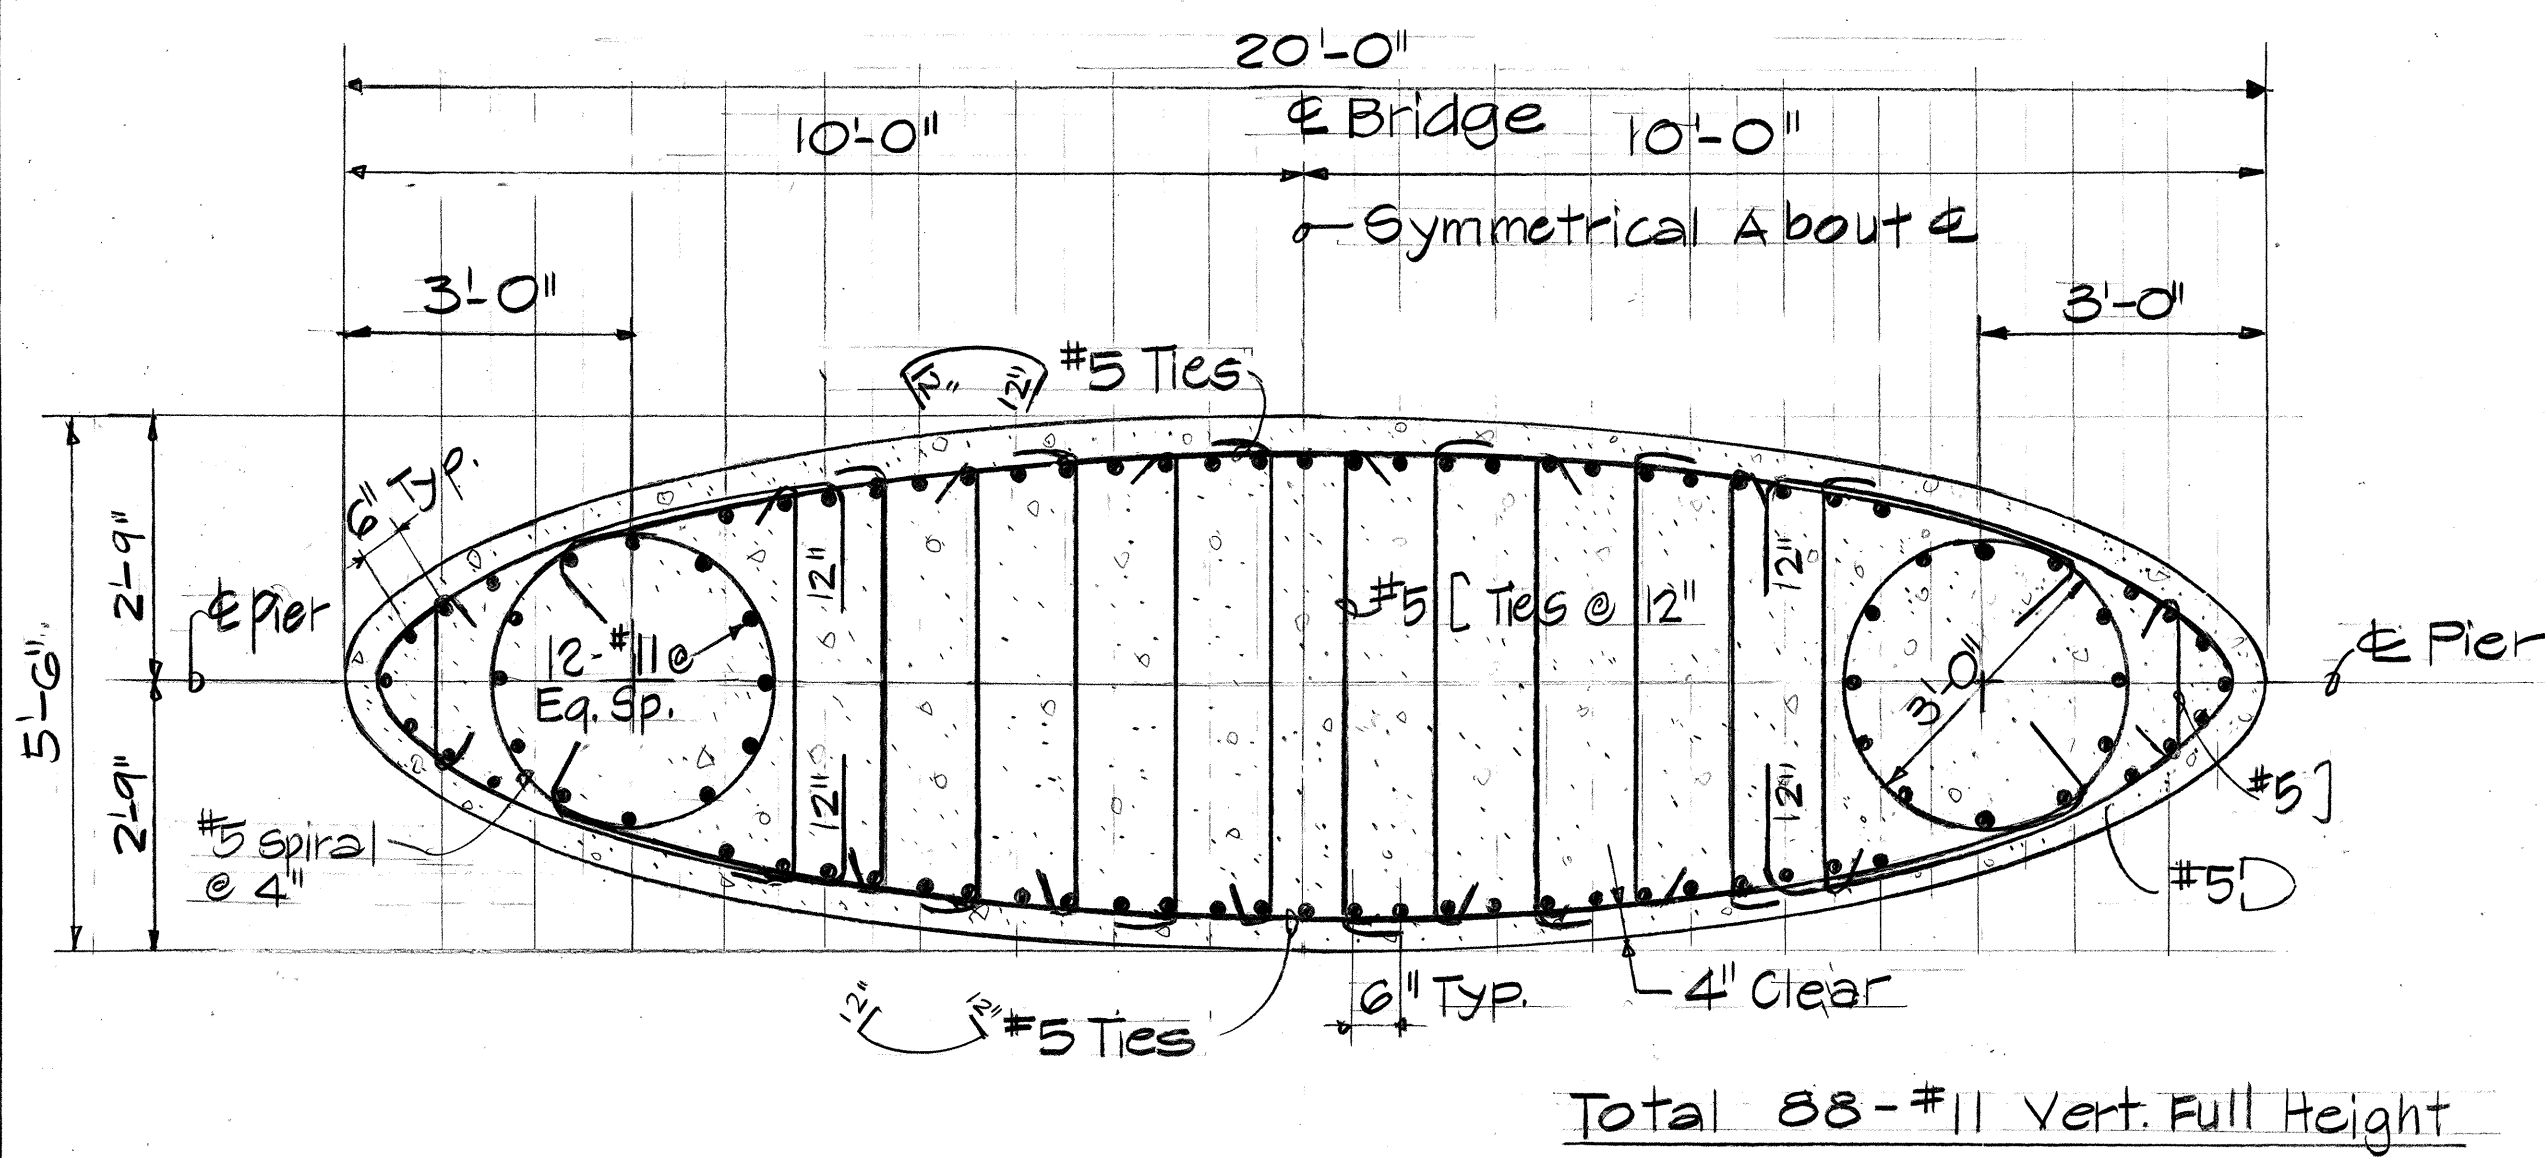


- Notes:
- All Pier vertical reinf. shall conform to ASTM A615 Grade 60.
 - Pier ties shall conform to ASTM A615 Grade 40.
 - Pier Cross section shall be in the form of an Ellipse, see Pier shape det.
 - Concrete for Pier Shaft shall have $f_c = 4,000$ p.s.i.
 - Pier Footing: For Reinf. and Details, see sheet S-10.
 - Box Pier Cap: For Reinf. and Details, see sheets S-11, S-12, S-13, S-14 & S-15.

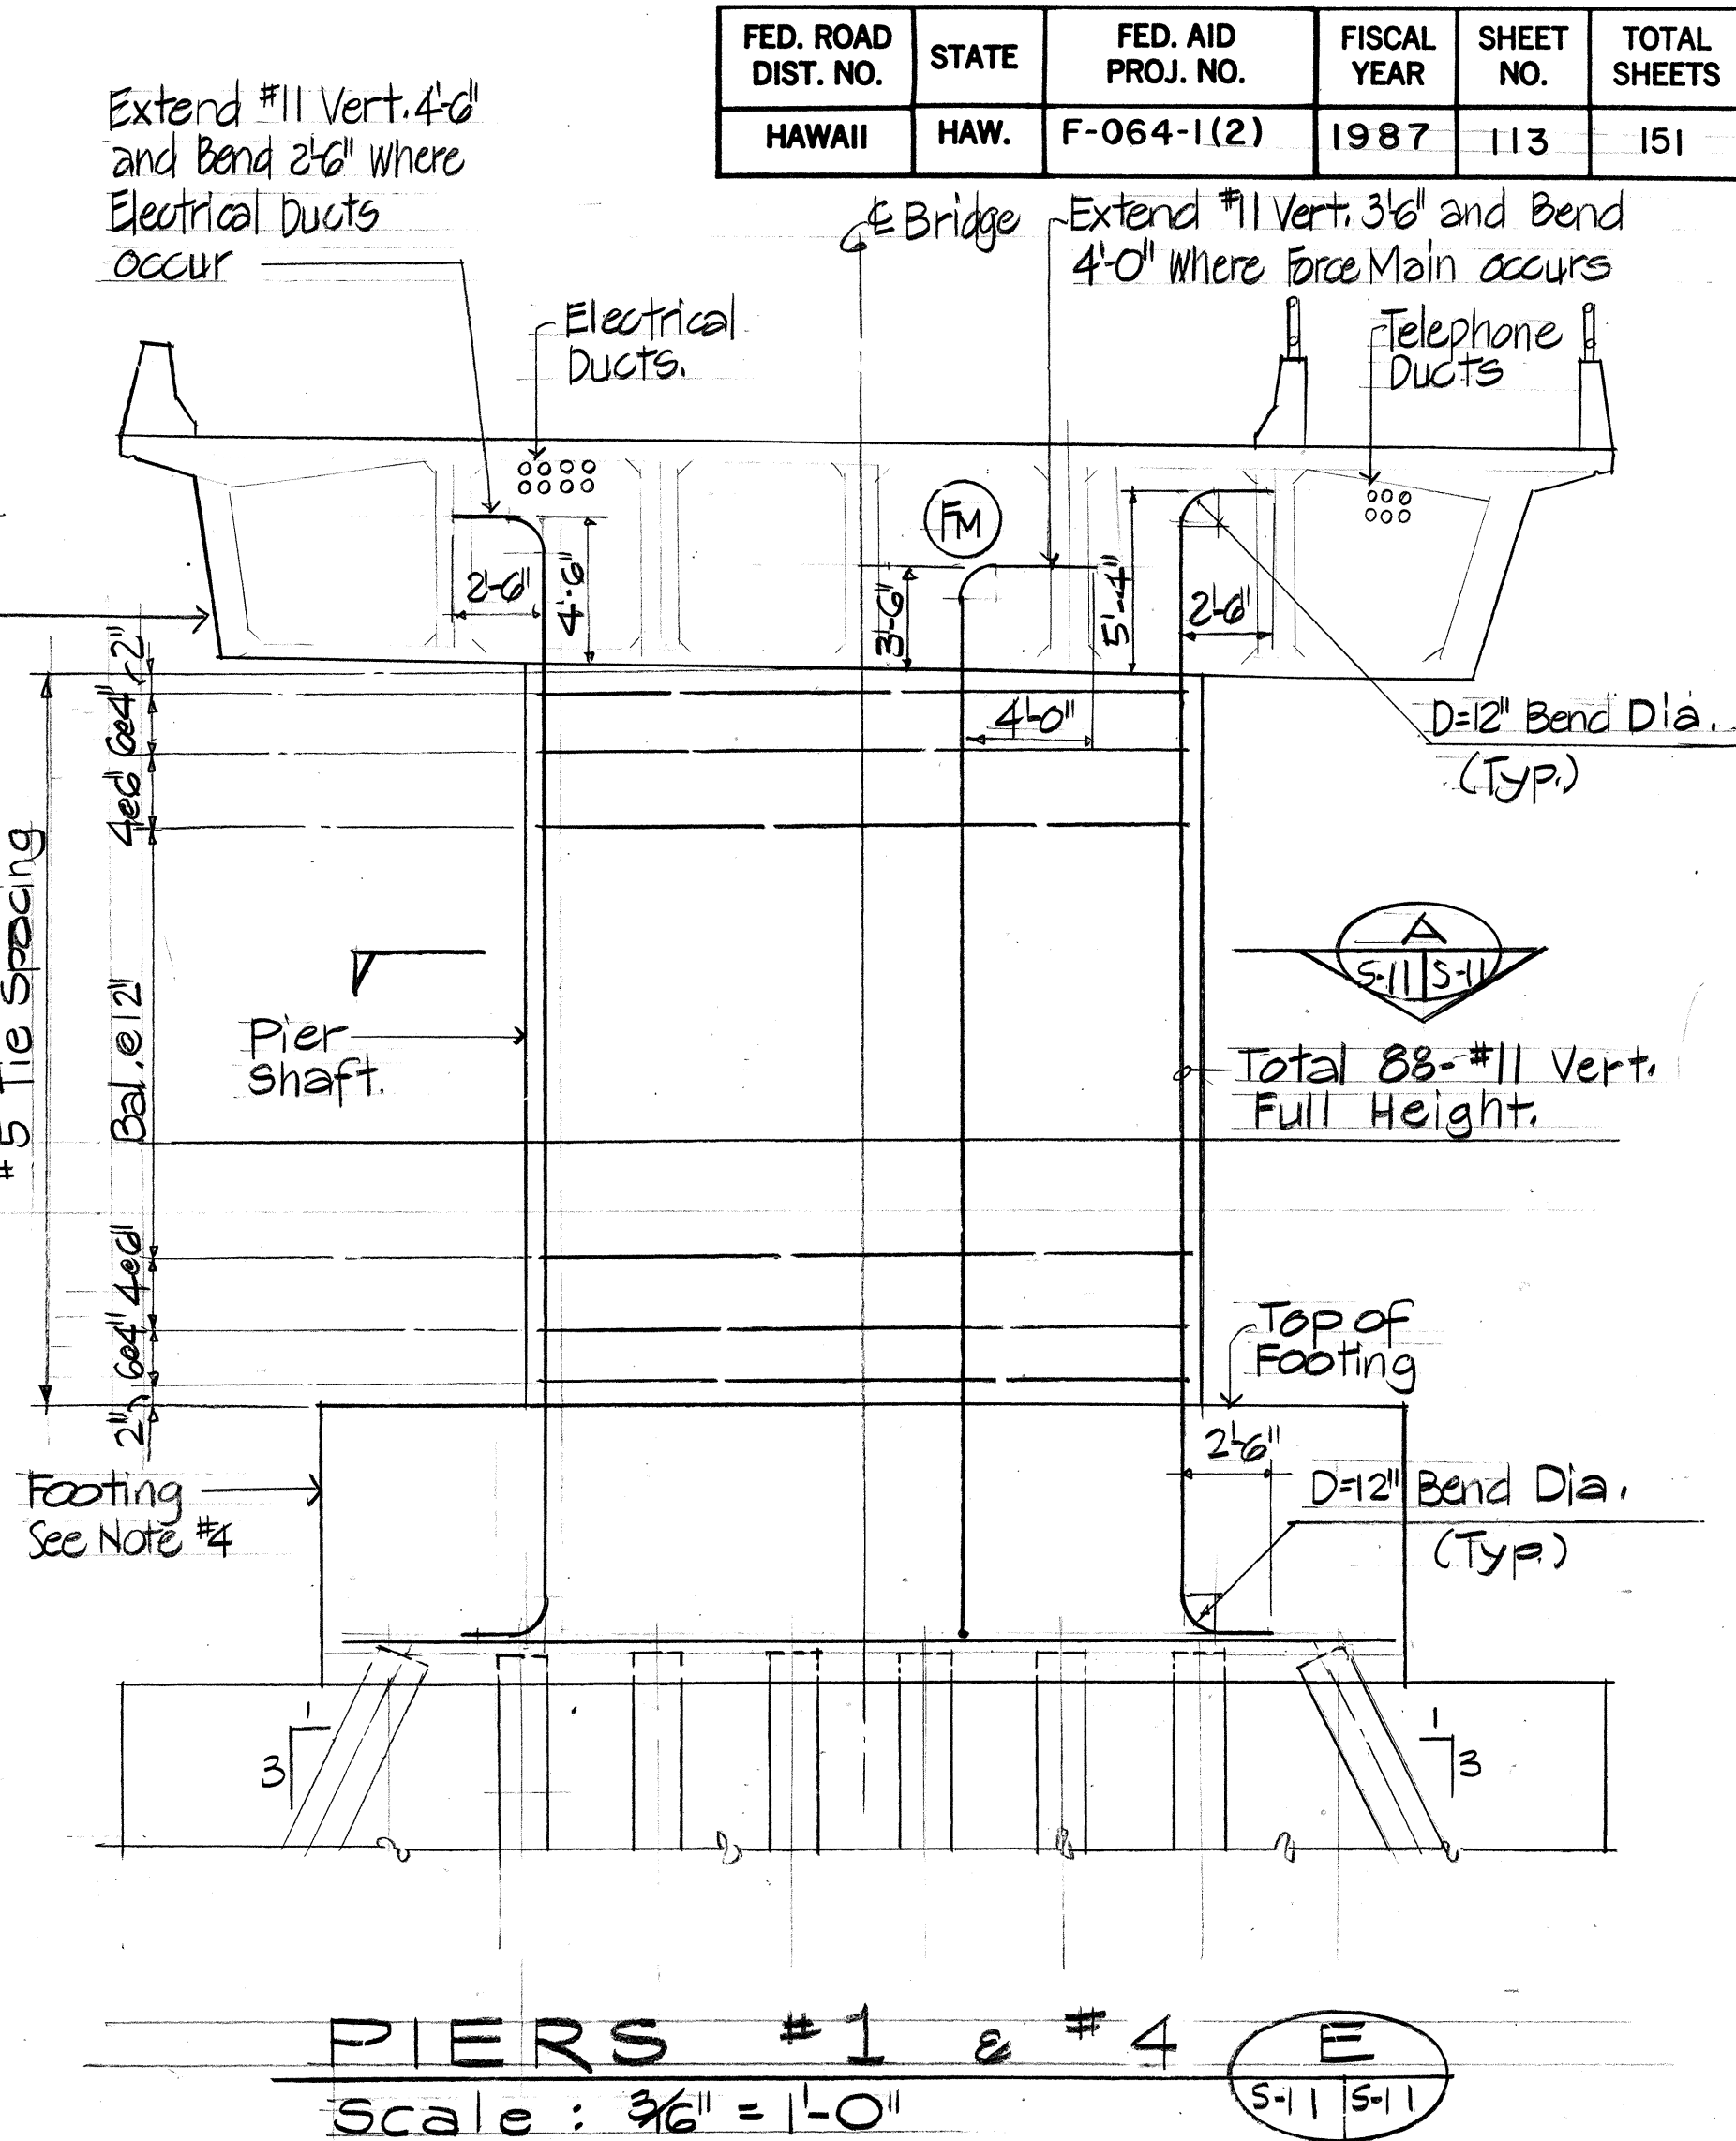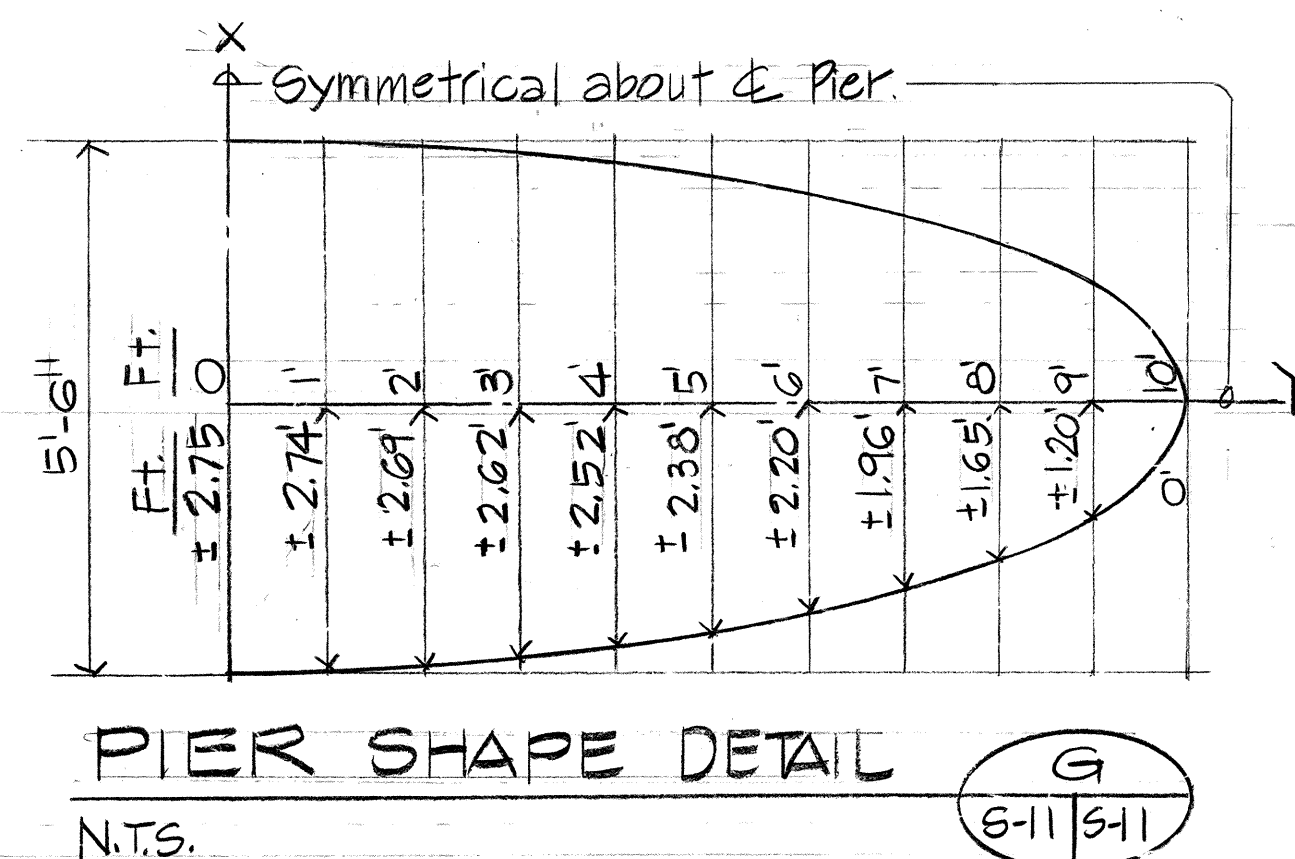

All Splices to develop not less than 90% of the specified Ultimate Tensile Strength of the Reinforcing Steel. No Lap Splices for #11 Vert. Reinf. will be allowed.

Stagger Mech. Splices

PIER VERT. BARS
SPICE DETAIL
N.T.S.

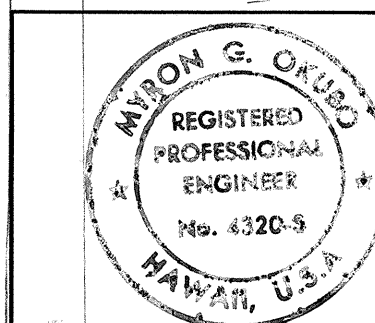

THIS WORK WAS PREPARED BY ME OR UNDER MY SUPERVISION

Myron Oakes

STATE OF HAWAII
DEPARTMENT OF TRANSPORTATION
HIGHWAYS DIVISION

PIERS - SECTIONS AND DETAILS


SAND ISLAND ROAD WIDENING
2ND. BRIDGE AND APPROACHES
FEDERAL AID PROJECT NO. F-064-1(2)

SCALE: AS NOTED DATE: JUN, 1986

SHEET NO. 5-11 OF 30 SHEETS


DATE REVISION

FED. ROAD DIST. NO.	STATE	FED. AID PROJ. NO.	FISCAL YEAR	SHEET NO.	TOTAL SHEETS
HAWAII	HAW.	F-064-1(2)	1987	114	151

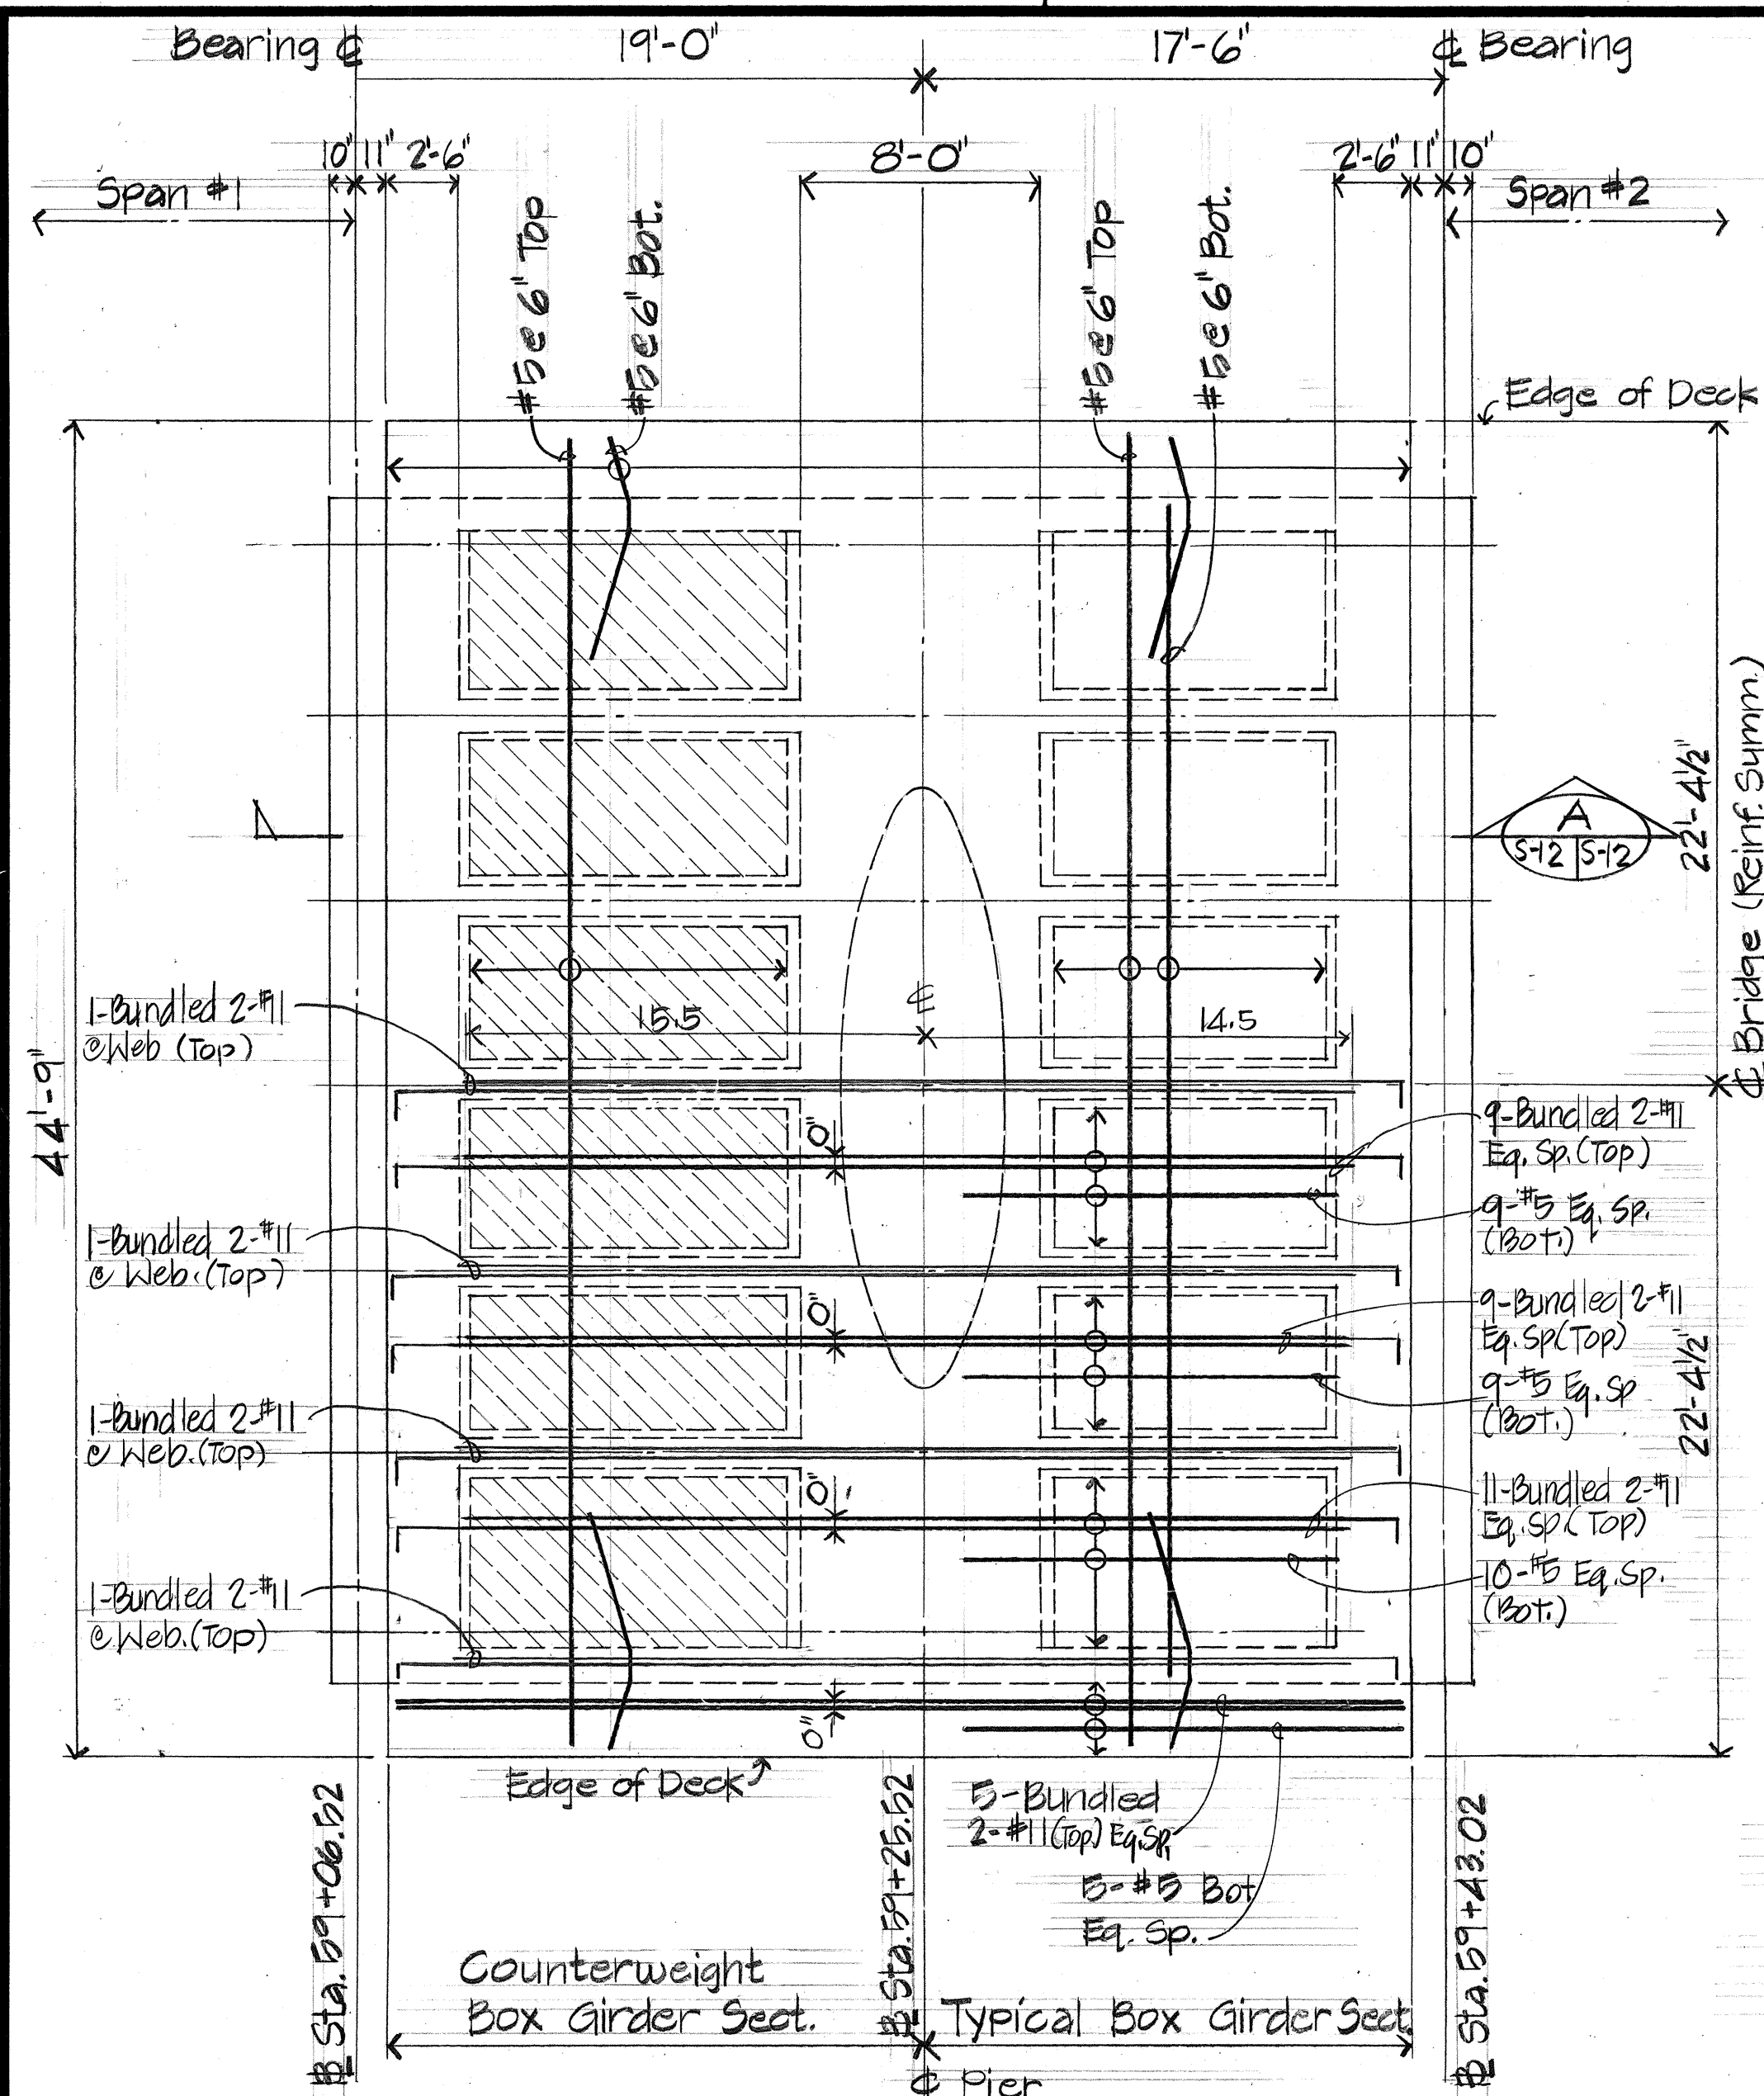


PIER #1 - PLAN

Scale: 3/16" = 1'-0"

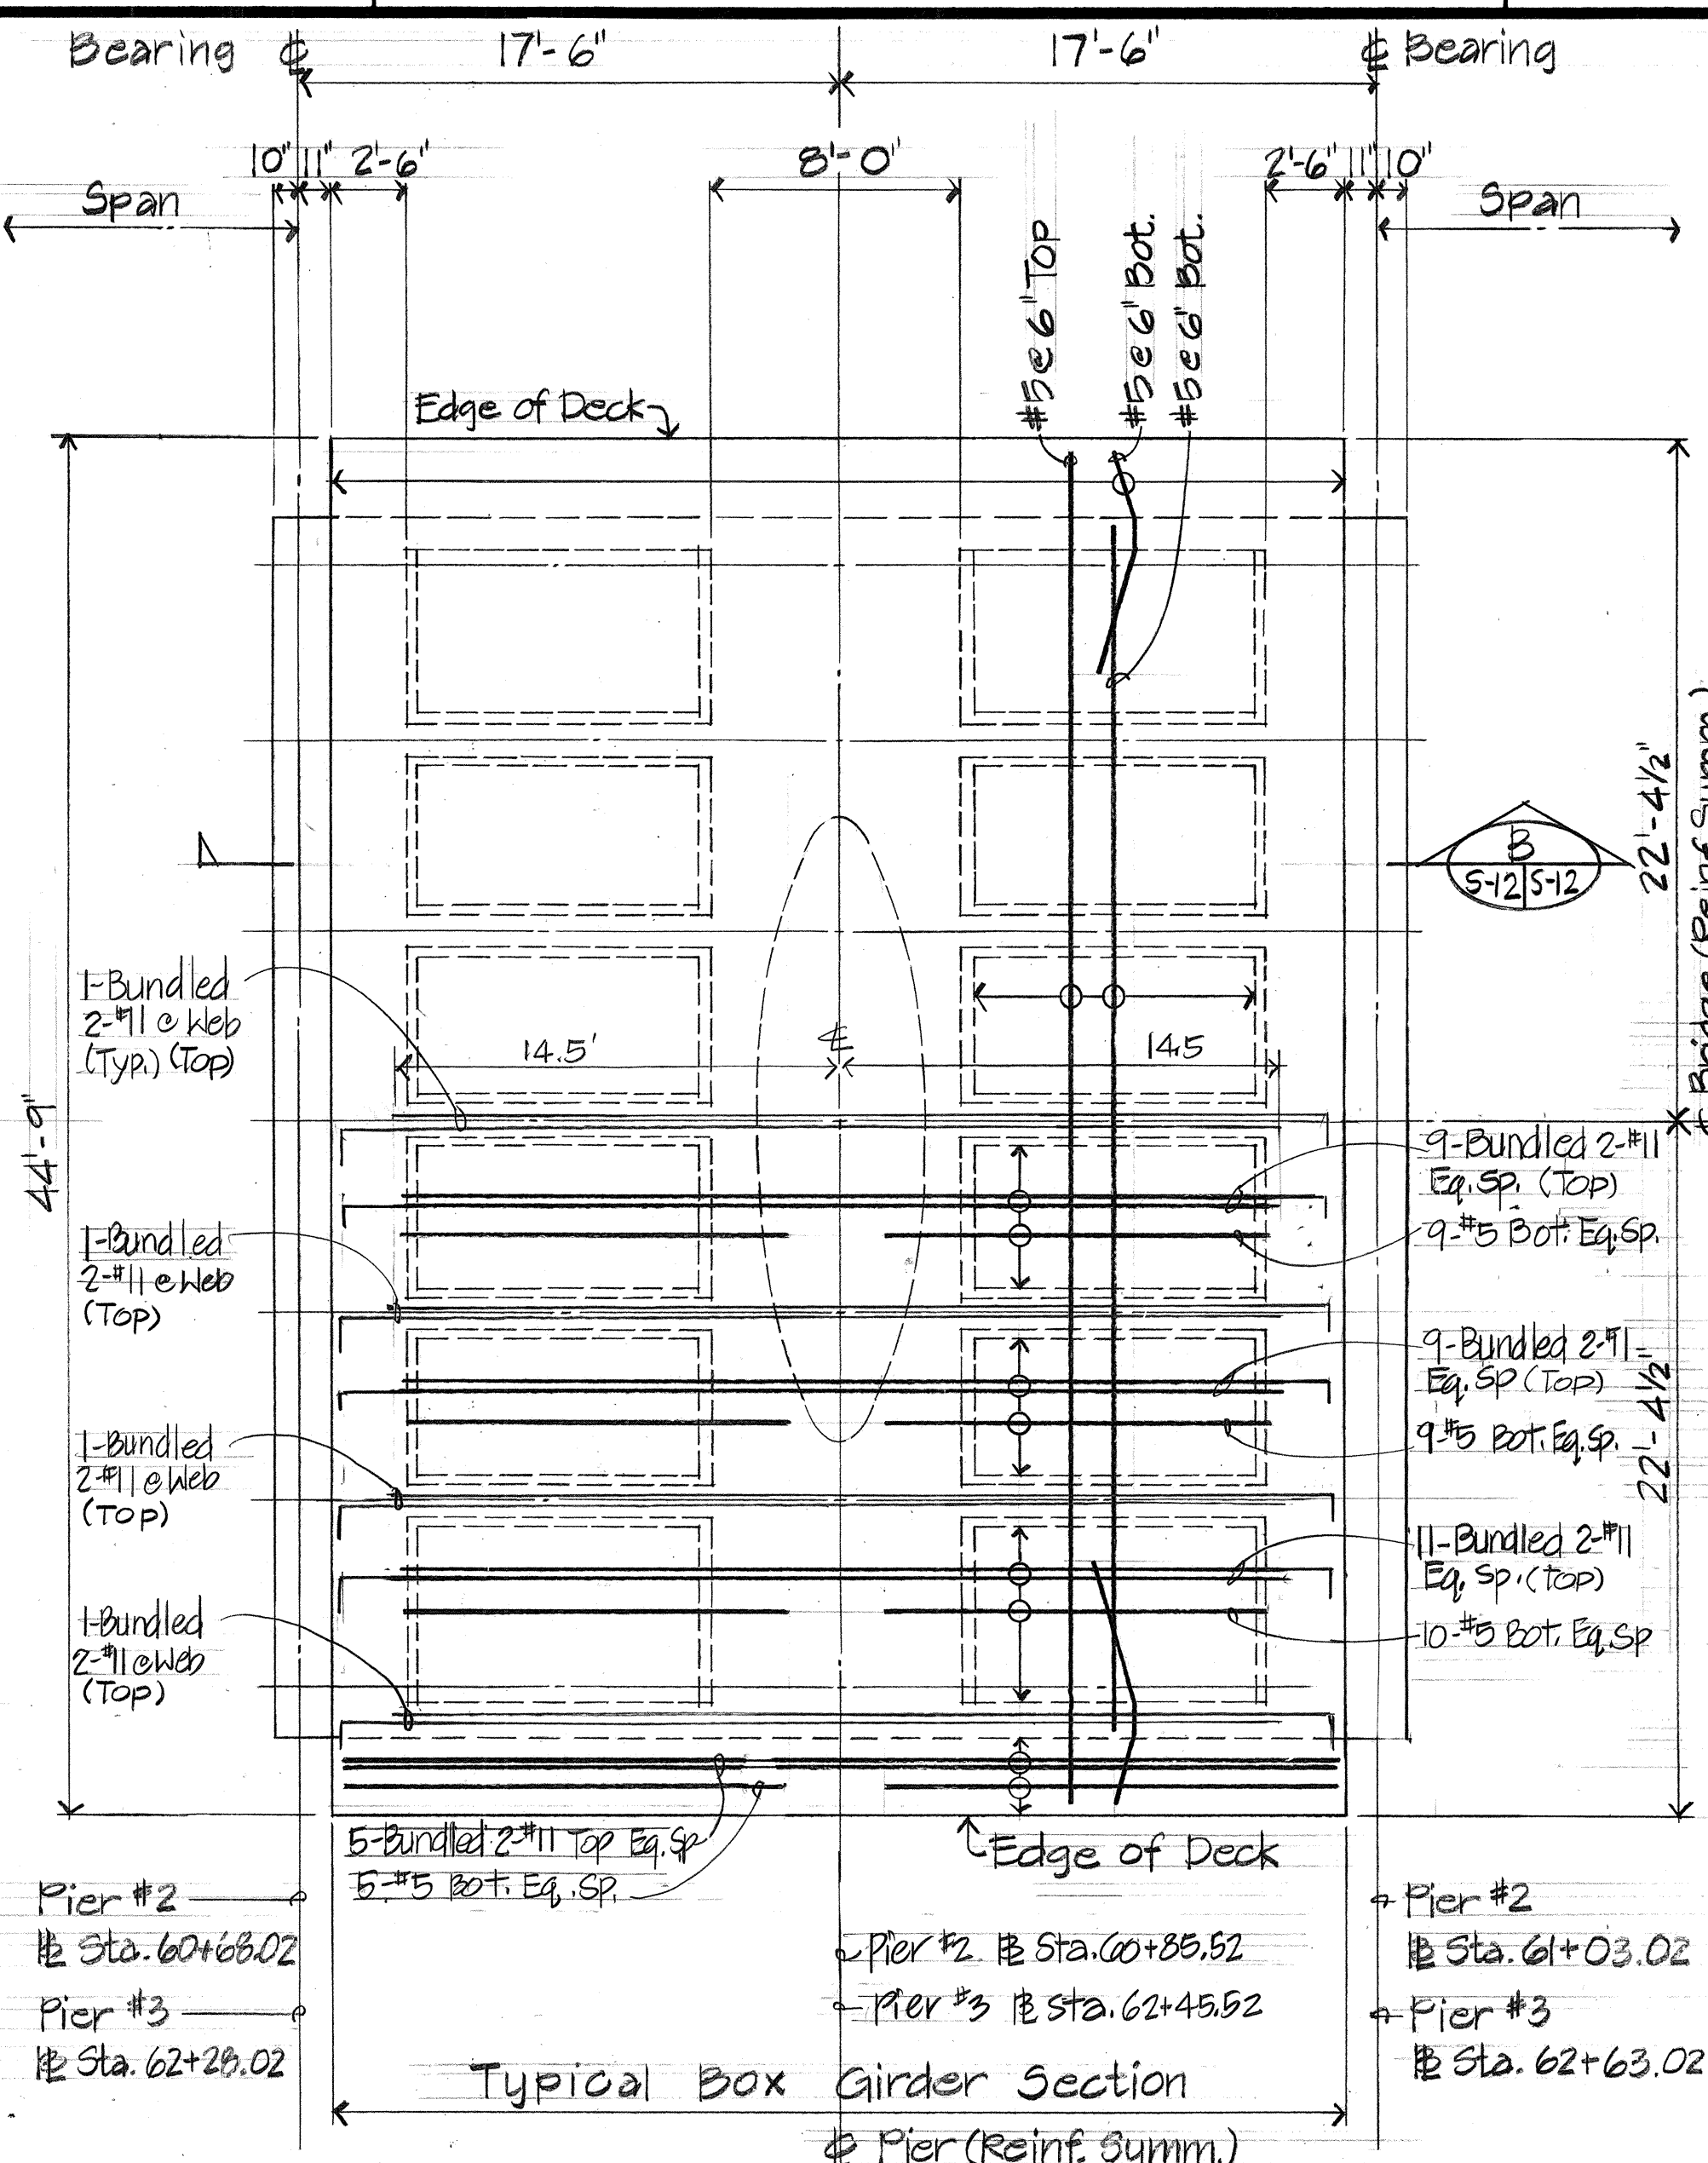


PIERS #2 & #3 - PLAN

Scale: 3/16" = 1'-0"

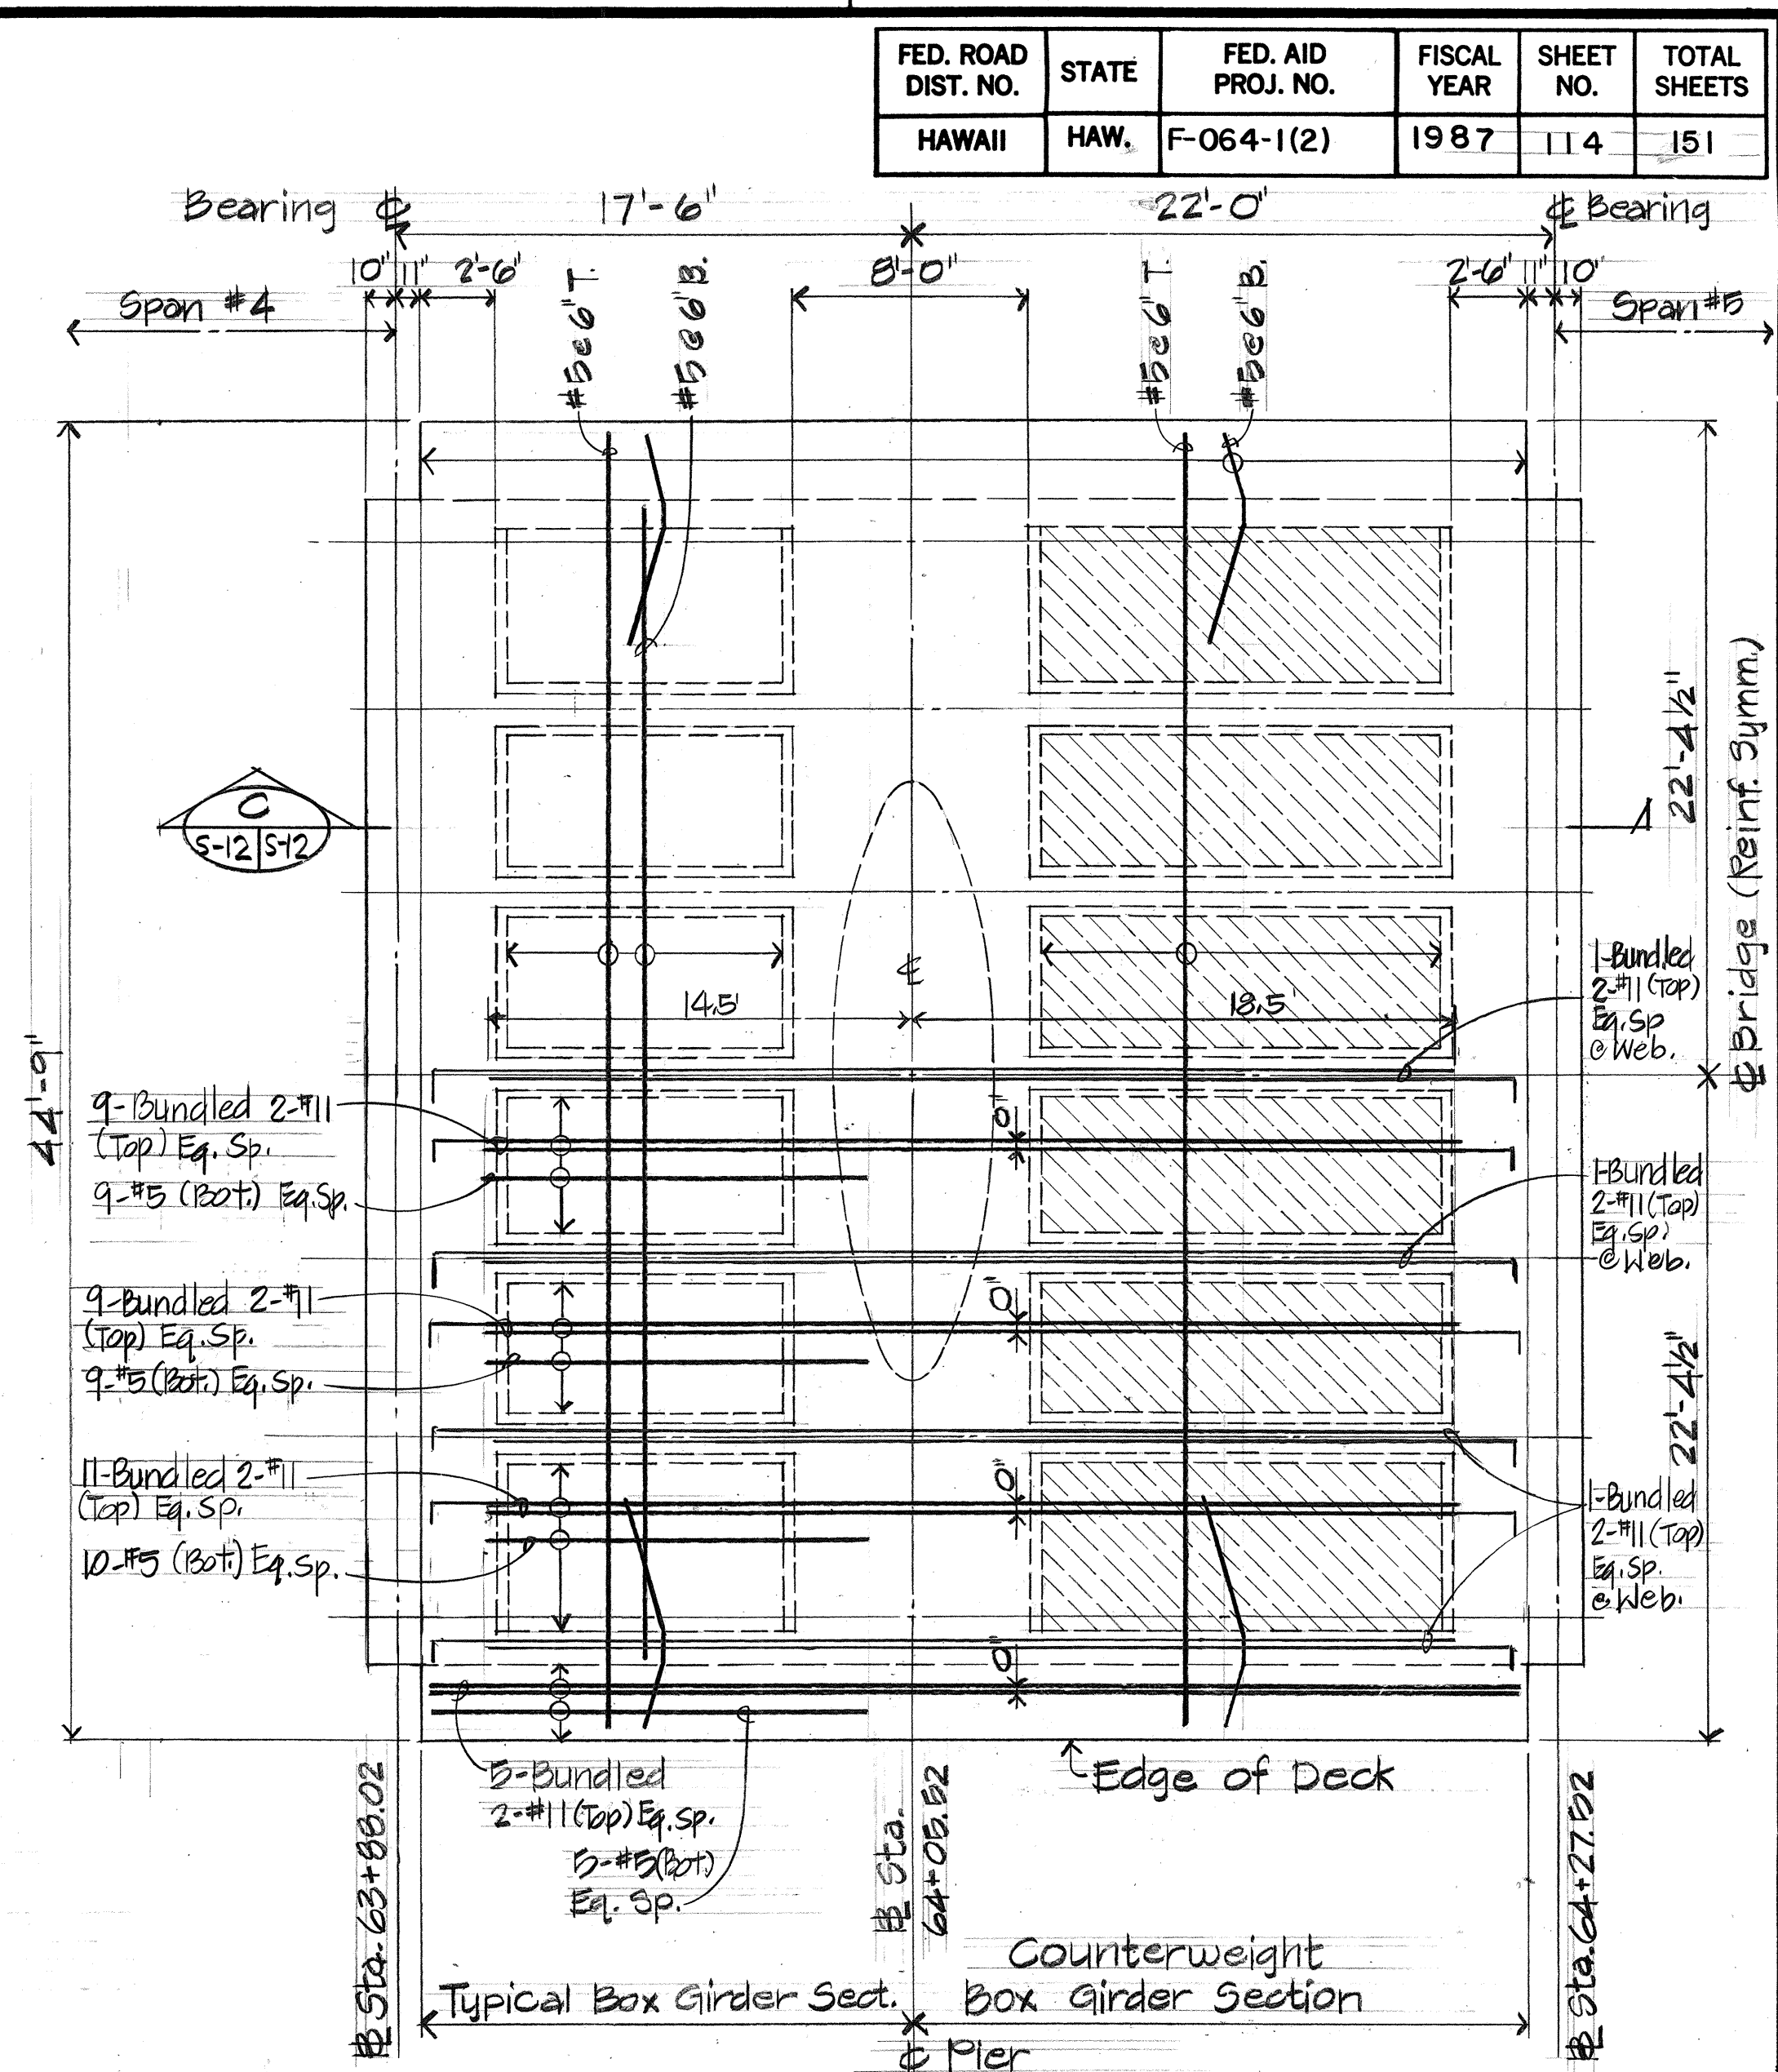


PIER #4 - PLAN

Scale: 3/16" = 1'-0"

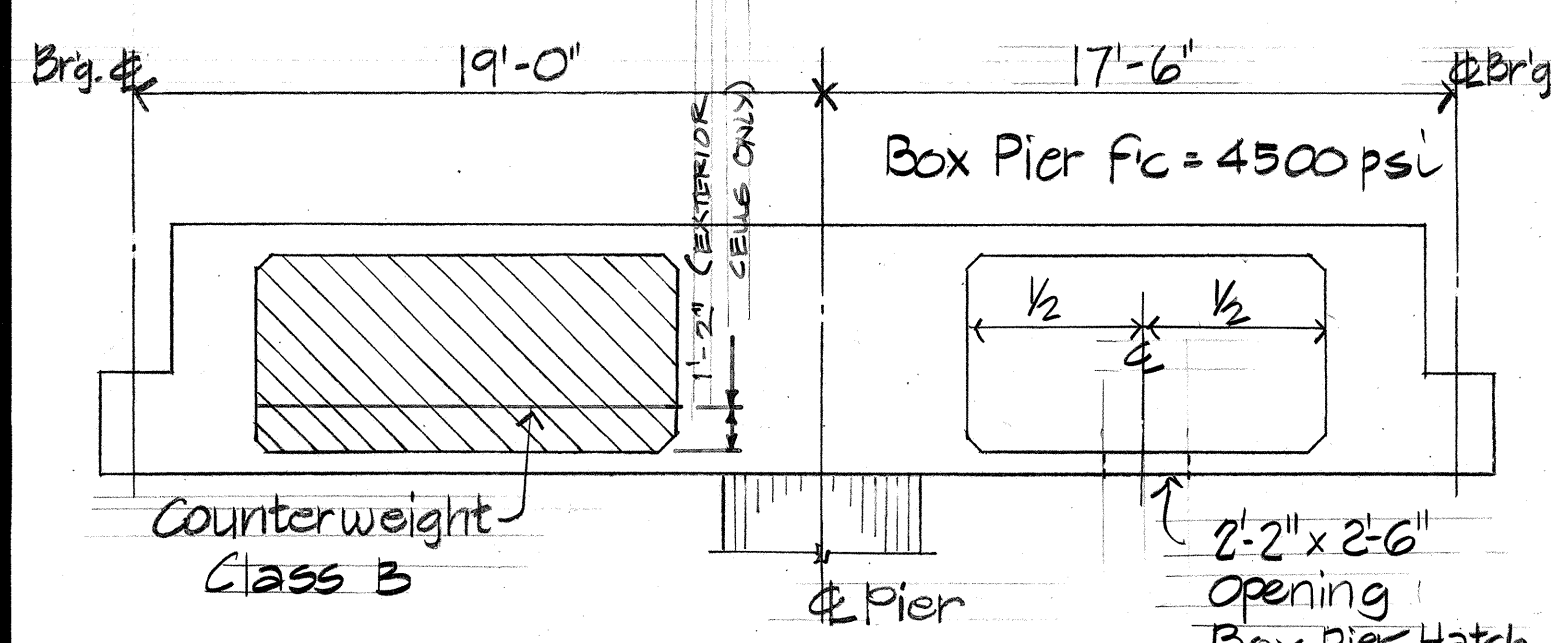


PIER #1 SECTION

Scale: 3/16" = 1'-0"

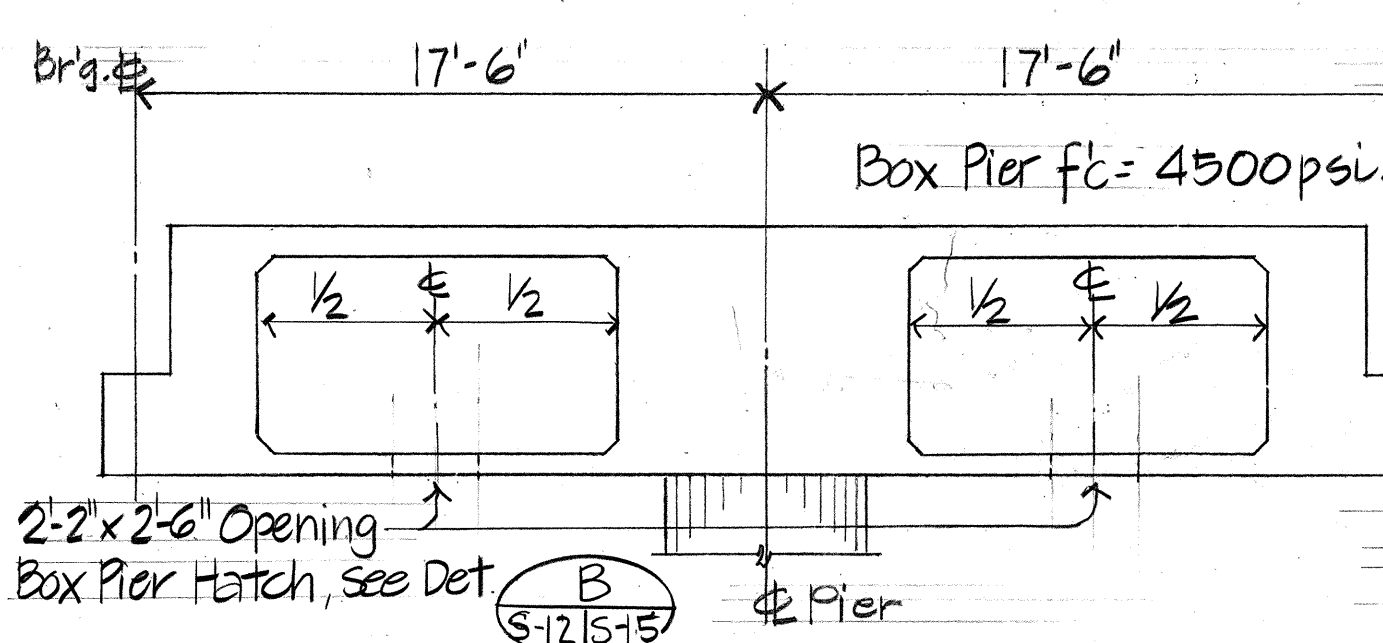

PIERS #2 & #3 SECTION

Scale: 3/16" = 1'-0"

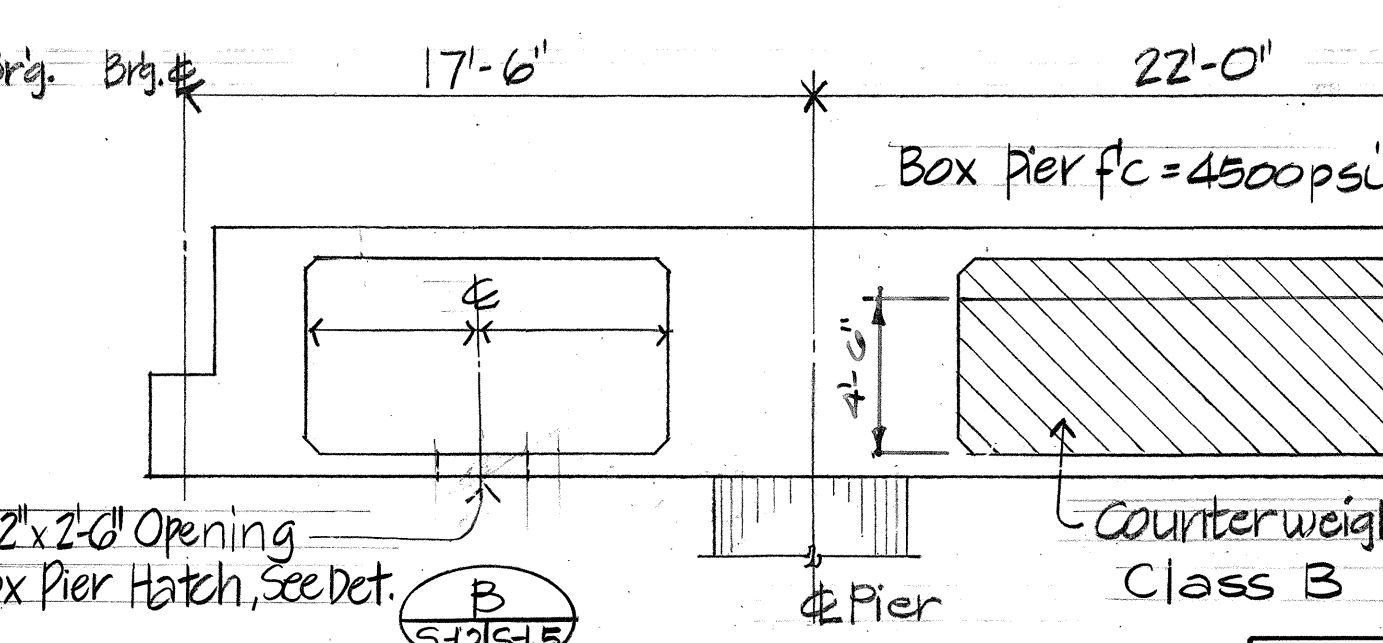

PIER #4 SECTION

Scale: 3/16" = 1'-0"

Note: Box Pier Hatch located only where 24" FM. pipe goes thru Box Piers.
All reinforcement for Box Pier shall be ASTM A615 Grade 60.

Cross Hatching Denotes Limits of Concrete Counterweight.
Concrete for Counterweight shall be Class B.
Concrete for Box Pier shall have $f_c = 4300$ psi.



THIS WORK WAS PREPARED BY ME OR UNDER MY SUPERVISION

Myron Okubo

STATE OF HAWAII
DEPARTMENT OF TRANSPORTATION
HIGHWAYS DIVISION

BOX PIER PLAN & SECTIONS


SAND ISLAND ROAD WIDENING
2 ND. BRIDGE AND APPROACHES
FEDERAL AID PROJECT NO.F-064-1(2)

SCALE: AS NOTED DATE: JUN, 1986
SHEET No.5-12 OF 30 SHEETS

DATE REVISION

"AS-BUILT"

FED. ROAD DIST. NO.	STATE	FED. AID PROJ. NO.	FISCAL YEAR	SHEET NO.	TOTAL SHEETS
HAWAII	HAW.	F-064-1(2)	1987	115	151

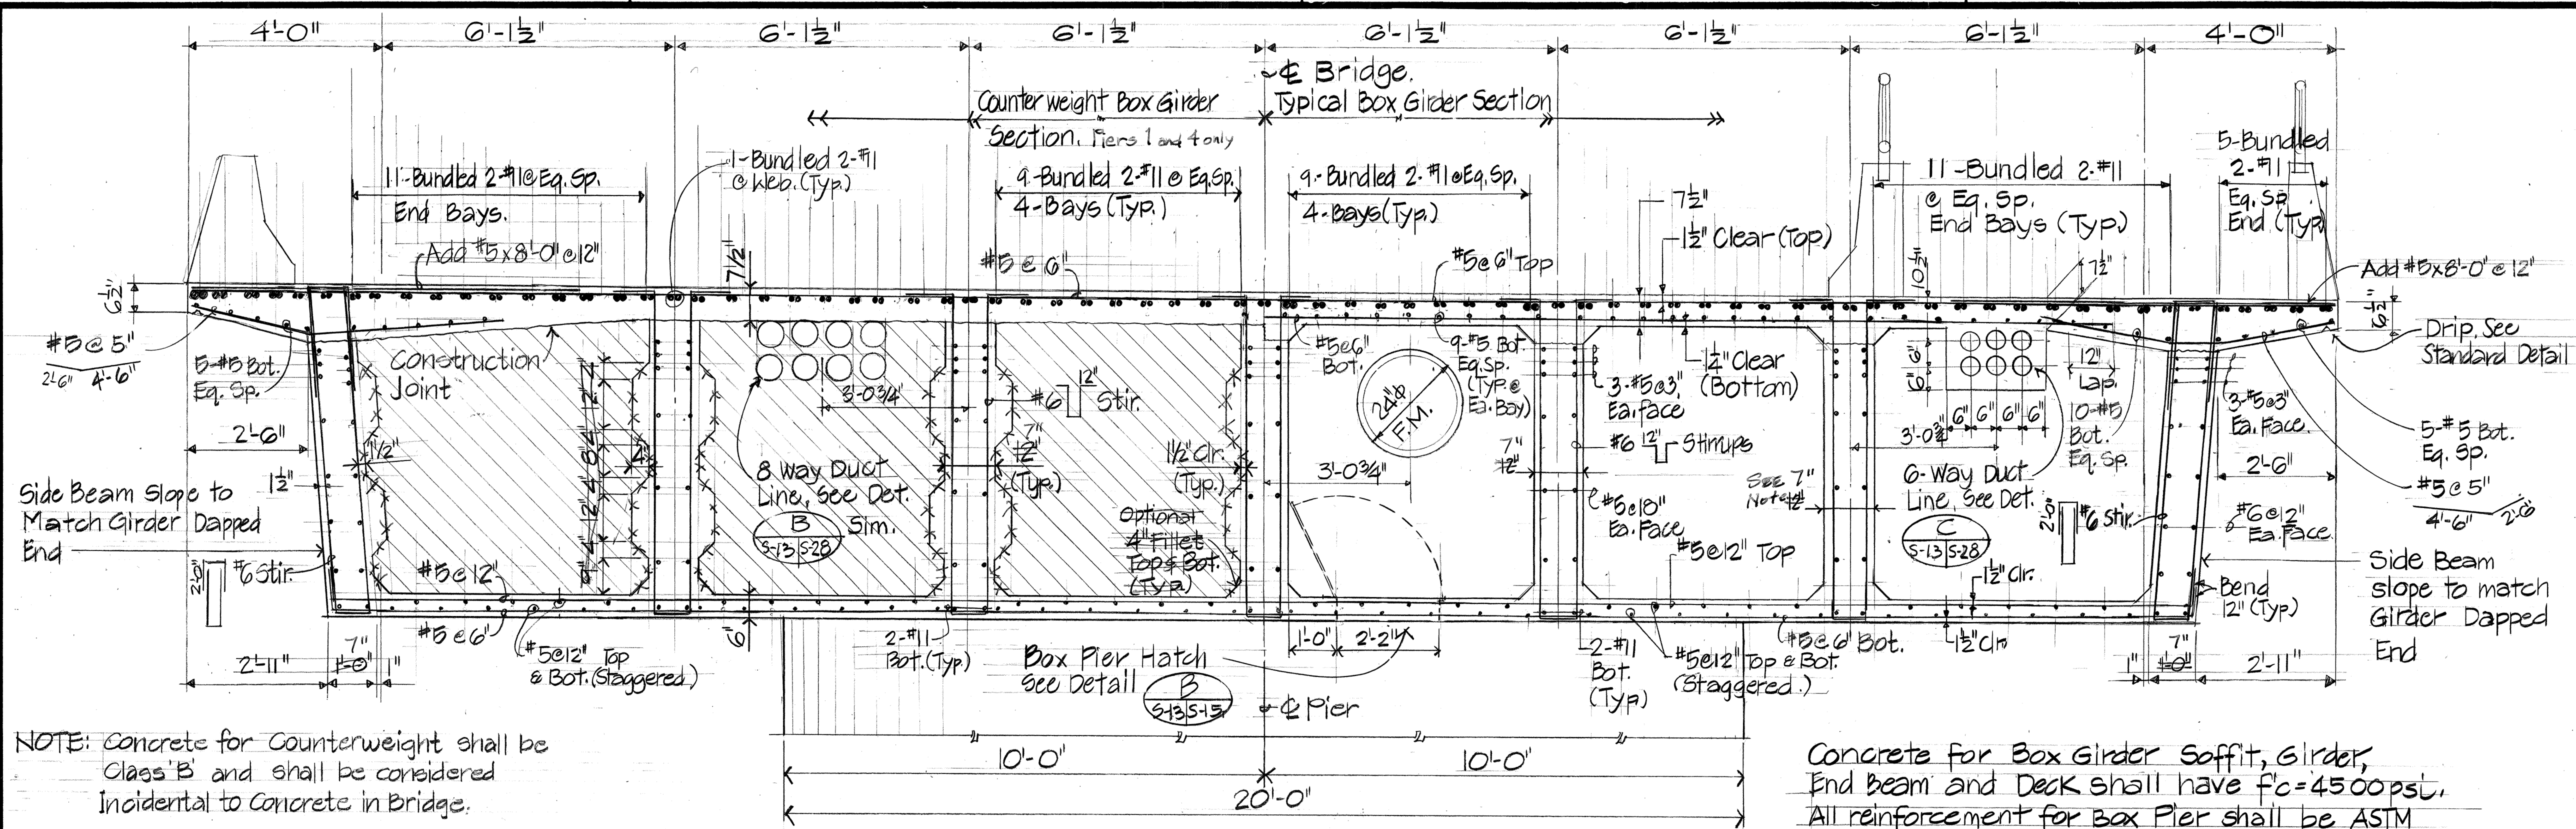


NOTE: Concrete for Counterweight shall be Class 'B' and shall be considered incidental to concrete in Bridge.


Concrete for Box Girder Soffit, Girder End beam and Deck shall have $f'_c = 4500 \text{ psi}$. All reinforcement for Box Pier shall be ASTM A615 Grade 60.

Note: As-built girders not as shown. See Sht. C.O. 121.

SECTION A
Scale: 1/2" = 1'-0"

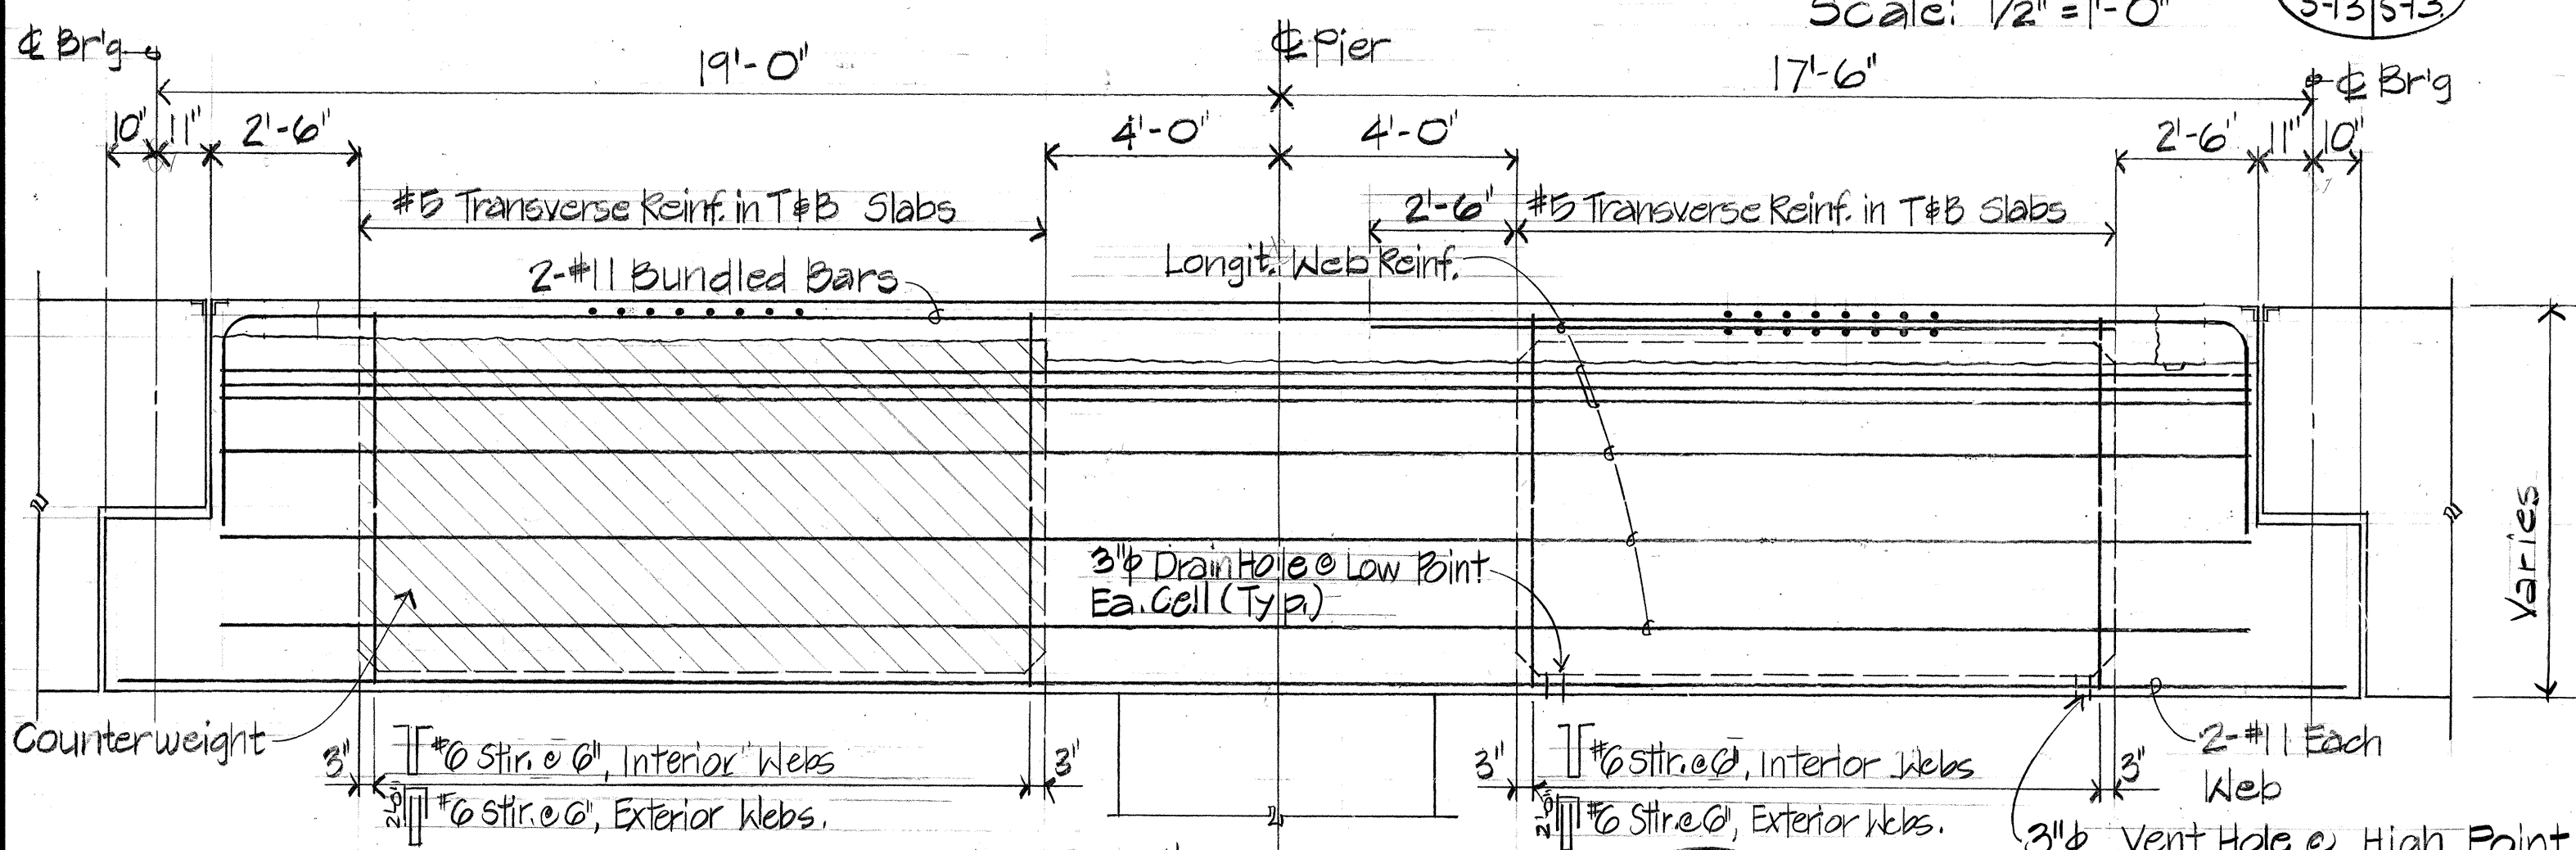


PIER #1 SECTION B
Scale: 3/8" = 1'-0"

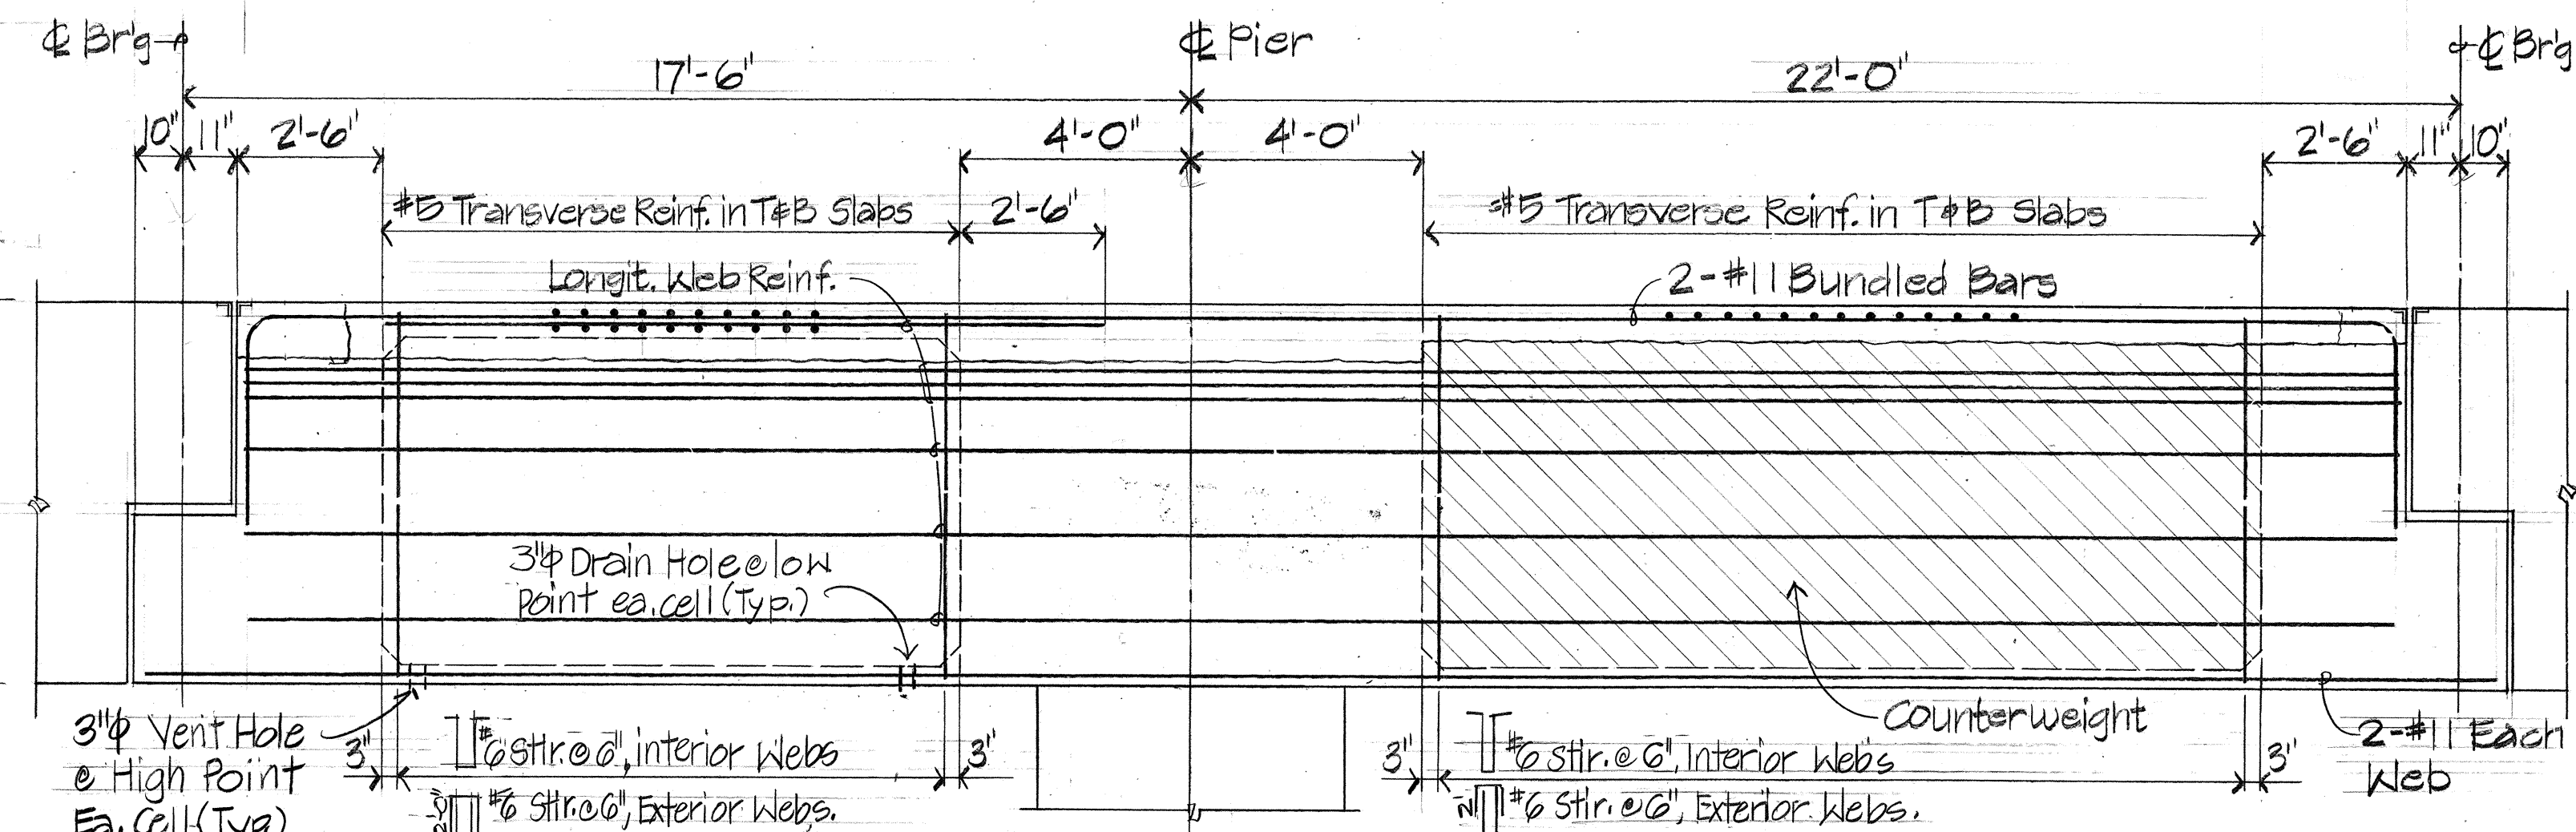

PIER #4 SECTION D
Scale: 3/8" = 1'-0"

Note: Drain and Vent Holes shall be of Non-Corrosive Material with 1/2" Drip all around. See Standard Details.

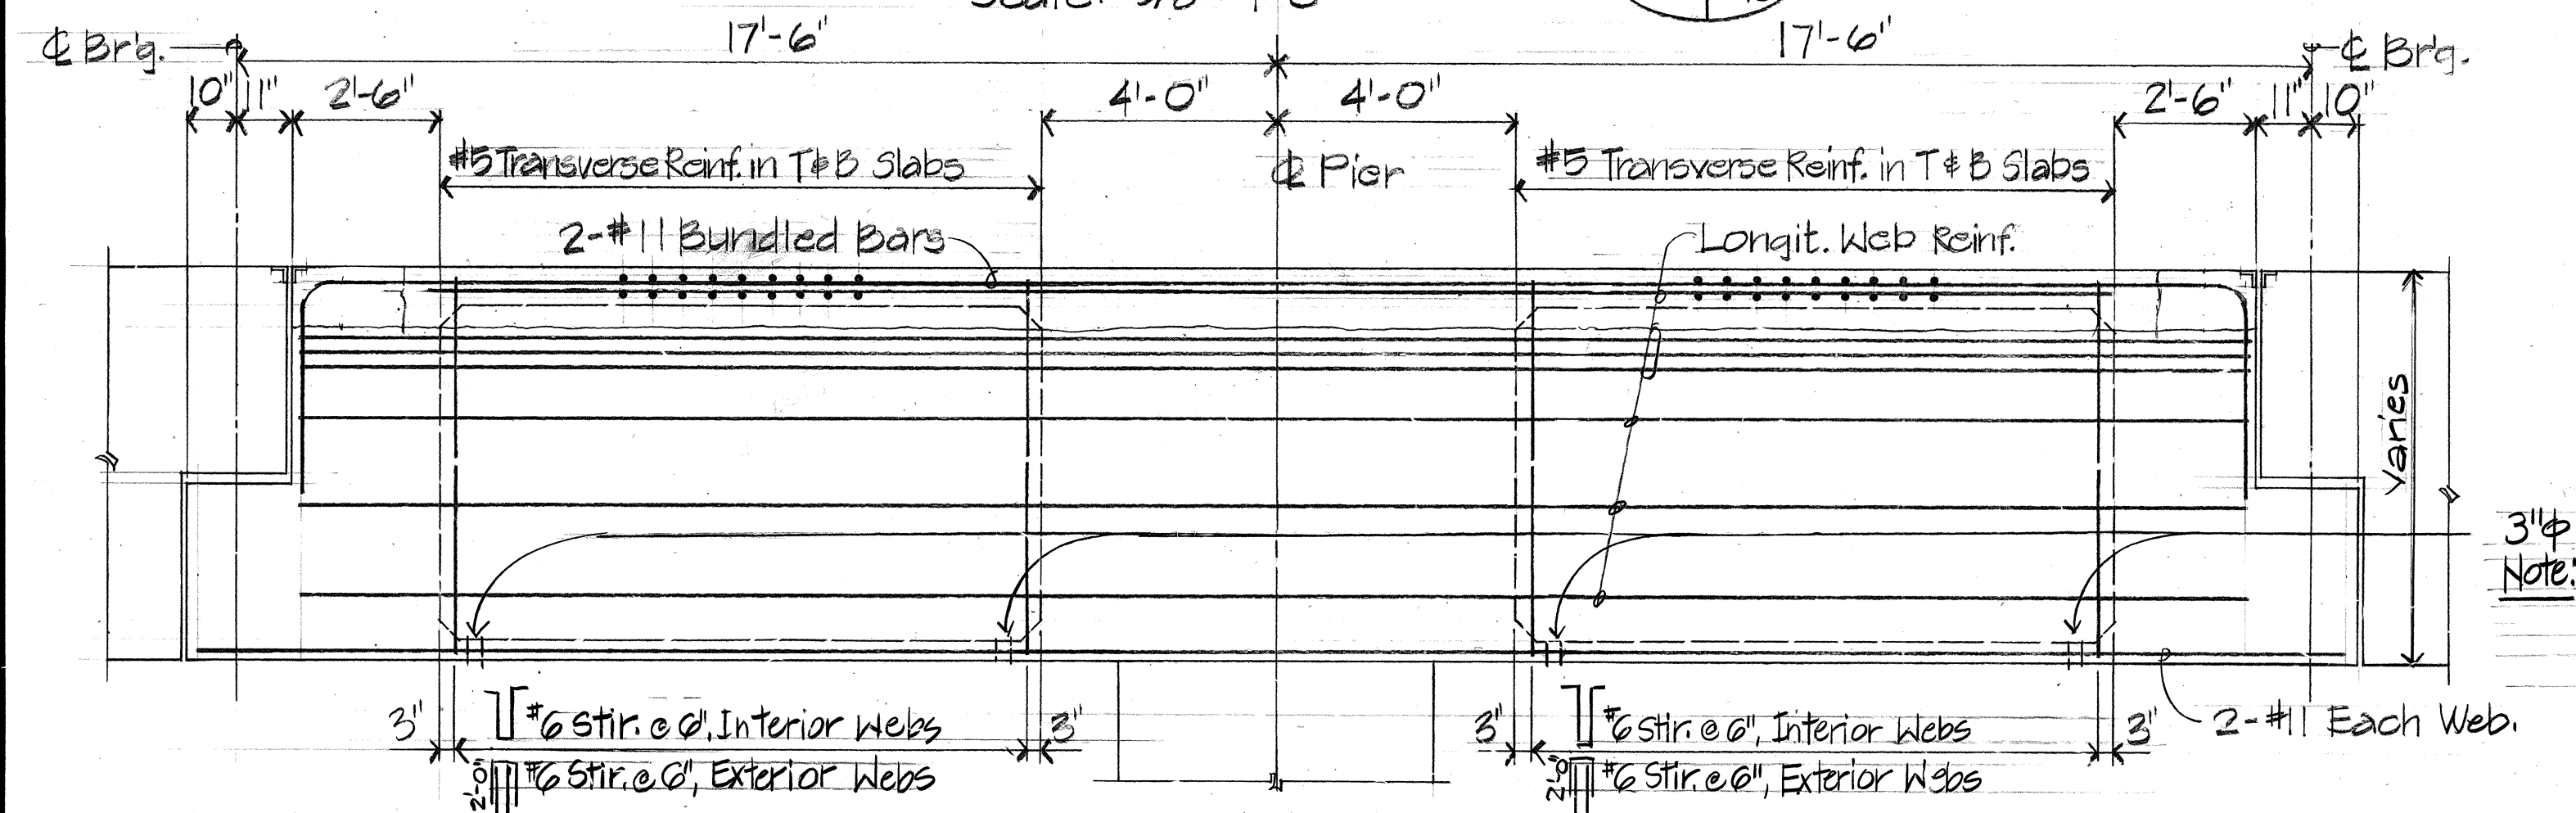

PIERS #2 & #3 SECTION C
Scale: 3/8" = 1'-0"

MYRON G. OKUNO
REGISTERED PROFESSIONAL ENGINEER
No. 4390-S
HAWAII, U.S.A.
THIS WORK WAS PREPARED BY ME OR UNDER MY SUPERVISION
Myron Okuno

STATE OF HAWAII
DEPARTMENT OF TRANSPORTATION
HIGHWAYS DIVISION

BOX PIER DETAILS

SAND ISLAND ROAD WIDENING
2ND BRIDGE AND APPROACHES
FEDERAL AID PROJECT NO. F-064-1(2)

SCALE: AS NOTED DATE: JUN, 1986
SHEET NO. 513 OF 30 SHEETS






DATE	REVISION

"AS-BUILT"

DATE	
SURVEY PLOTTED BY	
DESIGNED BY	
NOTED BY	
CHECKED BY	
ORIGINAL PLAN	
NO.	

FED. ROAD DIST. NO.	STATE	FED. AID PROJ. NO.	FISCAL YEAR	SHEET NO.	TOTAL SHEETS
HAWAII	HAW.	F-064-1(2)	1987	116	151

Notes:
1. All reinforcement in Box Pier shall be ASTM A615 Grade 60.

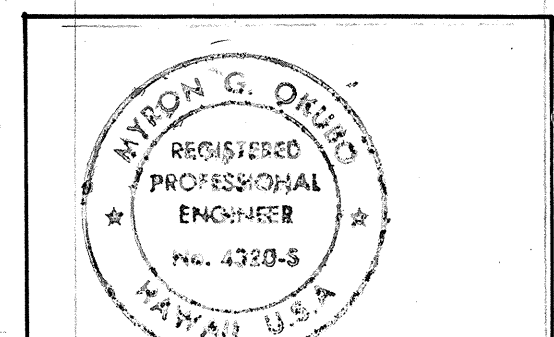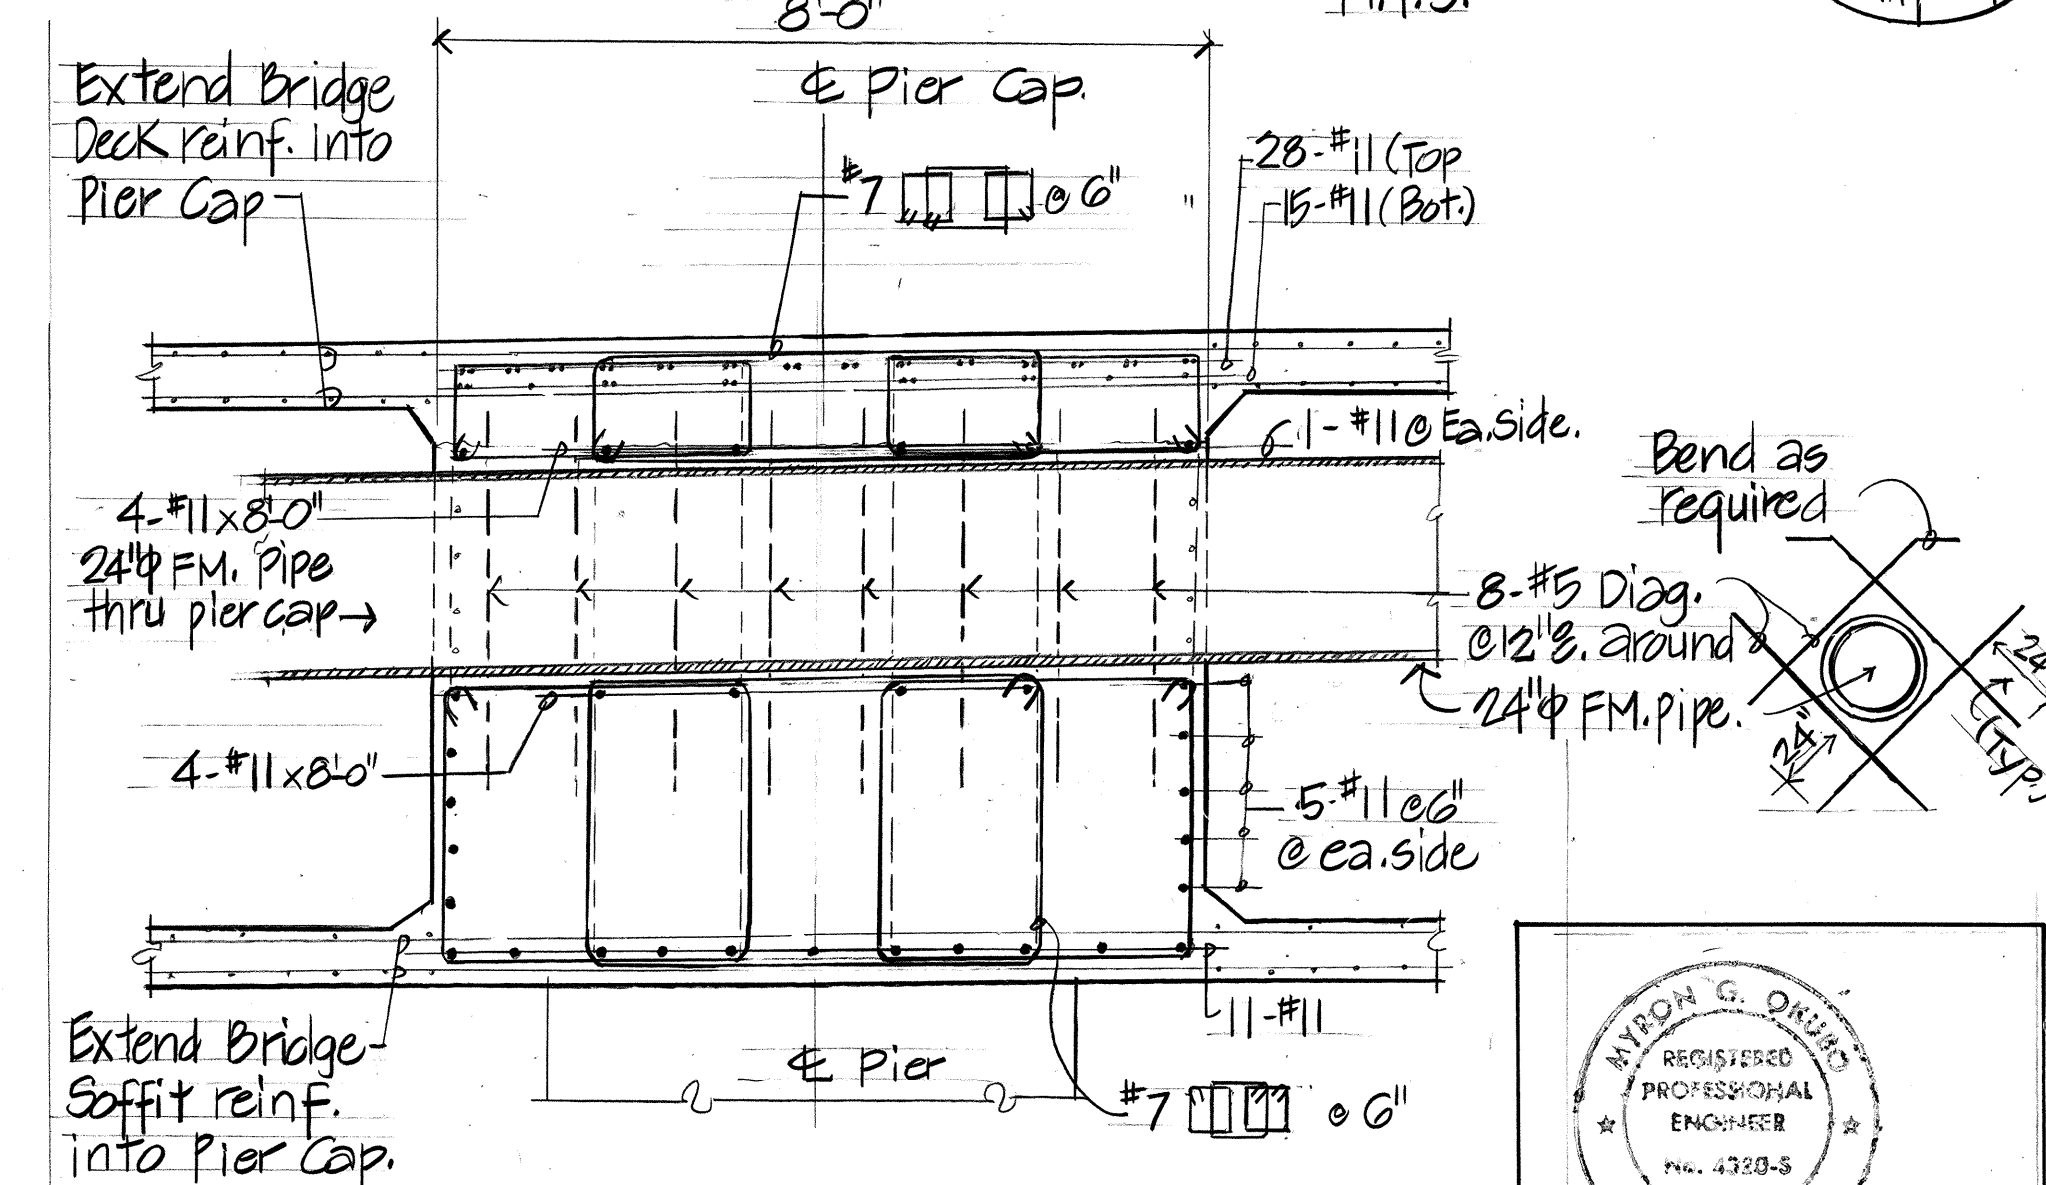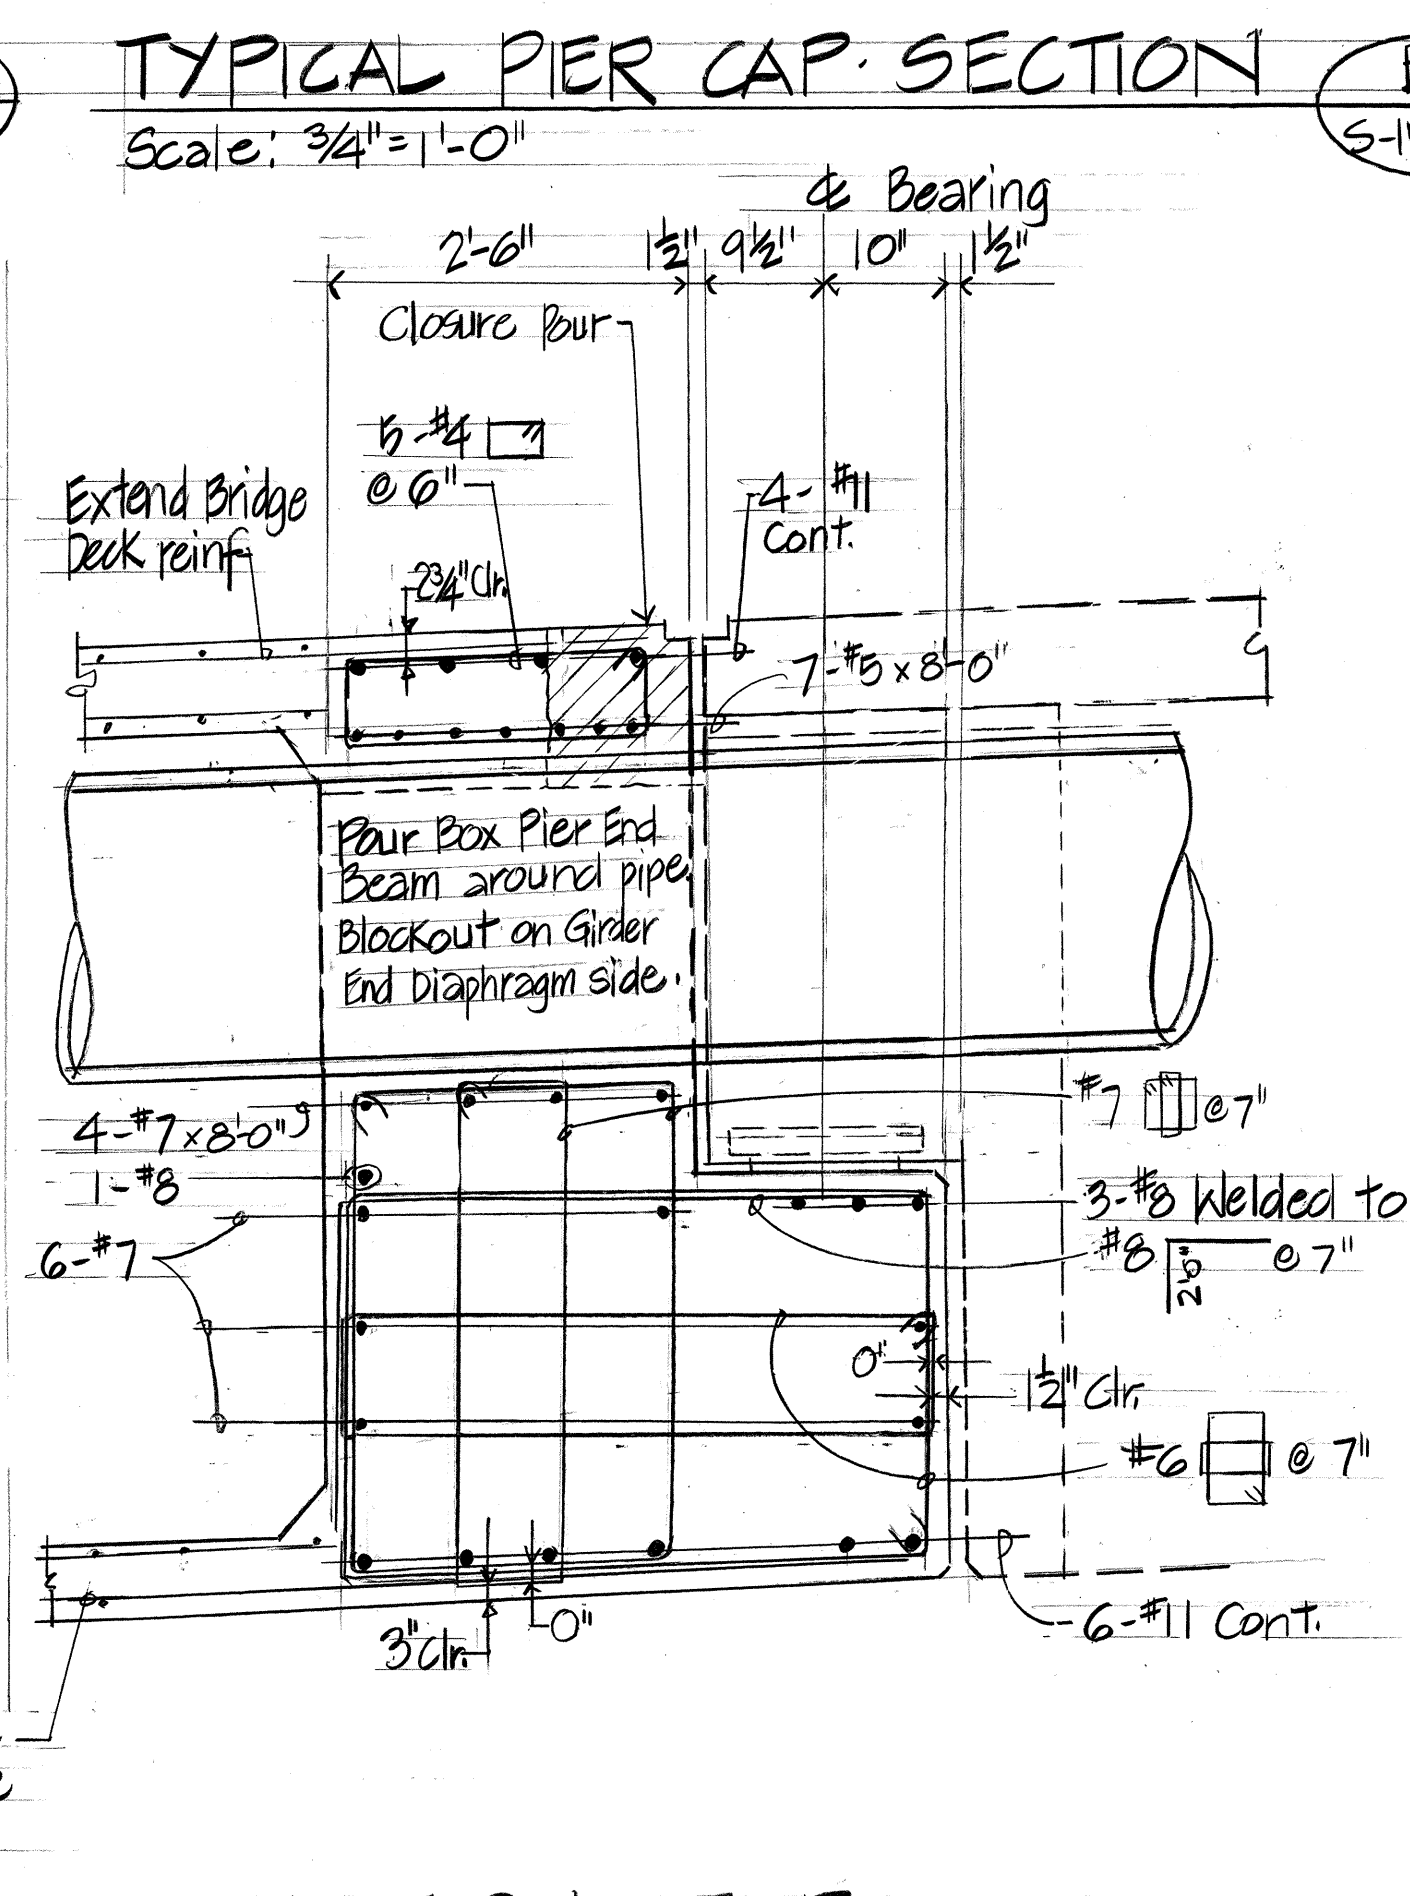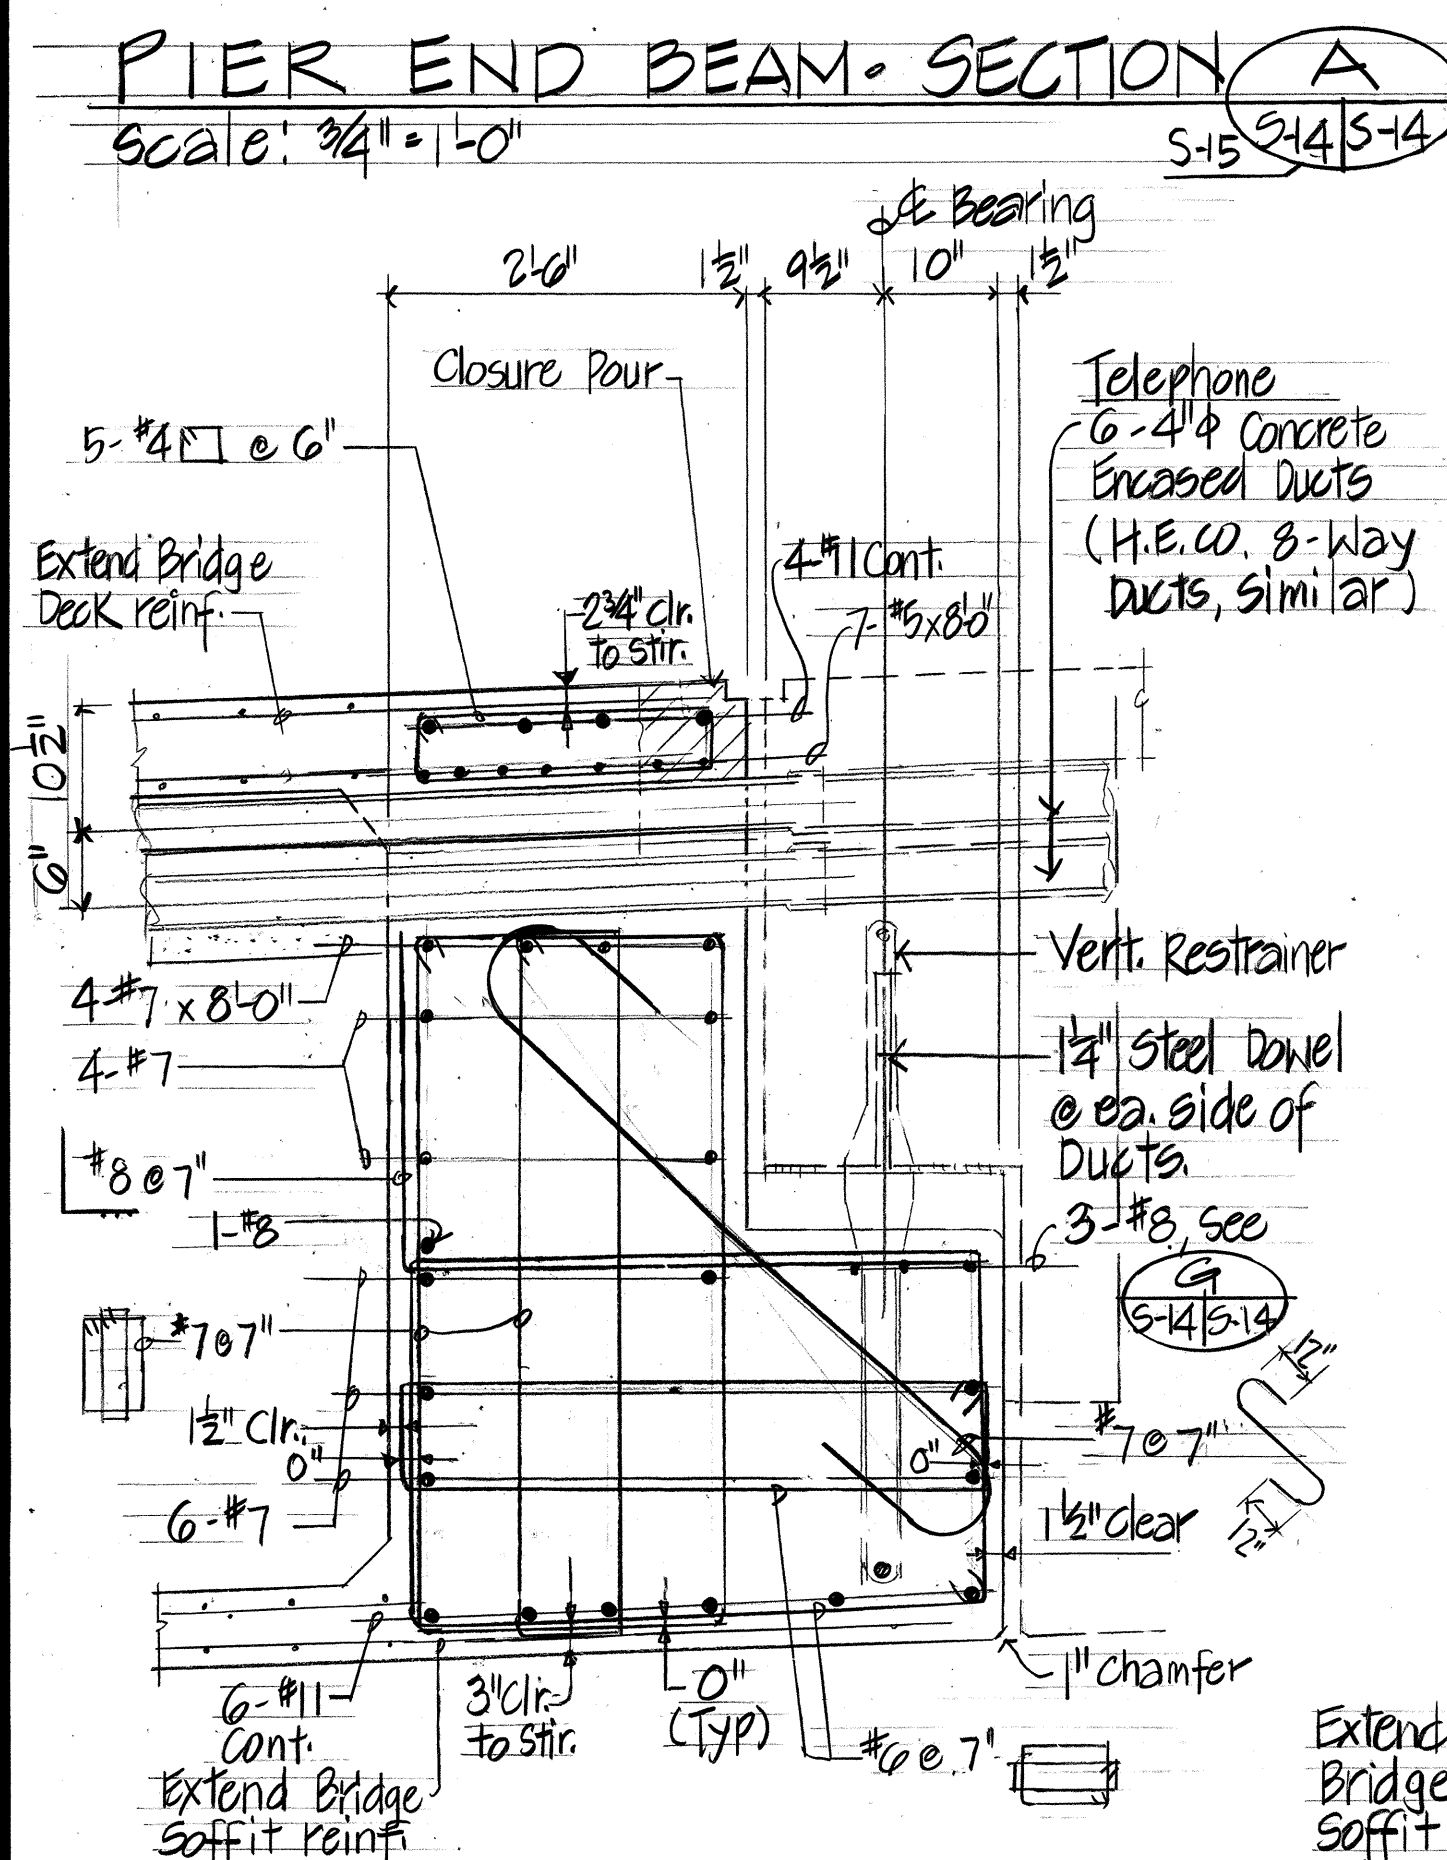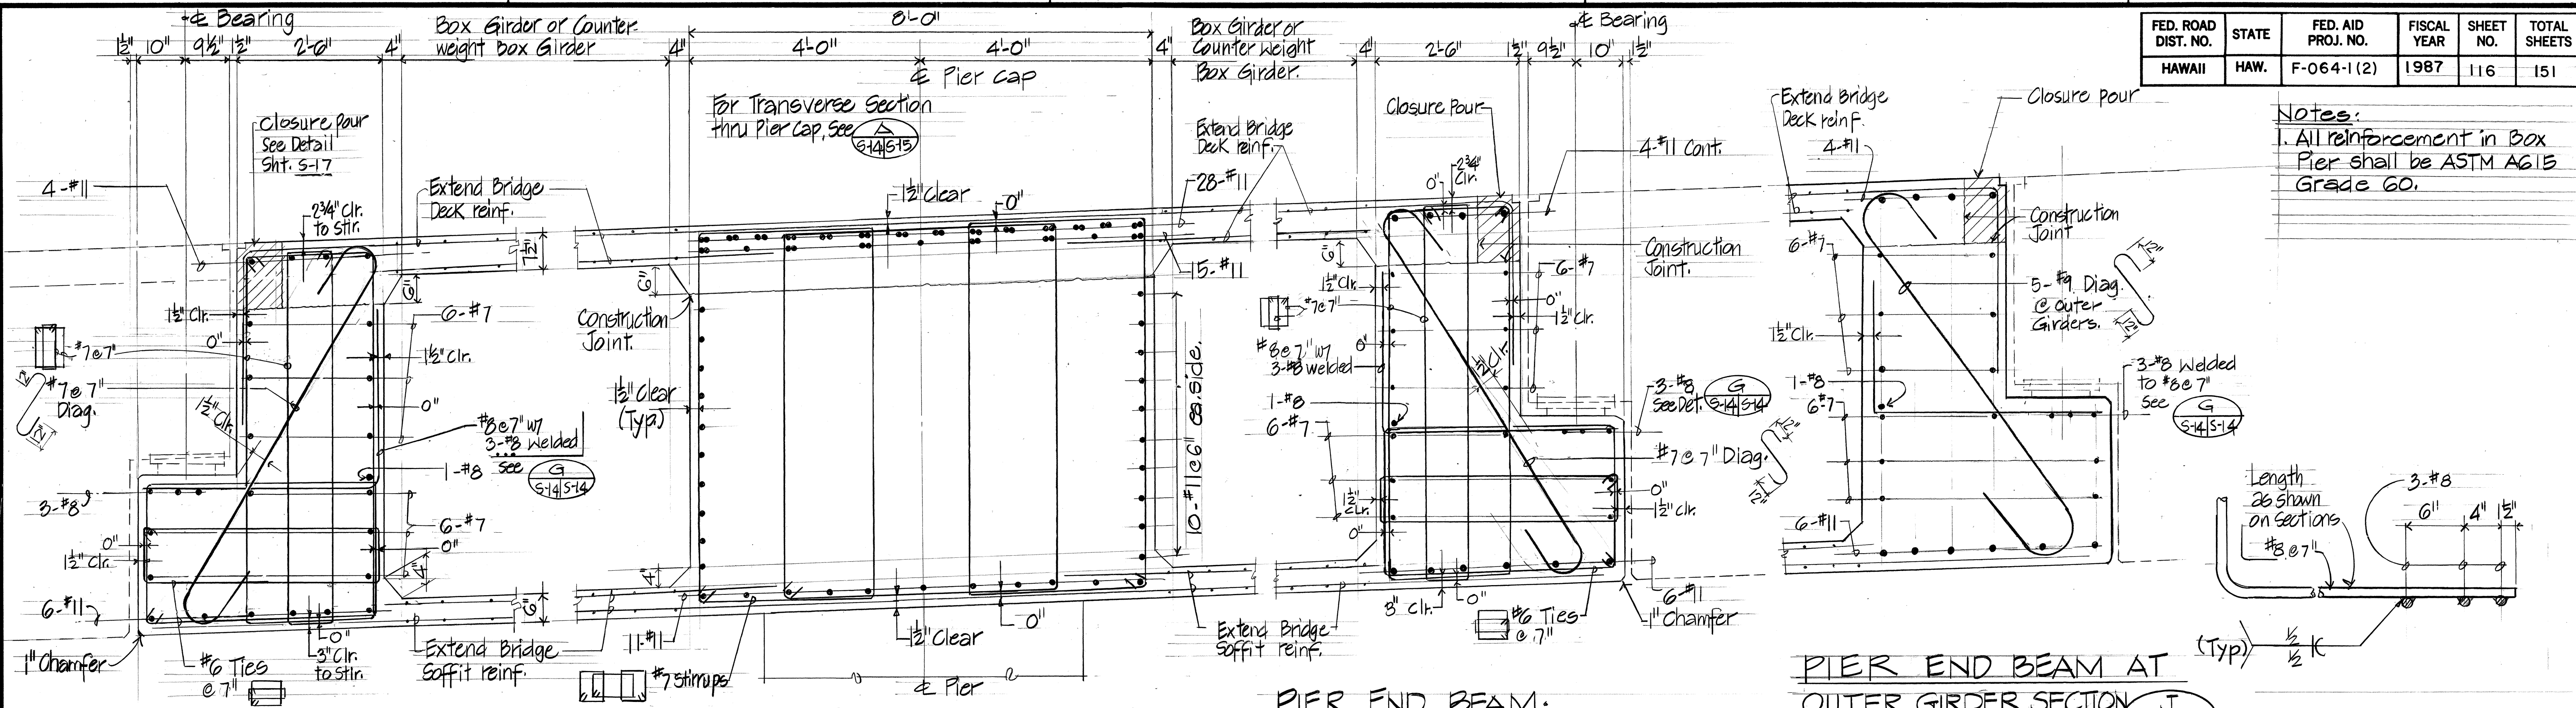

THIS WORK WAS PREPARED BY ME OR UNDER MY SUPERVISION.

Myron O'Brien

STATE OF HAWAII
DEPARTMENT OF TRANSPORTATION
HIGHWAYS DIVISION

BOX PIER DETAILS


SAND ISLAND ROAD WIDENING
2ND BRIDGE AND APPROACHES
FEDERAL AID PROJECT NO. F-064-1(2)

SCALE: AS NOTED. DATE: JUN, 1986

SHEET NO. 5-14 OF 30 SHEETS


DATE REVISION

FED. ROAD DIST. NO.	STATE	FED. AID PROJ. NO.	FISCAL YEAR	SHEET NO.	TOTAL SHEETS
HAWAII	HAW.	F-064-1 (2)	1987	117	151

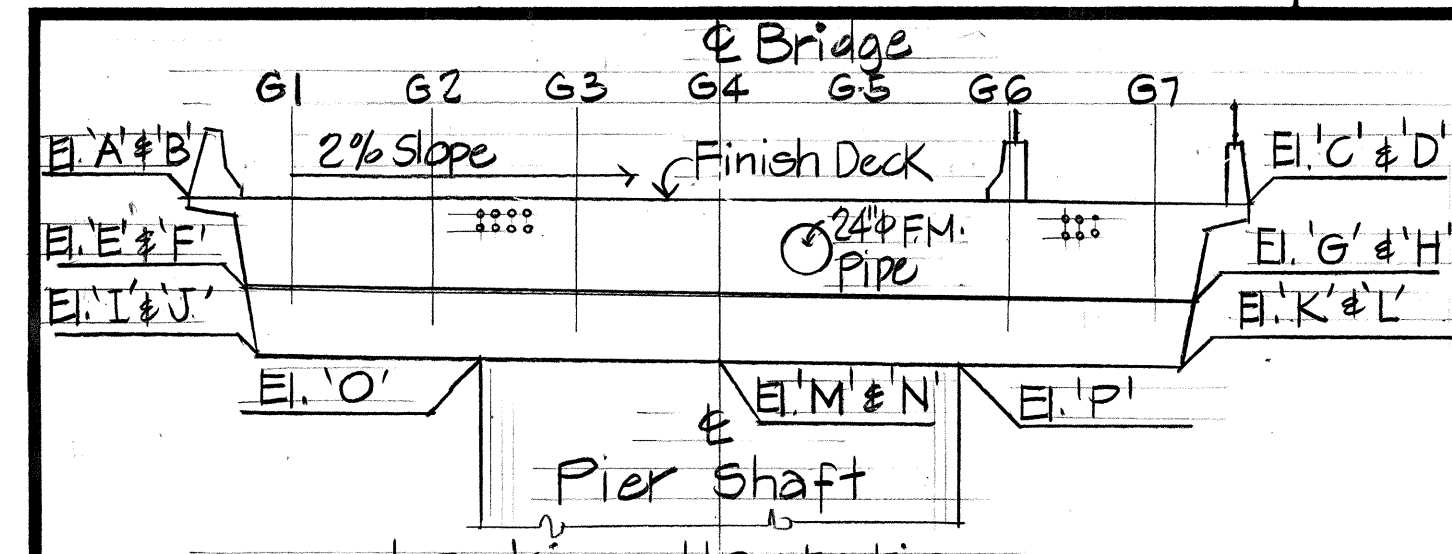


TRANSVERSE ELEVATION
N.T.S.

ELEVATIONS																
PIER	A	B	C	D	E	F	G	H	I	J	K	L	M	N	O	P
1	20.92	21.83	20.02	20.93	16.77	17.73	15.99	16.95	13.97	14.98	13.19	14.20	14.03	14.17	14.30	13.90
2	24.06	24.35	23.16	23.45	14.93	20.35	19.15	19.57	17.15	17.48	16.37	16.70	16.89	16.94	17.11	16.71
3	24.37	24.08	23.47	23.18	20.36	19.95	19.58	19.17	17.44	17.17	16.71	16.39	16.95	16.90	17.13	16.73
4	21.88	20.89	20.98	19.99	17.78	16.79	17.00	16.01	15.02	13.94	14.25	13.16	14.22	14.08	14.35	13.95

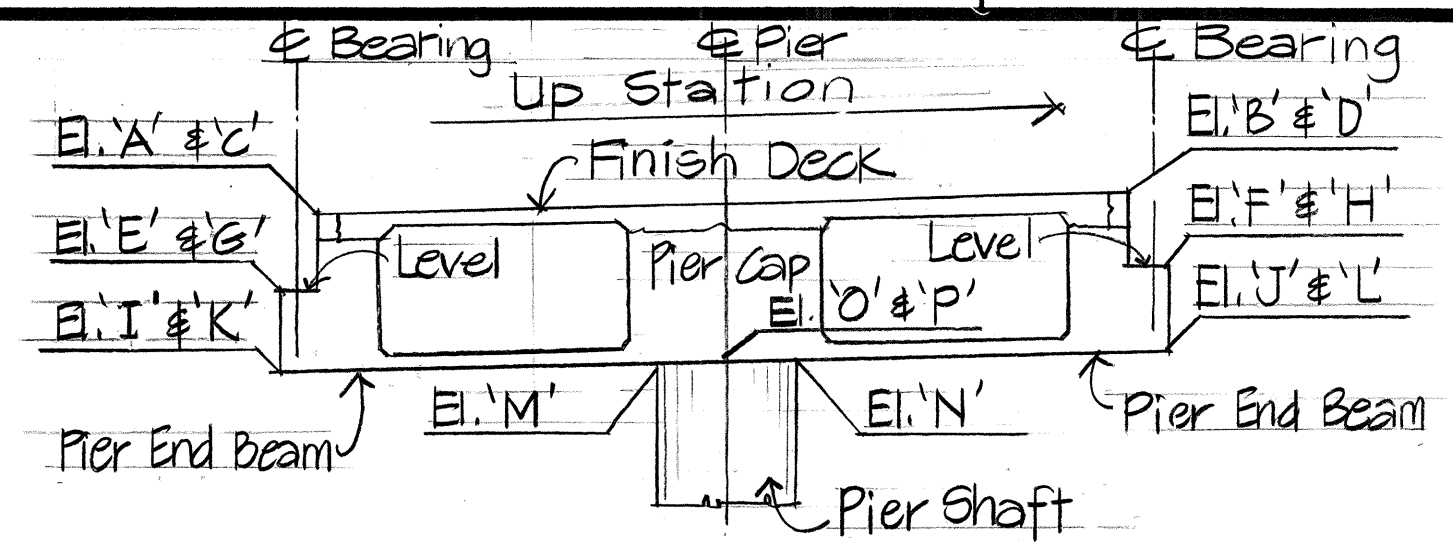


LONGITUDINAL ELEVATION
N.T.S.


- NOTES:
- All reinforcement in Pier End Beam shall be ASTM A615, GRADE 60.
 - FOR $\frac{1}{2}$ " Diagonals See Sections on Sheet S-14

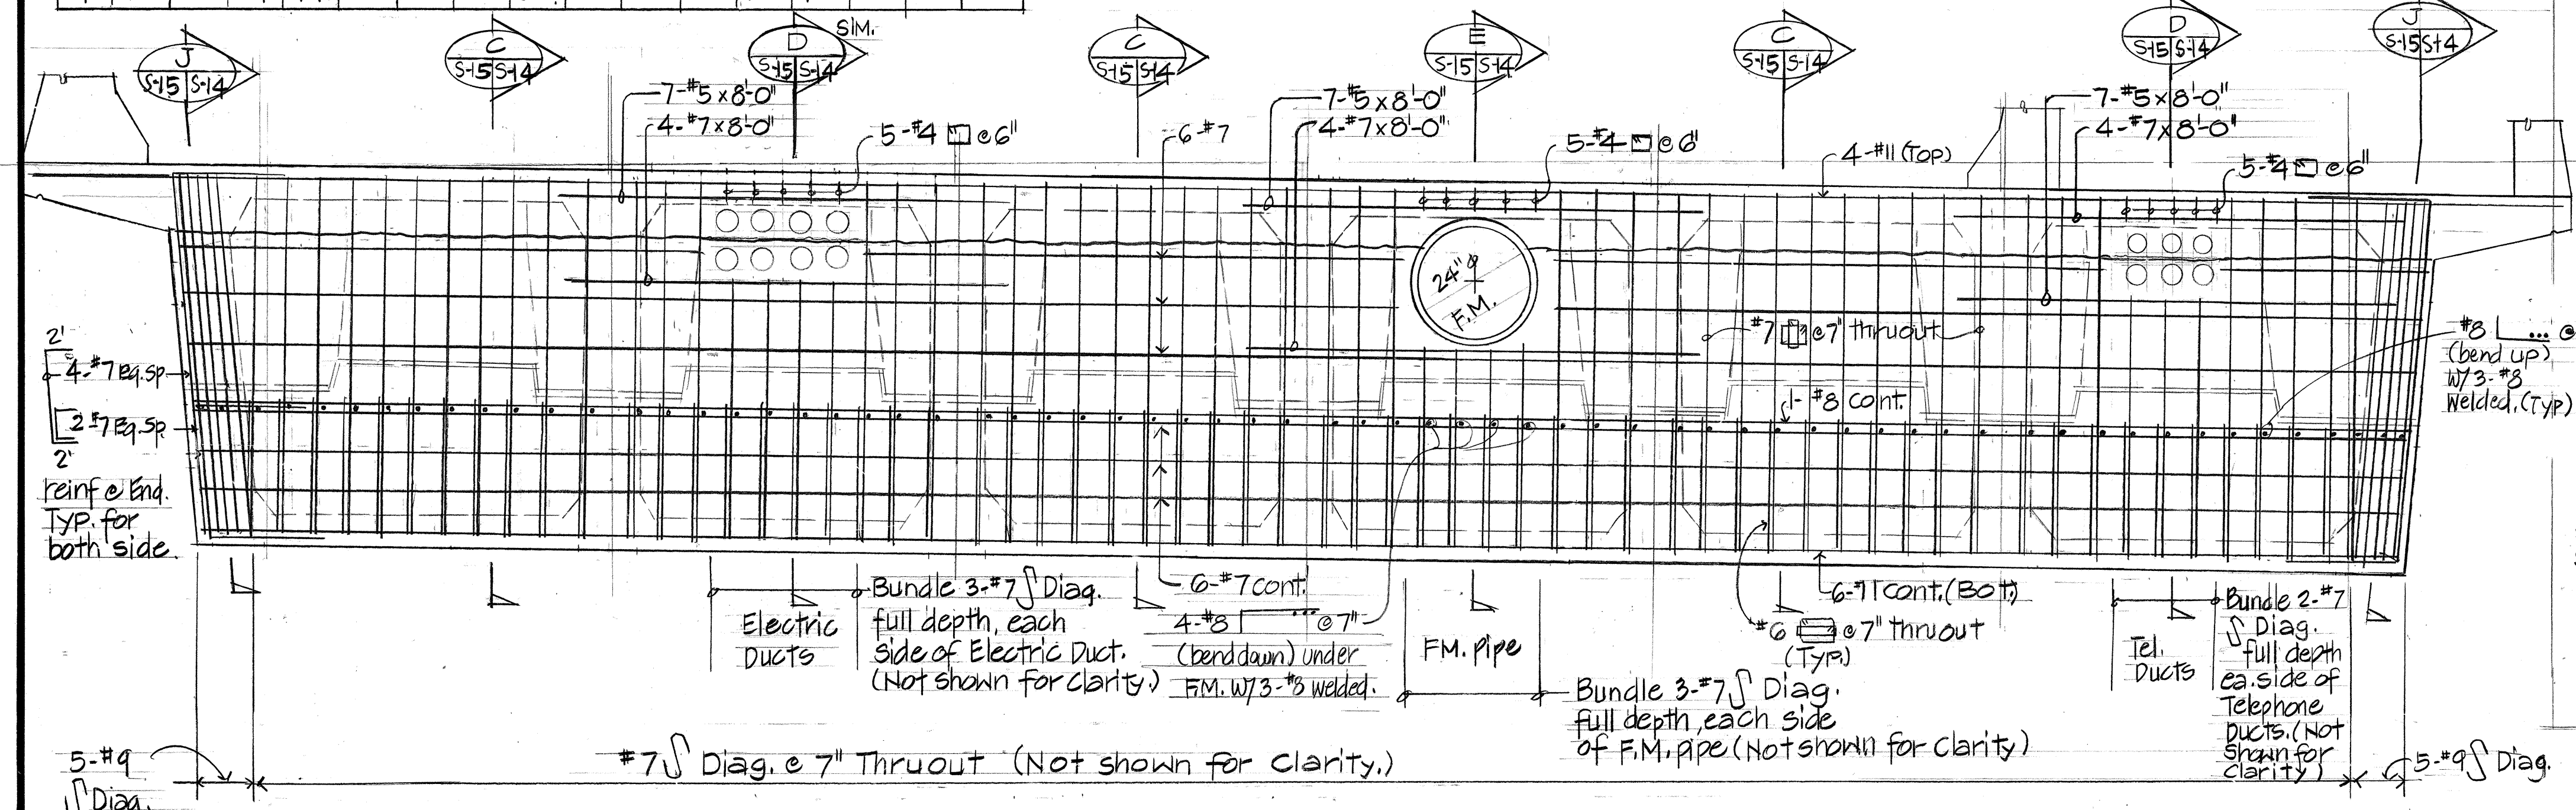


TRANSVERSE SECTION THRU PIER END BEAM
Scale: $\frac{1}{2}$ " = 1'-0"

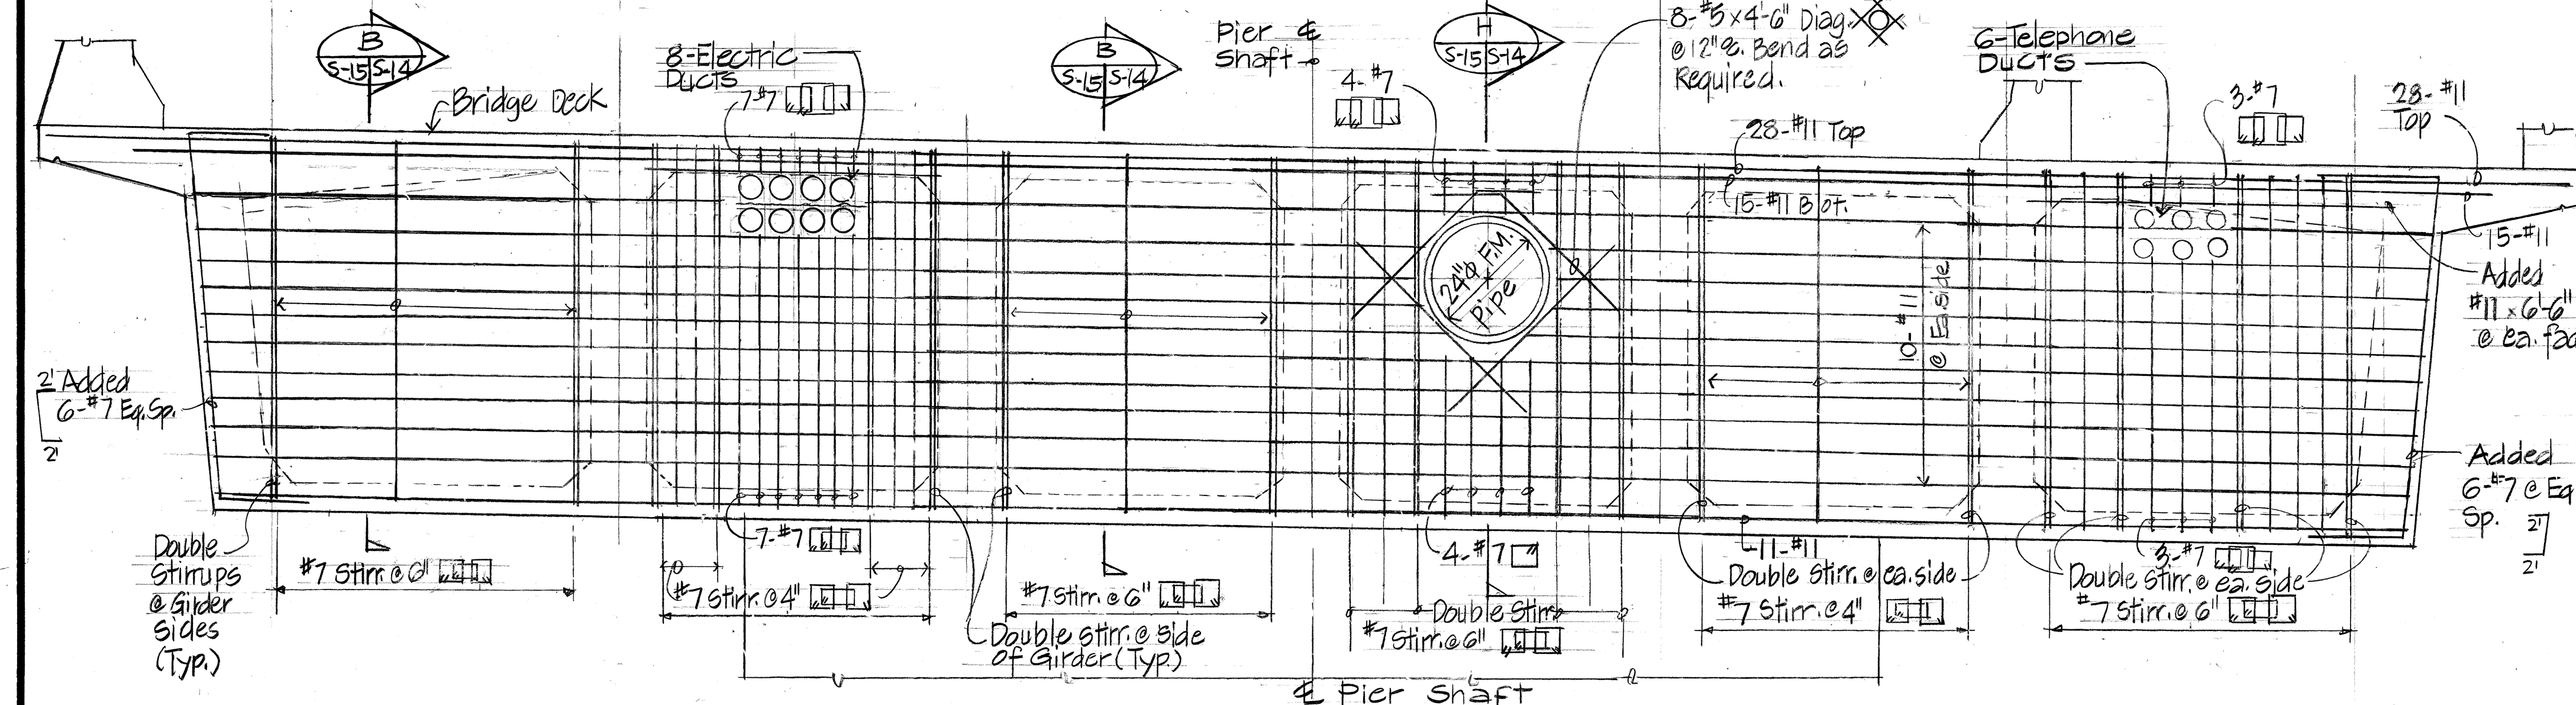


TRANSVERSE SECTION THRU PIER CAP
Scale: $\frac{1}{2}$ " = 1'-0"

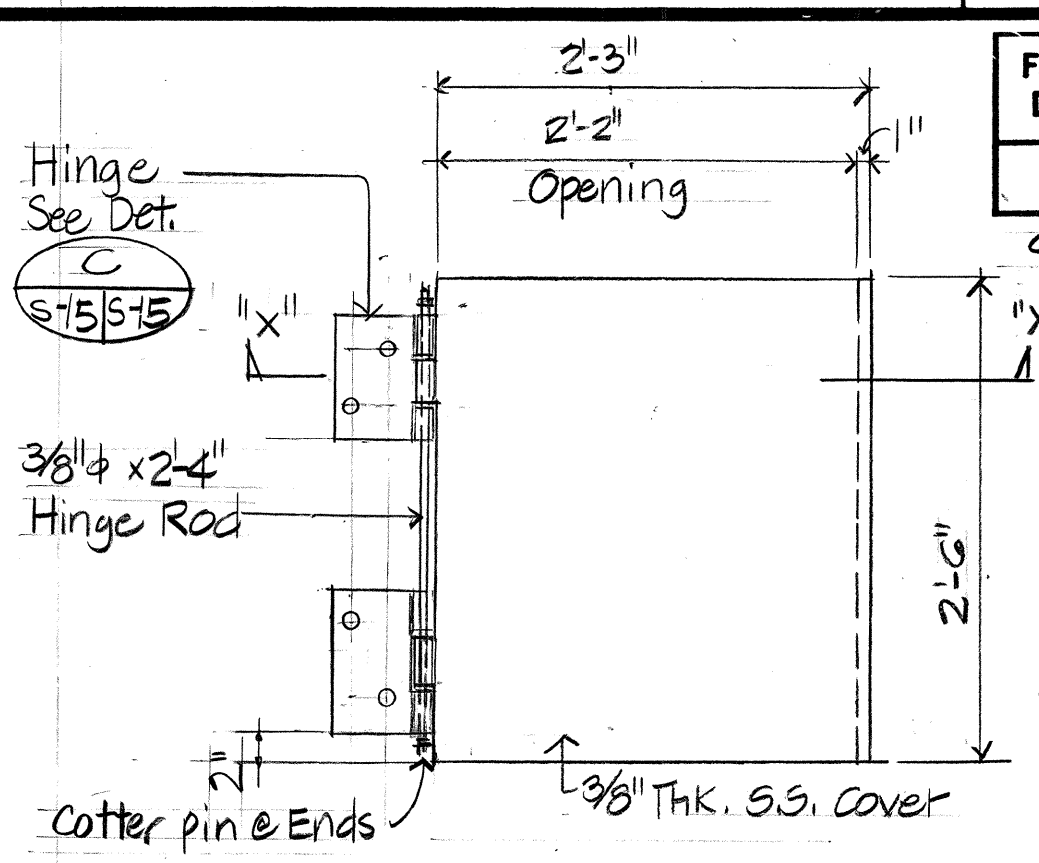


TOP COVER
Scale: $\frac{1}{2}$ " = 1'-0"

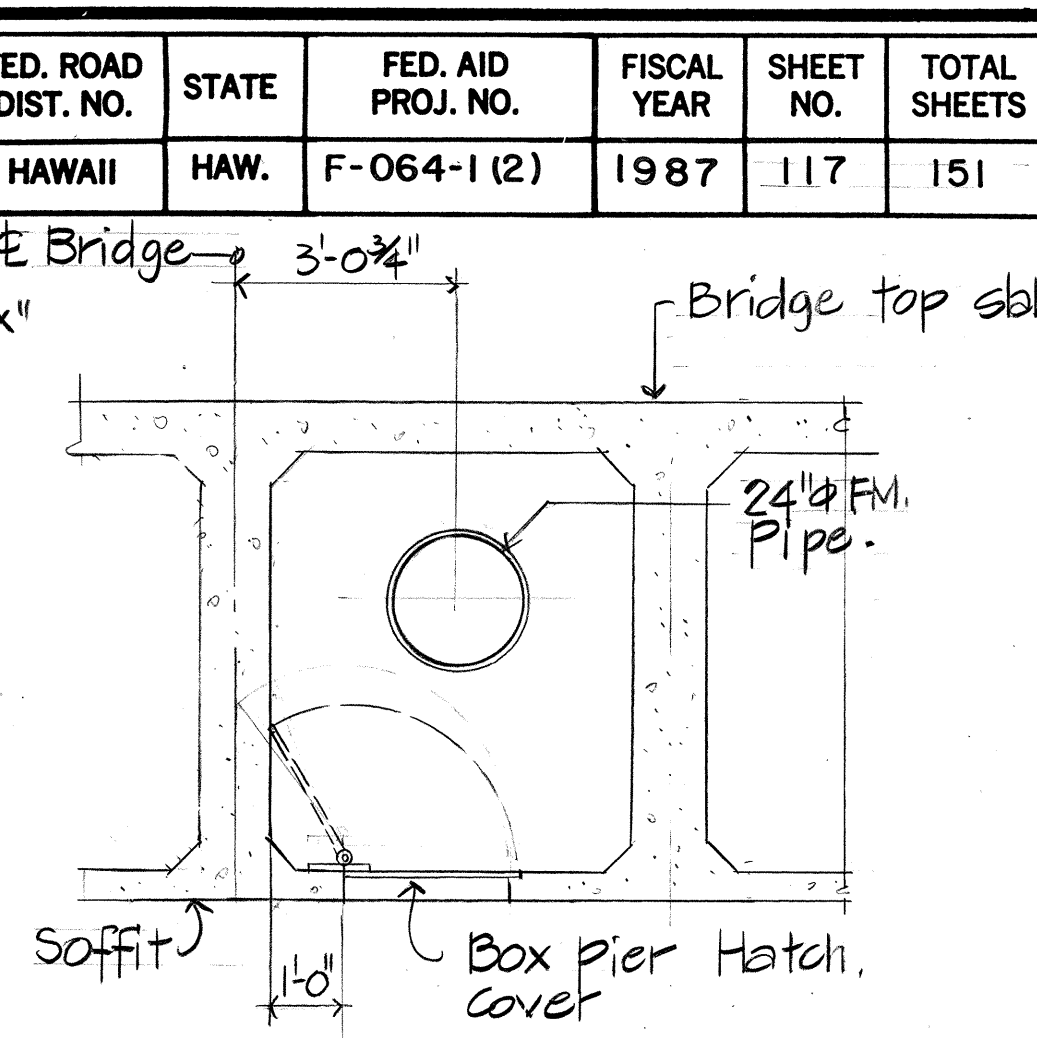


BOX PIER HATCH WITH COVER DETAIL B
Scale: $\frac{3}{8}$ " = 1'-0"

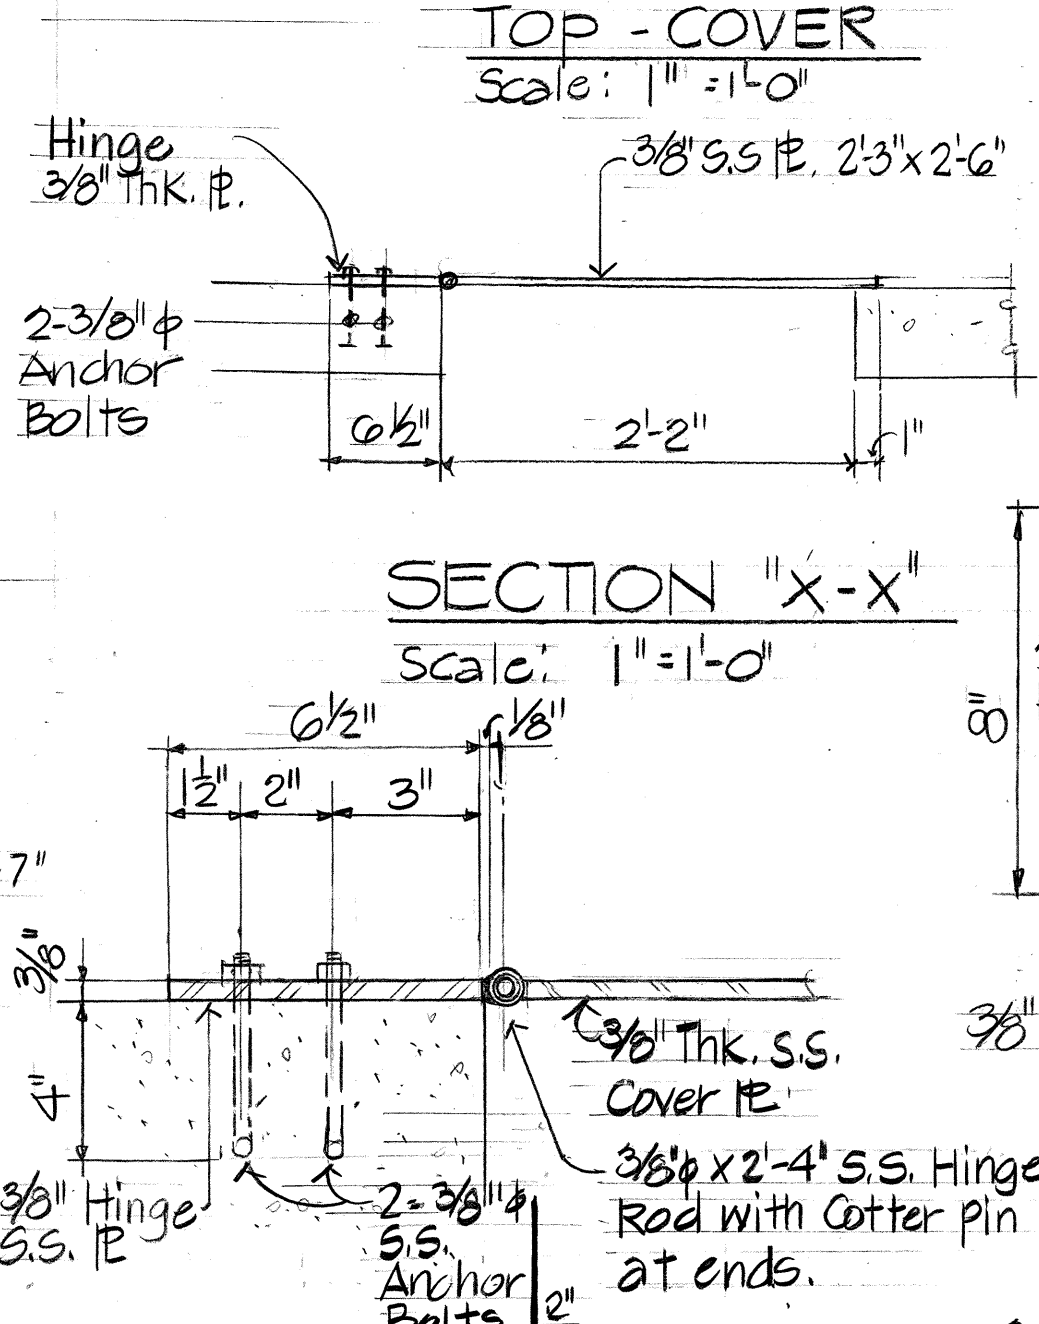


SECTION "X-X"
Scale: $\frac{1}{2}$ " = 1'-0"

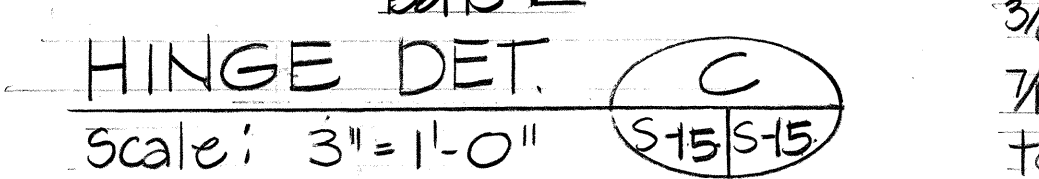


HINGE DET. C
Scale: $\frac{3}{8}$ " = 1'-0"

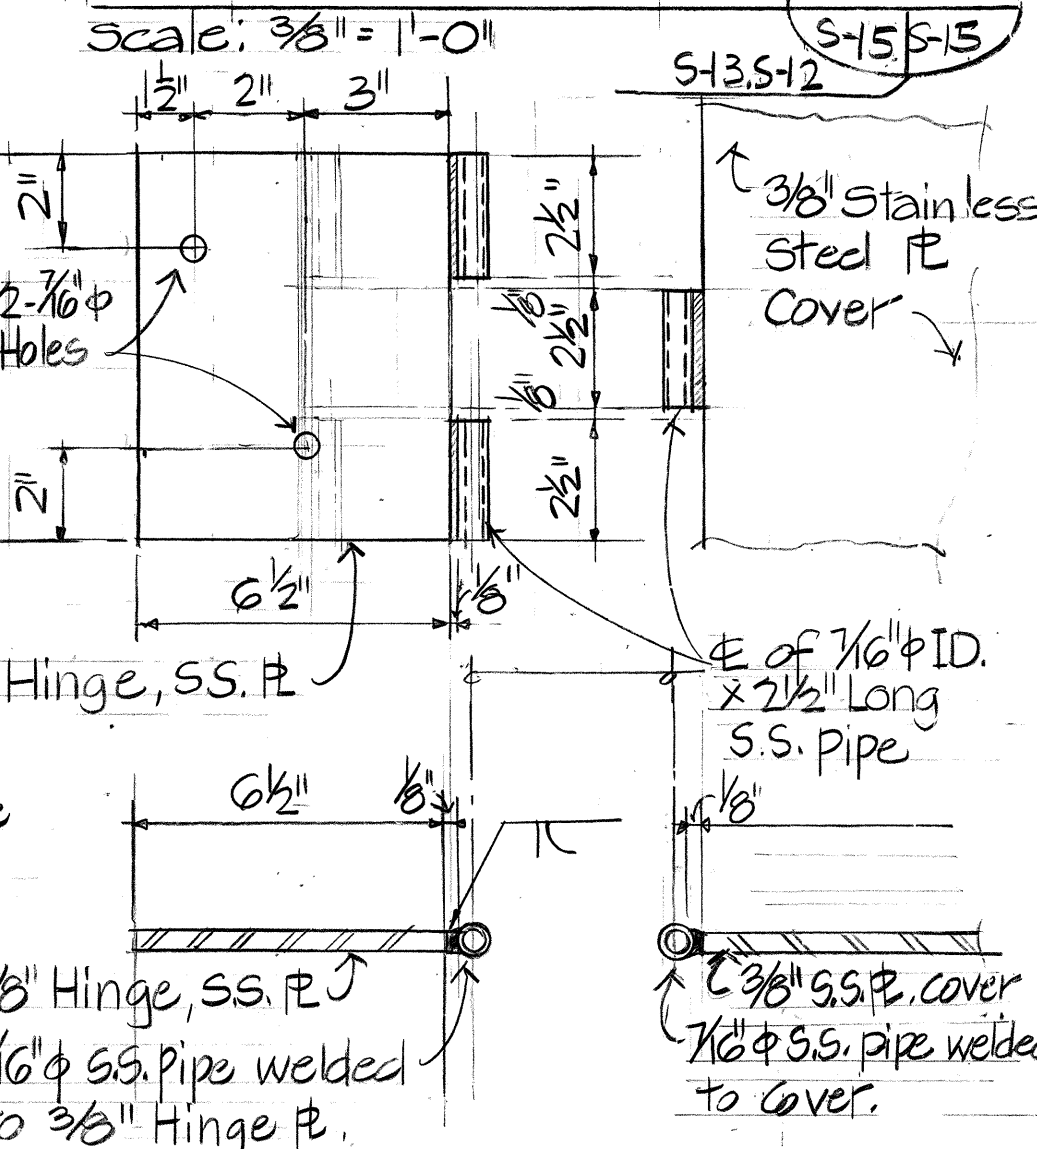

HINGE DET. D
Scale: $\frac{3}{8}$ " = 1'-0"

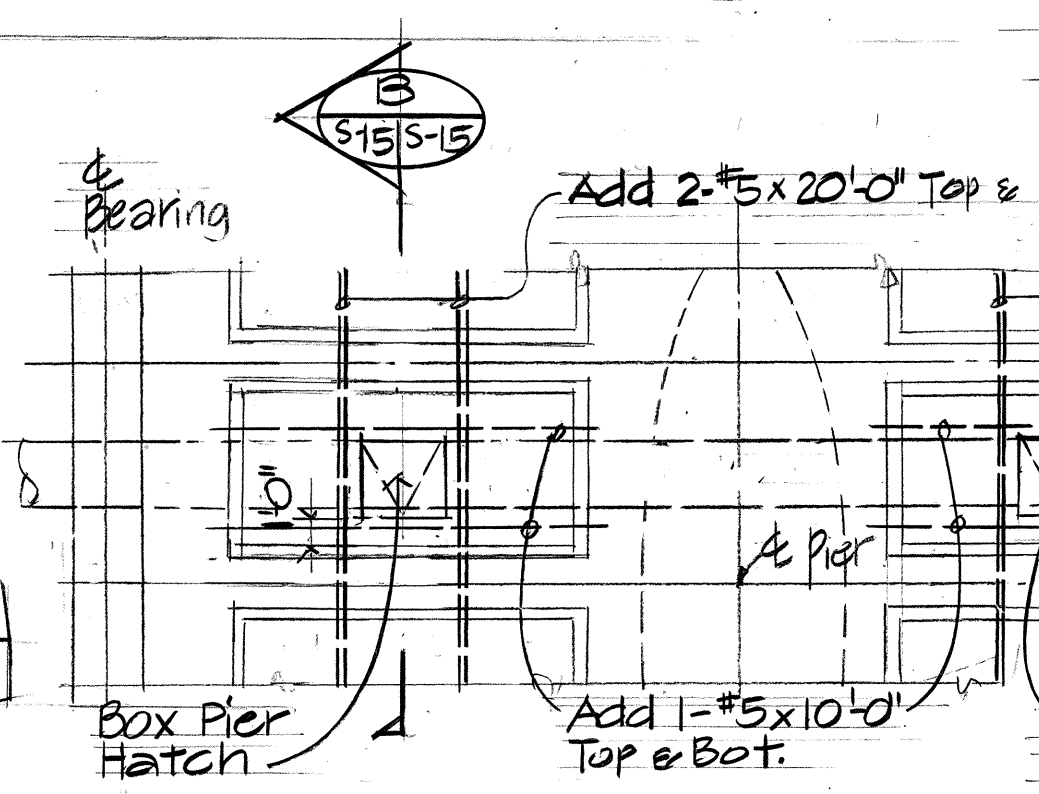

HATCH LOCATION PLAN
Scale: $\frac{3}{8}$ " = 1'-0"

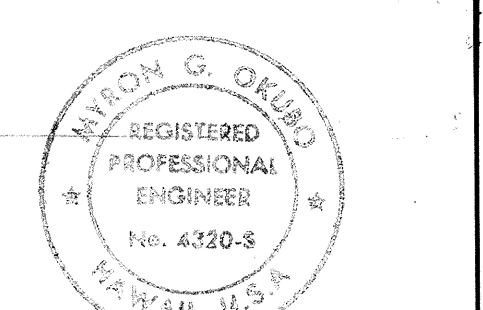

THIS WORK WAS PREPARED BY ME OR UNDER MY SUPERVISION

Myron Okada

STATE OF HAWAII
DEPARTMENT OF TRANSPORTATION
HIGHWAYS DIVISION

BOX PIER DETAILS

SAND ISLAND ROAD WIDENING
2ND BRIDGE AND APPROACHES
FEDERAL AID PROJECT NO. F-064-1(2)


SCALE: AS NOTED DATE: JUN, 1986

SHEET NO. 5-15 OF 30 SHEETS

DATE REVISION


ORIGINAL PLAN	DATE
DESIGNED BY	
NOTED BY	
CHECKED BY	
QUANTITIES BY	
NO.	

FED. ROAD DIST. NO.	STATE	FED. AID PROJ. NO.	FISCAL YEAR	SHEET NO.	TOTAL SHEETS
HAWAII	HAW.	F-064-1(2)	1987	118	151

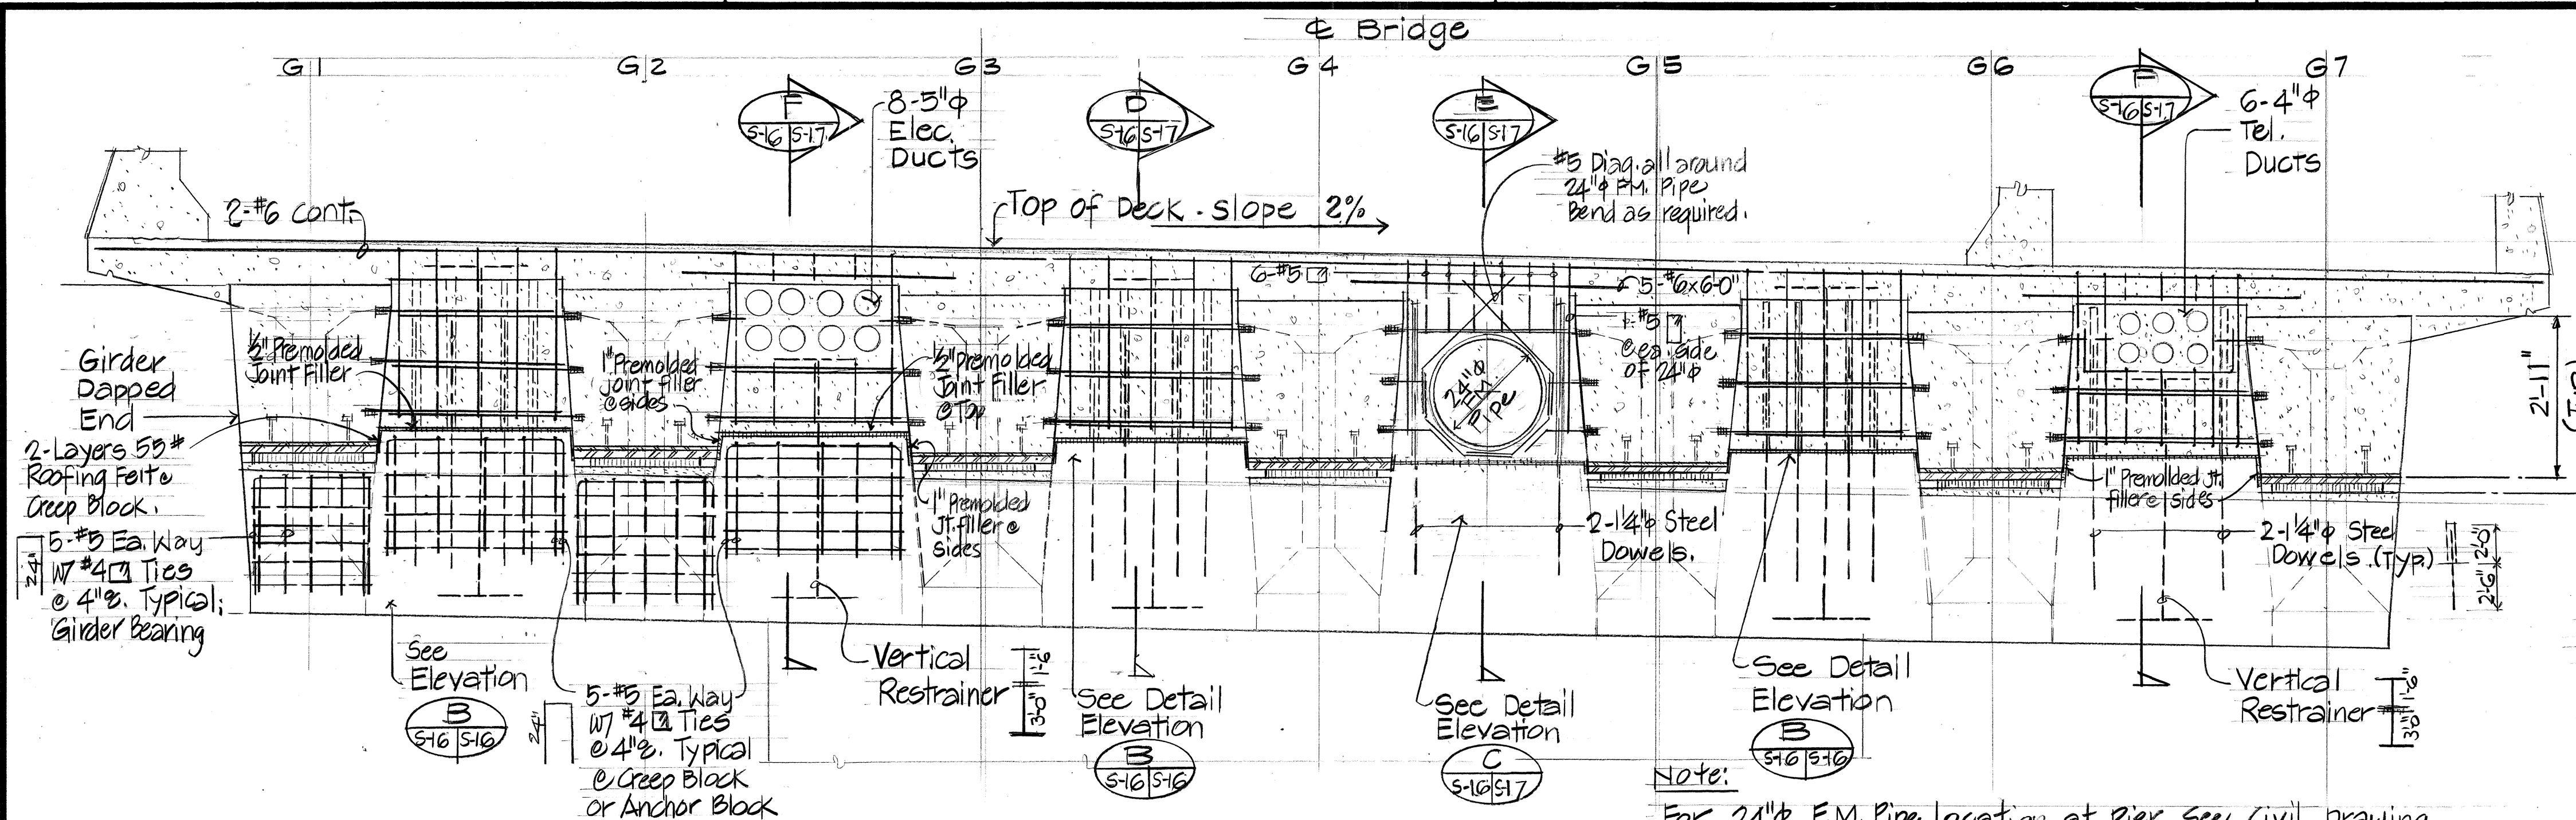

GIRDER BEARING AT PIER - ELEVATION


Scale: 1/2" = 1'-0"

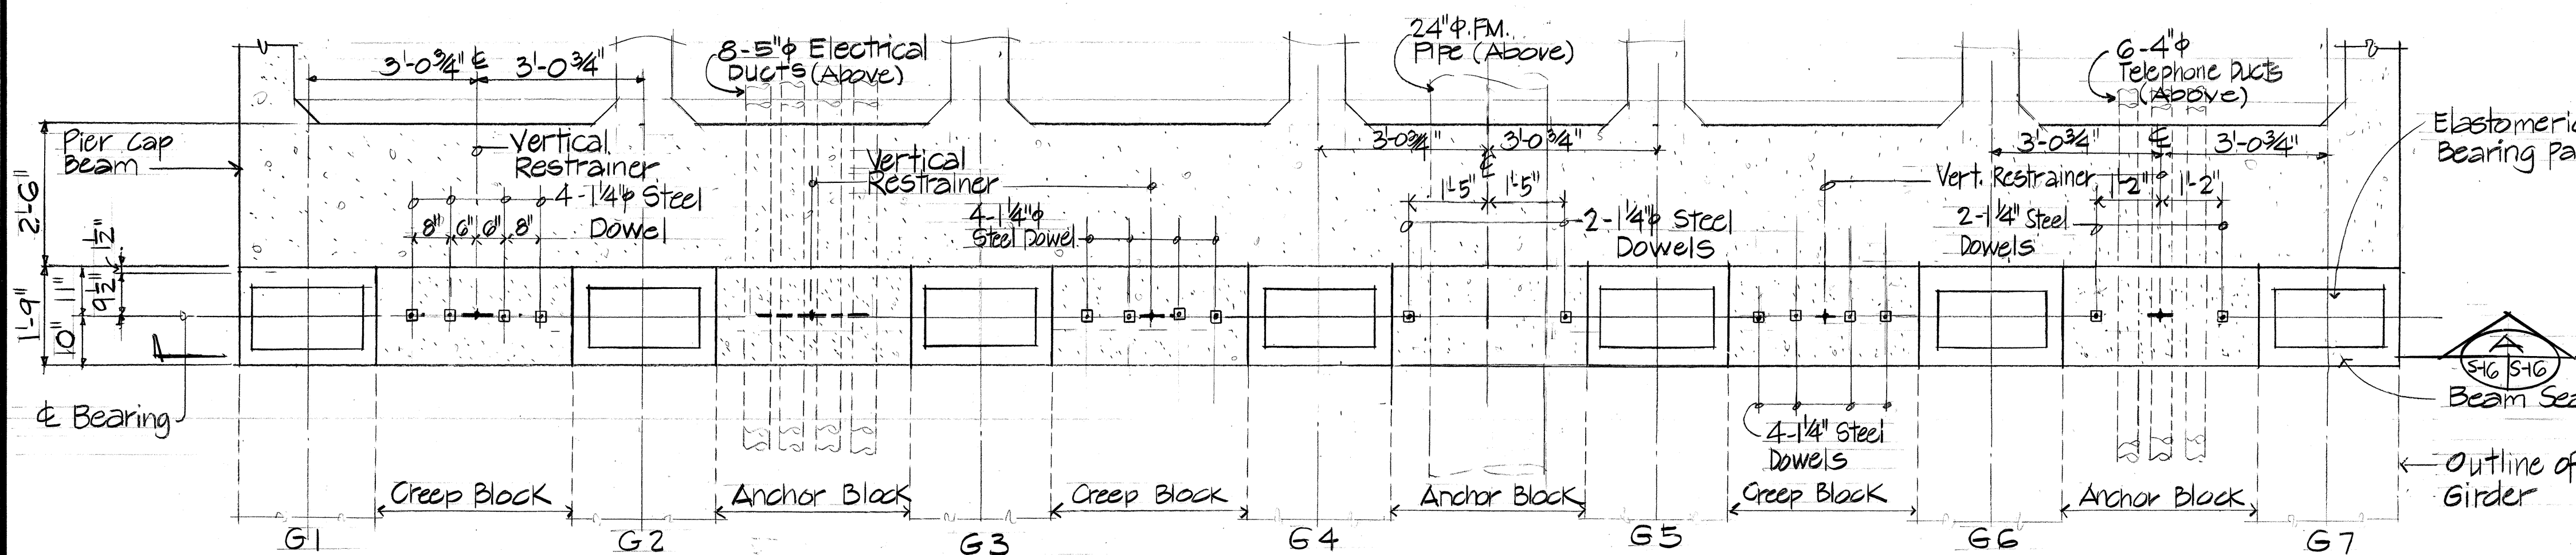

GIRDER BEARING AT PIER - PLAN

Scale: 1/2" = 1'-0"

- + Denotes Vertical Restrainer, see Detail A (5-16/5-26)
- Denotes 1/4" φ Dowel in 3 1/2" x 1 3/8" Galvanized steel tube, see Detail B (5-16/5-26)

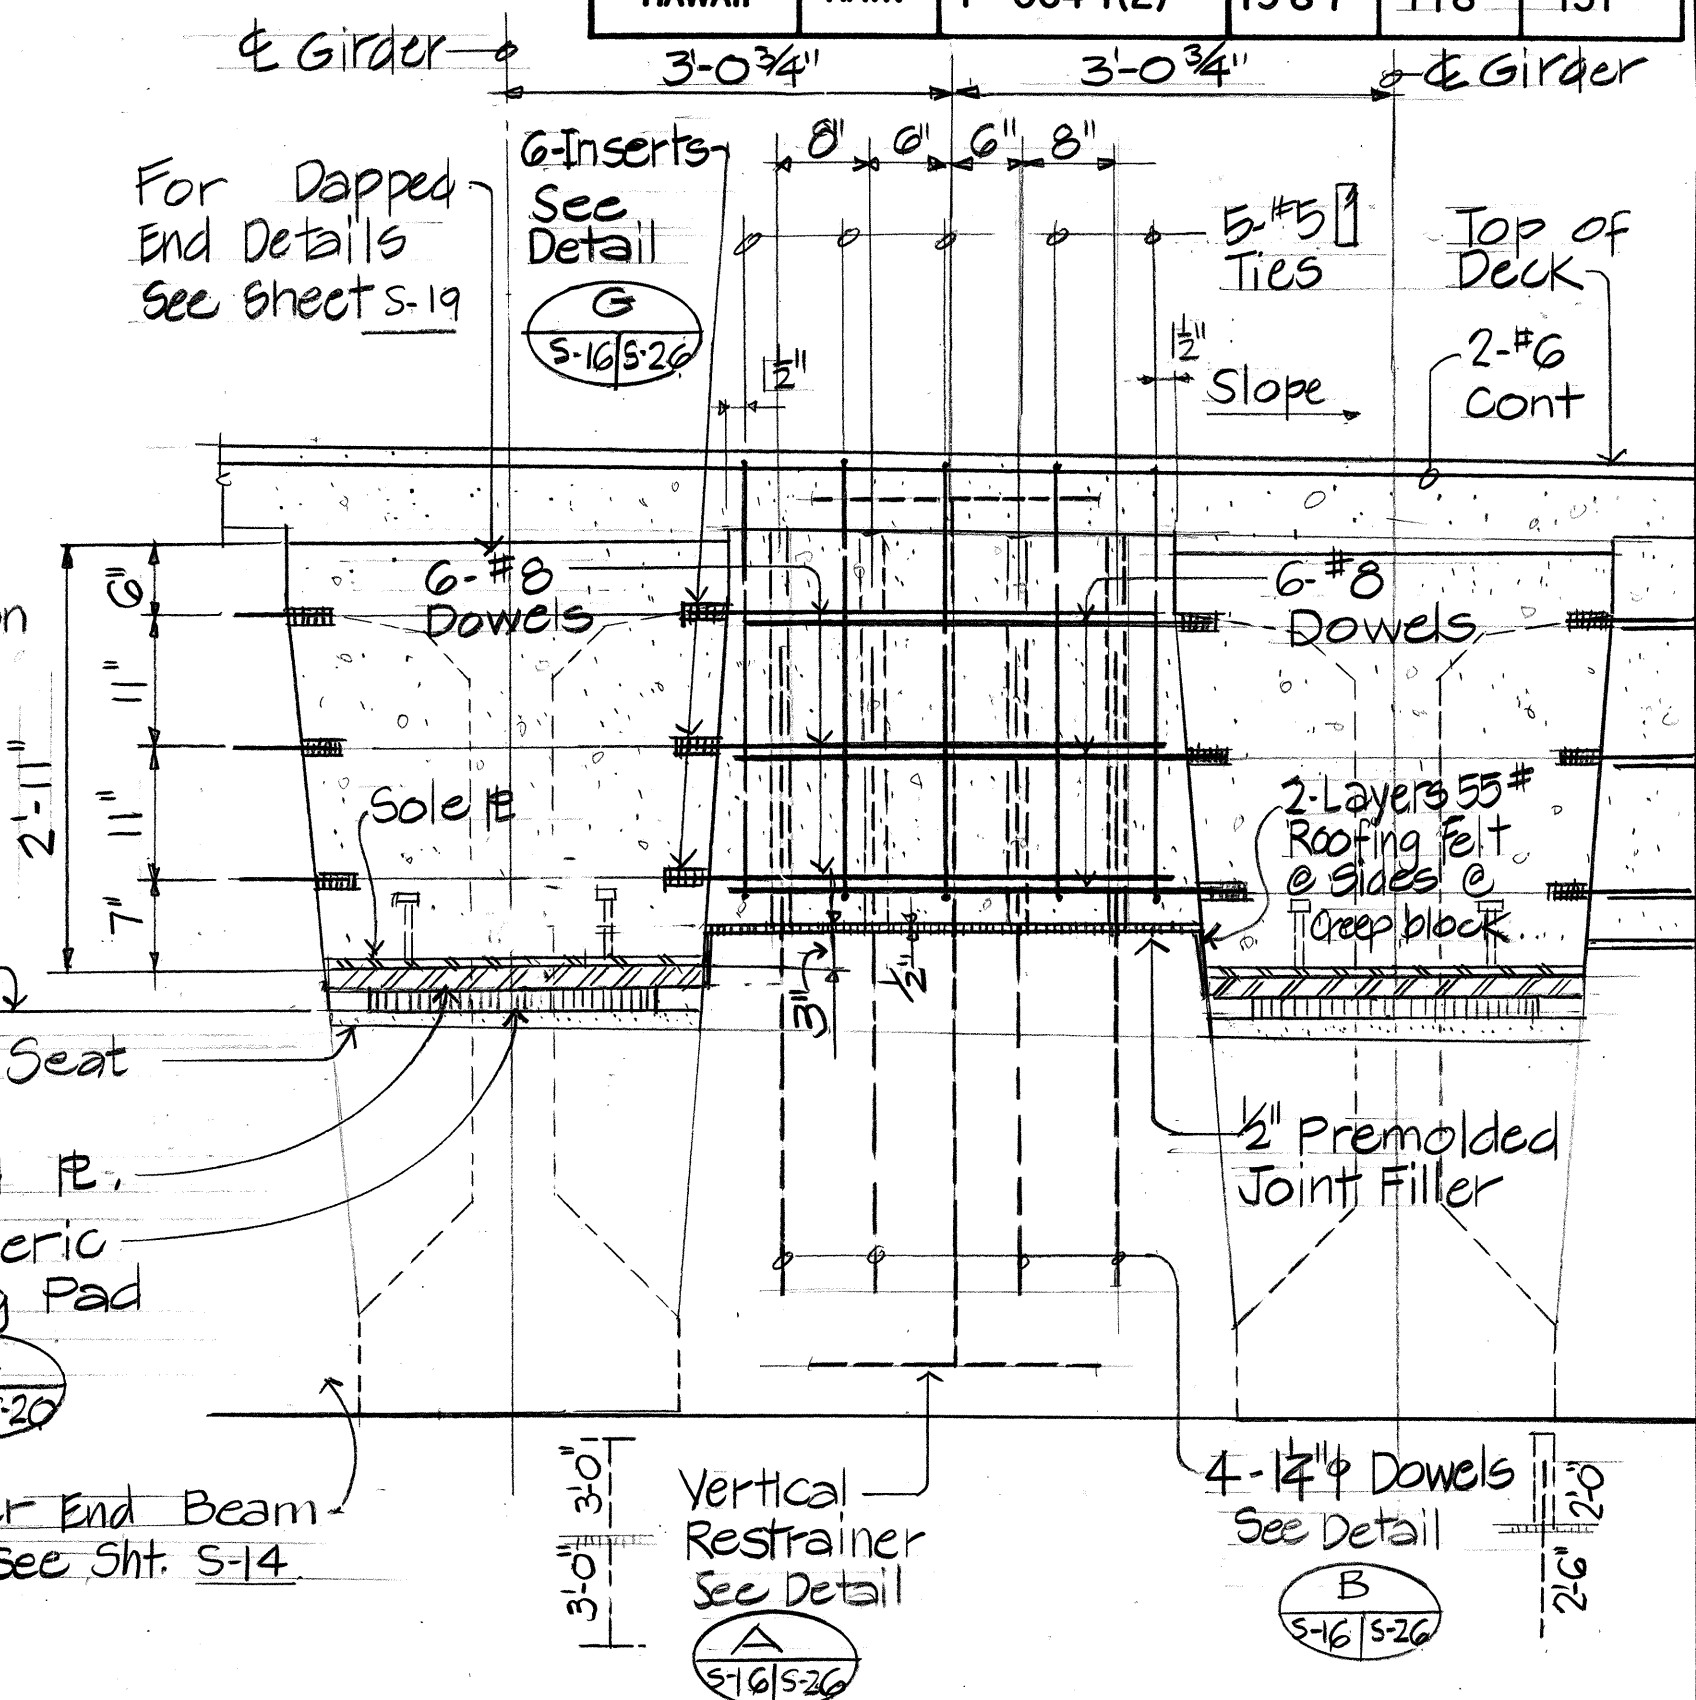


TYPICAL ELEVATION - DETAIL

Scale: 3/4" = 1'-0"

GIRDER SEAT ELEVATIONS

Girder No.	PIER #1		PIER #2		PIER #3		PIER #4	
	⊕ Bearing - Seat Elevation	Sta. 59+06.52 Sta. 59+43.02	⊕ Bearing - Seat Elevation	Sta. 60+08.02 Sta. 61+03.02	⊕ Bearing - Seat Elevation	Sta. 62+28.02 Sta. 62+63.02	⊕ Bearing - Seat Elevation	Sta. 63+88.02 Sta. 64+27.52
G1	16.93	17.89	20.09	20.50	20.51	20.11	17.94	16.96
G2	16.81	17.77	19.97	20.39	20.40	19.99	17.82	16.84
G3	16.68	17.64	19.84	20.26	20.27	19.86	17.69	16.71
G4	16.56	17.52	19.72	20.14	20.15	19.74	17.57	16.59
G5	16.44	17.40	19.60	20.02	20.03	19.62	17.45	16.47
G6	16.31	17.27	19.47	19.88	19.89	19.49	17.32	16.34
G7	16.19	17.15	19.35	19.77	19.78	19.37	17.20	16.22

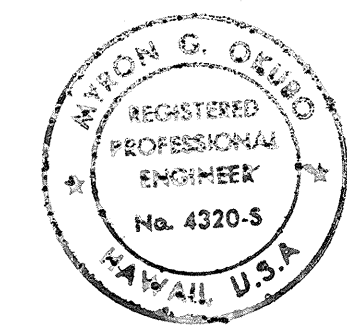

THIS WORK WAS PREPARED BY ME OR UNDER MY SUPERVISION

Myron Okubo

STATE OF HAWAII
DEPARTMENT OF TRANSPORTATION
HIGHWAYS DIVISION

GIRDER BEARING AT
PIER - DETAILS


SAND ISLAND ROAD WIDENING
2ND. BRIDGE AND APPROACHES
FEDERAL AID PROJECT NO. F-064-1(2)

SCALE: AS NOTED. DATE: JUN, 1986

SHEET No. 5-16 OF 30 SHEETS


DATE	REVISION

FED. ROAD DIST. NO.	STATE	FED. AID PROJ. NO.	FISCAL YEAR	SHEET NO.	TOTAL SHEETS
HAWAII	HAW.	F-064-1(2)	1987	119	151

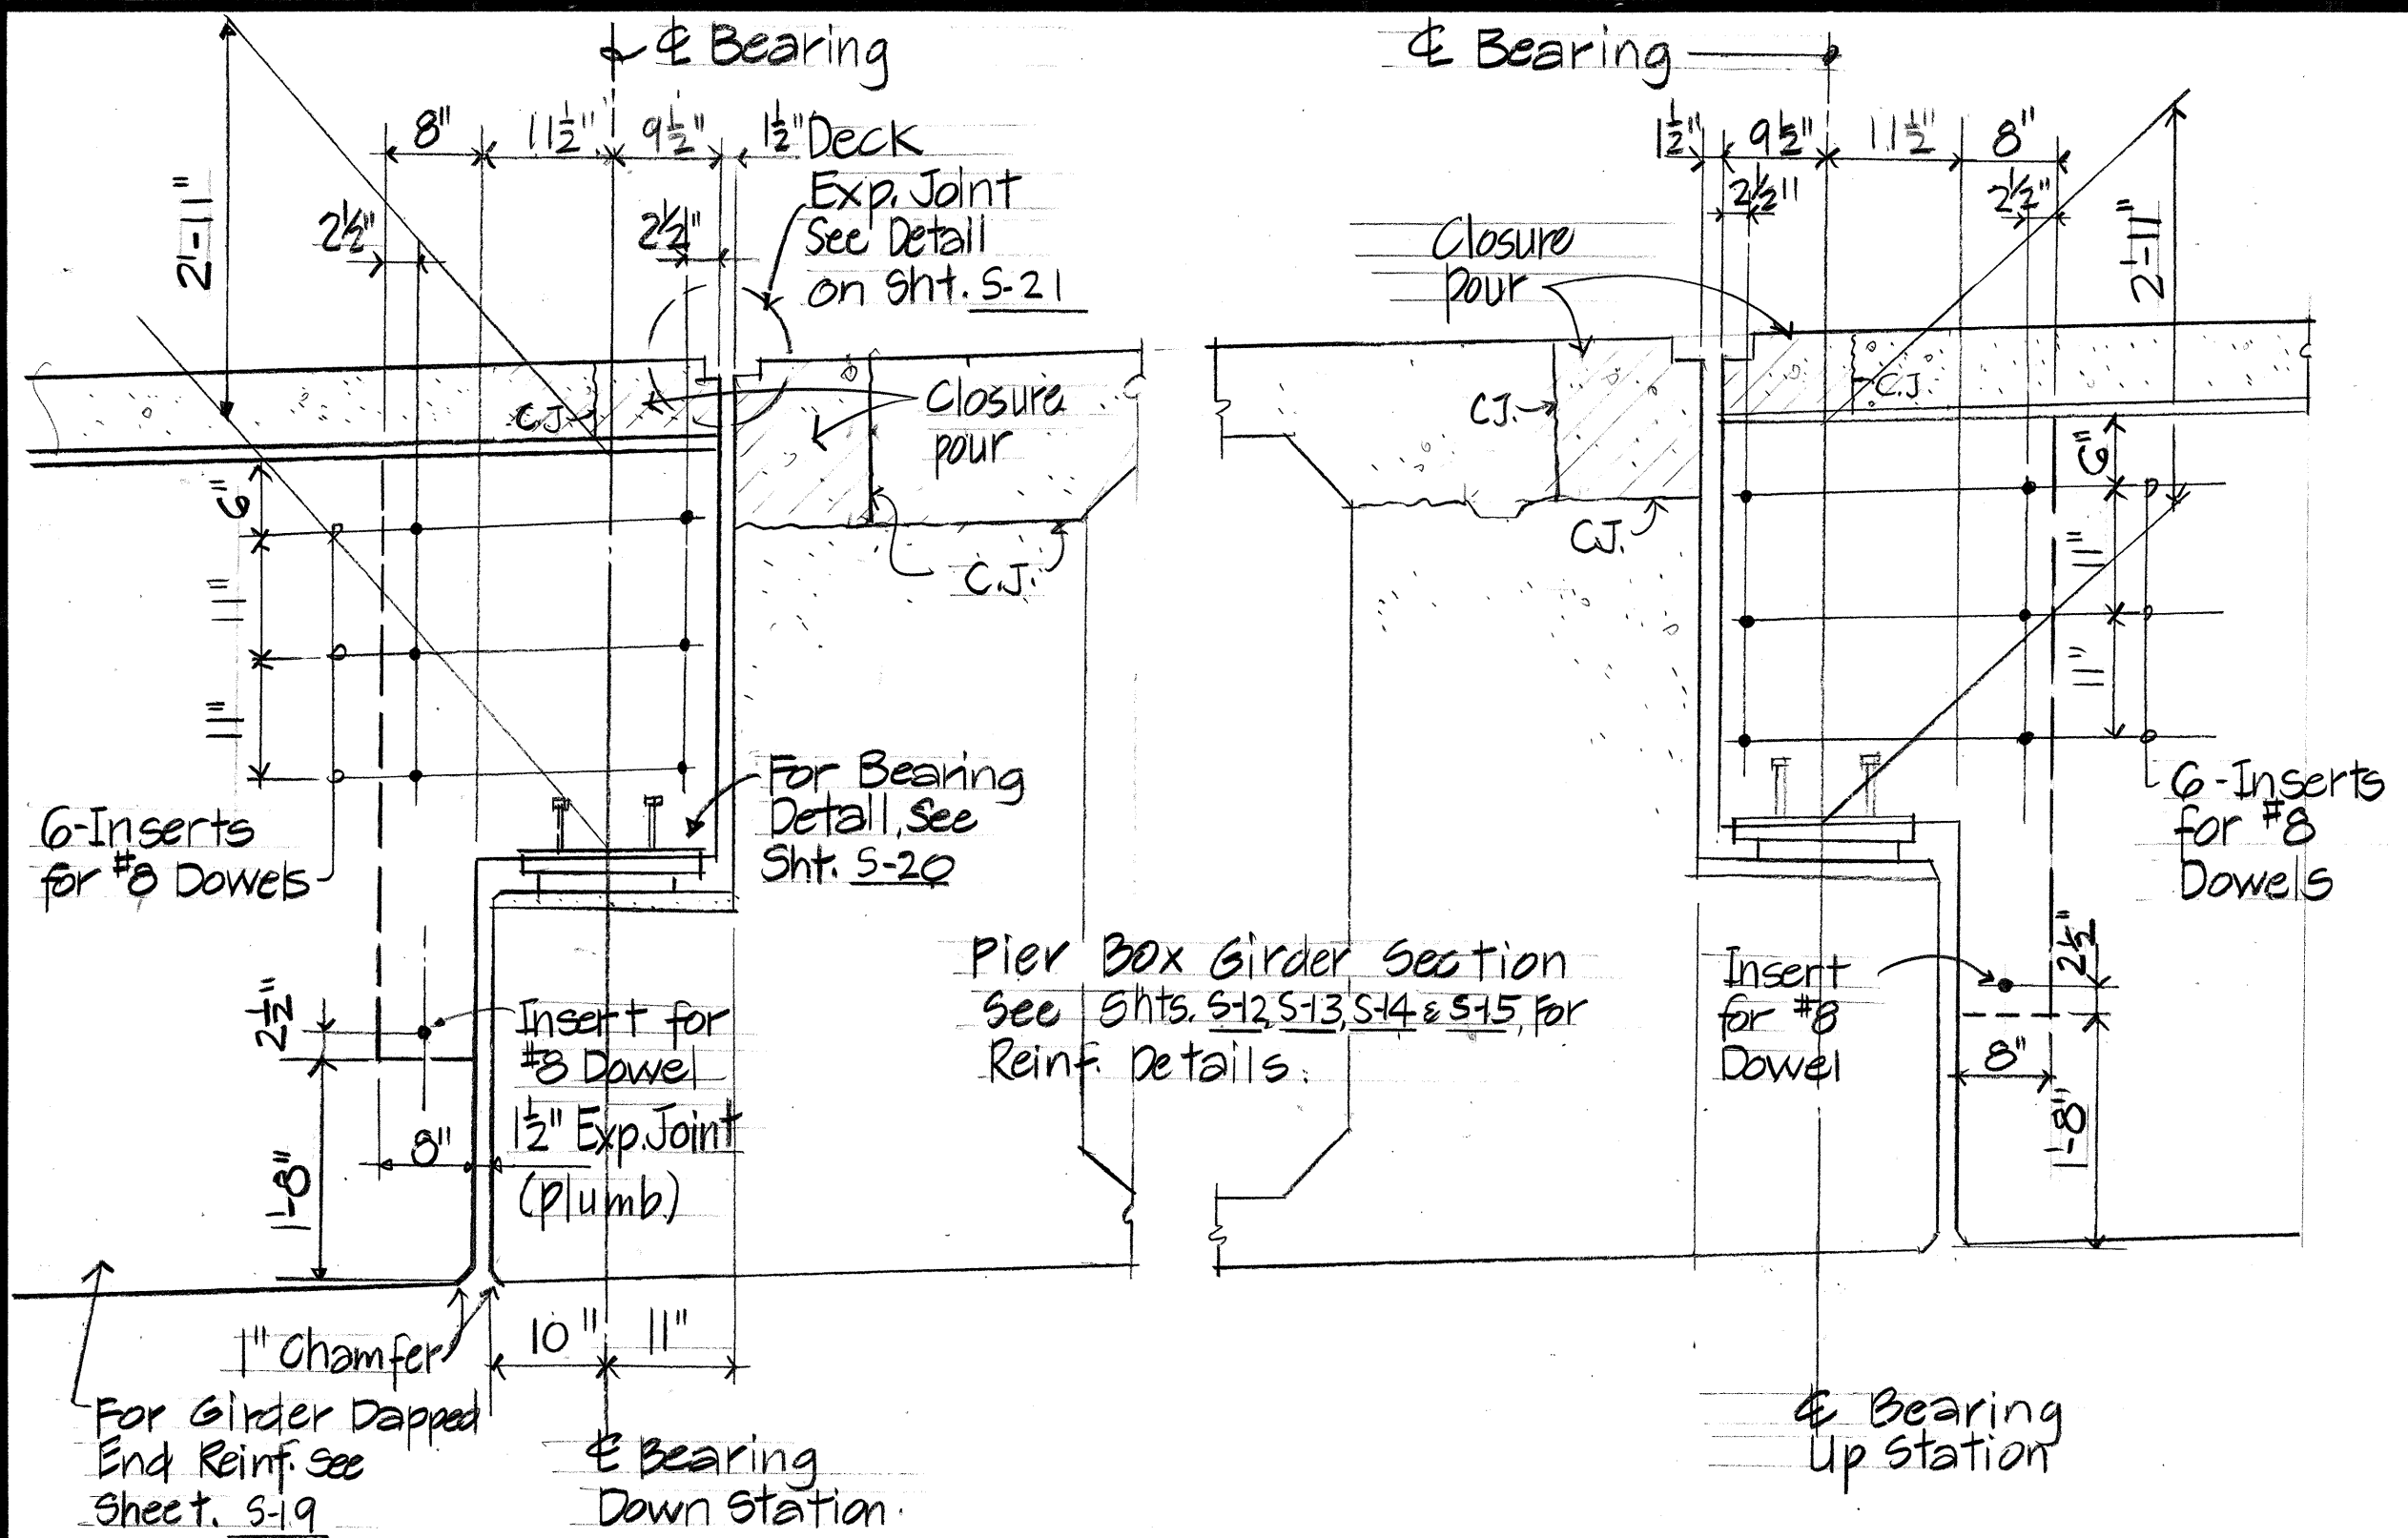


GIRDER BEARING AT DOWN STATION

SECTION A
Scale: 3/4" = 1'-0" S17/S17

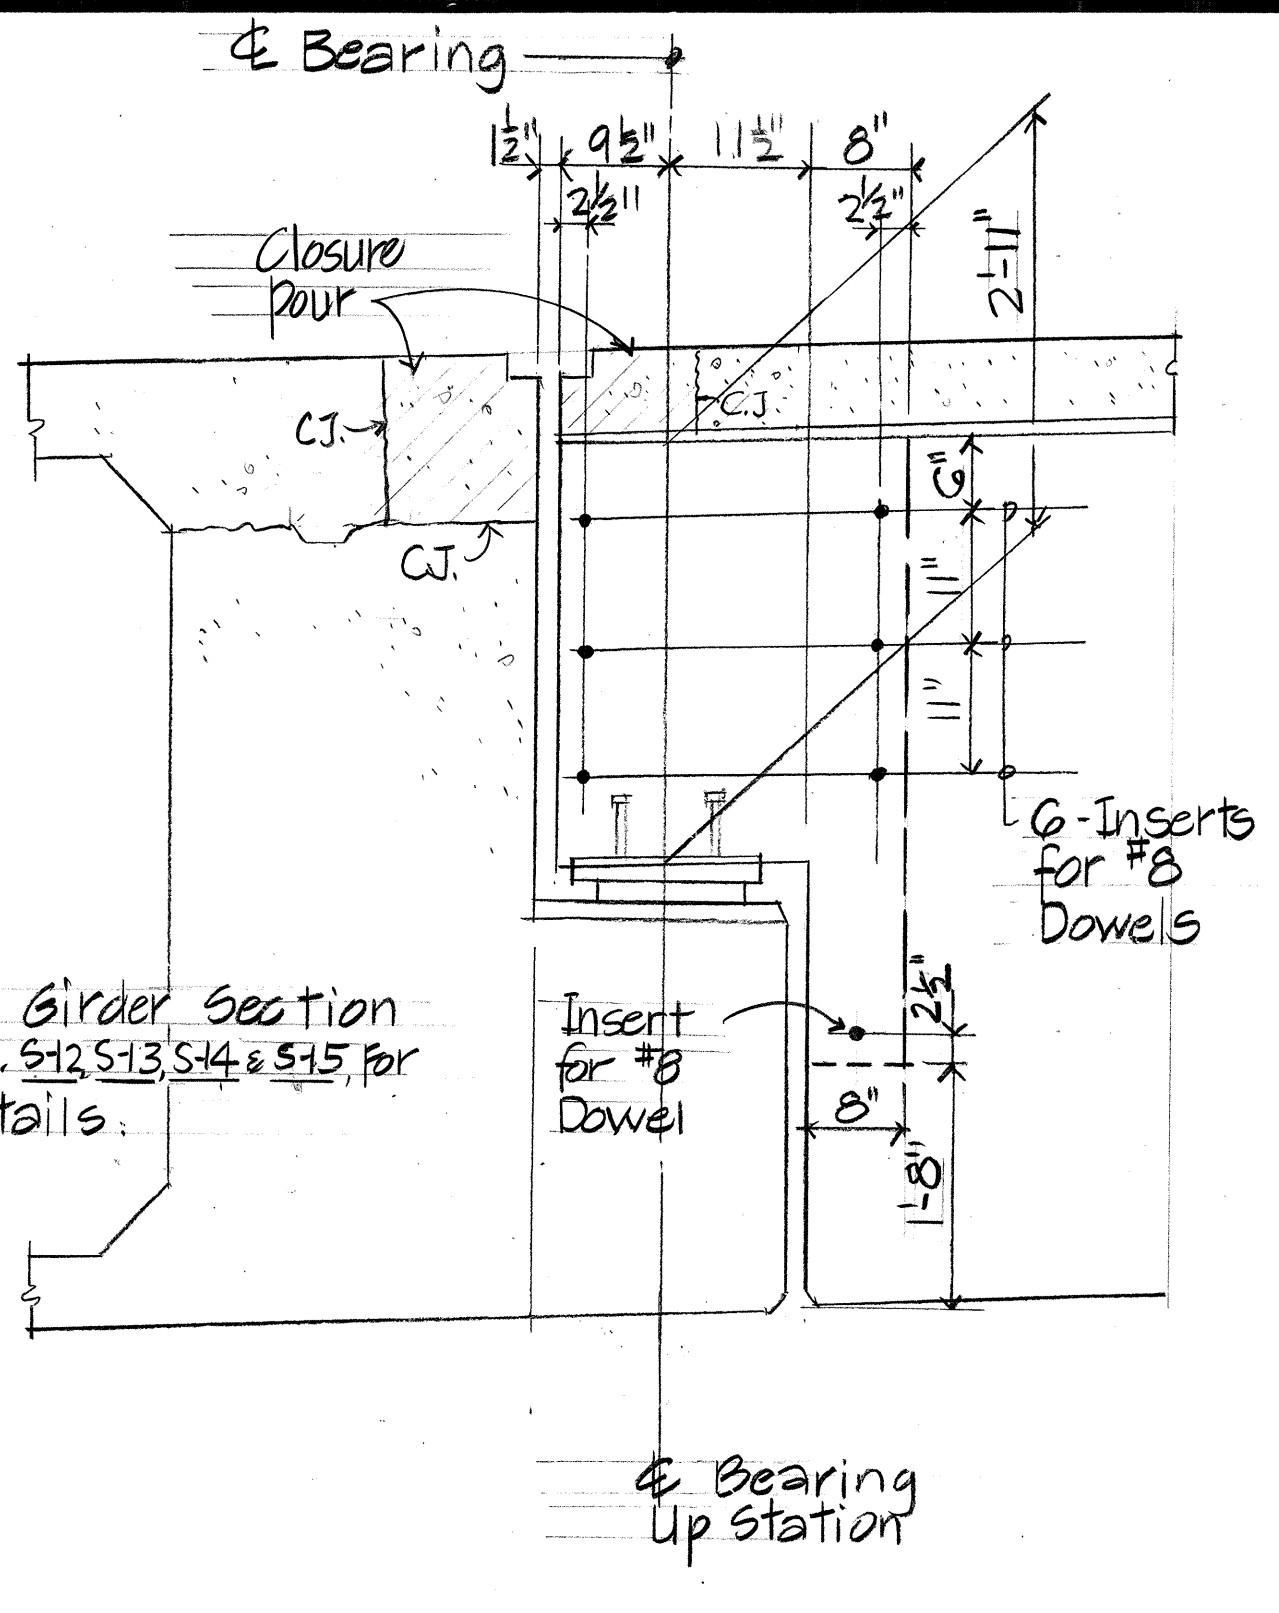

GIRDER BEARING AT UP STATION

SECTION B
Scale: 3/4" = 1'-0" S17/S17

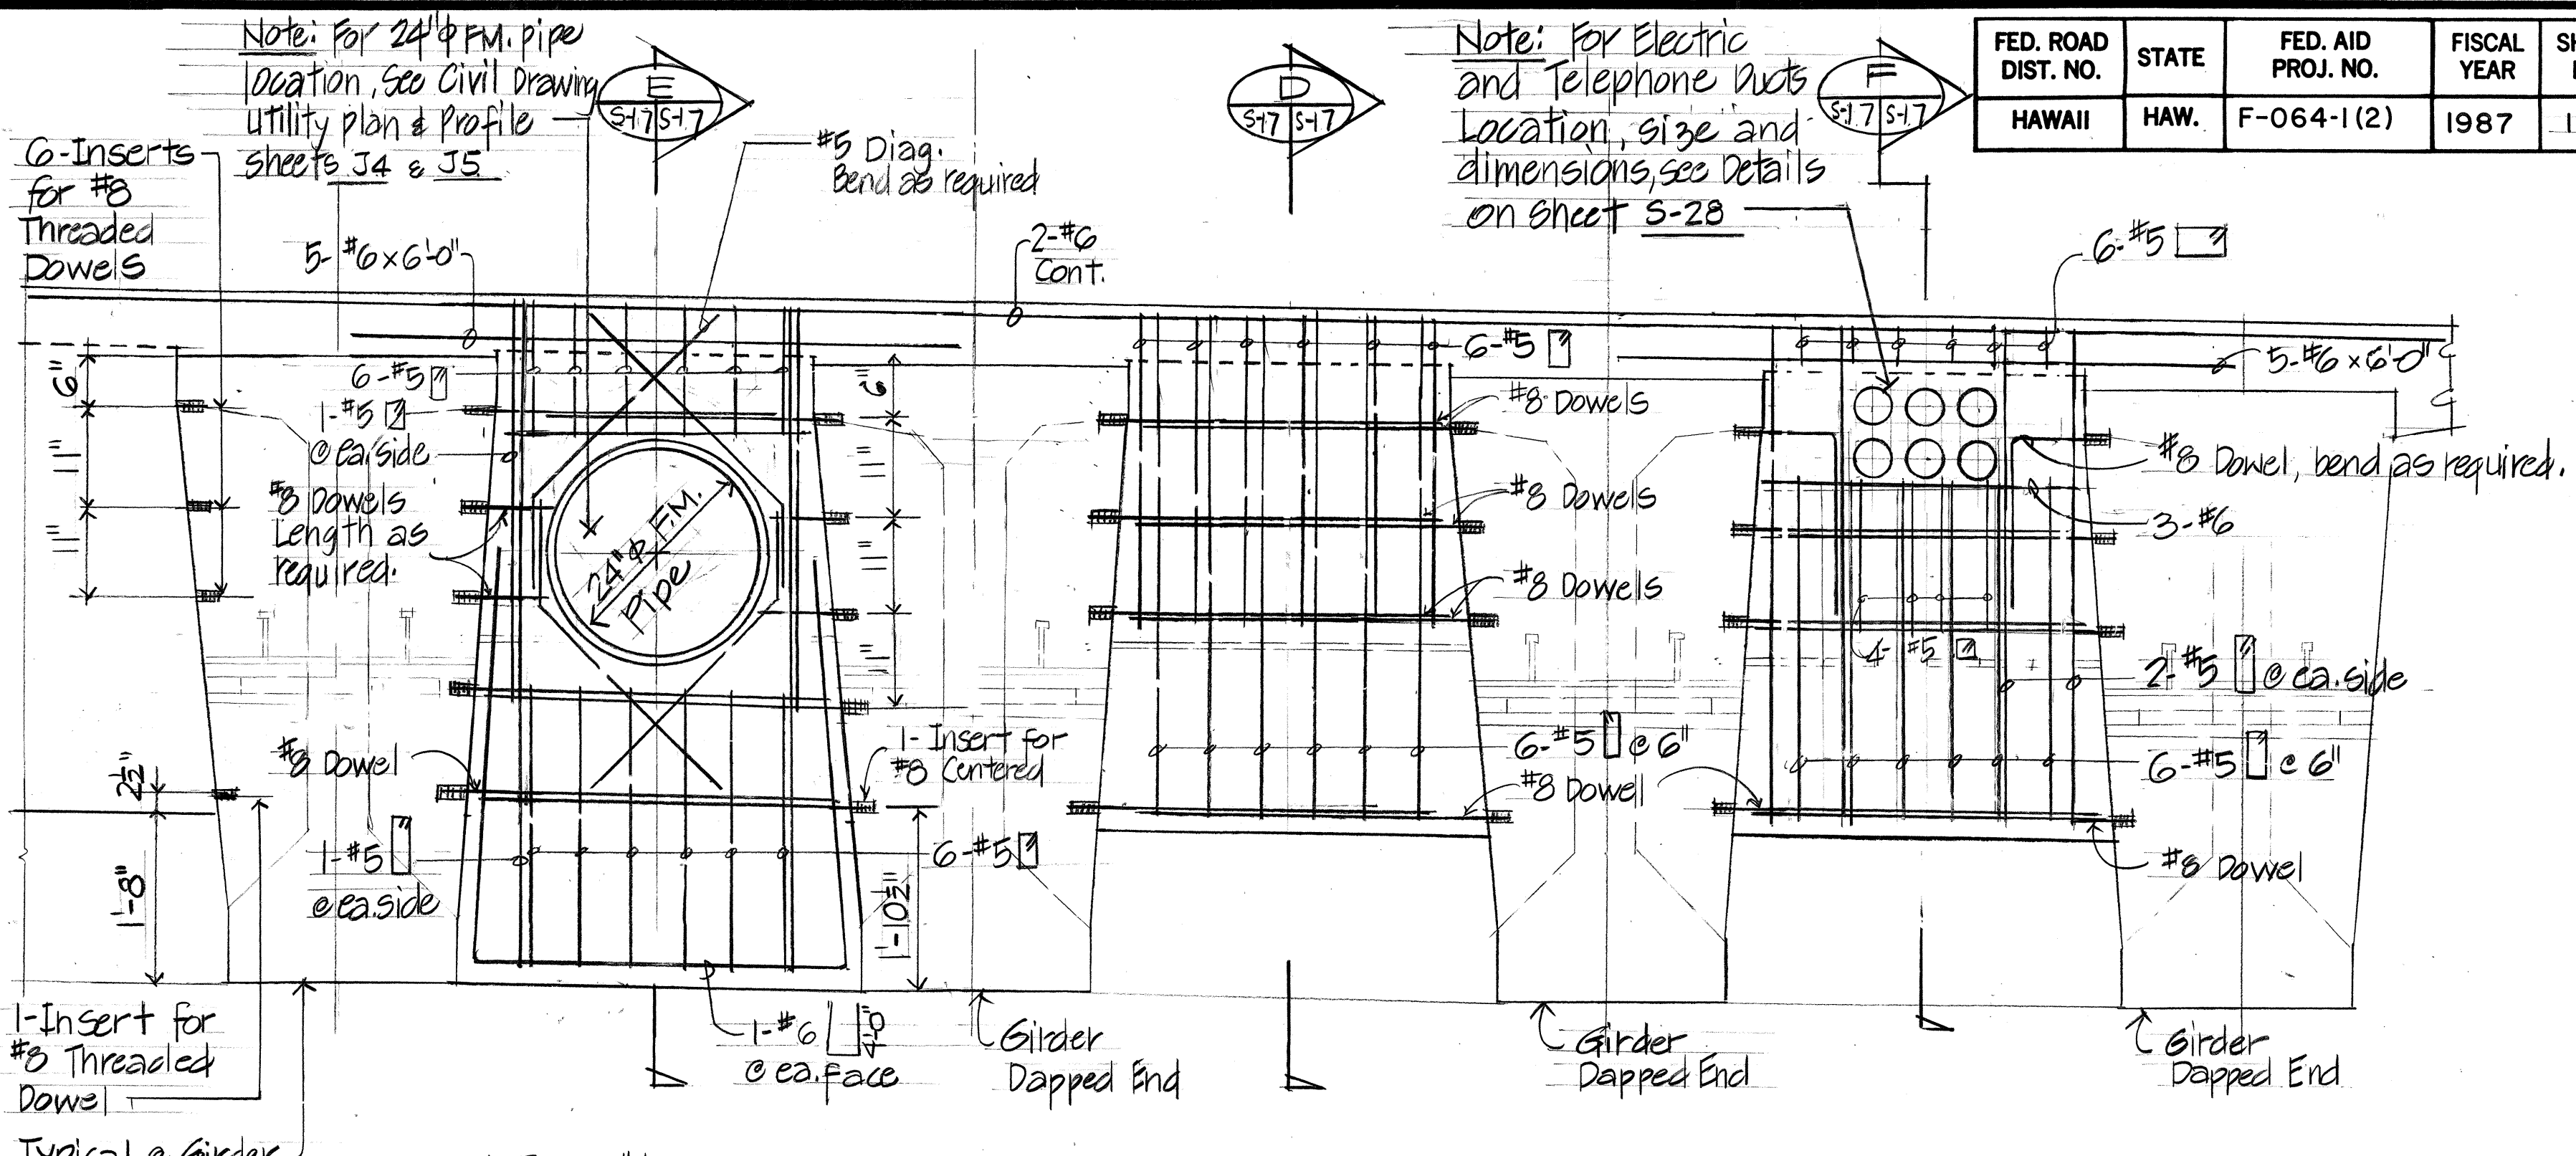


AT 24" PIPE THRU DIAPHRAGM

TYPICAL DIAPHRAGM

AT DUCTS THRU DIAPHRAGM


END DIAPHRAGM AT BOX PIER - PARTIAL ELEVATION C

Scale: 3/4" = 1'-0" S17/S17

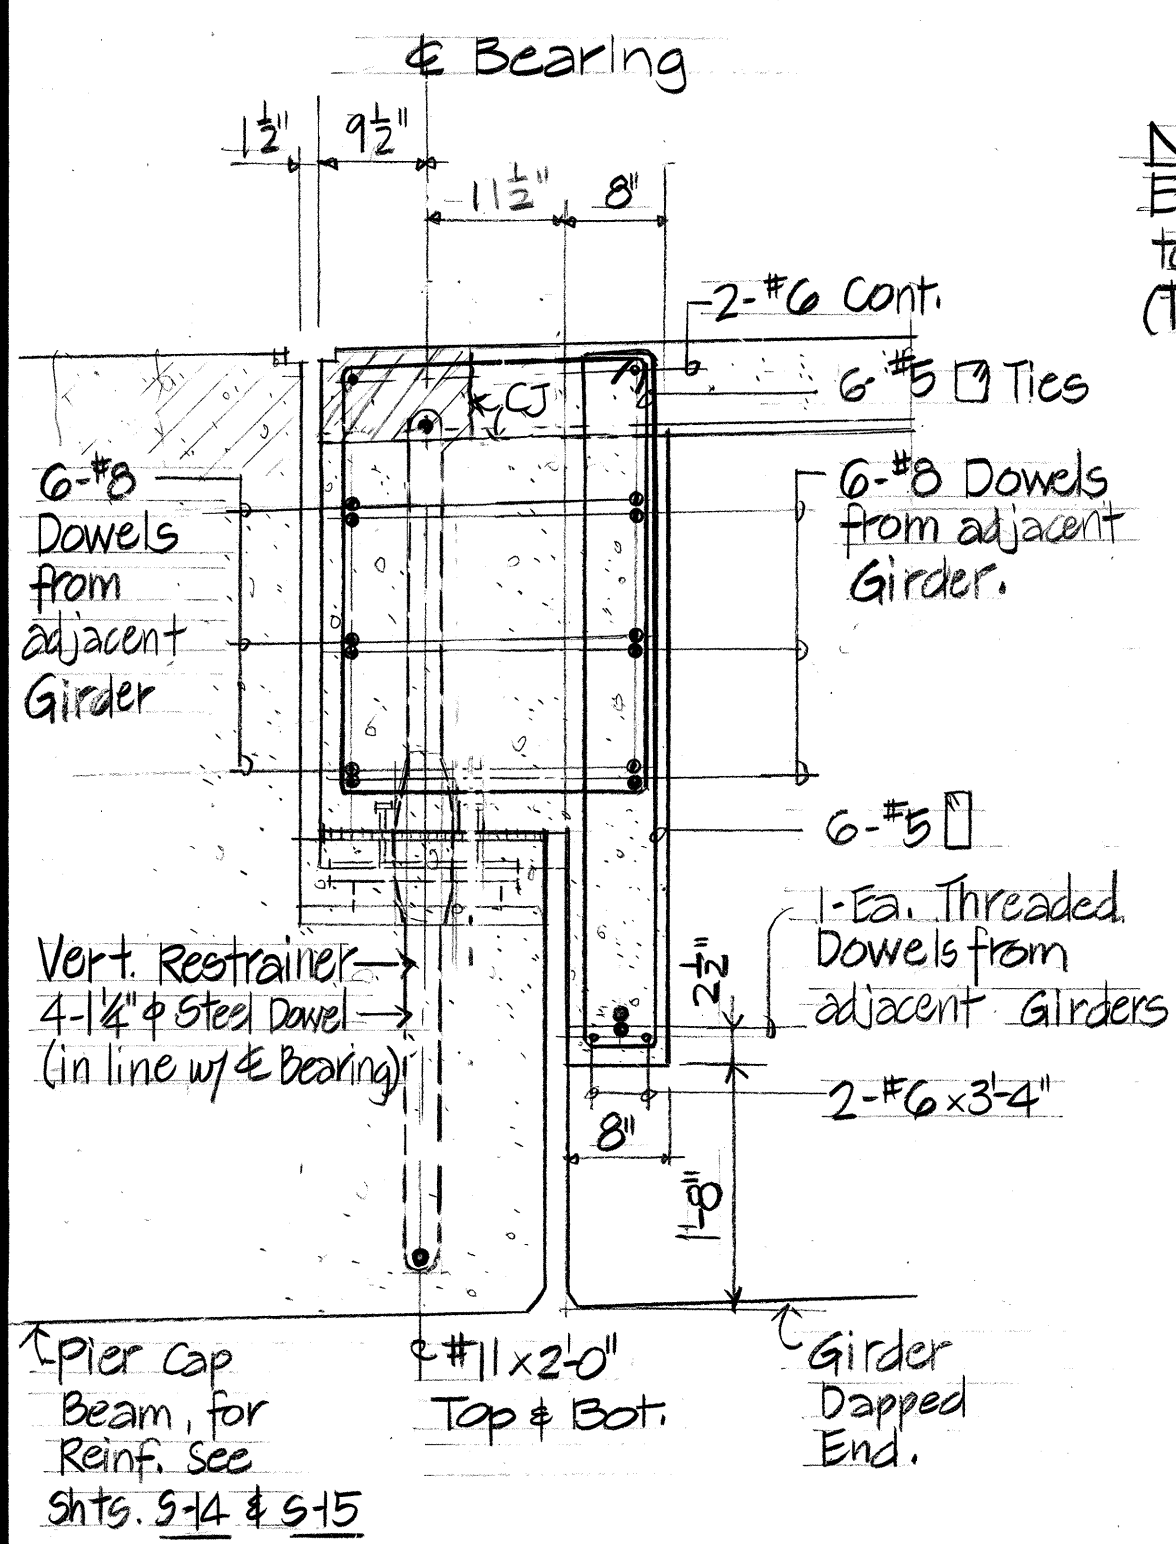

TYPICAL PIER DIAPHRAGM


SECTION D
Scale: 3/4" = 1'-0" S17/S17

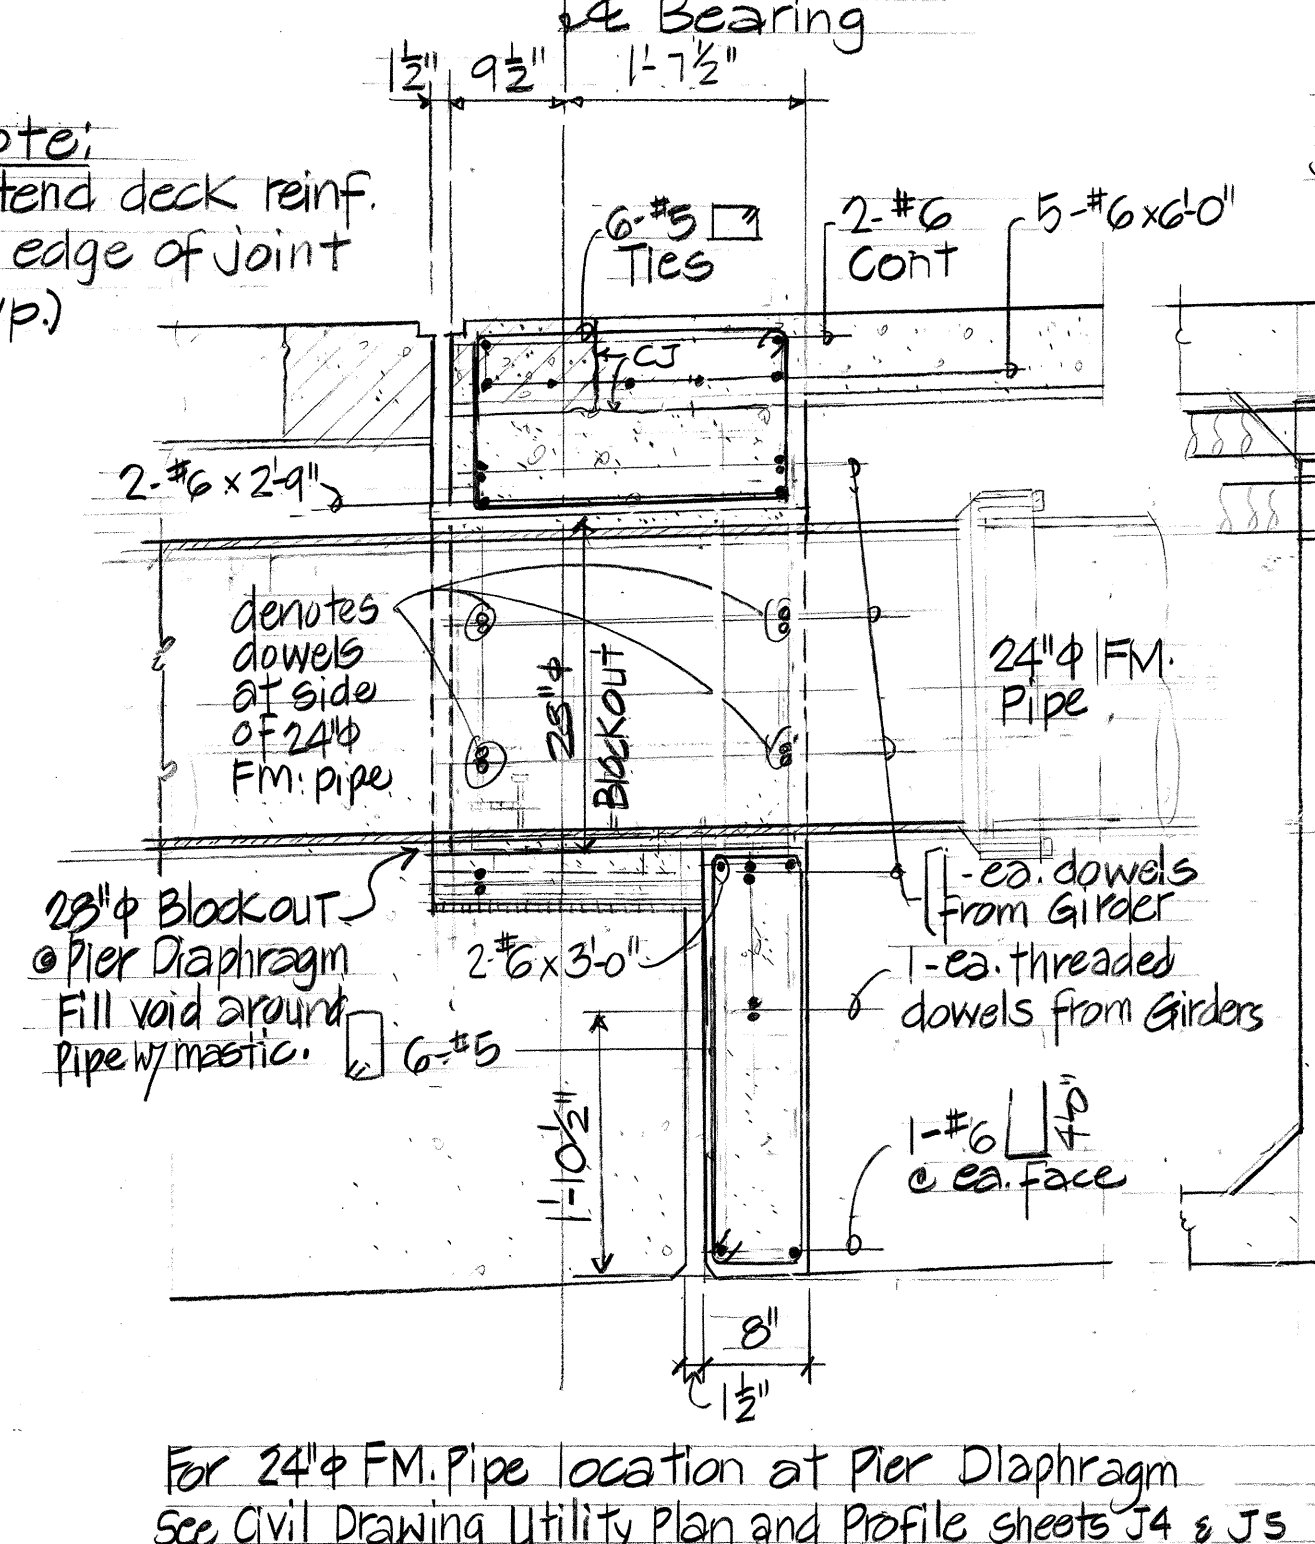

For 24" FM. Pipe location at Pier Diaphragm See Civil Drawing Utility Plan and Profile sheets J4 & J5


FORCE MAIN THRU PIER DIAPHRAGM

SECTION E
Scale: 3/4" = 1'-0" S17/S17

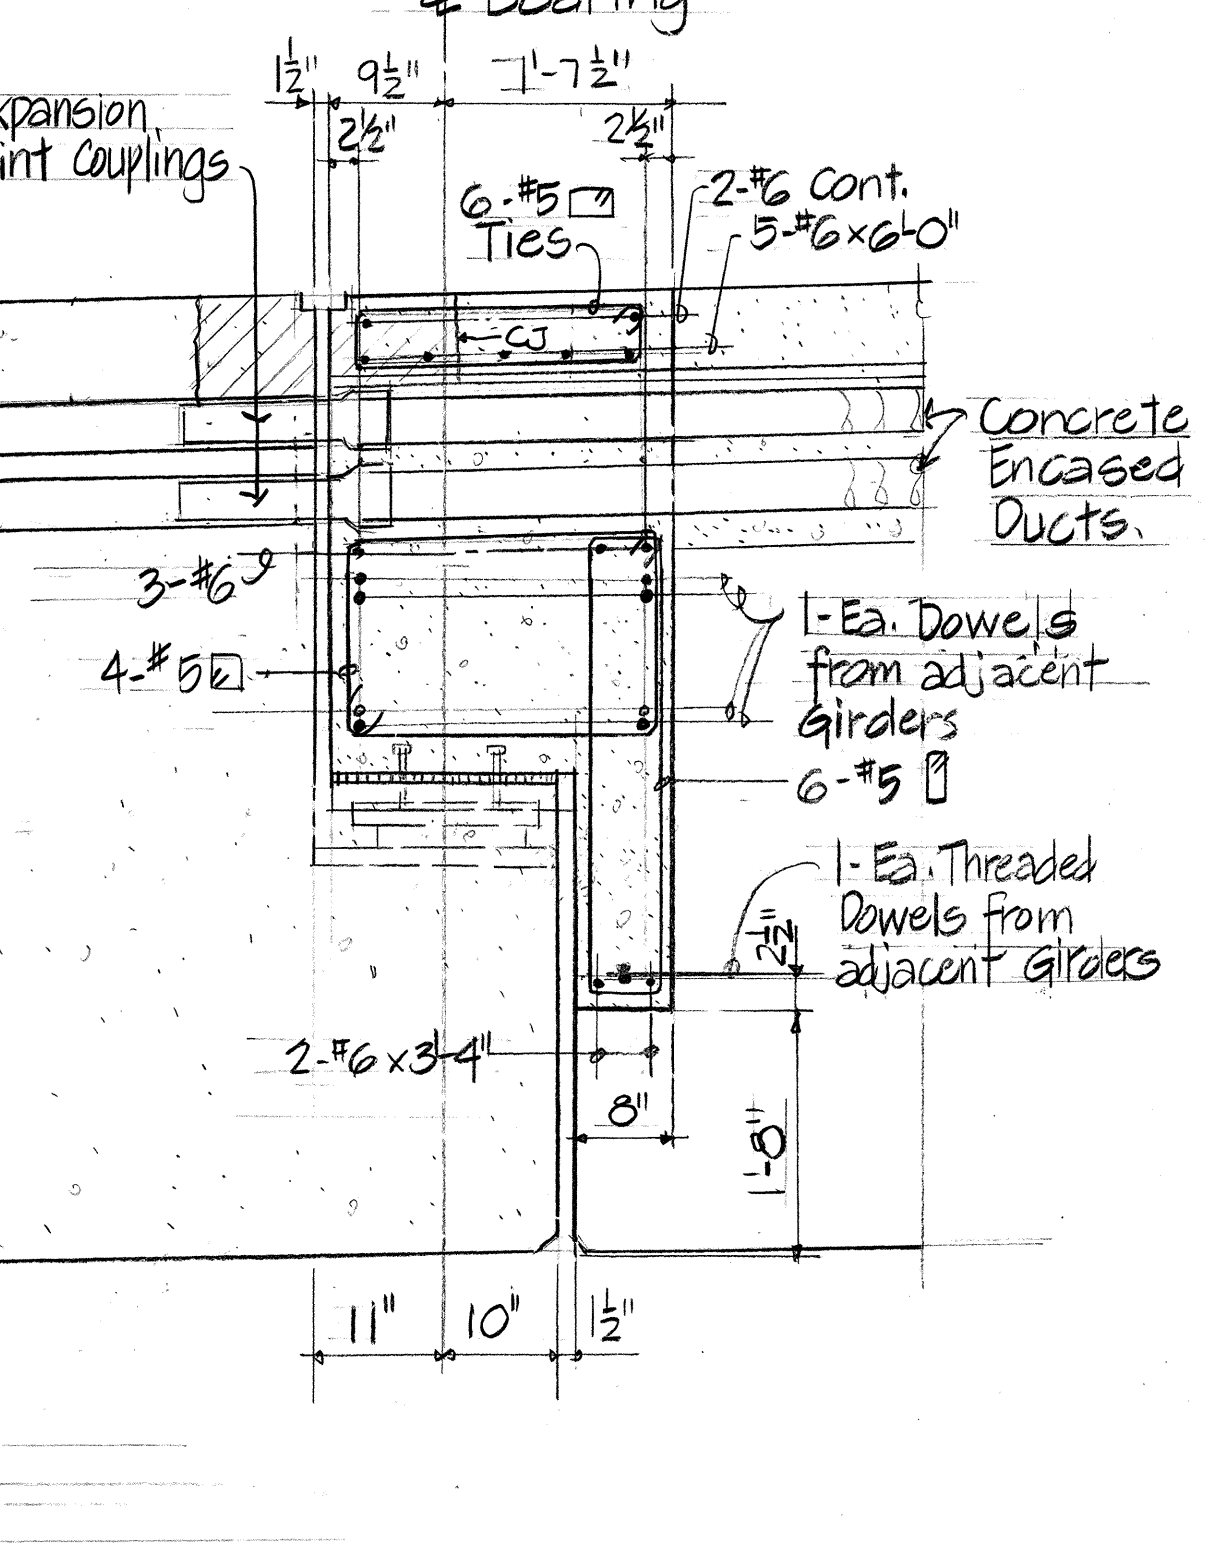

DUCTS THRU PIER DIAPHRAGM (8-WAY & 6-WAY DUCTS SIMILAR)

SECTION F
Scale: 3/4" = 1'-0" S17/S17

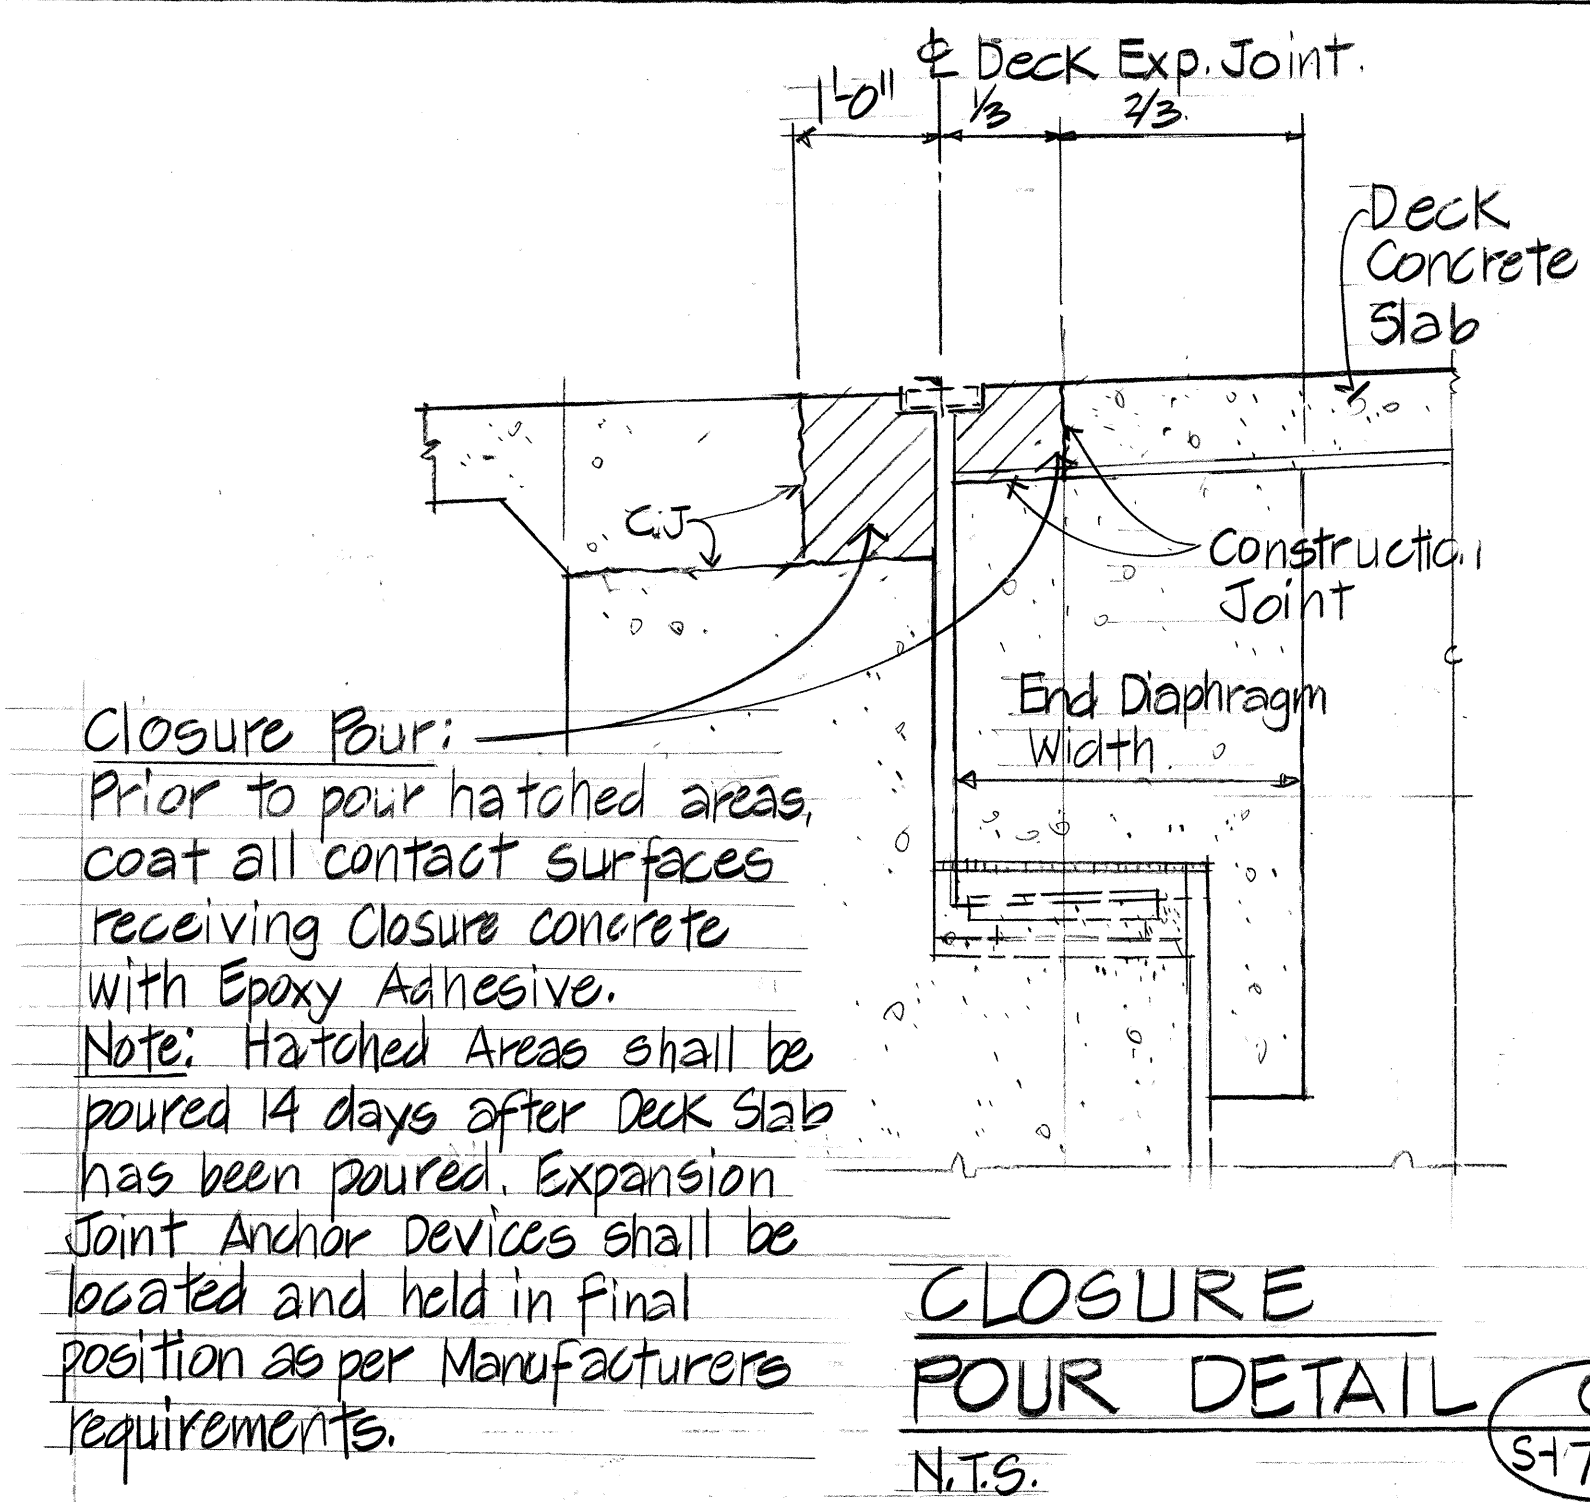

CLOSURE POUR DETAIL G
N.T.S. S17/S17

REGISTERED PROFESSIONAL ENGINEER
No. 4230-S
HAWAII, U.S.A.
THIS WORK WAS PREPARED BY ME OR UNDER MY SUPERVISION
Myron Okubo


STATE OF HAWAII
DEPARTMENT OF TRANSPORTATION
HIGHWAYS DIVISION
END DIAPHRAGM AT BOX PIER DETAILS
SAND ISLAND ROAD WIDENING
2ND BRIDGE AND APPROACHES
FEDERAL AID PROJECT NO. F-064-1(2)

SCALE: AS NOTED DATE: JUN, 1986
SHEET NO. 517 OF 30 SHEETS


DATE	
DESIGNED BY	
TRACED BY	
QUANTITIES BY	
CHECKED BY	
NO.	

DATE REVISION


ORIGINAL	SURVEY PLOTTED BY	DATE
PLAN	DRAWN BY	"
	TRACED BY	"
NOTE BOOK	DESIGNED BY	"
	QUANTITIES BY	"
No.	CHECKED BY	"

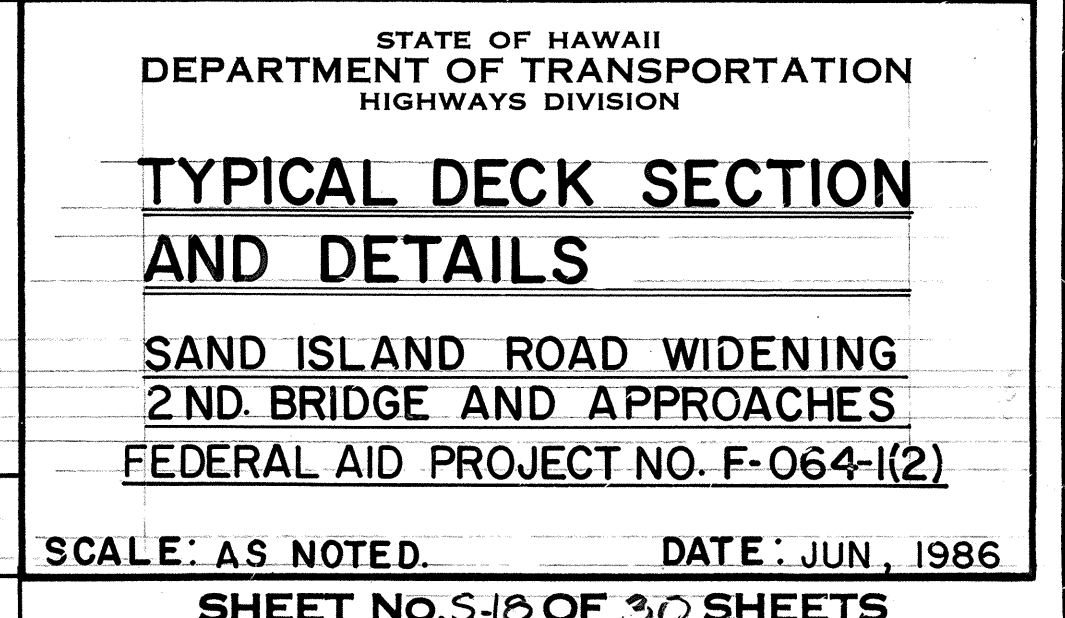


FED. ROAD DIST. NO.	STATE	FED. AID PROJ. NO.	FISCAL YEAR	SHEET NO.	TOTAL SHEETS
HAWAII	HAW.	F-064-1(2)	1987	121	151

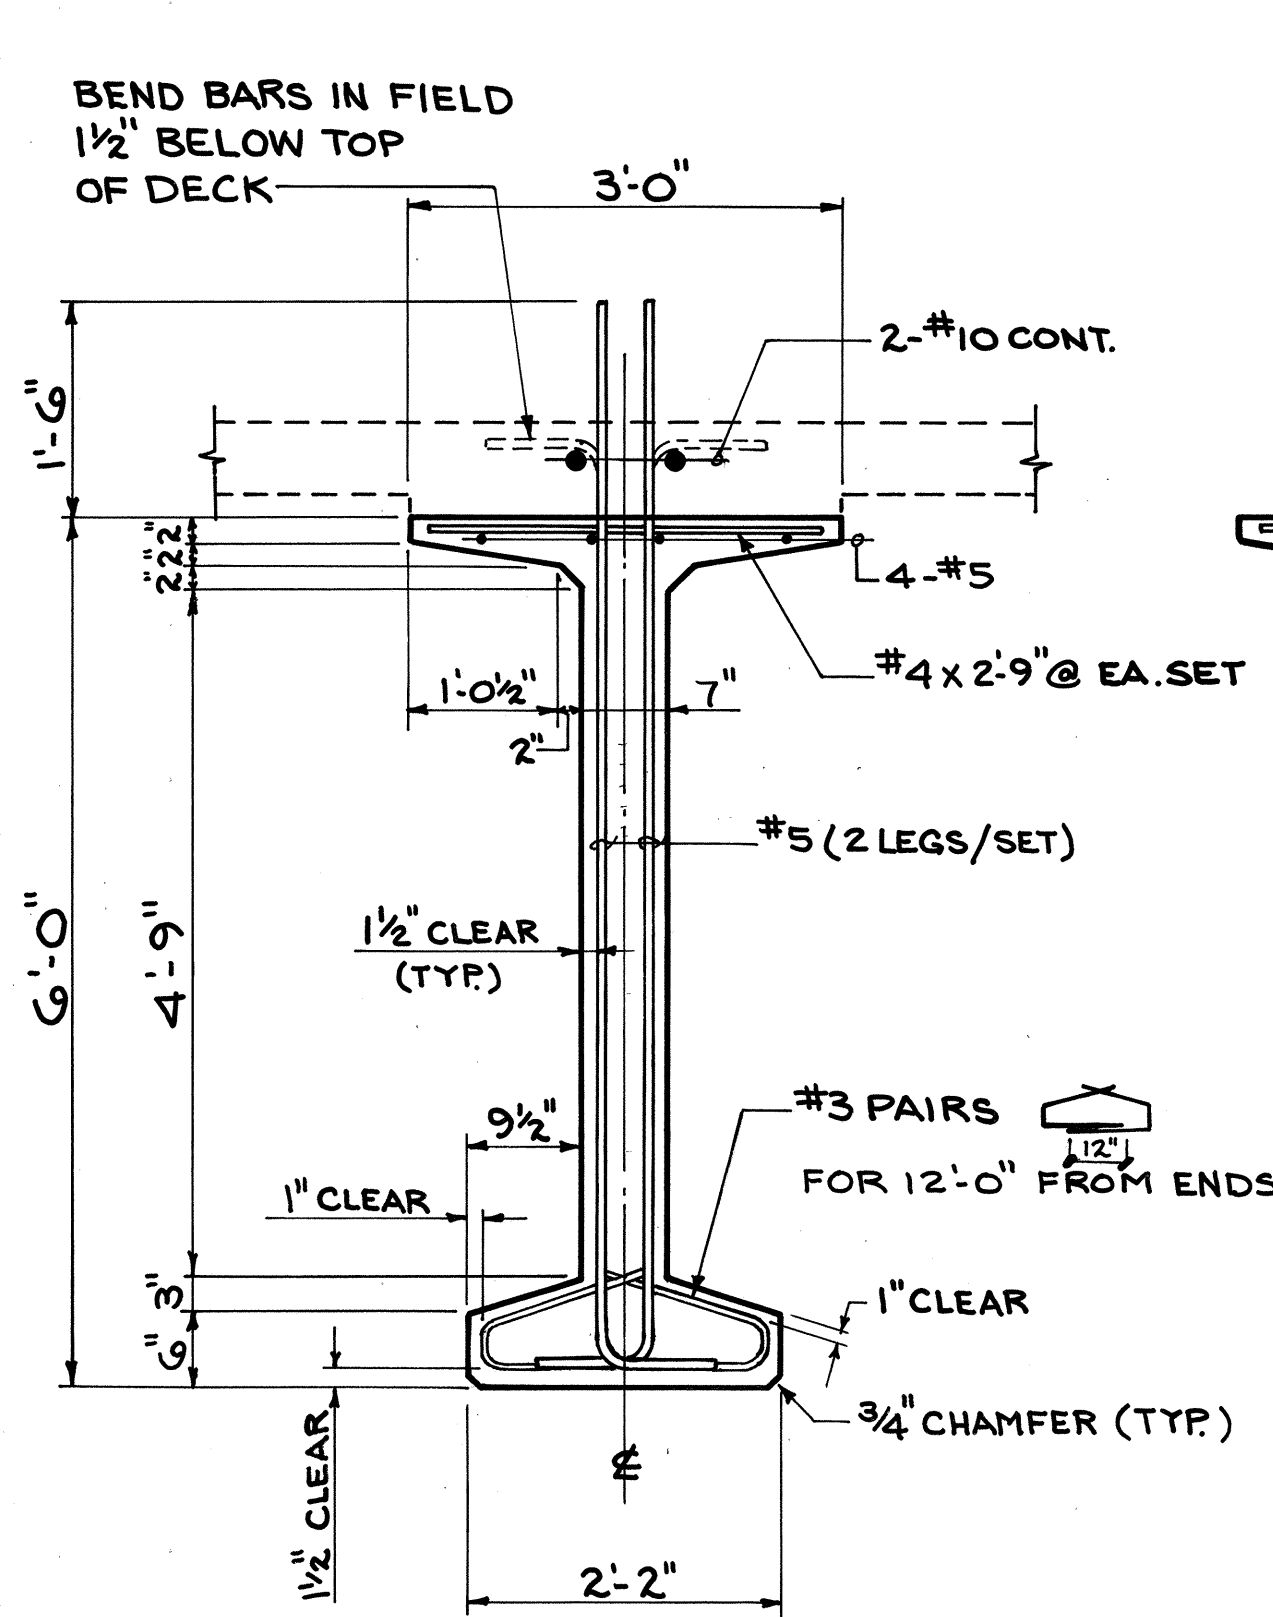


TYPICAL GIRDER SECTION A
SCALE: 3/4" = 1'-0"

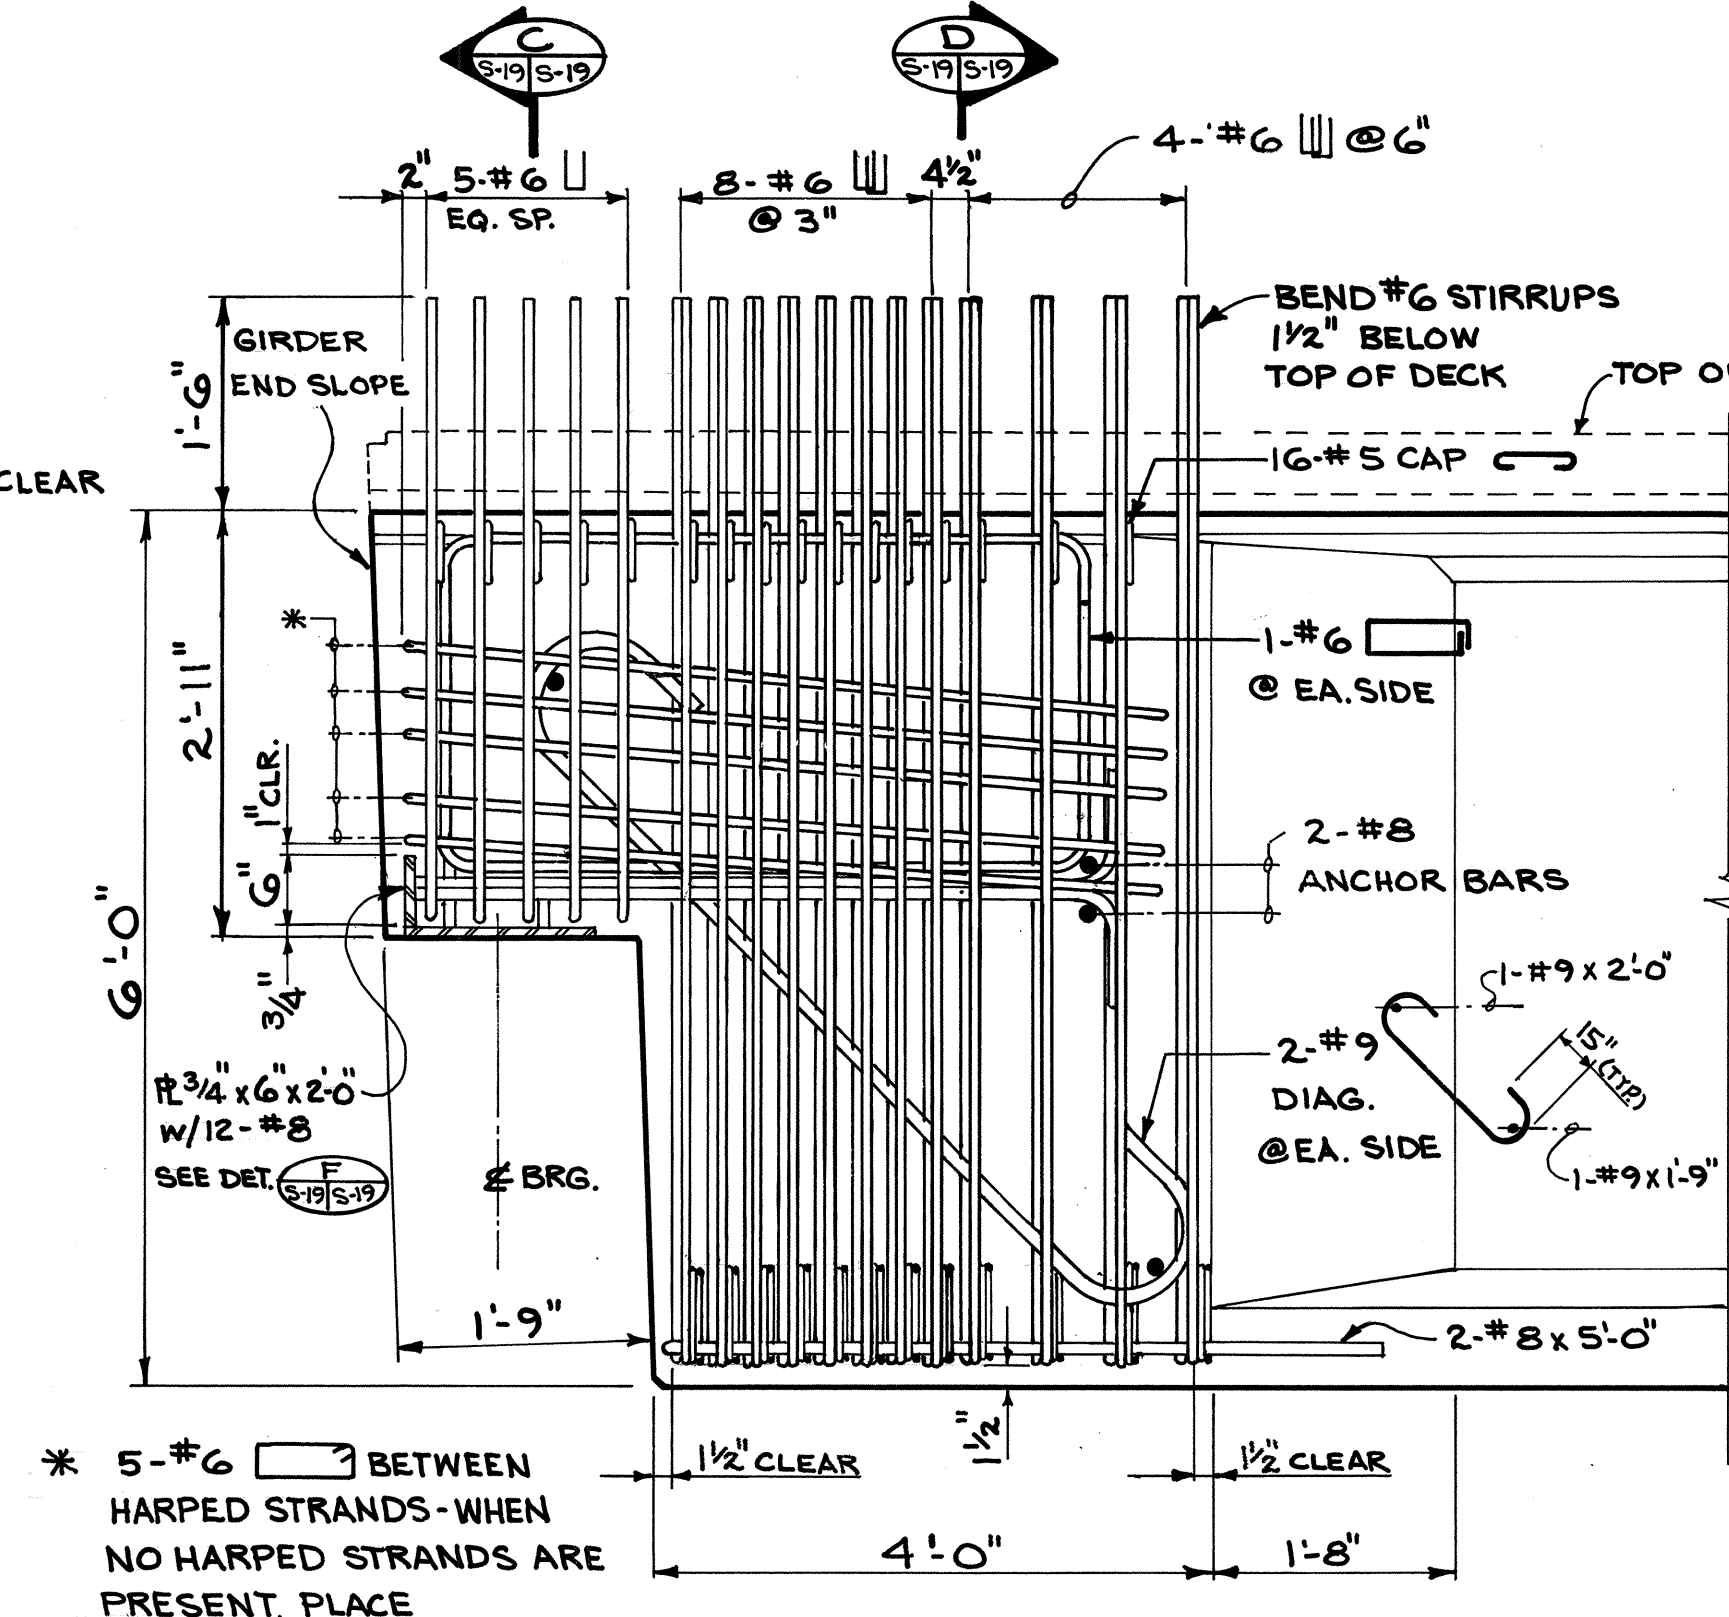


GIRDER DAPPED END DETAIL B
SCALE: 3/4" = 1'-0"

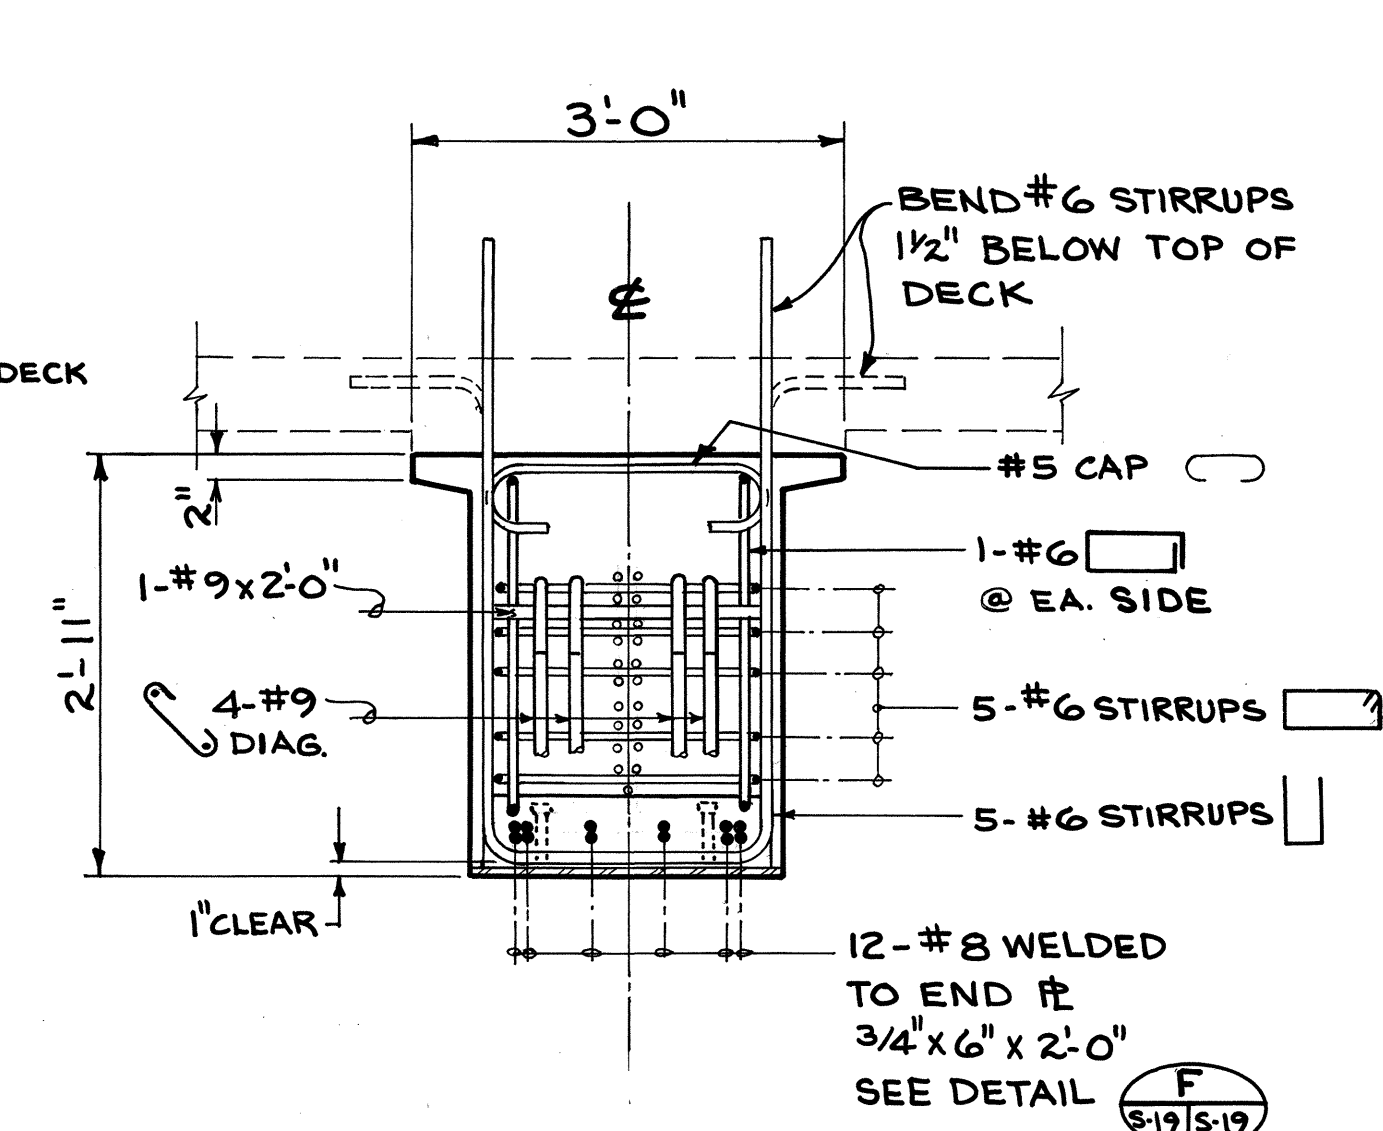


SECTION C
SCALE: 3/4" = 1'-0"

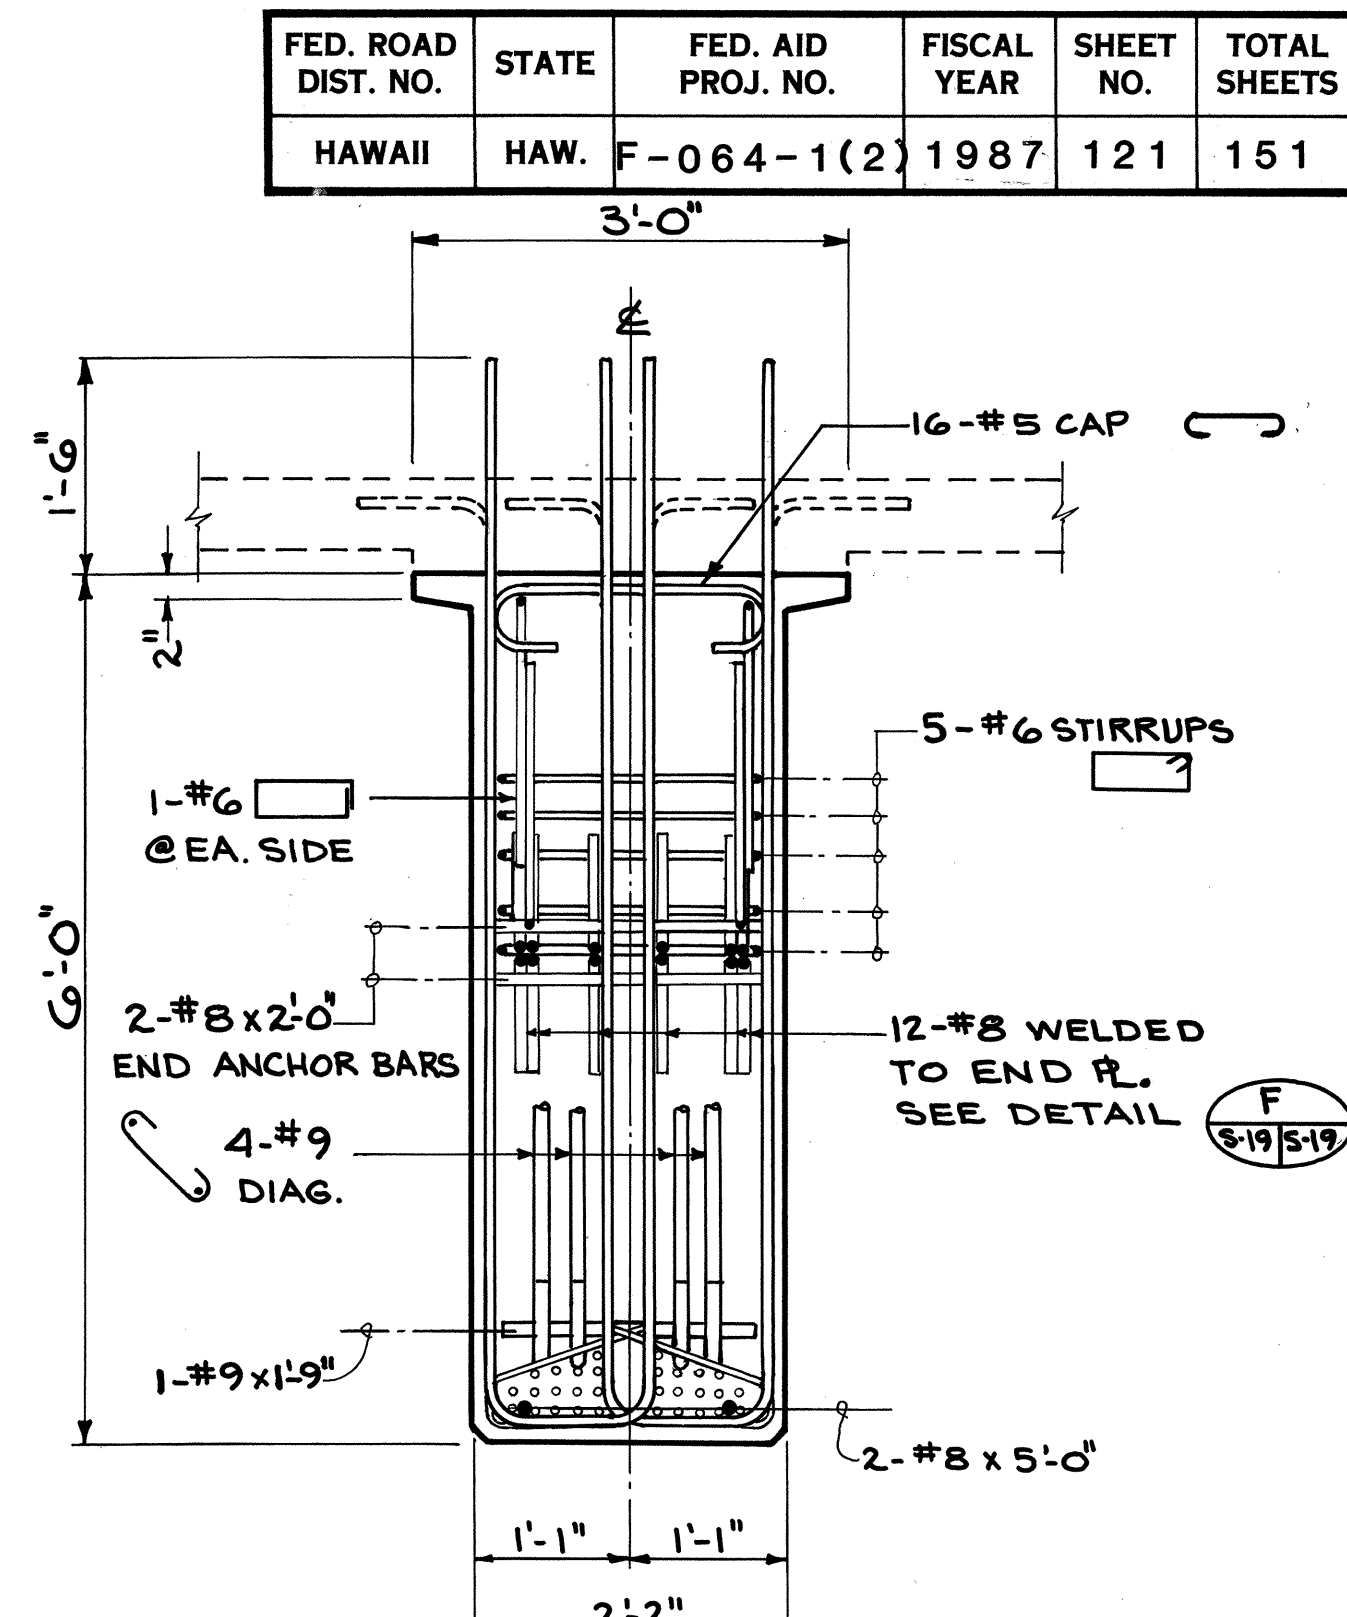

SECTION D
SCALE: 3/4" = 1'-0"

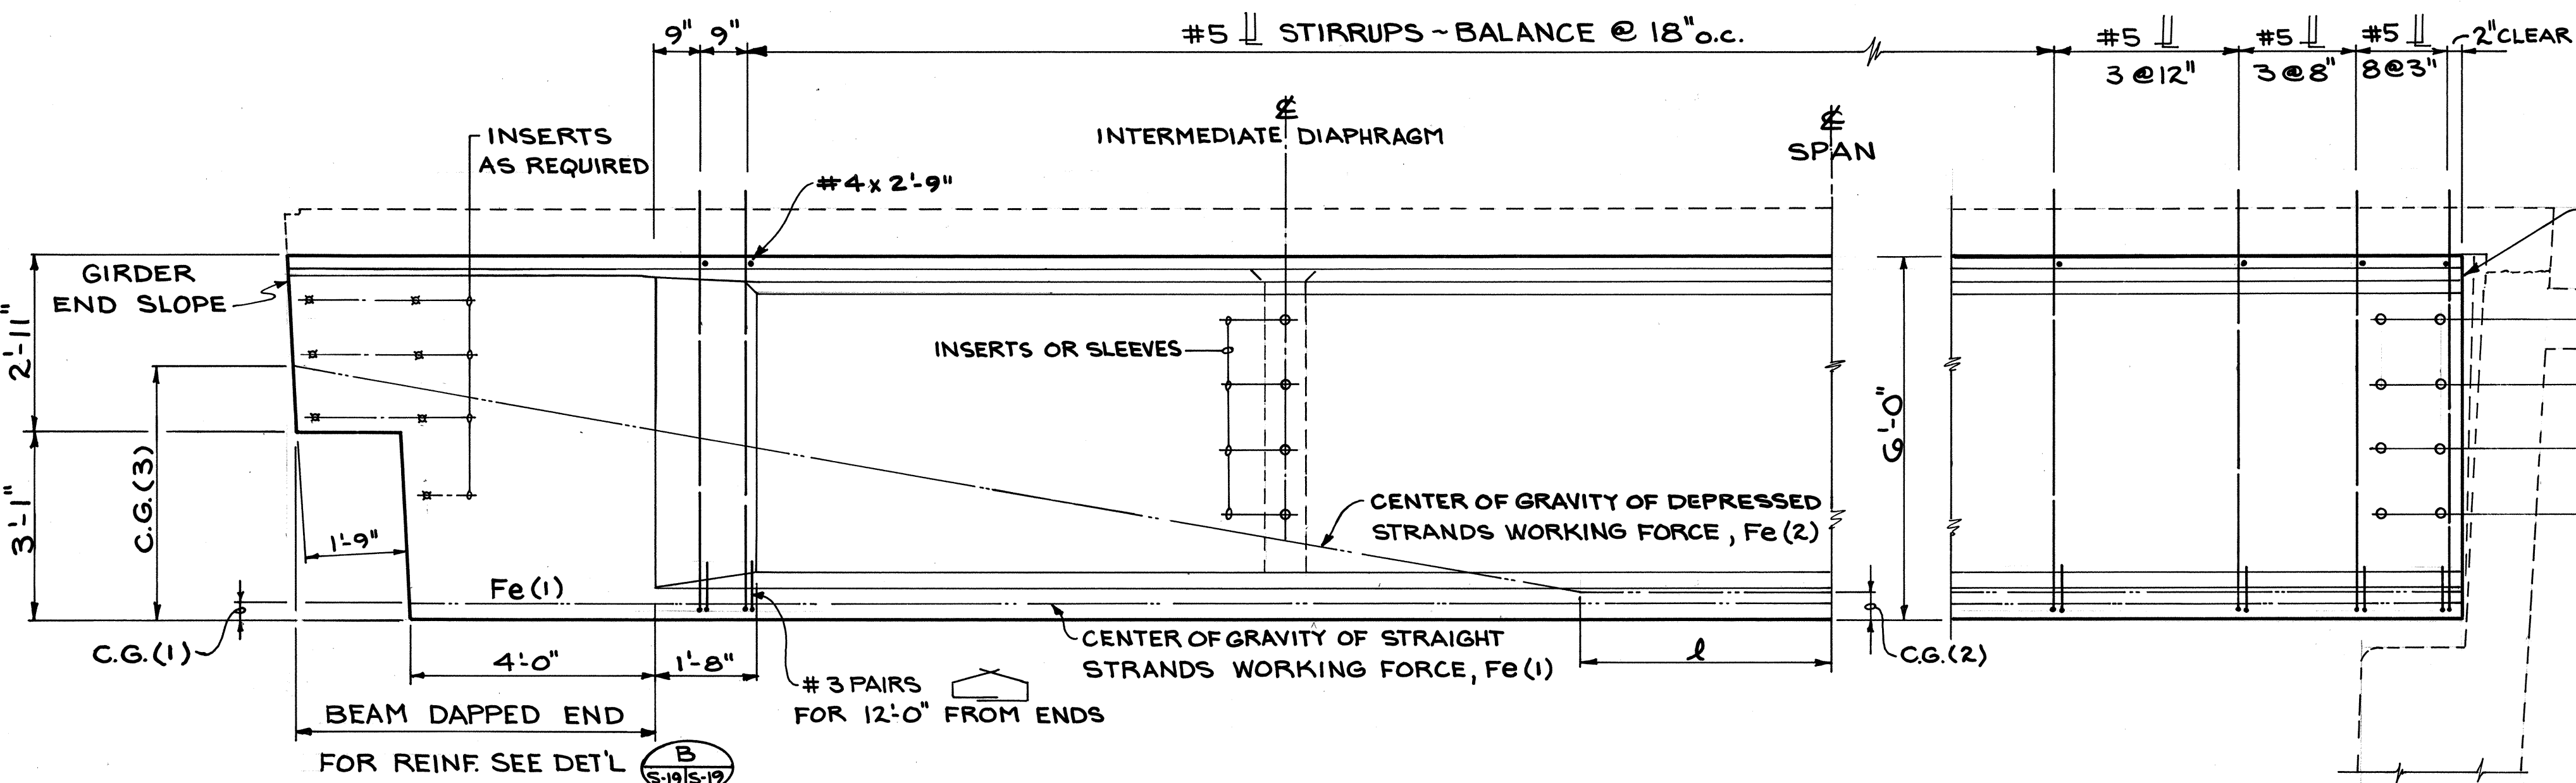

TYPICAL GIRDER LONGITUDINAL SECTION E
NOT TO SCALE.

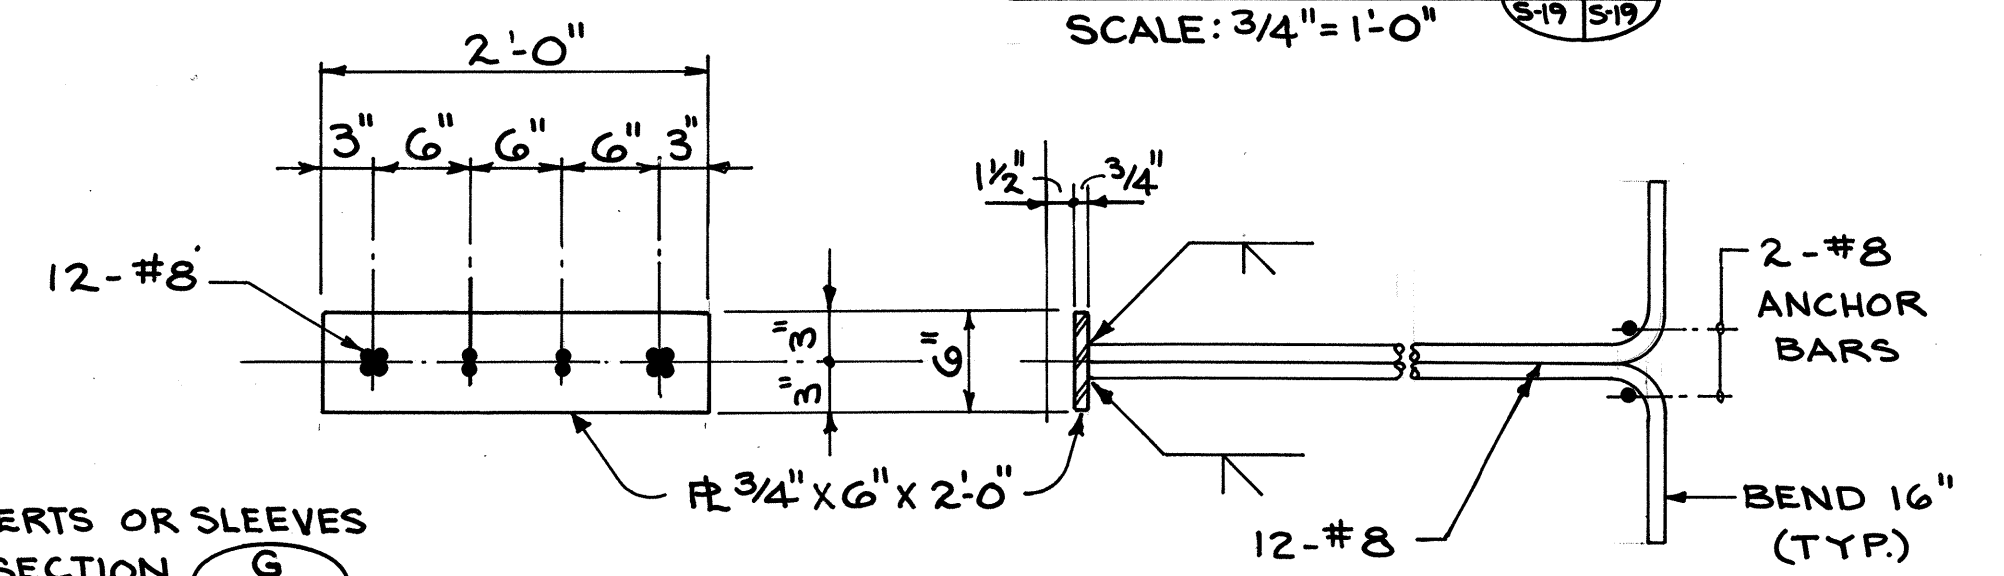


DETAIL F
SCALE: 1" = 1'-0"
REINFORCEMENT SHALL CONFORM TO ASTM A588. ASSEMBLY SHALL BE HOT DIPPED GALVANIZED AFTER FABRICATION. REINFORCEMENT SHALL BE CONSIDERED INCIDENTAL TO PRESTRESSED GIRDERS. SOLE PLATE NOT SHOWN IN THIS DETAIL. SEE SHEET S-20

NOTES:

- FOR GIRDER END SLOPE SEE BRIDGE DECK FRAMING PLAN. +) CLOCKWISE SLOPE. -) COUNTER CLOCKWISE SLOPE.
- INSERTS AND SLEEVES SHALL BE CONSIDERED INCIDENTAL TO PRESTRESSED CONCRETE GIRDER.
- GR. 60 REINF. USED FOR ALL REINFORCEMENT.
- "As-Built" Girder Manufactured by Washington Technology Inc. Seattle, Washington.

NOTE:
VECP MADE BY CONTRACTOR

GIRDER SCHEDULE														
GIRDER	Fe (1)	CG (1)	Fe (2)	CG (2)	CG (3)	l	CALCULATED CAMBER	CALCULATED DEAD LOAD DEFLECTION						
								G1	G2	G3	G4	G5	G6	G7
1-G1-1-G7	450K	3.28"	250K	3.60"	49.50'	9.08'	-1.01"	0.50"	0.50"	0.50"	0.50"	0.50"	0.50"	0.50"
2-G1-2-G7	672K	4.37"	471K	5.57"	53.42'	12.5'	-2.18"	2.09"	2.09"	2.09"	2.09"	2.09"	2.09"	2.09"
3-G1-3-G7	672K	4.37"	471K	5.57"	53.42'	12.5'	-2.18"	2.09"	2.09"	2.09"	2.09"	2.09"	2.09"	2.09"
4-G1-4-G7	672K	4.37"	471K	5.57"	53.42'	12.5'	-2.18"	2.09"	2.09"	2.09"	2.09"	2.09"	2.09"	2.09"
5-G1-5-G7	219K	2.50"	110K	3.00"	46.88'	9.08'	-0.19"	0.10"	0.10"	0.10"	0.10"	0.10"	0.10"	0.10"

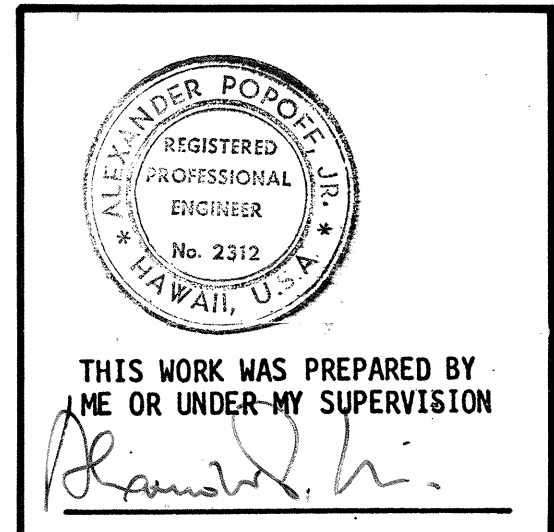


STATE OF HAWAII DEPARTMENT OF TRANSPORTATION LAND TRANSPORTATION FACILITIES DIVISION GIRDER DETAILS	
SAND ISLAND ROAD WIDENING 2ND BRIDGE AND APPROACHES	
FEDERAL AID PROJECT NO. F-064-1(2)	
APR. 1988	PER H.D.O.T. REVIEW
APR. 1988	CAMBER & DEFLECTIONS
MAR. 1988	CAMBER & DEFLECTIONS
FEB. 1988	SHEET REDRAWN FOR ALTERNATE GIRDER SECTION
DATE	REVISION
SCALE: AS NOTED DATE: JUN. 1986 SHEET NO. S19 OF 30 SHEETS	

"AS-BUILT"

FED. ROAD DIST. NO.	STATE	FED. AID PROJ. NO.	FISCAL YEAR	SHEET NO.	TOTAL SHEETS
HAWAII	HAW.	F-064-1(2)	1987	122	151


Notes

- Bevelled and sole plates shall conform to ASTM A 242, and shall be hot dipped galvanized after fabrication.
- 7/8" ϕ studs shall be welded to sole plate with automatically timed welding equipment.
- Bevelled plate shall be welded to sole plate prior to erection of the girder at the job site.
- Galvanized coatings damaged during welding operations or any phase of construction shall be repaired by a field galvanizing method conforming to Annex A1 of ASTM A 780 and to subsection 501.03 (G) Galvanizing of Specifications. Repair shall be by the use of repair material conforming to Federal Specification 0-6-93, stick form.
- Sole plates and bevelled plates are incidental keel VI Prestressed Concrete Girders.
- For Bearing Type location, see Bridge Deck Framing Plan, Sheet 9-5.

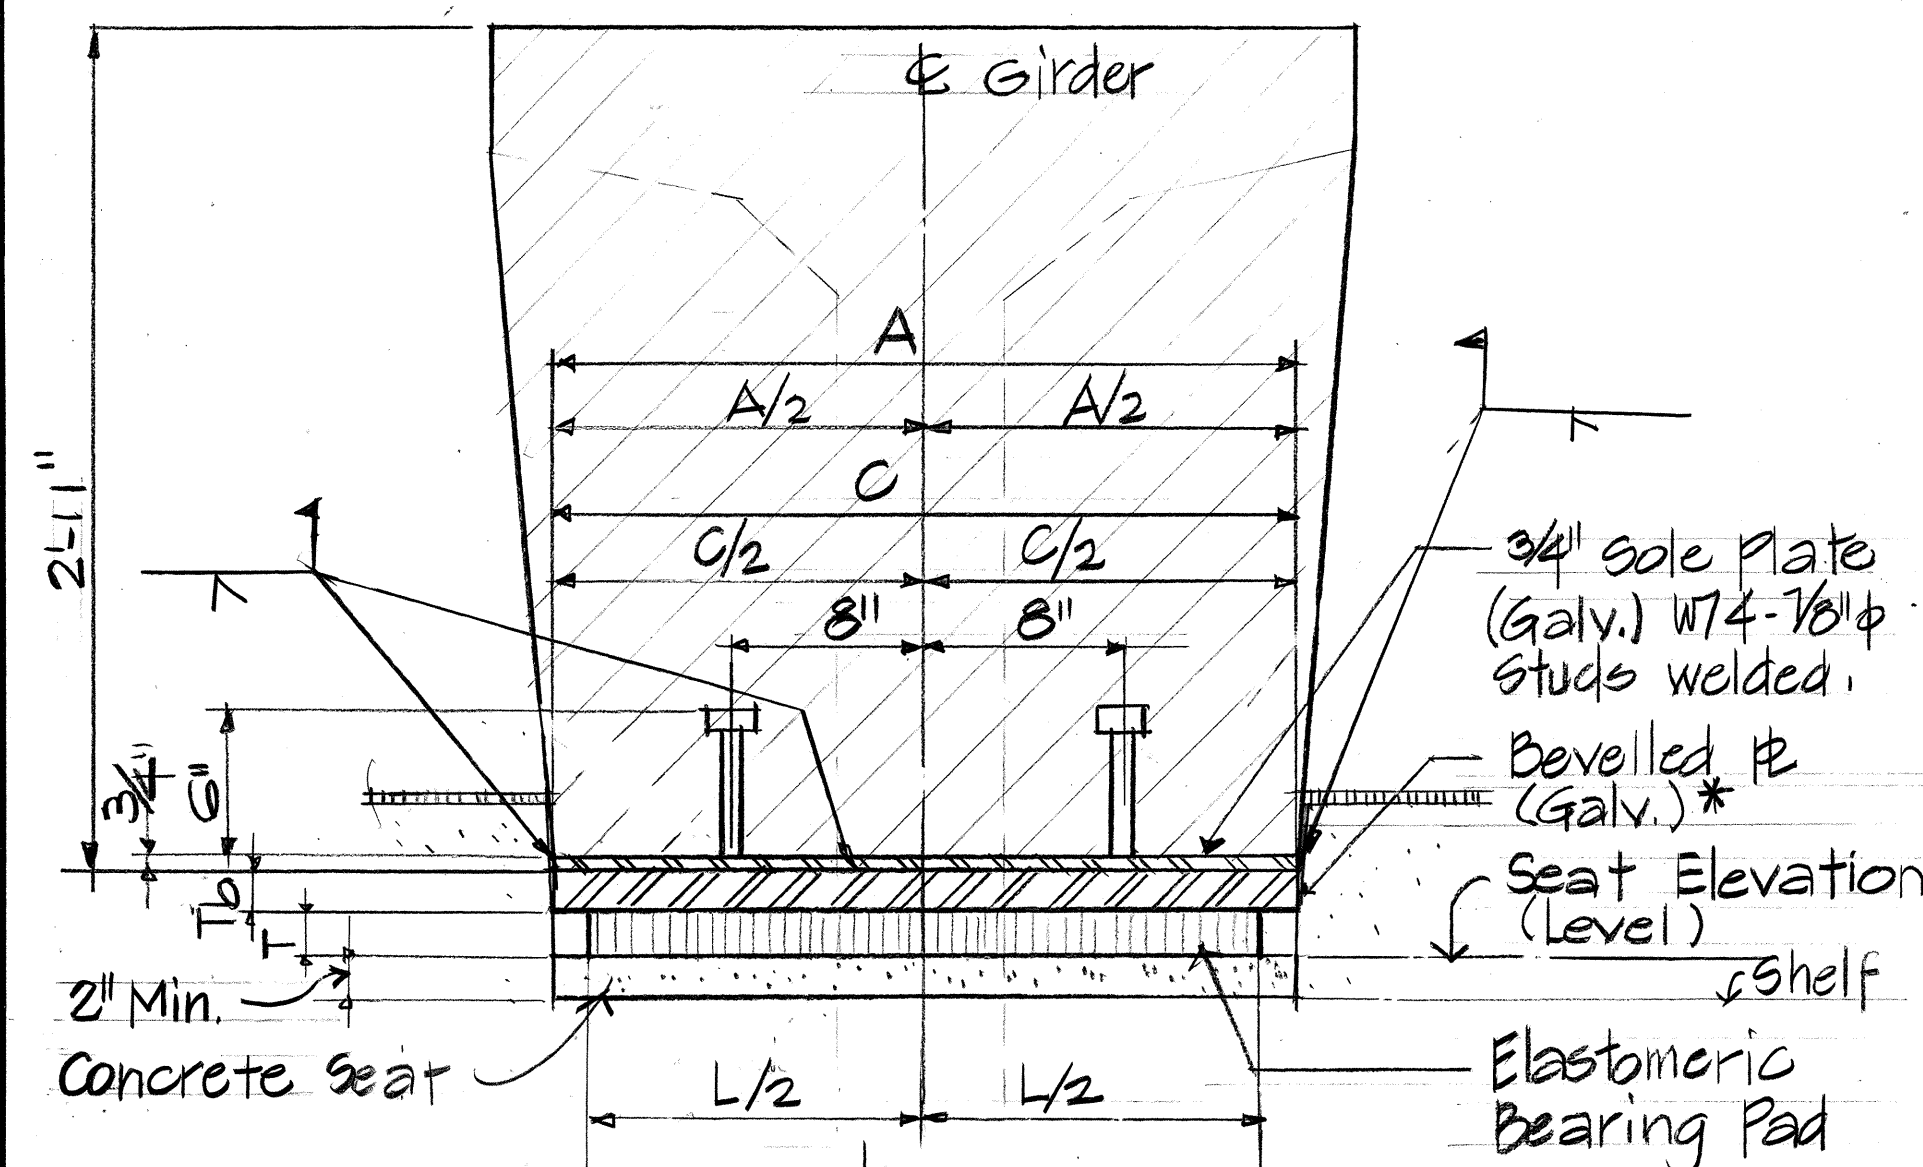


* No bevelled plate required for Bearing Type IV.

CONDITION AT PIER
BEARING - SECTION A
Scale: 1/2" = 1'-0"

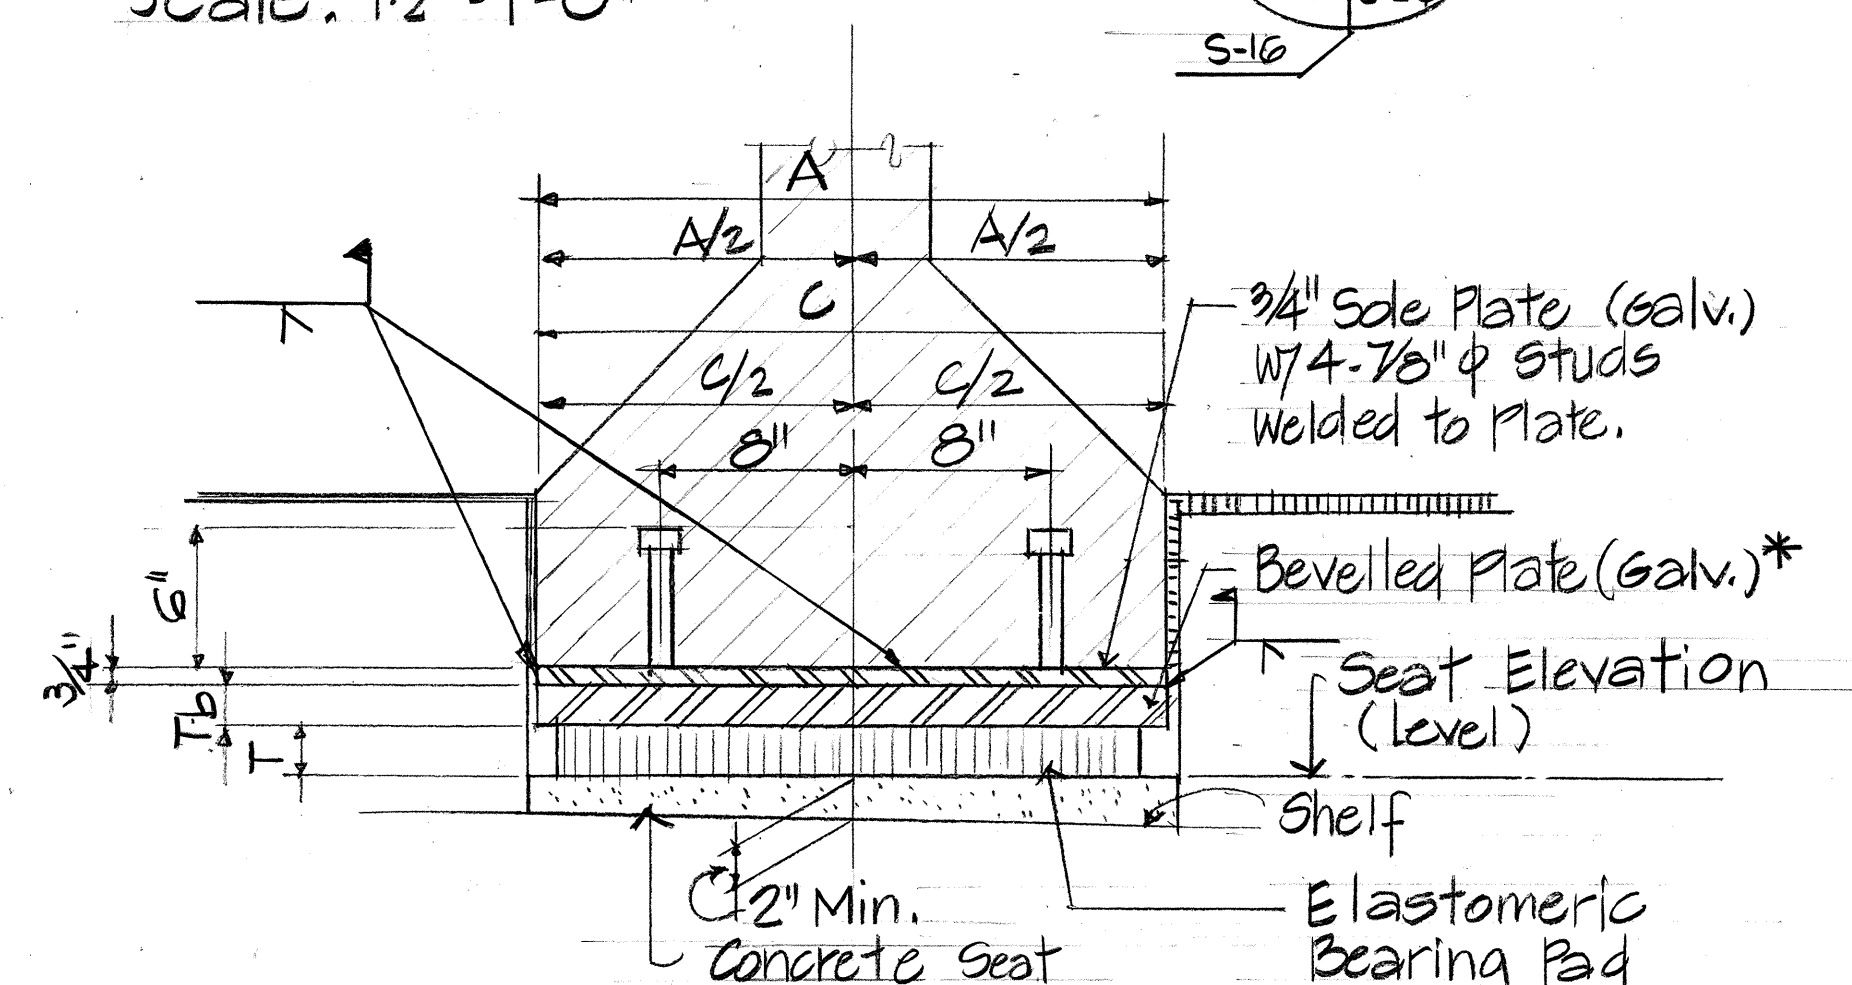


* No bevelled plate required for Bearing Type IV.

CONDITION AT ABUTMENT
BEARING - SECTION B
Scale: 1/2" = 1'-0"

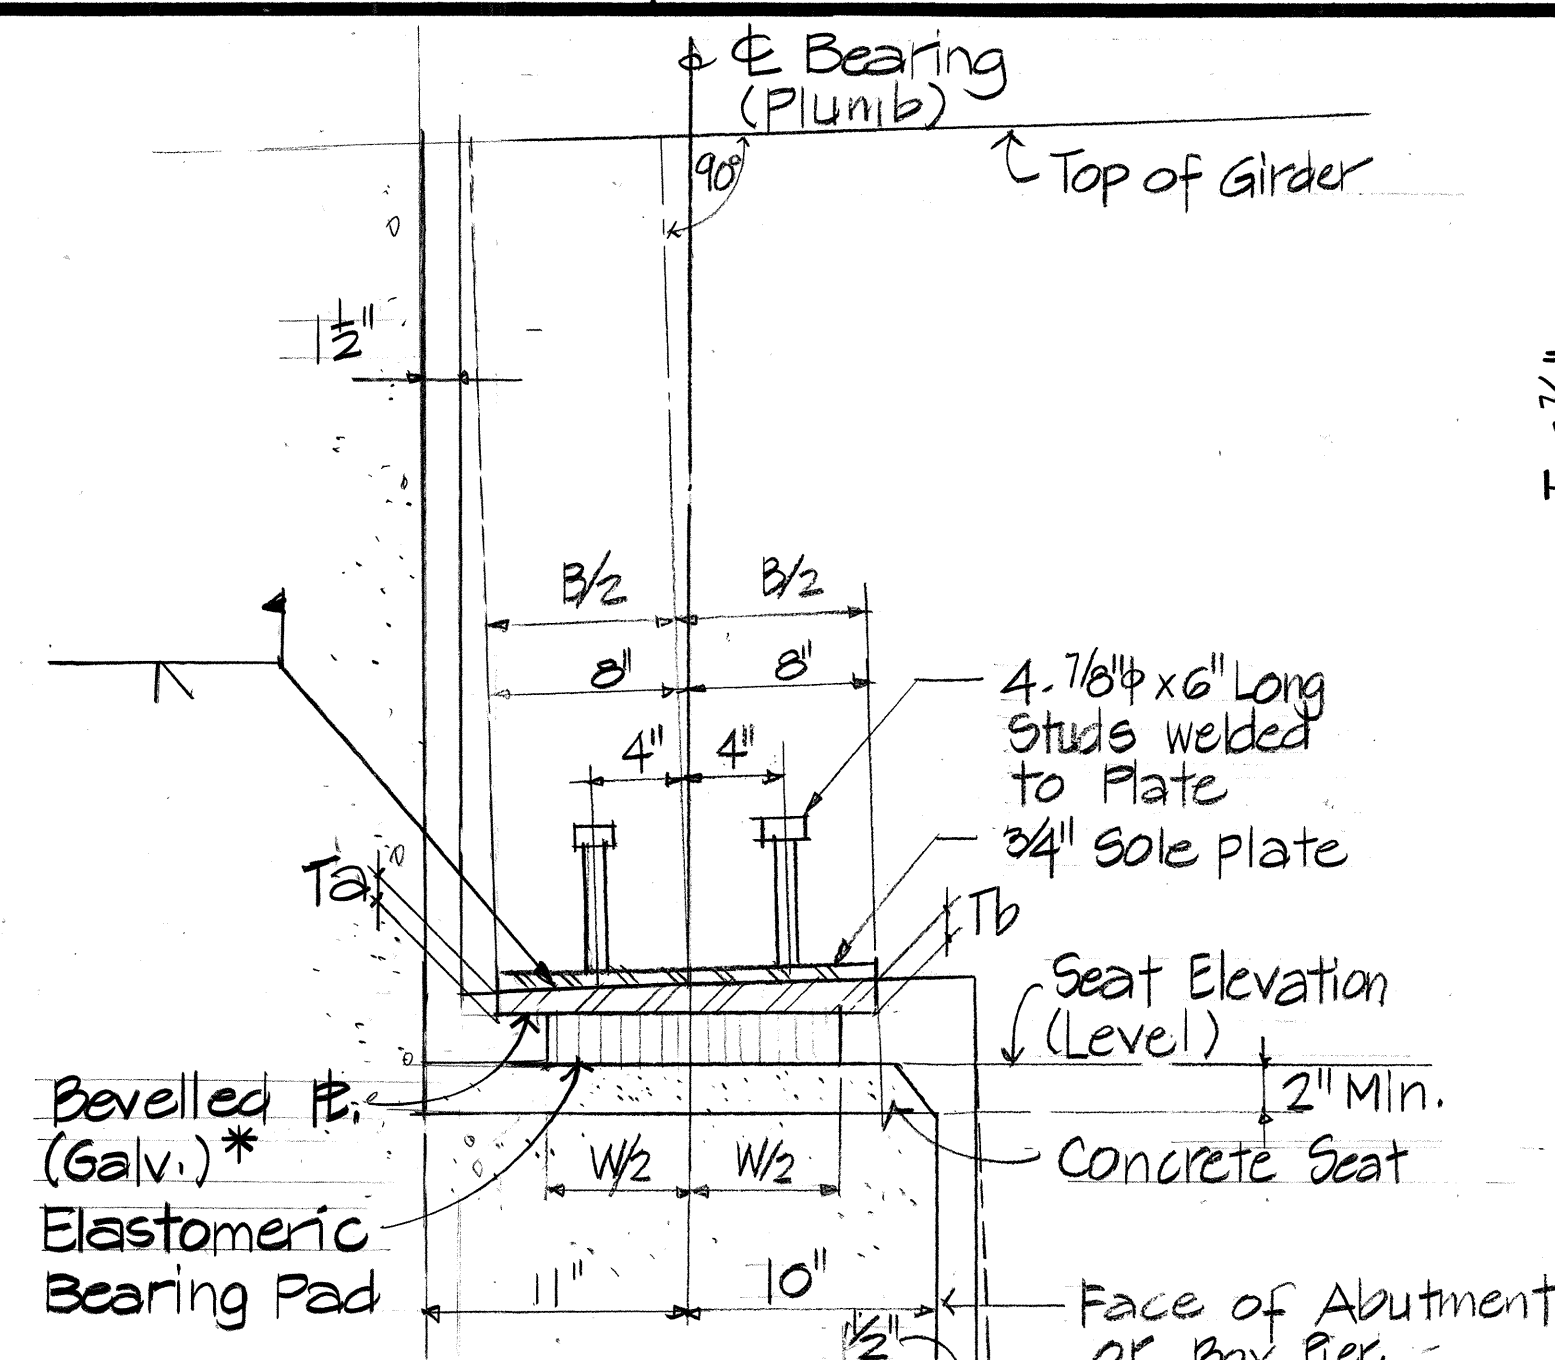


* No bevelled plate required for Bearing Type IV.

SECTION C
Scale: 1/2" = 1'-0"

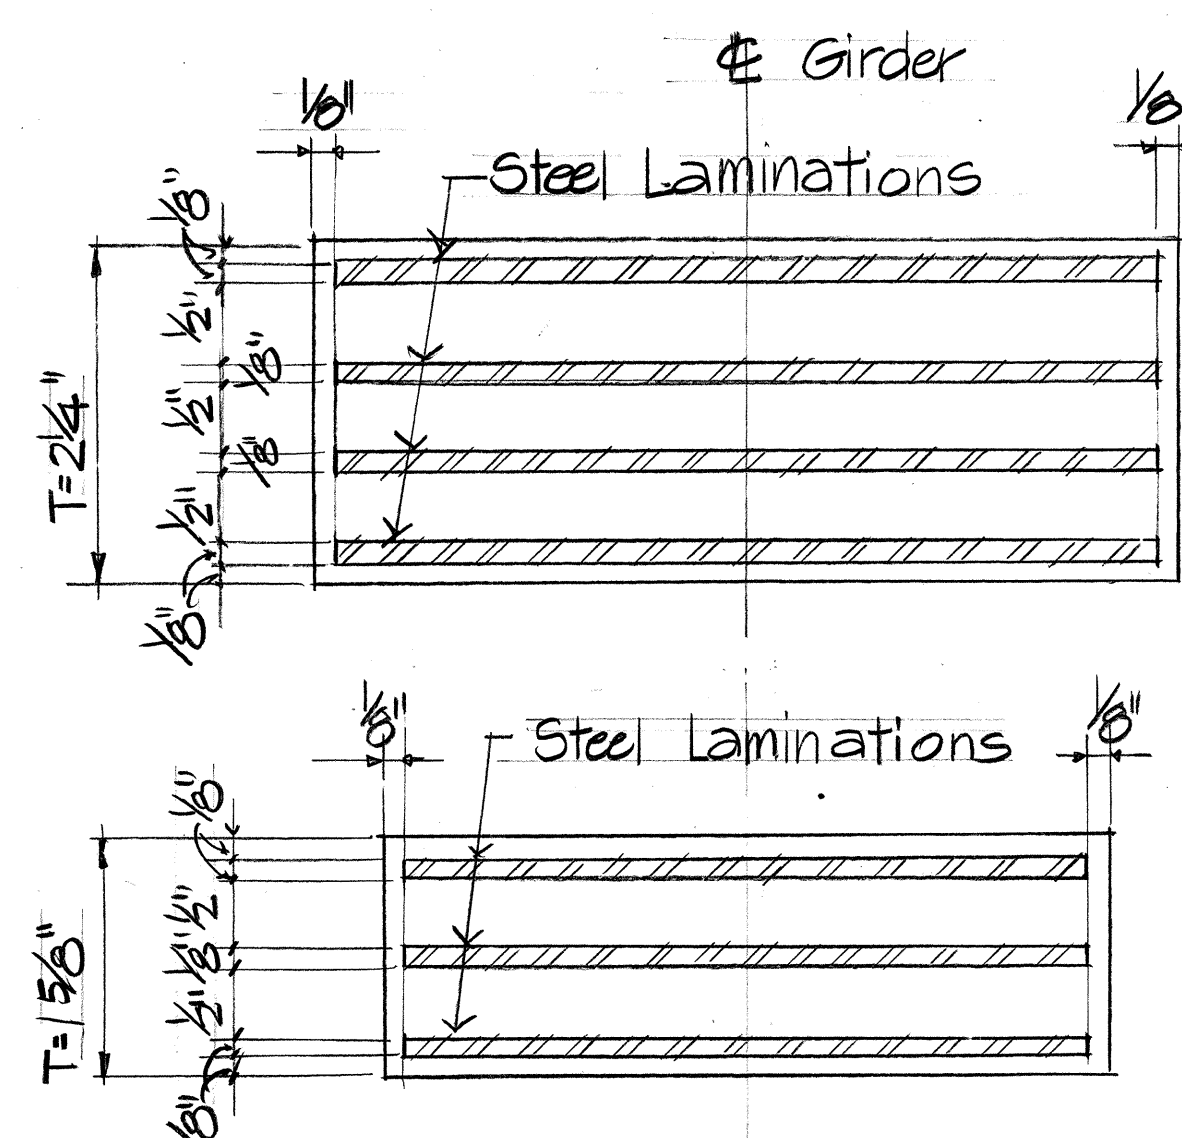

Steel Laminated Elastomeric
Bearing Pad

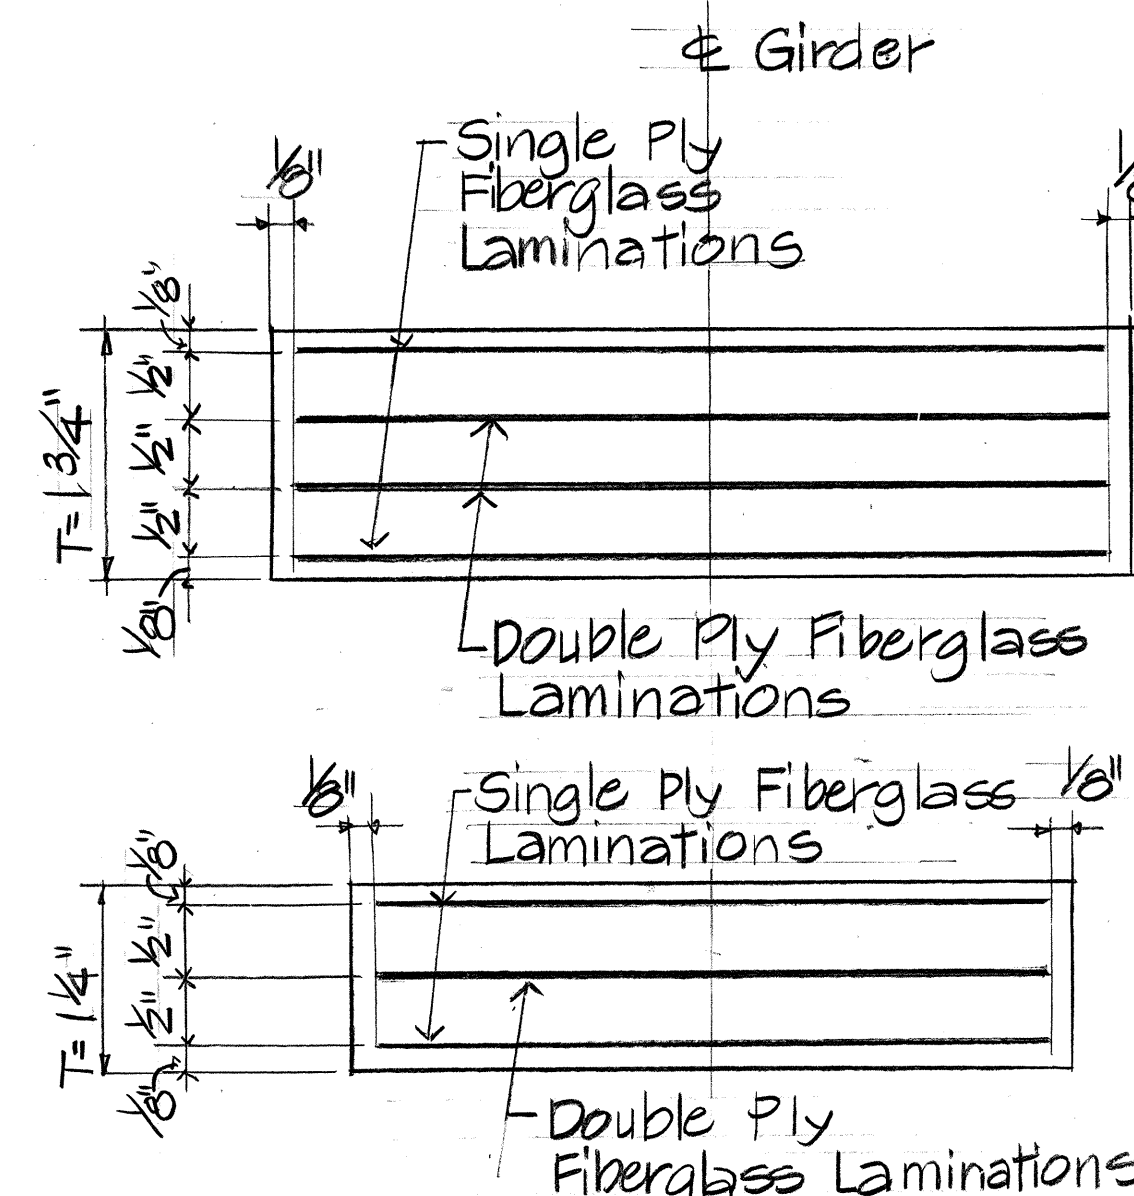

Fiberglass Laminated
Elastomeric Bearing Pad.


ELASTOMERIC BEARING PADS
N.T.S.

Elastomeric Bearing Pads shall have a Durometer Hardness of 60 $\pm$ 5. Elastomeric Bearing Pads shall be considered incidental to concrete in bridge.

All Girder Seat Elevations are based on steel laminated bearing pads. Should the contractor elect to use fiberglass laminated bearing pads, he shall insure that the fiberglass laminated bearing pads comply with the drawings and special provisions. The contractor shall also revise the girder seat elevations to reflect the thickness of the fiberglass laminated bearing pads. All revisions shall be approved by the engineer.

Bearing Type	Bevelled Plate				Sole Plate, 3/4" Thk.	Elastomeric Bearing Pad		
	A	B	Ta	Tb		L	W	T
I	26"	16"	0.98"	1.52"	26"	24"	10"	2 1/4"
II	31"	16"	0.98"	1.52"	31"	28"	9"	2 1/4"
III	31"	16"	1.11"	1.39"	31"	28"	12"	2 7/8"
IV	31"	16"	N/A	N/A	31"	28"	12"	2 7/8"
V	31"	16"	1.39"	1.11"	31"	28"	12"	2 7/8"
VI	26"	16"	1.50"	1.00"	31"	28"	7"	1 5/8"
VII	26"	16"	1.50"	1.00"	26"	24"	8"	1 5/8"


Ta is the plate thickness at Down Station End of the Bevelled Plate.
Tb is the plate thickness at Up Station End of the Bevelled Plate.

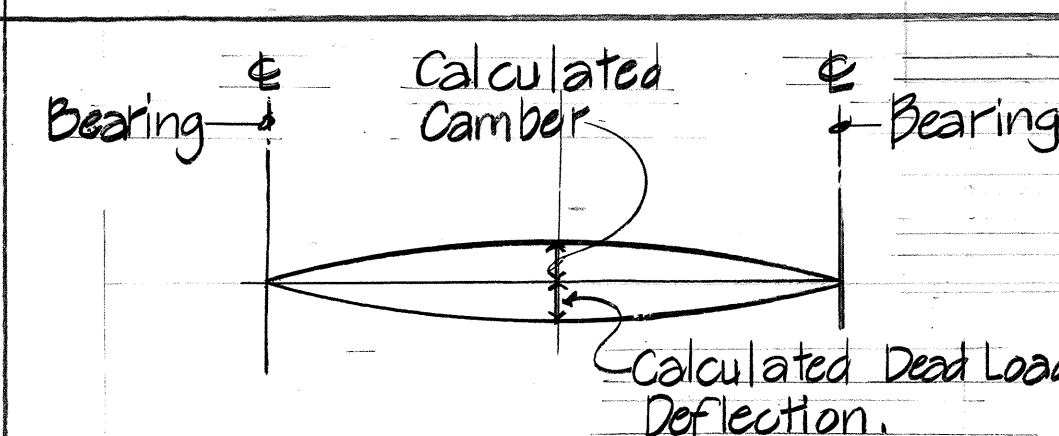

Calculated Dead Load Deflection accounts for the effects of the weight of Deck Slab, Haunches, and Diaphragms.


CAMBER DIAGRAM

No Scale

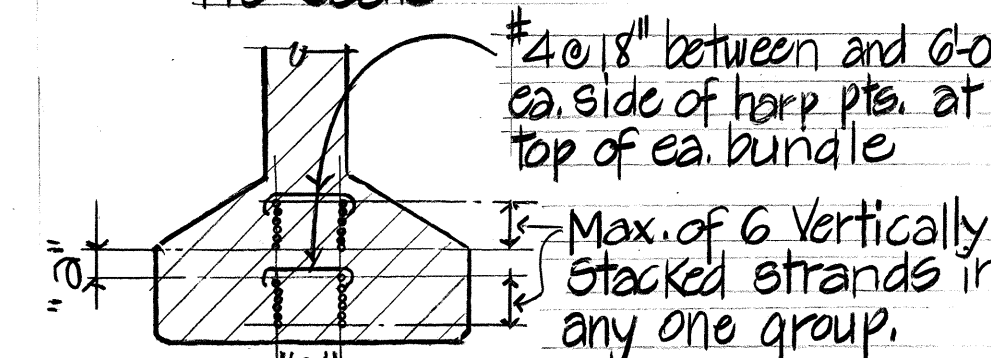

CASE II

- Strands may be bundled in groups as shown.
- The minimum distance "a" between groups or individual strands is 2" for 1/2" ϕ strands.
- "a" is measured between centers of adjacent strands.

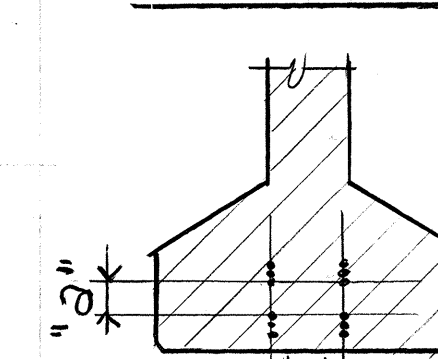


CASE I

BUNDLING PRESTRESSING REINFORCEMENT

DETAIL

No scale:

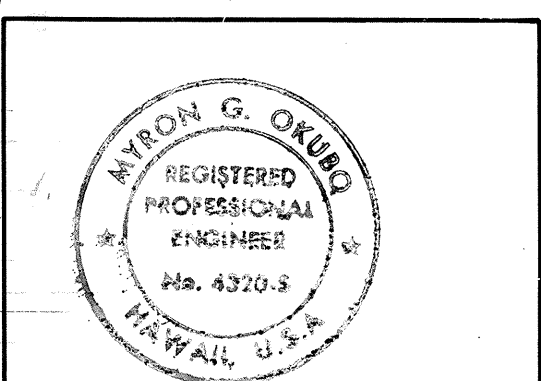

THIS WORK WAS PREPARED BY ME OR UNDER MY SUPERVISION

Myron Okubo

STATE OF HAWAII
DEPARTMENT OF TRANSPORTATION
HIGHWAYS DIVISION

GIRDER AND BEARING DETAILS


SAND ISLAND ROAD WIDENING
2ND BRIDGE AND APPROACHES
FEDERAL AID PROJECT NO. F-064-1(2)

SCALE: AS NOTED. DATE: JUN, 1986


SHEET NO. 5-20 OF 30 SHEETS

DATE REVISION


FED. ROAD DIST. NO.	STATE	FED. AID PROJ. NO.	FISCAL YEAR	SHEET NO.	TOTAL SHEETS
HAWAII	HAW.	F-064-1(2)	1987	123	151

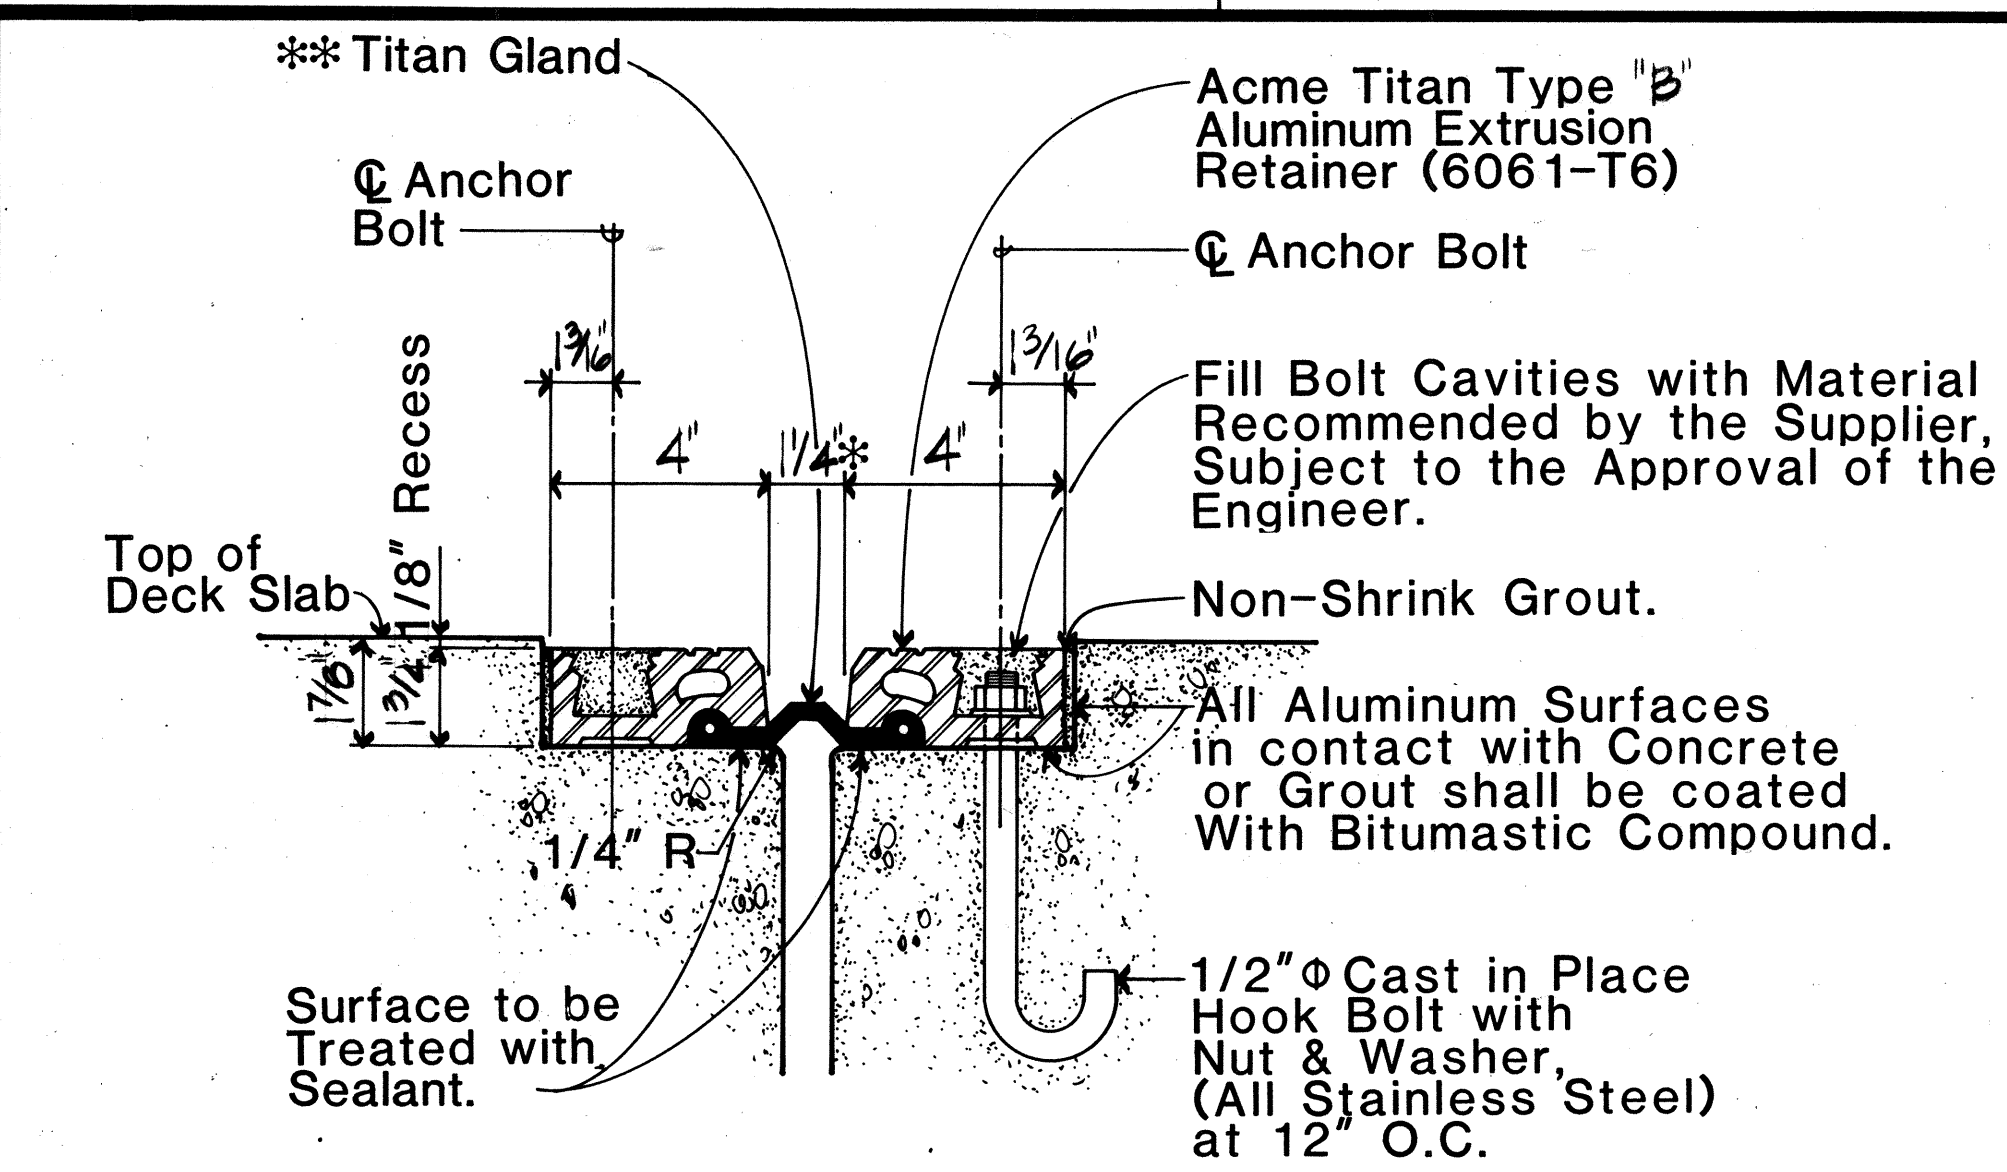


ACME TITAN TYPE "B"
 Not to scale
 (Manufacturer: Acme Highway Products Co.)

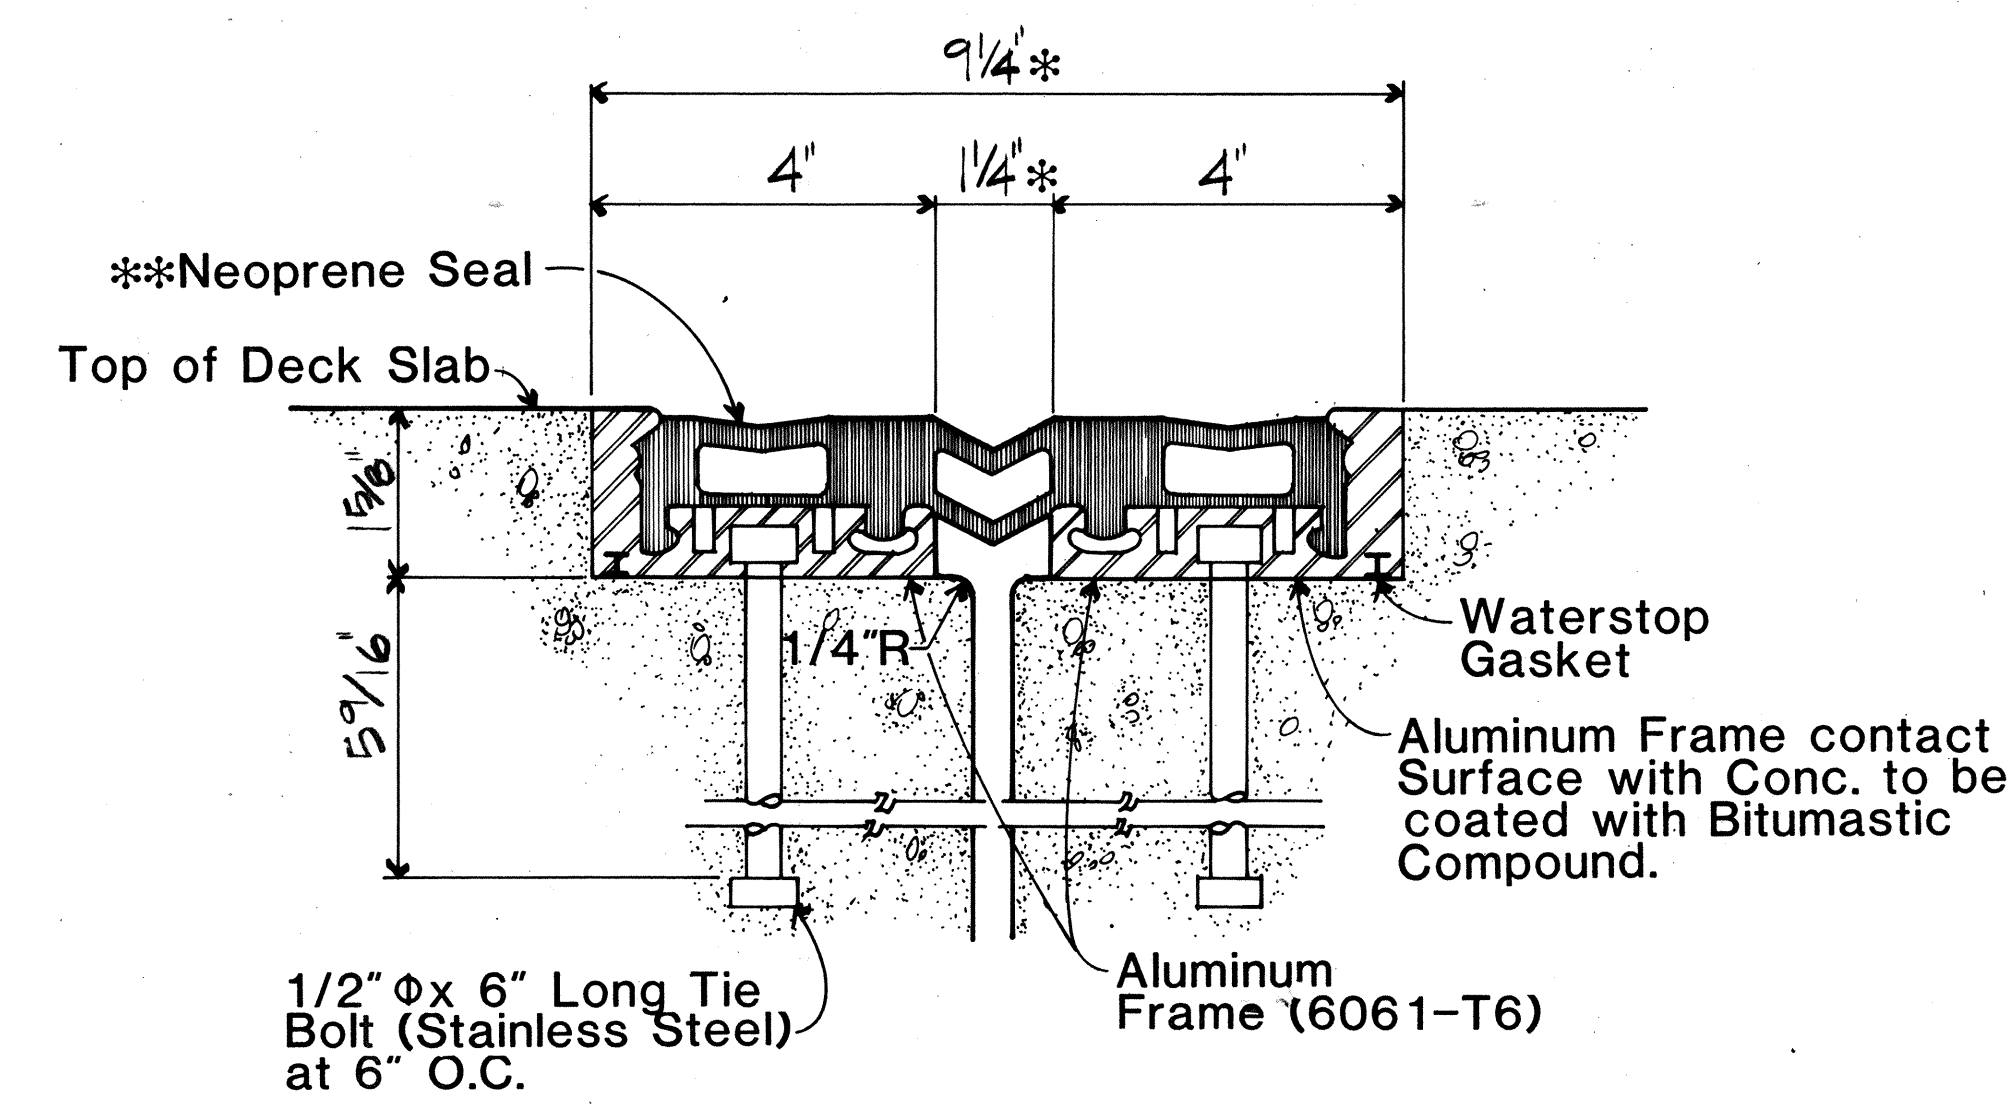


DELASTIFLEX TYPE SM 200
 Not to scale
 (Manufacturer: D.S. Brown & Co.)

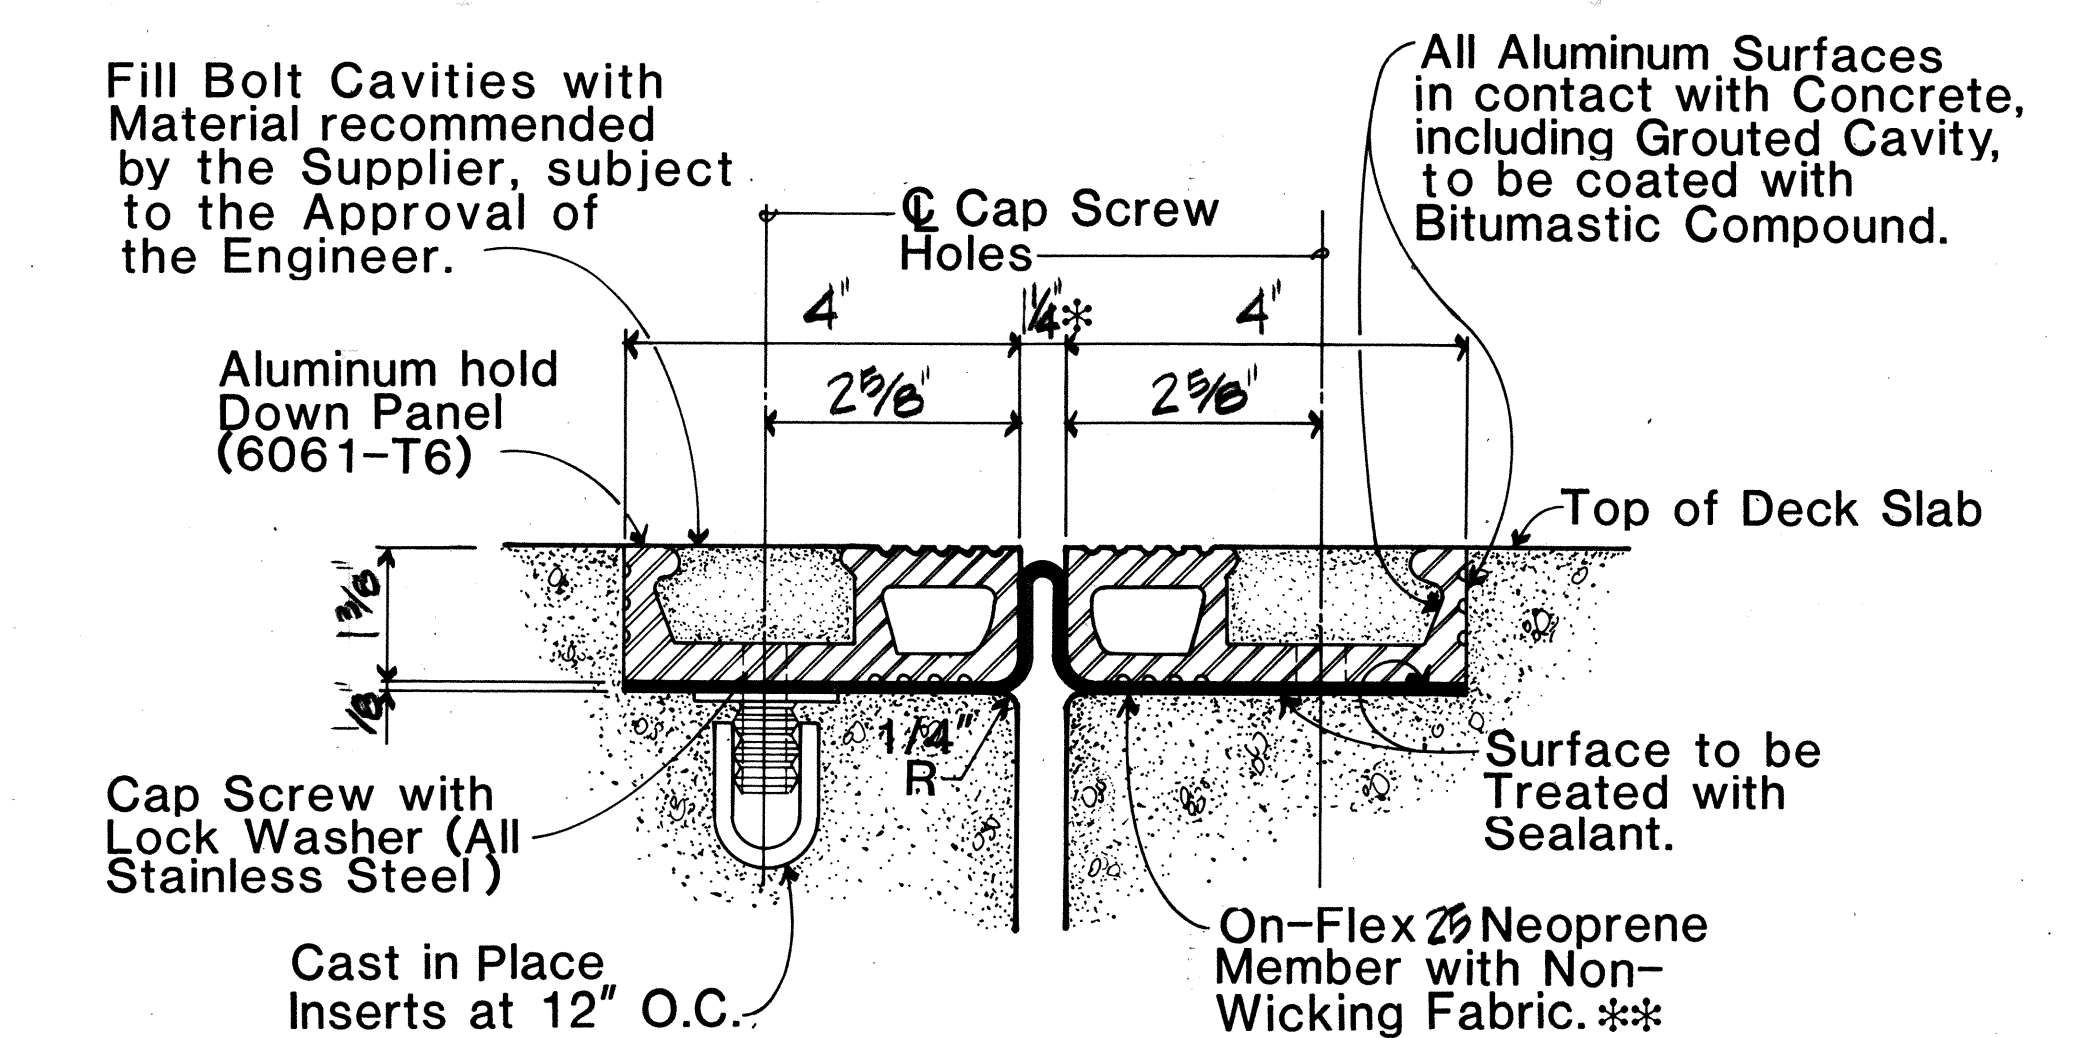


ON-FLEX 25
 Not to scale
 (Manufacturer: Structural Accessories Inc.)

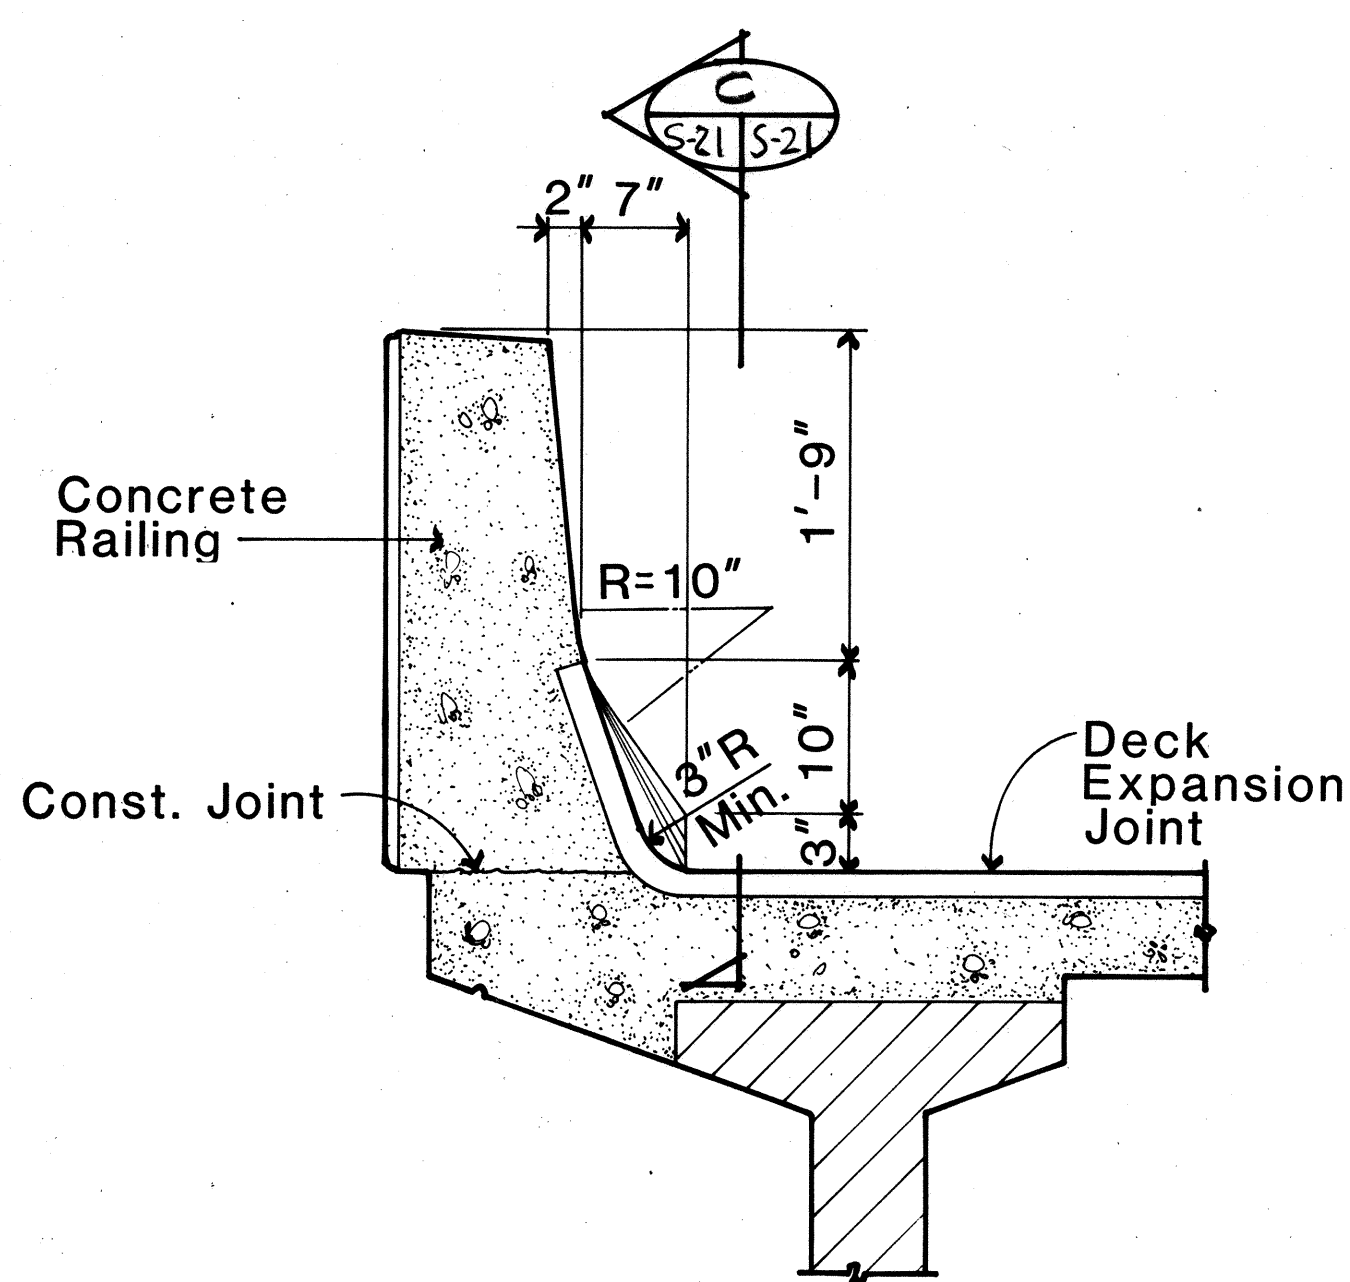


TYPICAL DETAIL
 Scale: 1" = 1'-0"

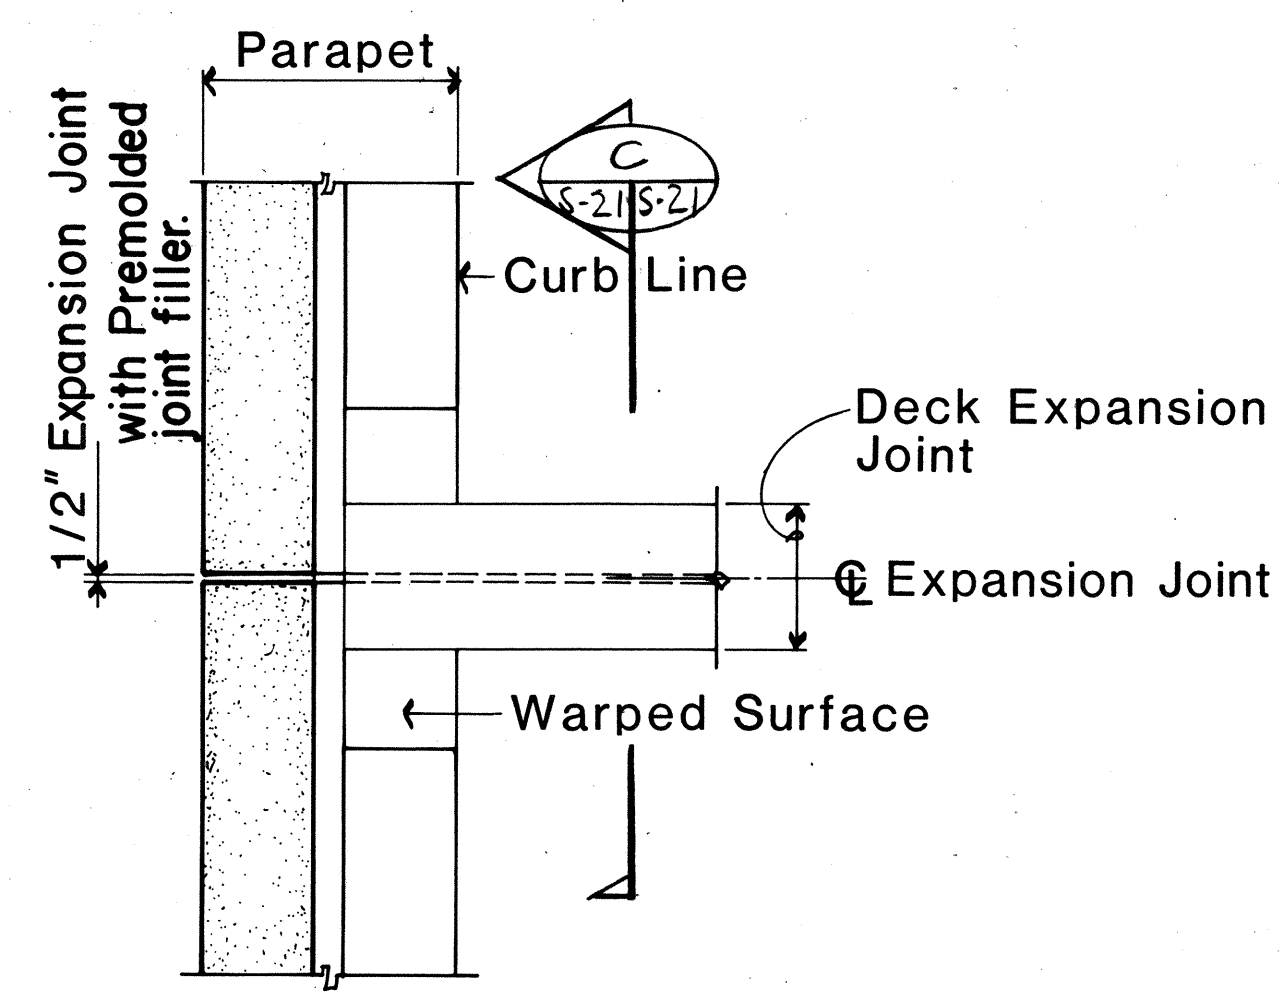

PLAN
 Scale: 1" = 1'-0"

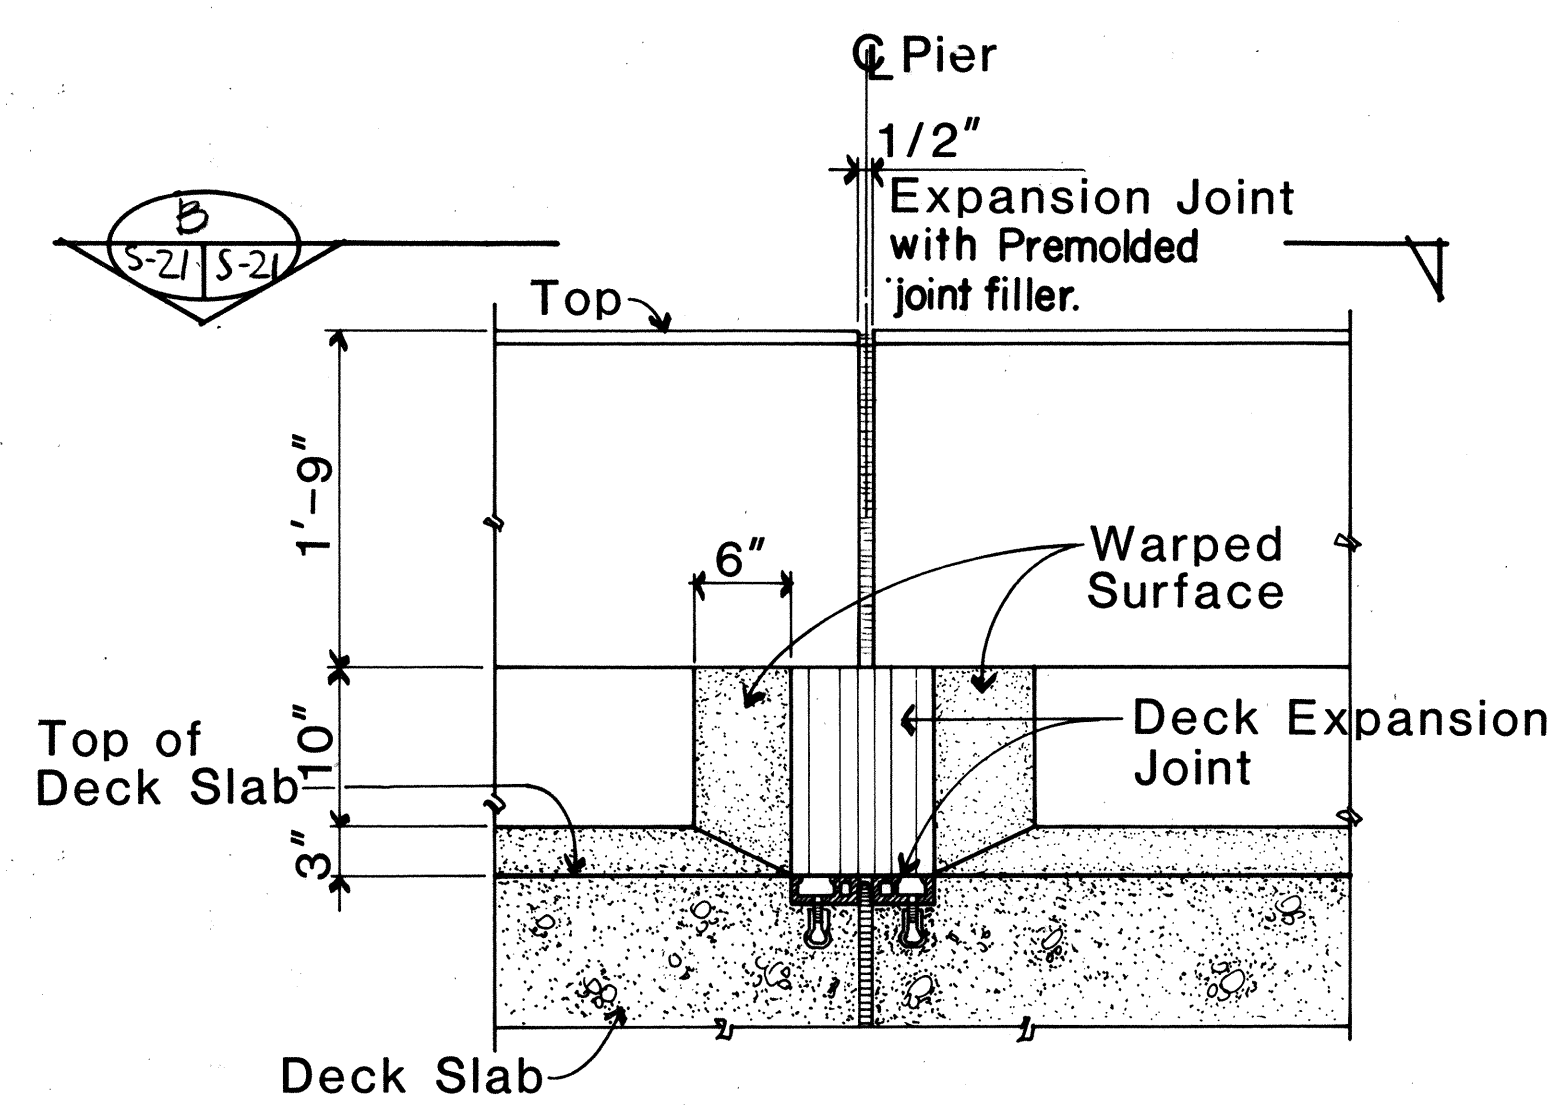

SECTION
 Scale: 1" = 1'-0"

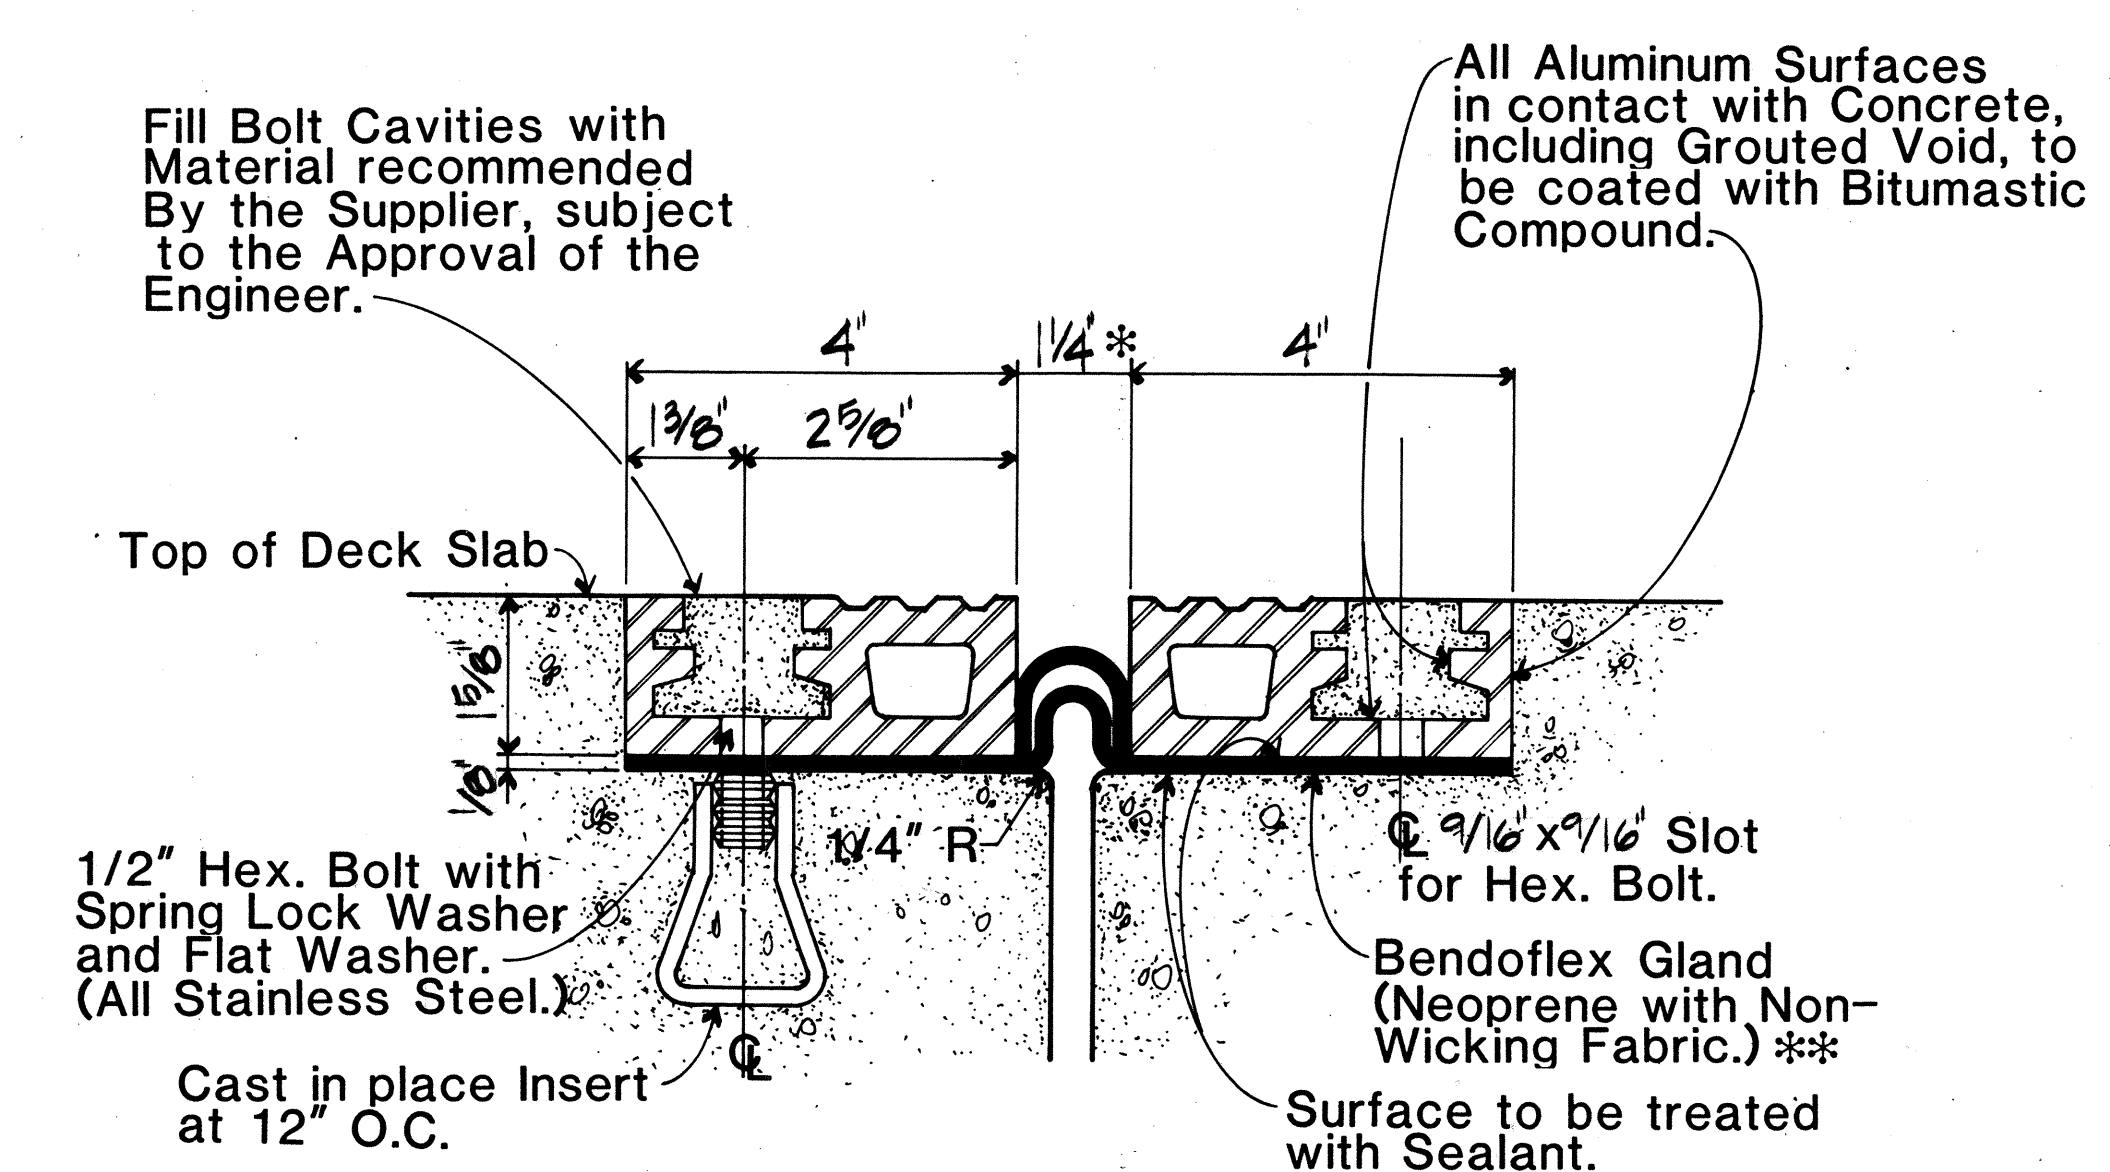


WABO BENDOFLEX 250
 Not to scale
 (Manufacturer: Watson Bowman Assoc. Inc.)


DECK EXPANSION JOINT NOTES

- Four Alternate Deck Expansion Joint Systems are shown. Contractor has the Option of selecting any One of the Systems. The Contractor shall submit Detailed Shop Drawings of the selected Joint to the Engineer for Approval.
- The Contractor also has the Option of using an Alternate Expansion Joint System provided it complies with the Plans and Specifications.


*Installation Width at 75° F.
 **Seal Gland or Membrane shall be continuous across the Full Width of the Structure.

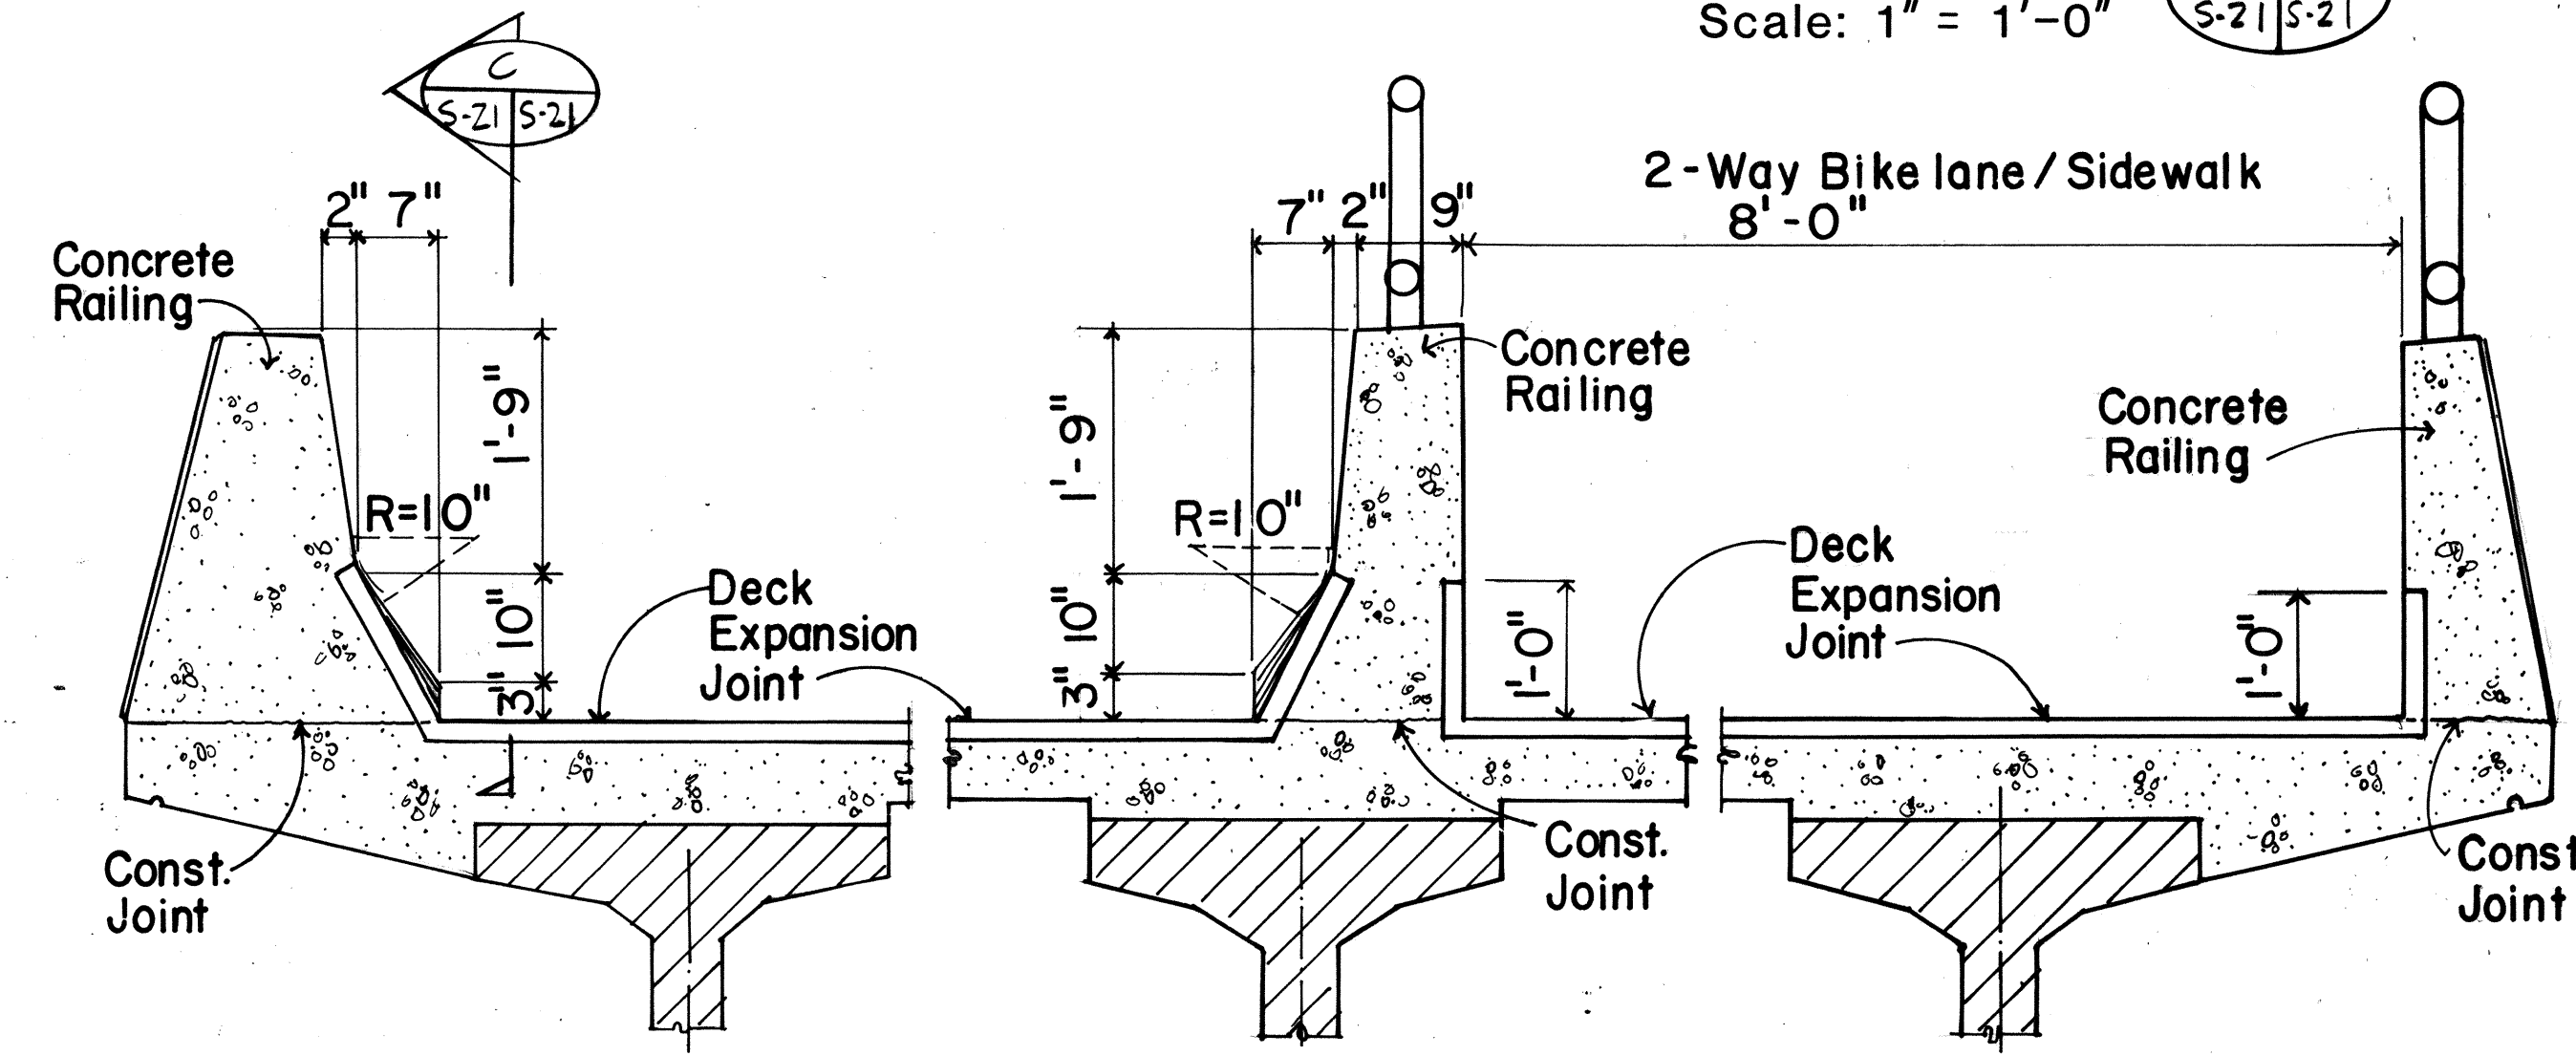

ALTERNATE DETAIL
 Scale: 3/4" = 1'-0"

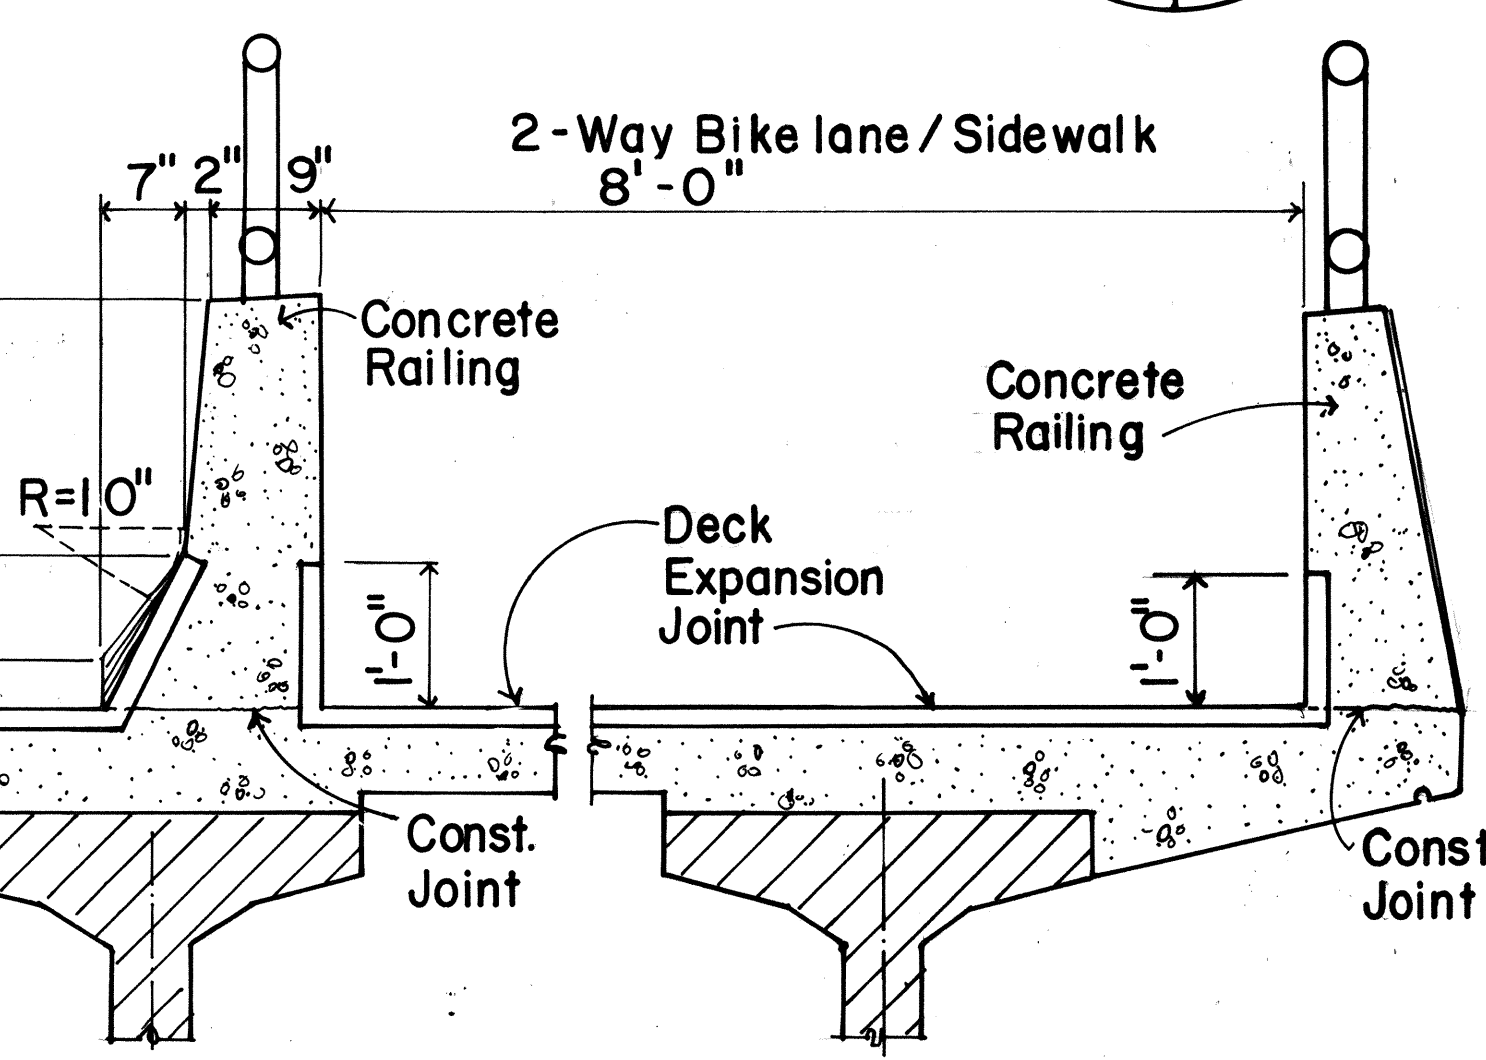

TYPICAL DETAILS
 Scale: 3/4" = 1'-0"

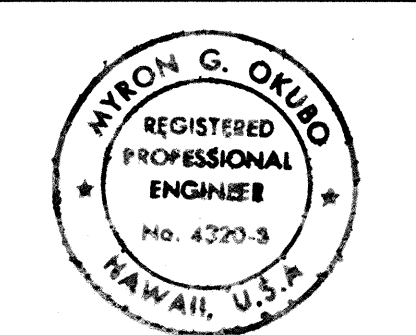


THIS WORK WAS PREPARED BY
 ME OR UNDER MY SUPERVISION
Myron Okubo

STATE OF HAWAII
 DEPARTMENT OF TRANSPORTATION
 HIGHWAYS DIVISION
**DECK EXPANSION
 JOINT DETAILS**
 SAND ISLAND ROAD WIDENING
 2ND. BRIDGE AND APPROACHES
 FEDERAL AID PROJECT NO. F-064-1(2)


SCALE: AS NOTED DATE: JUN, 1986
 SHEET No. S-21 OF 30 SHEETS

DATE REVISION


FED. ROAD DIST. NO.	STATE	FED. AID PROJ. NO.	FISCAL YEAR	SHEET NO.	TOTAL SHEETS
HAWAII	HAW.	F-064-(12)	1987	124	151

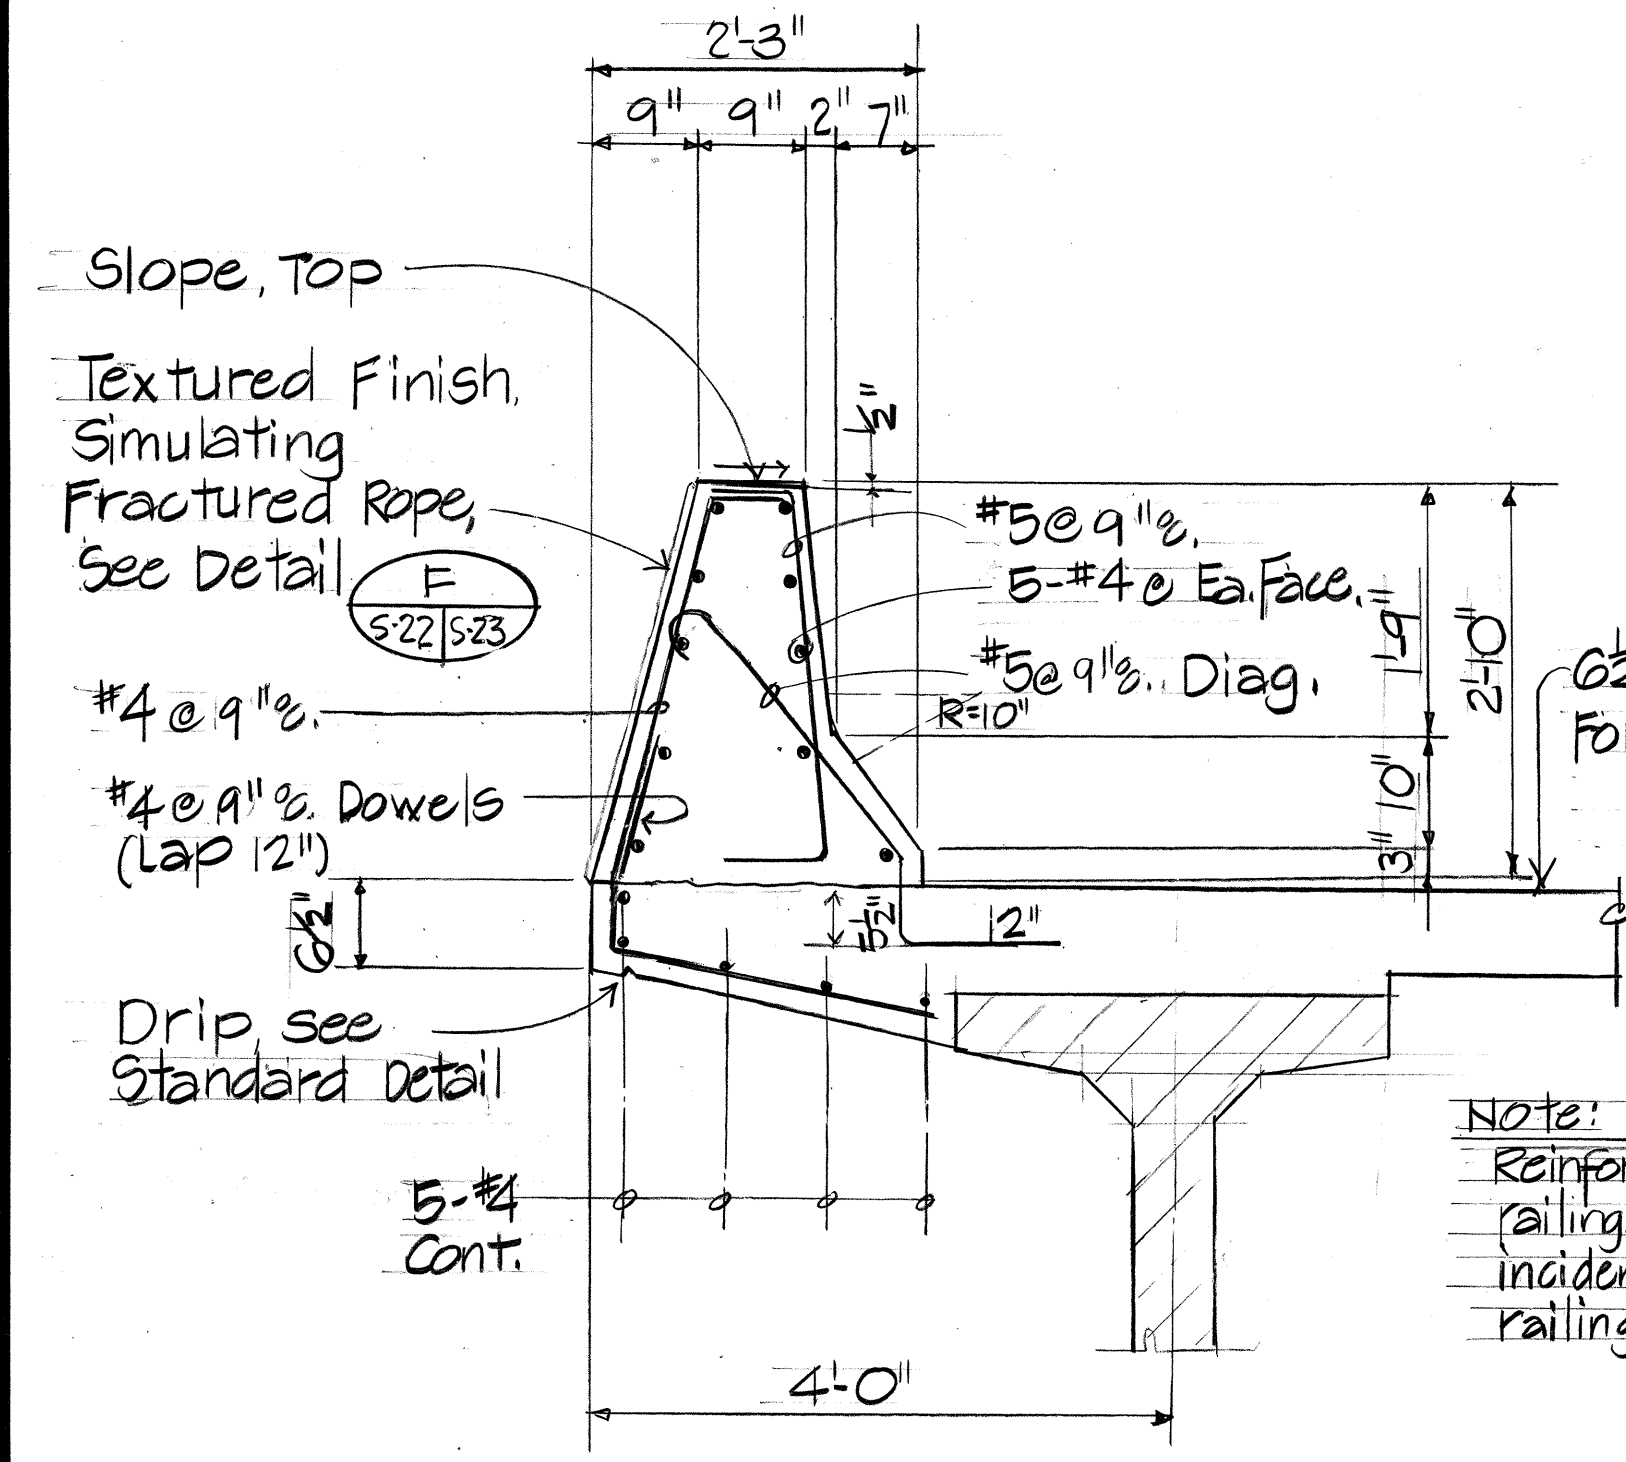


TYPE "A"
CONCRETE RAILING DET. A
Scale: 3/4" = 1'-0"

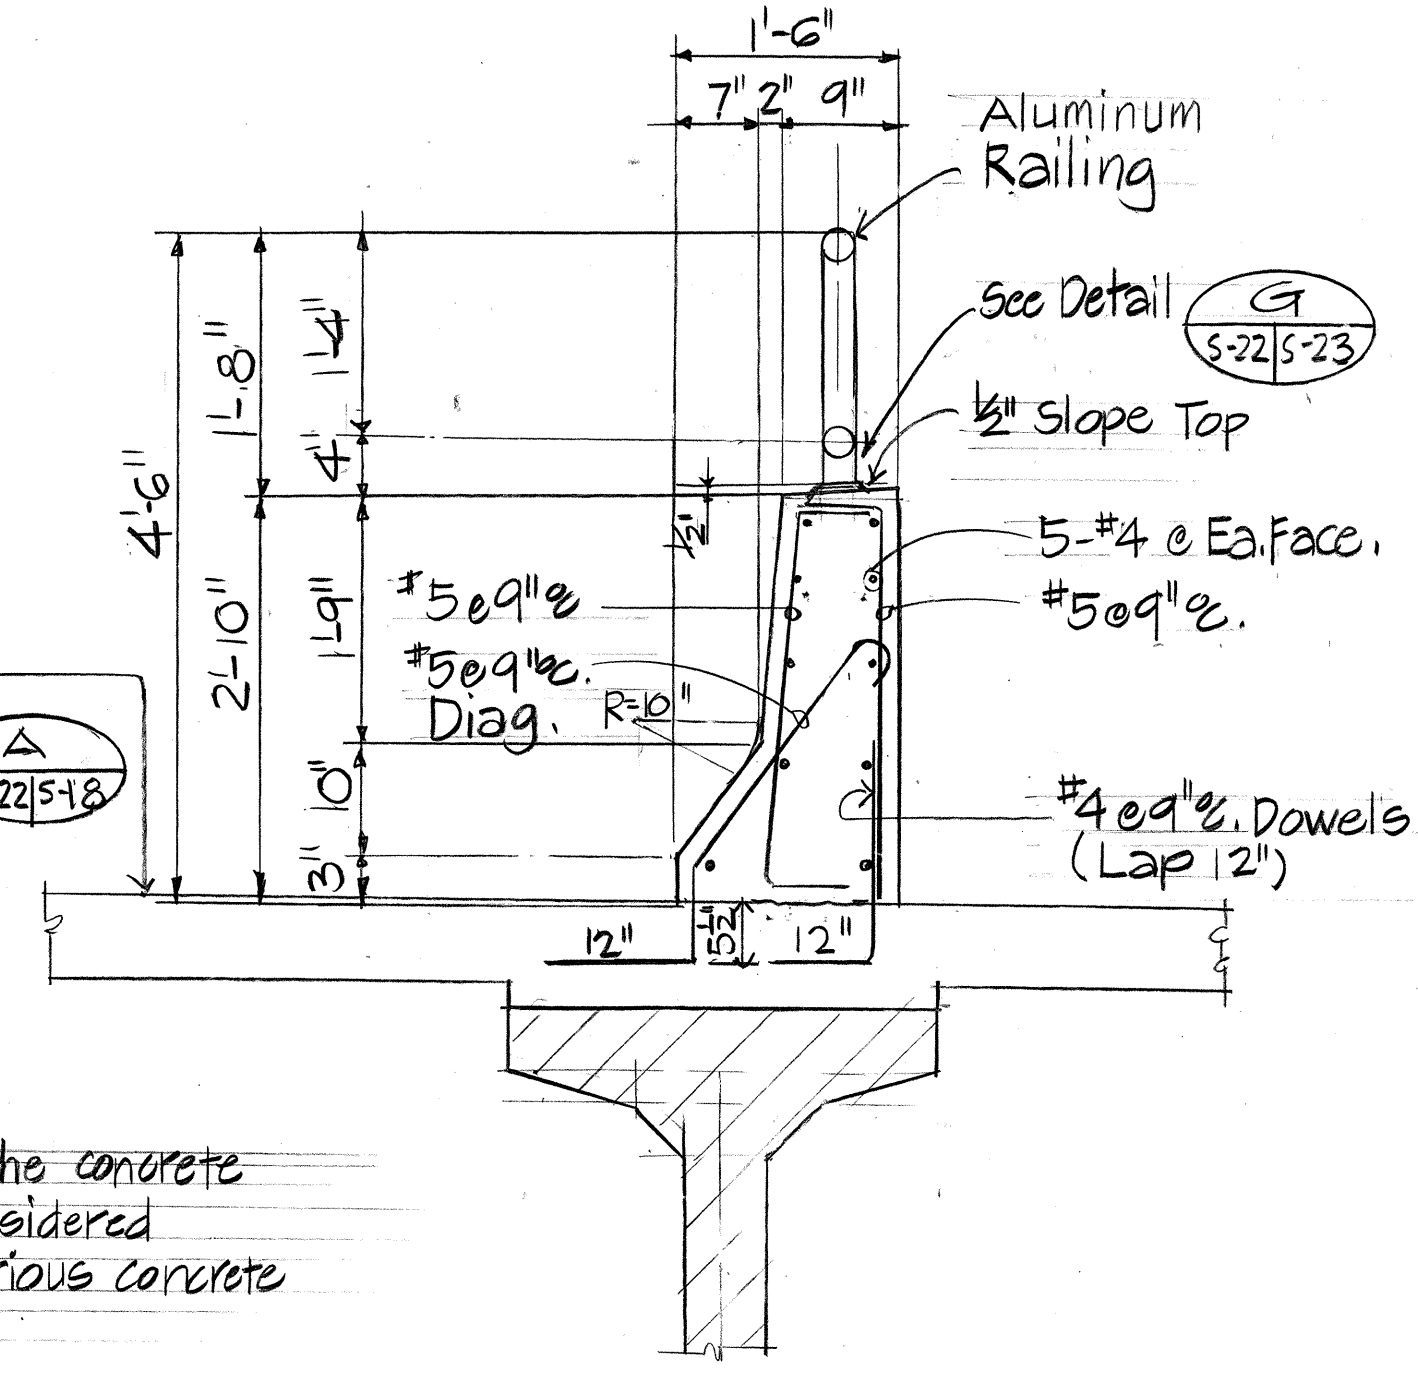


TYPE "B"
CONCRETE RAILING DET. B
Scale: 3/4" = 1'-0"

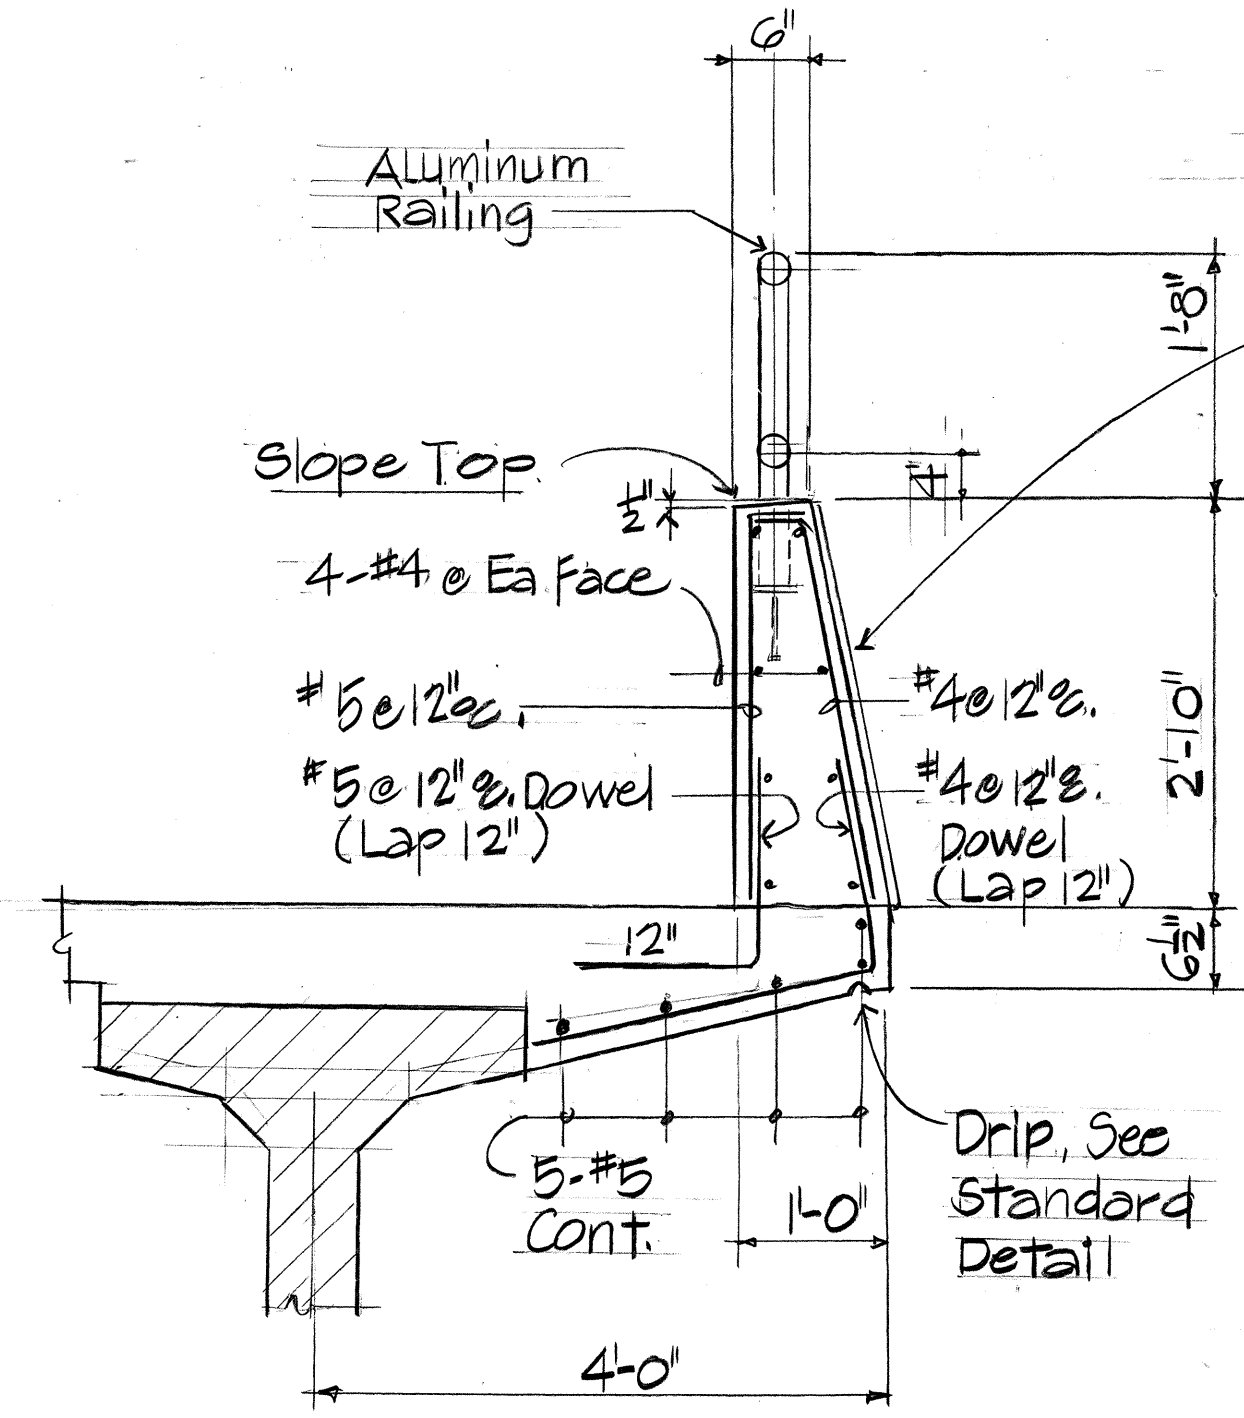


TYPE "C"
CONCRETE RAILING DET. C
Scale: 3/4" = 1'-0"

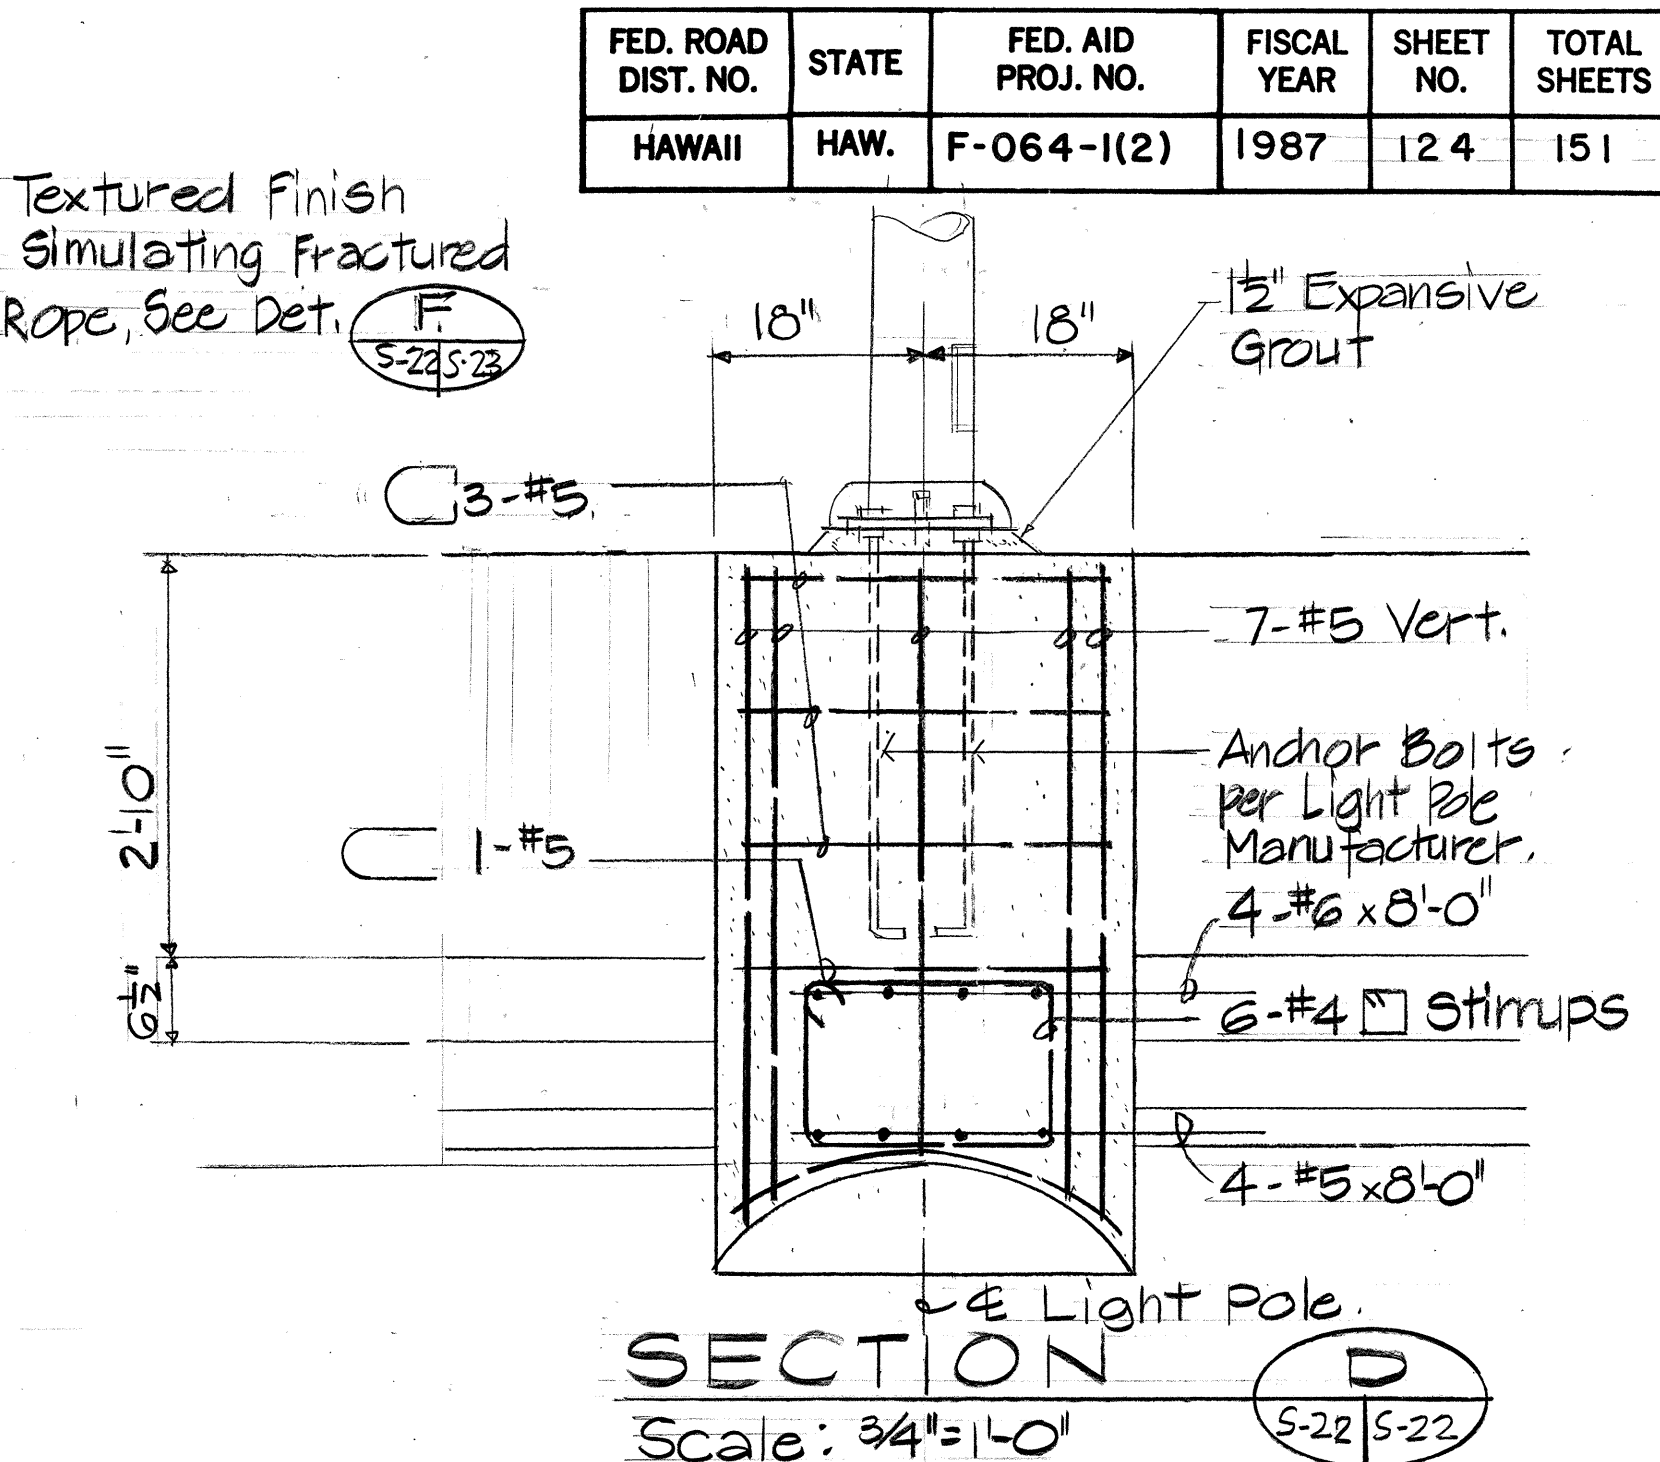


SECTION D
Scale: 3/4" = 1'-0"

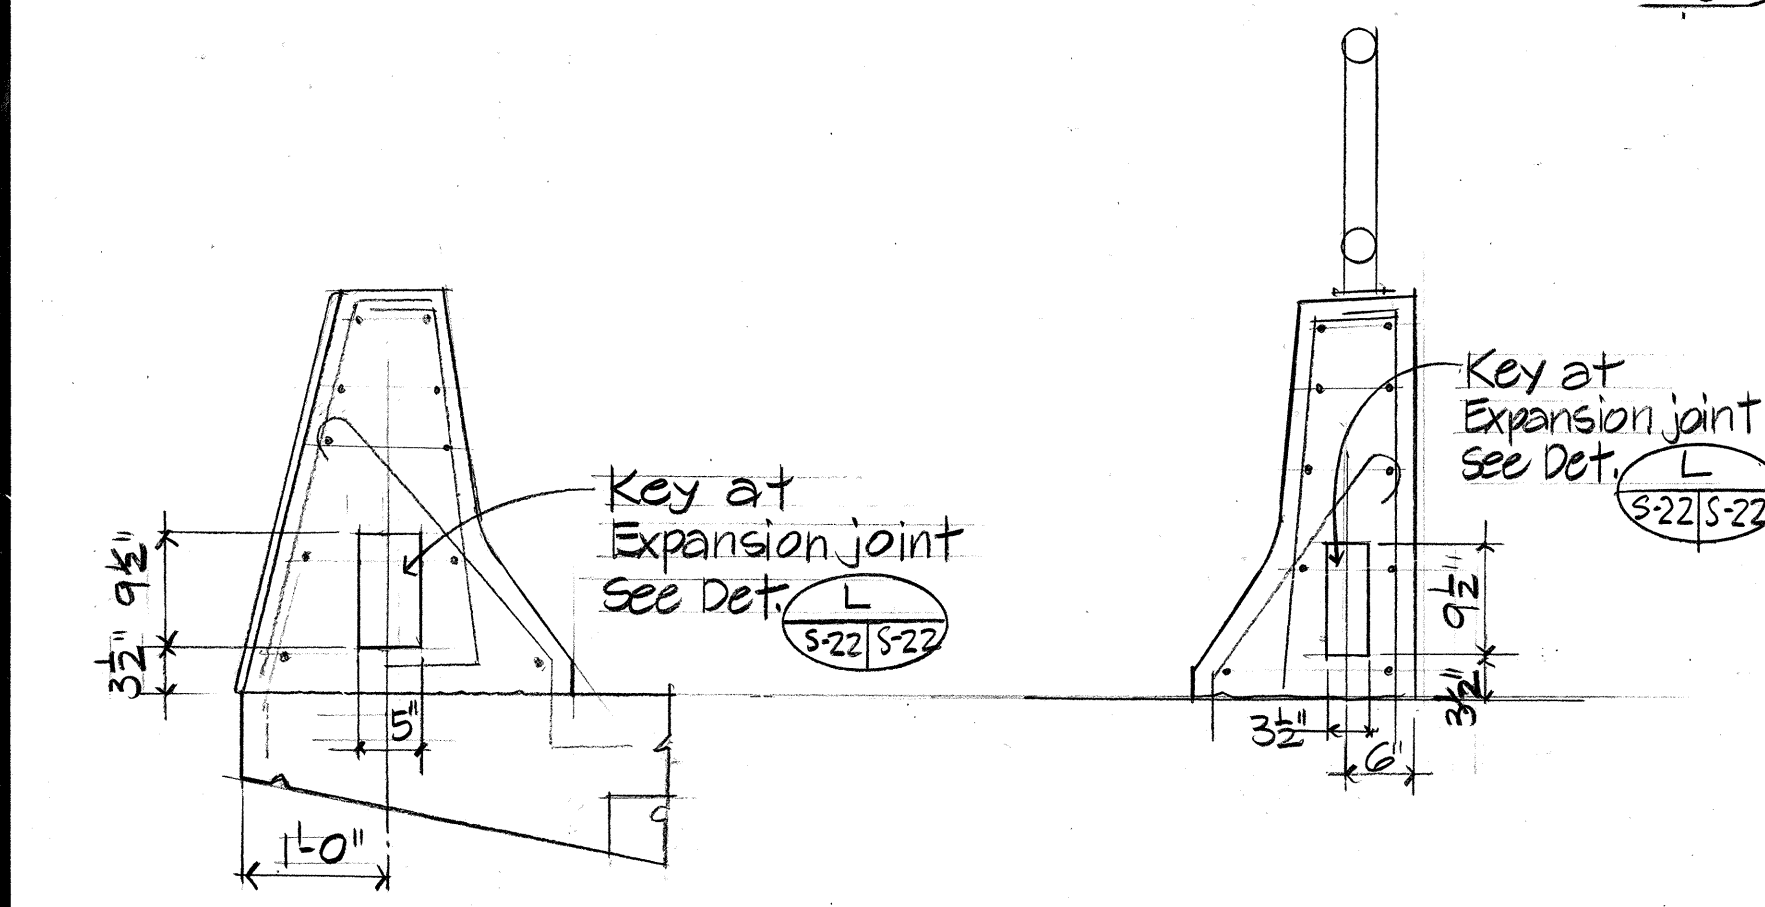


KEY @ TYPE "A"
CONCRETE RAILING DET. H
Scale: 3/4" = 1'-0"

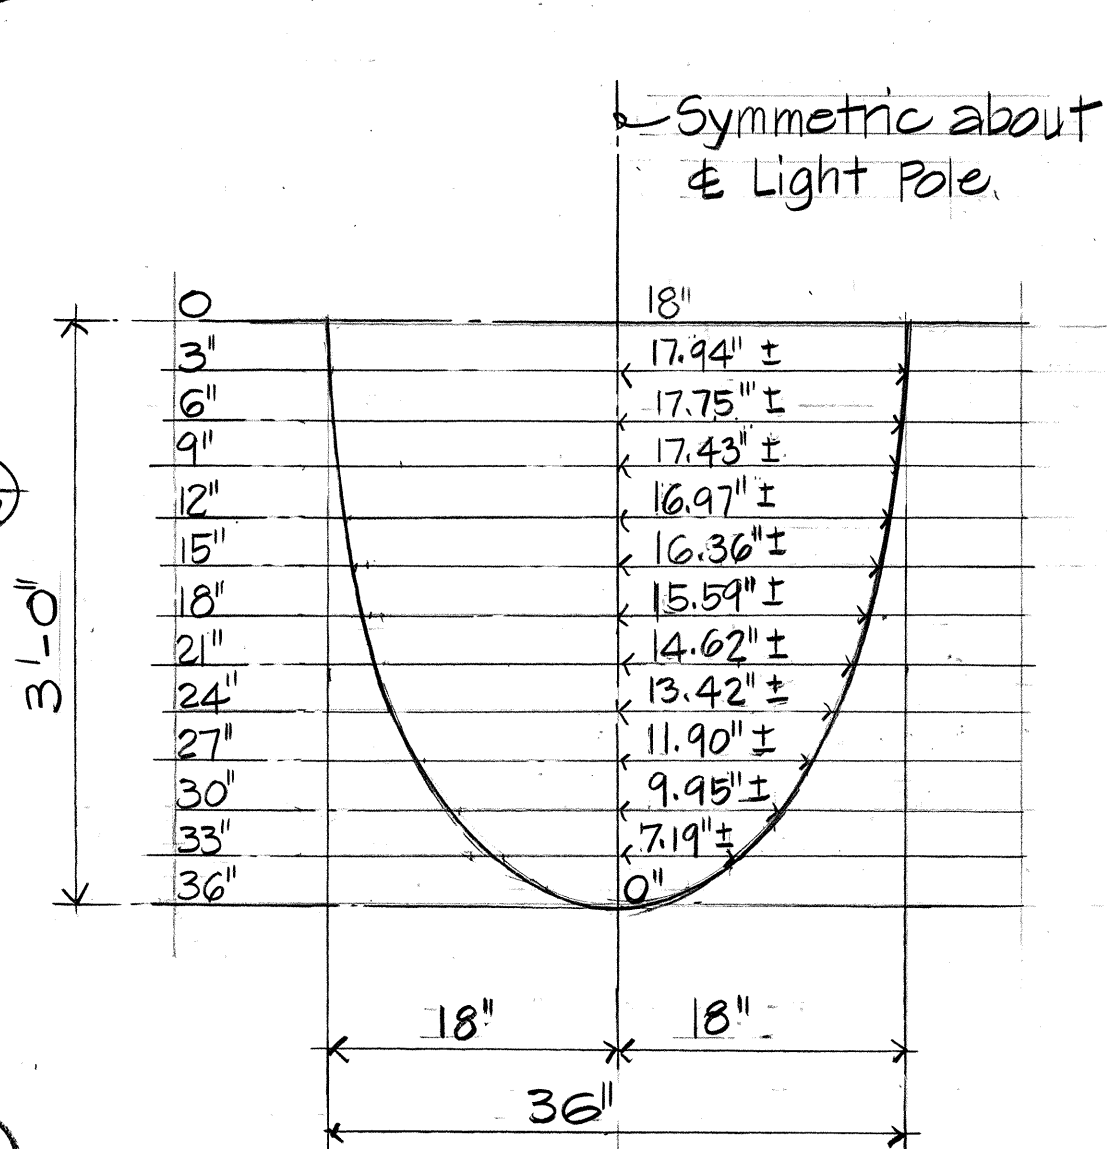


LIGHT POLE CONCRETE SUPPORT SHAPE DET. G
N.T.S.

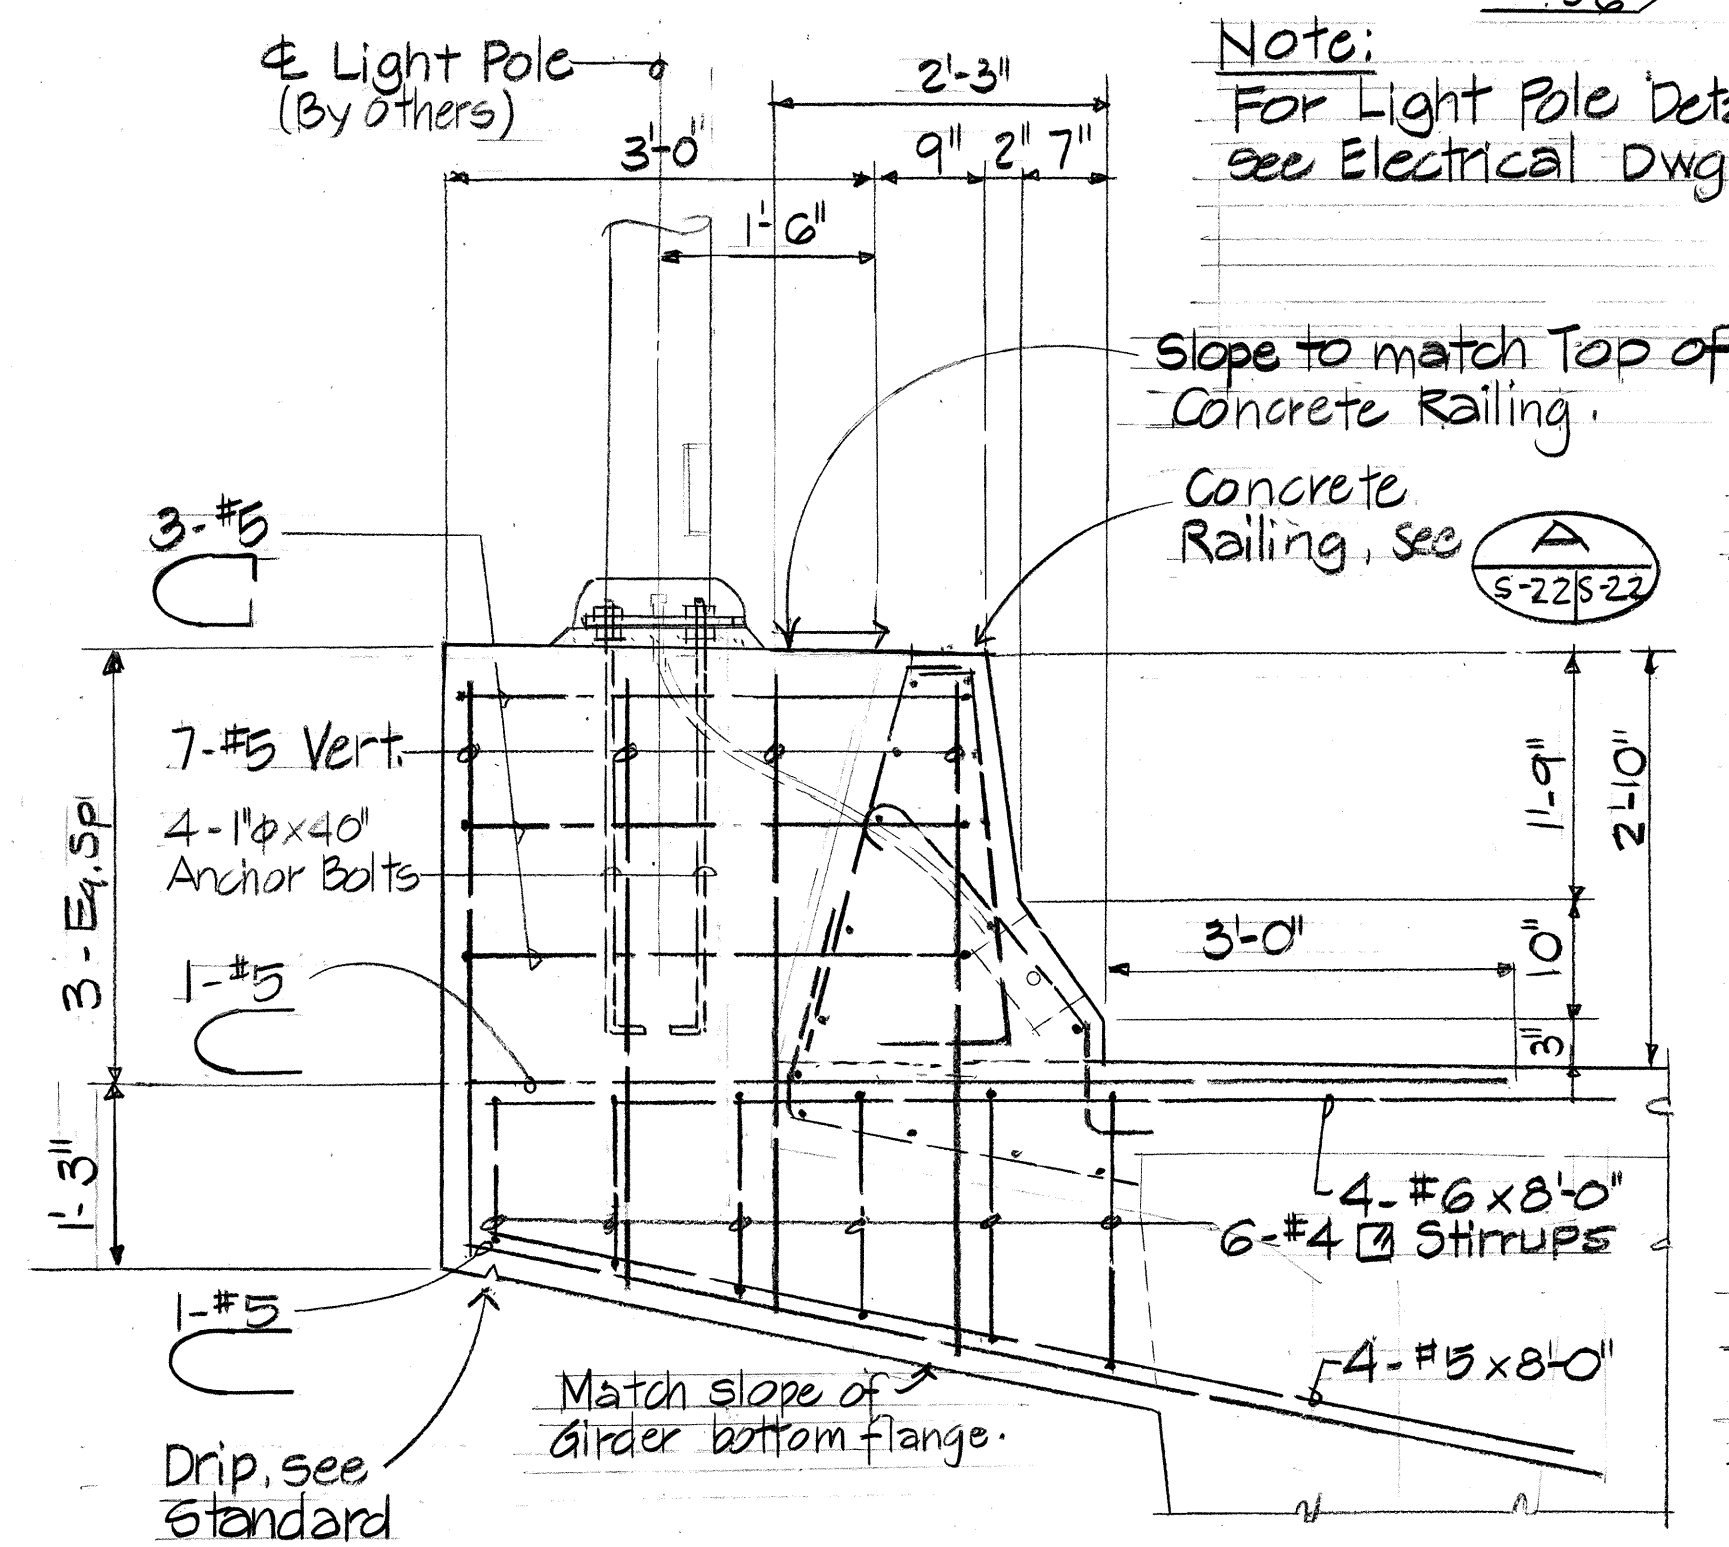

SECTION E
Scale: 3/4" = 1'-0"

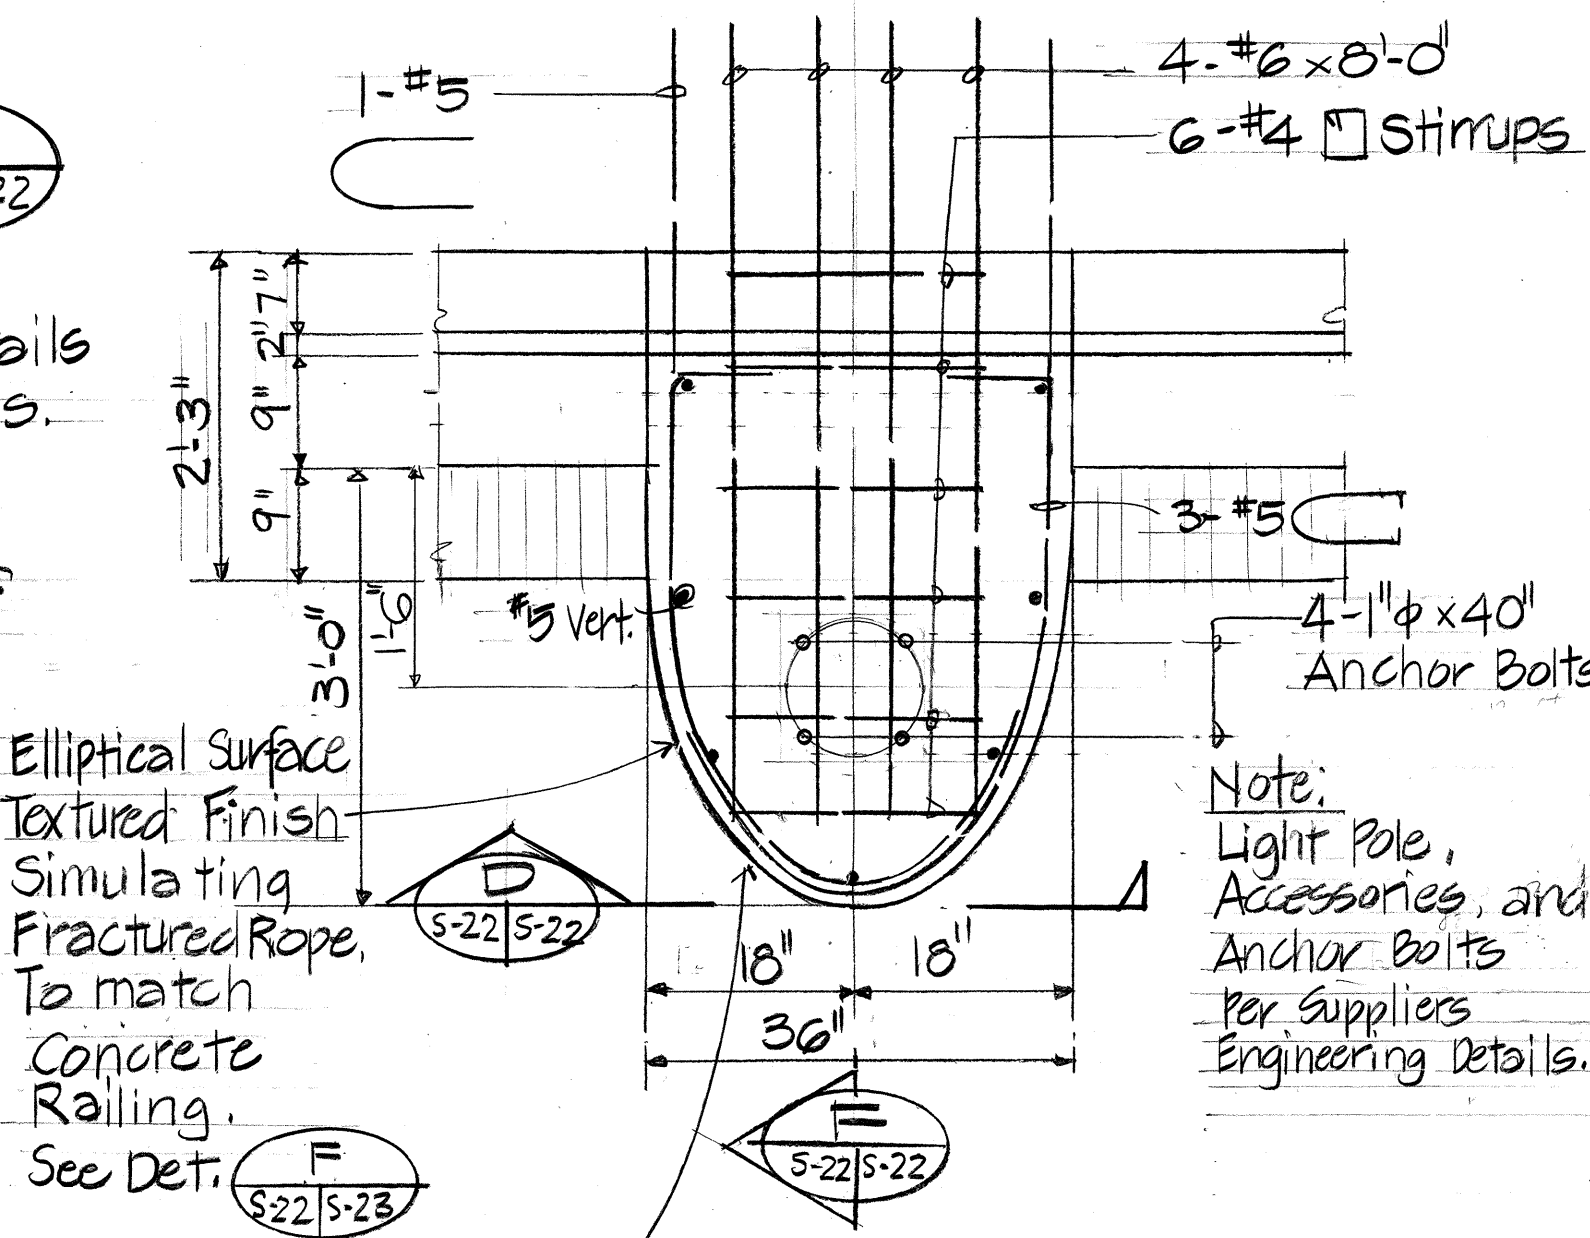

PLAN
Scale: 3/4" = 1'-0"

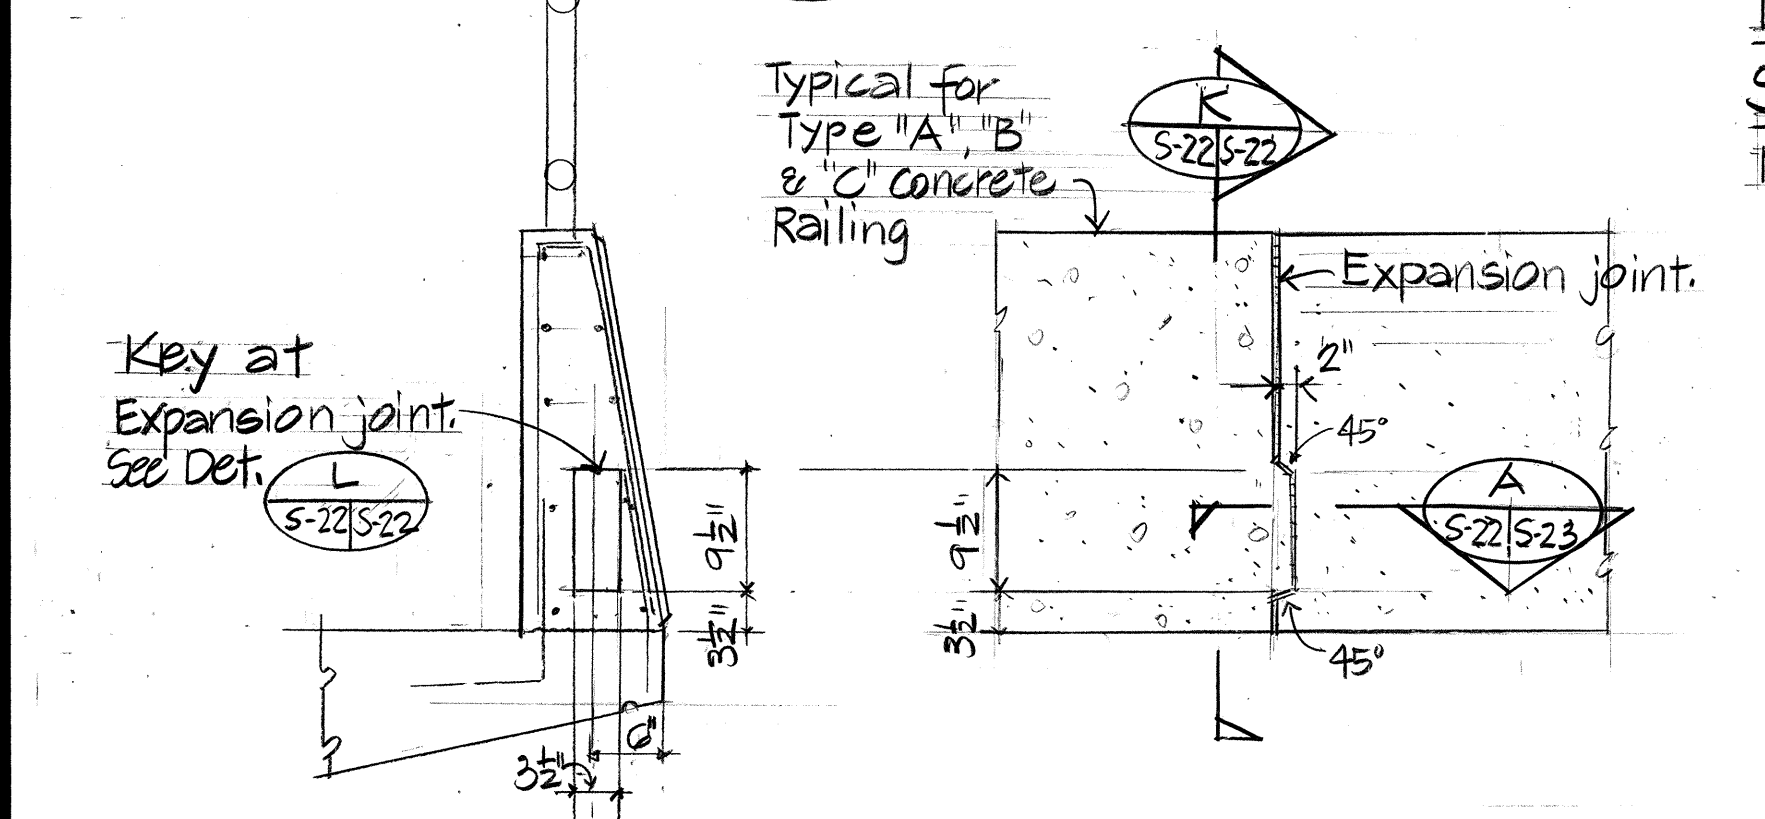

KEY @ TYPE "C"
CONCRETE RAILING DET. K
Scale: 3/4" = 1'-0"

KEY DETAIL L
Scale: 3/4" = 1'-0"



THIS WORK WAS PREPARED BY ME OR UNDER MY SUPERVISION

Myron Okubo

STATE OF HAWAII
DEPARTMENT OF TRANSPORTATION
HIGHWAYS DIVISION

CONCRETE RAILING AND STREET LIGHT DETAILS

SAND ISLAND ROAD WIDENING
2ND. BRIDGE AND APPROACHES
FEDERAL AID PROJECT NO. F-064-(12)


SCALE: AS NOTED. DATE: JUN, 1986

SHEET NO. 5-22 OF 30 SHEETS

DATE REVISION


FED. ROAD DIST. NO.	STATE	FED. AID PROJ. NO.	FISCAL YEAR	SHEET NO.	TOTAL SHEETS
HAWAII	HAW.	F-064-1(2)	1987	125	151

Notes:
 1. Bend longitudinal bars 12" min.
 2. See Sheet S-5 for location of Expansion Joints.

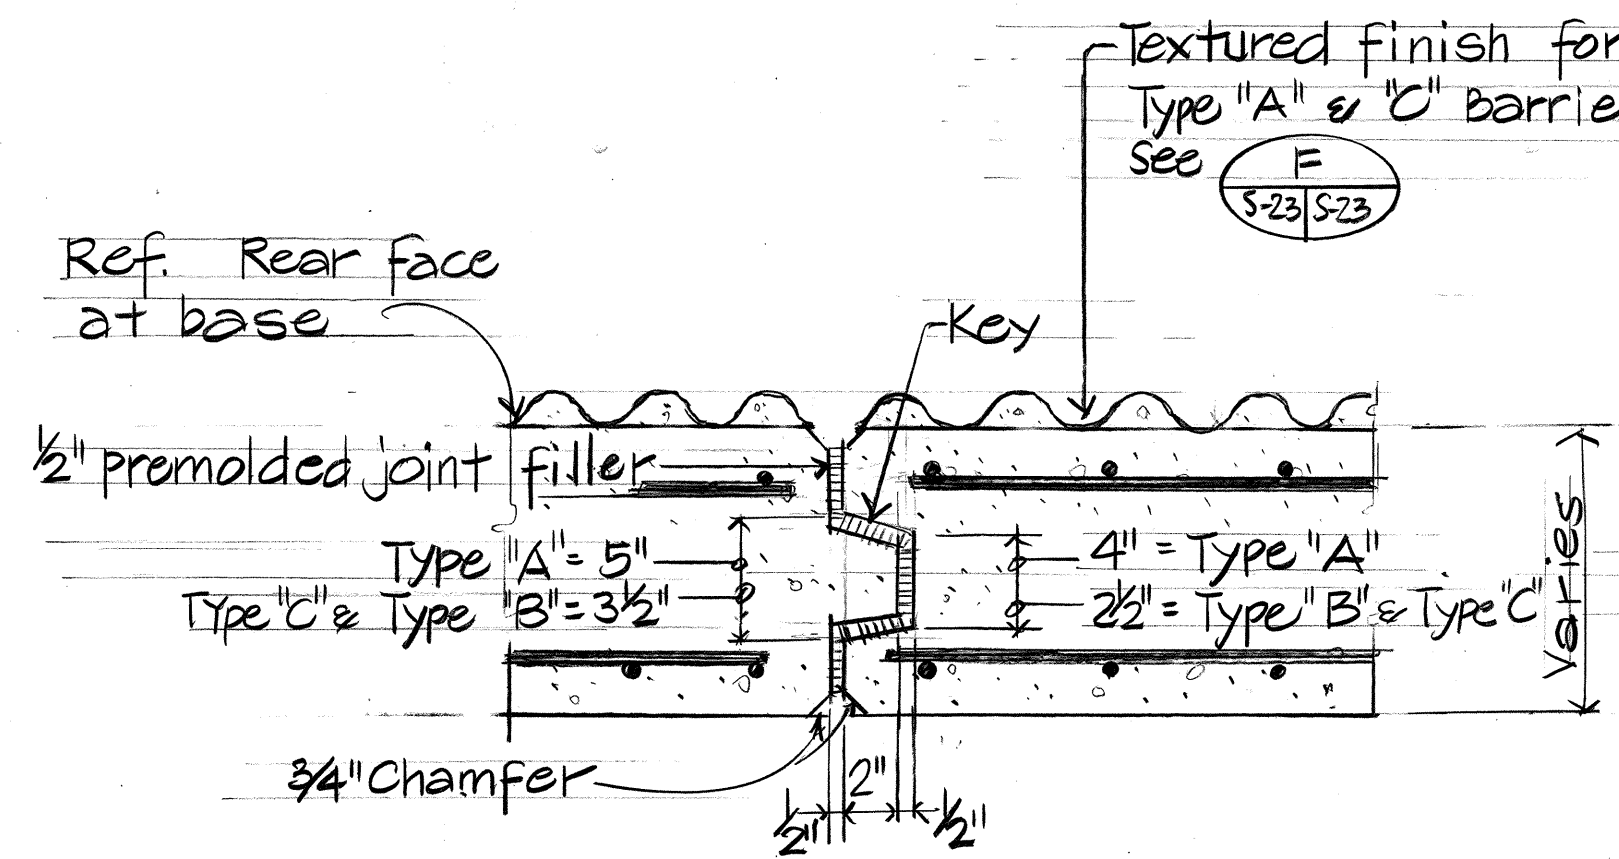


See Note #1 & #2

PLAN
EXPANSION JOINT KEY (A)
N.T.S.

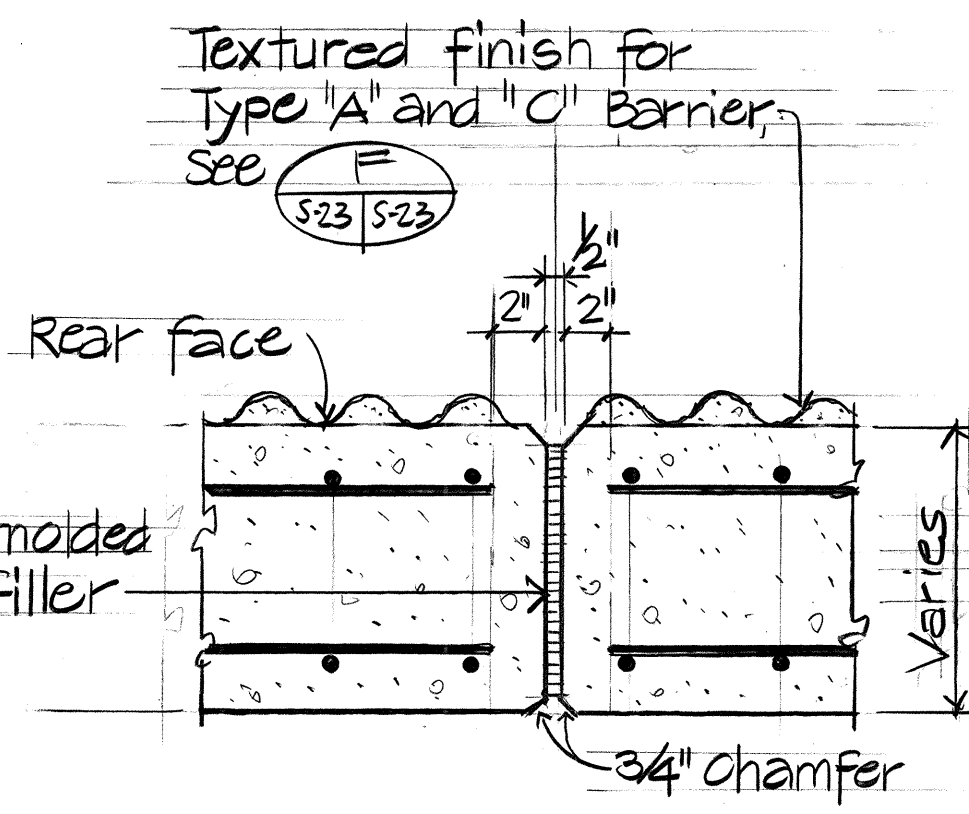


See Notes #1 & #2

PLAN
EXPANSION JOINT (B)
N.T.S.

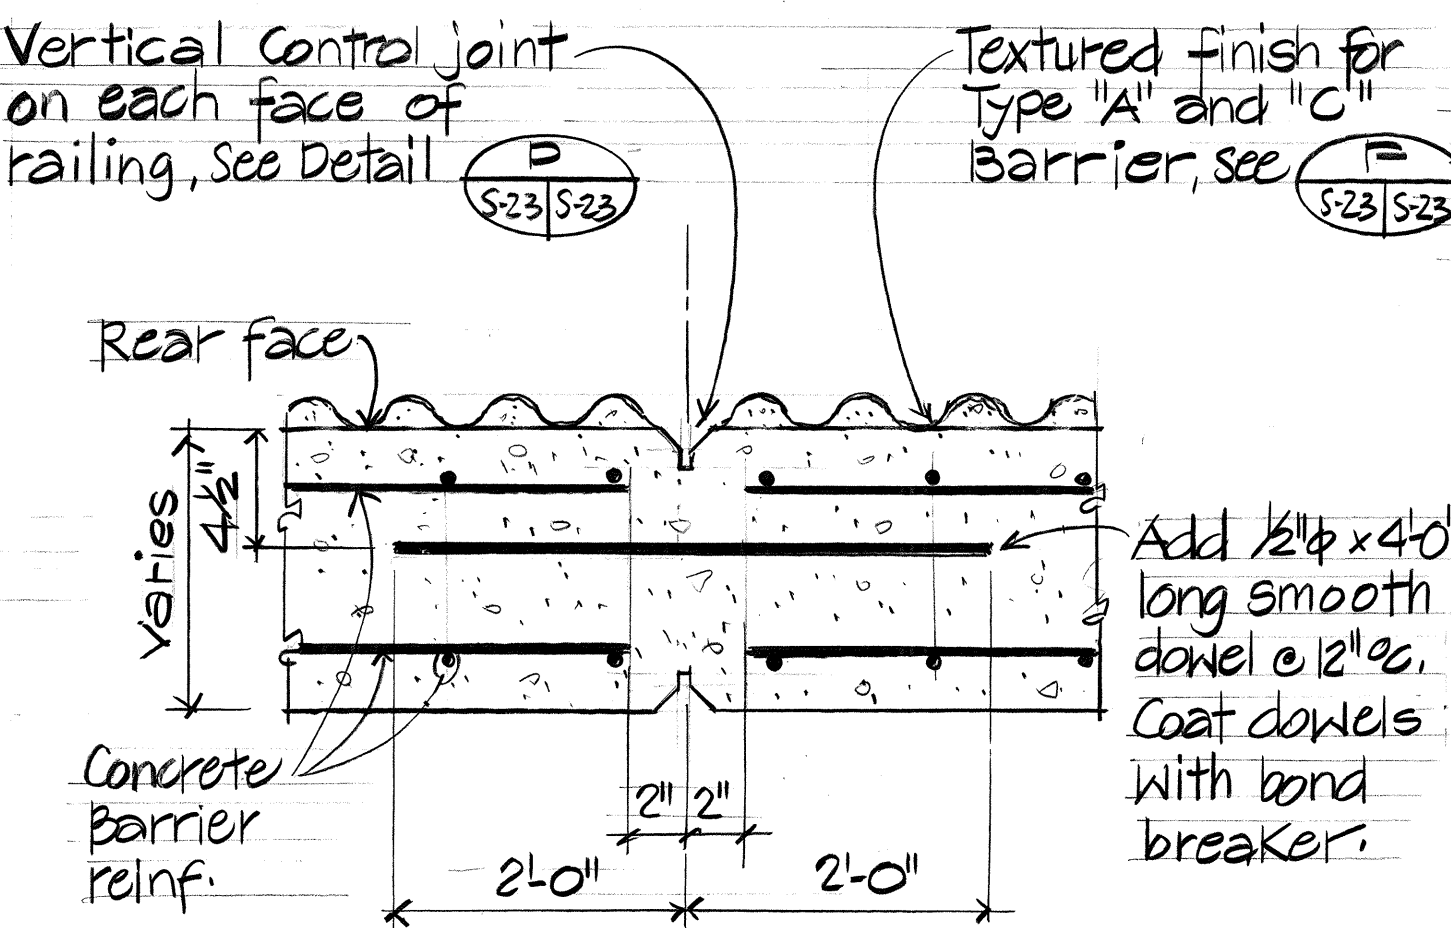


See Notes #1 & #2


PLAN
CONTROL JOINT (C)
N.T.S.

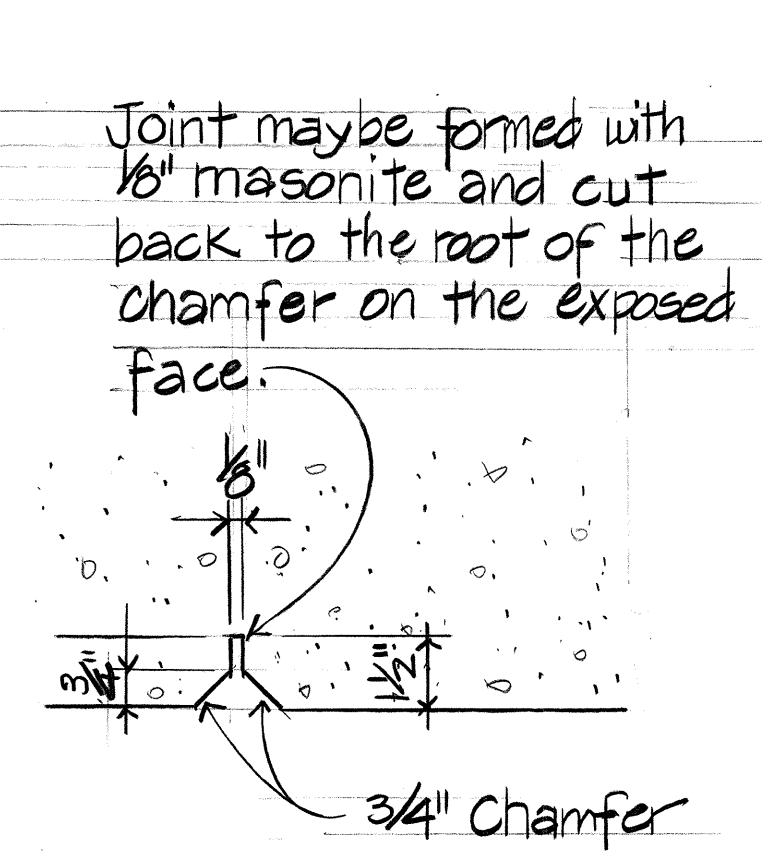


PLAN
DETAIL (D)
N.T.S.

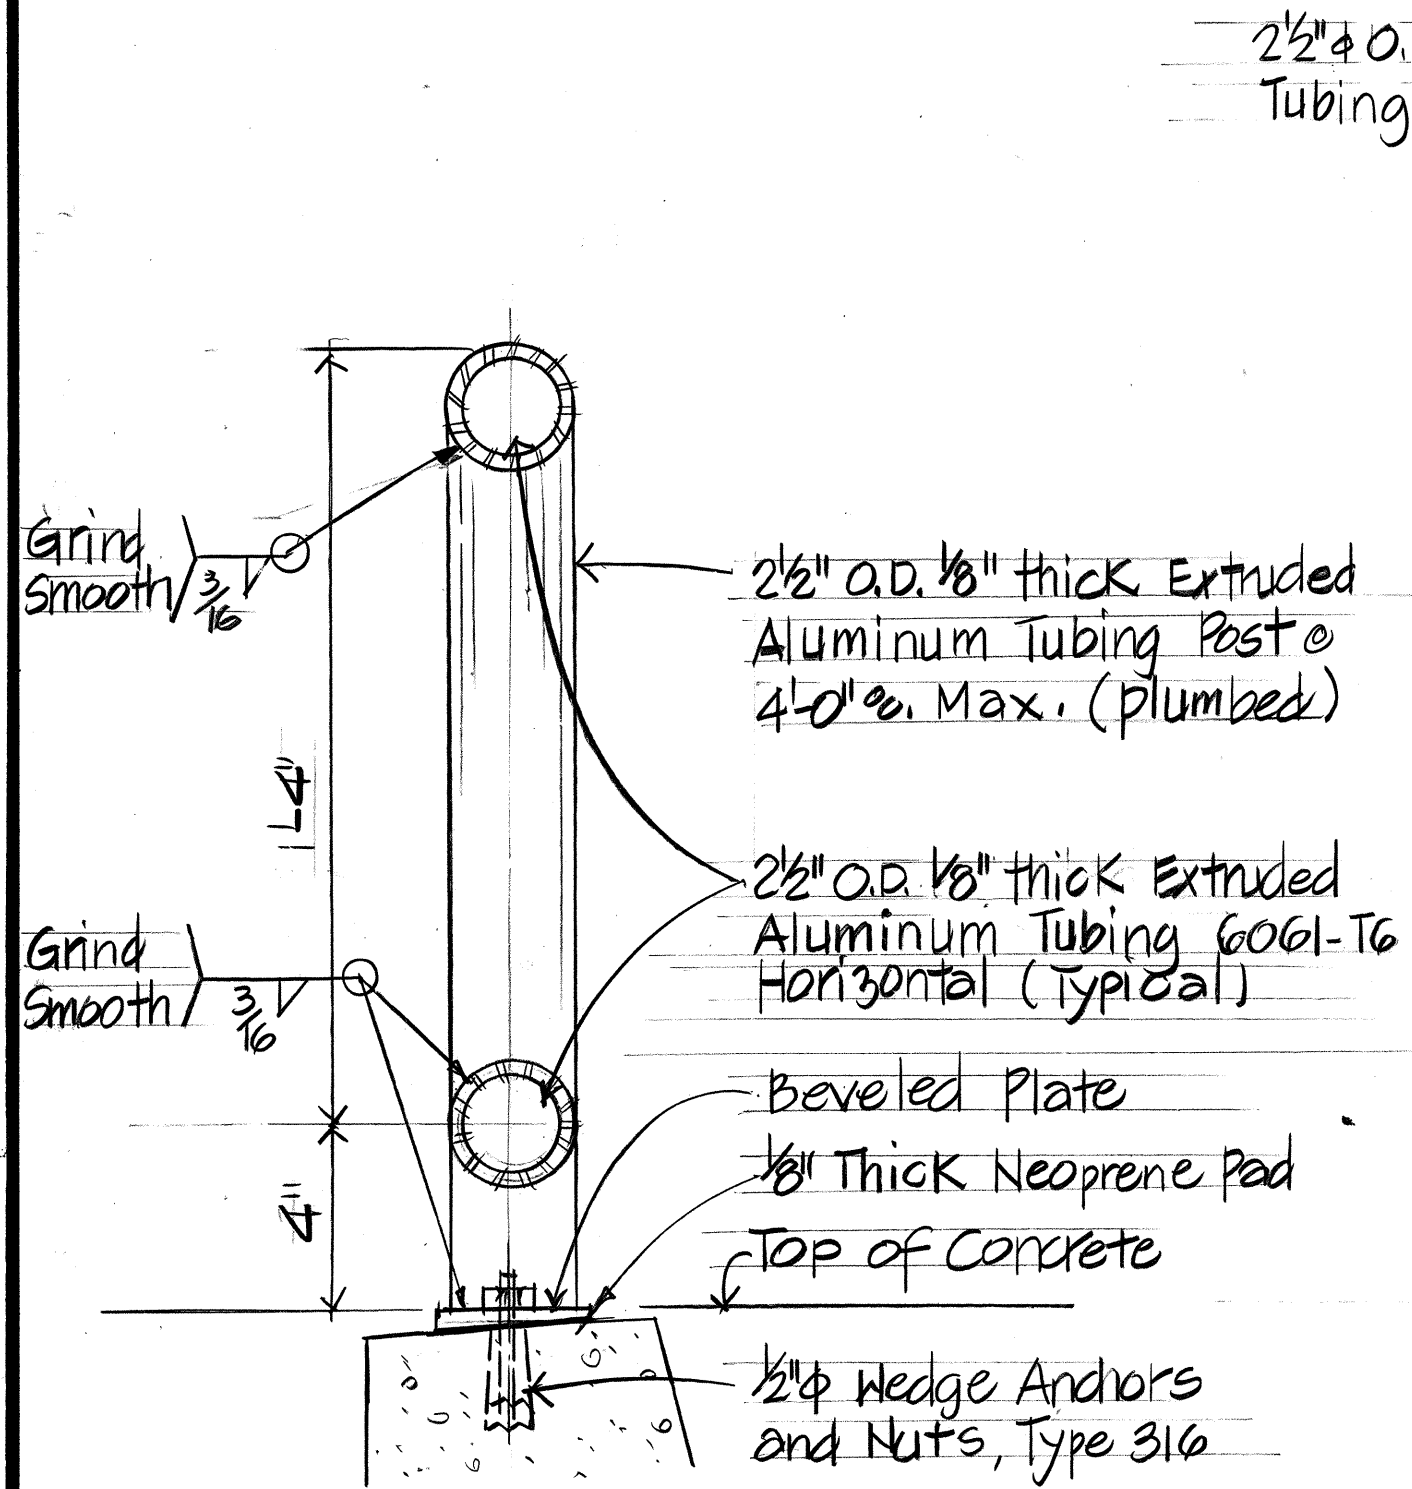


SECTION

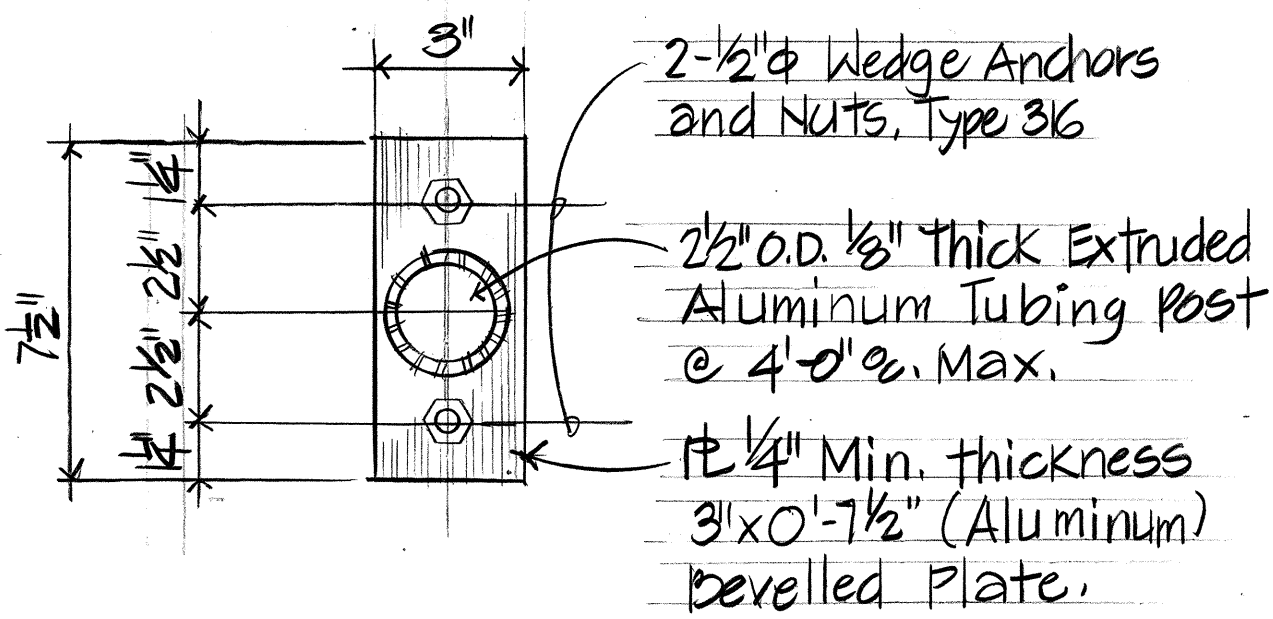


ALUMINUM RAILING DETAIL (G)
N.T.S.

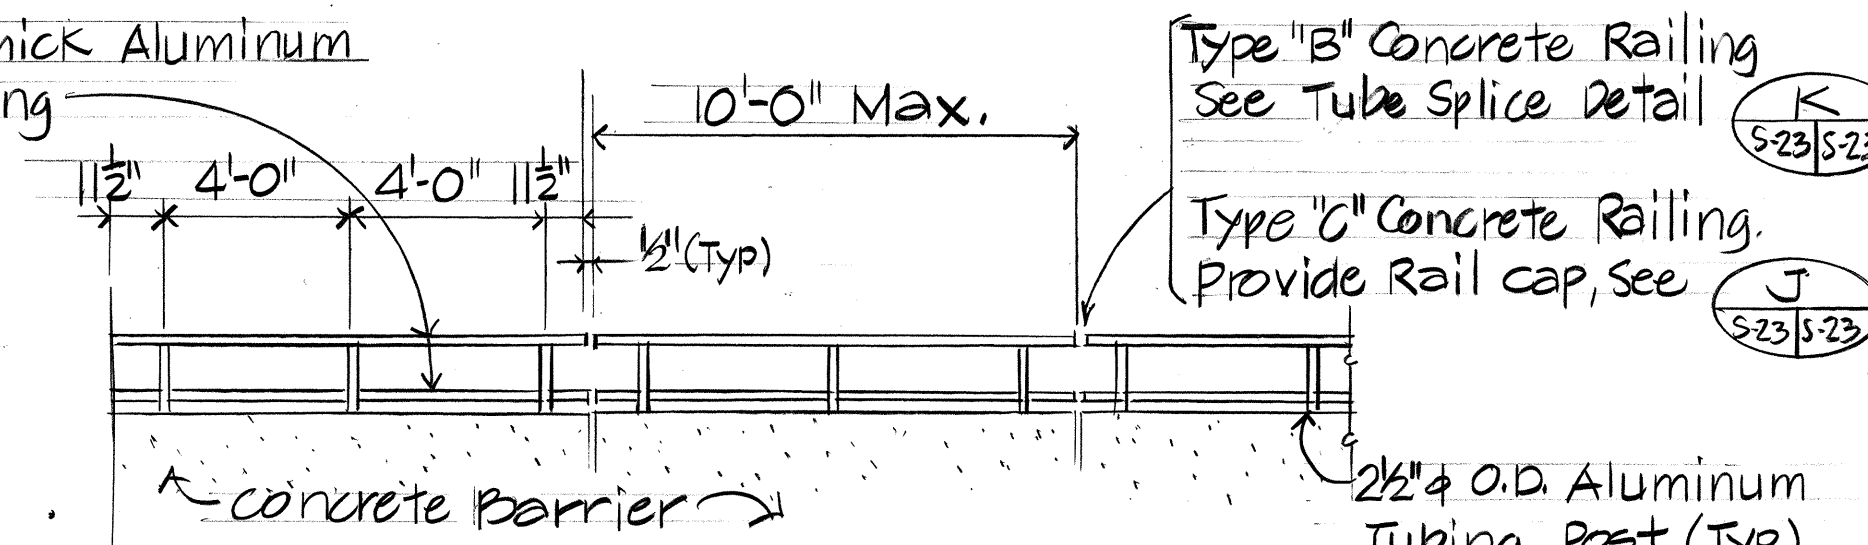

RAILING POST SPACING (E)
N.T.S.

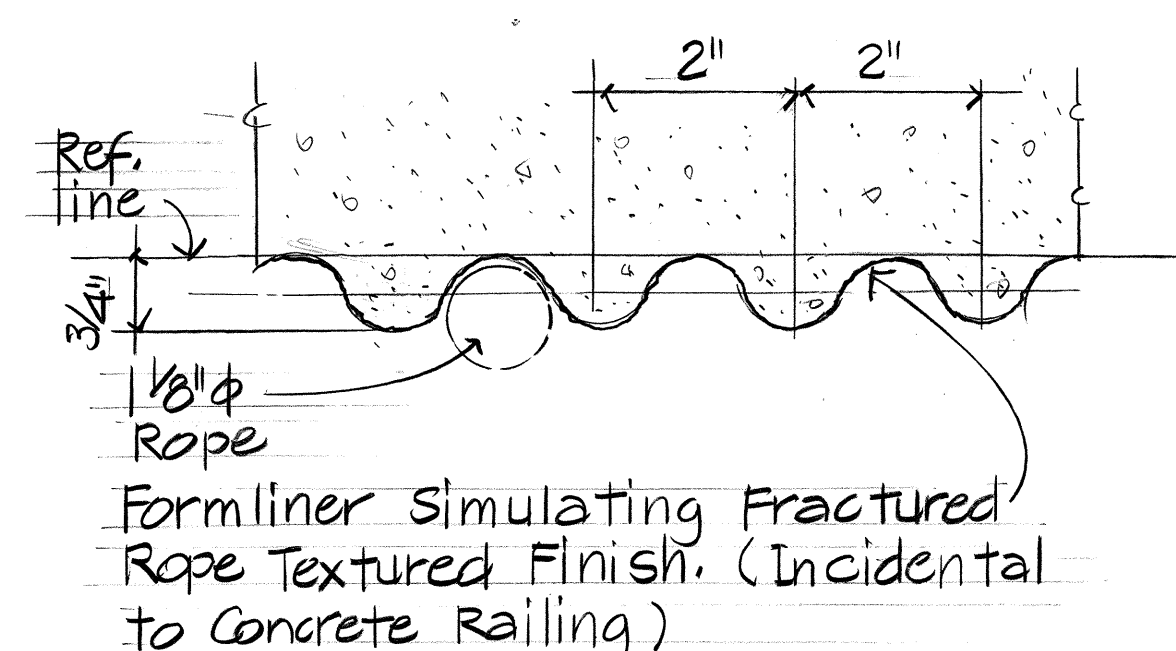


TEXTURED FINISH DETAIL (F)
N.T.S.

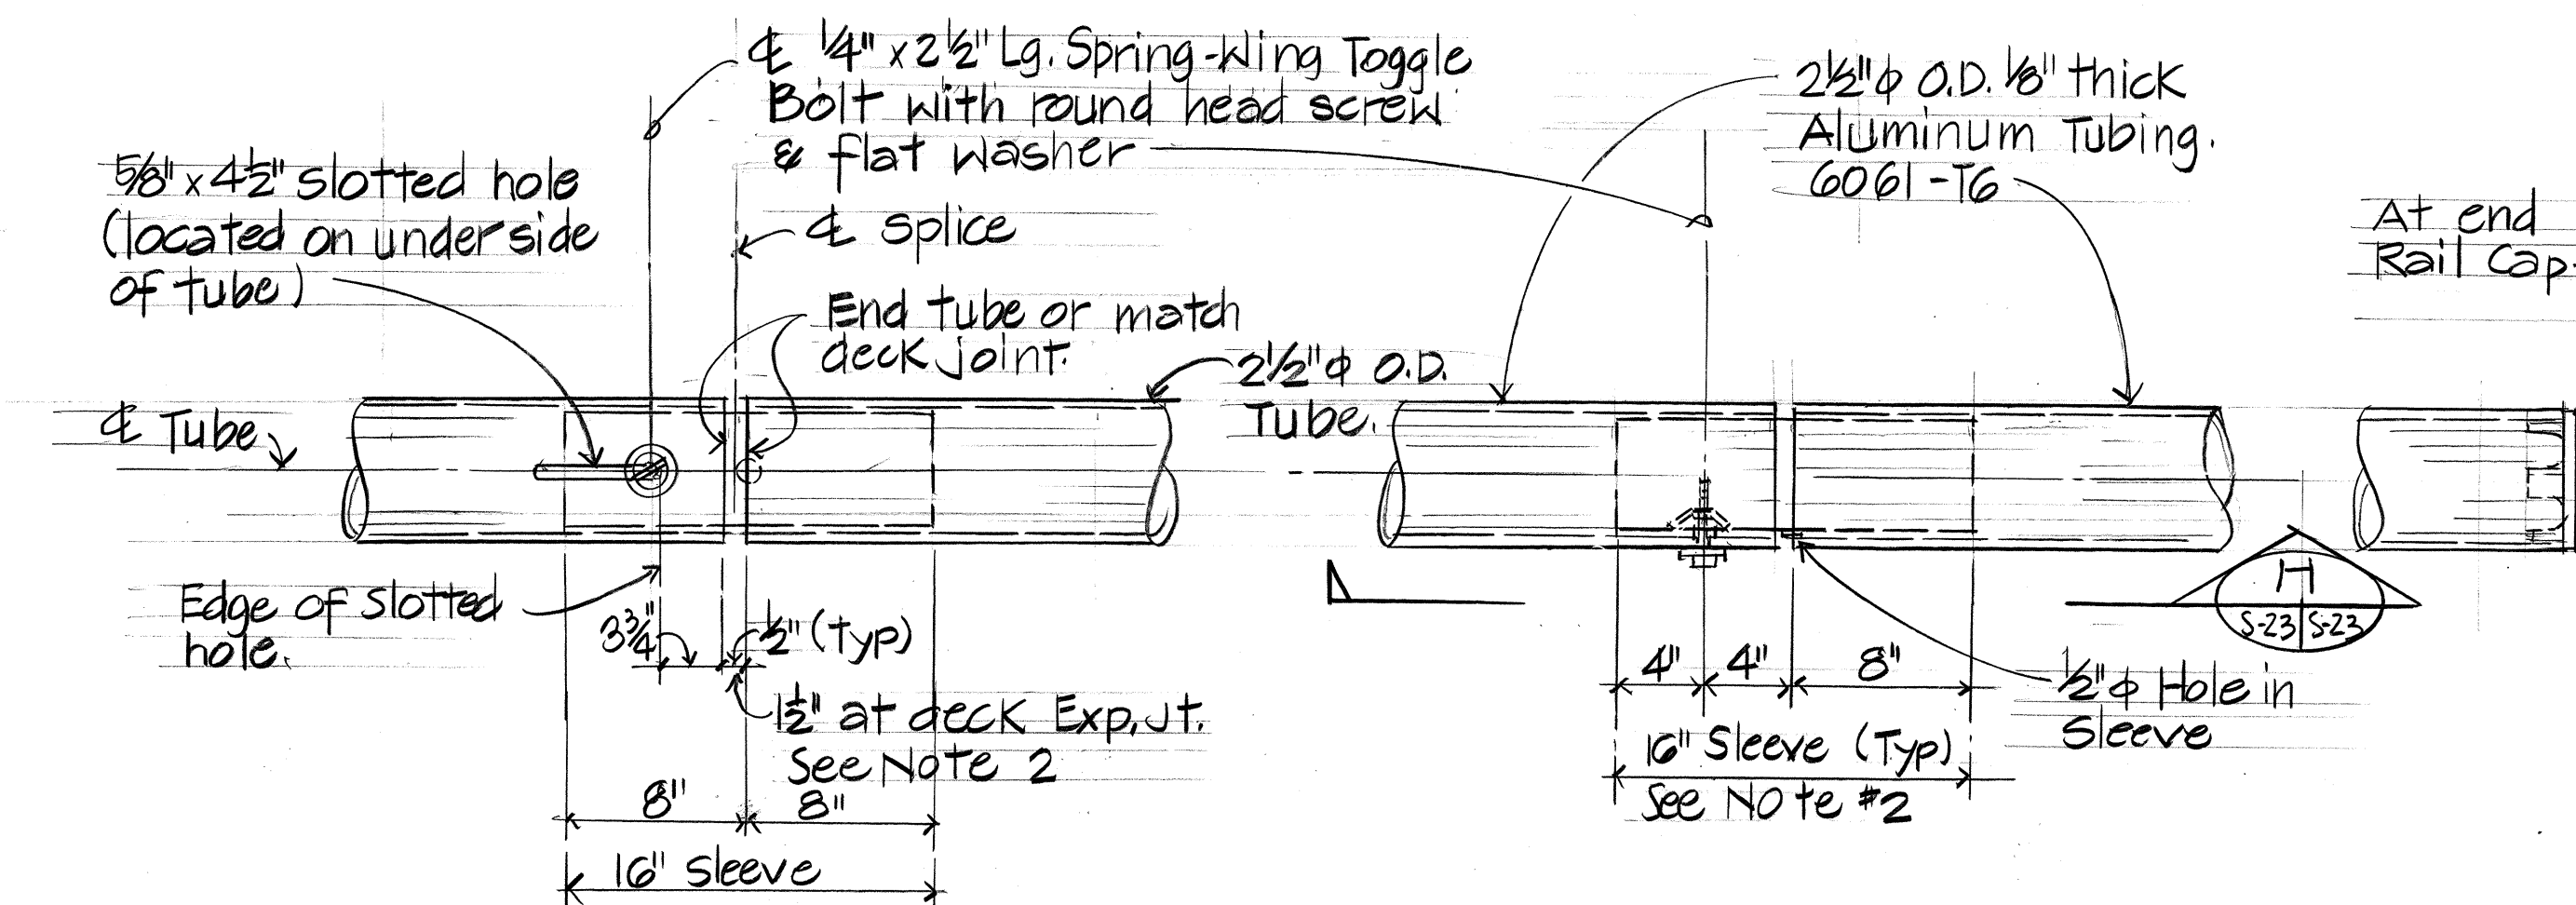

SECTION (H)
N.T.S.

SLEEVE - (FRONT VIEW)
N.T.S.

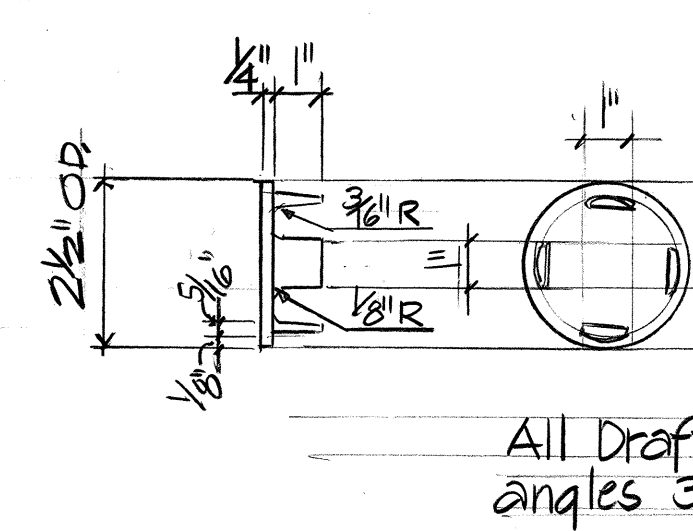

RAIL CAP DETAIL (J)
N.T.S.

TYPE "B" CONCRETE RAILING - TUBE SPICE DETAIL (K)
N.T.S.

Notes:
 1. Slotted hole & toggle bolts shall be located on underside of tube.
 2. All tubes shall be spliced where shown in (E) and in the panel spanning deck expansion joints. Increase joint width between tube to 1/2 inch and increase sleeve length by 1 inch at expansion joints.

ROSCOE O. FORD
 REGISTERED PROFESSIONAL ENGINEER
 No. 3731-S
 HAWAII, U.S.A.
 THIS WORK WAS PREPARED BY ME OR UNDER MY SUPERVISION.
 Roscoe O. Ford

STATE OF HAWAII
 DEPARTMENT OF TRANSPORTATION
 HIGHWAYS DIVISION
CONCRETE RAILING DETAILS


SAND ISLAND ROAD WIDENING
 2ND BRIDGE AND APPROACHES
 FEDERAL AID PROJECT NO. F-064-1(2)

SCALE: AS NOTED. DATE: JUN, 1986
 SHEET NO. S-23 OF 30 SHEETS


DATE REVISION

Notes:

1. All Anchor Bolts shall be High Strength Bolts conforming to the Requirements of ASTM A325.
2. All Shoe Assembly, including Anchor Bolts, Nuts and Washers shall be Galvanized.
3. Special End Shoe shall be fabricated from 10 Gage Steel conforming to the Requirements of AASHTO M160.
4. The first 2- Panels or 25'-0" of Guard Rail adjoining Special End Shoe shall be Galvanized Steel.
5. Anchor Bolt Length given from under Bolt Head.
6. Place Name of Structure as shown. For location, see "Plan" on Contract Drawing. Date shown will be Year Structure is completed. Letter size and Detail, see Standard Details.
7. Front Face of End Post to match Front Face of Concrete Railing.
8. Embedment of anchor bolts shall be such that a snug fit of the elements and full thread engagement plus $\frac{1}{4}$ " (Maximum) is attained.

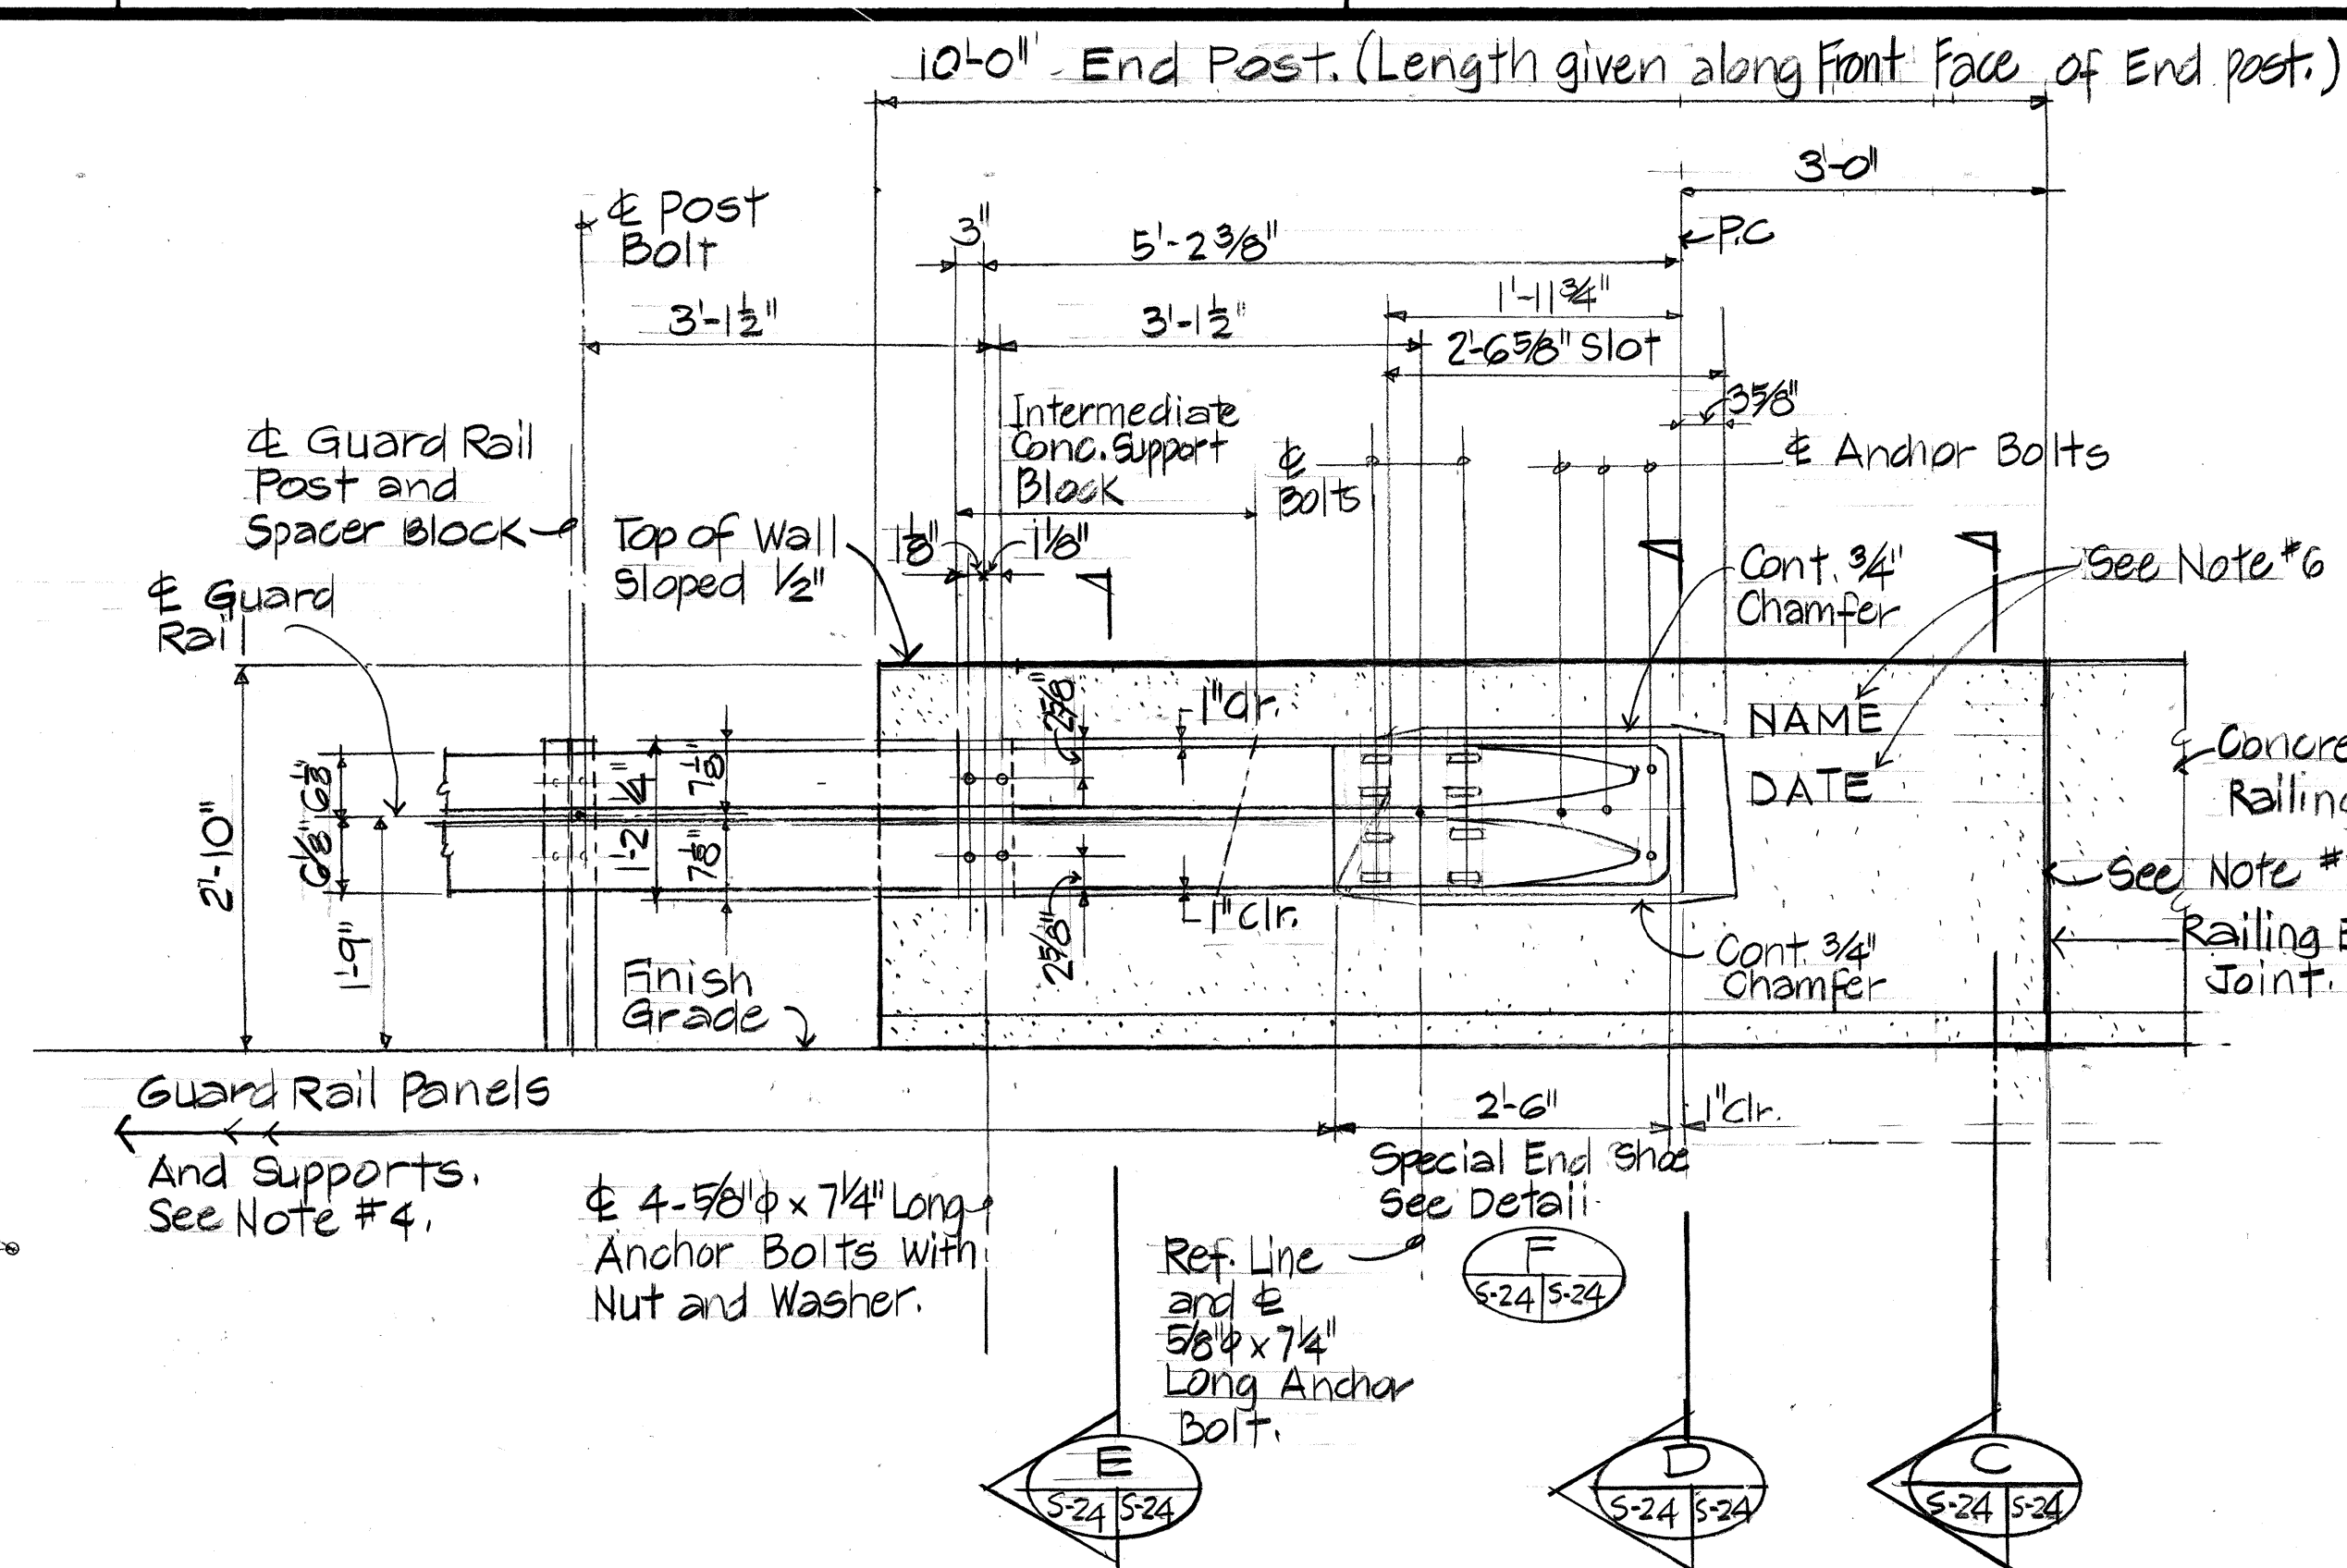


ELEVATION
Scale: $\frac{3}{4}" = 1'-0"$

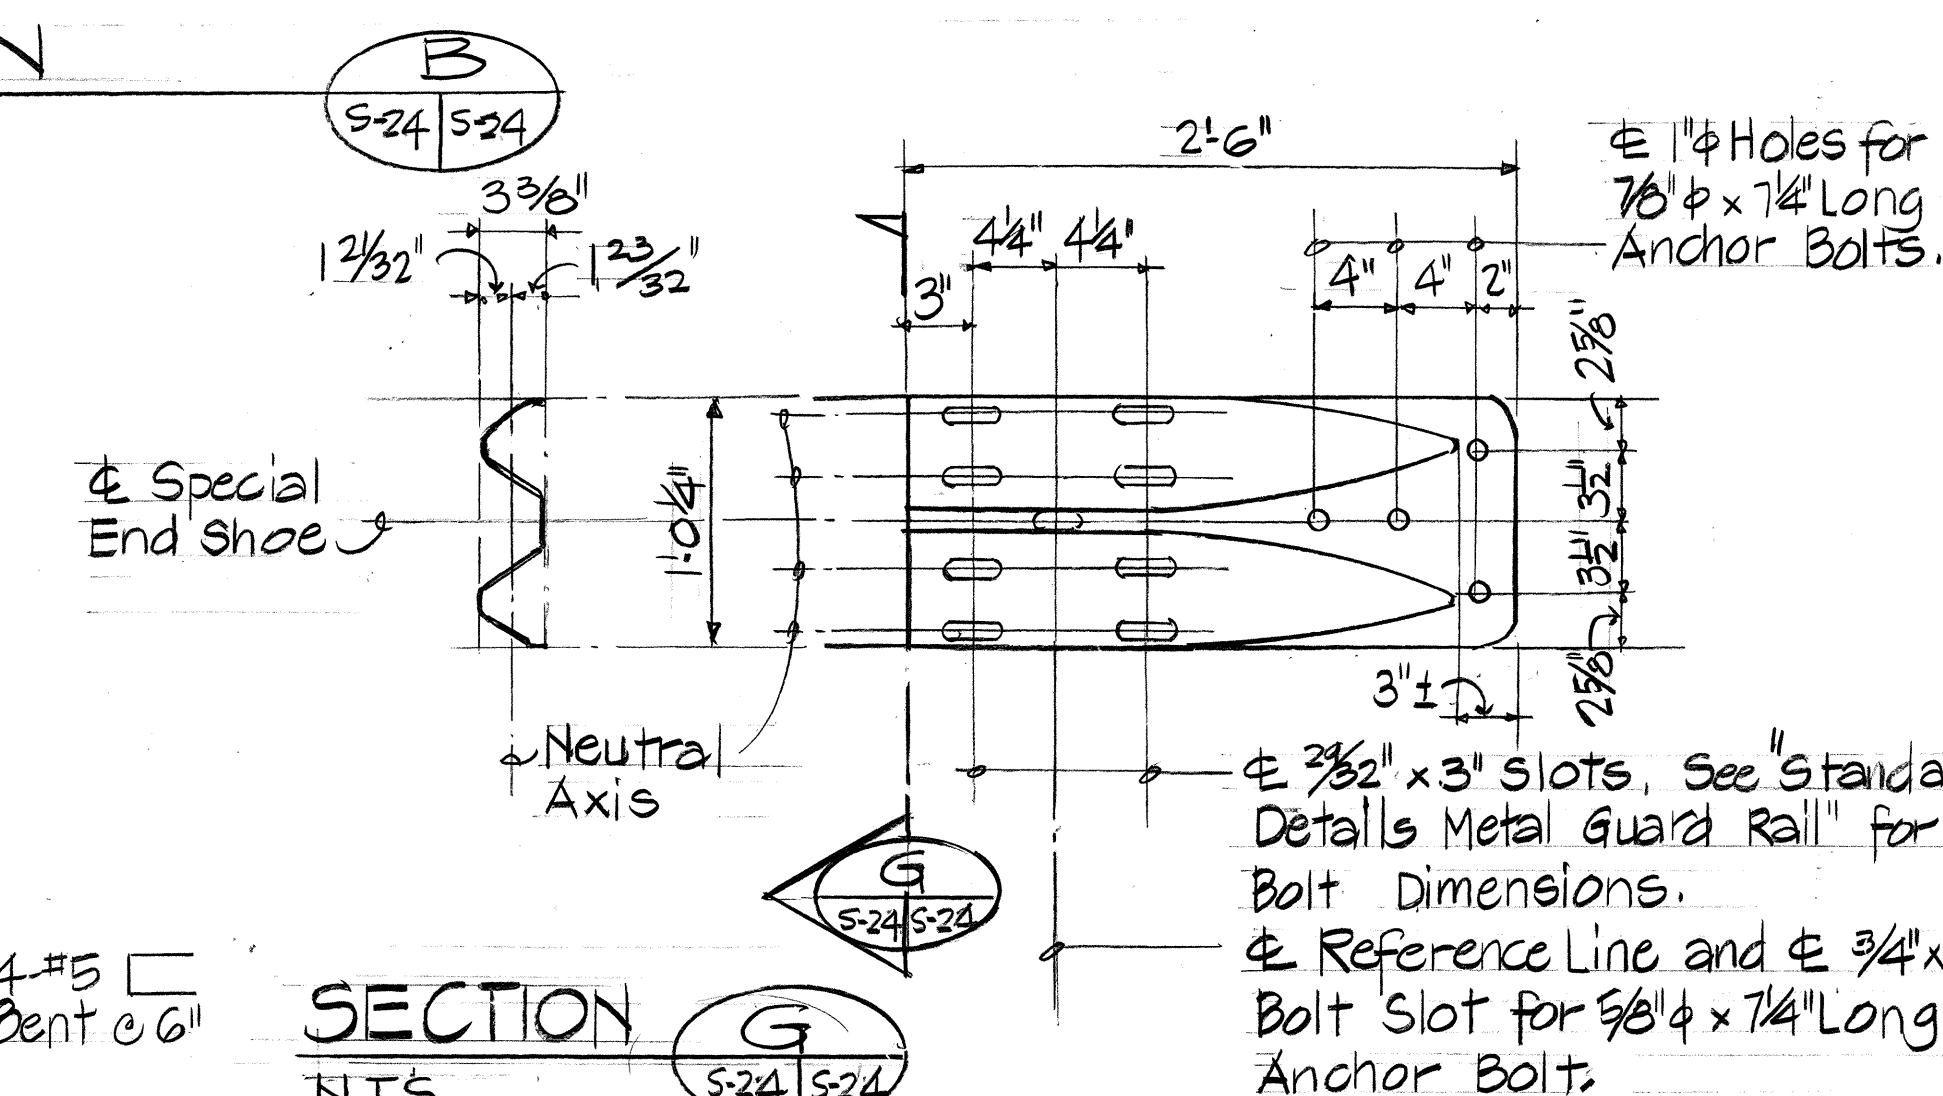


ELEVATION
N.T.S.


SPECIAL END SHOE DETAIL
N.T.S.

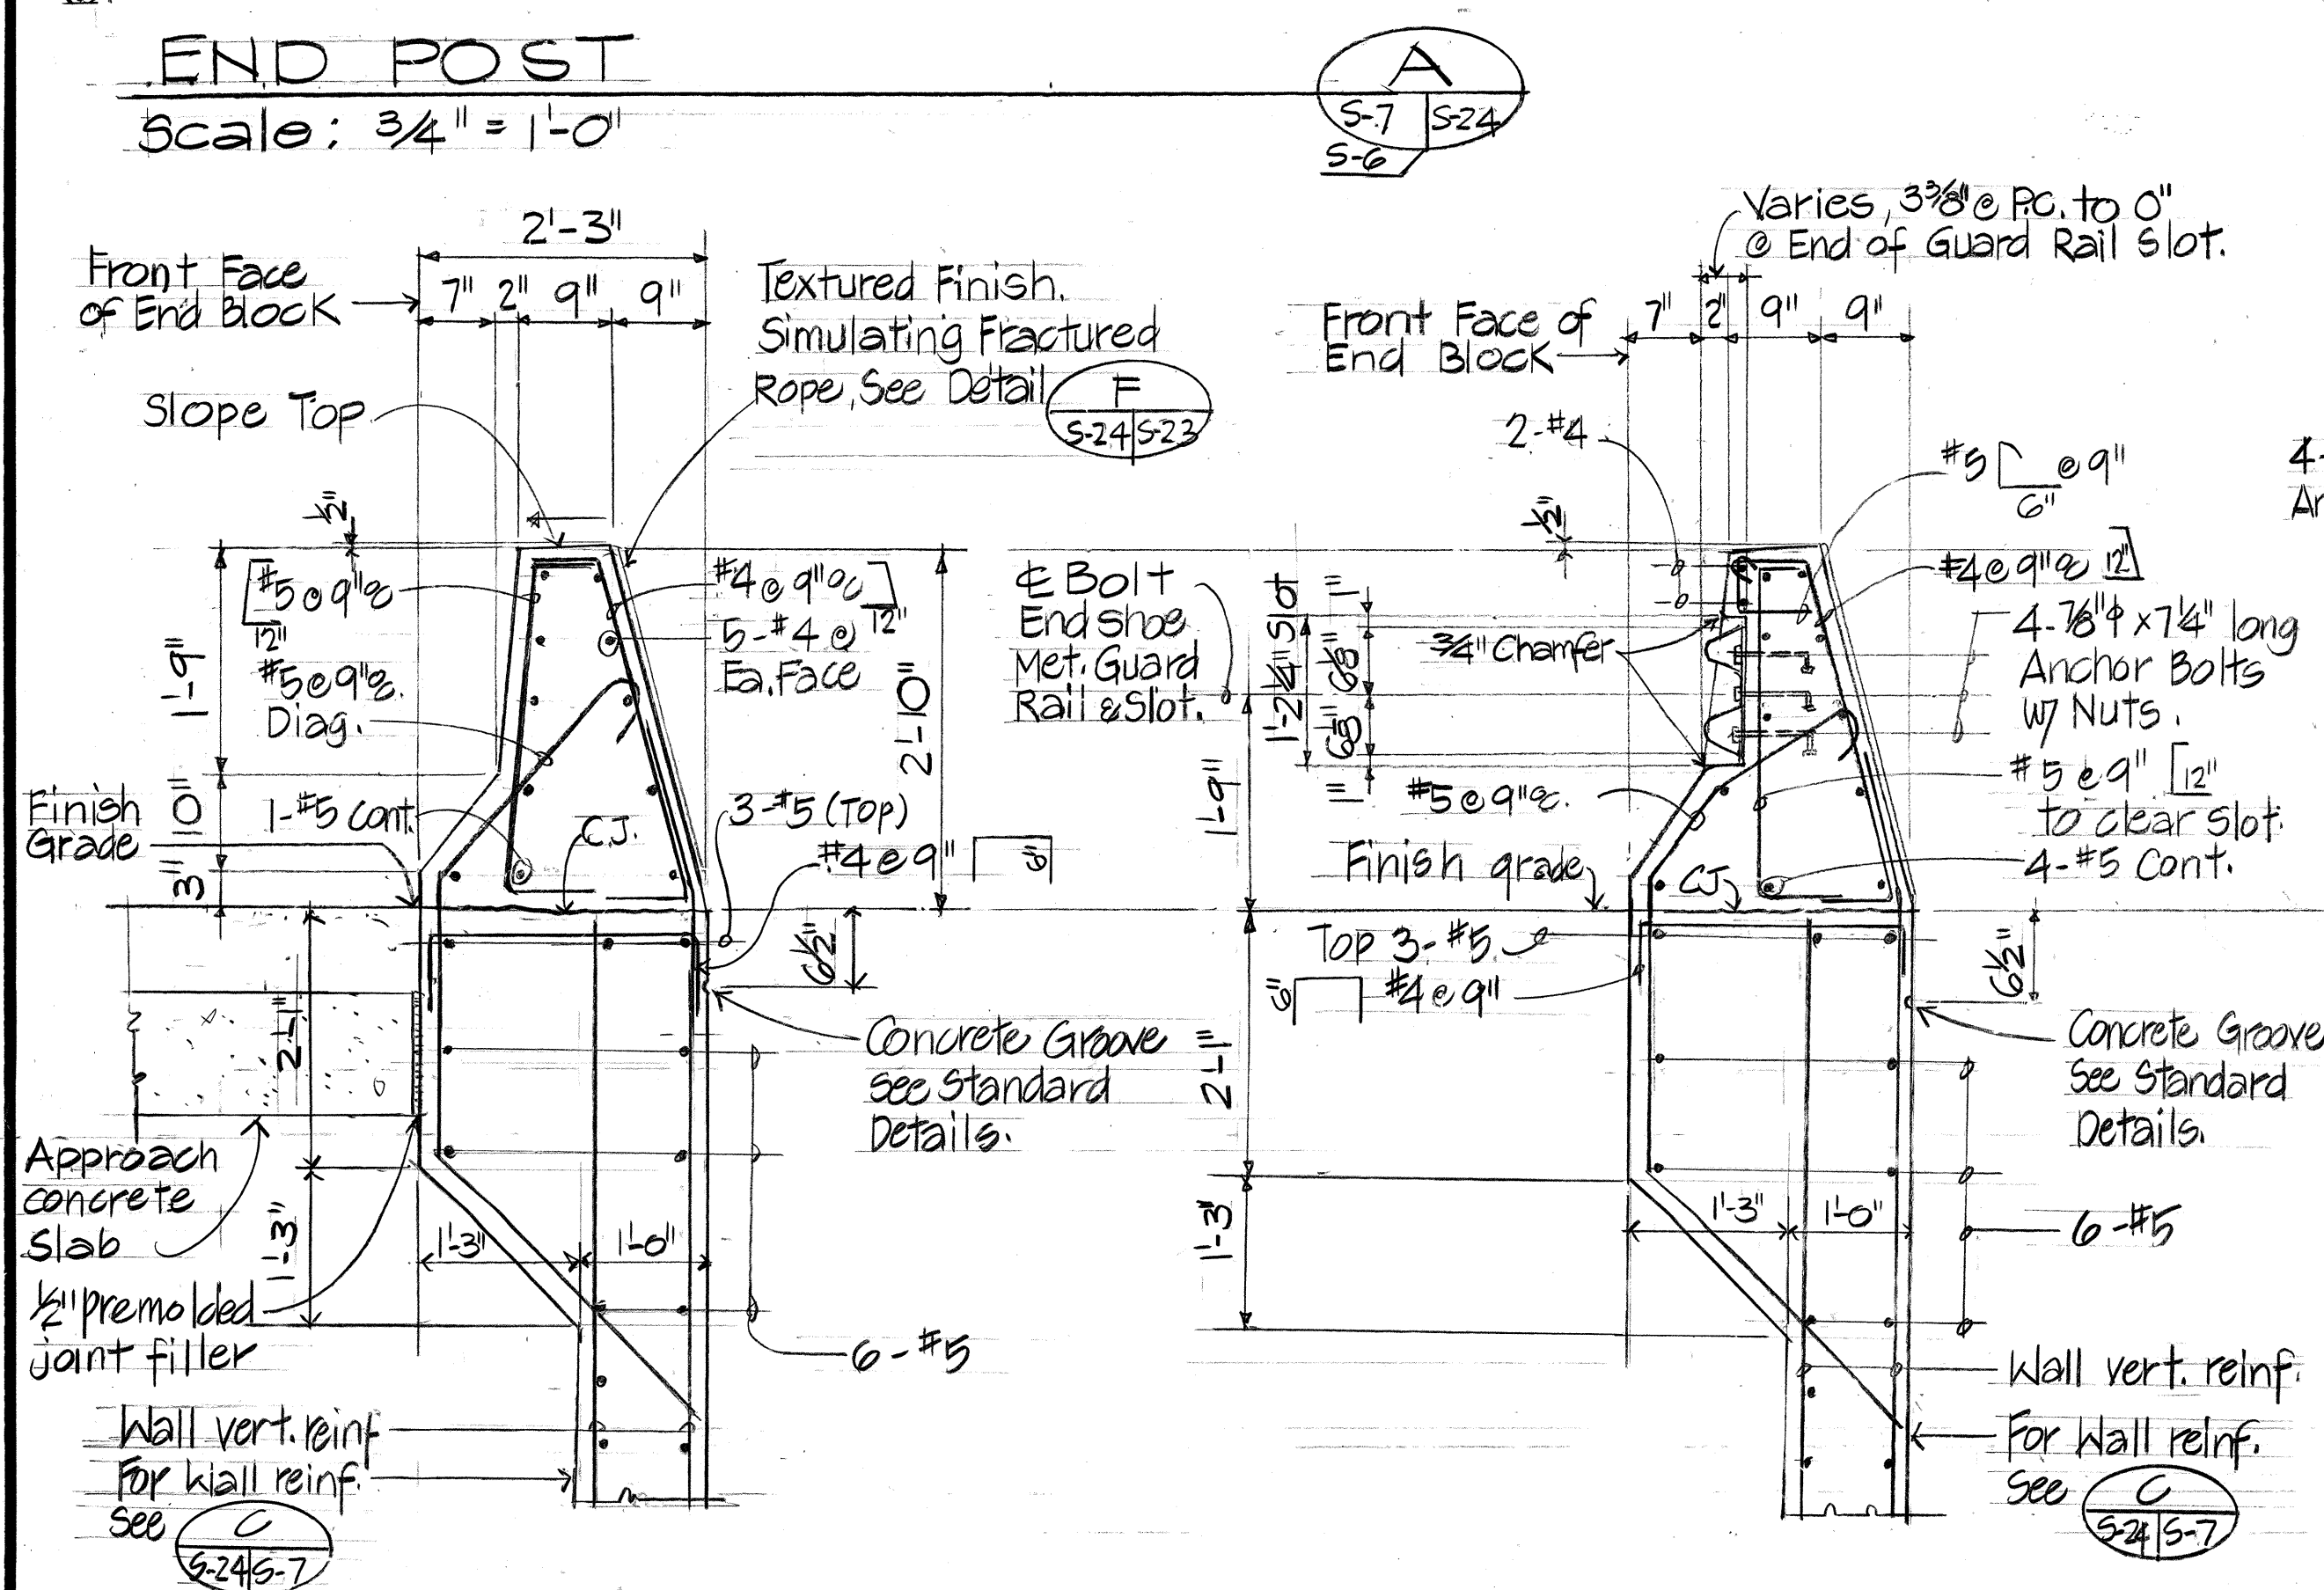


SECTION C
Scale: $\frac{3}{4}" = 1'-0"$

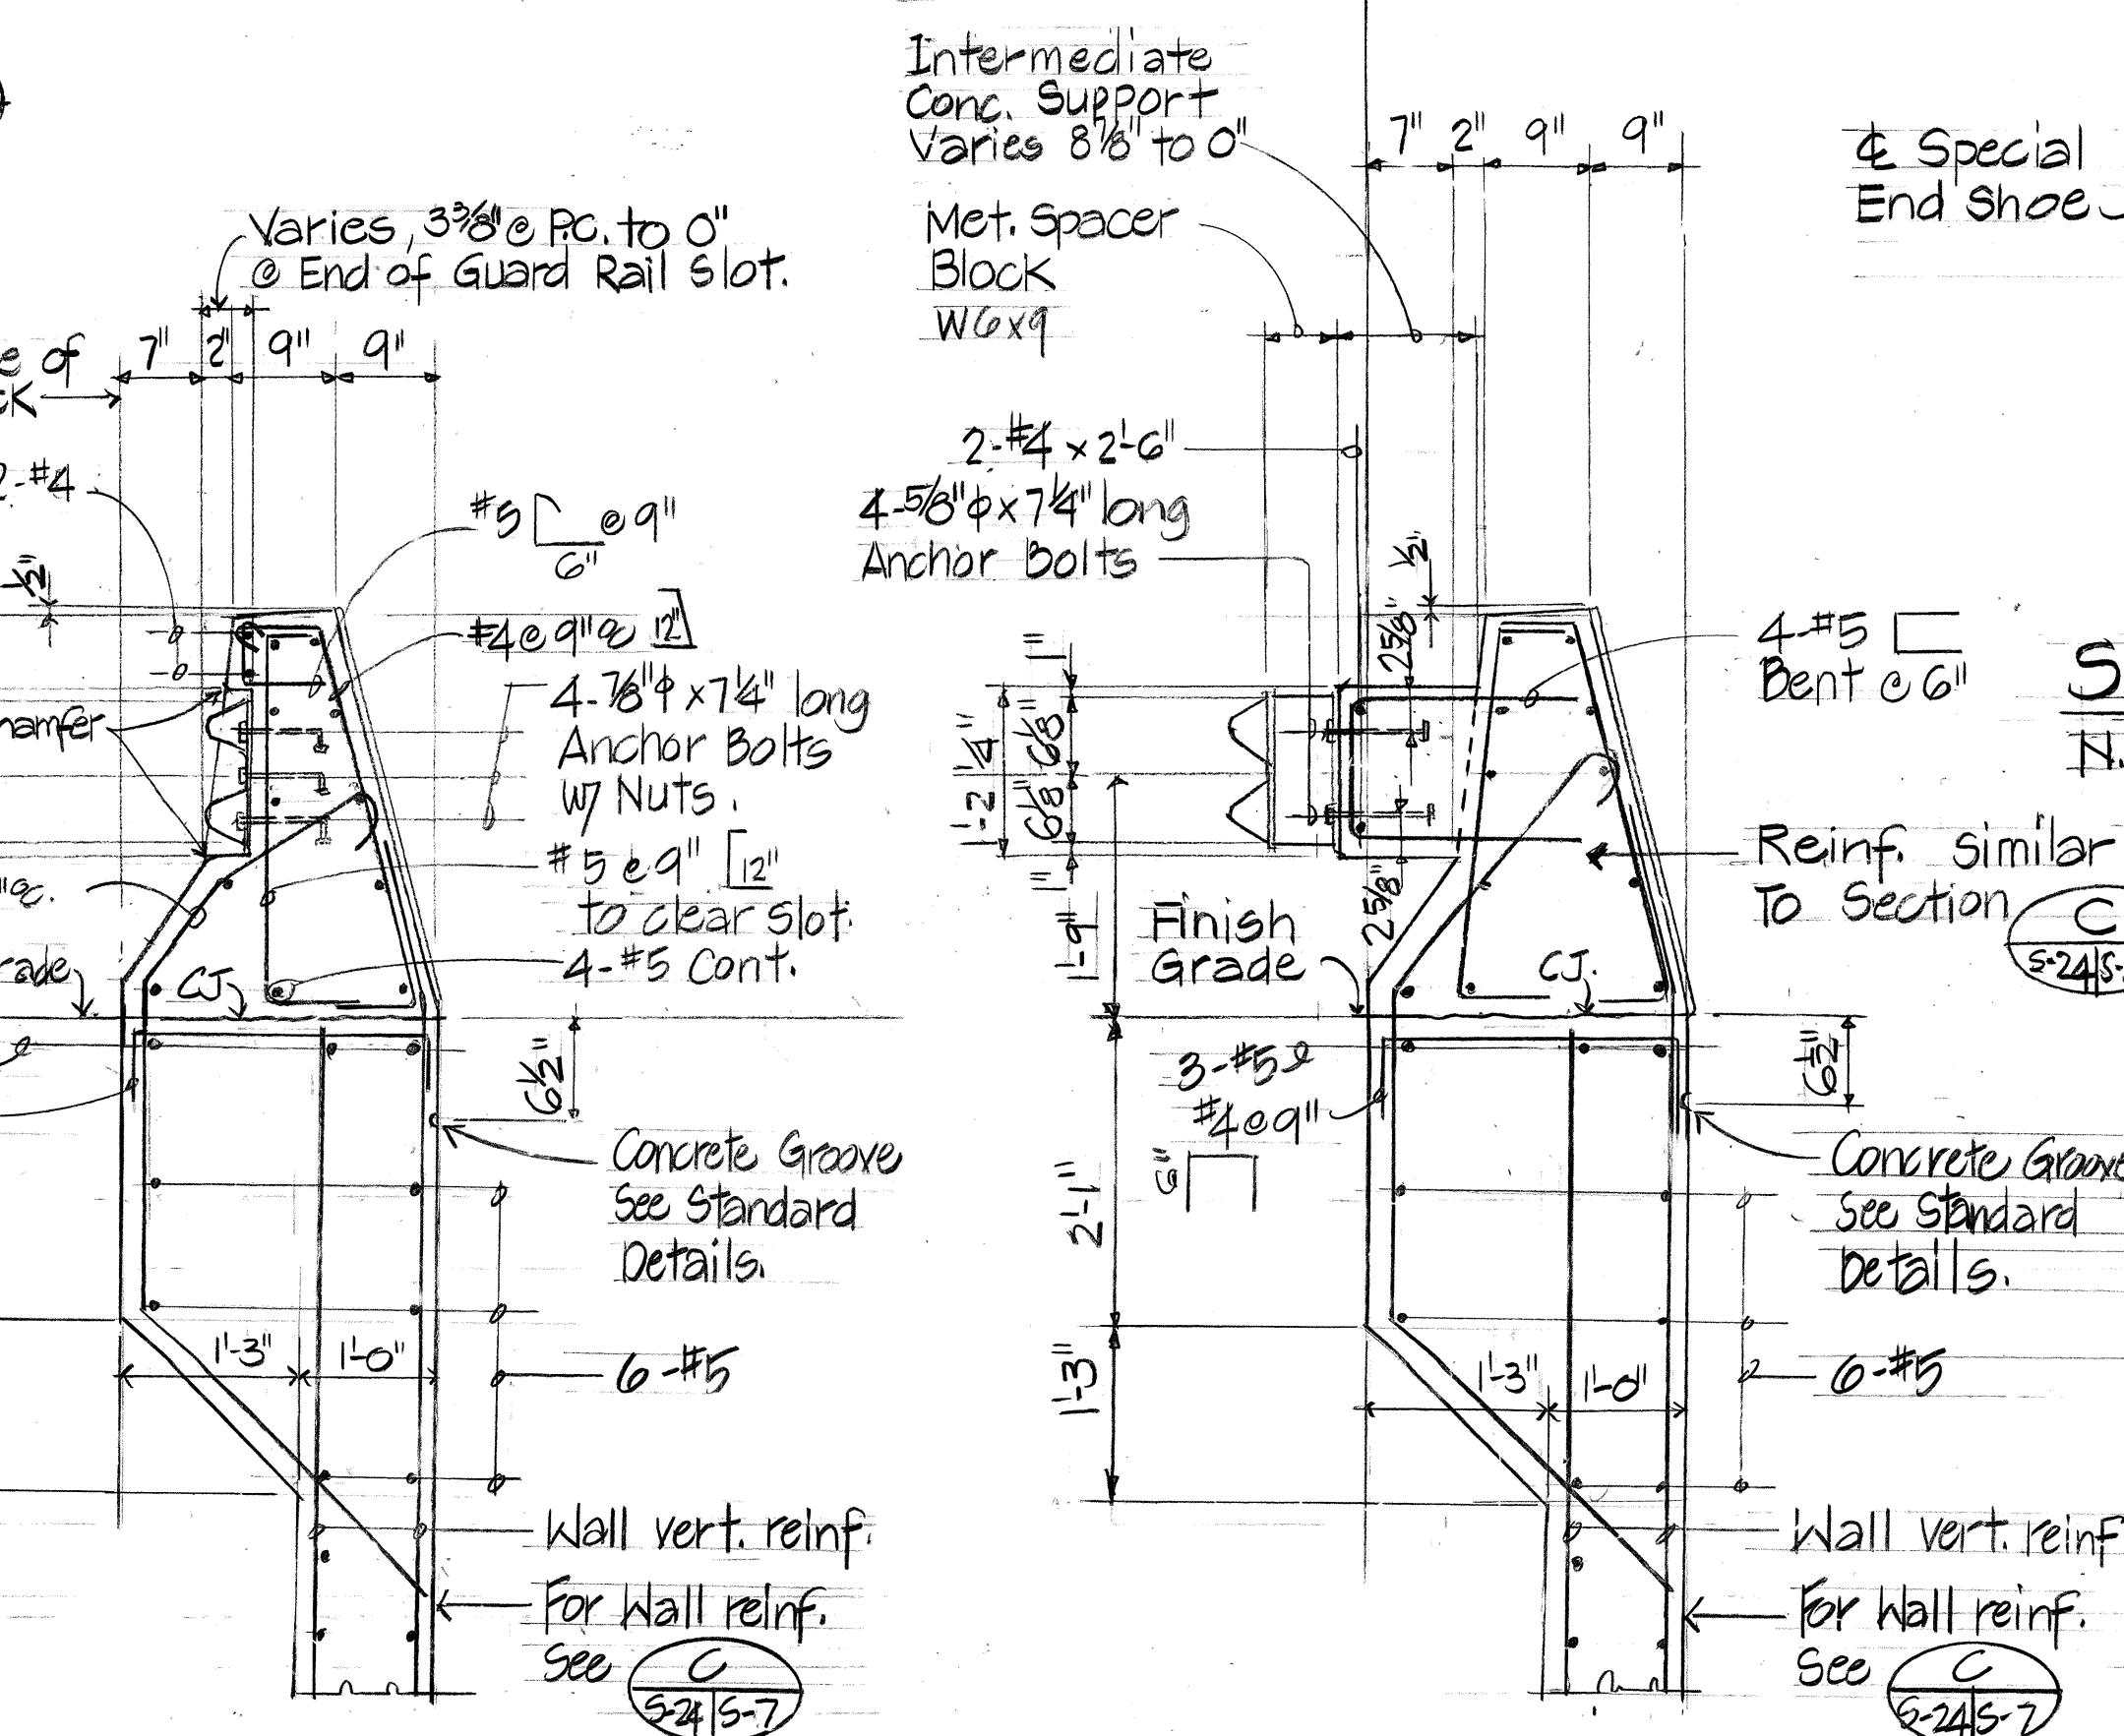

SECTION D
SC2 e: $3\frac{1}{4}'' = 1'-0''$ S-24 S-24

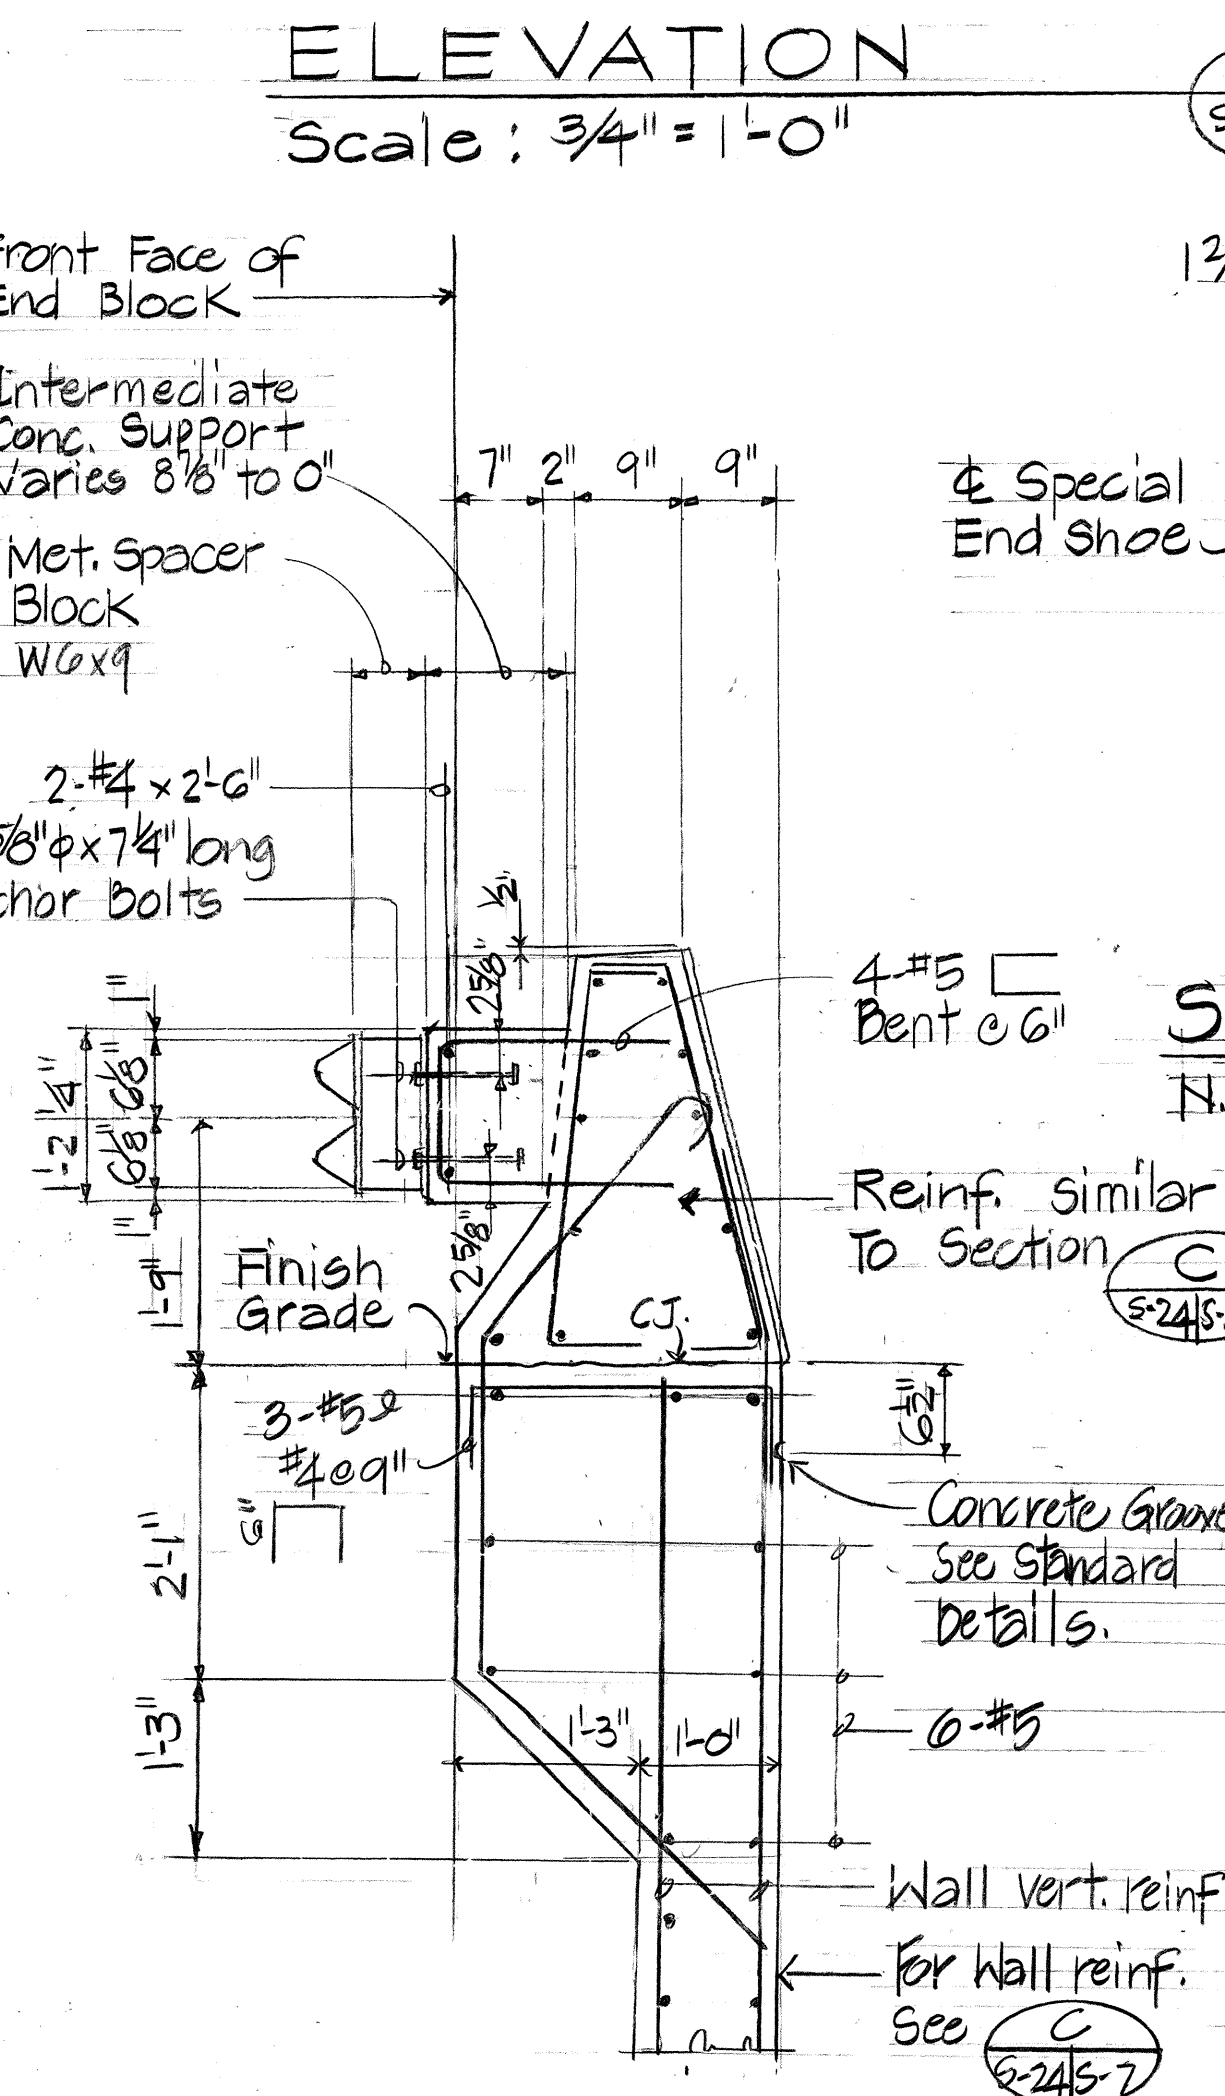

SECTION E
Scale: $3/4" = 1'-0"$ S-24 | S-24

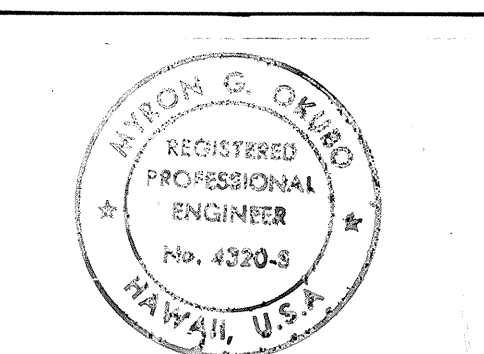

THIS WORK WAS PREPARED BY
ME OR UNDER MY SUPERVISION

Myron Okubo

END POST DETAILS

SAND ISLAND ROAD WIDENING
2 ND. BRIDGE AND APPROACHES
FEDERAL AID PROJECT NO. F-064-1(2)

SCALE: AS NOTED. DATE: JUN, 1986

SHEET No. 5.24 OF 30 SHEETS


DATE	REVISION
------	----------

FED. ROAD DIST. NO.	STATE	FED. AID PROJ. NO.	FISCAL YEAR	SHEET NO.	TOTAL SHEETS
HAWAII	HAW.	F-064-1(2)	1987	127	151

GENERAL NOTES

- Concrete strengths:
 - Typical pile: 28 day compressive strength $f'_c = 5000$ psi.
 - Pile build-up with driving: 28 day compressive strength $f'_c = 5000$ psi.
 - Pile build-up without driving: Identical 28 day f'_c as footing or pile cap.
- Reinforcing steel shall conform to the following ASTM specifications:
 - Bar reinforcement: ASTM A615 Grade 40
 - Spiral reinforcement: ASTM A82
 - Prestressing strand: ASTM A416 Grade 270
- Splice can:
 - Structural steel shall conform to ASTM A36
 - All welding shall meet the requirements of Section 501 of the Standard Specification.
 - No measurement for payment shall be made for the splice can as it shall be considered incidental to the driving of the pile.
- Piles accepted by the Engineer shall be of sound concrete. Damaged piles shall be replaced or repaired by the Contractor at his expense as directed by the Engineer.
- Work of cutting off prestress concrete piles or concrete pile build-ups shall be performed in such a manner as to avoid spalling or damaging the pile below cut-off. Damaged portions shall be removed and pile cut-off elevation lowered as required by the Engineer.
- Top of pile at cut-off line shall be prepared as required for construction joints in Section 503 of the Standard Specifications.
- Pile splice shall not be permitted except for pile length in excess of 100 feet unless otherwise approved by Engineer.
- The in-place length of pile above the splice shall be approximately 50% of the total length of pile driven, unless location of splice is indicated in the plans or specifications.
- Build-ups may be driven after the concrete attains a compressive strength of 4000 psi., but not earlier than 7 days after the concrete is poured. Use of pile build-up is not permitted at Footings for Piers 1, 2, 3 and 4.
- Pile splice shall not be permitted at Foundations for Piers 1, 2, 3 and 4.
- The minimum working force in the Prestressing steel shall be 165 kips for 16 1/2" Prestressed Concrete Piles and 375 kips for 20" Square Prestressed Concrete Piles.

- Should the Contractor elect to drive piles with a follower, details (size, length, weight, material, etc.) of the follower to be used shall be submitted to the Engineer for approval.

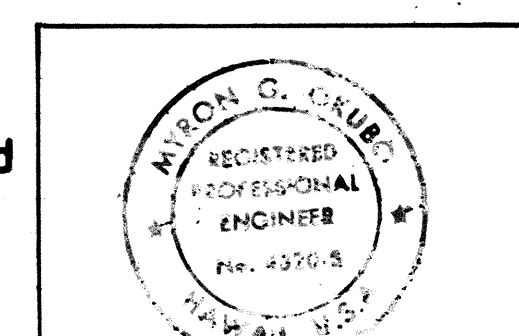

THIS WORK WAS PREPARED BY ME OR UNDER MY SUPERVISION

Wilson O. Mendes


STATE OF HAWAII
DEPARTMENT OF TRANSPORTATION
HIGHWAYS DIVISION

PRESTRESSED CONCRETE PILES-DETAILS


SAND ISLAND ROAD WIDENING
2ND BRIDGE AND APPROACHES
FEDERAL AID PROJECT NO. F-064-1(2)

Scale: As Noted Date: JUN, 1986

SHEET NO. S-25 OF 30 SHEETS

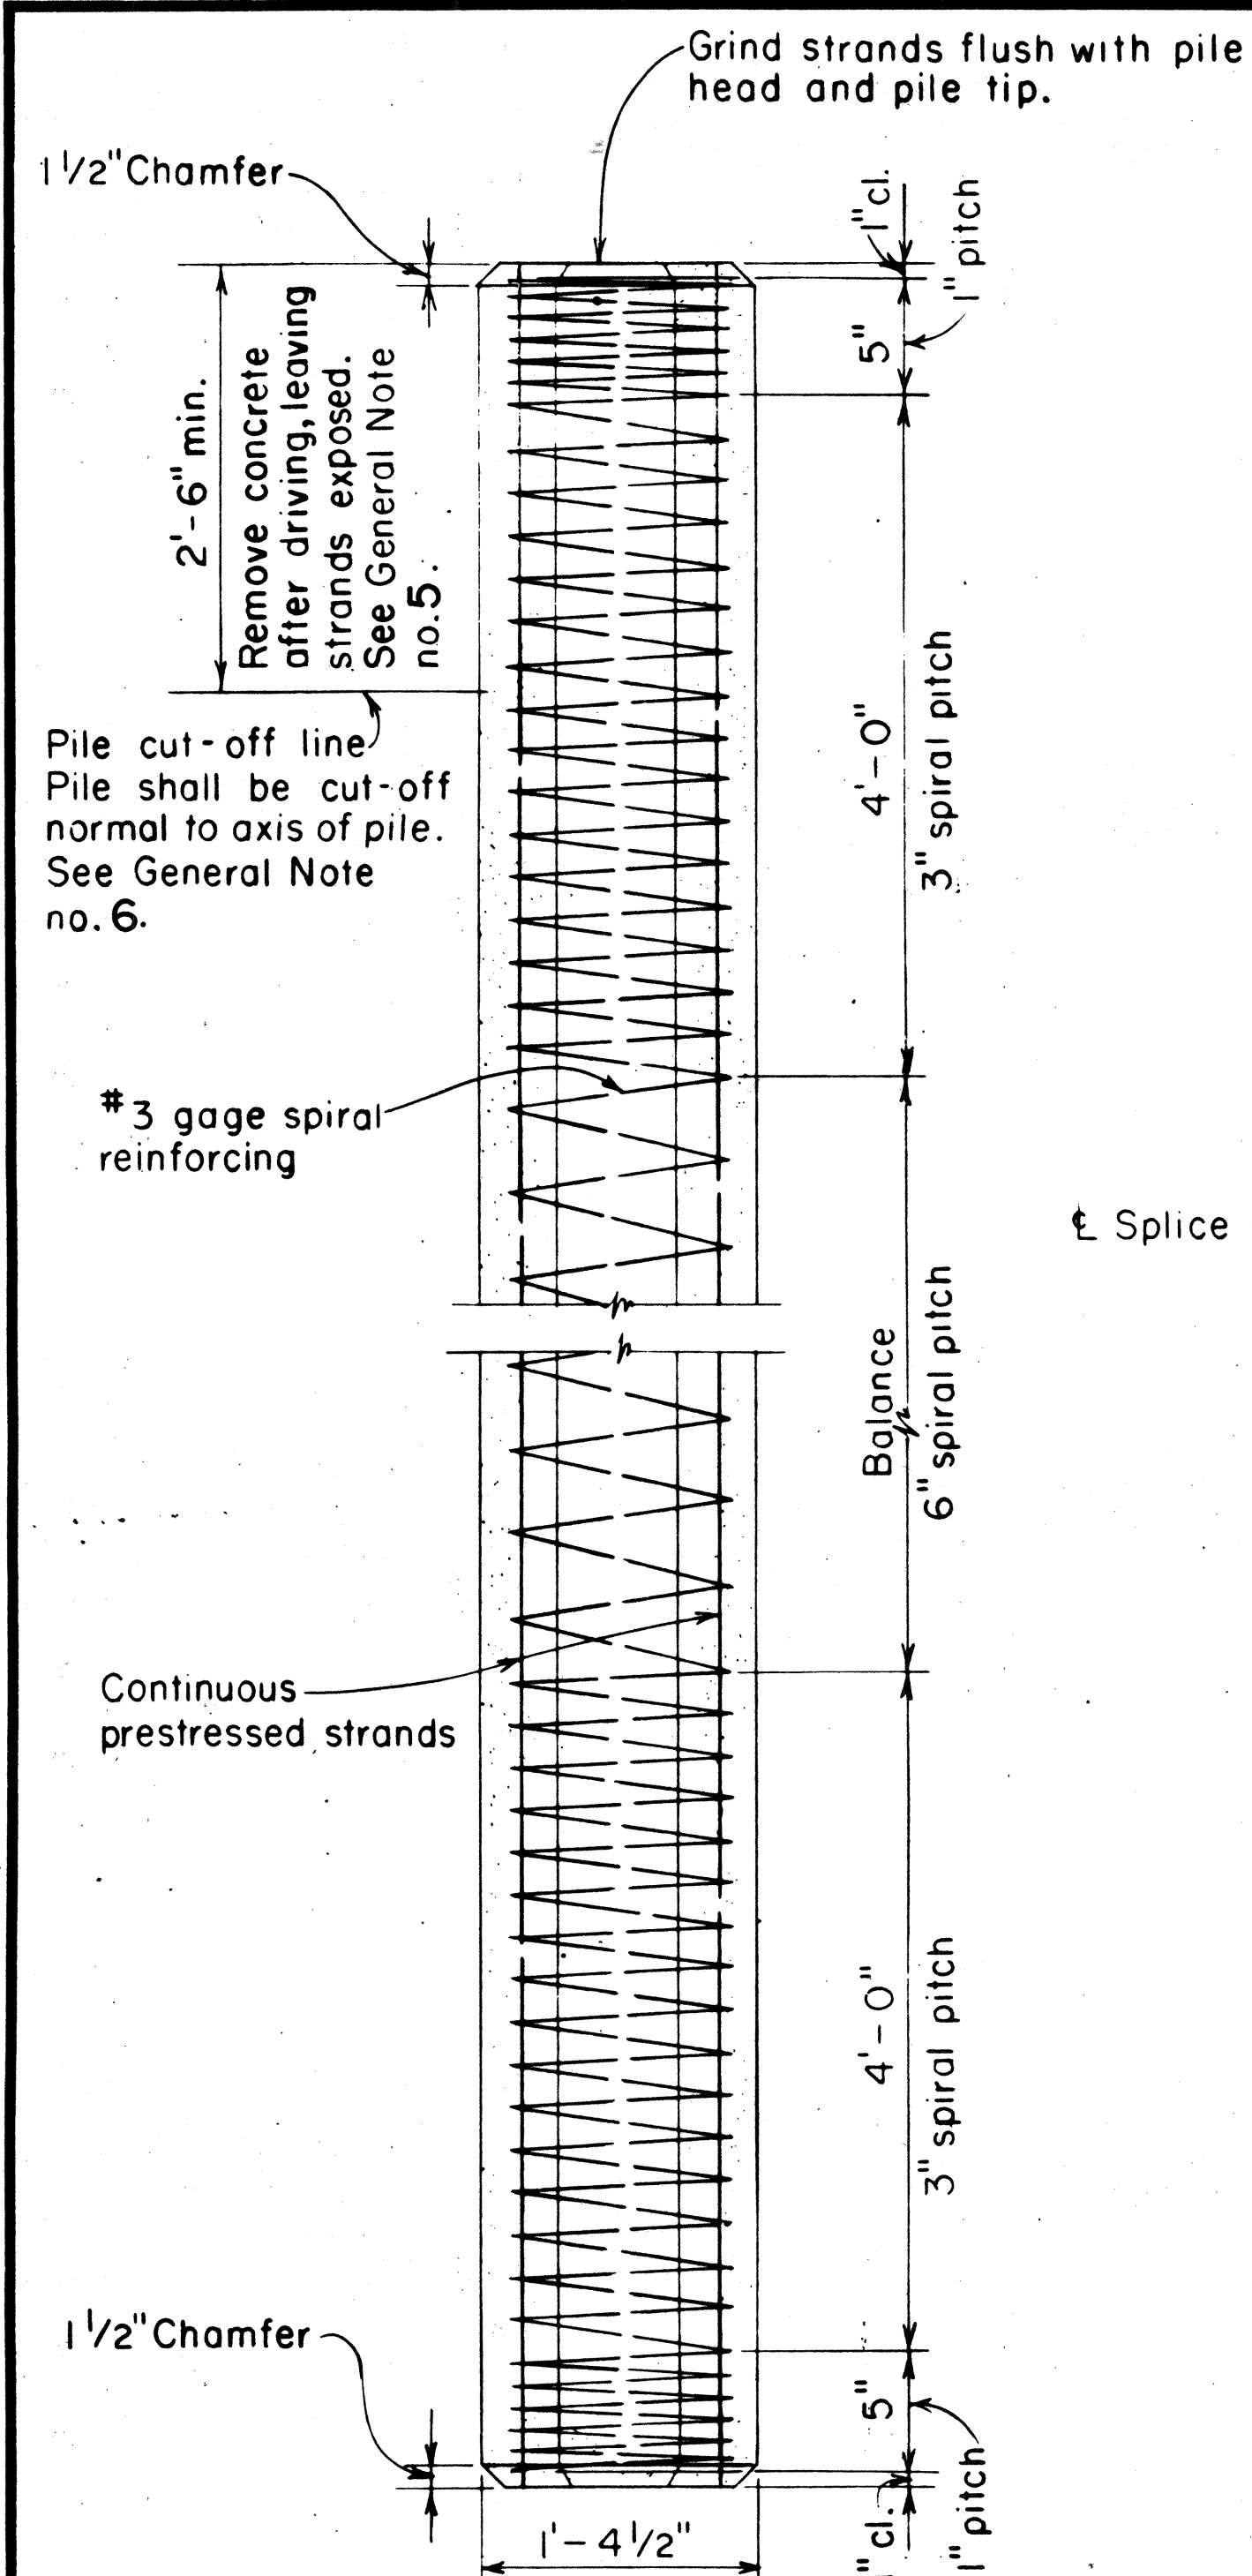


ELEVATION

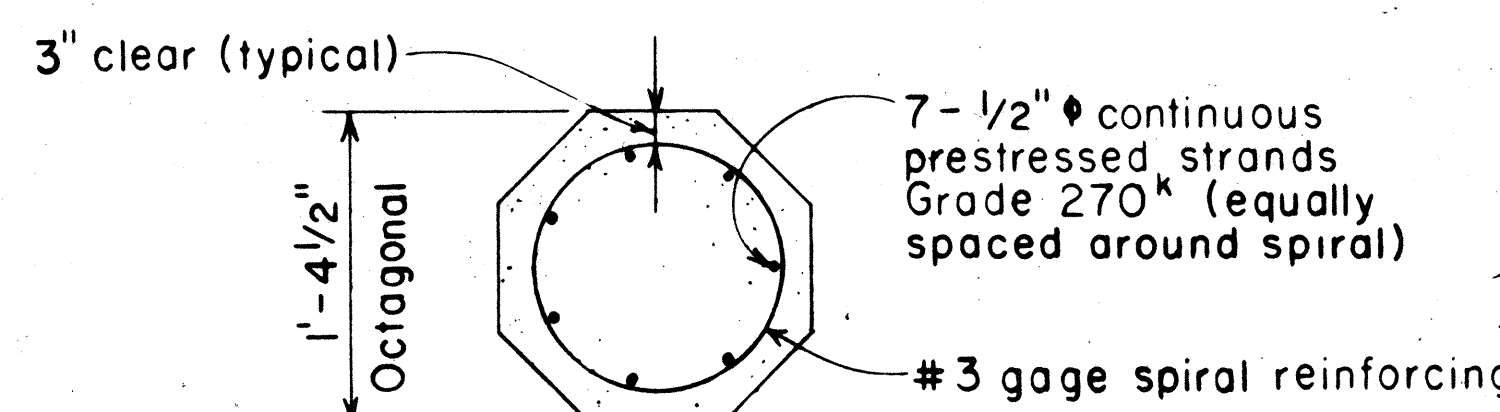

SECTION

16 1/2" PRESTRESSED CONCRETE PILE


Not to scale.

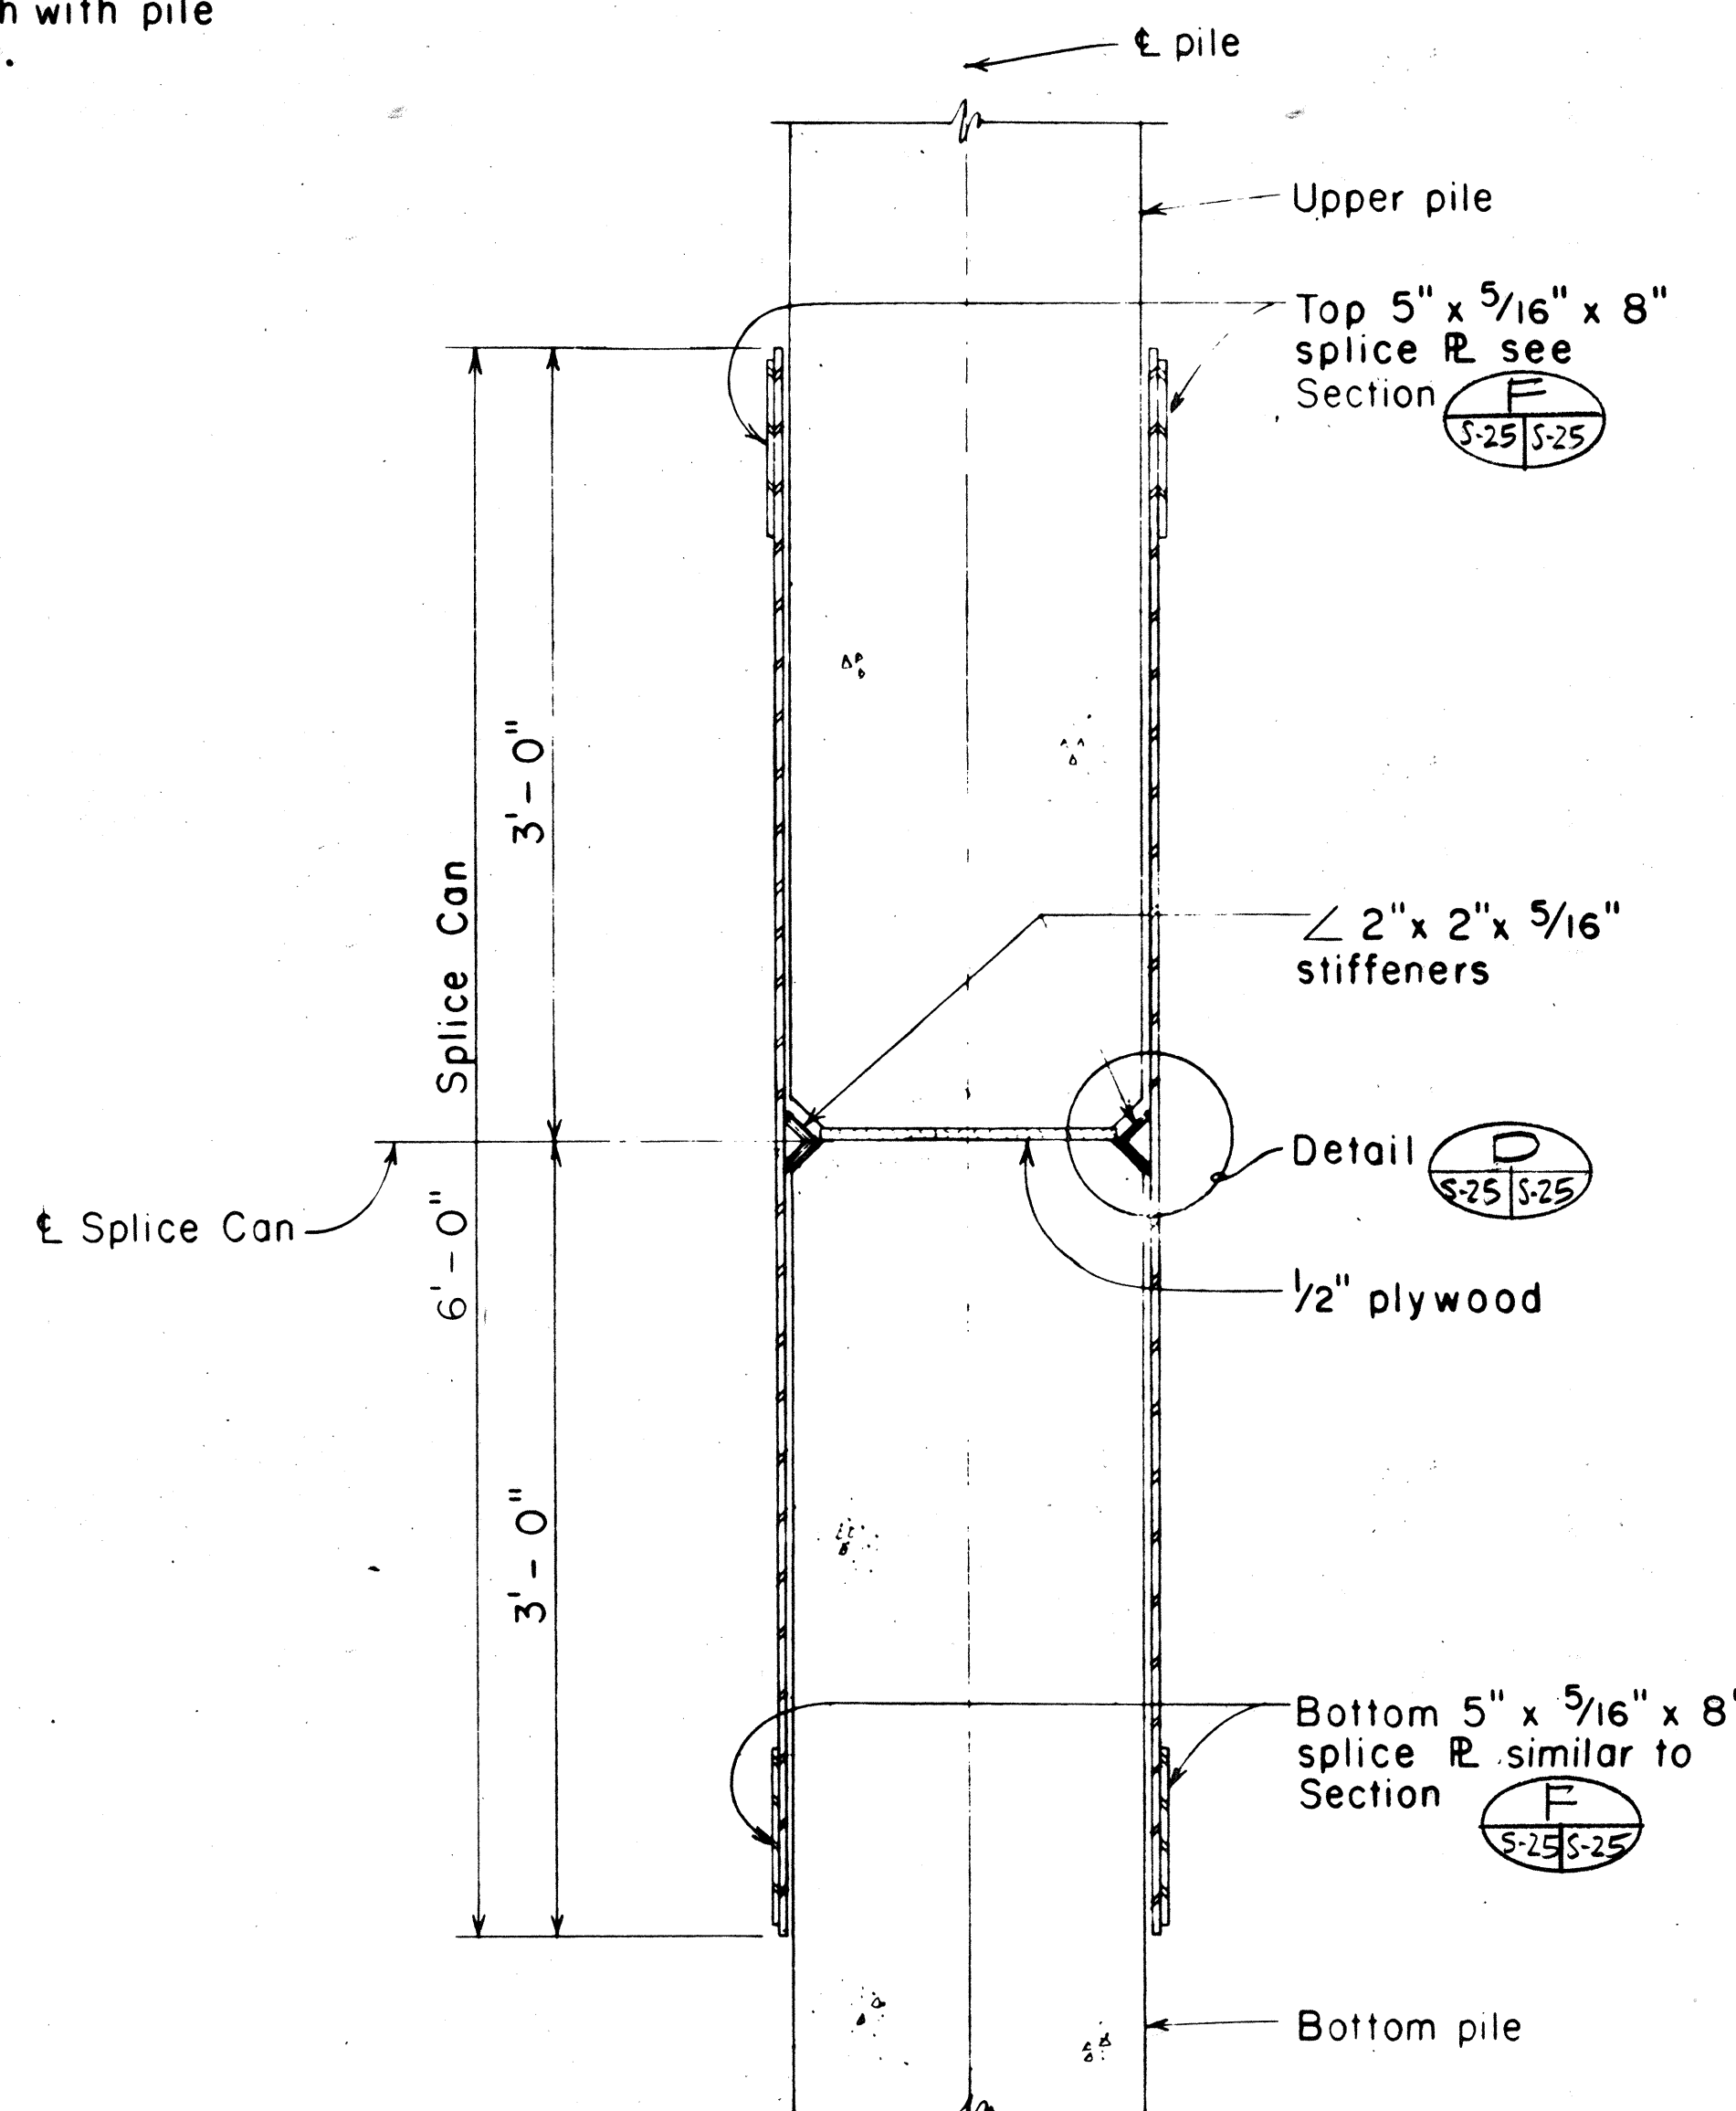

SECTION


Scale: 1 1/2" = 1'-0"

TYPICAL PILE SPLICE DETAILS

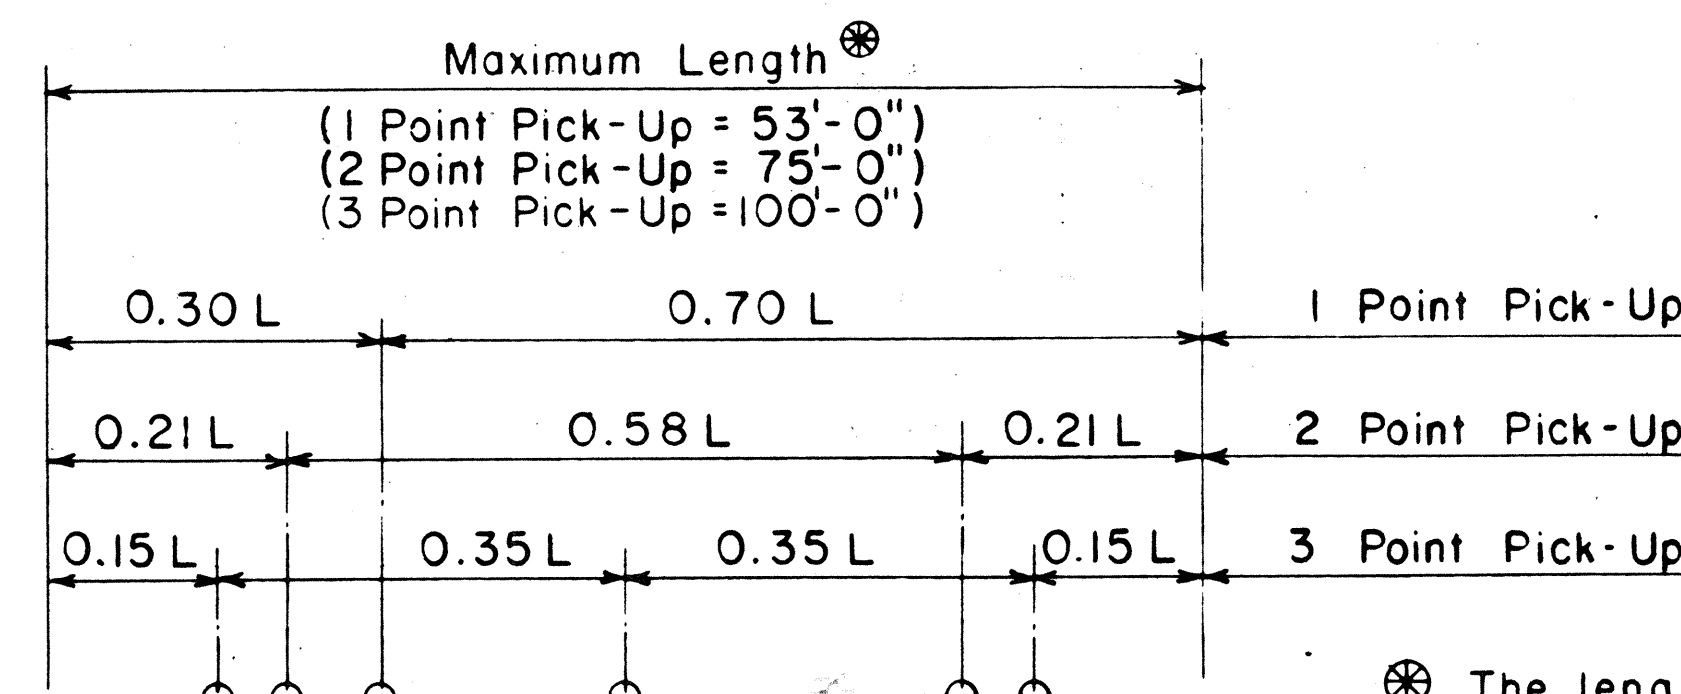


PILE PICK-UP POINTS

Not to scale

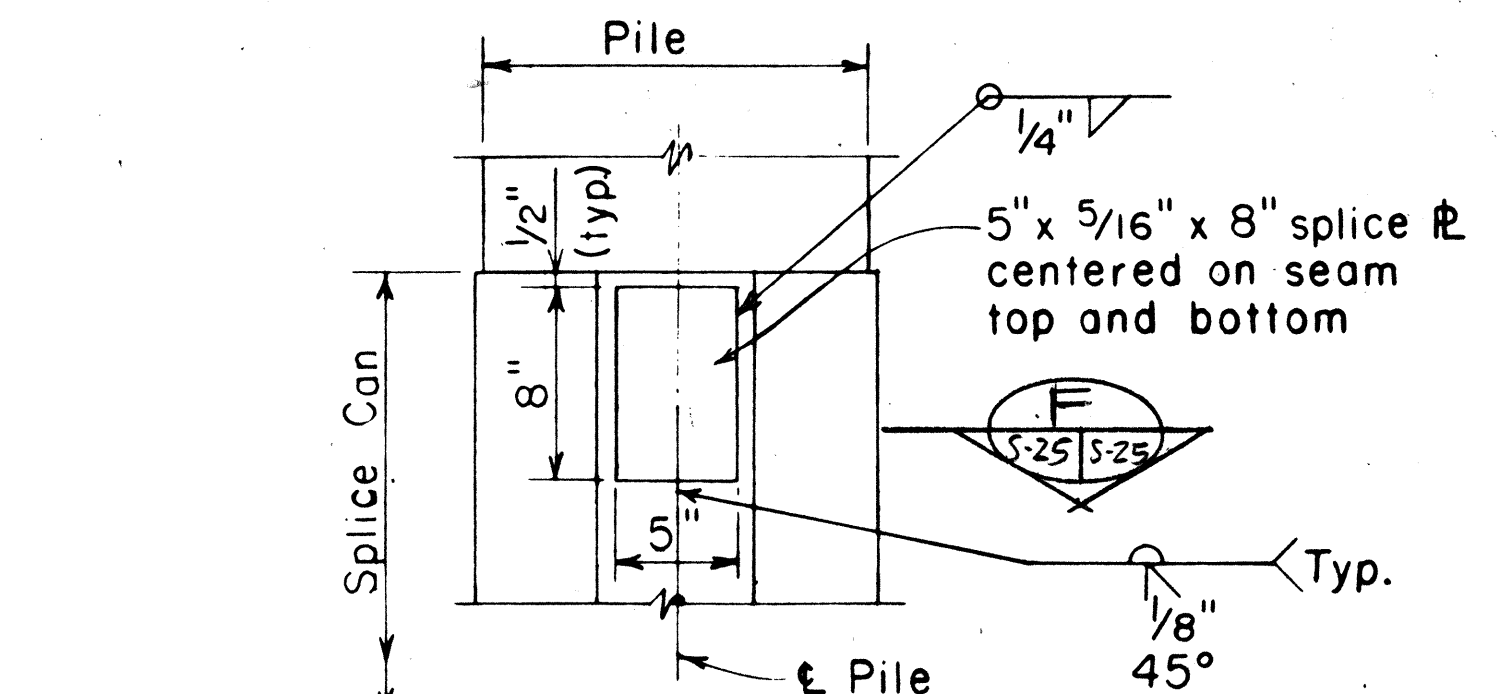


SECTION

Scale: 1 1/2" = 1'-0"

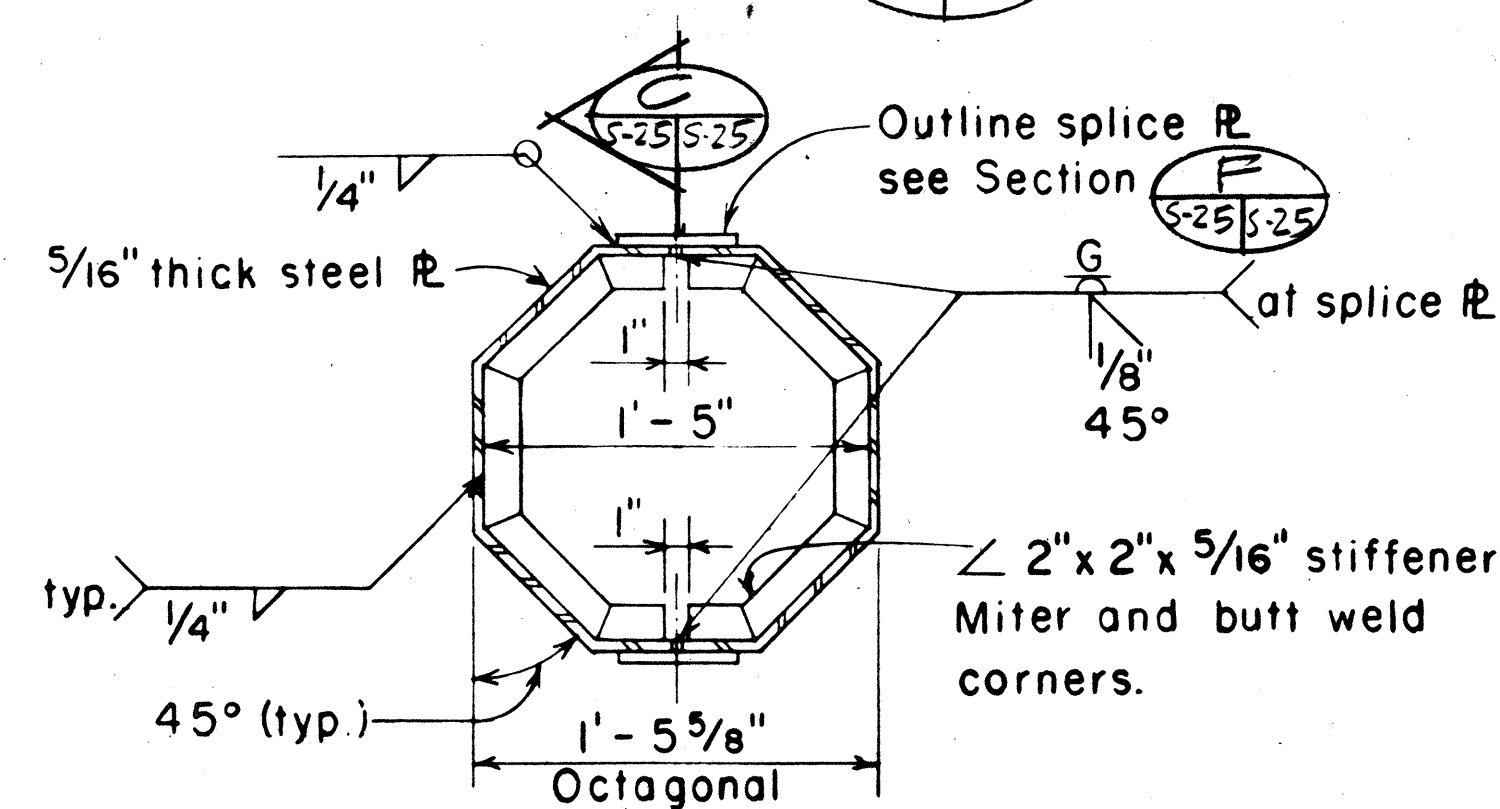


SECTION

Scale: 1 1/2" = 1'-0"

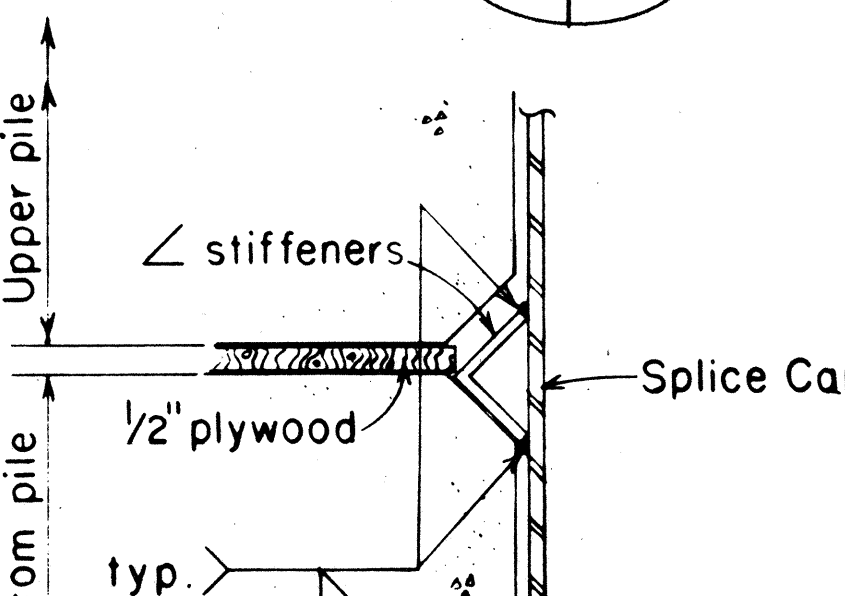

DETAIL

Scale: 3" = 1'-0"

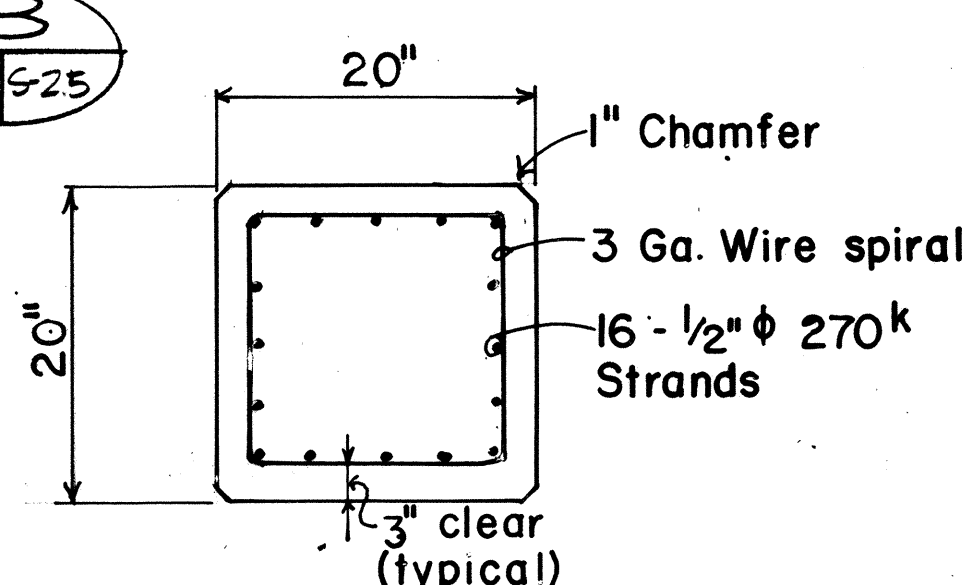

SECTION


20" SQUARE
PRESTRESSED
CONCRETE PILE

Scale: 1" = 1'-0"

The length "L" is the distance end to end of pile.

DATE REVISION

FED. ROAD DIST. NO.	STATE	FED. AID PROJ. NO.	FISCAL YEAR	SHEET NO.	TOTAL SHEETS
HAWAII	HAW.	F-064-12	1987	128	151

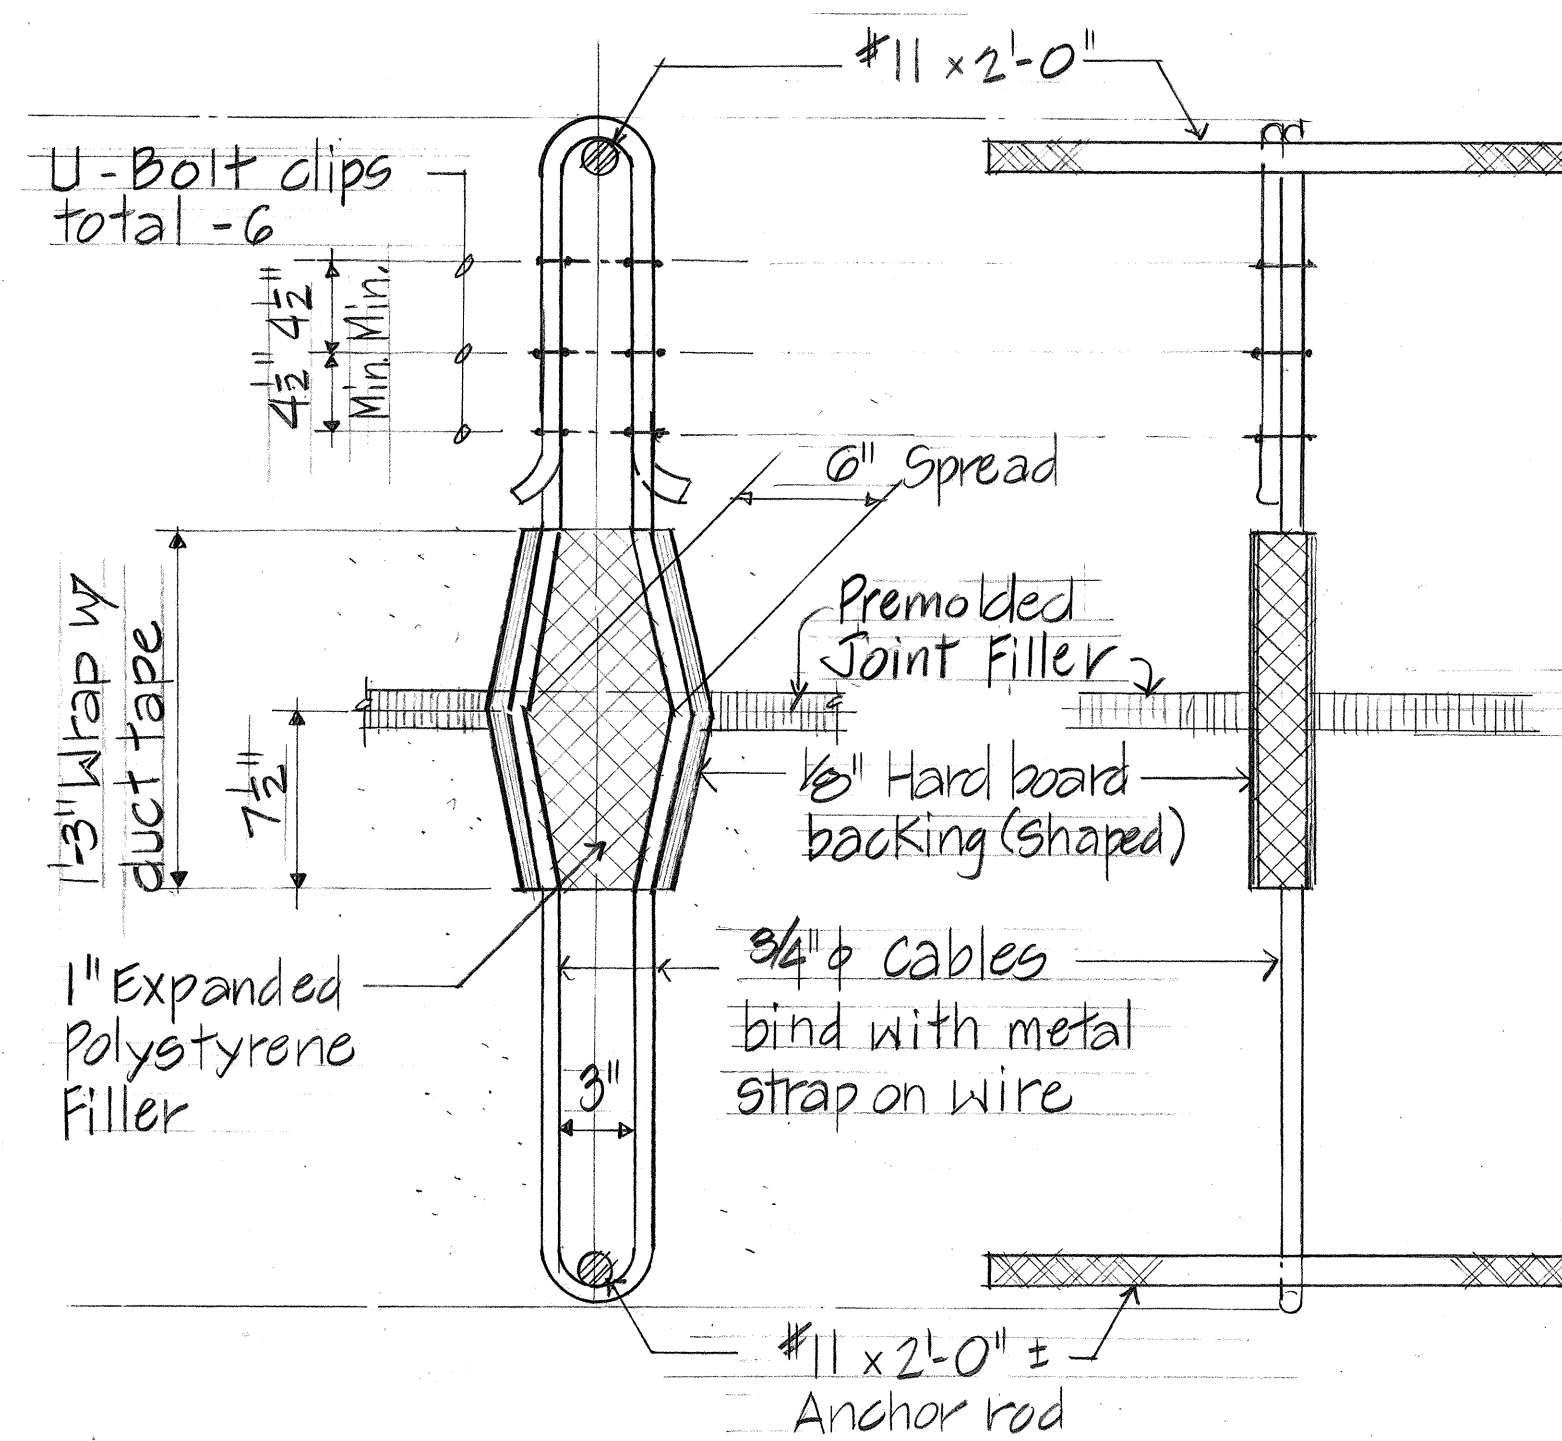


ELEVATION SECTION

VERTICAL RESTRAINER TYPICAL DETAIL

Not to scale!

Notes:


1. Restrainer Assemblage shall be securely held in place while placing concrete.
2. Restrainer Assemblage shall be considered Incidental to Concrete in Bridge.

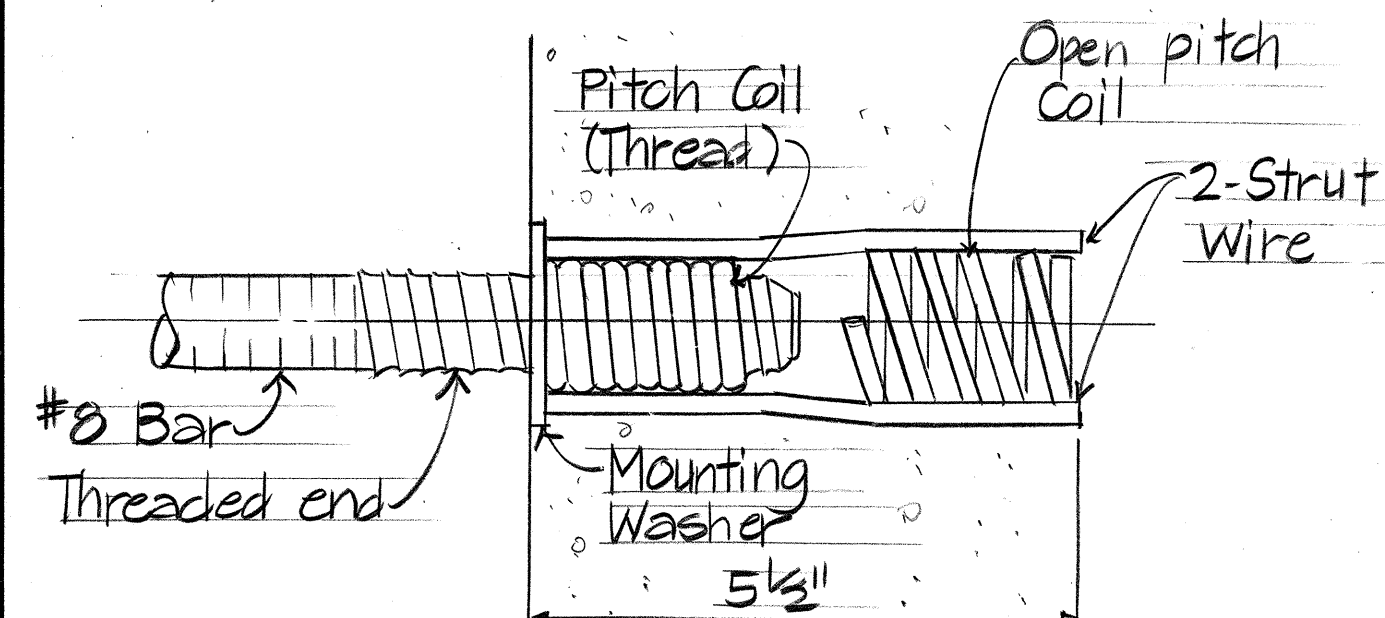

Inserts to develop Minimum
ultimate pull out value of 24 Kips.
Inserts shall be considered incidental
to concrete Bridge.

INSERT DETAIL

N.T.S.

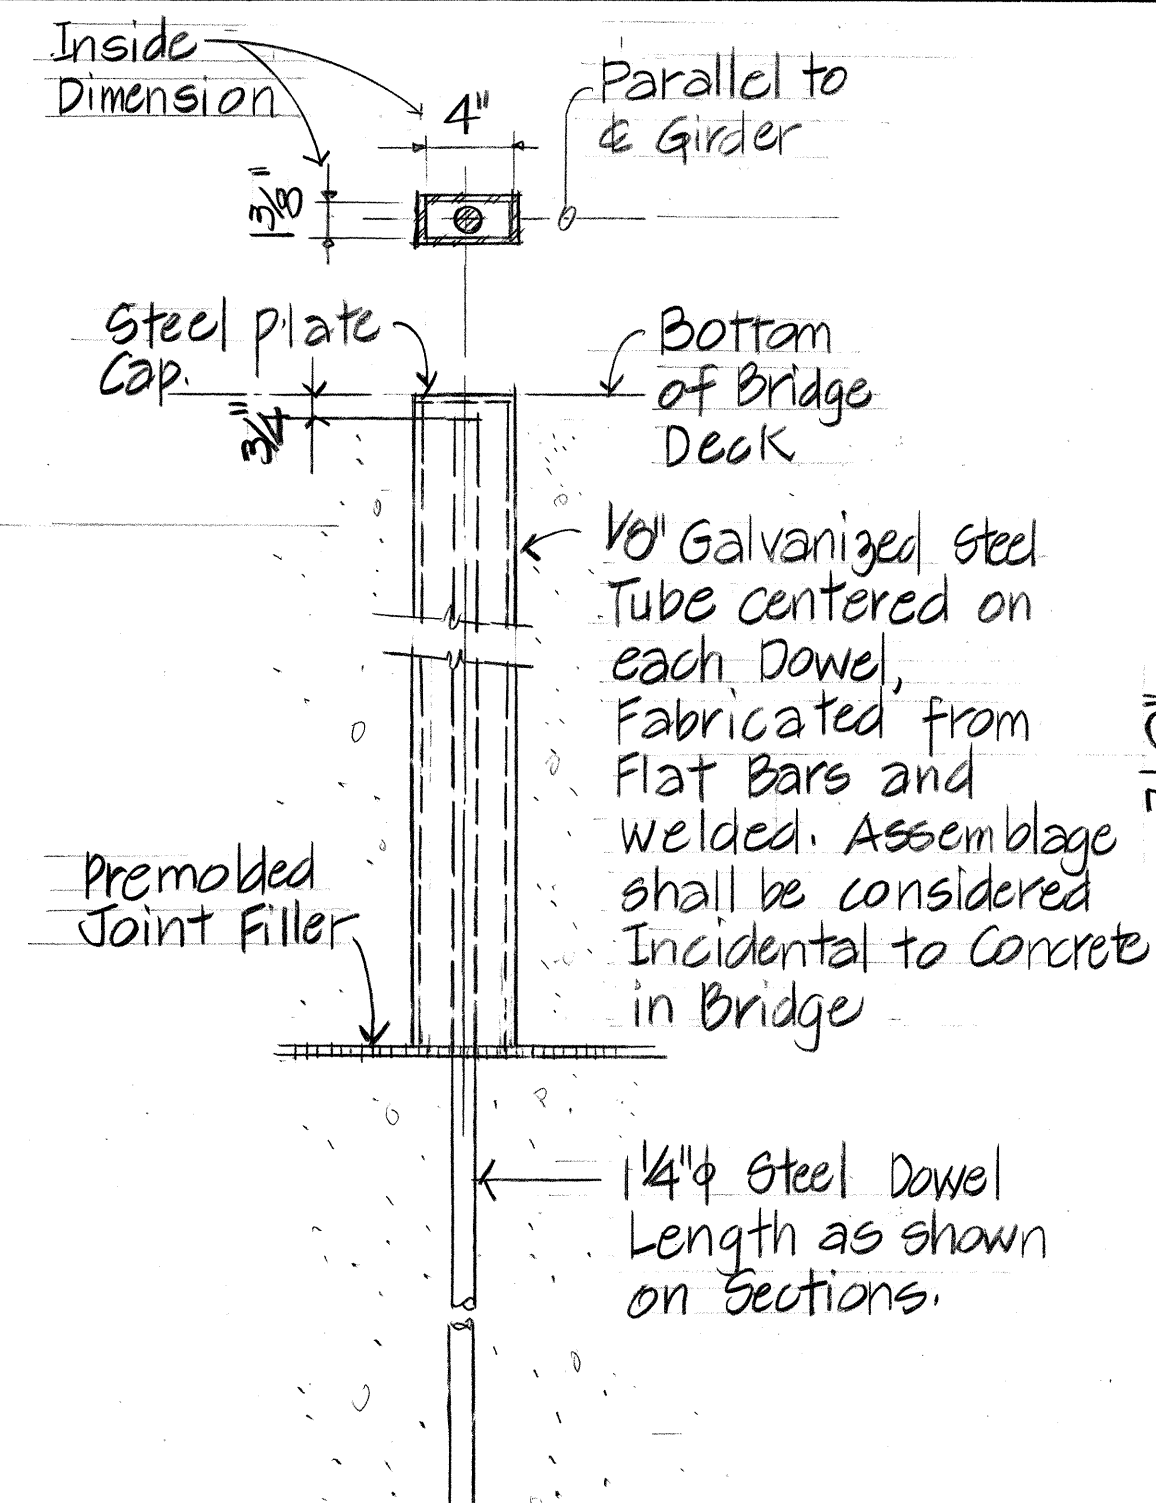


SECTION

1 1/4" ϕ STEEL DOWEL

Not to scale:

Notes:

1. At Expansion Joints, Tubes shall be filled with Tar or Mastic. Tubes shall be filled prior to pouring Deck Concrete.
2. Tubes shall be capped by welding on a $\frac{1}{2}$ " Steel Plate after inspection following End Diaphragm pour and prior to deck pour.
3. At Hinge Joints steel Tube shall be omitted, and $\frac{1}{2}$ " premolded joint filler attached at ends of dowel.

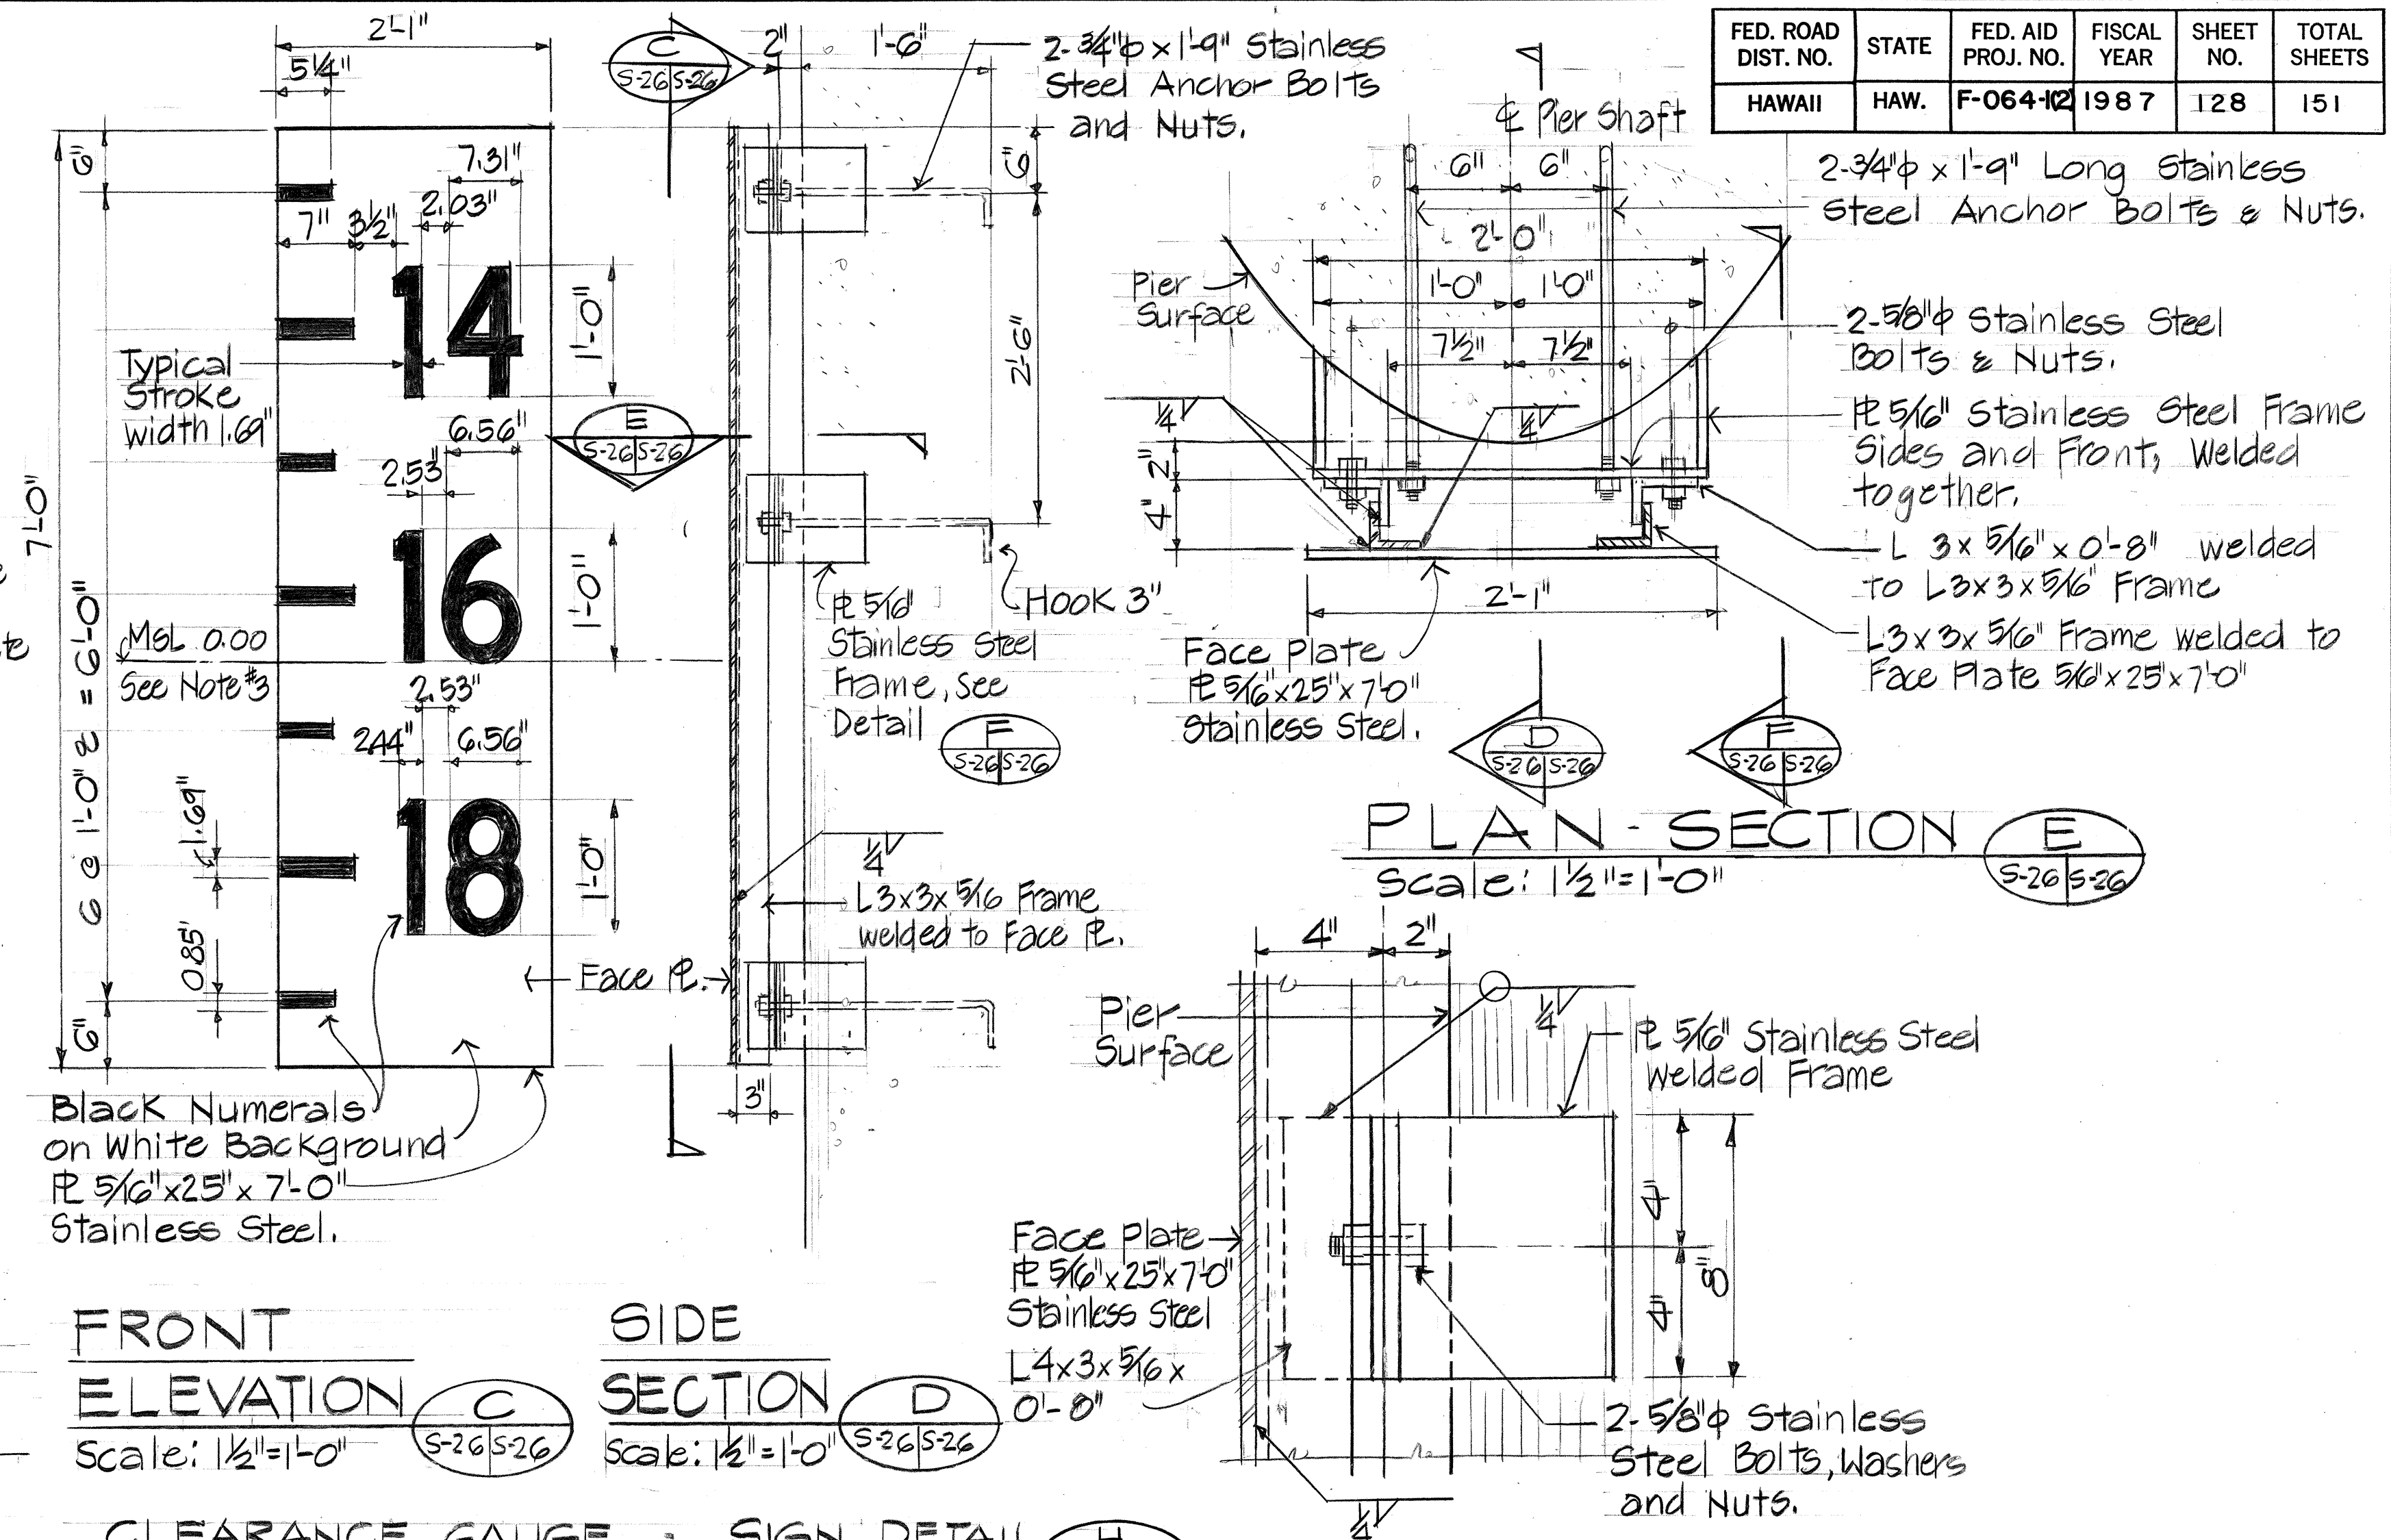

PLAN - SECTION E

Scale: $\frac{1}{2}'' = 1'-0''$

S-26 S-26

FRONT

ELEVATION

Scale: $\| \frac{1}{2} \| = \| 1 - 0 \|$

SIDE

SECTION

Scale: $\frac{1}{2}'' = 1'$

CLEARANCE GAUGE - SIGN DETAIL

1. All Stainless Steel Items to be Type 316.
2. Numerals shown detailed per "Standard Alphabets For Highways Signs", U.S. Dept. of Transportation, Fed. Highway Administration, Series "C".
3. Place Clearance Gauge so that El. = 0.00 MSL. Aligns with 16.50 Mark on gauge.
4. The Clearance Gauge shall be painted to conform to SSPC-PS 4.01, Four Coat Vinyl Painting System with Red Lead Primer.
5. Clearance Gauge shall be consider incidental to Concrete in Bridge.

DETAIL F
Scale: 3" = 1'-0" S-26 S-26

ORIGINAL PLAN	SURVEY PLOTTED BY _____ DATE _____
NOTE BOOK	DRAWN BY _____
	TRACED BY _____
	DESIGNED BY _____
	QUANTITIES BY _____
	CHECKED BY _____
No. _____	



THIS WORK WAS PREPARED BY
ME OR UNDER MY SUPERVISION

Myron Okubo

STATE OF HAWAII
DEPARTMENT OF TRANSPORTATION
LAND TRANSPORTATION FACILITIES DIVISION
MISCELLANEOUS DETAILS

SAND ISLAND ROAD WIDENING
2ND. BRIDGE AND APPROACHES
FEDERAL AID PROJECT NO. F-064-1(2)

SCALE: AS NOTED DATE: JUN, 1986





SHEET No. S-26 OF 30 SHEETS

DATE	REVISION
------	----------





FED. ROAD DIST. NO.	STATE	FED. AID PROJ. NO.	FISCAL YEAR	SHEET NO.	TOTAL SHEETS
HAWAII	HAW.	F-064-1 (2)	1987	129	151

Notes:





1. See Electrical Plans for all Electrical Conduits, Wiring, Junction Box, and Other Attachments.
2. For Navigation Lights, Center Channel Lights, See Electrical Plans.
3. Anchor Bolts shown on Details shall be verified to conform to Manufacturers Requirements.
4. Anchor Bolts to be placed accurately with the use of a Template.
5. Anchor Bolts to be Stainless Steel Type 316.

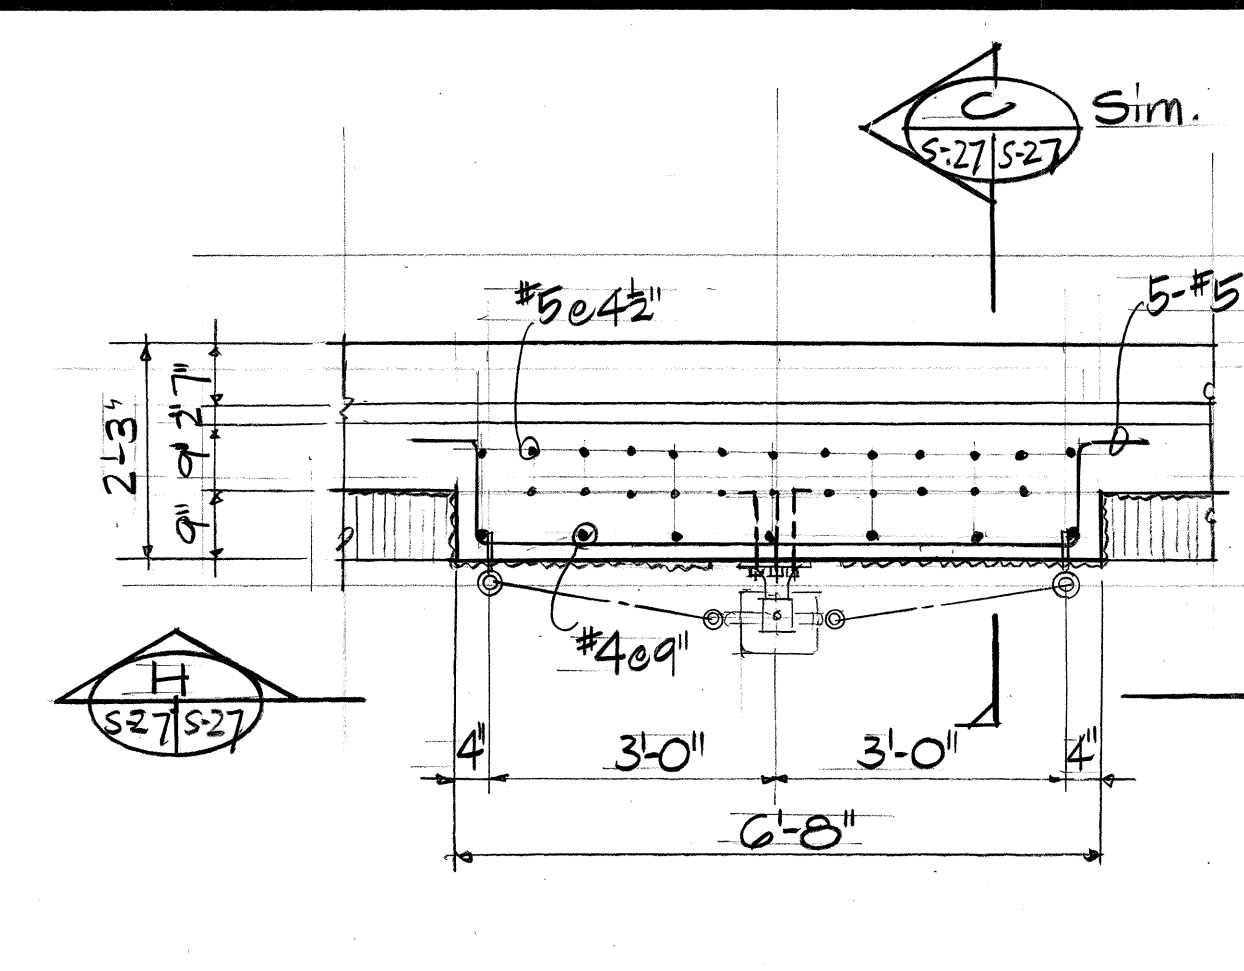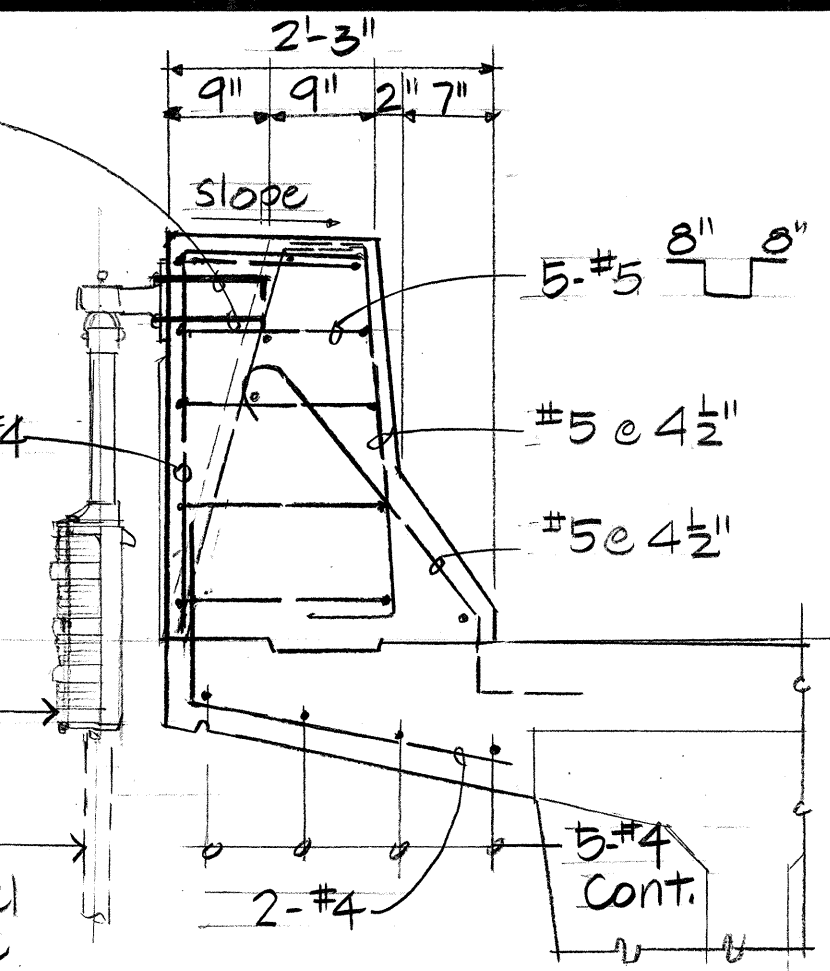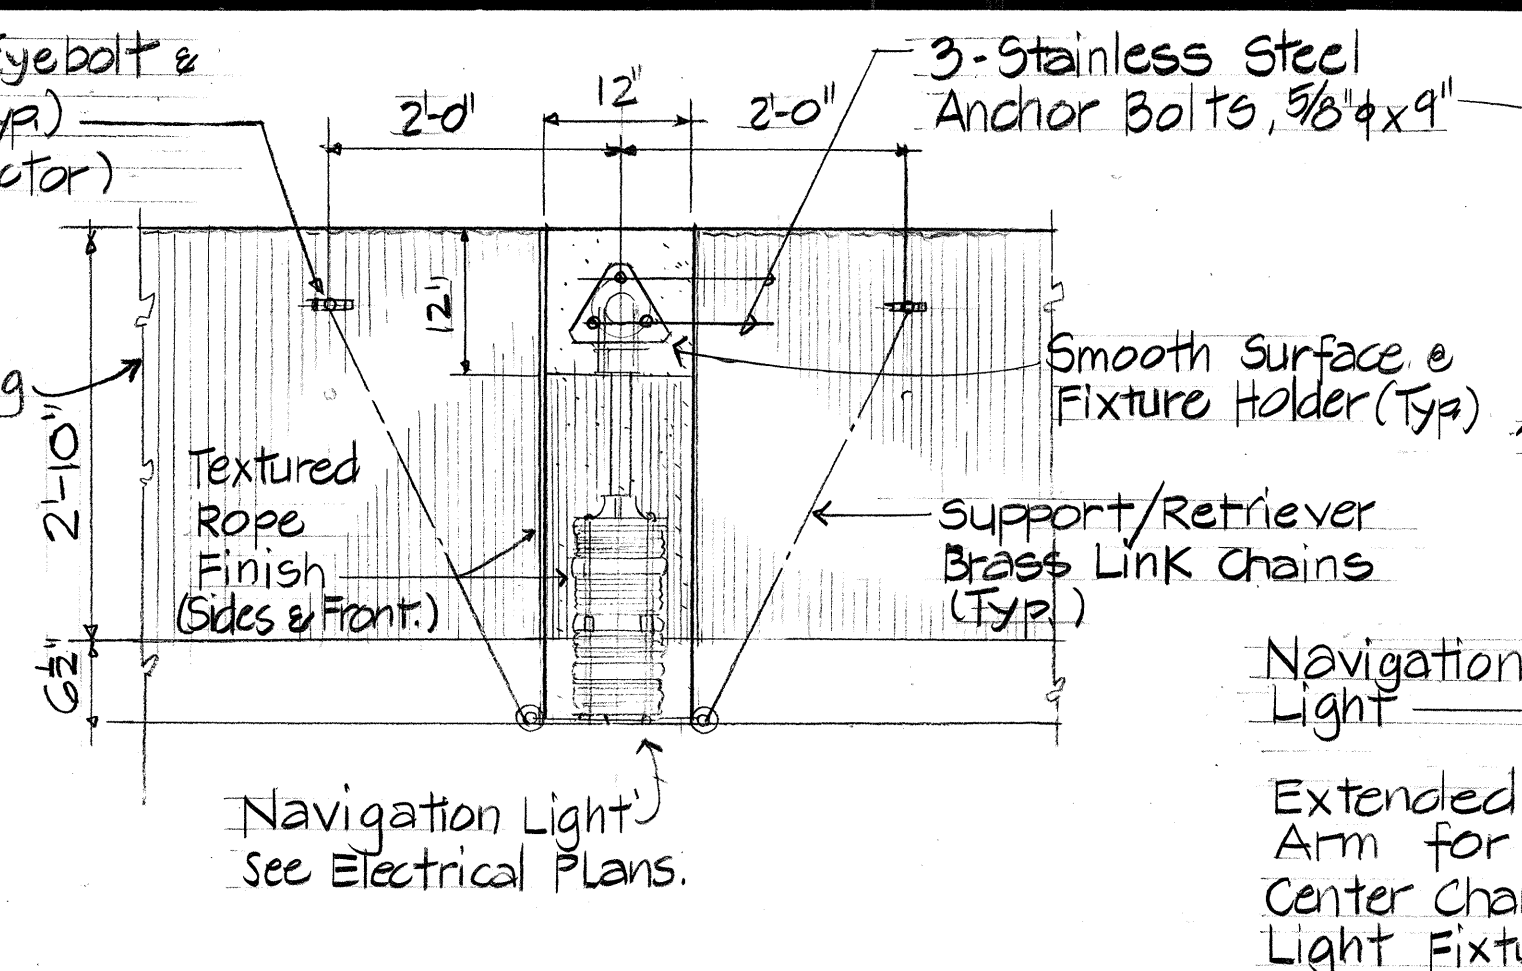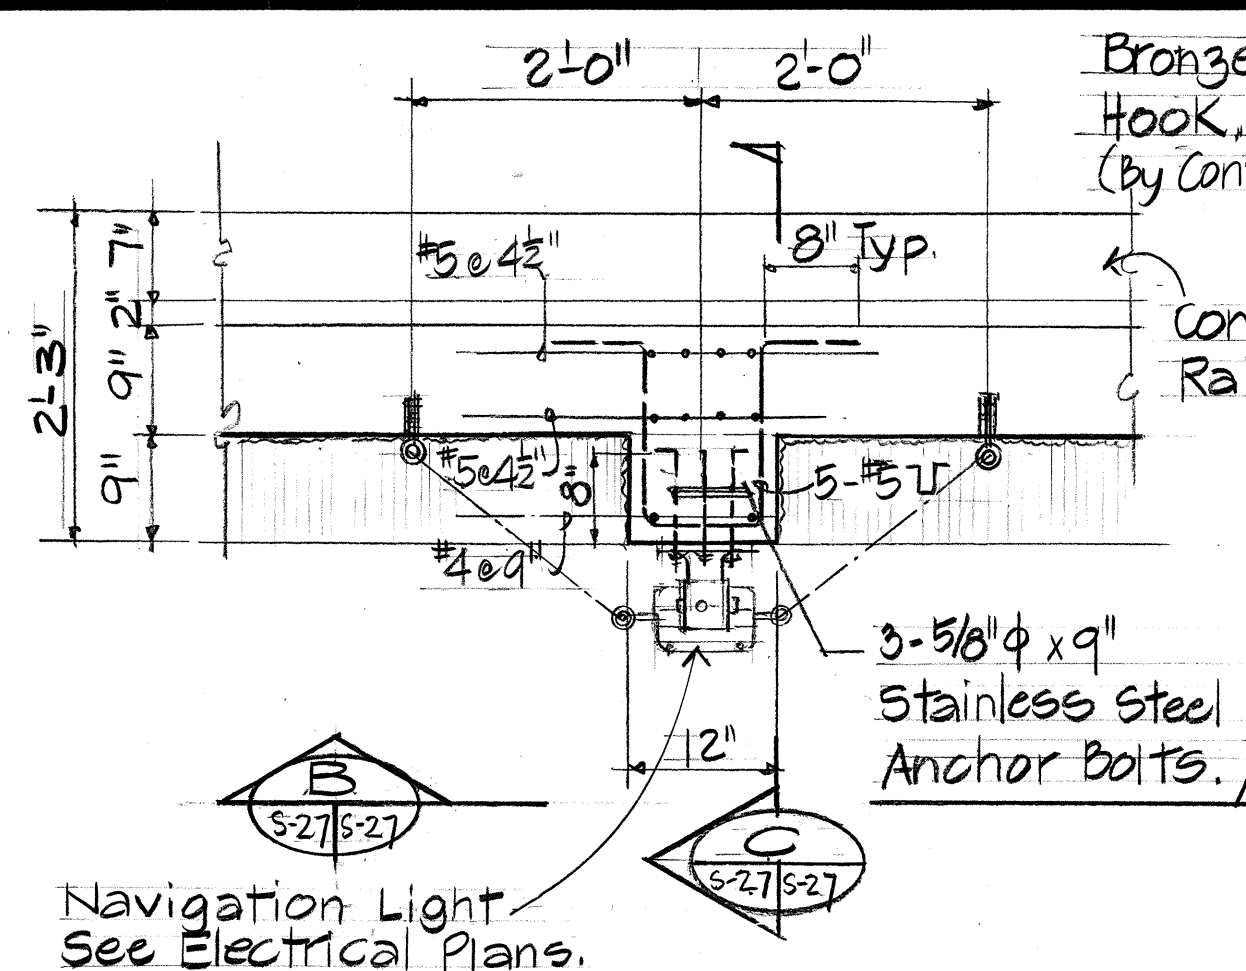


Notes:

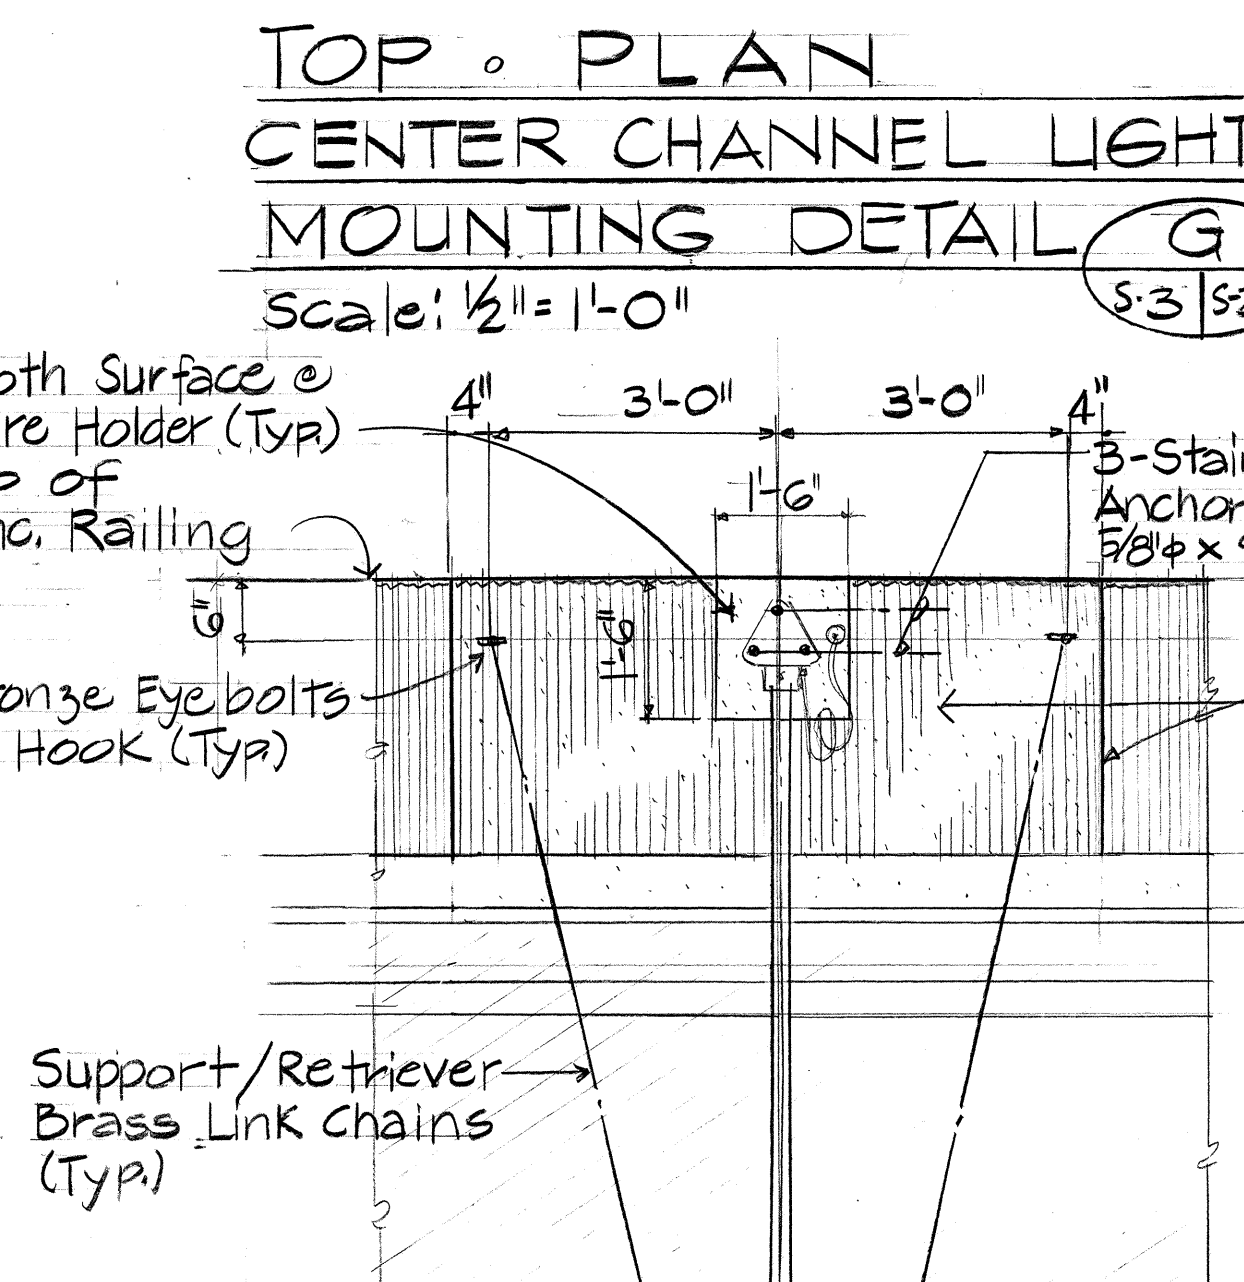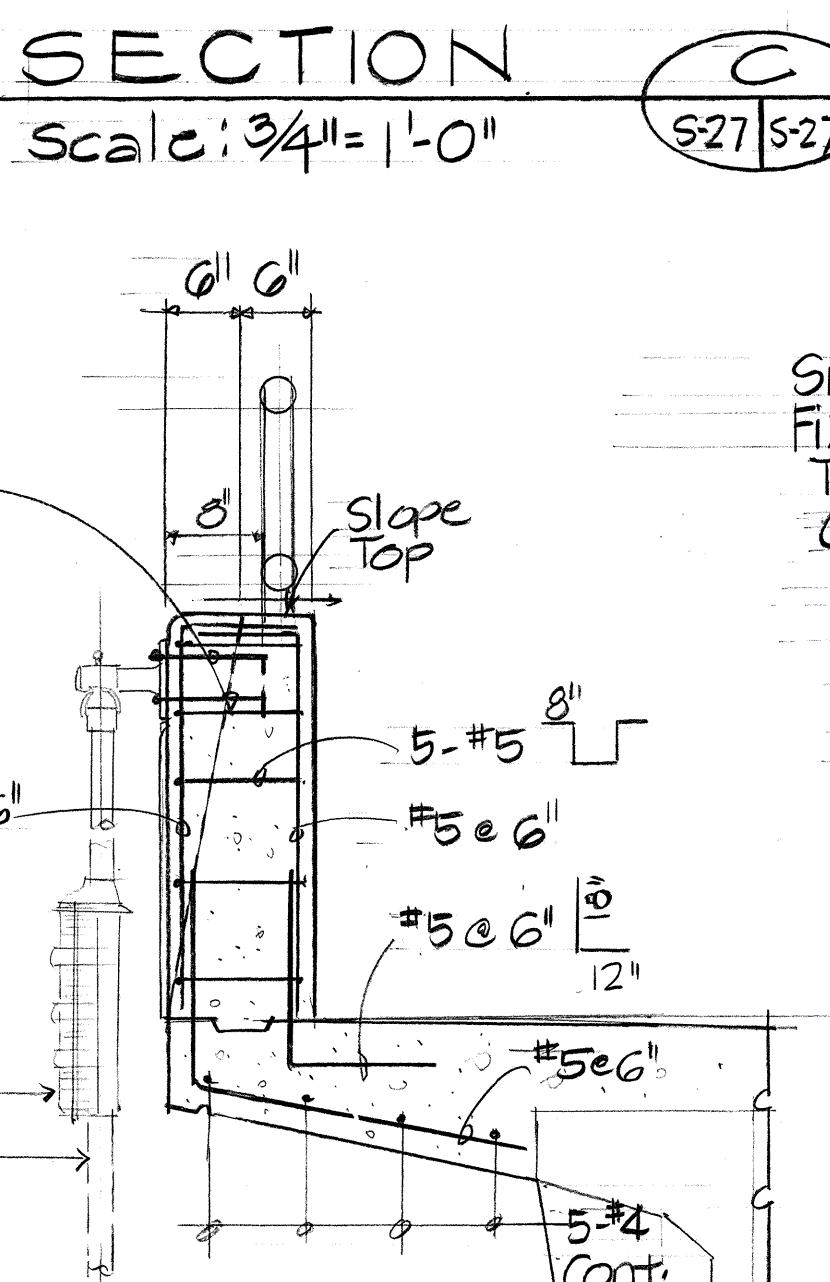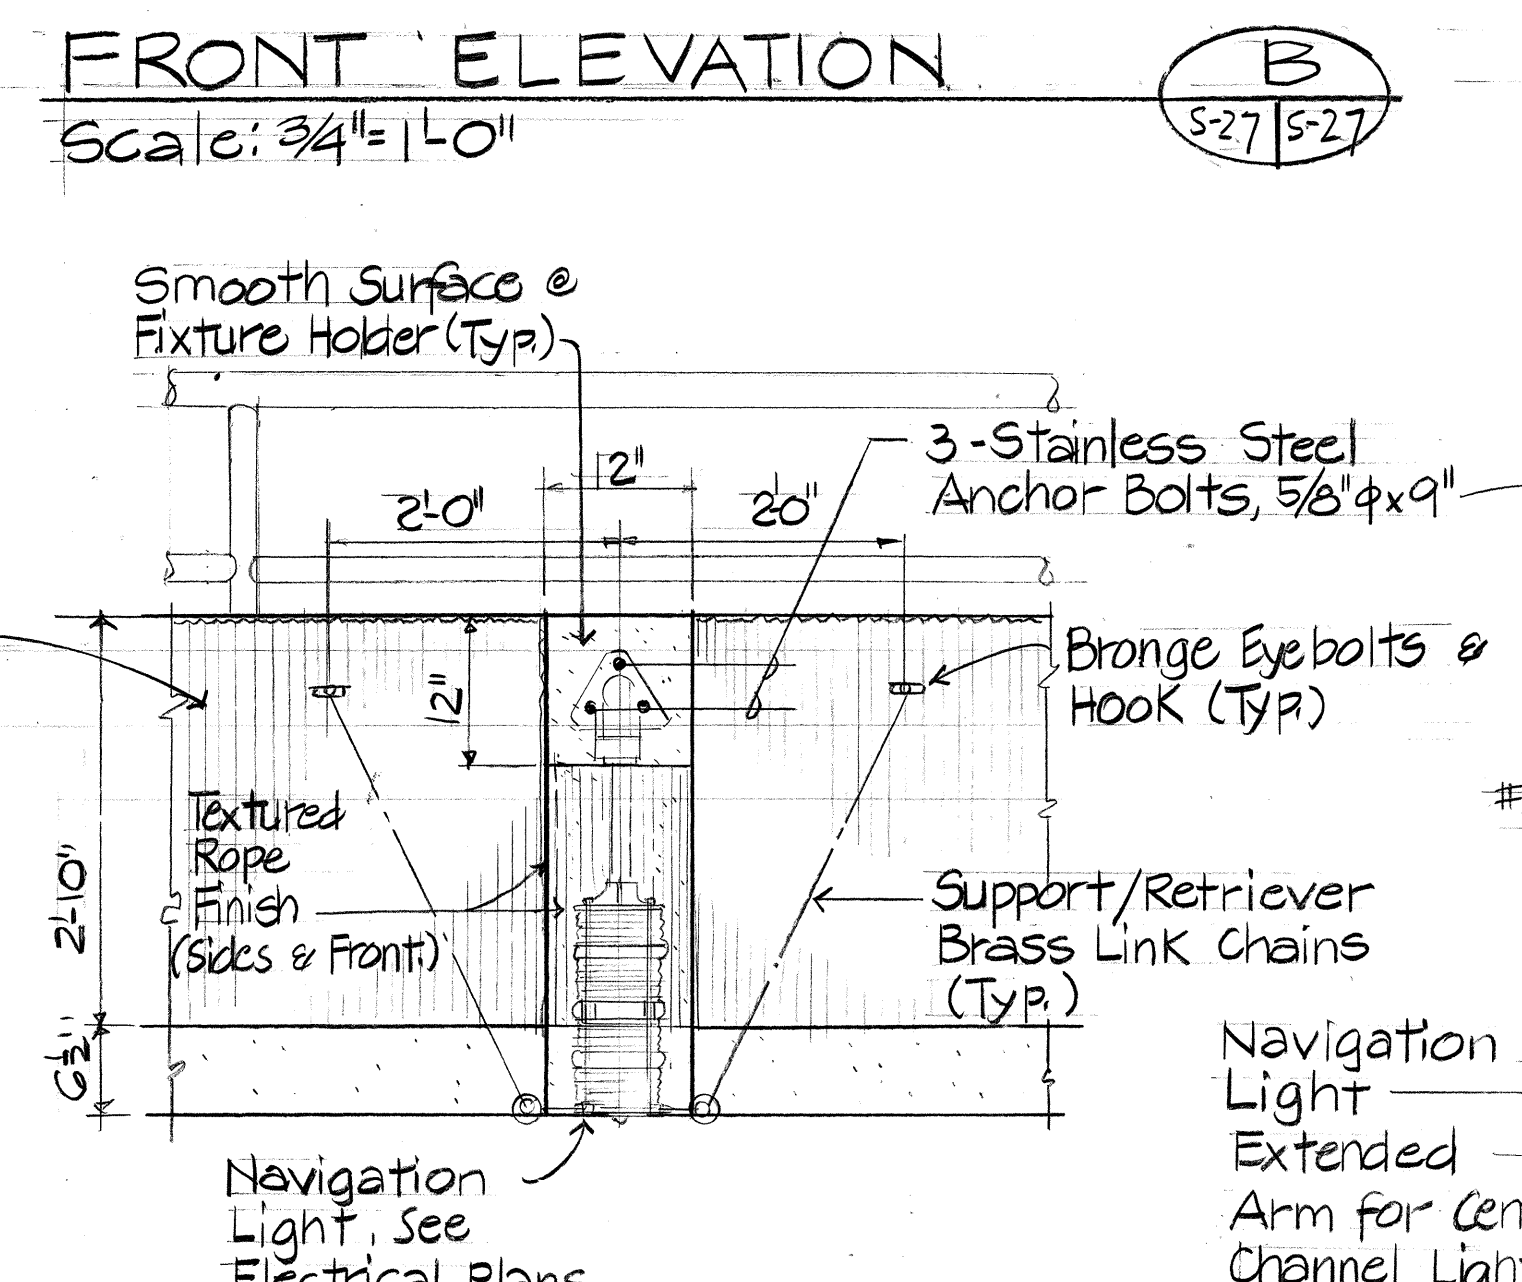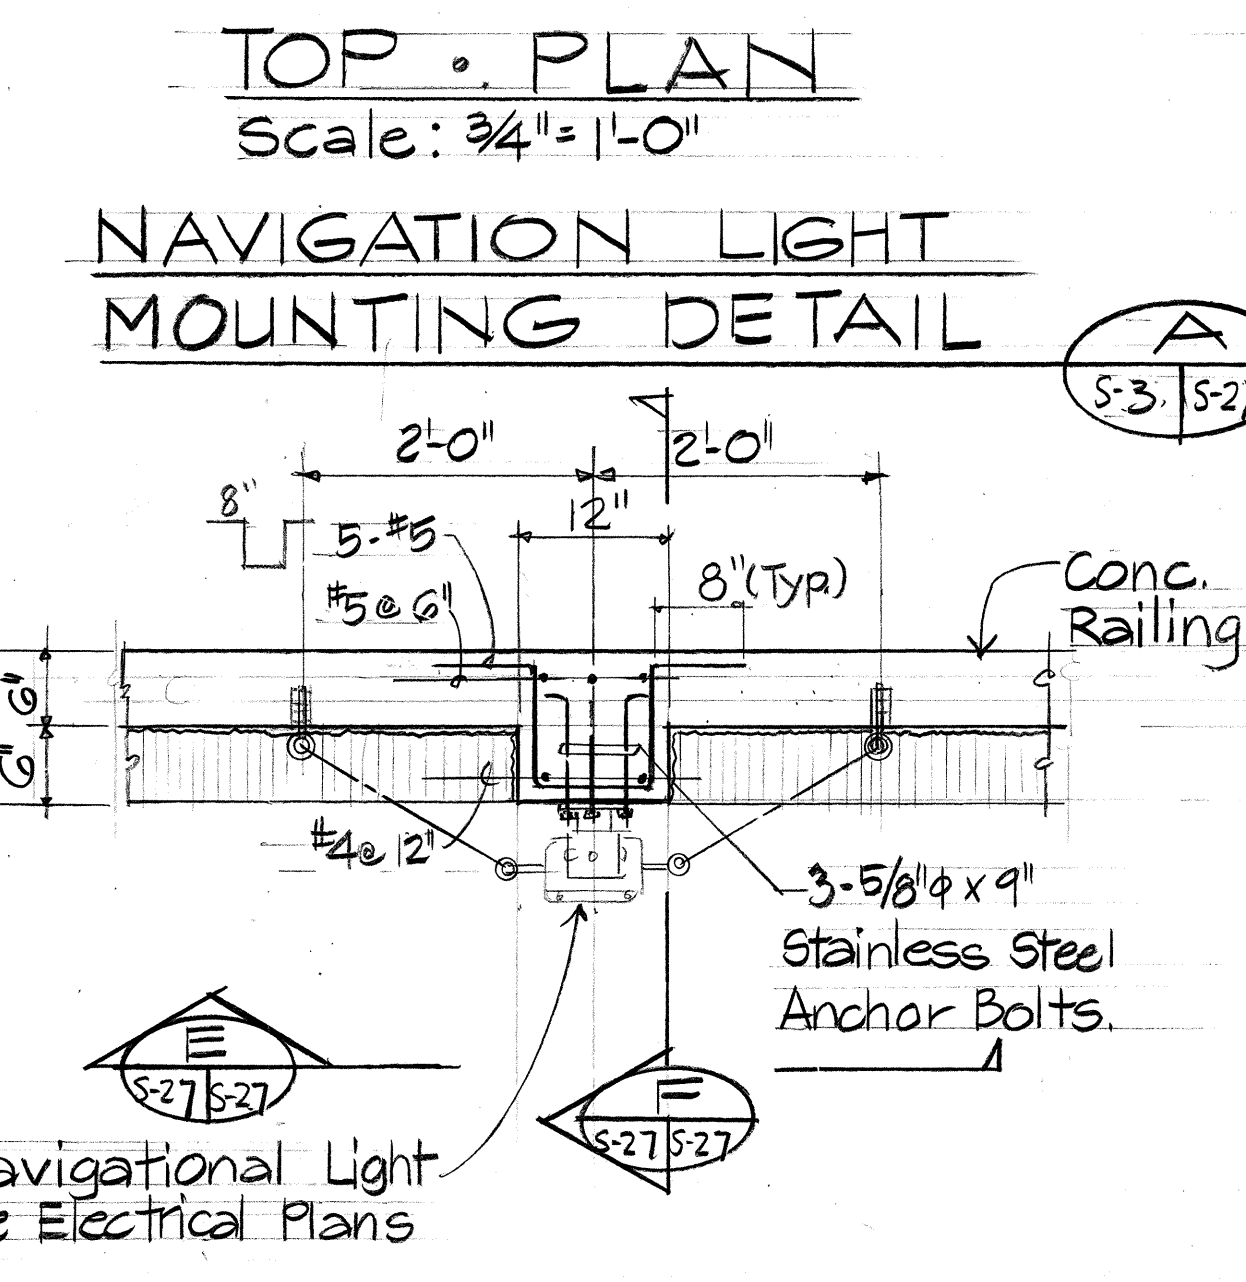



Notes:

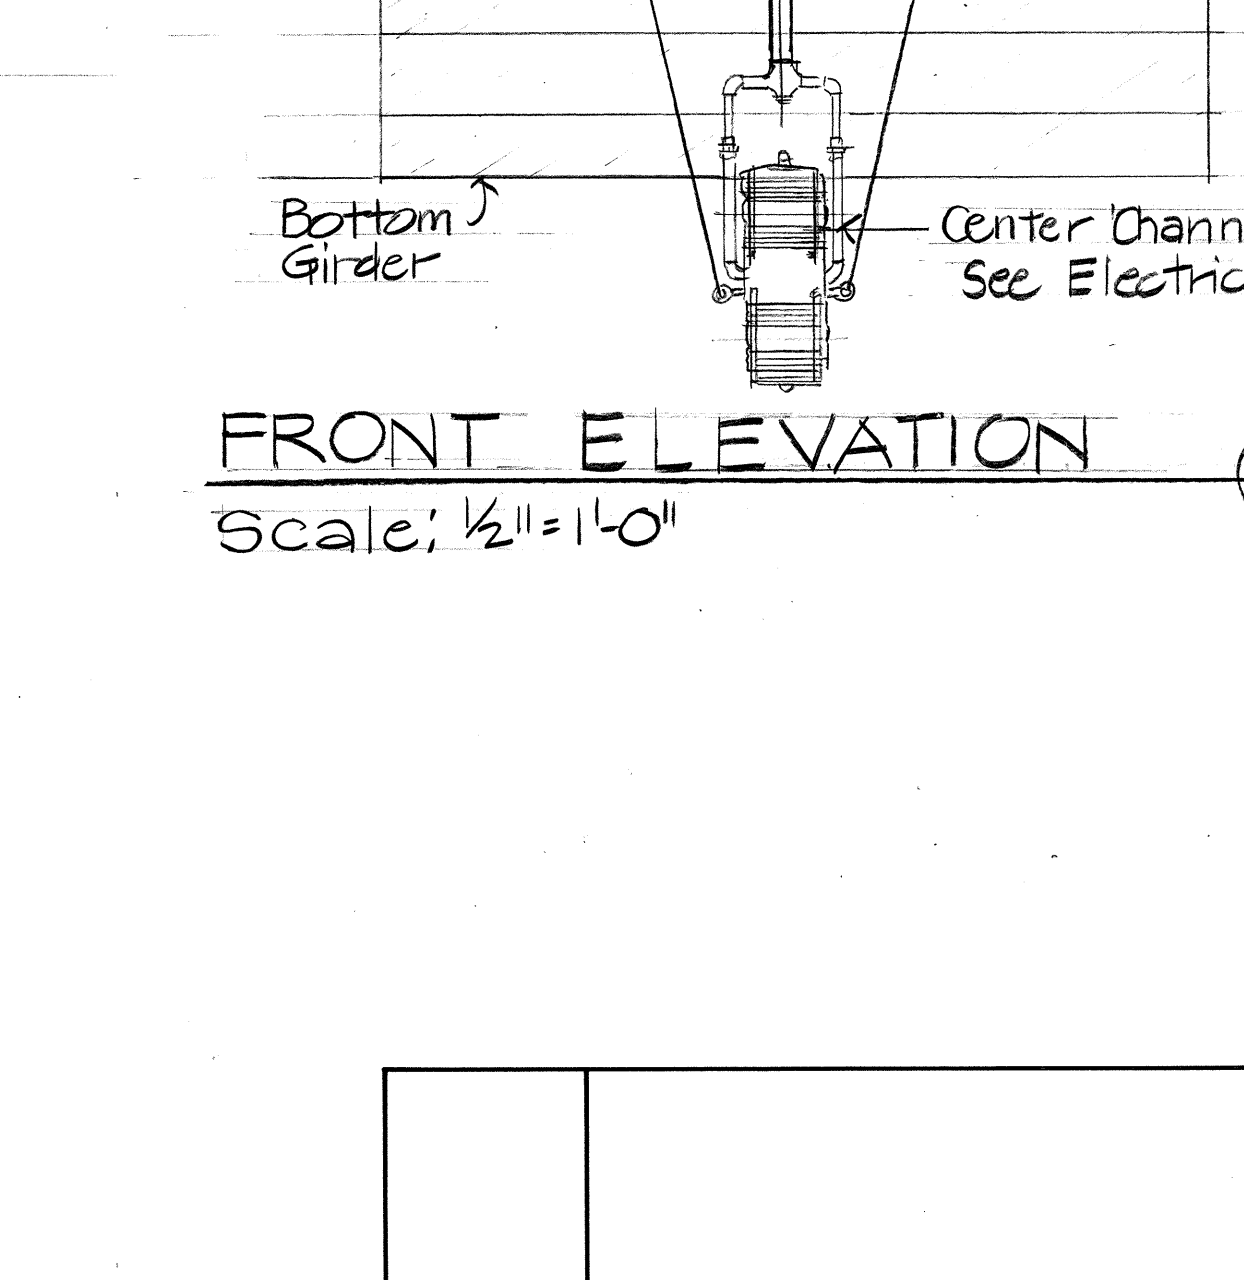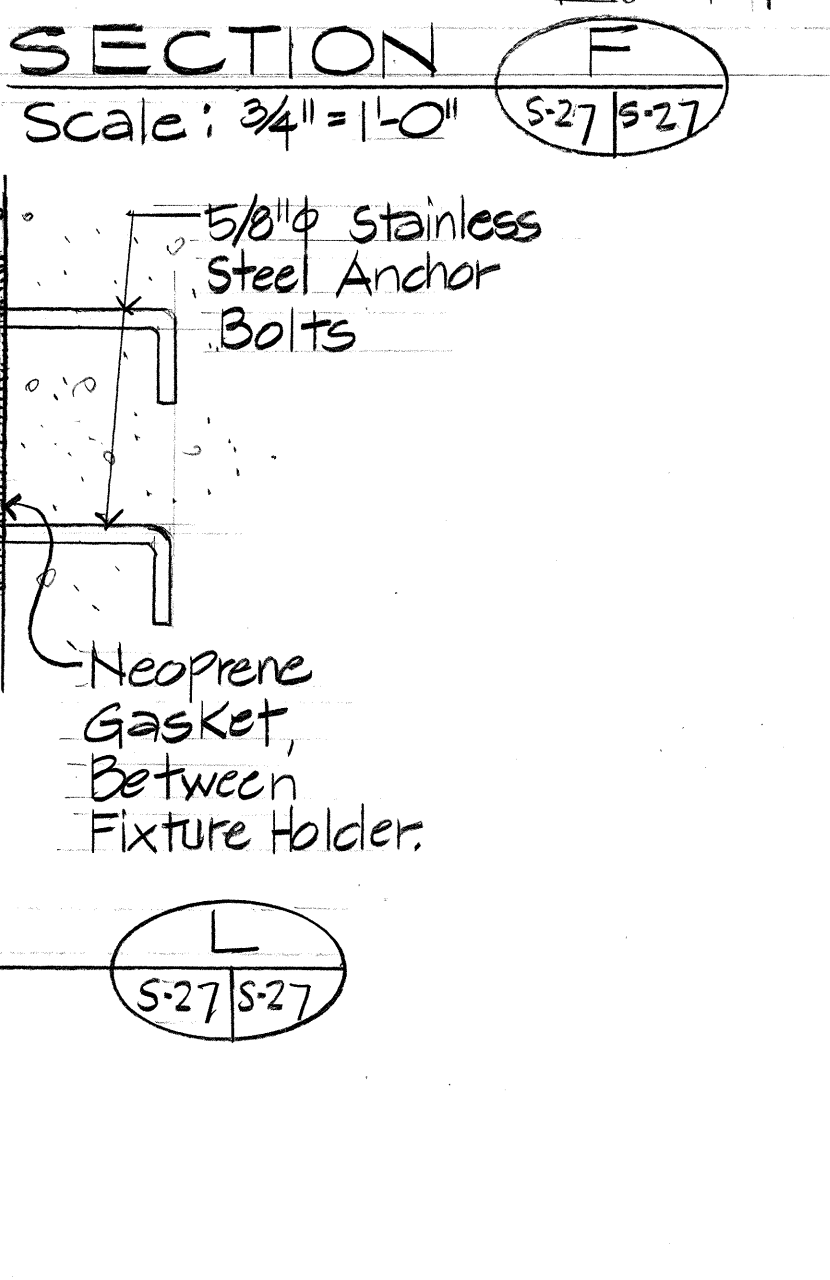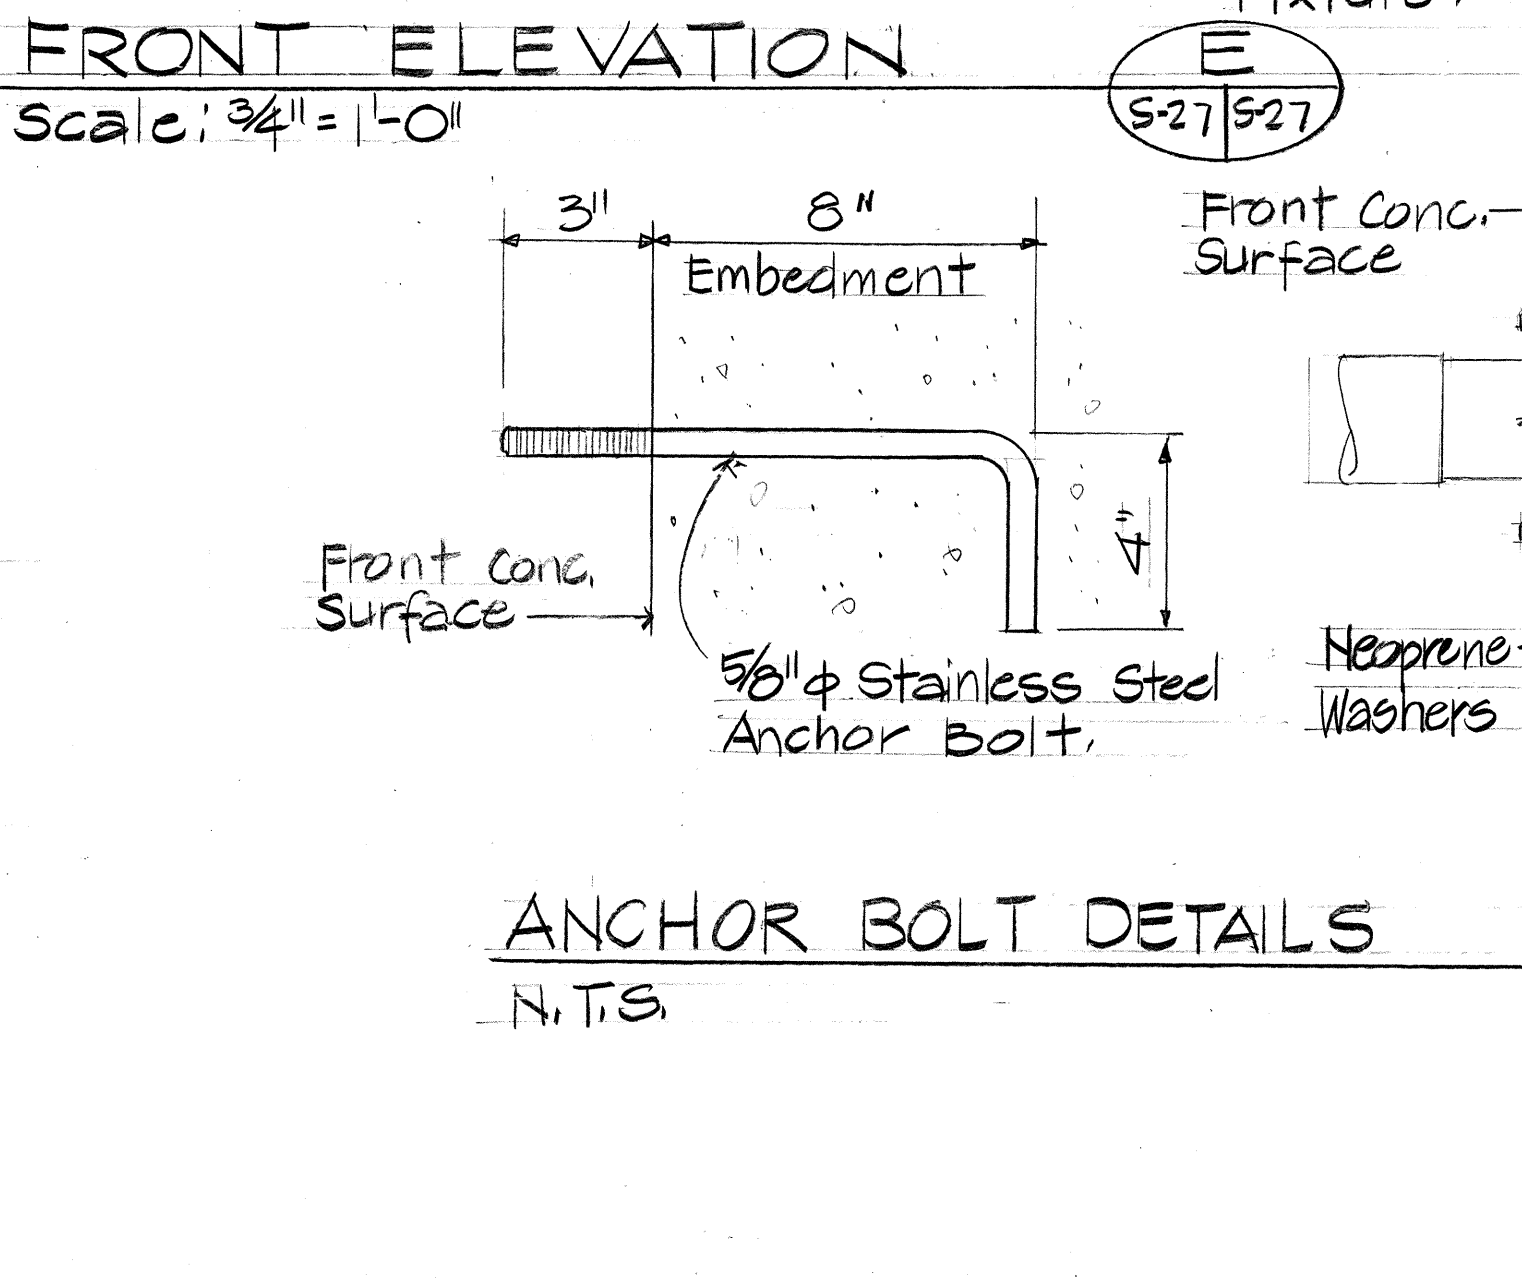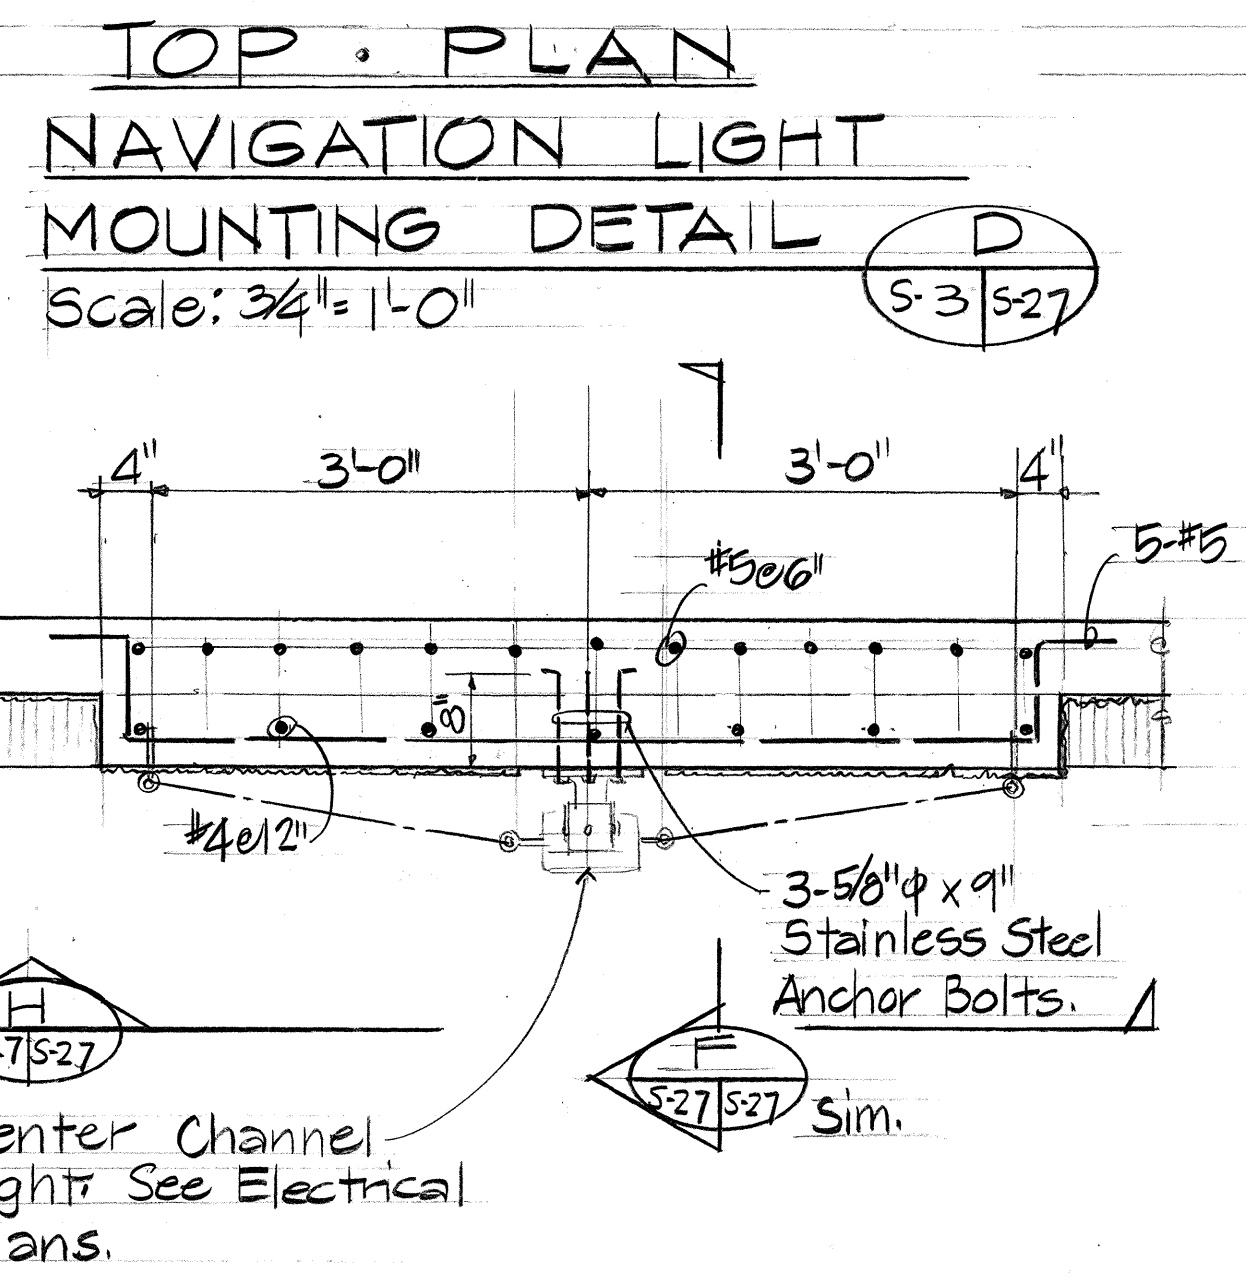

Notes:

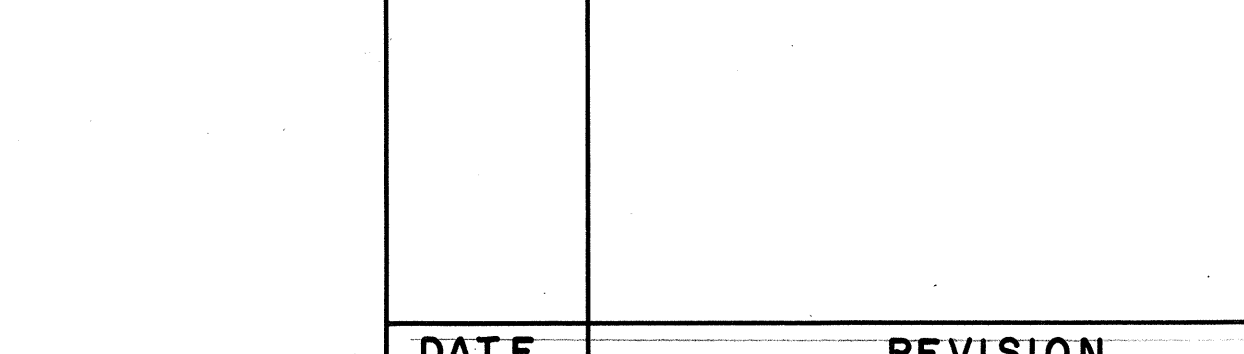


Notes:

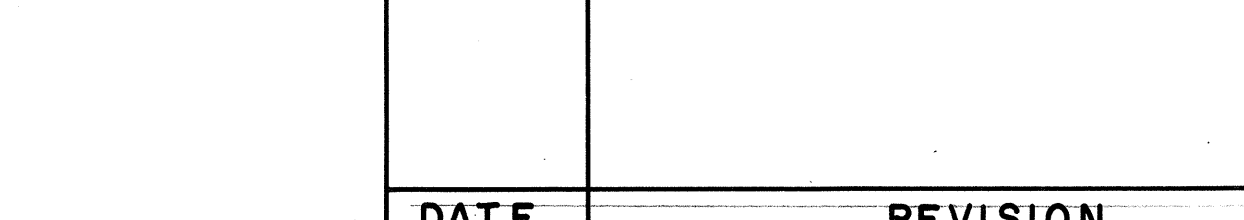 

Notes:



Notes:

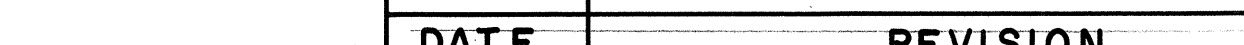

Notes:



FED. ROAD DIST. NO.	STATE	FED. AID PROJ. NO.	FISCAL YEAR	SHEET NO.	TOTAL SHEETS
HAWAII	HAW.	F-064-1(2)	1987	130	151

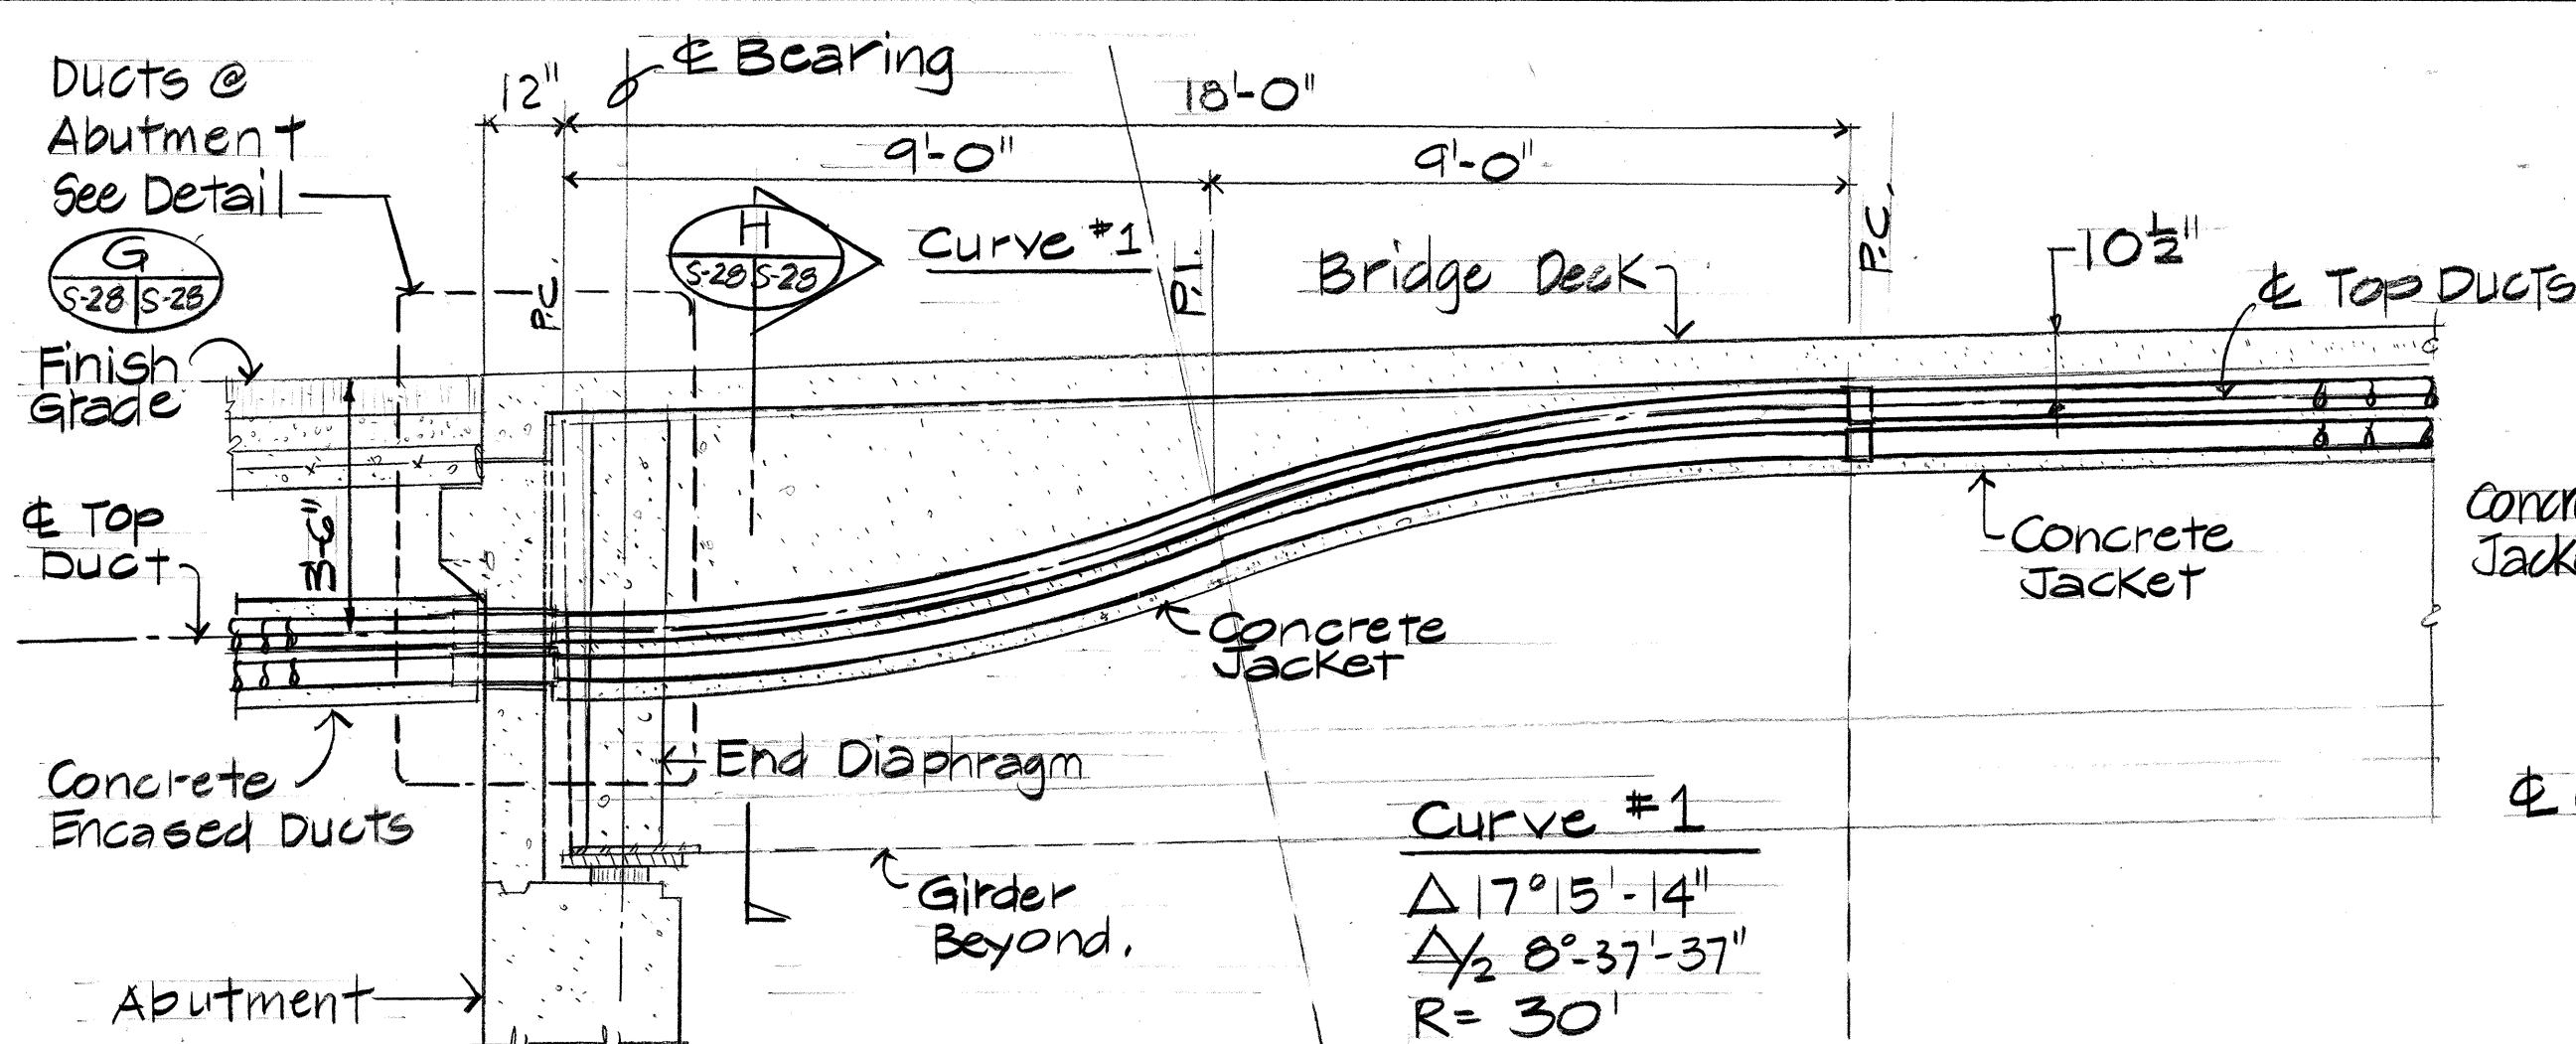


Curve #1
 $\Delta 17^\circ 15' - 14''$
 $\Delta \frac{1}{2} 8^\circ - 37' - 37''$
 $R = 30'$
 $T = 4.55'$
 $Ch = 9'$
 $Lc = 9.03'$
 Note: Reverse Curve


DUCT PROFILE AT
 ABUTMENT SECTION A
 Scale: 3/8" = 1'-0"

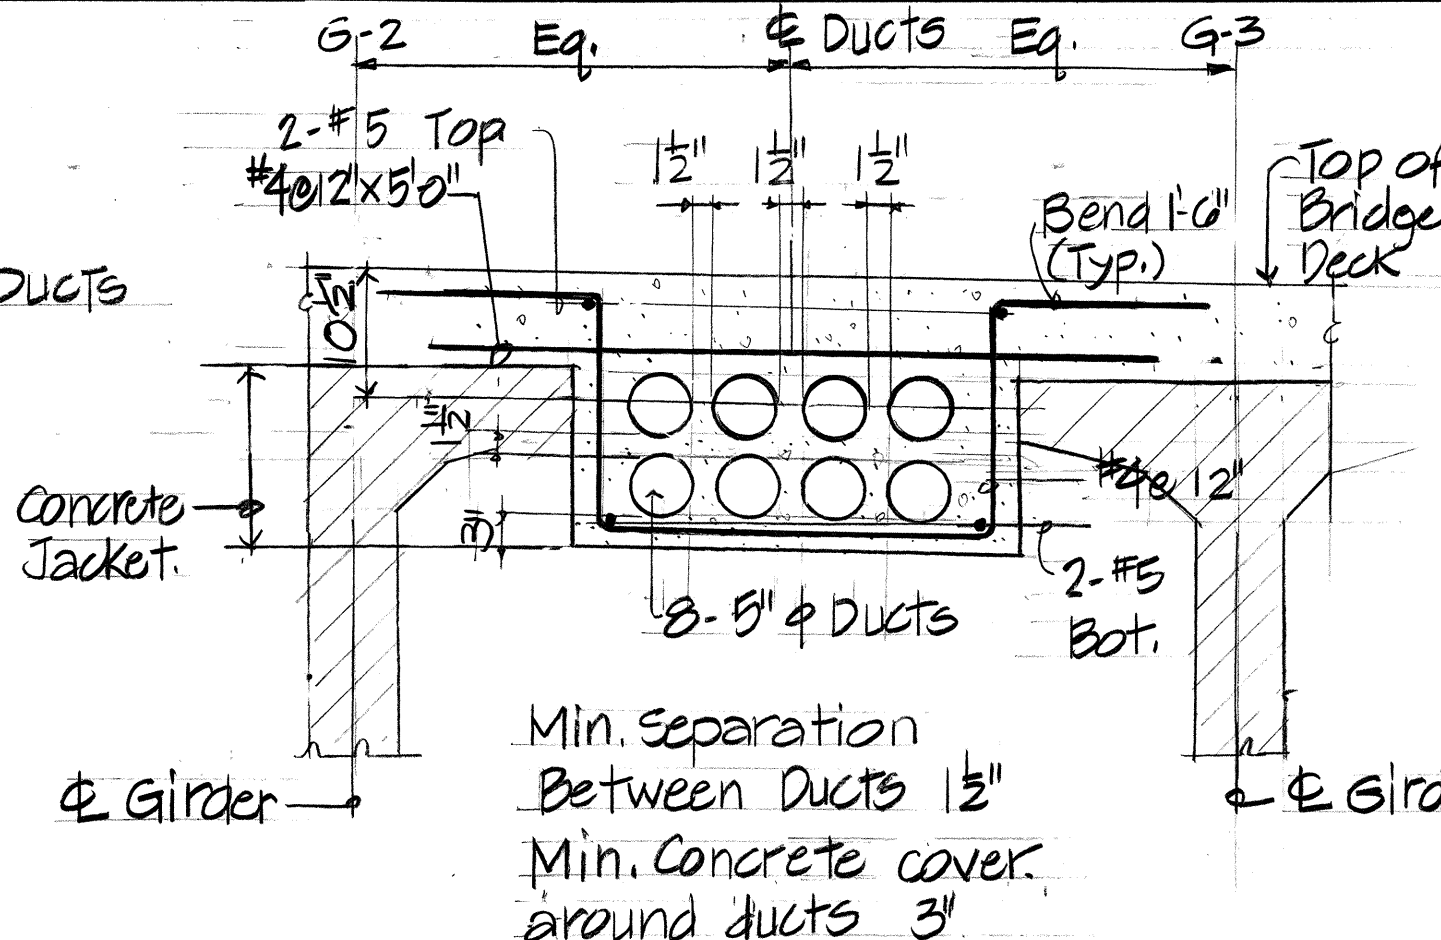


8 WAY ELECTRIC
 DUCT DETAIL B
 Scale: 3/4" = 1'-0"

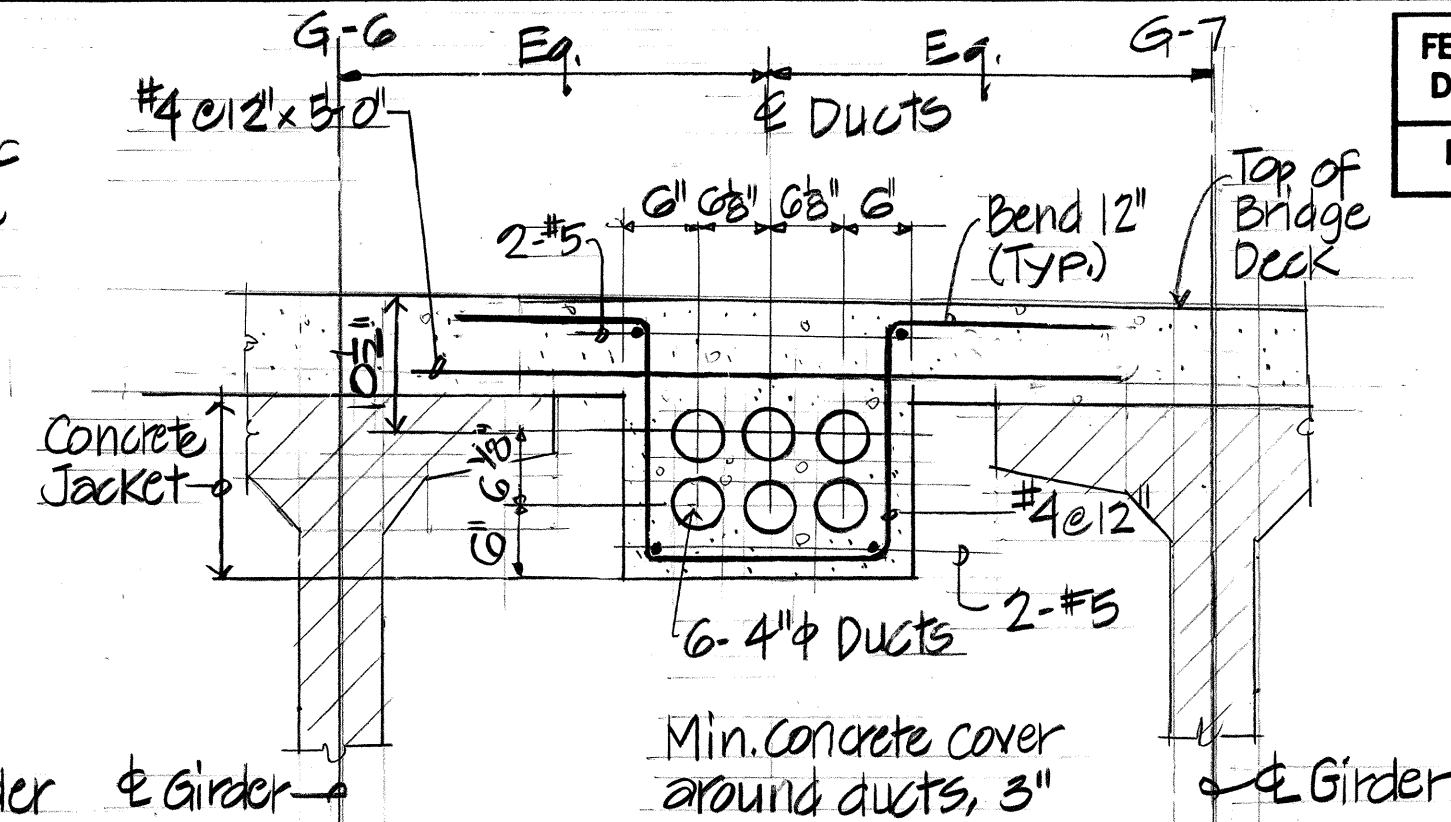


6 WAY TELEPHONE
 DUCT DETAIL C
 Scale: 3/4" = 1'-0"

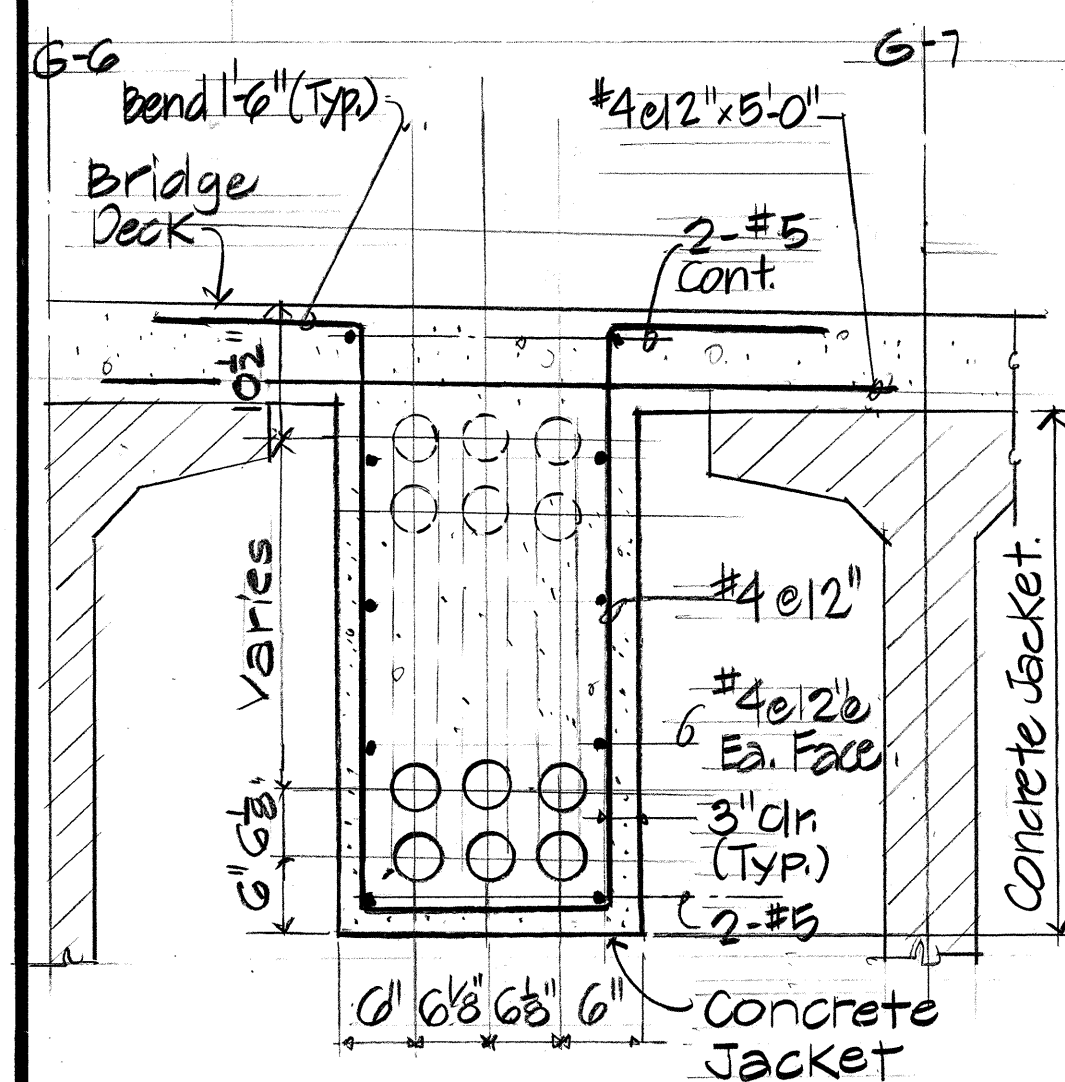


DUCT SECTION H
 Scale: 3/4" = 1'-0"
 (8-WAY DUCT SECTION
 SIMILAR)

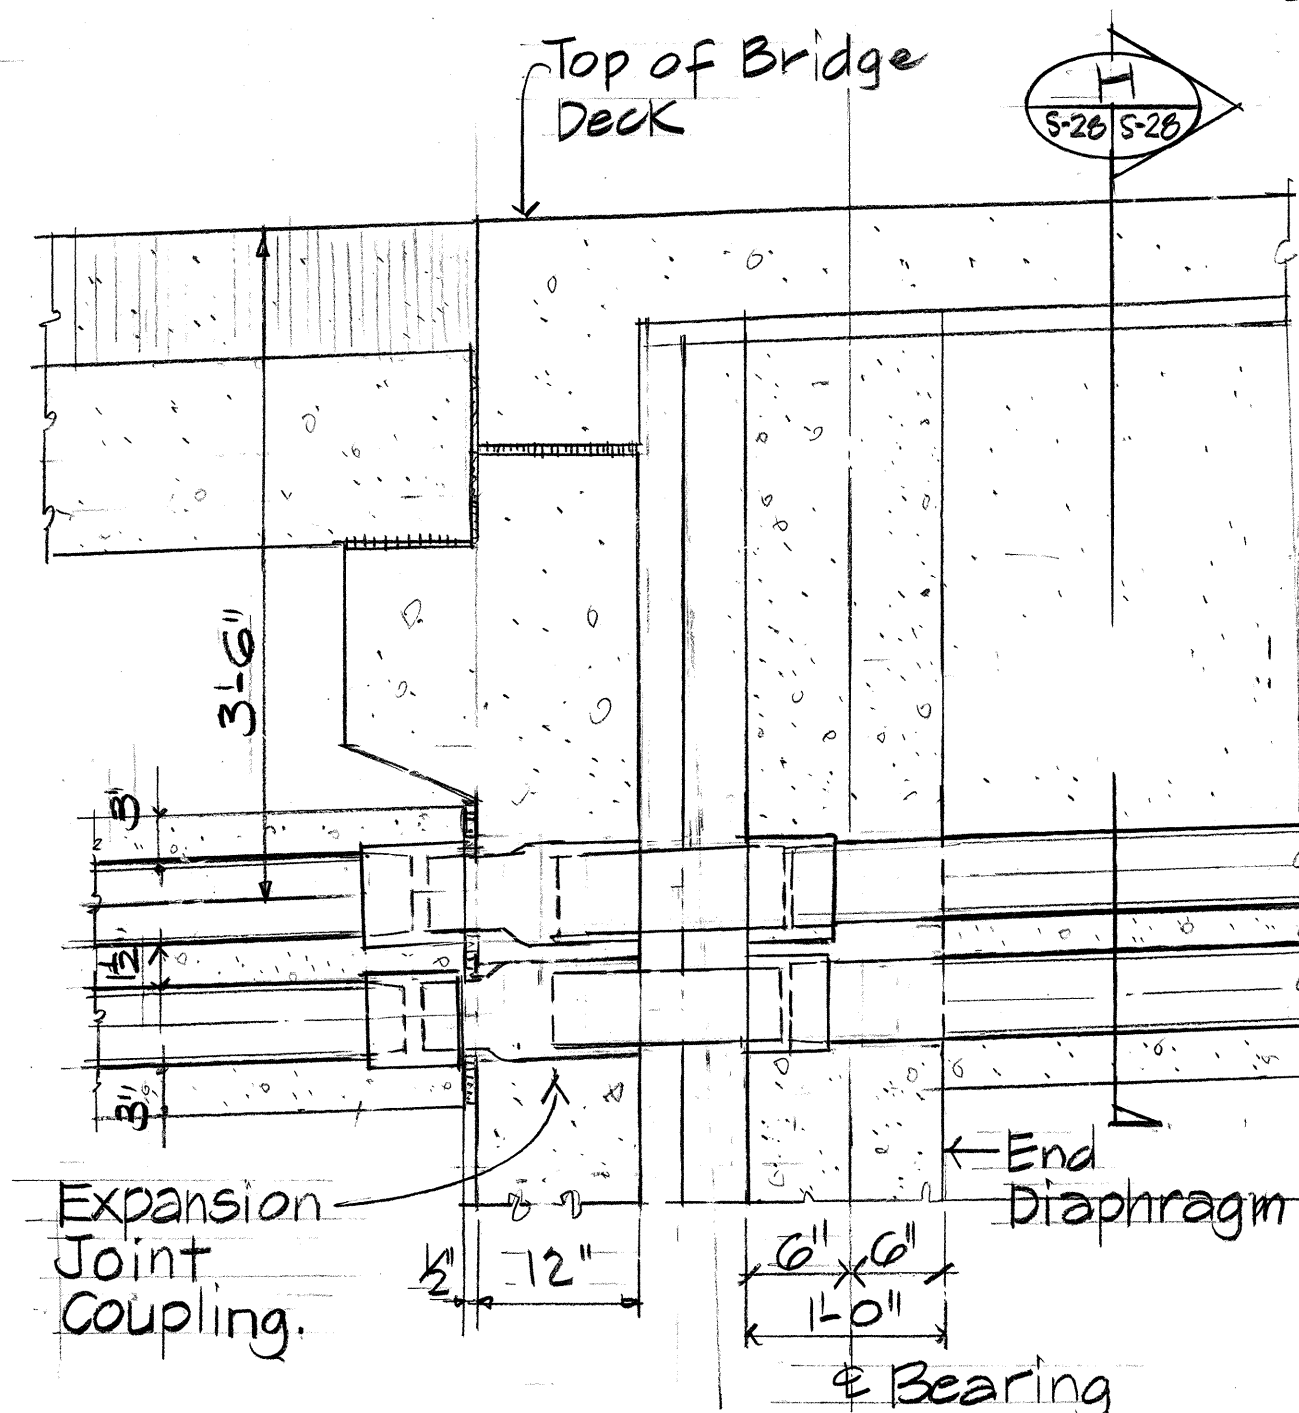

TYPICAL DUCT CONNECTORS
 AT ABUTMENT DETAIL G
 Scale: 1" = 1'-0"

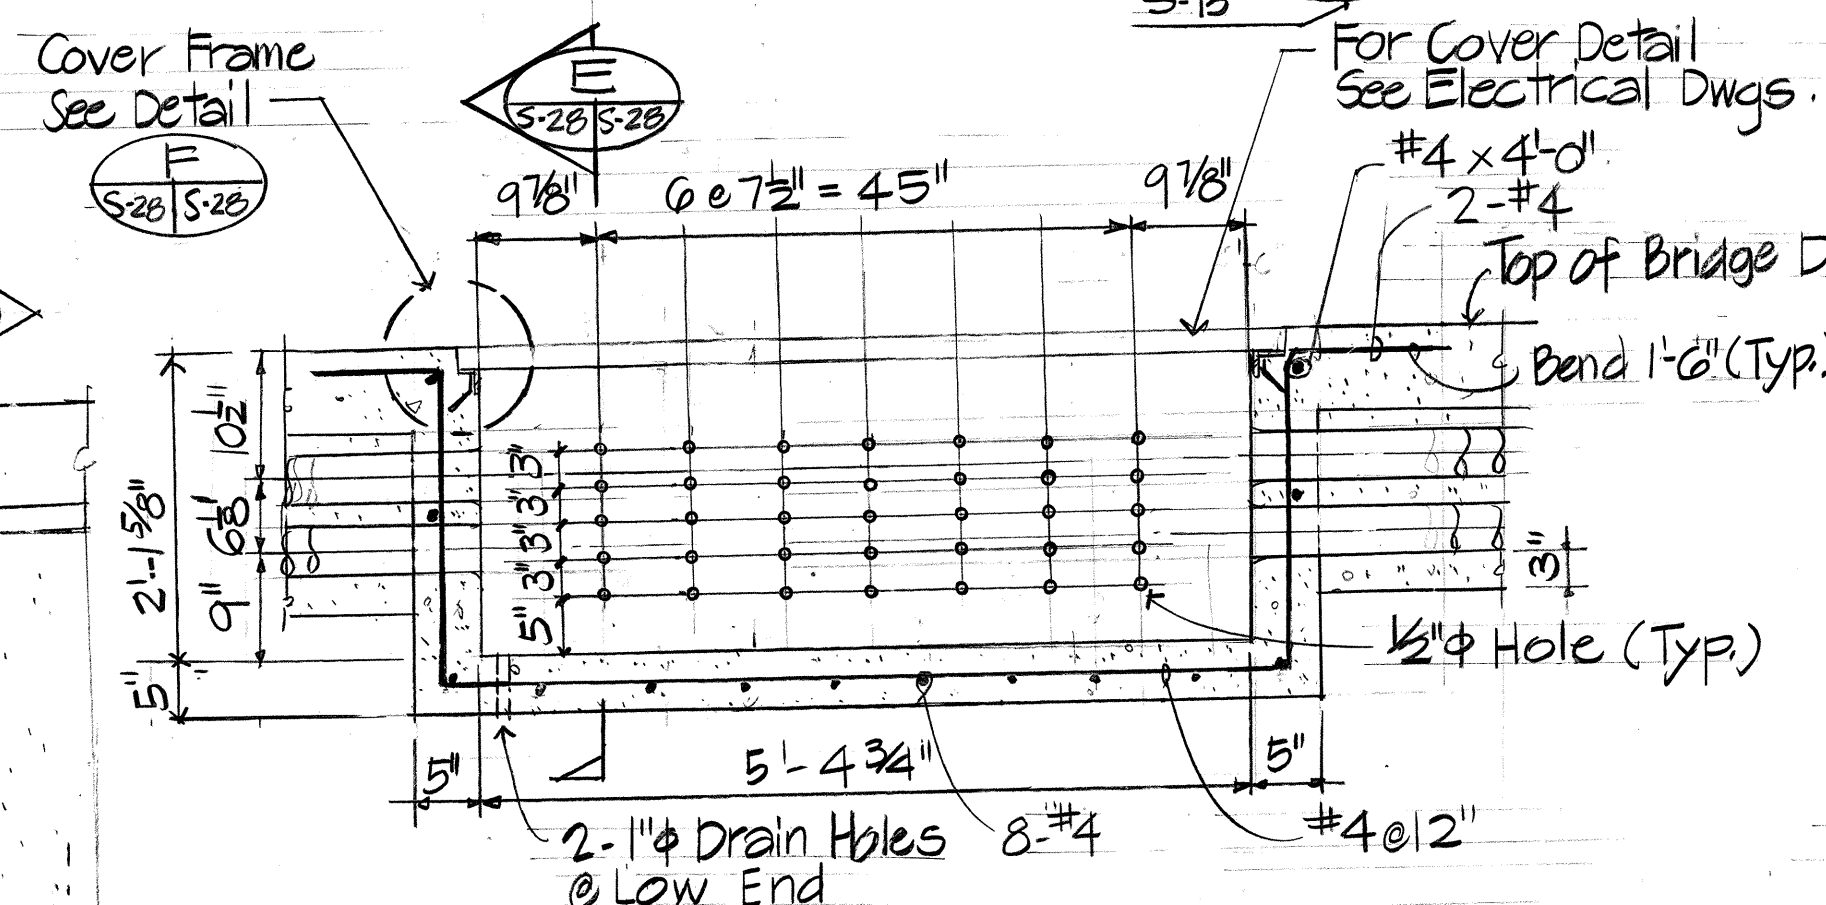


TELEPHONE PULLBOX
 LONGITUDINAL SECTION D
 Scale: 3/4" = 1'-0"

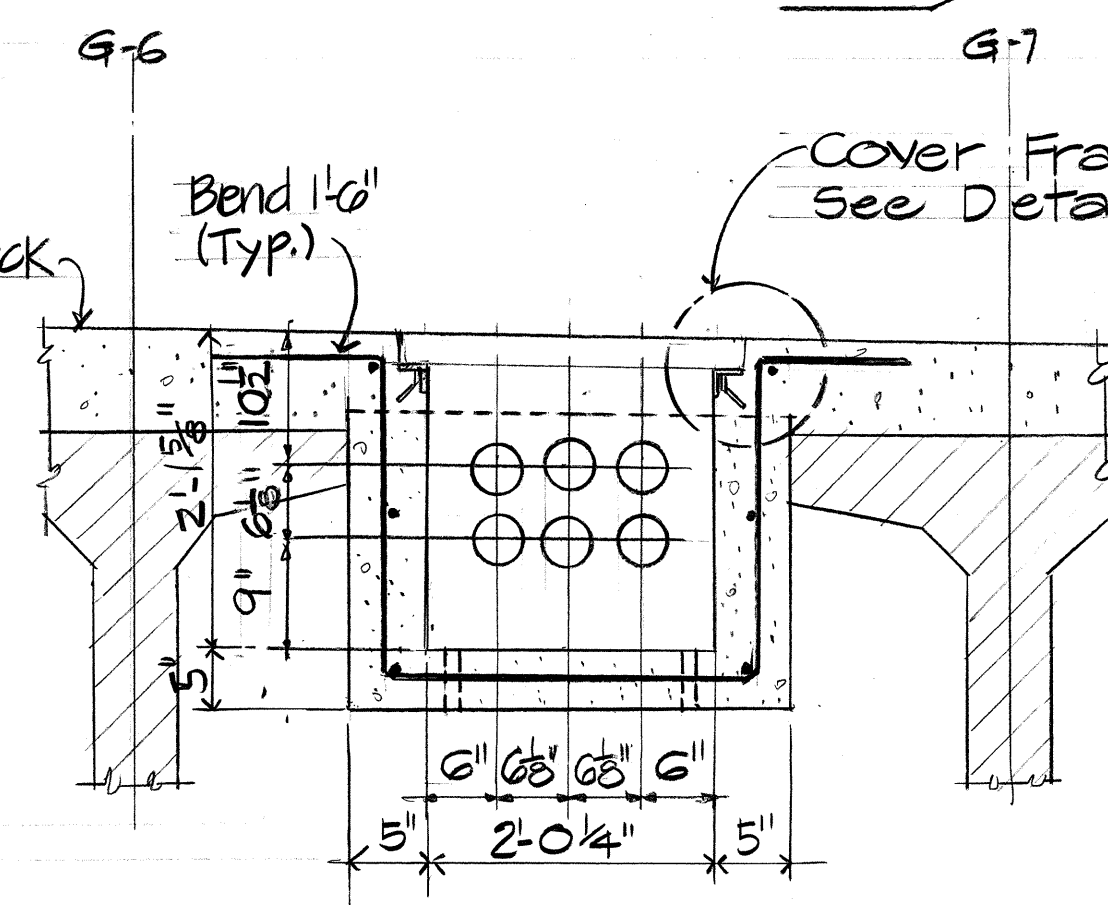


SECTION E
 Scale: 3/4" = 1'-0"

Note: See Elec. Shts. for arrangement of ducts for pull boxes @ Sta. 60+50 and Sta. 61+35.

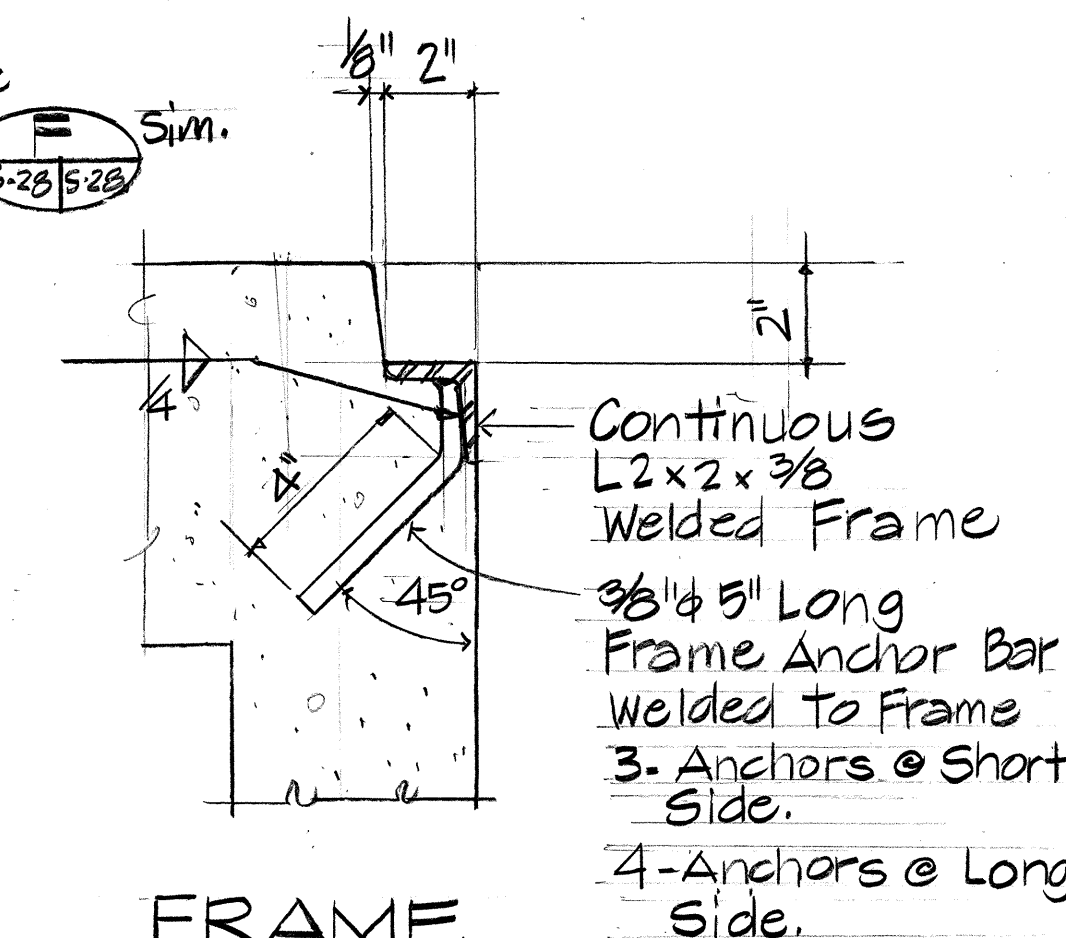

FRAME
 DETAIL F
 Scale: 3" = 1'-0"

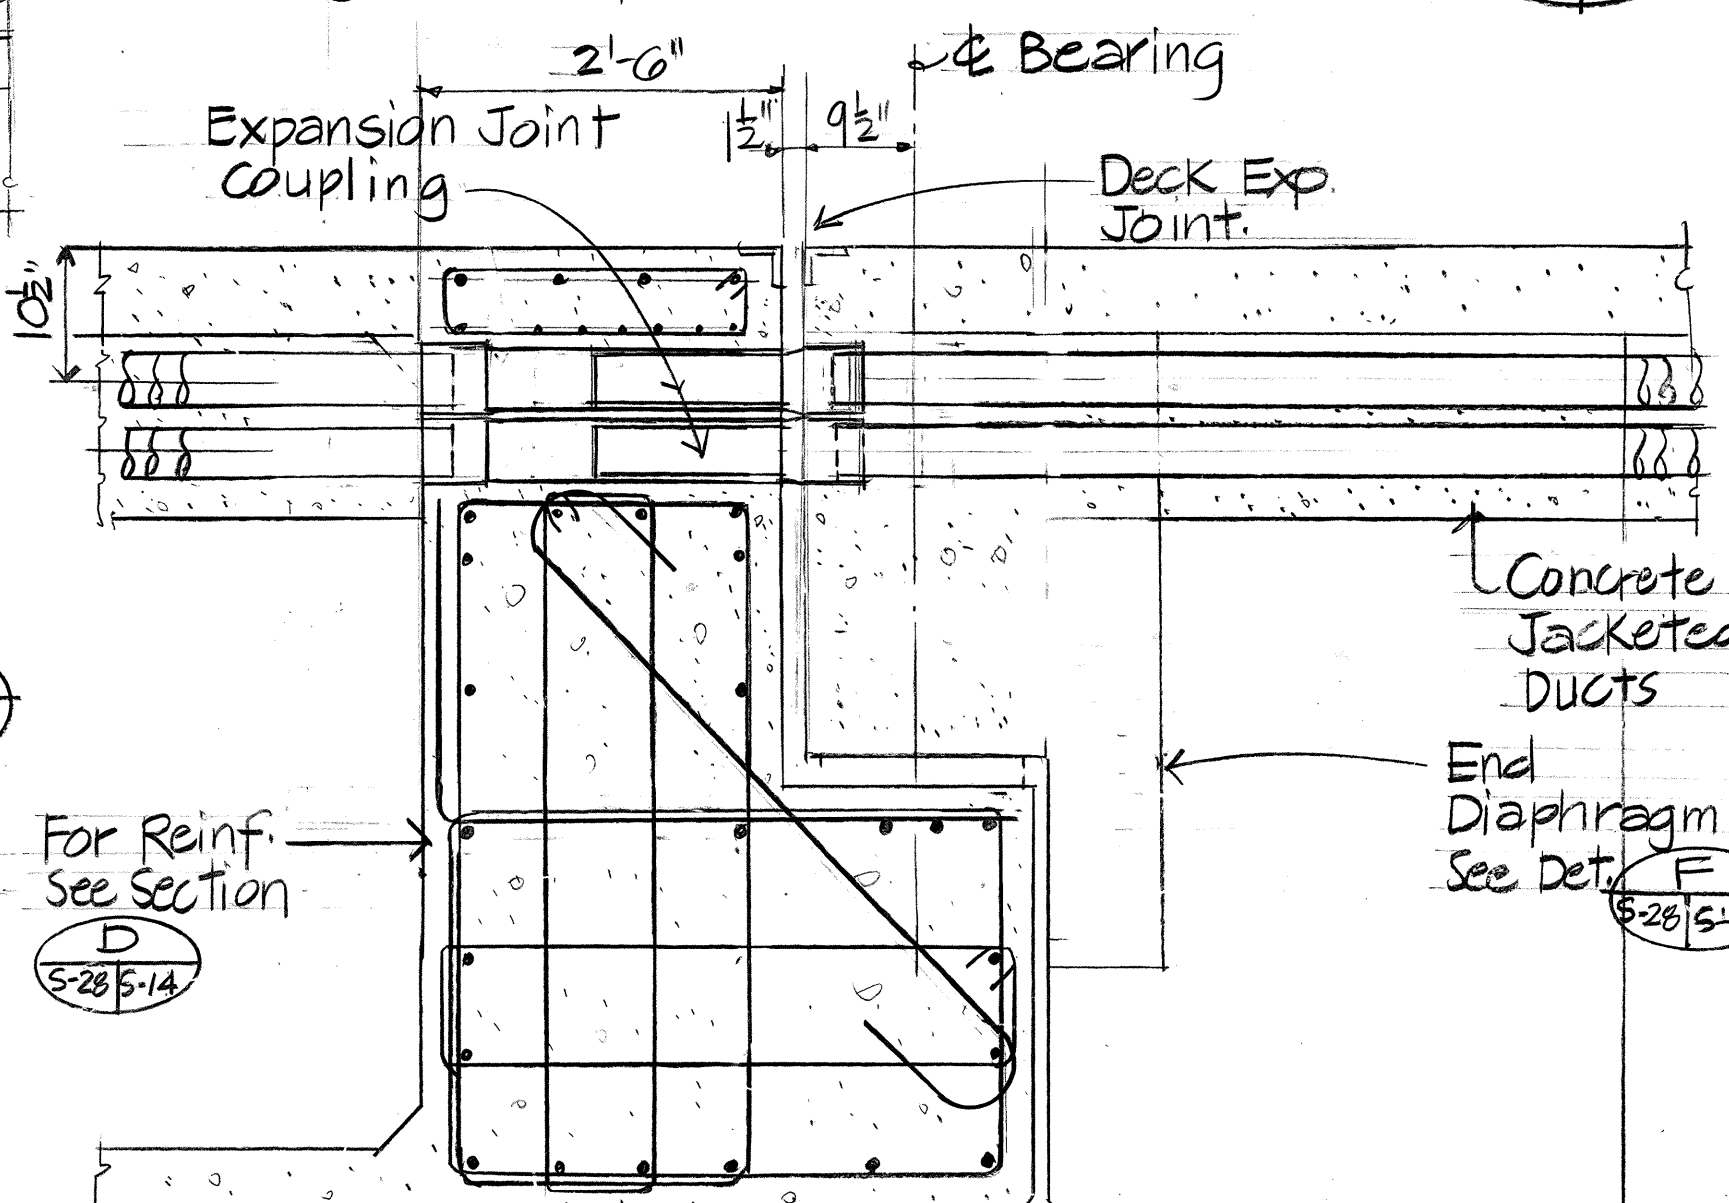

TYPICAL DUCT CONNECTORS
 AT PIER END BEAM DETAIL J
 Scale: 3/4" = 1'-0"

APPROVED:


140 w/p m...
 HAWAIIAN ELECTRIC CO. INC.

APPROVED:

140 w/p m...
 HAWAIIAN TELEPHONE CO.

6-7-86
 DATE

6/6/86
 DATE

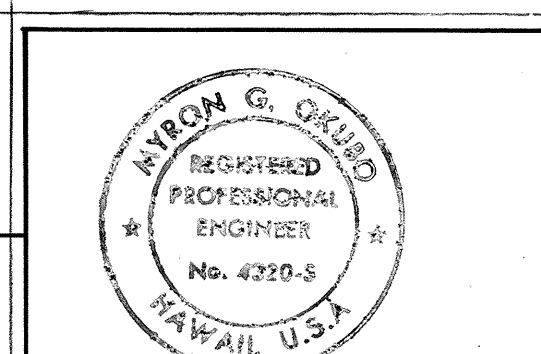

THIS WORK WAS PREPARED BY ME OR UNDER MY SUPERVISION

Myron Okubo

STATE OF HAWAII
 DEPARTMENT OF TRANSPORTATION
 HIGHWAYS DIVISION

ELECTRIC AND TELEPHONE
 DETAILS.


SAND ISLAND ROAD WIDENING
 2ND. BRIDGE AND APPROACHES
 FEDERAL AID PROJECT NO. F-064-1(2)

SCALE: AS NOTED. DATE: JUN, 1986

SHEET NO. 28 OF 30 SHEETS

DATE REVISION


FED. ROAD DIST. NO.	STATE	FED. AID PROJ. NO.	FISCAL YEAR	SHEET NO.	TOTAL SHEETS
HAWAII	HAW.	F-064-1(2)	1987	131	151

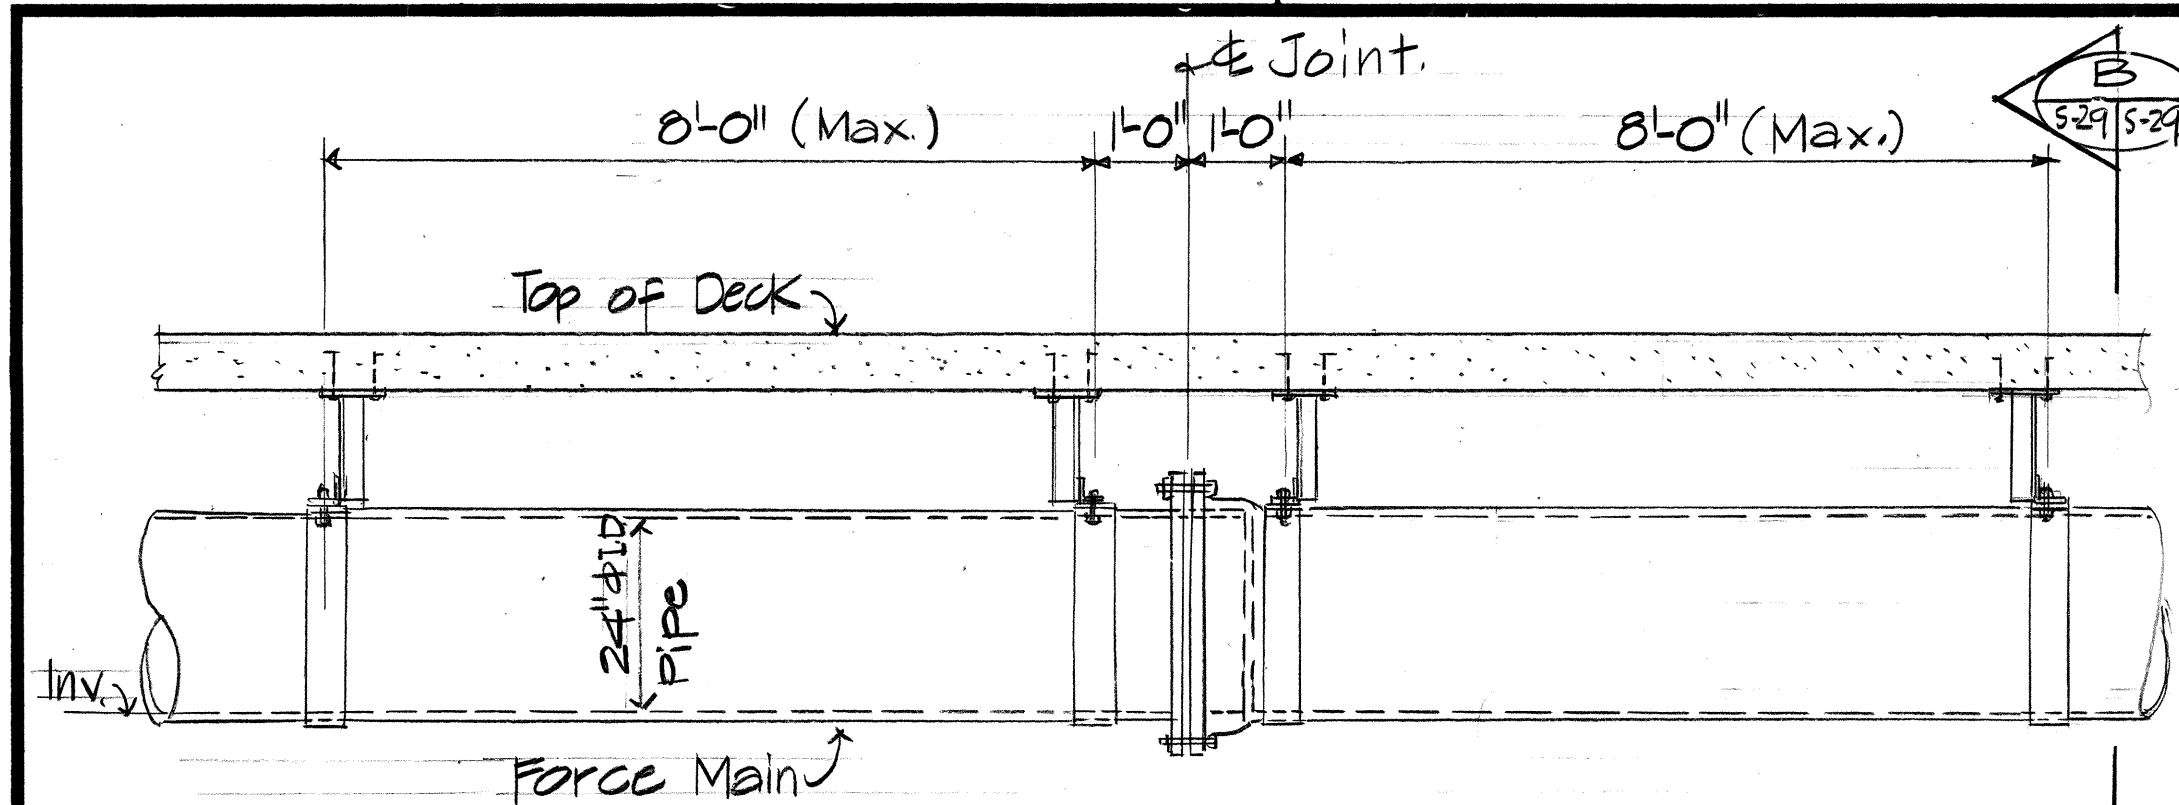

F.M. PIPE HANGER - ELEVATION

Scale: $\frac{1}{2}'' = 1'-0''$


Note: All Bolts, Washers, Nuts, P's. Shapes shall be Type 316 Stainless steel.

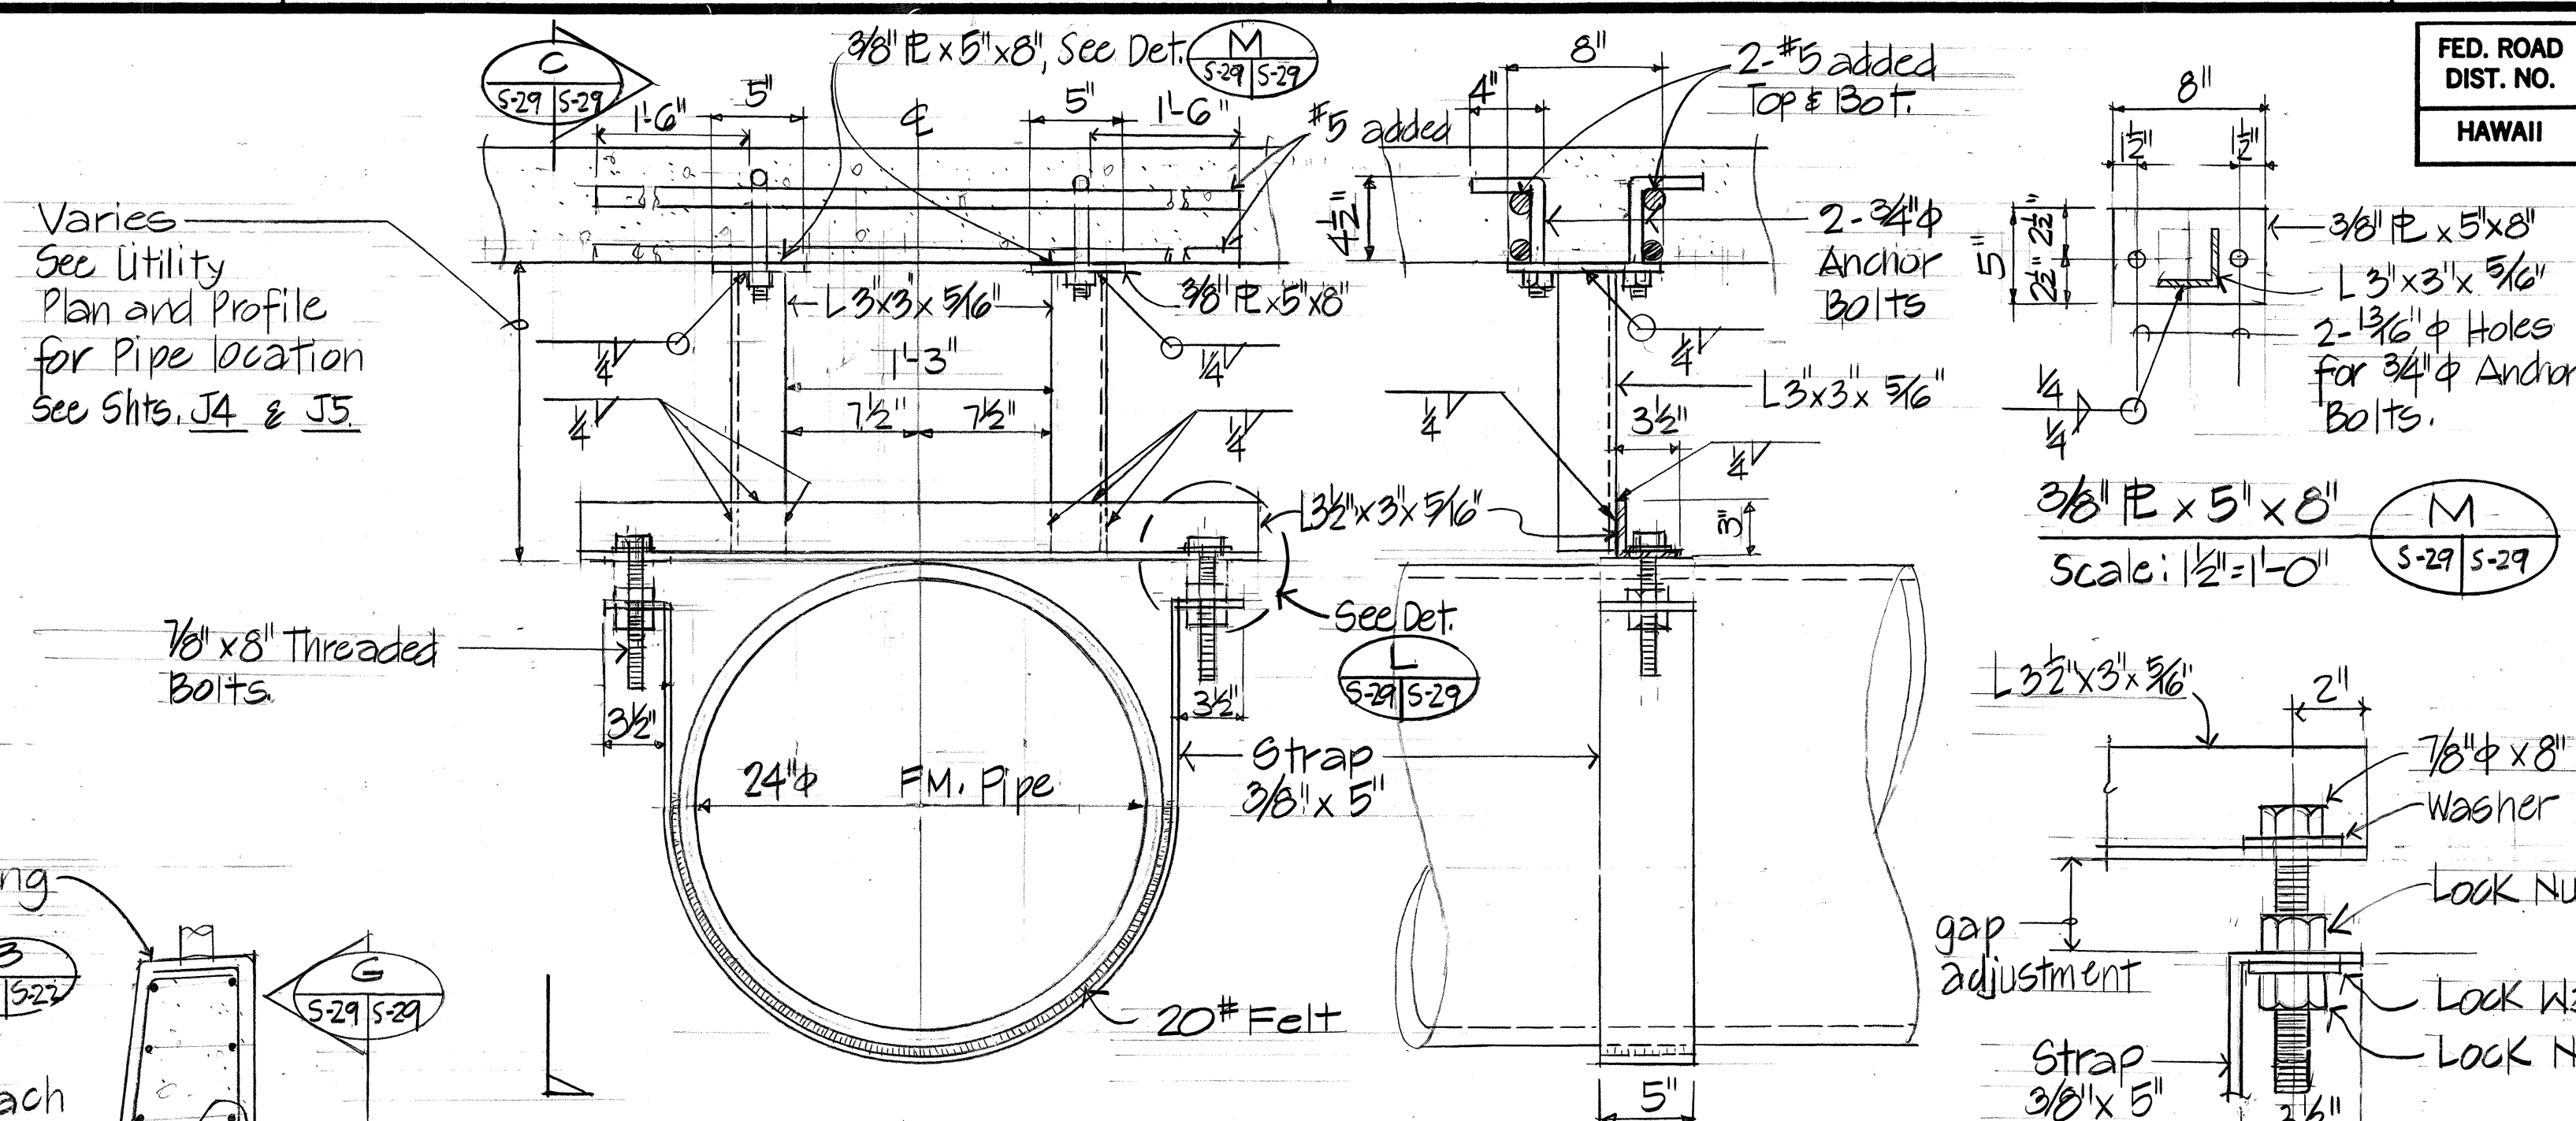

SECTION B
Sca|e: $\frac{1}{2}'' = 1'-0''$ S-29 S-29


SECTION C
Scale: $1/2" = 1'-0"$ S-29 S-29

DETAIL L
N.T.S. S-29 | S-29

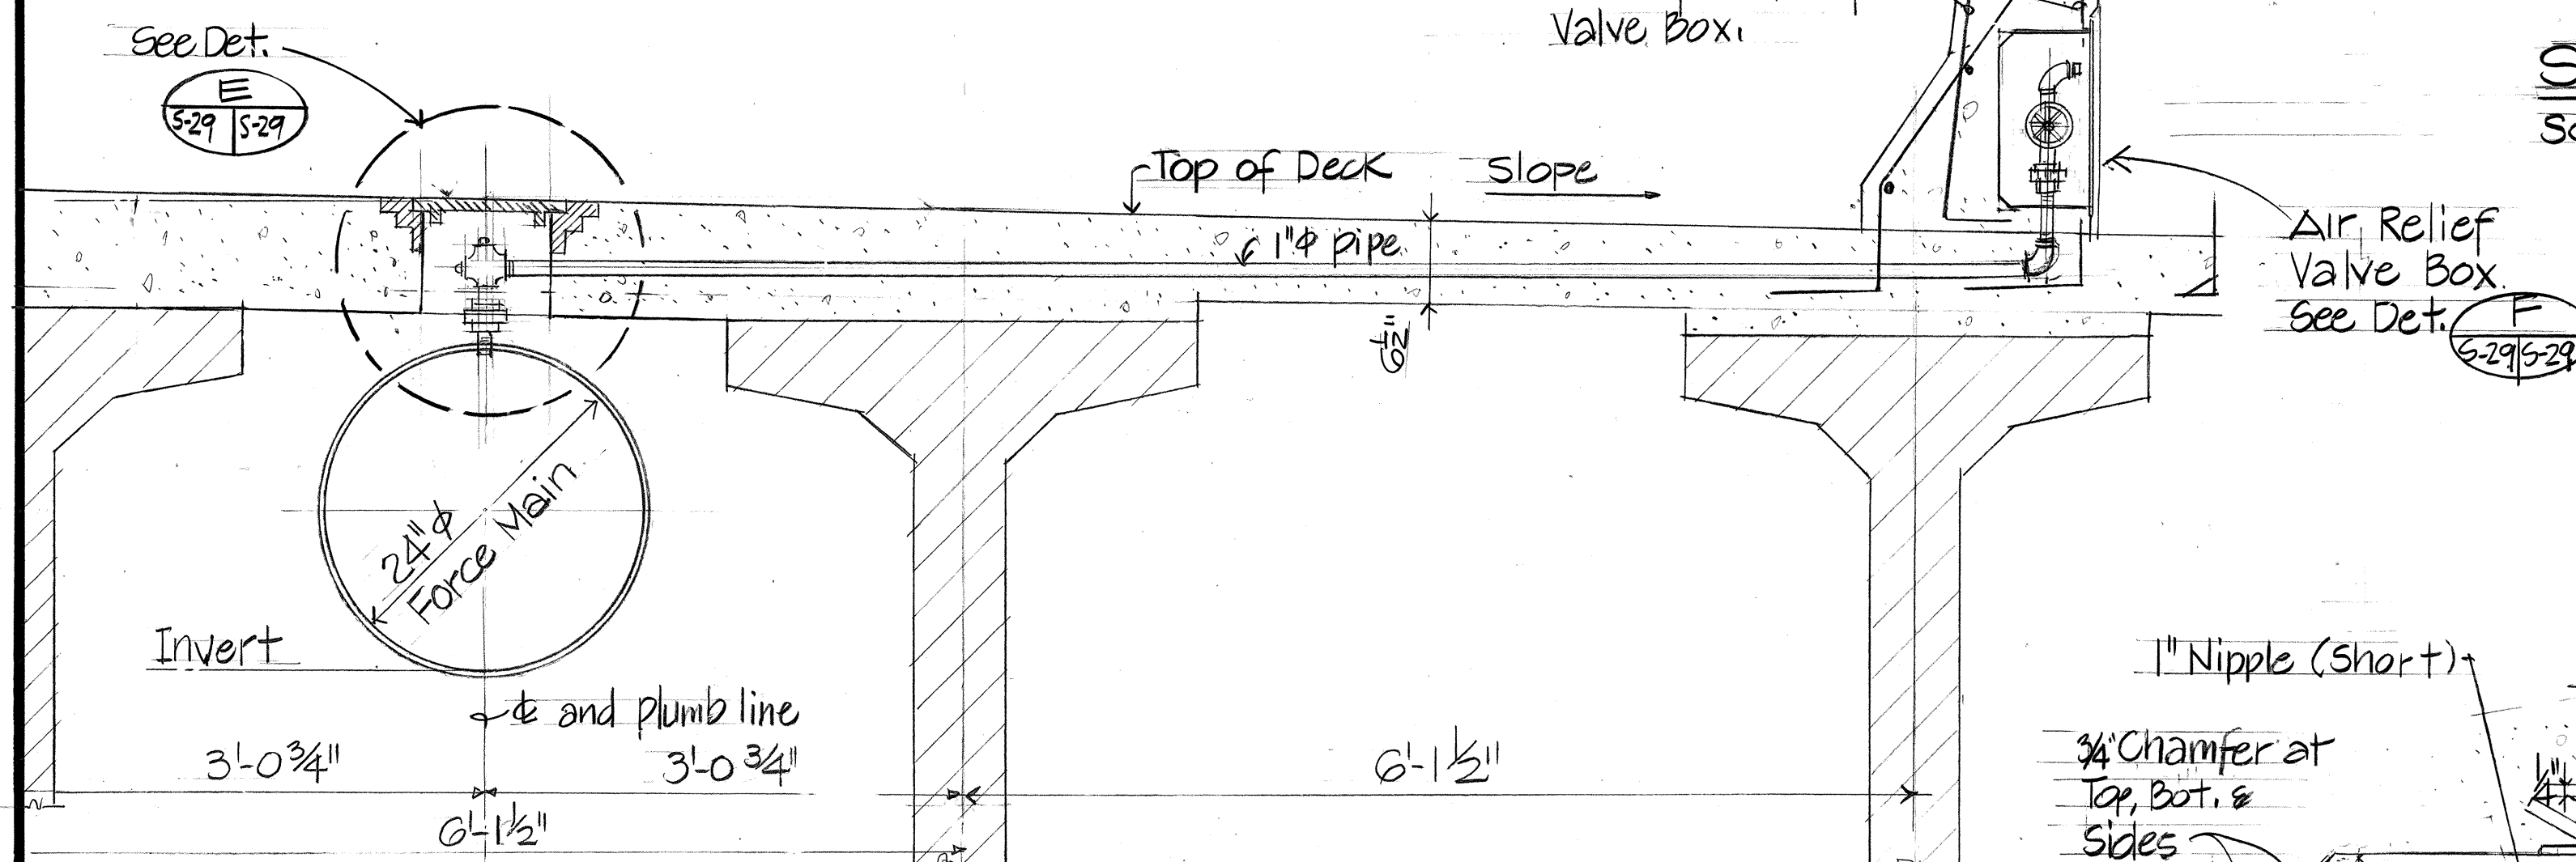


24" ϕ FORCE MAIN W/ AIR RELIEF VALVE

scale: 1" = 1'-0" (AT STA. 61+50)

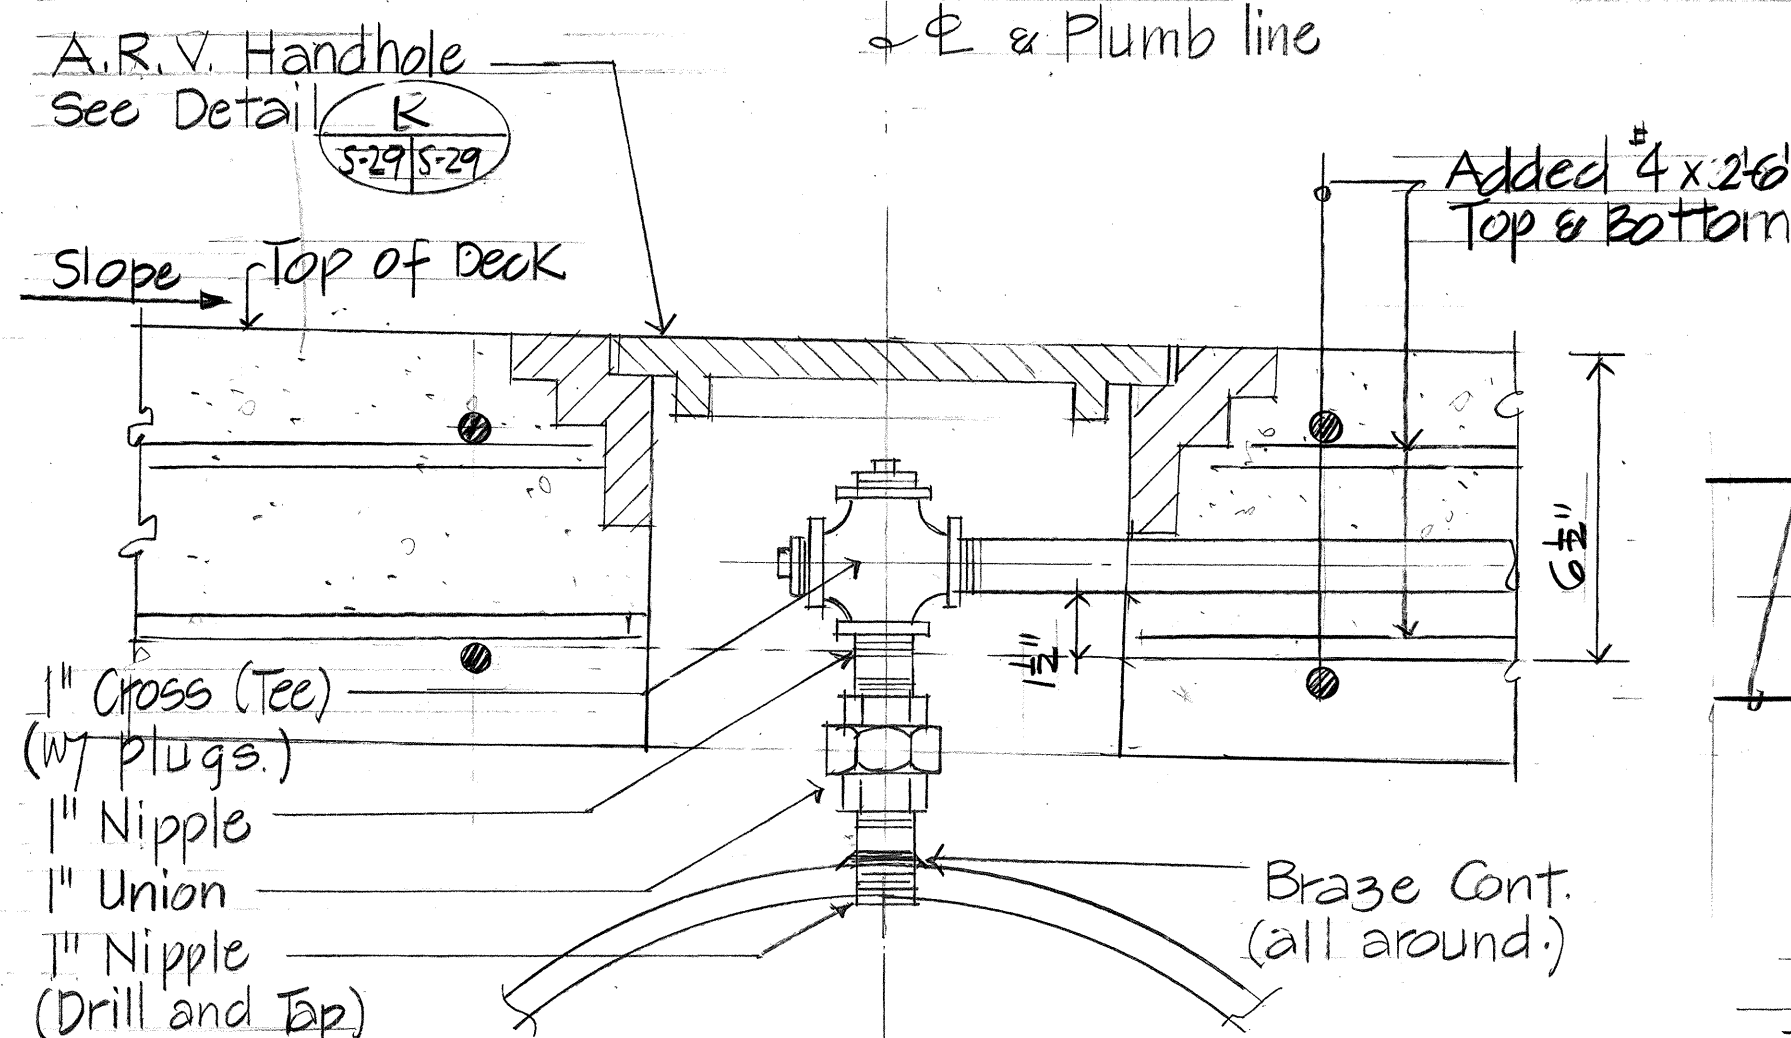

DETAIL E


Scale: 3" = 1'-0" S-29 S-29

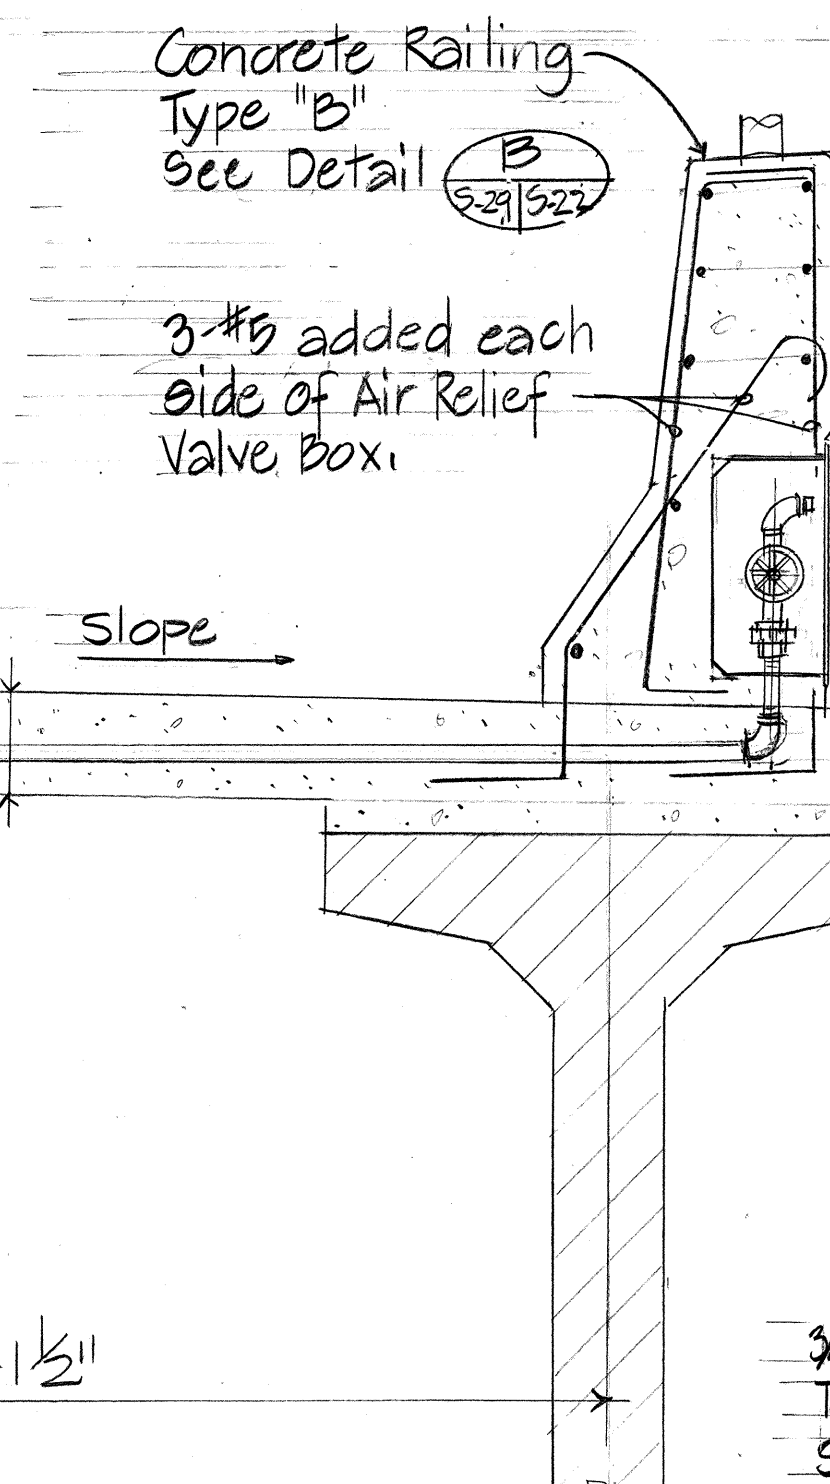


SECTION B
Sca|e: $\frac{1}{2}'' = 1'-0''$ S-29 S-29

SECTION C
Scale: $1/2" = 1'-0"$ S-29 S-29

DETAIL L
N.T.S. S-29 | S-29

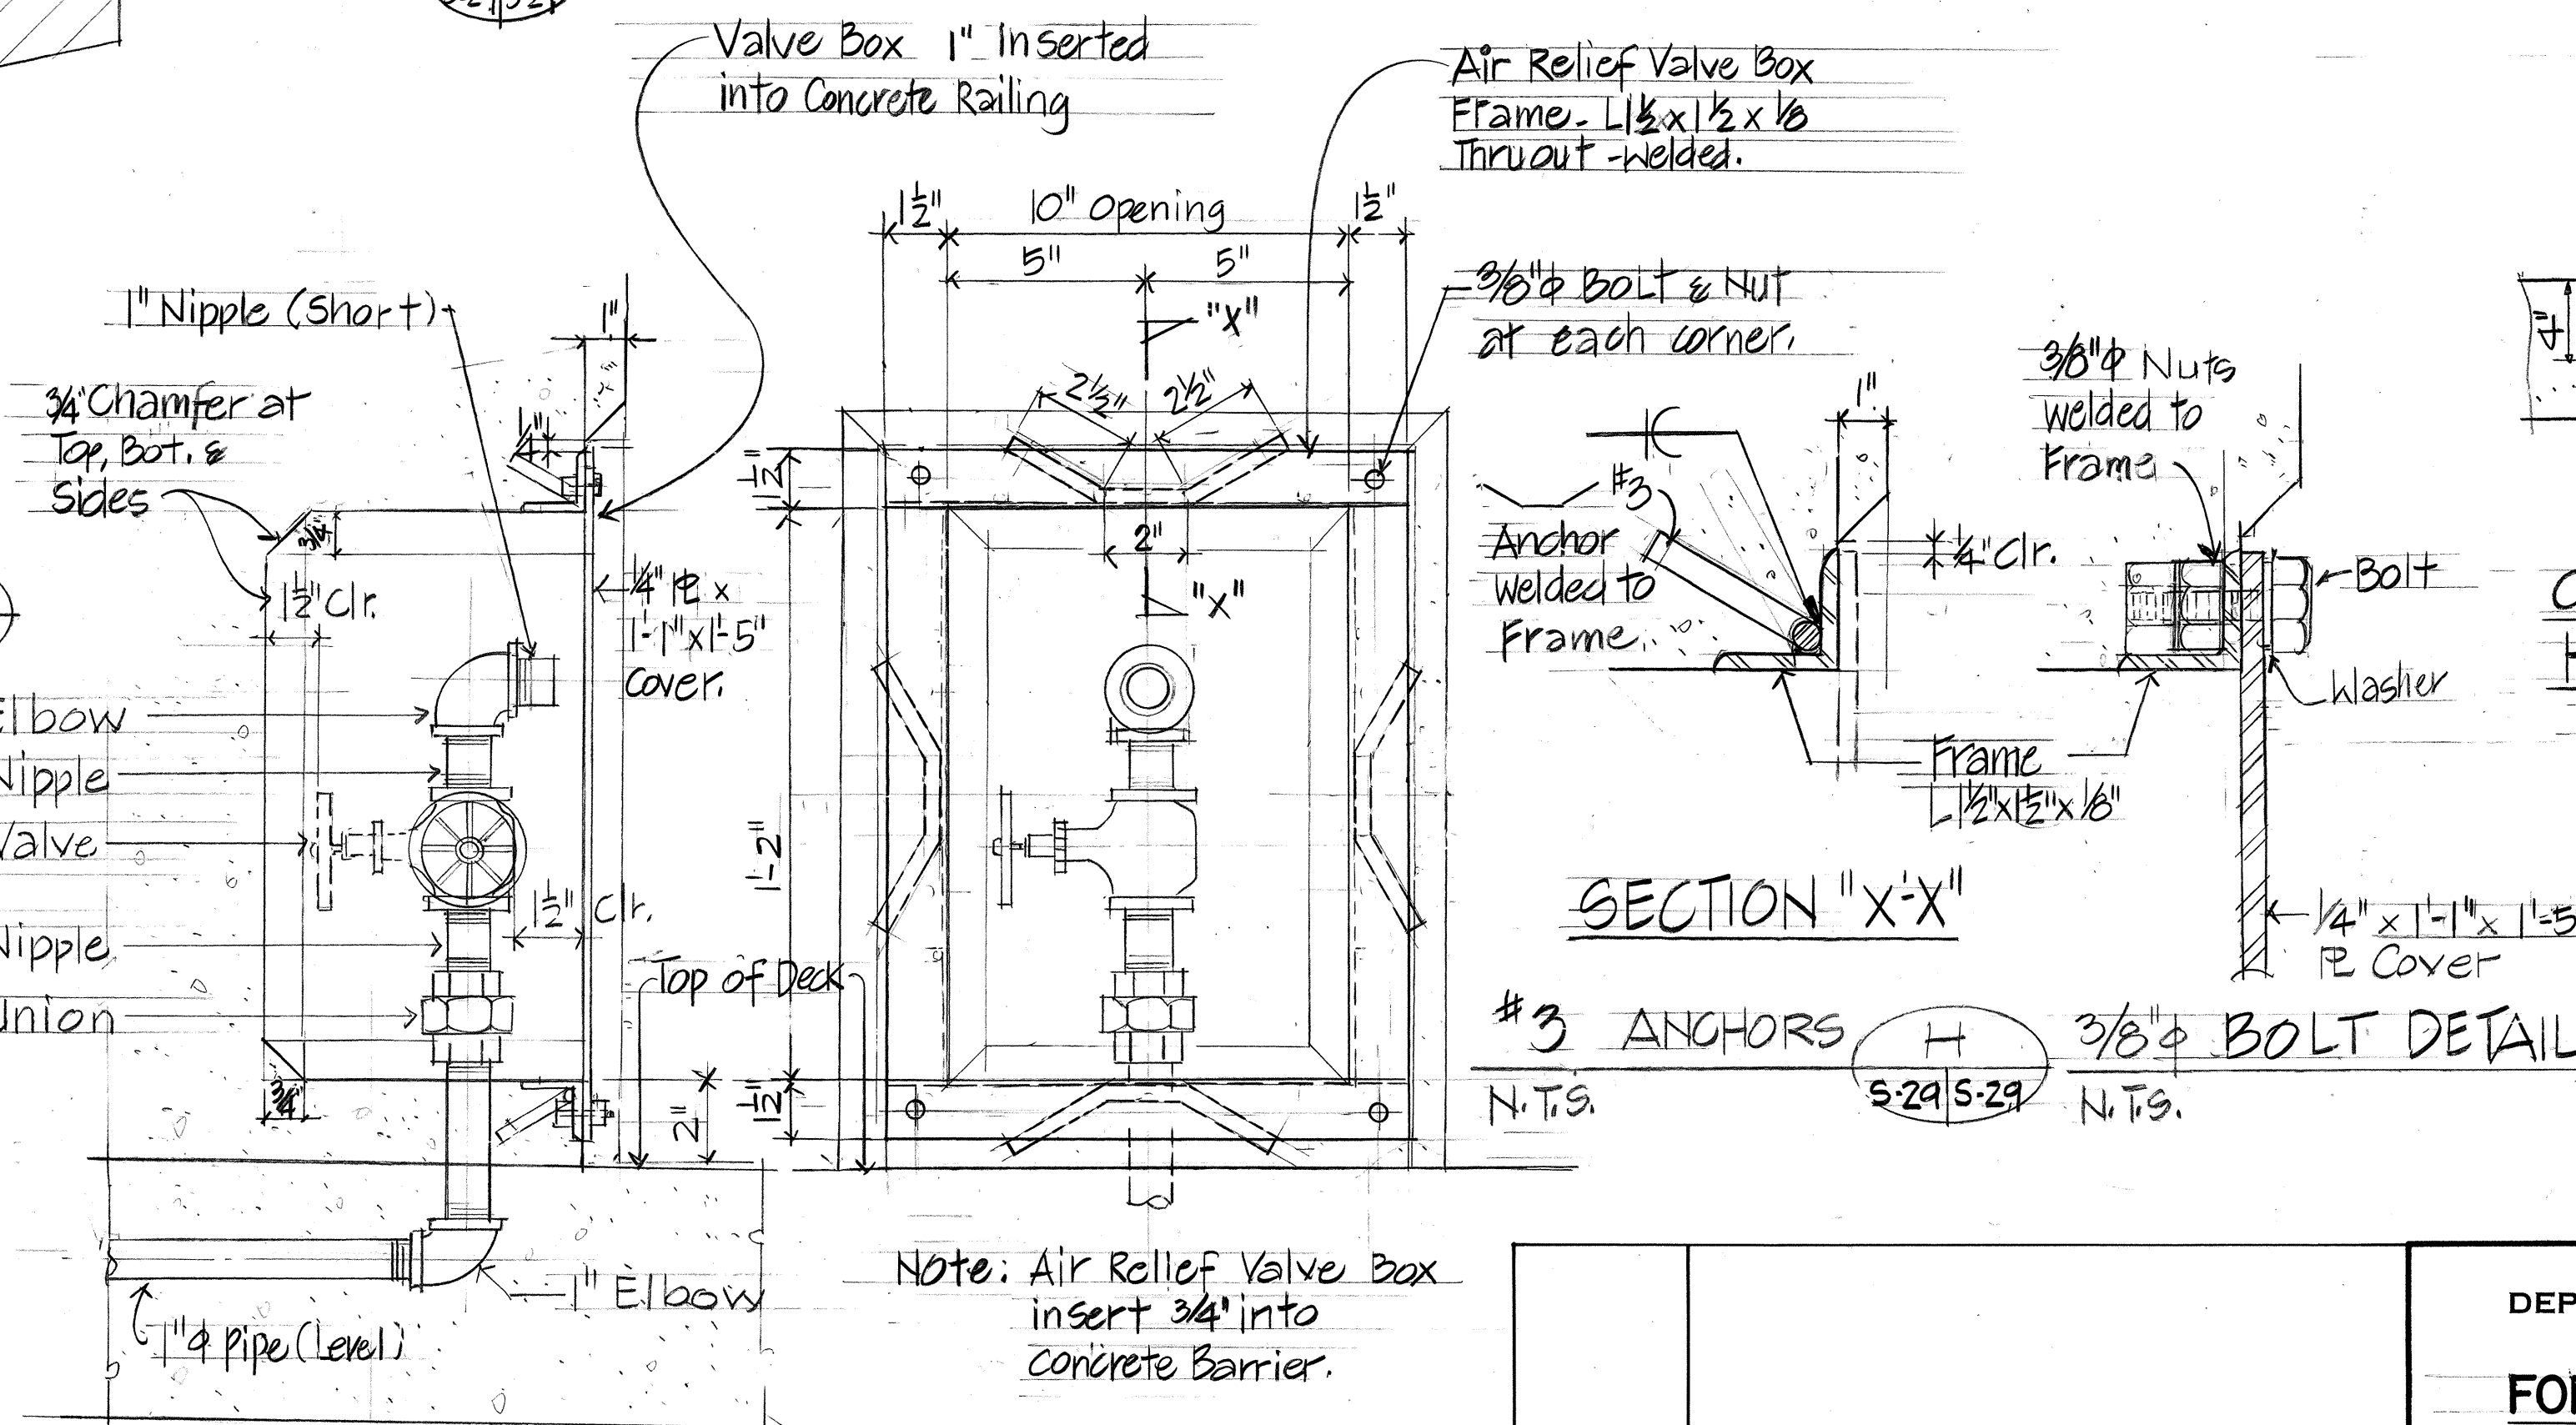


COVER & FRAME - A.R.V.
HAND HOLE DET K
N.T.S. 5-29 | 5-29

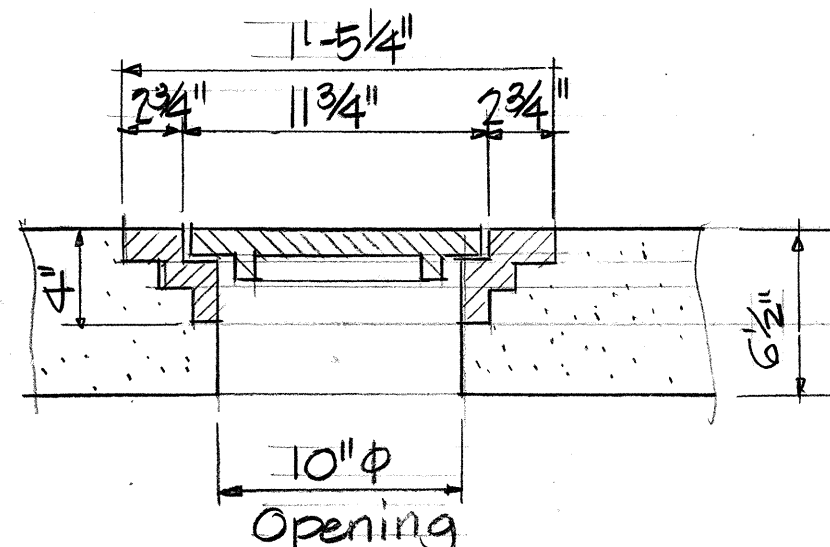

SECTION "X'-X"

#3 ANCHORS H
N.T.S. S-29 S-29

3/8" BOLT DETAIL
N.T.S.

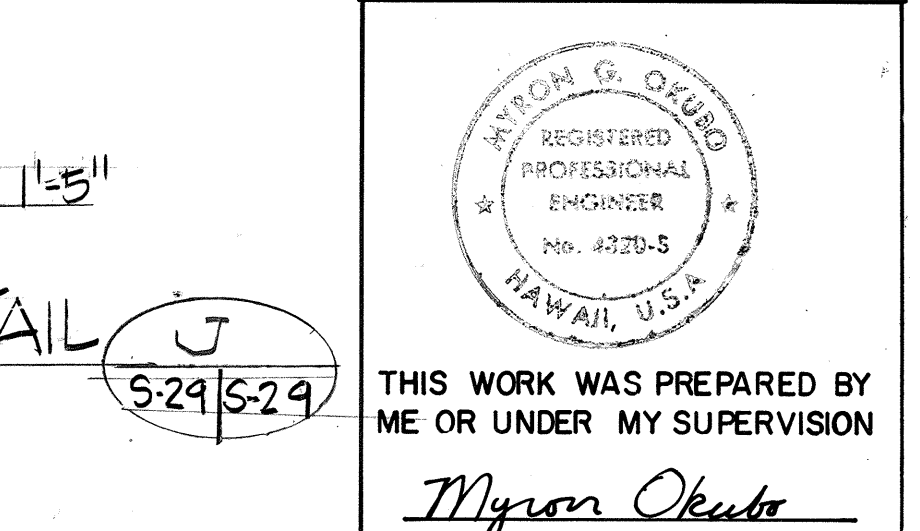

THIS WORK WAS PREPARED BY
ME OR UNDER MY SUPERVISION

Myron Okubo

STATE OF HAWAII
DEPARTMENT OF TRANSPORTATION
HIGHWAYS DIVISION

FORCE MAIN DETAILS

SAND ISLAND ROAD WIDENING
2ND. BRIDGE AND APPROACHES
FEDERAL AID PROJECT NO. F-064-1(2)

SCALE: AS NOTED DATE: JUN, 1986










SHEET No.5-29 OF 30 SHEETS

ORIGINAL PLAN	SURVEY PLOTTED BY _____	DATE _____
NOTE BOOK	DRAWN BY _____	_____
	TRACED BY _____	_____
	DESIGNED BY _____	_____
	QUANTITIES BY _____	_____
No. _____	CHECKED BY _____	_____

DATE	REVISION
------	----------

13

FED. ROAD DIST. NO.	STATE	FED. AID PROJ. NO.	FISCAL YEAR	SHEET NO.	TOTAL SHEETS
HAWAII	HAW.	F-064-1(2)	1987	132	151

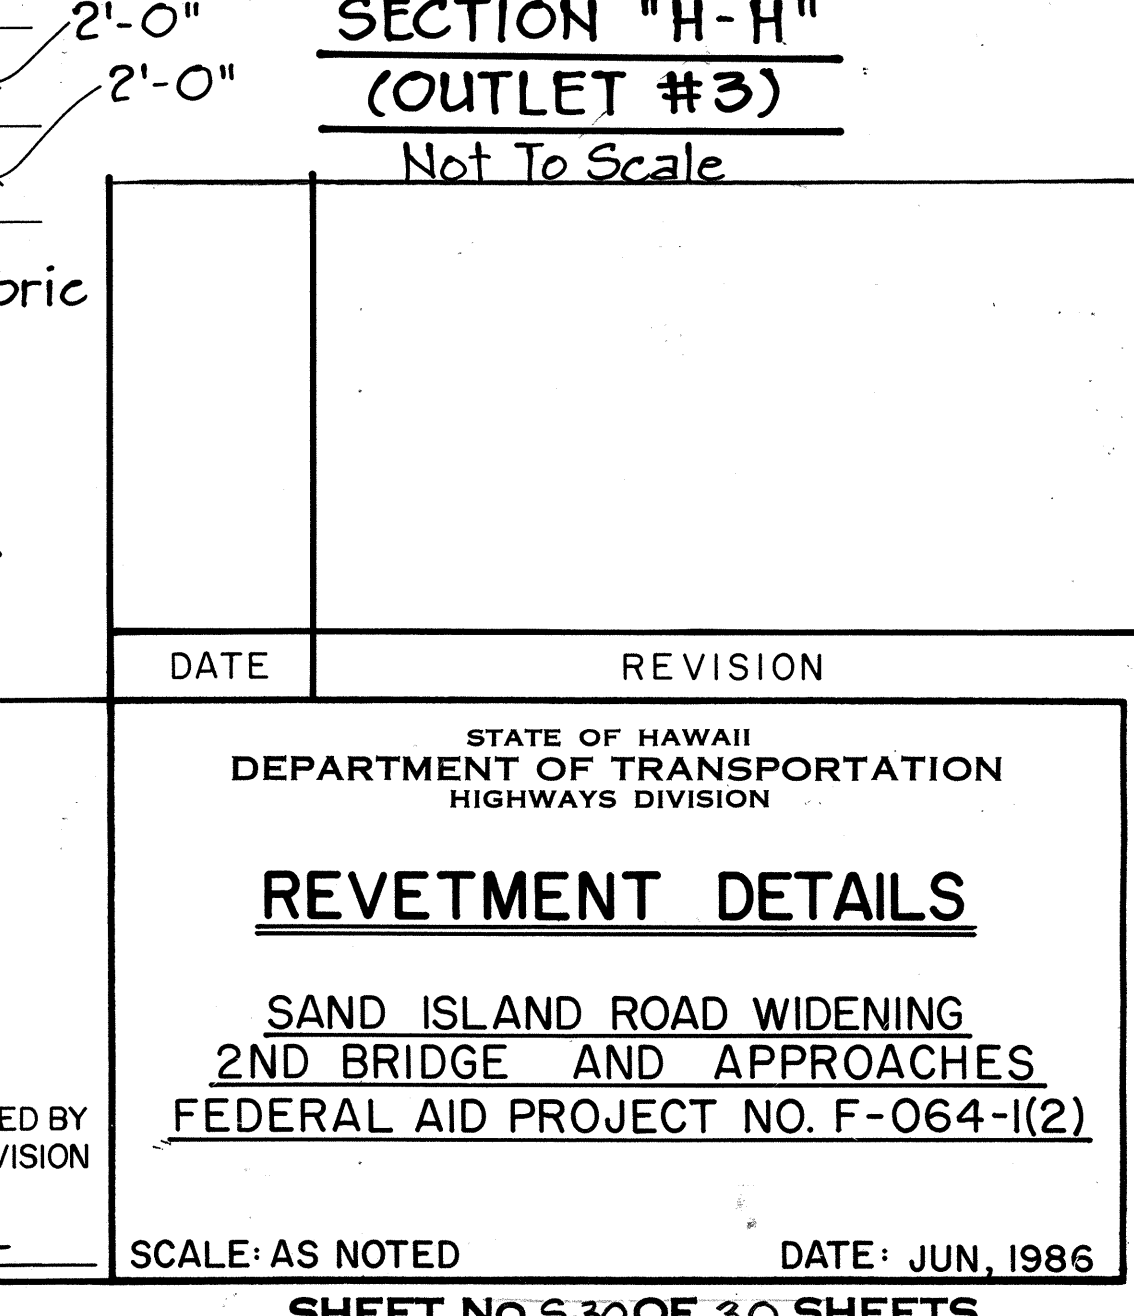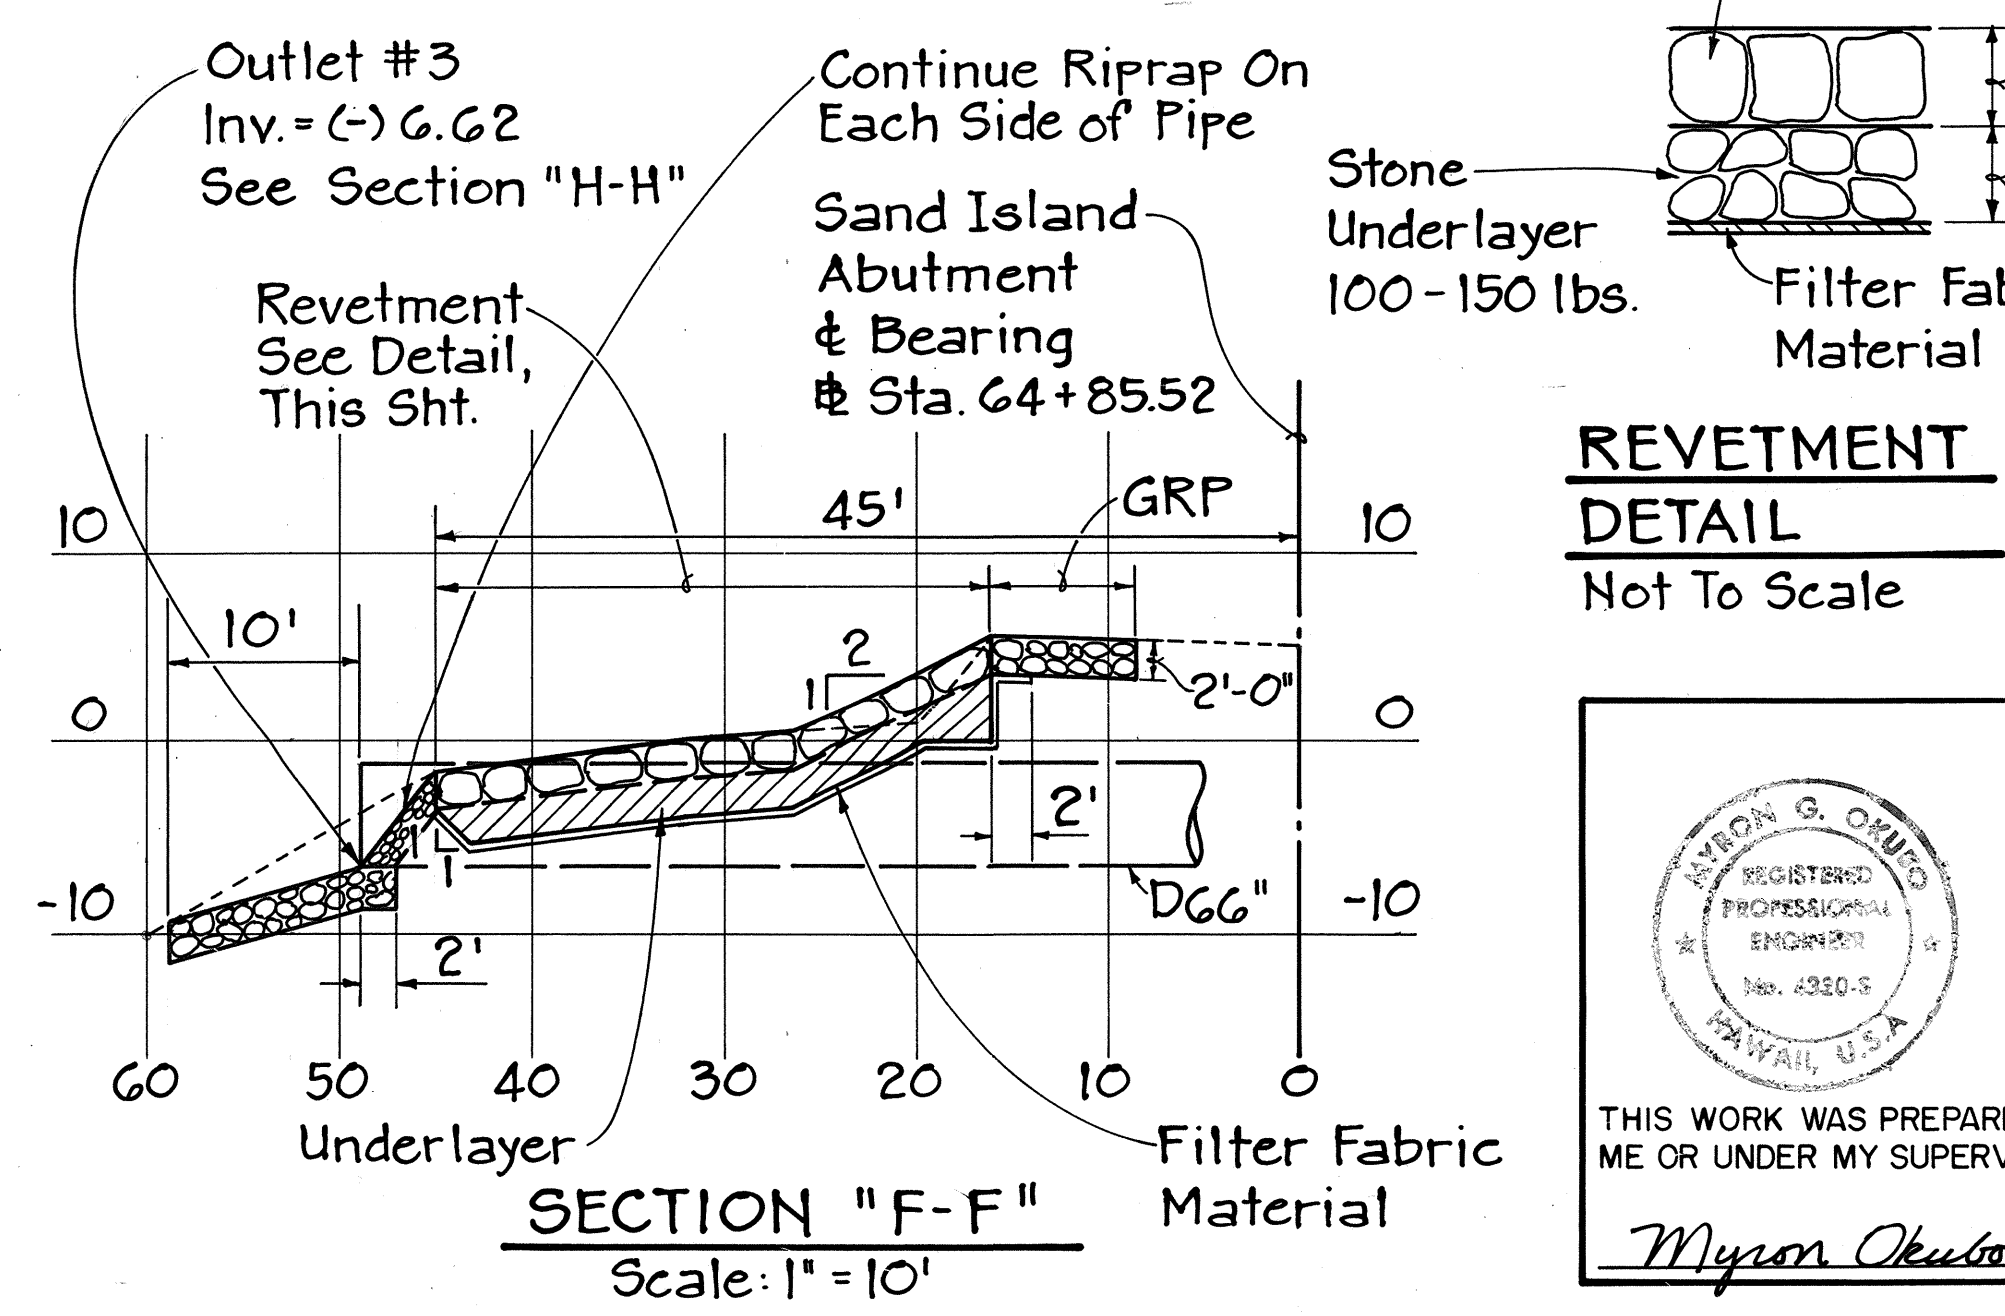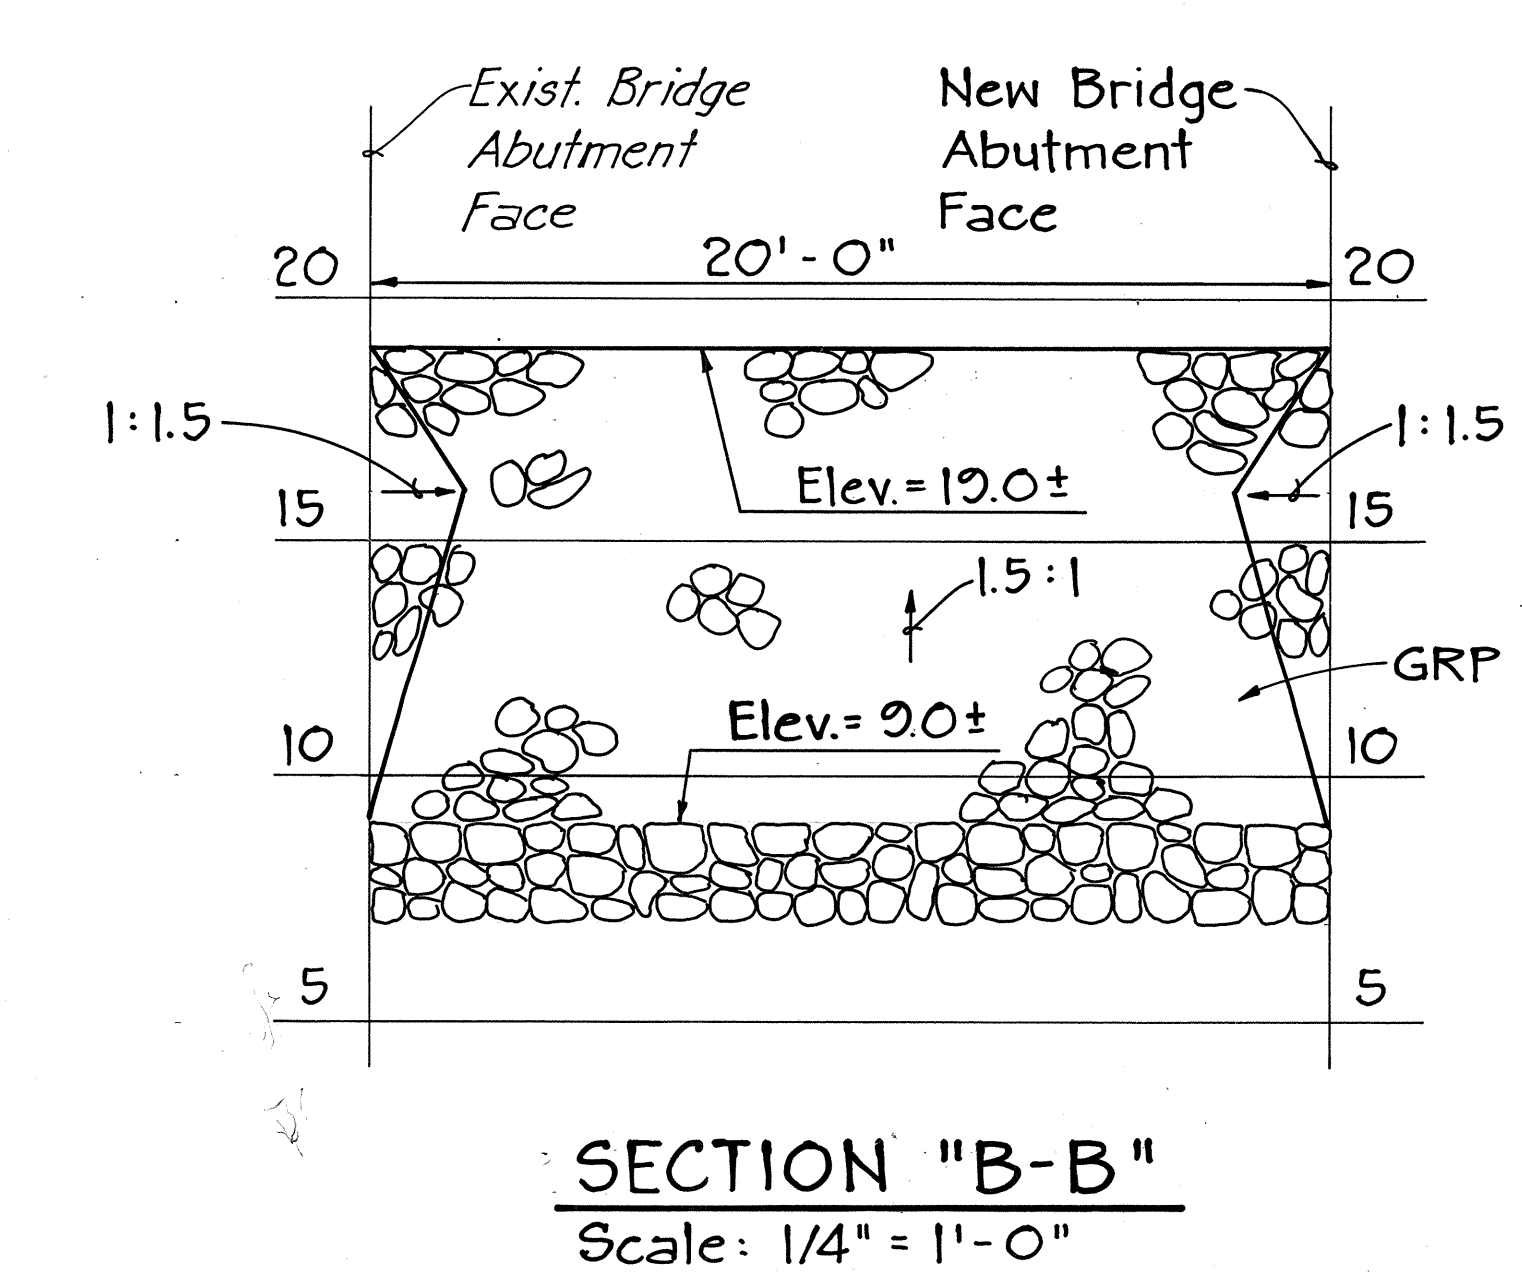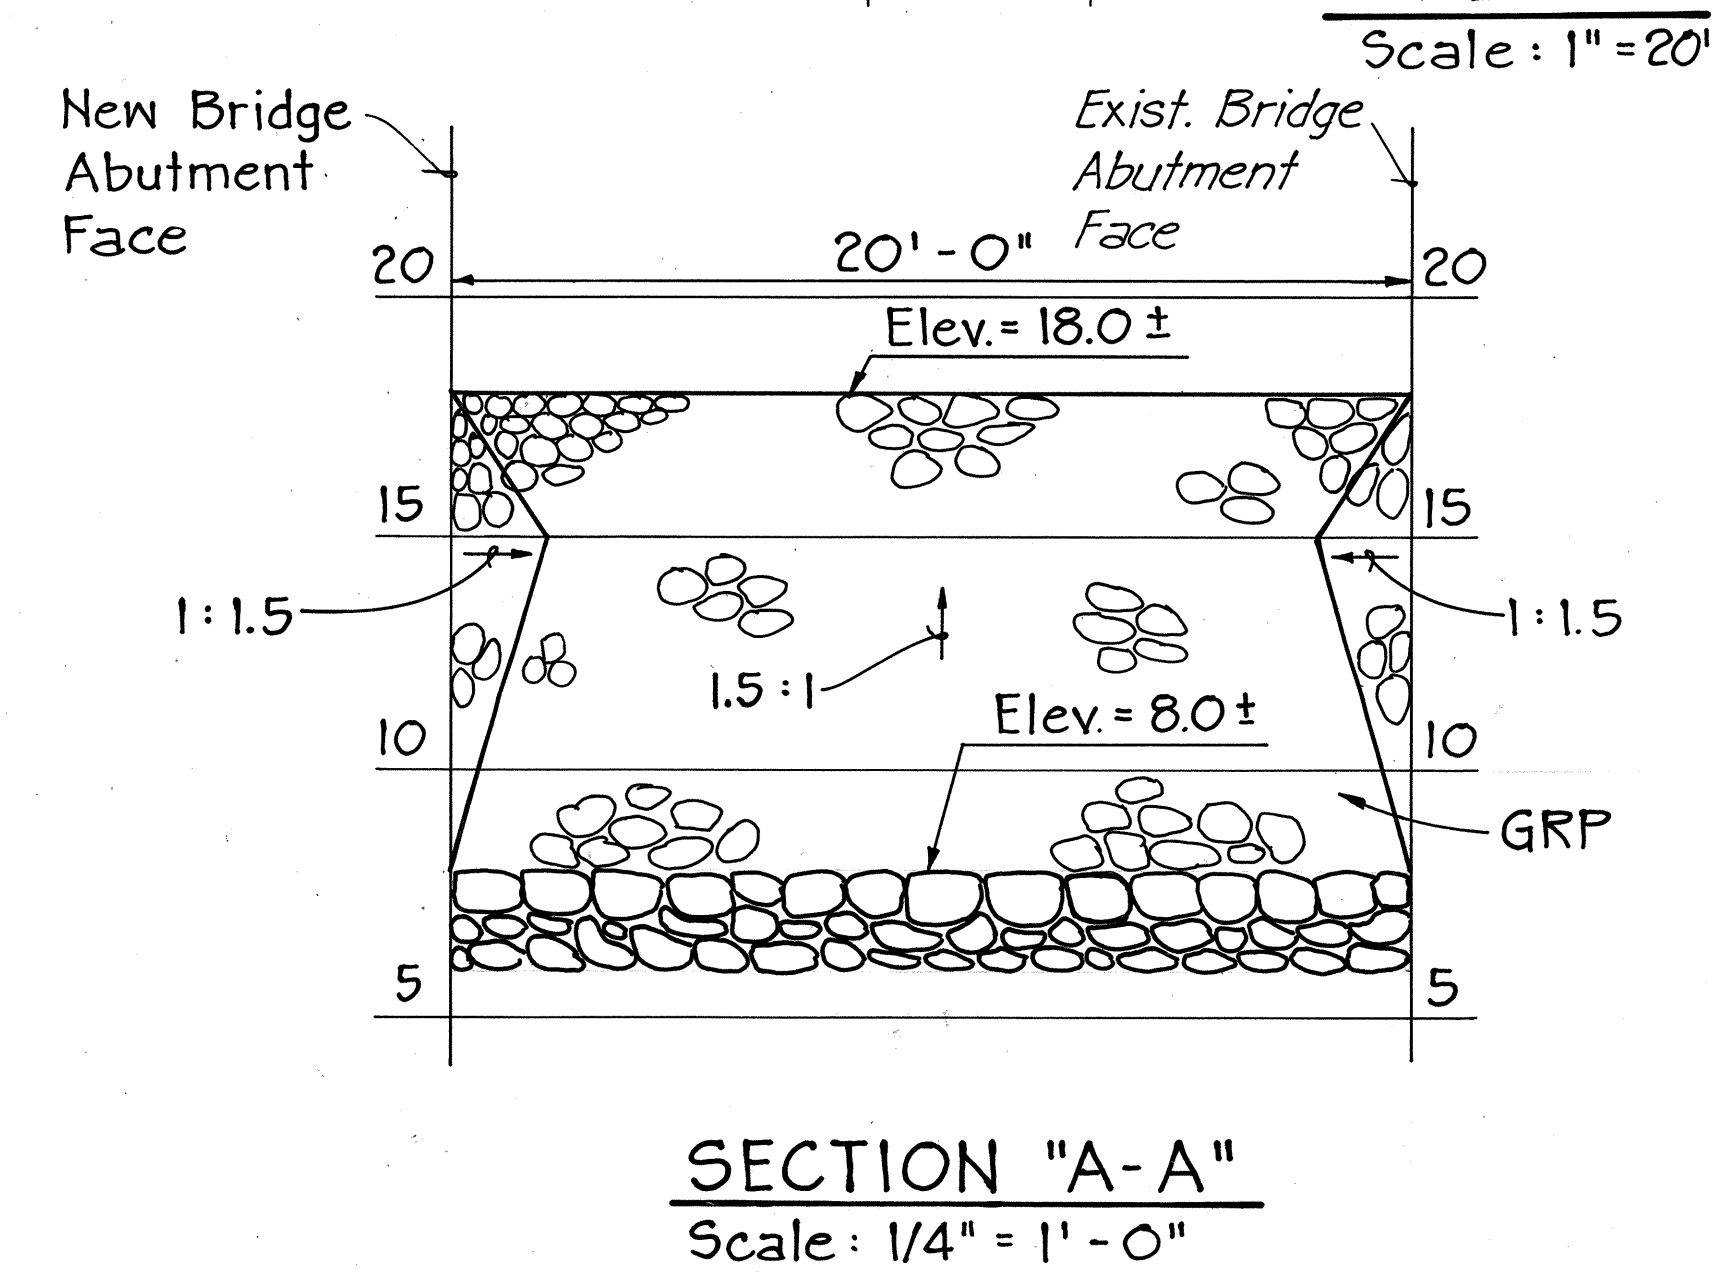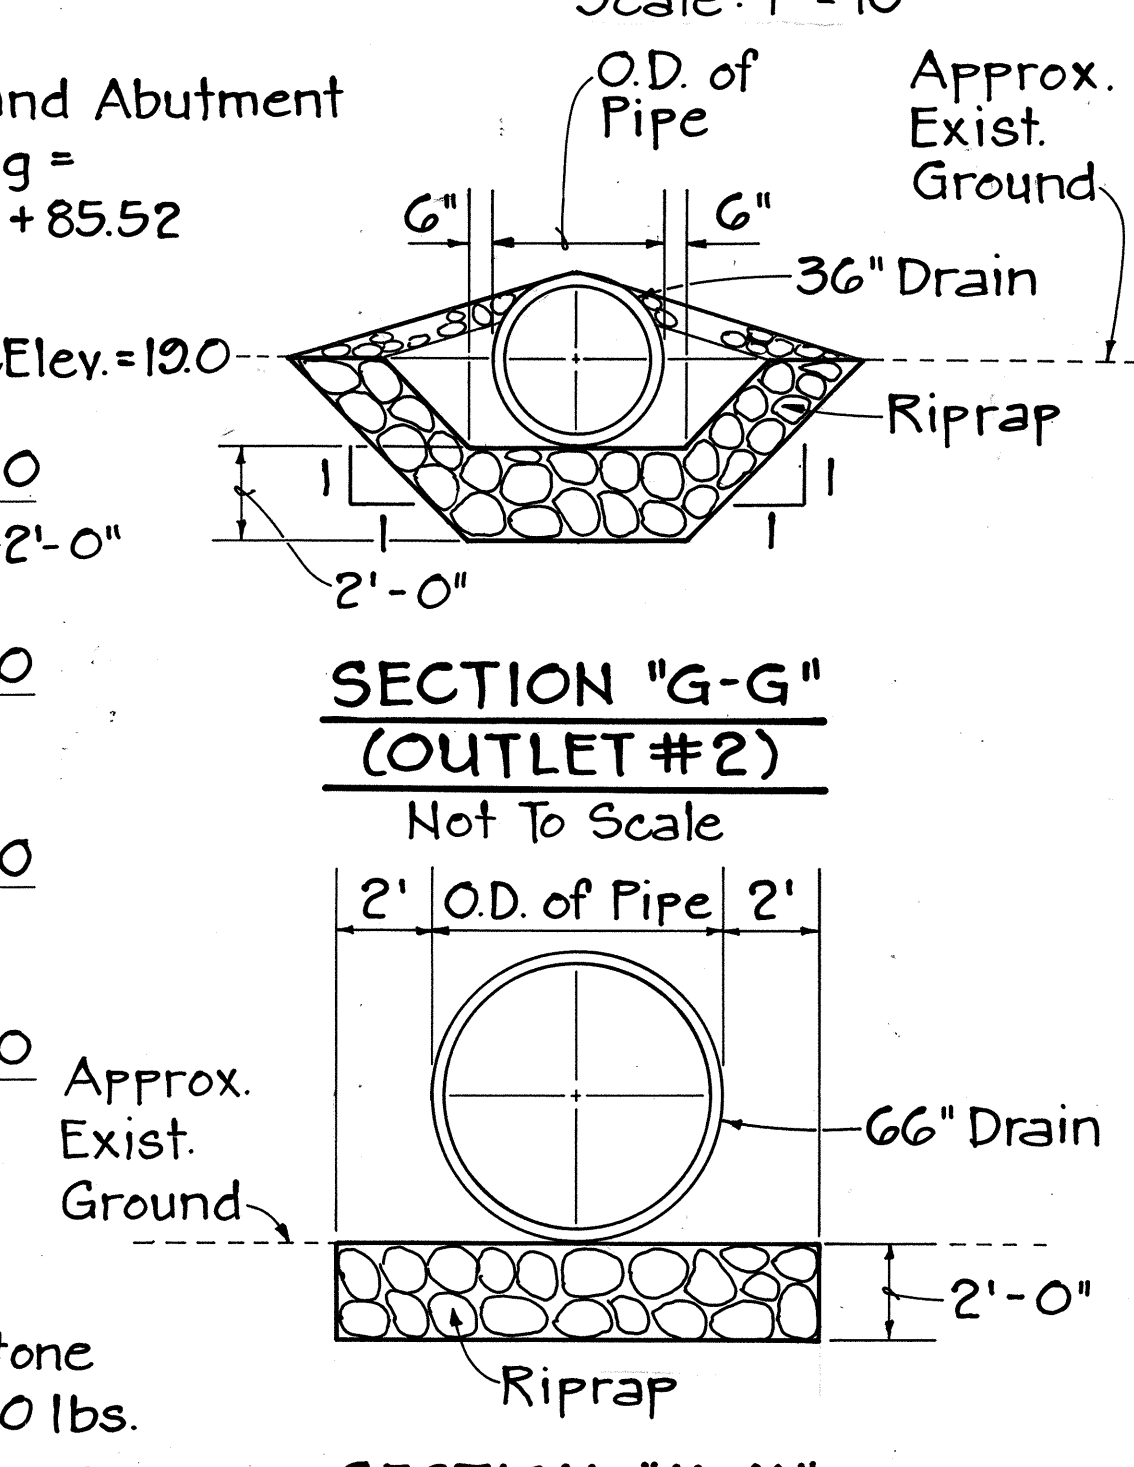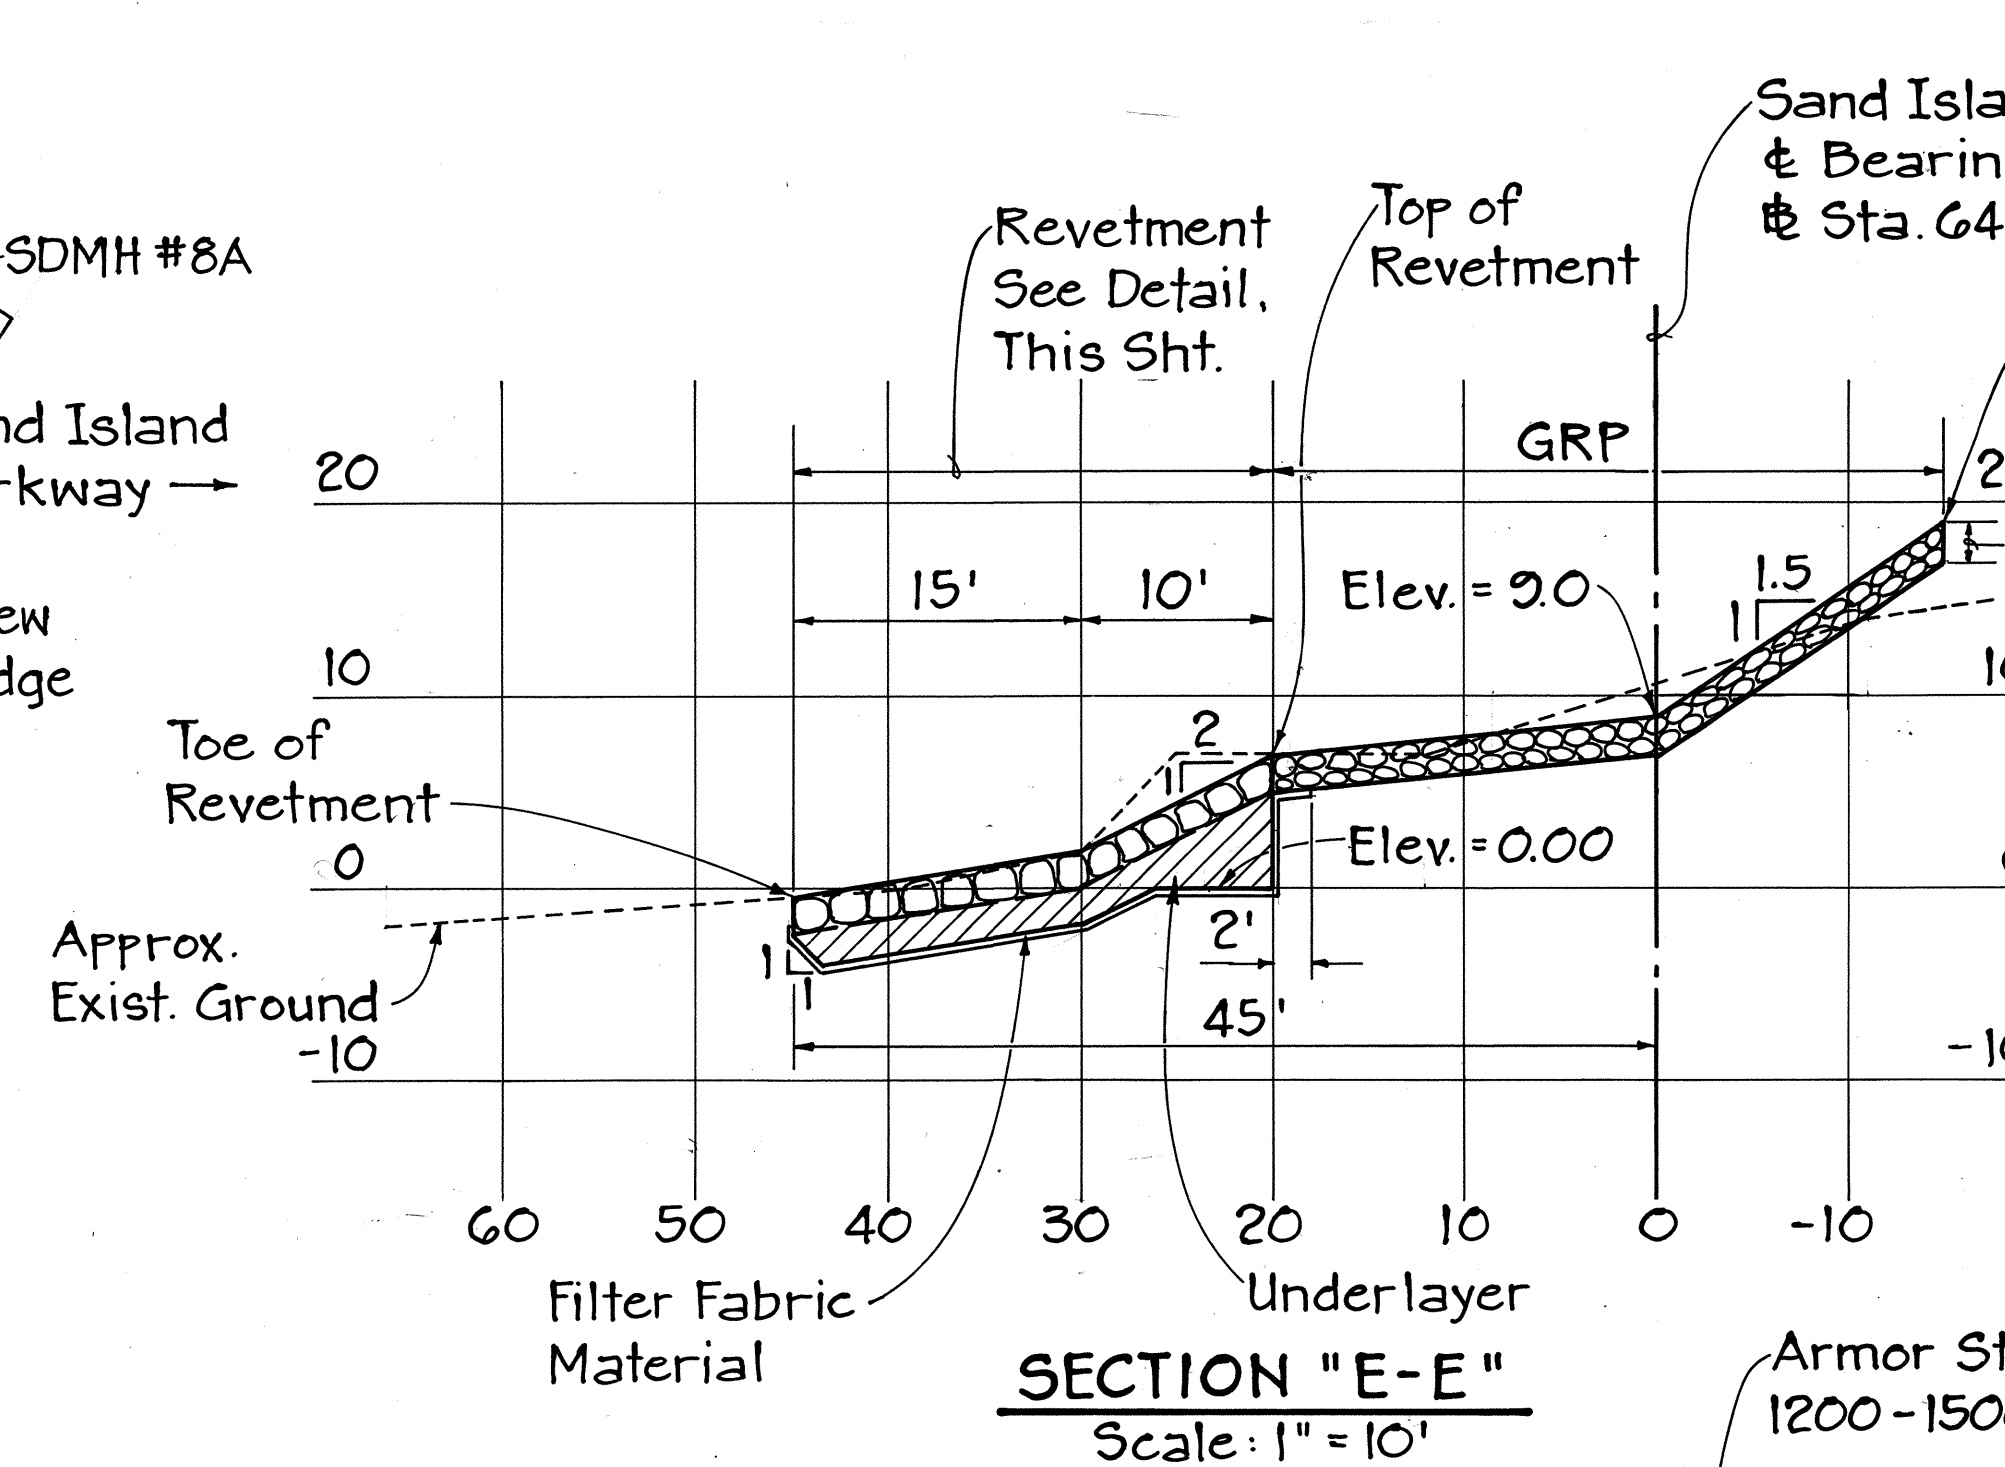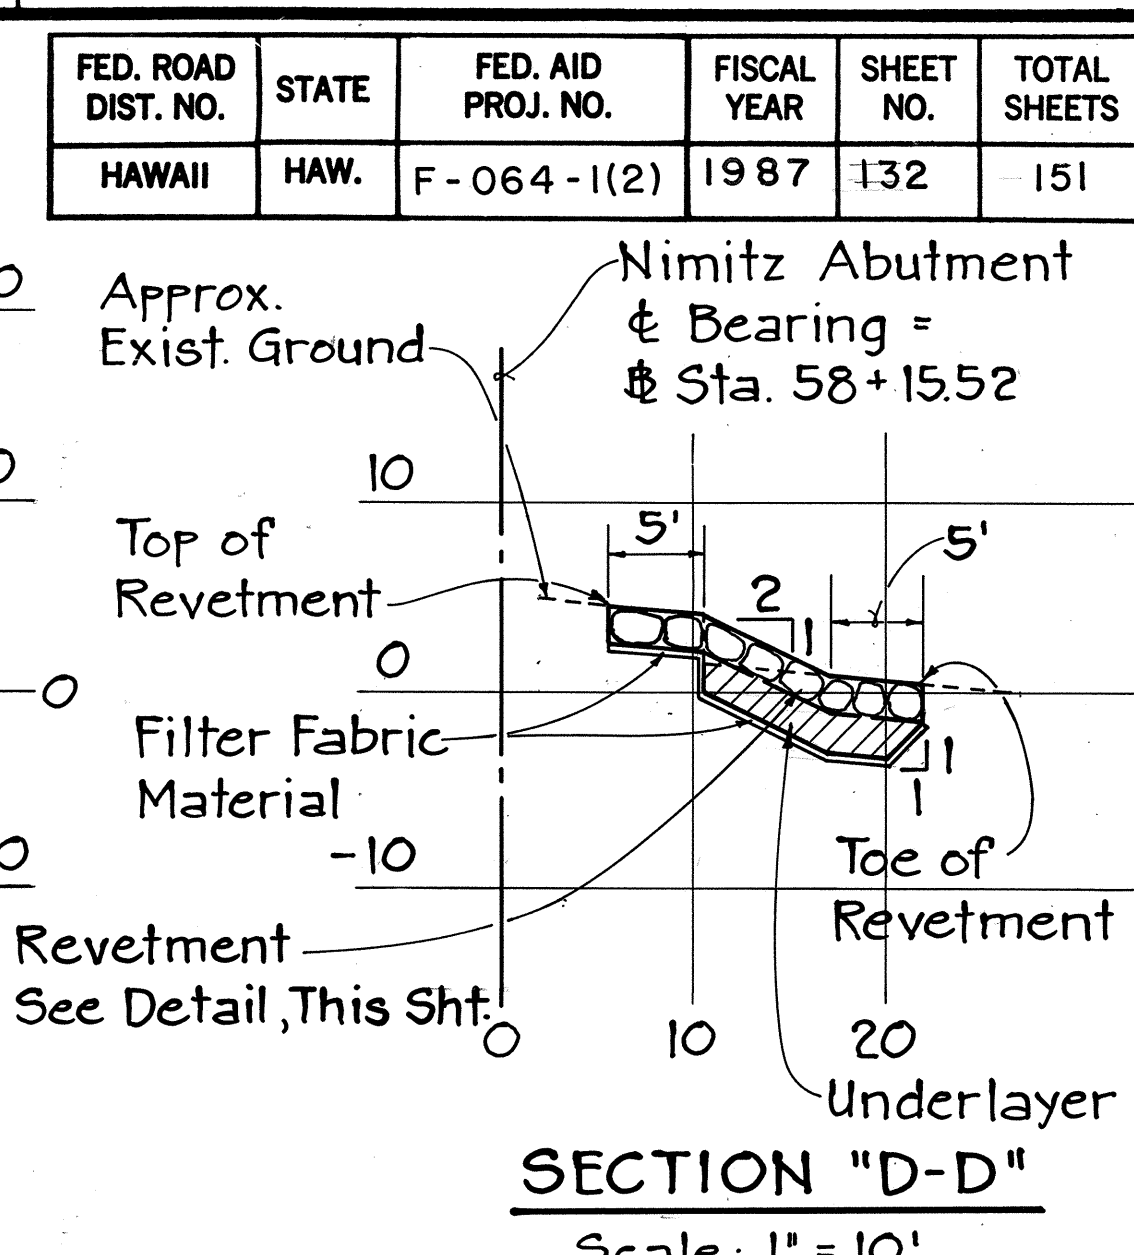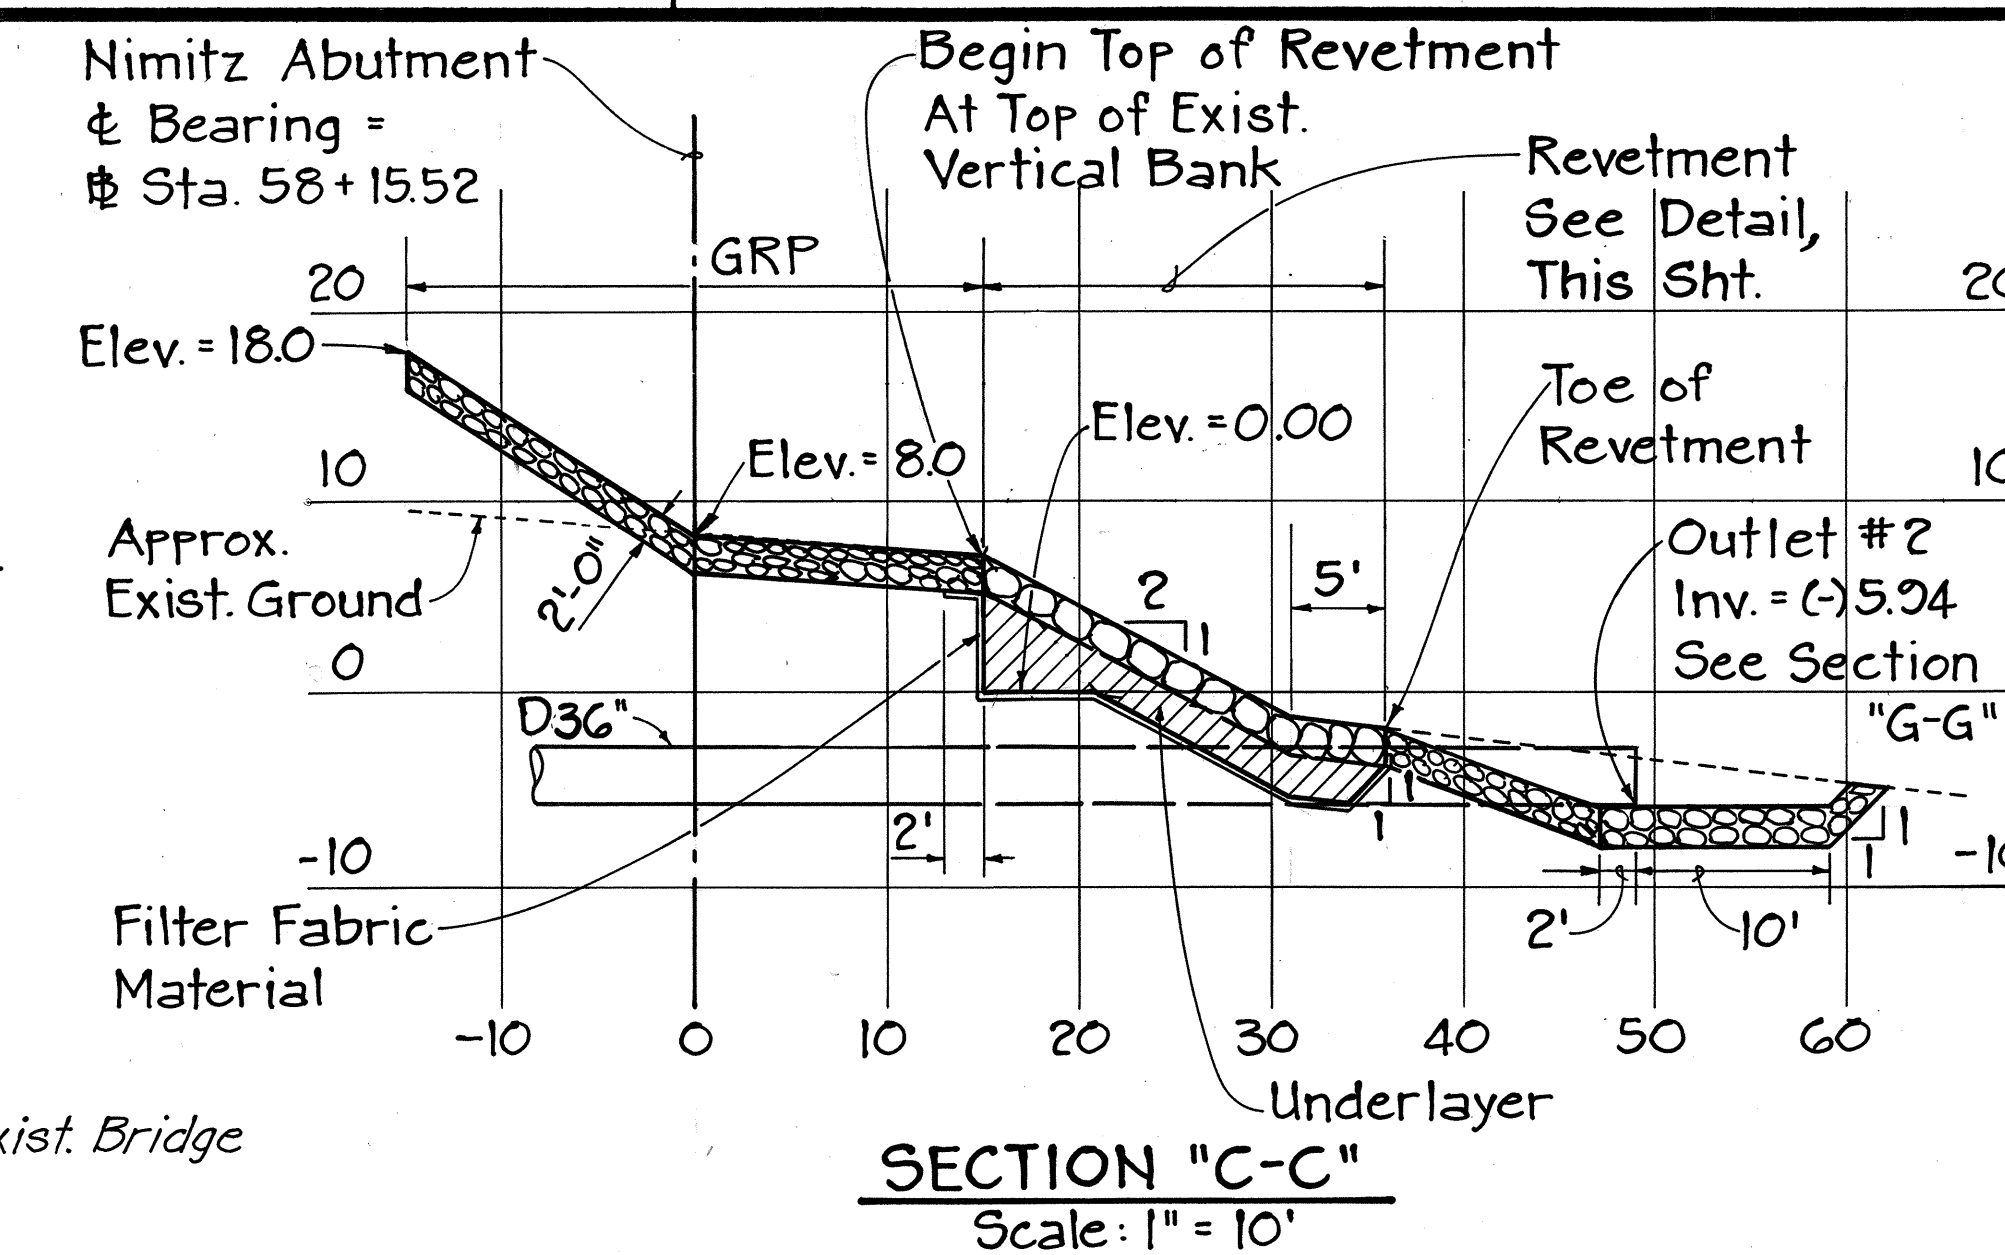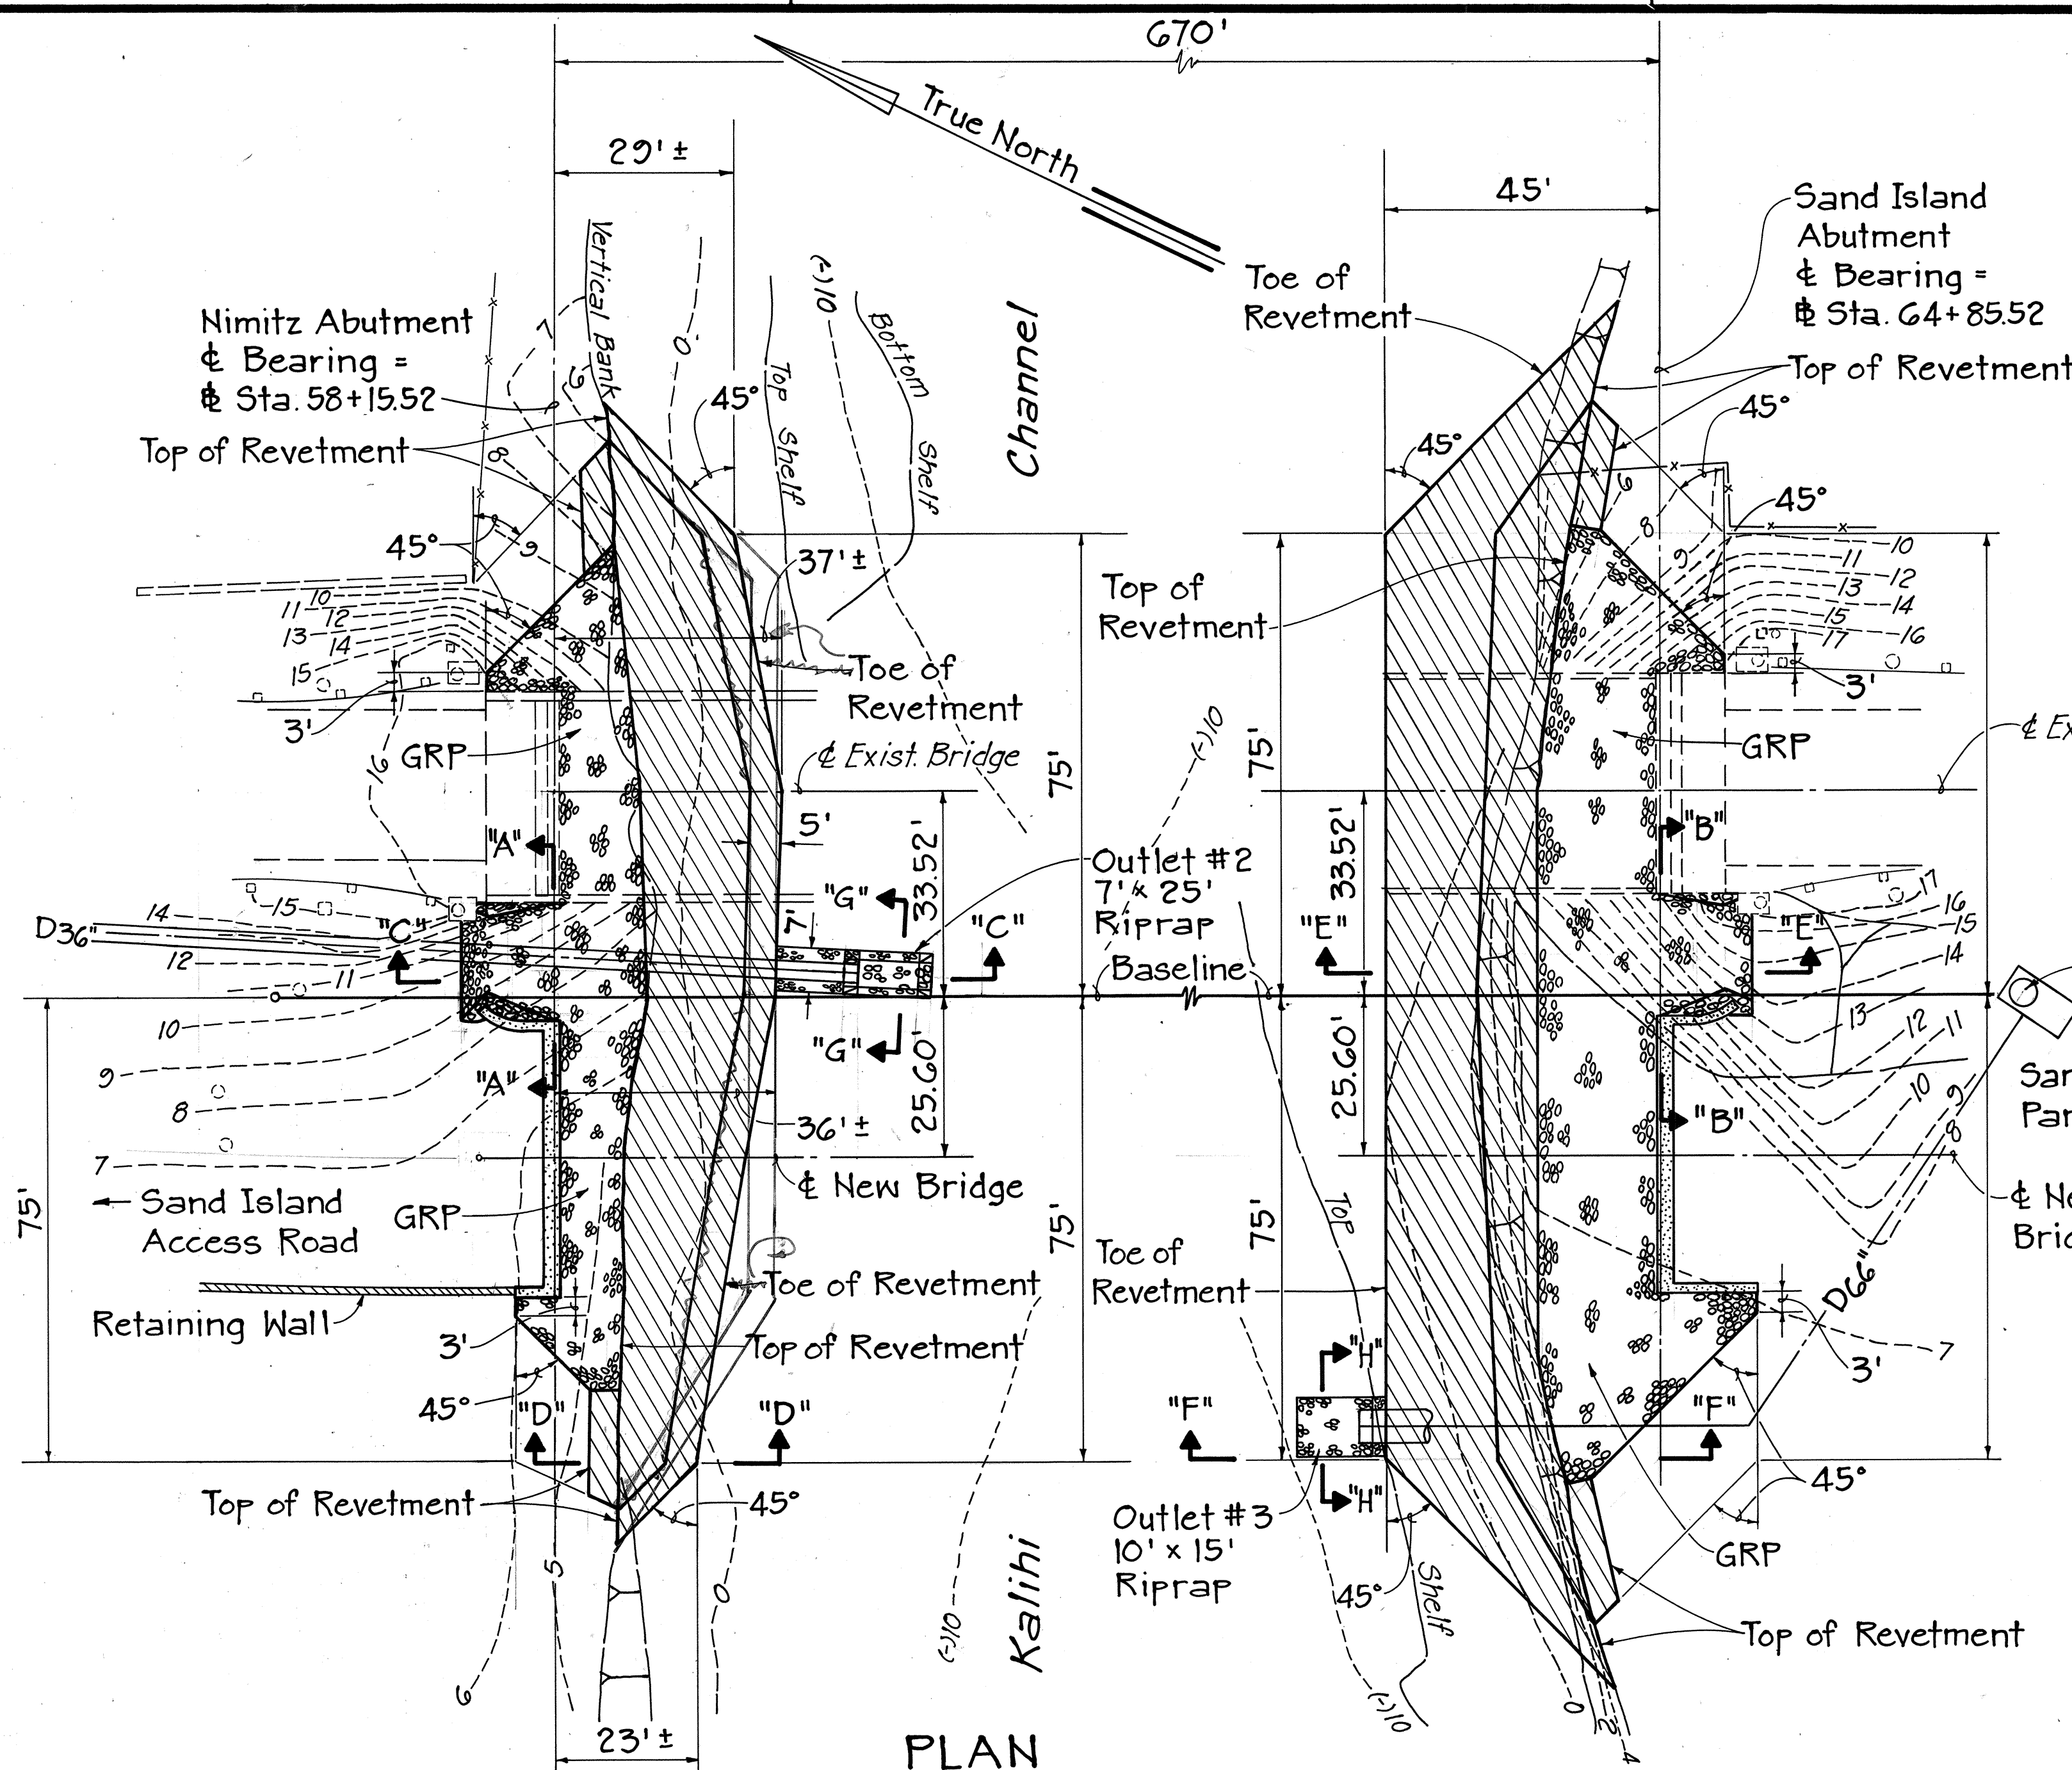

REVTMENT DETAIL
Not To Scale

THIS WORK WAS PREPARED BY
ME OR UNDER MY SUPERVISION
Myron Okubo


STATE OF HAWAII
DEPARTMENT OF TRANSPORTATION
HIGHWAYS DIVISION

REVTMENT DETAILS

SAND ISLAND ROAD WIDENING
2ND BRIDGE AND APPROACHES
FEDERAL AID PROJECT NO. F-064-1(2)

SCALE: AS NOTED DATE: JUN, 1986
SHEET NO. 53 OF 30 SHEETS

FED. ROAD DIST. NO.	STATE	FED. AID PROJ. NO.	FISCAL YEAR	SHEET NO.	TOTAL SHEETS
HAWAII	HAW.	BR-F-064-1(2)	1987	132 A	151

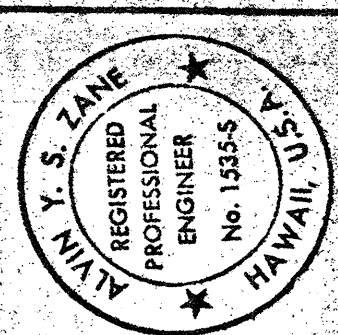

THIS WORK WAS PREPARED BY ME OR UNDER MY SUPERVISION

OWNERSHIP OF DOCUMENTS
This document, and the ideas and designs incorporated as an instrument of professional service, is the property of Alvin Zane and Associates, Inc., and is not to be used, in whole or in part, for any project other than that for which it was prepared by Alvin Zane and Associates, Inc.

ALVIN ZANE & ASSOC.
CIVIL & STRUCTURAL ENGINEERS
FIRST INTERSTATE BANK BLDG.
1314 S. KING ST.
HONOLULU, HAWAII 96814
TELEPHONE: 524-3478



CONTRACTOR: KIEWIT PACIFIC CO.
2828 PAA STREET, SUITE 3060
HONOLULU, HI 96819
SAND ISLAND ROAD WIDENING
SIDEWALK BRIDGE AT STA. 36+10
PLANS, ELEVATION & GEN. NOTES


SHEET
OF 5 SHEETS
JOB NO. 88-21
DATE: 6/2/89

DESIGN DATA:

- SIDEWALK LIVE LOADS:
 - UNIFORM LOAD: 85 PSF
 - TRUCK LOAD: HS-20-44
- WIND PRESSURE: 50 PSF
- SEISMIC ZONE 2: $A = 0.09g$, $F = 1.0$, $C = 0.08$
- EARTH LATERAL (EQUIVALENT FLUID) PRESSURES AND COEFFICIENT:
 - ACTIVE: 40 PCF ($K_a = 0.33$)
 - PASSIVE: 200 PCF
 - COEFFICIENT OF FRICTION: 0.5
- ALLOWABLE SOIL BEARING PRESSURES:
 - NET AVERAGE PRESSURE: 1,000 PSF
 - NET TOE PRESSURE: 1,300 PSF


GENERAL NOTES:

- MATERIALS:
 - CONCRETE MINIMUM COMPRESSIVE STRENGTH AT 28 DAYS SHALL BE 4,000 PSI.
 - REINFORCING STEEL: ASTM A615, DEFORMED BARS
#4 AND SMALLER: $F_y = 40$ KSI (MIN.)
#5 AND LARGER: $F_y = 60$ KSI
 - ELASTOMERIC BEARING PADS: HARDNESS, 60 IS DUROMETER; MIN. TENSILE STRENGTH, 2,500 PSI.
- THE CONTRACTOR SHALL VERIFY ALL DIMENSIONS, ELEVATIONS AND LOCATION OF EXISTING AND NEW WORK PRIOR TO FABRICATION AND CONSTRUCTION.
- ALL REINFORCING STEEL MARKED CONTINUOUS (CONT.) SHALL BE LAPPED AT ALL SPLICES AND CORNERS 40 BAR DIAMETERS, UNLESS NOTED OTHERWISE.
- ALL CONCRETE WORK SHALL BE IN ACCORDANCE WITH ACI MANUAL OF CONCRETE PRACTICE, LATEST EDITION.
- WELDING OF REINFORCING STEEL SHALL BE IN ACCORDANCE WITH AWS D1.4, LATEST EDITION.
- EDGES OF ALL EXPOSED CORNERS SHALL BE CHAMFERED $\frac{3}{4}'' \times \frac{3}{4}''$
- UNLESS INDICATED OTHERWISE, ALL WORK SHALL BE IN ACCORDANCE WITH THE STATE OF HAWAII, DEPT. OF TRANSPORTATION, HIGHWAYS DIV., PROJECT "SAND ISLAND ROAD WIDENING, 2ND BRIDGE AND APPROACHES, FEDERAL AID PROJECT NO. F-064-1(2)".

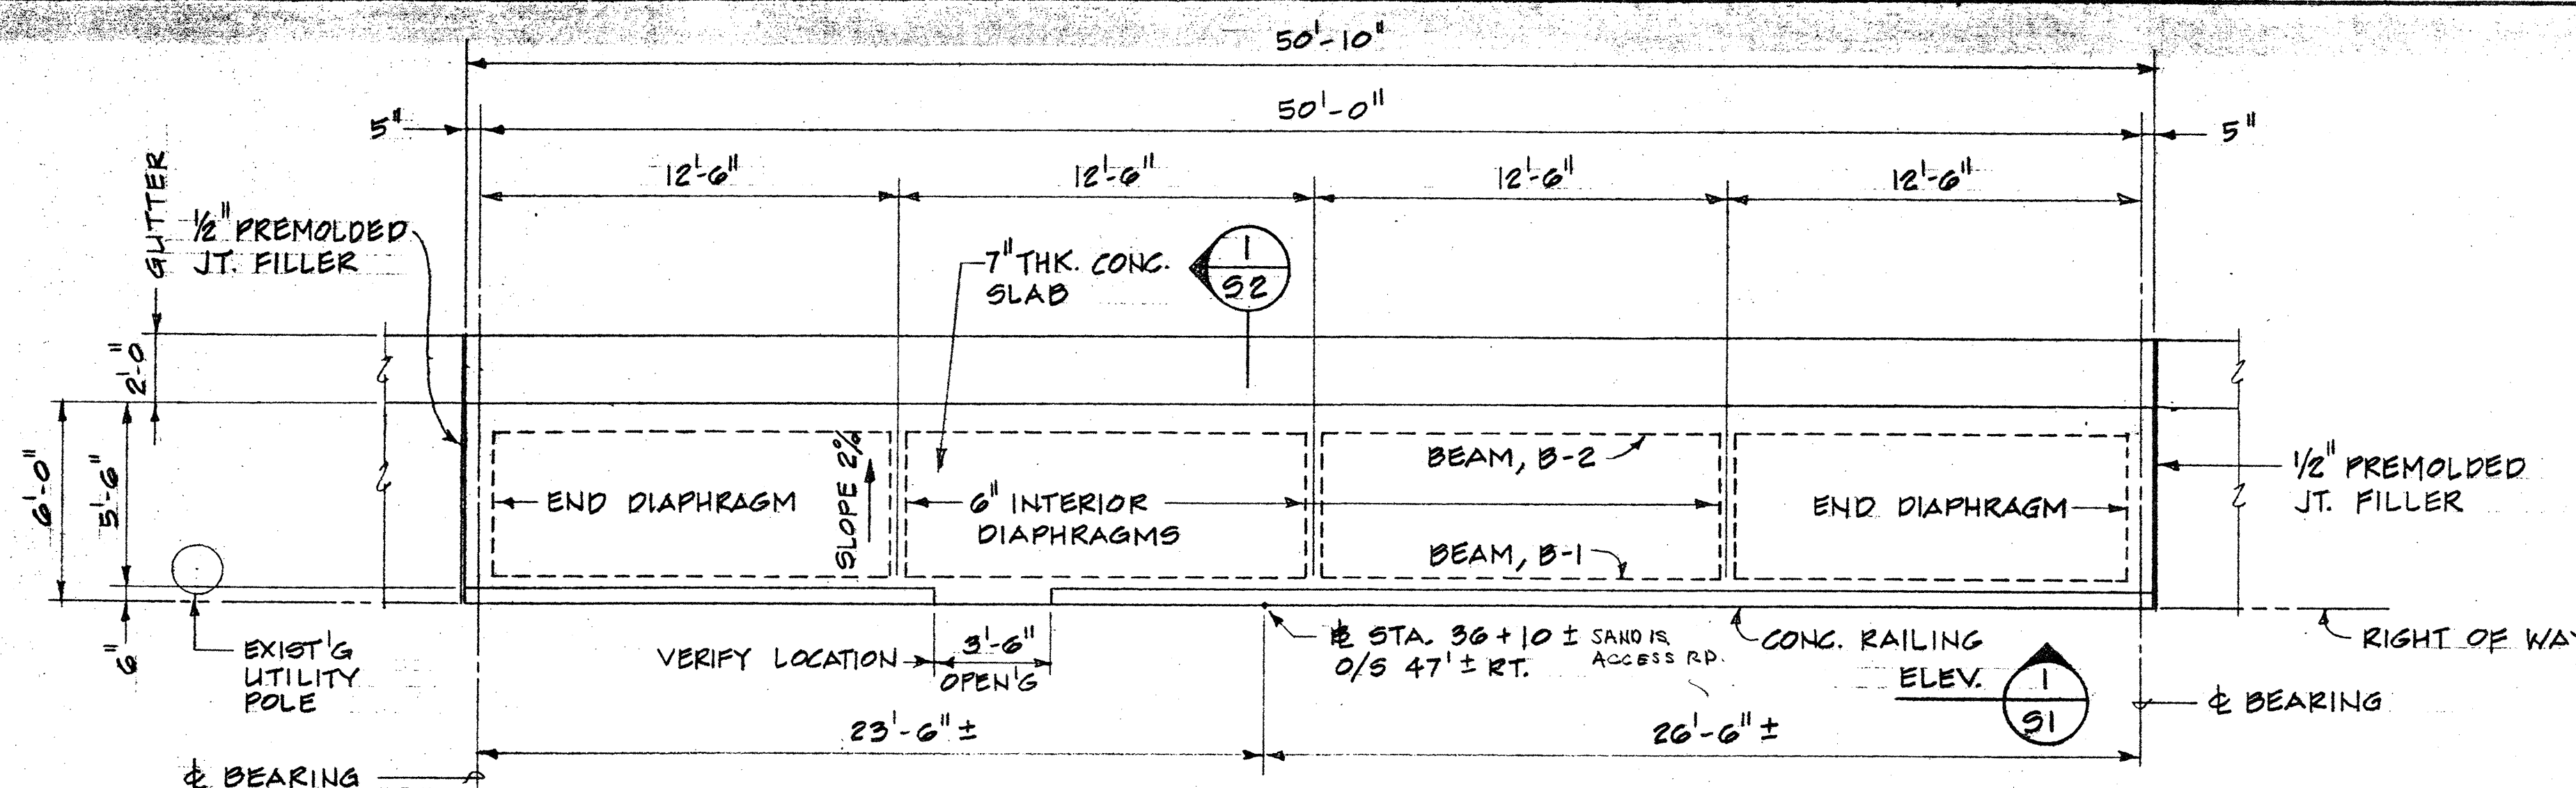


PLAN

SCALE: $\frac{1}{4}'' = 1'-0''$

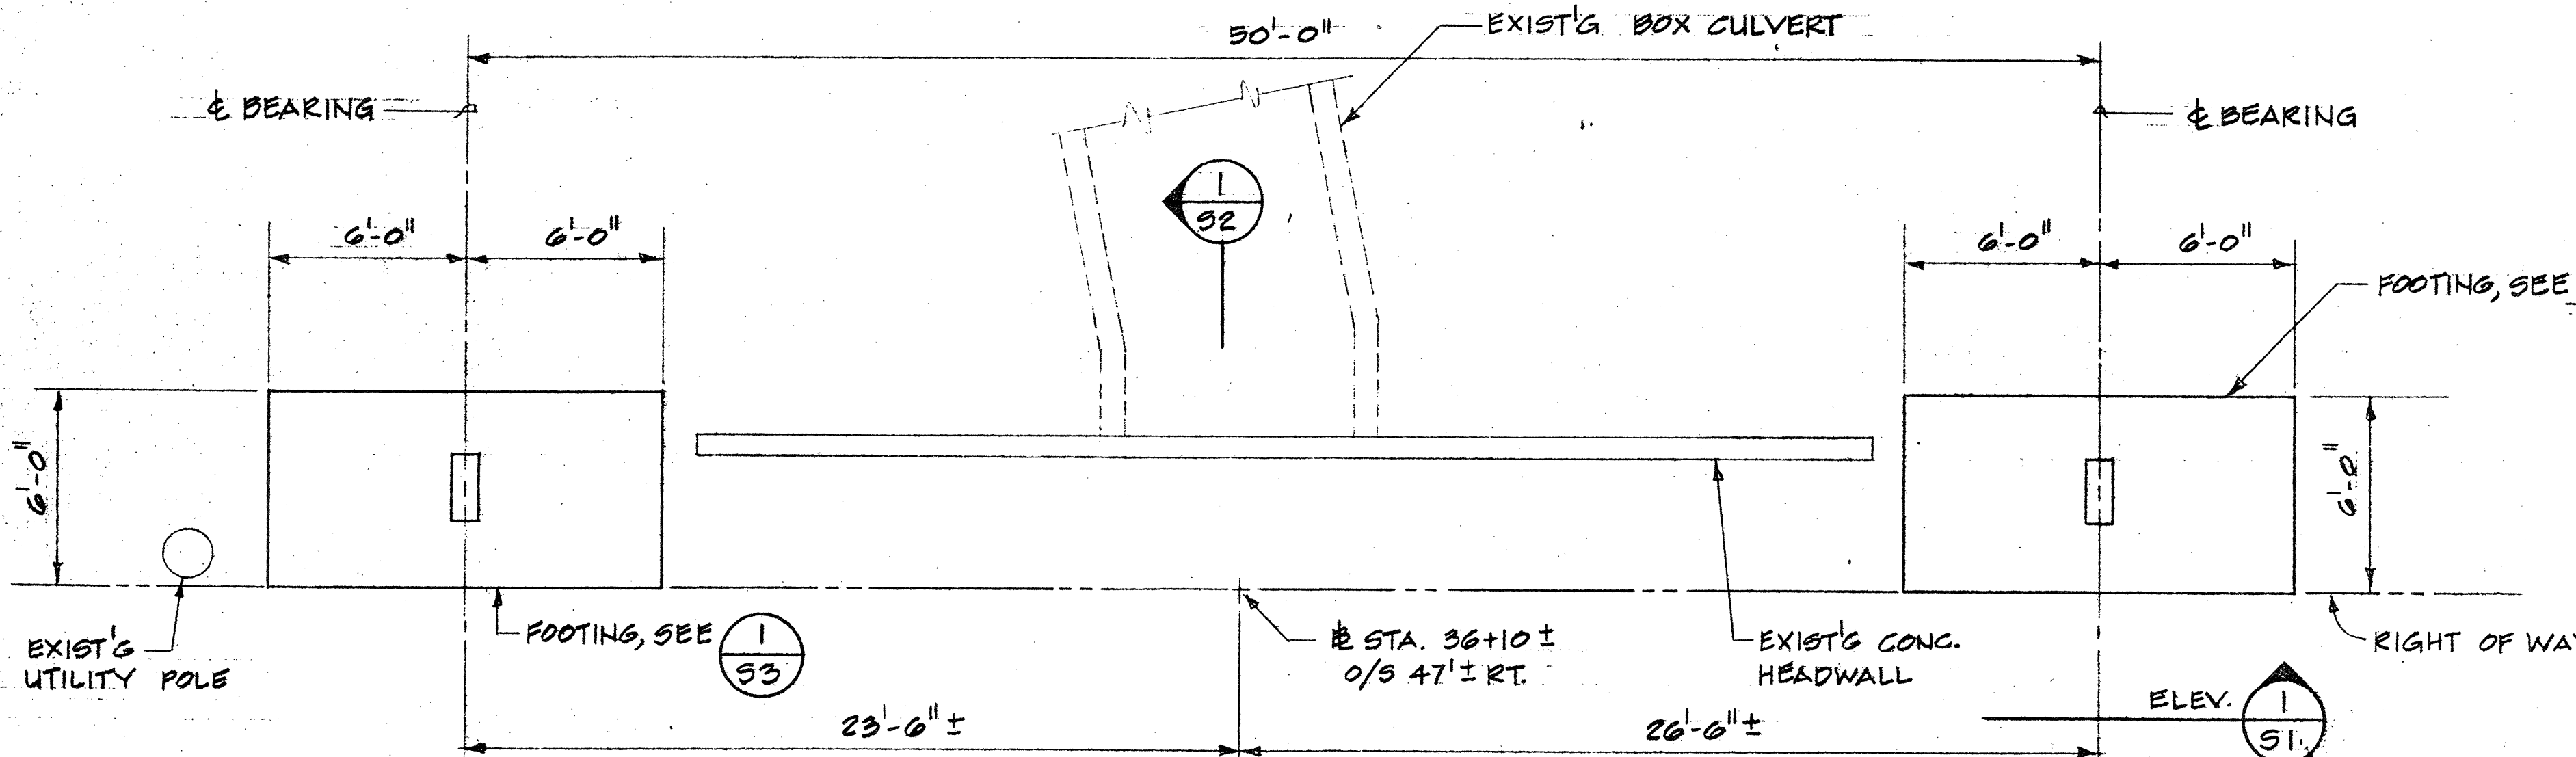

FOUNDATION PLAN

SCALE: $\frac{1}{4}'' = 1'-0''$

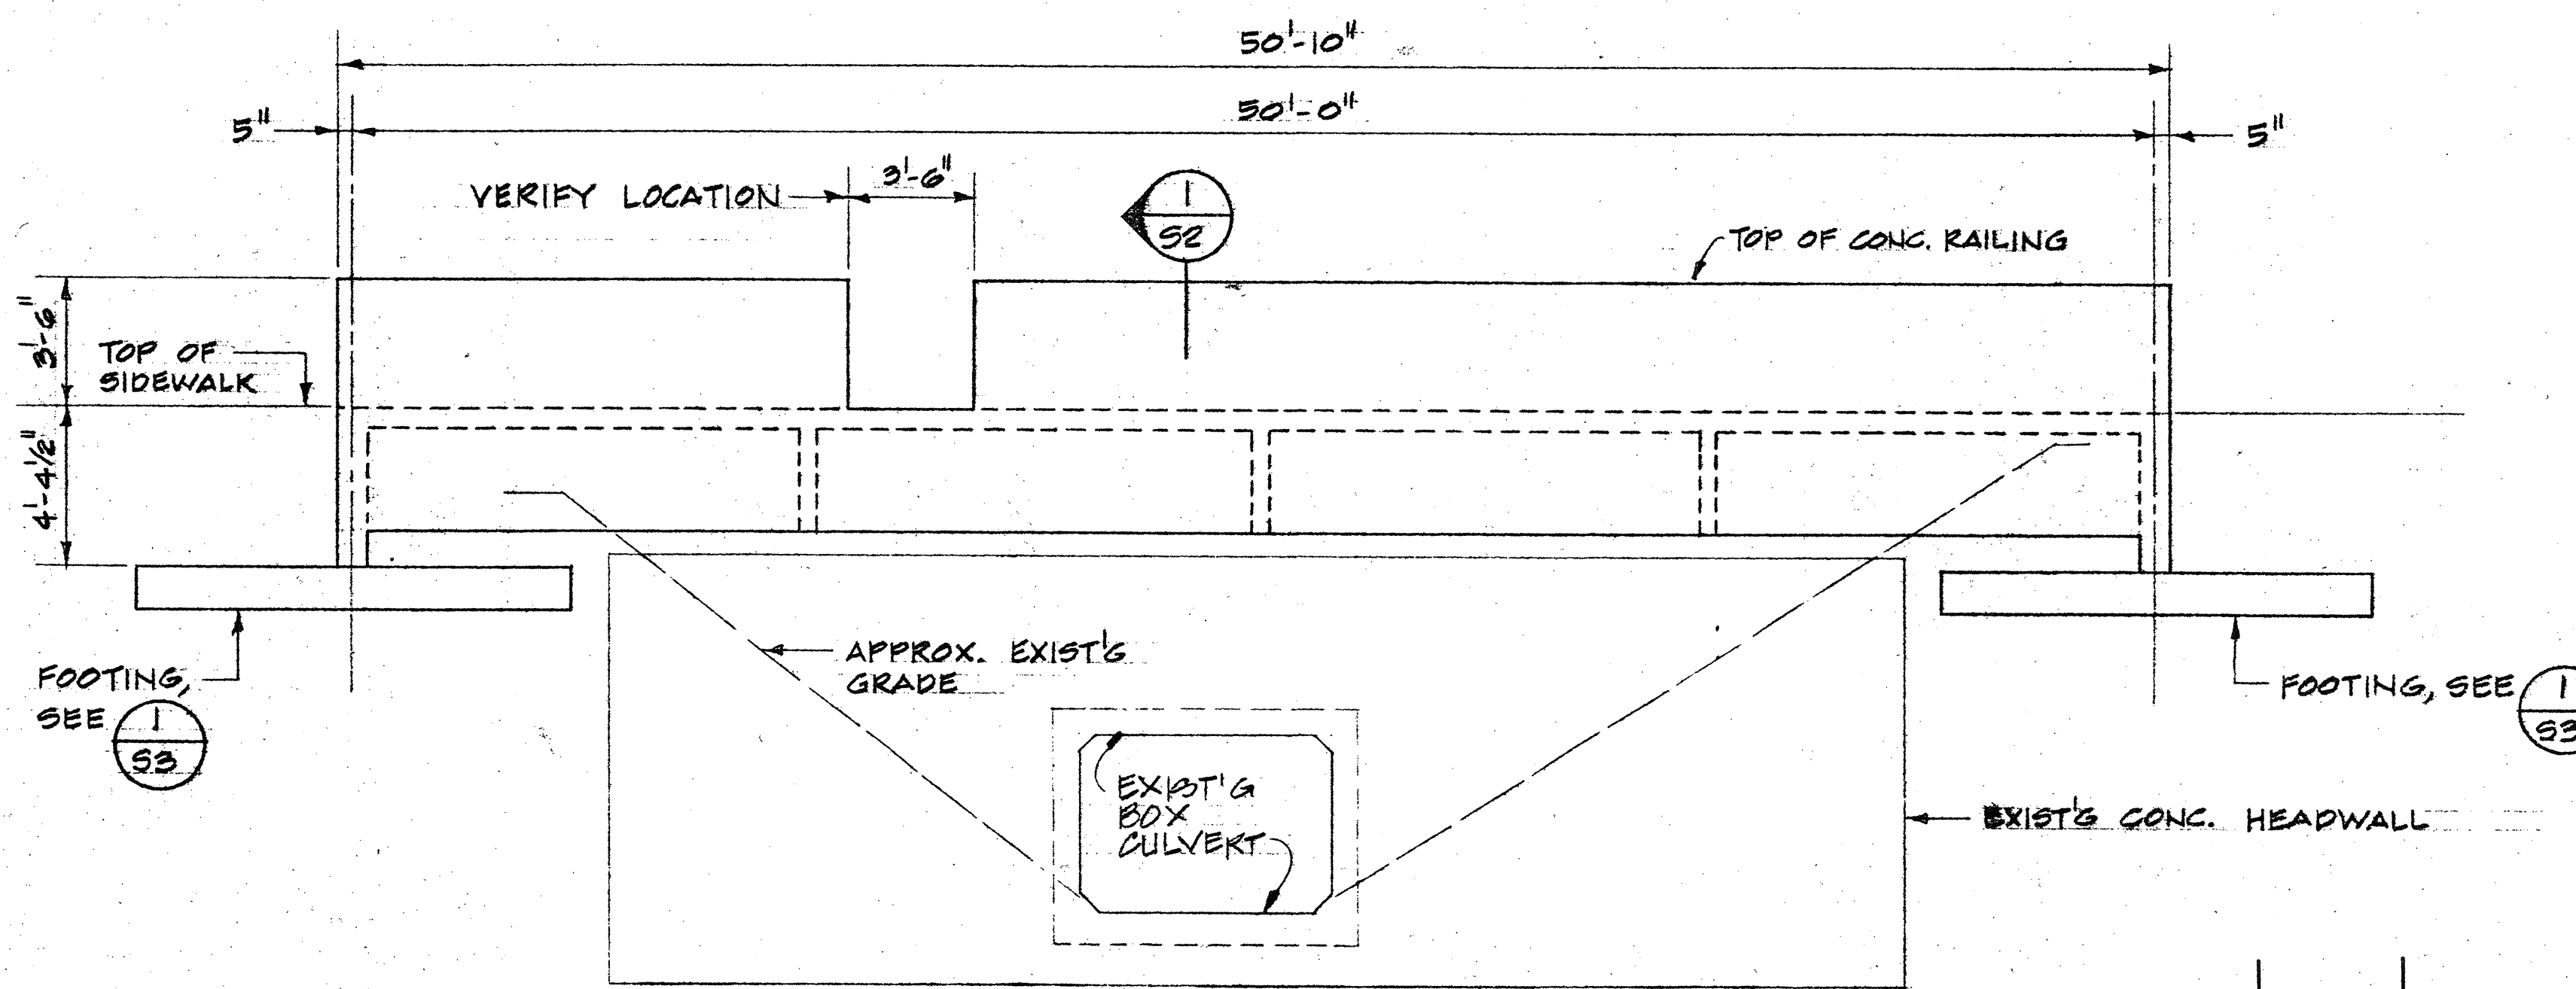


ELEVATION

SCALE: $\frac{1}{4}'' = 1'-0''$

9/7/89	Added new sheets to the original contract plans.
DATE	REVISION

132 A


FED. ROAD DIST. NO.	STATE	FED. AID PROJ. NO.	FISCAL YEAR	SHEET NO.	TOTAL SHEETS
HAWAII	HAW.	BR-F-064-1(2)	1987	132 B	151

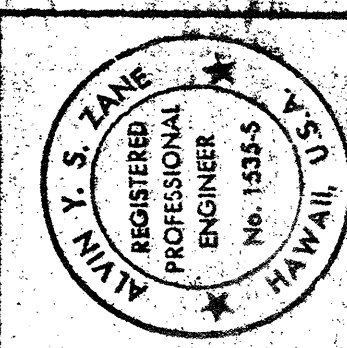

THIS WORK WAS PREPARED BY ME OR UNDER MY SUPERVISION.




OWNERSHIP OF DOCUMENTS
This document, and the ideas and designs incorporated as an instrument of professional service, is the property of Alvin Y. Zane and Associates, Inc., and it is not to be used, in whole or in part, for any other project without the written authorization of Alvin Y. Zane and Associates, Inc.

ALVIN ZANE & ASSOC.
CIVIL & STRUCTURAL ENGINEERS
FIRST INTERSTATE BANK BLDG.
1314 S. KING ST.
HONOLULU, HAWAII 96814
TELEPHONE: 524-3478

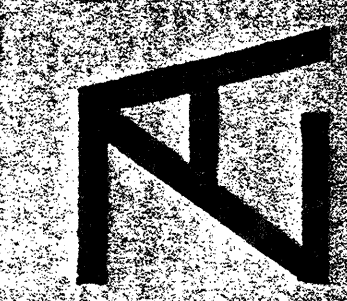

CONTRACTOR: KIEWIT PACIFIC CO.
2828 PAA STREET, SUITE 3060
HONOLULU, HI 96819
SAND ISLAND ROAD WIDENING
SIDEWALK BRIDGE AT STA. 36+10.1


SECTIONS AND DETAILS
SHEET 132 B
OF 5 SHEETS
JOB NO. 88-01
DATE: 6/12/89

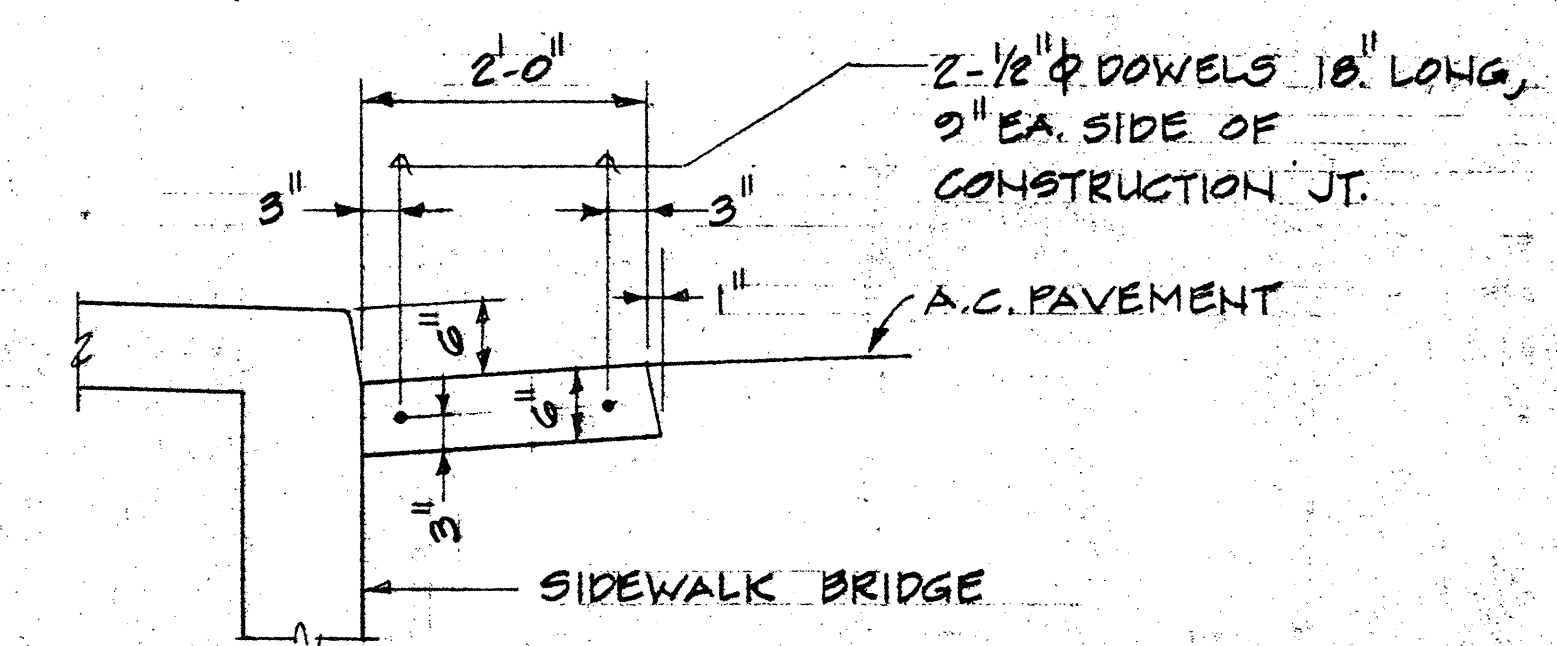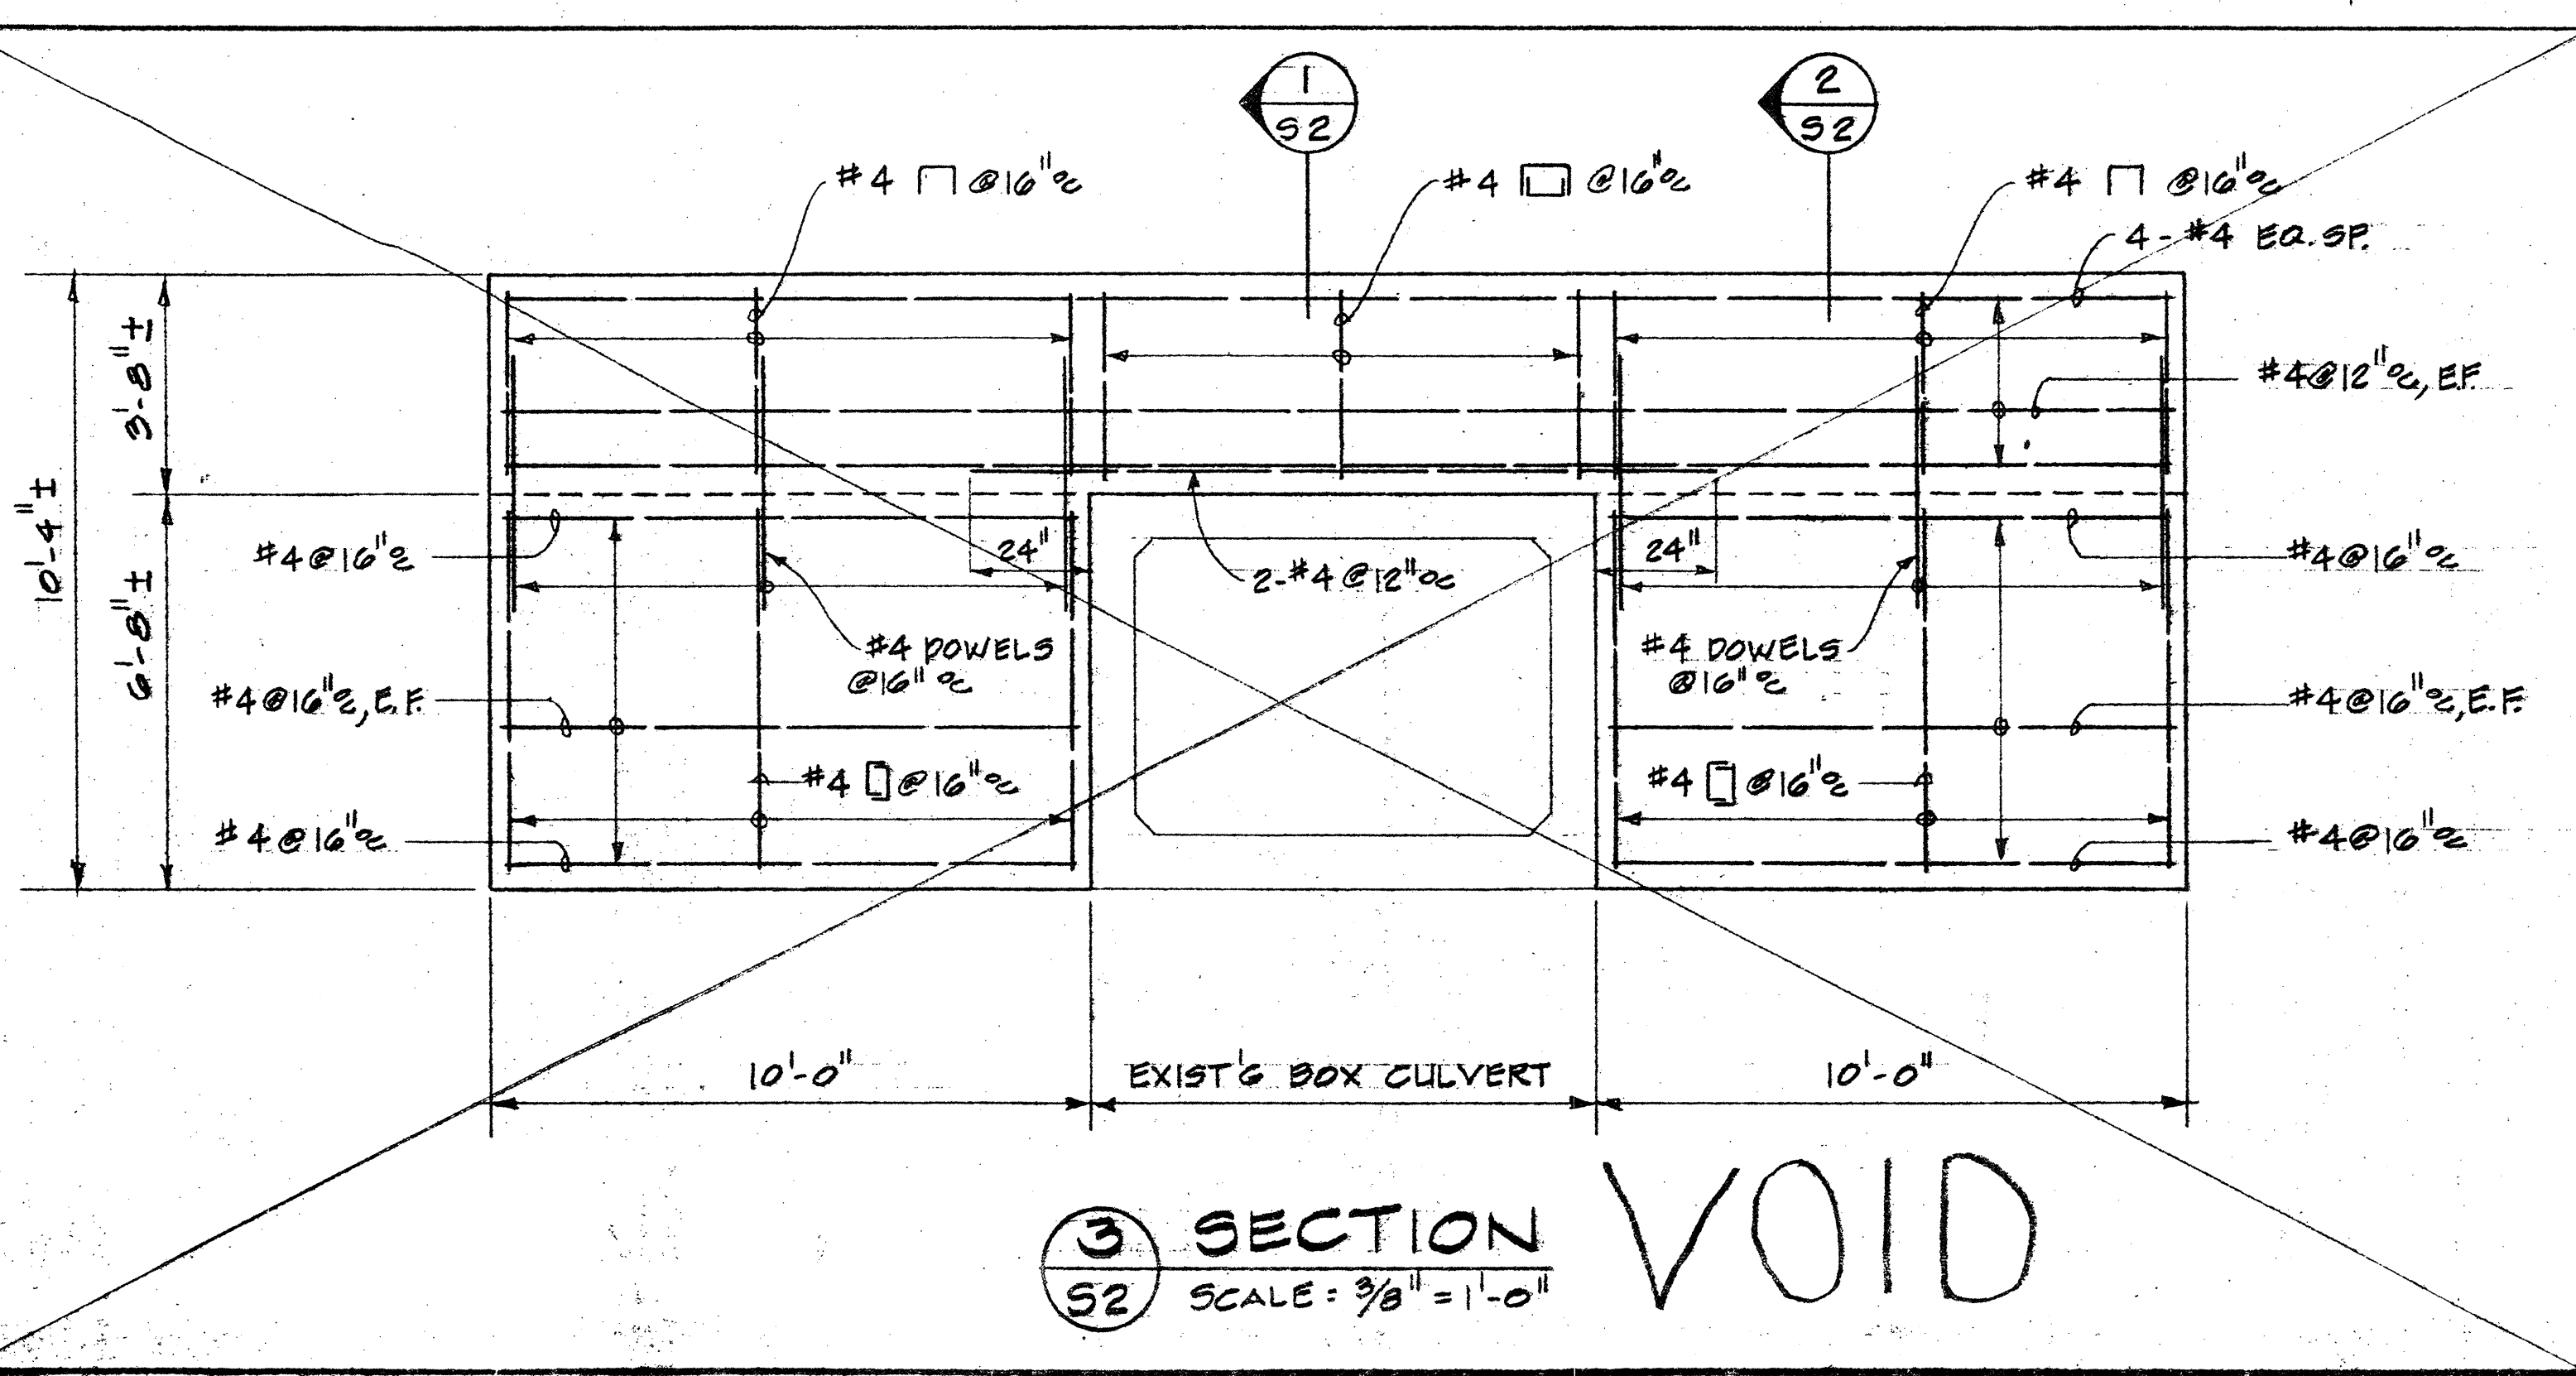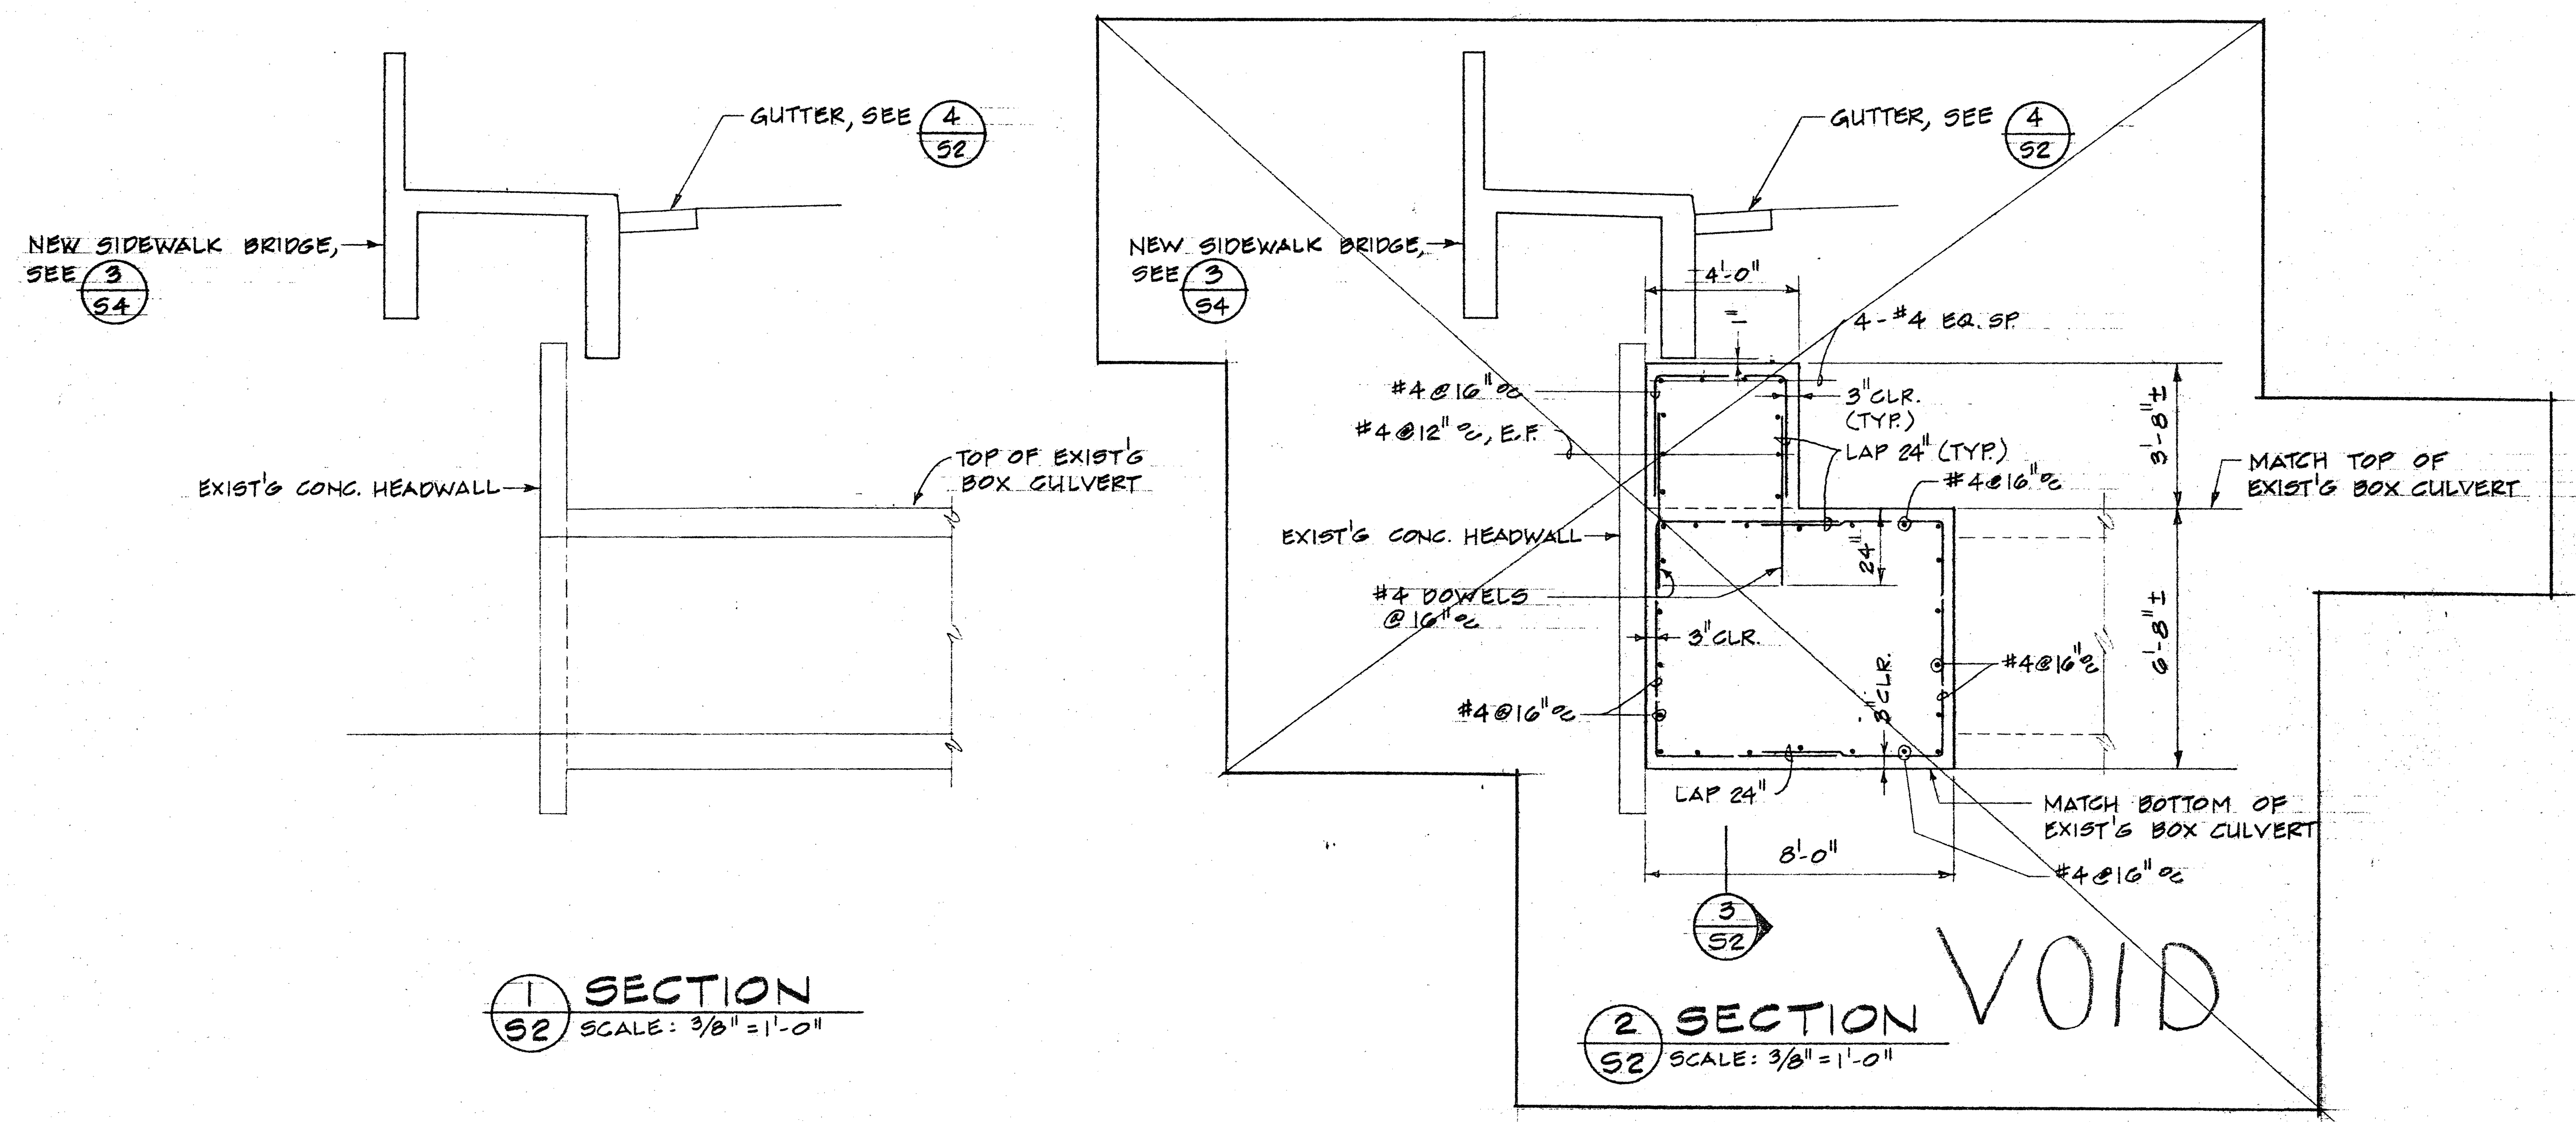

NOTES:
1. SPACE CONSTRUCTION JT. AT 20 FEET MAX.

9/7/89	Added new sheets to the original contract plans.
DATE	REVISION


132 B

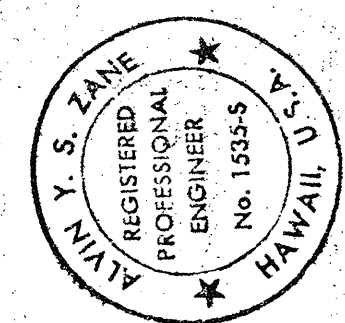

THIS WORK WAS PREPARED BY ME OR UNDER MY SUPERVISION.

OWNERSHIP OF DOCUMENTS
This document, and the ideas and designs incorporated as an instrument of professional service, is the property of Alvin S. Zane and Associates, Inc., and is not to be used, in whole or in part, for any other project without written authorization of Alvin S. Zane and Associates, Inc.


ALVIN ZANE & ASSOC.
CIVIL & STRUCTURAL ENGINEERS
FIRST INTERSTATE BANK BLDG.
1314 S. KING ST.
HONOLULU, HAWAII 96814
TELEPHONE: 524-3478

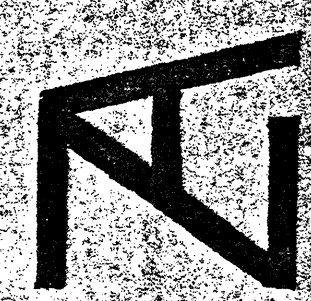


CONTRACTOR: KIEWIT PACIFIC CO.
2828 PAA STREET, SUITE 3060
HONOLULU, HI 96819
SAND ISLAND ROAD WIDENING
SIDEWALK BRIDGE AT STA. 36+10+
DIAPHRAGM ELEVATIONS & SECTIONS

SHEET
132E
OF 5 SHEETS
JOB NO. 132E
DATE: 6/2/89


NOTE:
BALANCE OF REINF.
NOT SHOWN FOR
CLARITY.

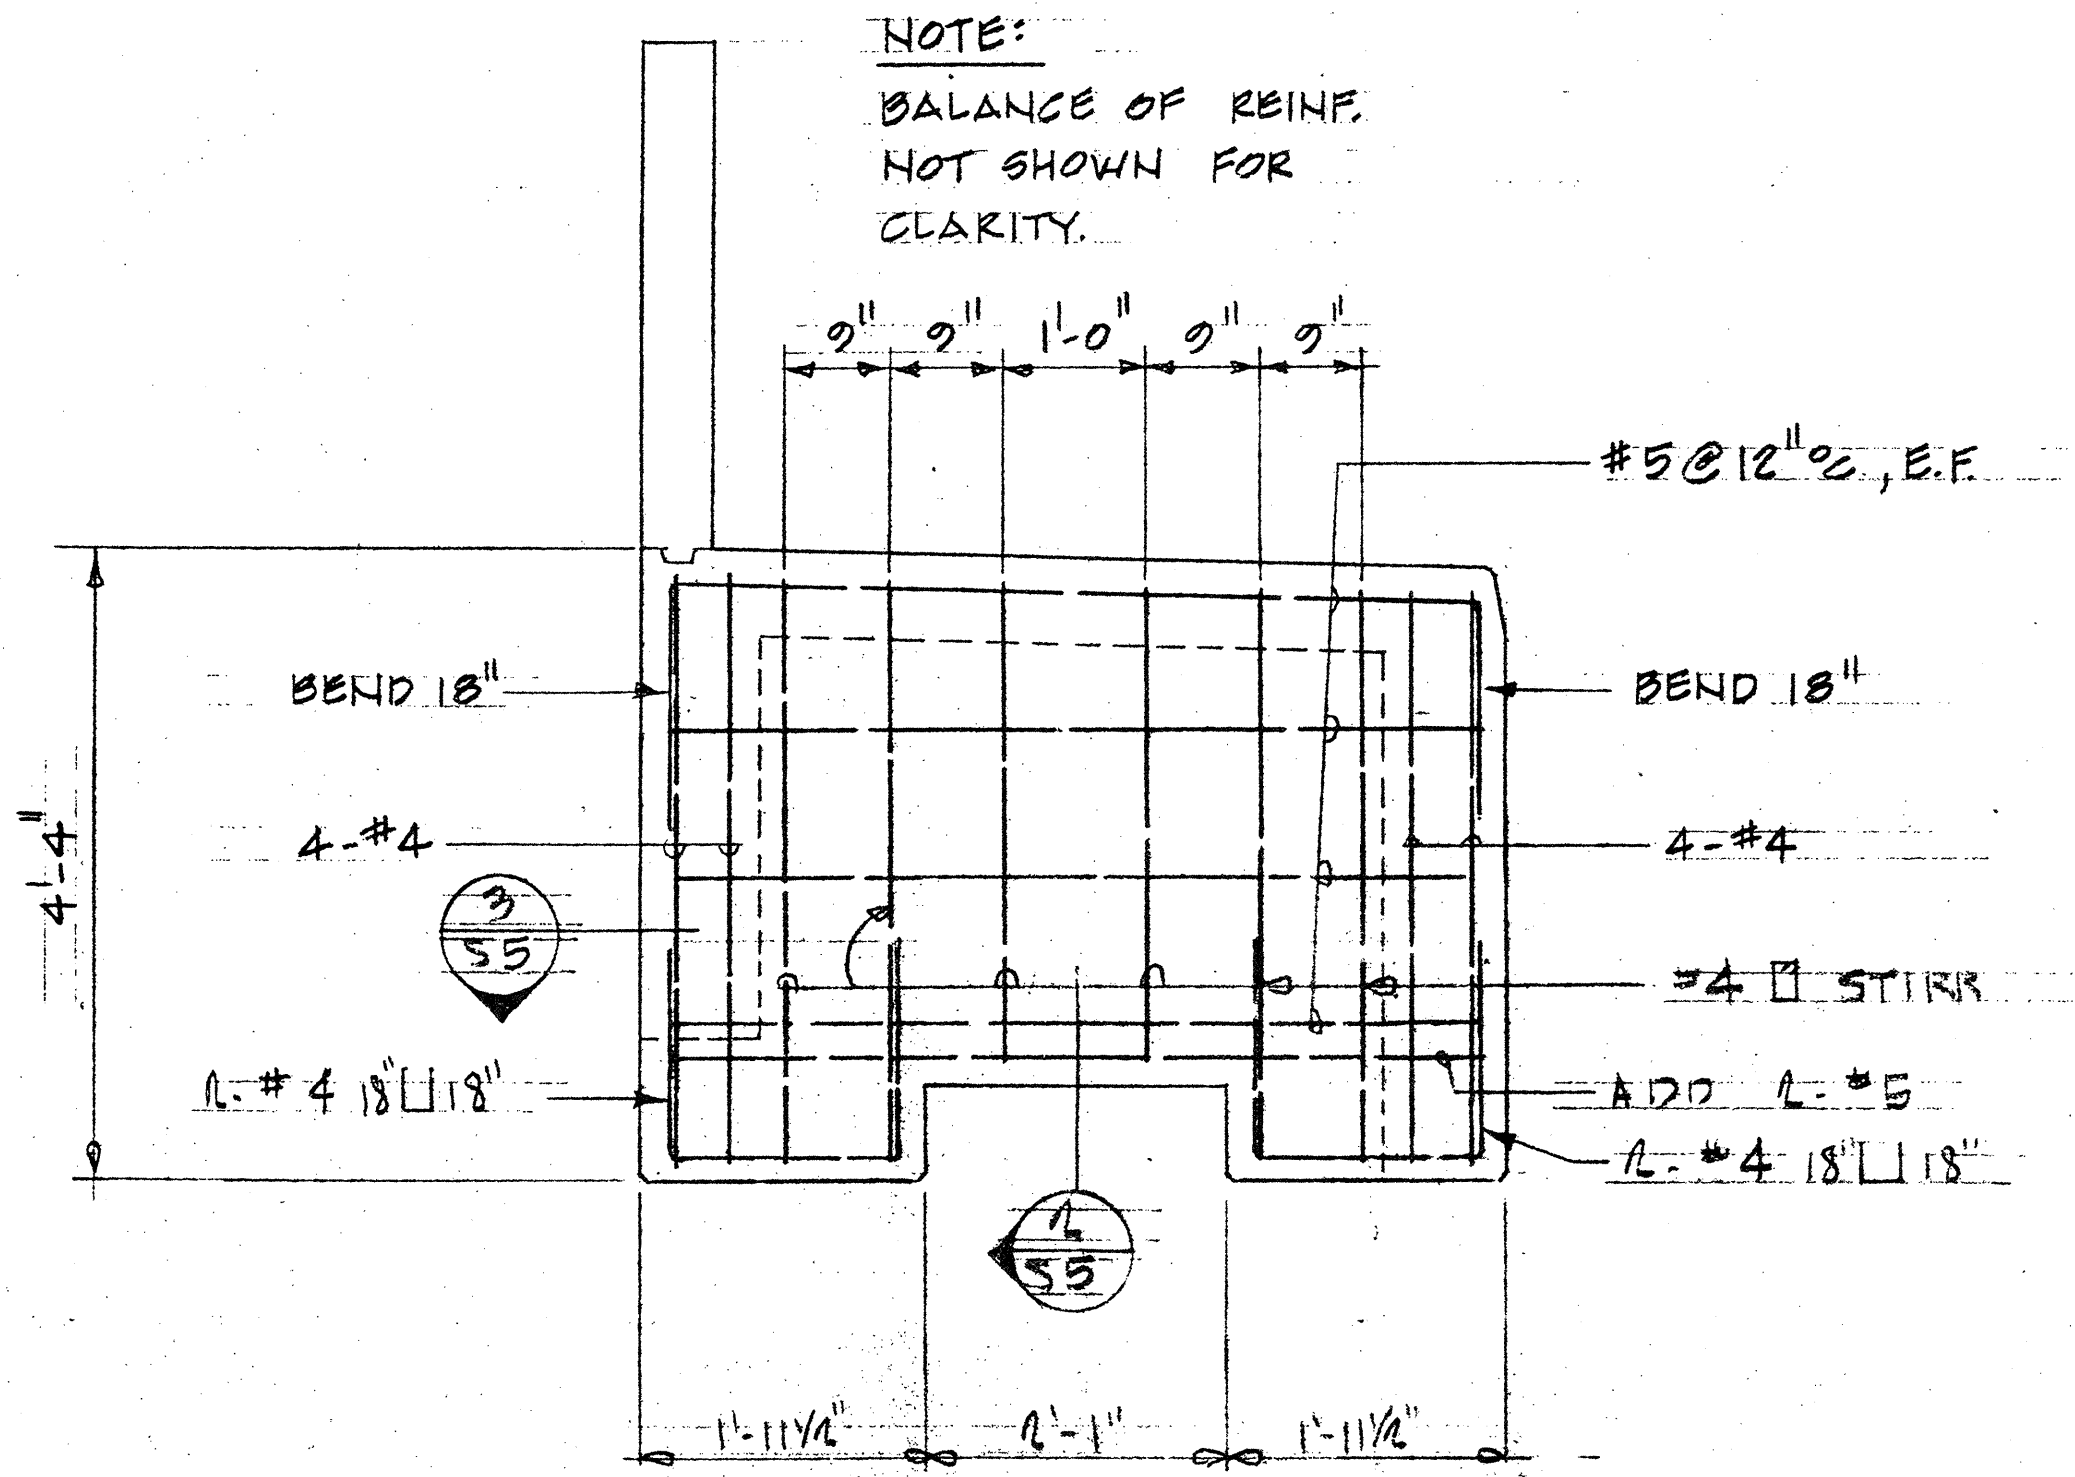

1 END DIAPHRAGM ELEVATION
SS SCALE: 3/4" = 1'-0"

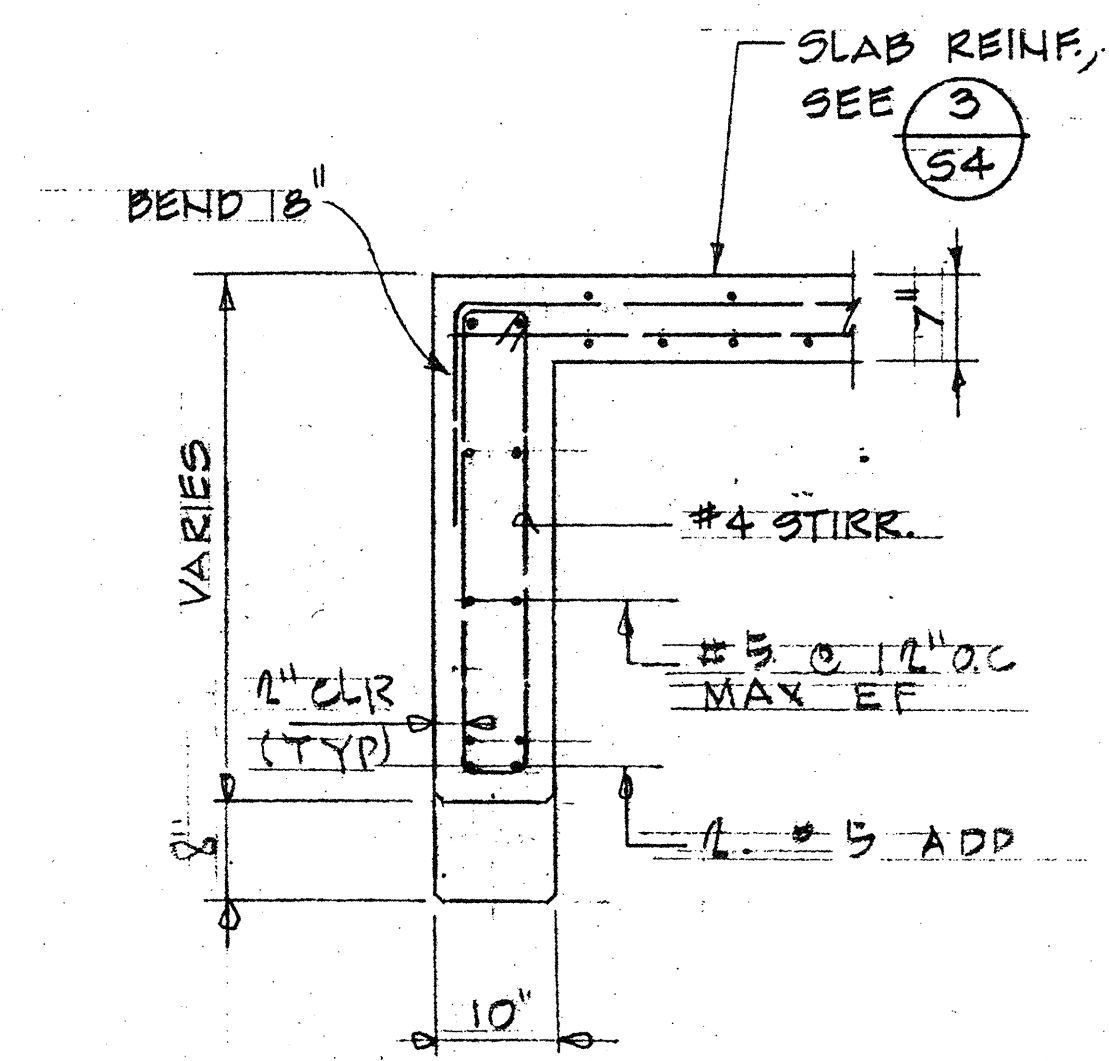


2 END DIAPHRAGM SECTION
SS SCALE: 3/4" = 1'-0"

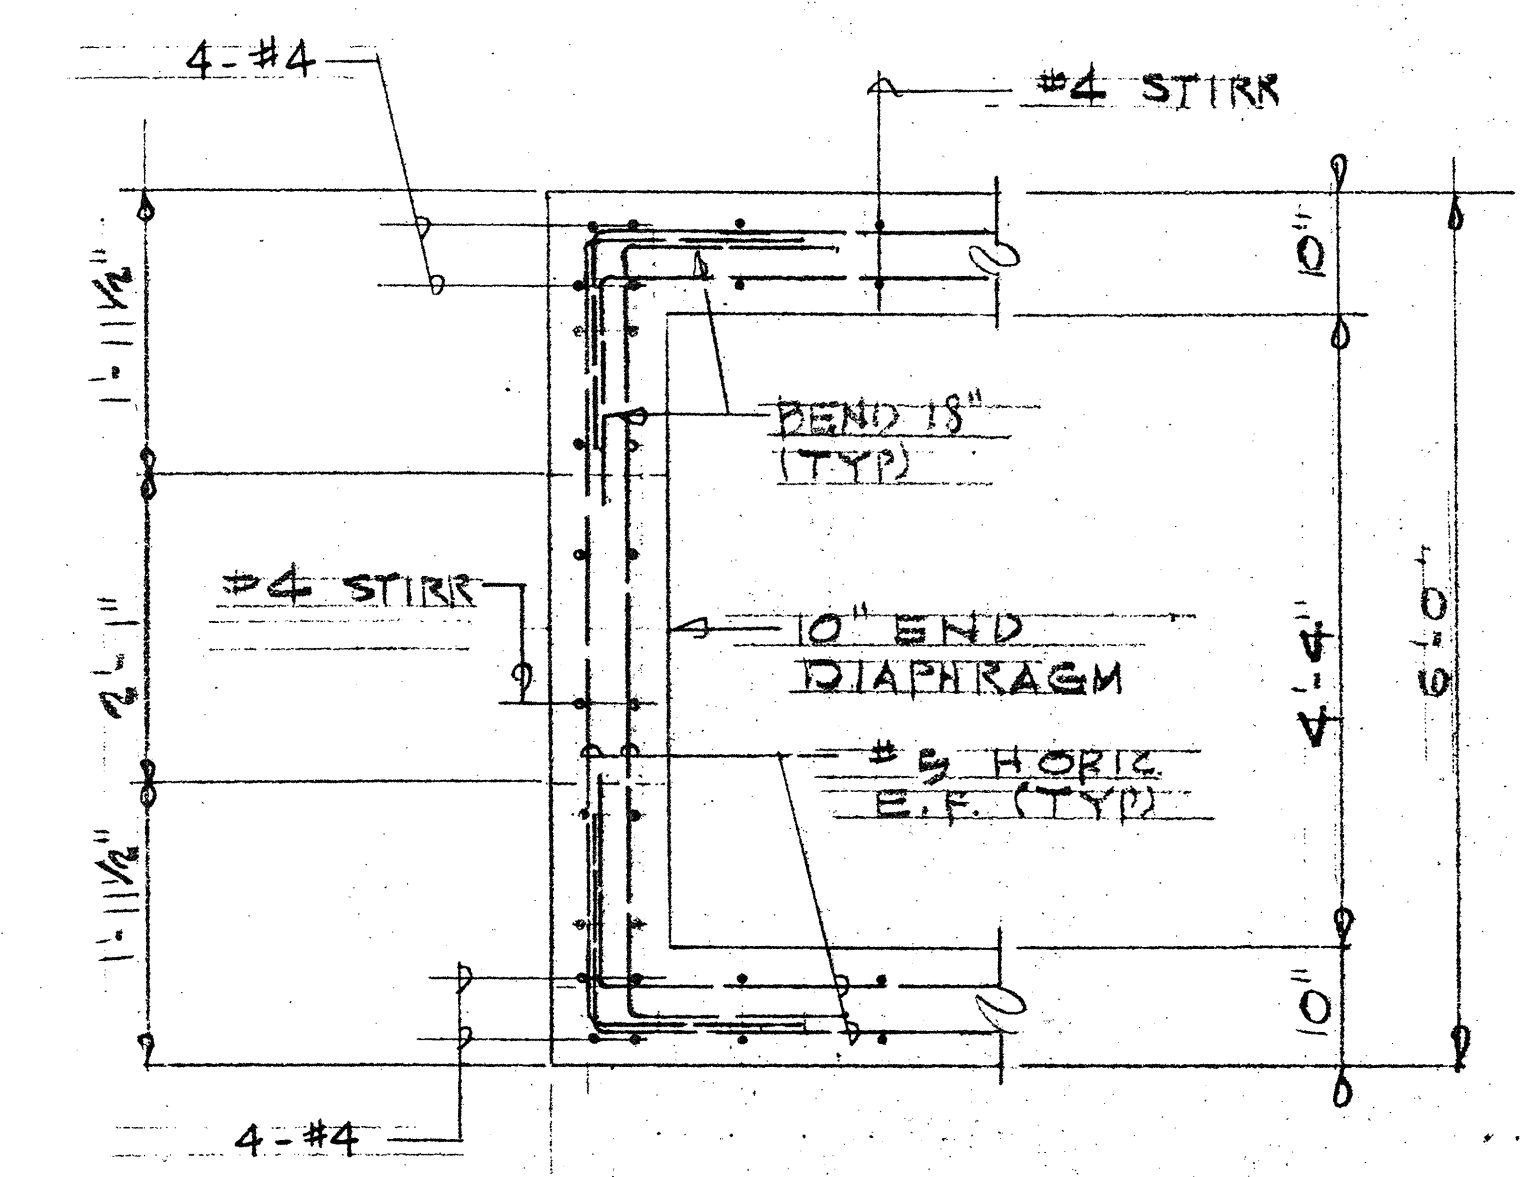


3 SECTION
SS SCALE: 3/4" = 1'-0"


NOTE:
BALANCE OF REINF.
NOT SHOWN FOR CLARITY

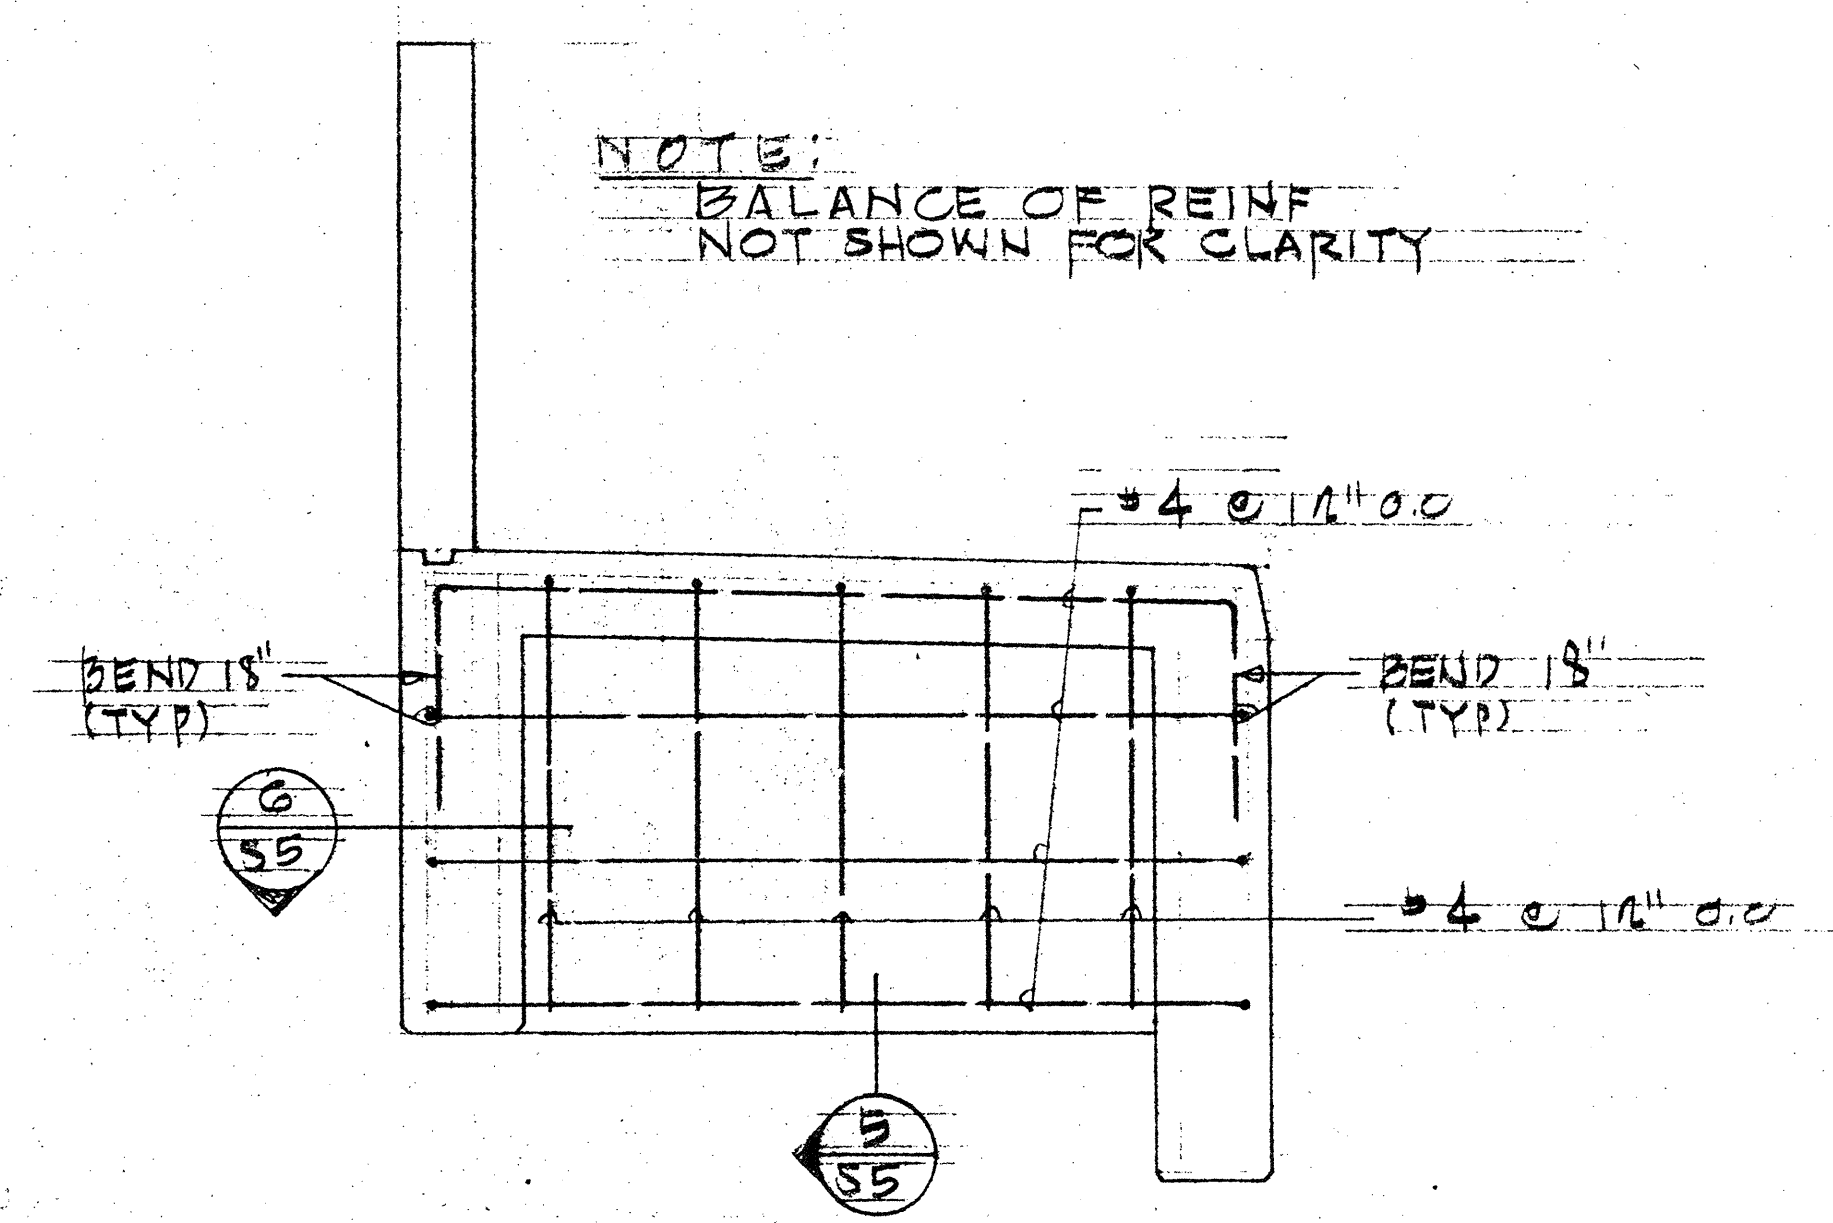

4 INTERIOR DIAPHRAGM REIN
SS SCALE: 3/4" = 1'-0"

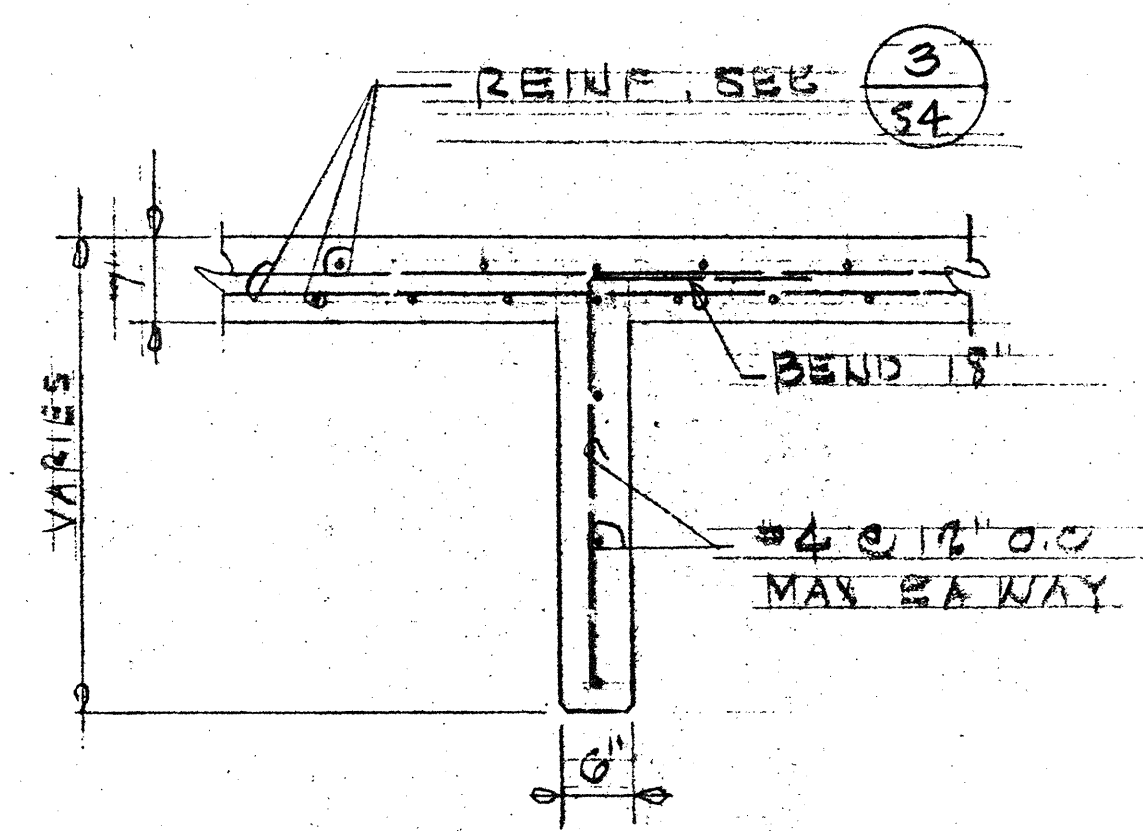

5 TYP SECTION
SS SCALE: 3/4" = 1'-0"

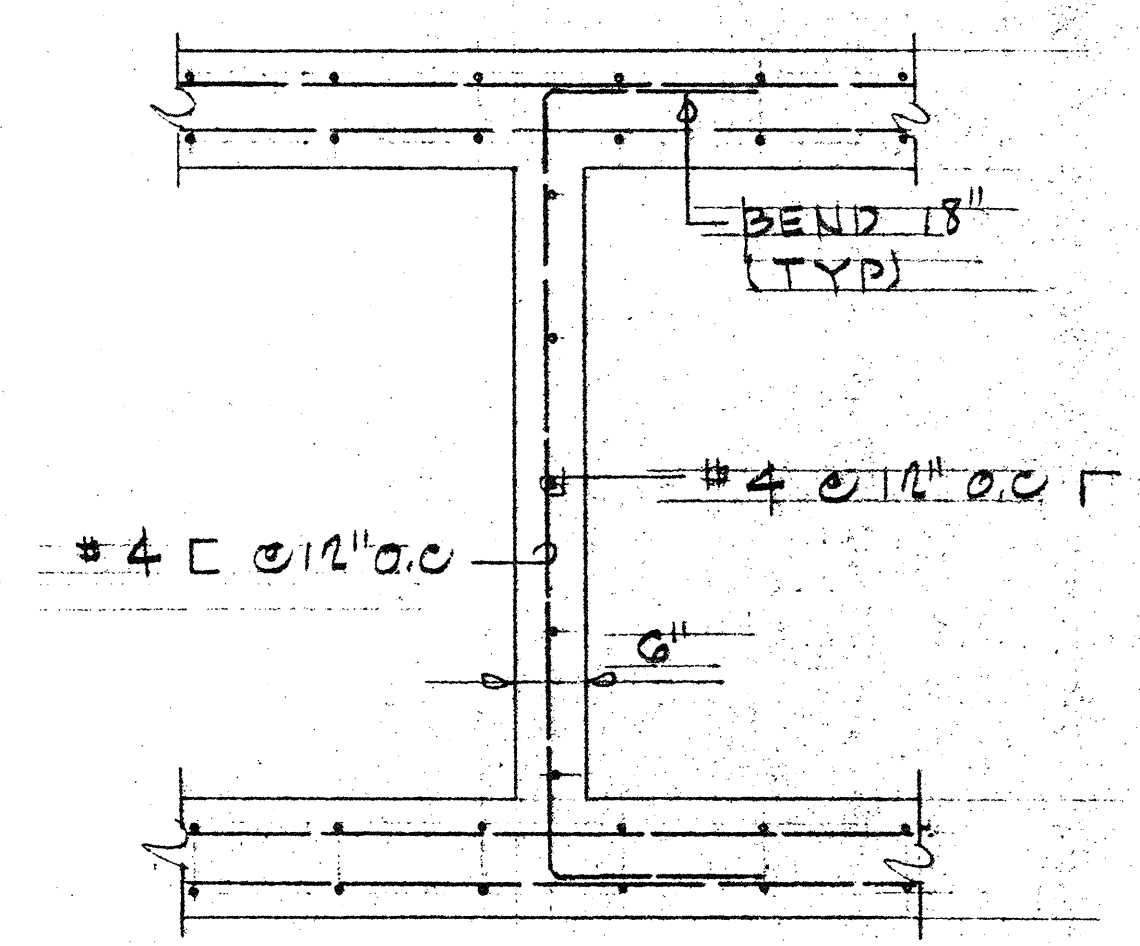

6 TYP SECTION
SS SCALE: 3/4" = 1'-0"

9/7/89	Added new sheets to the original contract plans.
DATE	REVISION

132E