


FED. ROAD DIST. NO.	STATE	FED. AID PROJ. NO.	FISCAL YEAR	SHEET NO.	TOTAL SHEETS
HAWAII	HAW.	F-064-1(2)	1987	82	151

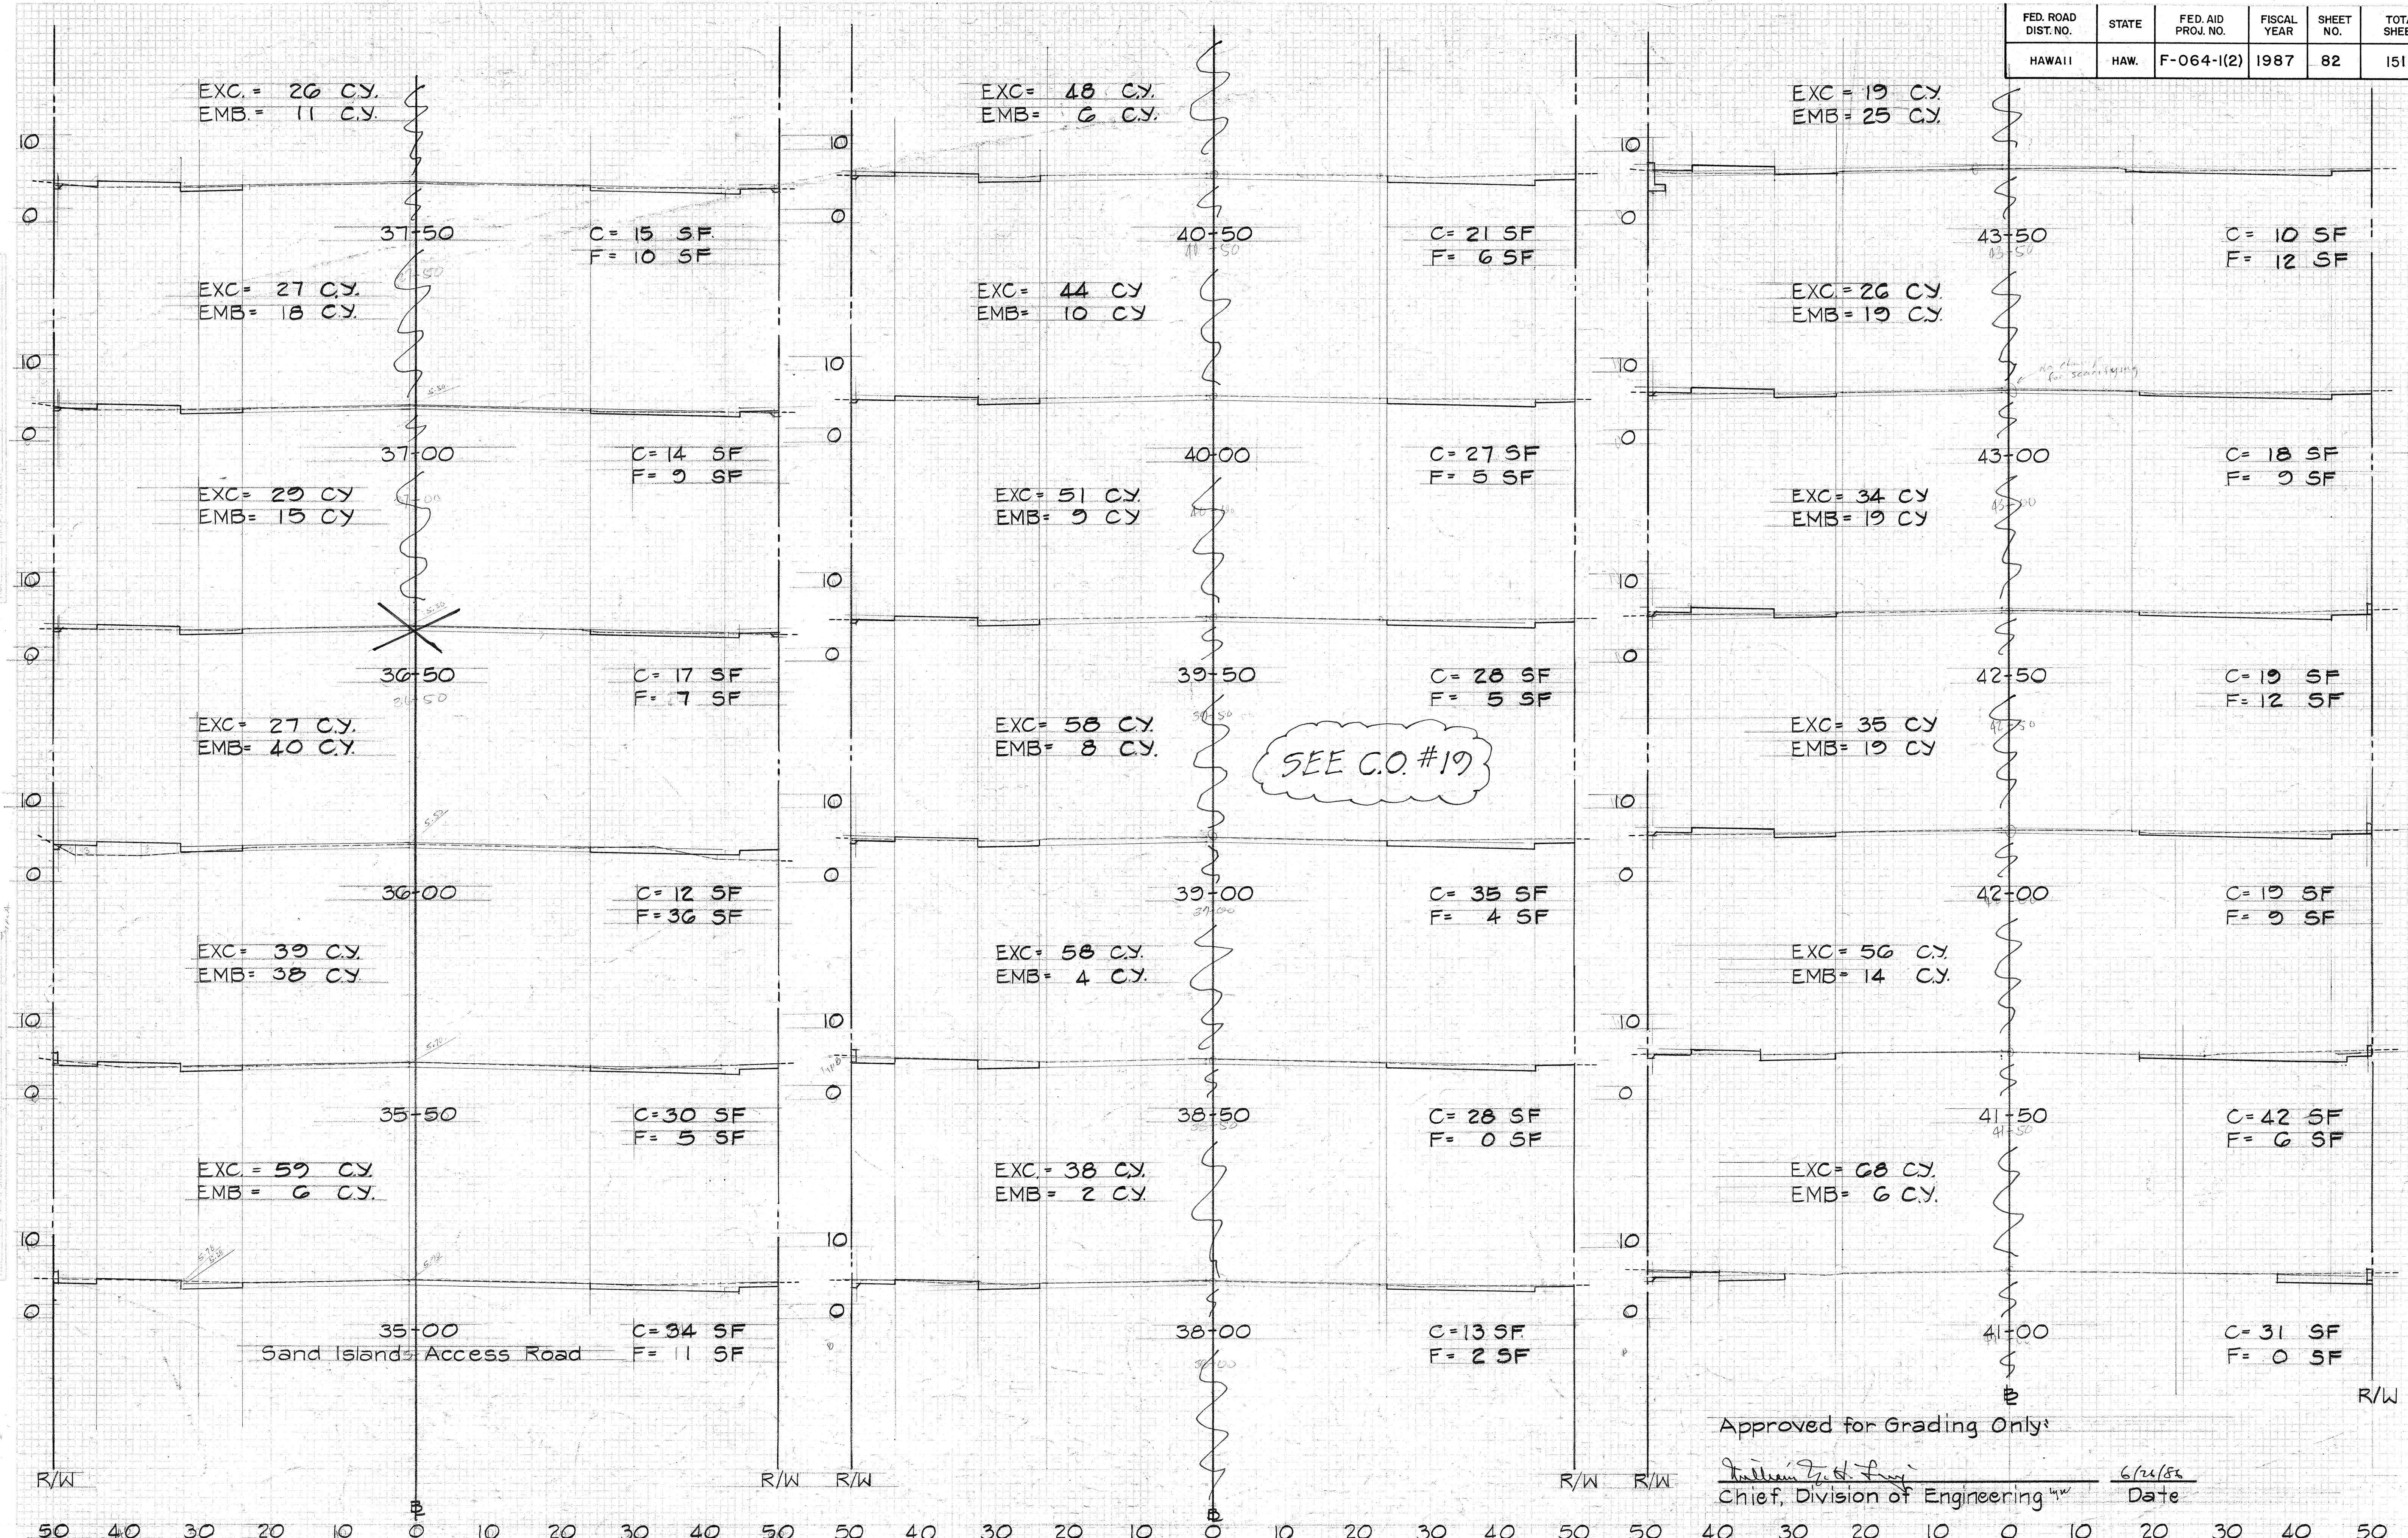

Approved for Grading Only:

William J. H. Fung
Chief, Division of Engineering

6/24/86
Date

"AS-BUILT"

EXC = 17 CY.
EMB = 20 CY.
20

EXC = 50 CY.
EMB = 6 CY.

EXC = 16 CY.
EMB = 63 CY.

FED. ROAD DIST. NO.	STATE	FED. AID PROJ. NO.	FISCAL YEAR	SHEET NO.	TOTAL SHEETS
HAWAII	HAW.	F-064-1(2)	1987	83	151

EXC = 17 CY.
EMB = 28 CY.
28

C = 14 SF
F = 10 SF

EXC = 31 CY.
EMB = 23 CY.

C = 22 SF
F = 4 SF

EXC = 14 CY.
EMB = 35 CY.

C = 4 SF
F = 20 SF

EXC = 19 CY.
EMB = 30 CY.

C = 11 SF
F = 21 SF

EXC = 12 CY.
EMB = 54 CY.

C = 11 SF
F = 17 SF

EXC = 15 CY.
EMB = 23 CY.

C = 10 SF
F = 12 SF

EXC = 4 CY.
EMB = 77 CY.

C = 2 SF
F = 41 SF

EXC = 7 CY.
EMB = 30 CY.

C = 6 SF
F = 13 SF

SEE C.O. #19

EXC = 12 CY.
EMB = 53 CY.

C = 2 SF
F = 42 SF

EXC = 13 CY.
EMB = 42 CY.

C = 2 SF
F = 19 SF

EXC = 20 CY.
EMB = 28 CY.

C = 11 SF
F = 15 SF

EXC = 15 CY.
EMB = 35 CY.

C = 12 SF
F = 26 SF

EXC = 1 CY.
EMB = 63 CY.

C = 0 SF
F = 46 SF

EXC = 3 CY.
EMB = 44 CY.

C = 1 SF
F = 22 SF

EXC = 29 CY.
EMB = 23 CY.

C = 2 SF
F = 25 SF

EXC = 55 CY.
EMB = 19 CY.

C = 29 SF
F = 0 SF

EXC = 46 CY.
EMB = 25 CY.

C = 30 SF
F = 20 SF

EXC = 48 CY.
EMB = 9 CY.

C = 20 SF
F = 7 SF

Approved for Grading Only:

Chief Division of Engineering



Date

C = 32 SF
F = 3 SF



"AS-BUILT"

83

FED. ROAD DIST. NO.	STATE	FED. AID PROJ. NO.	FISCAL YEAR	SHEET NO.	TOTAL SHEETS
HAWAII	HAW.	F-064-1(2)	1987	85	151

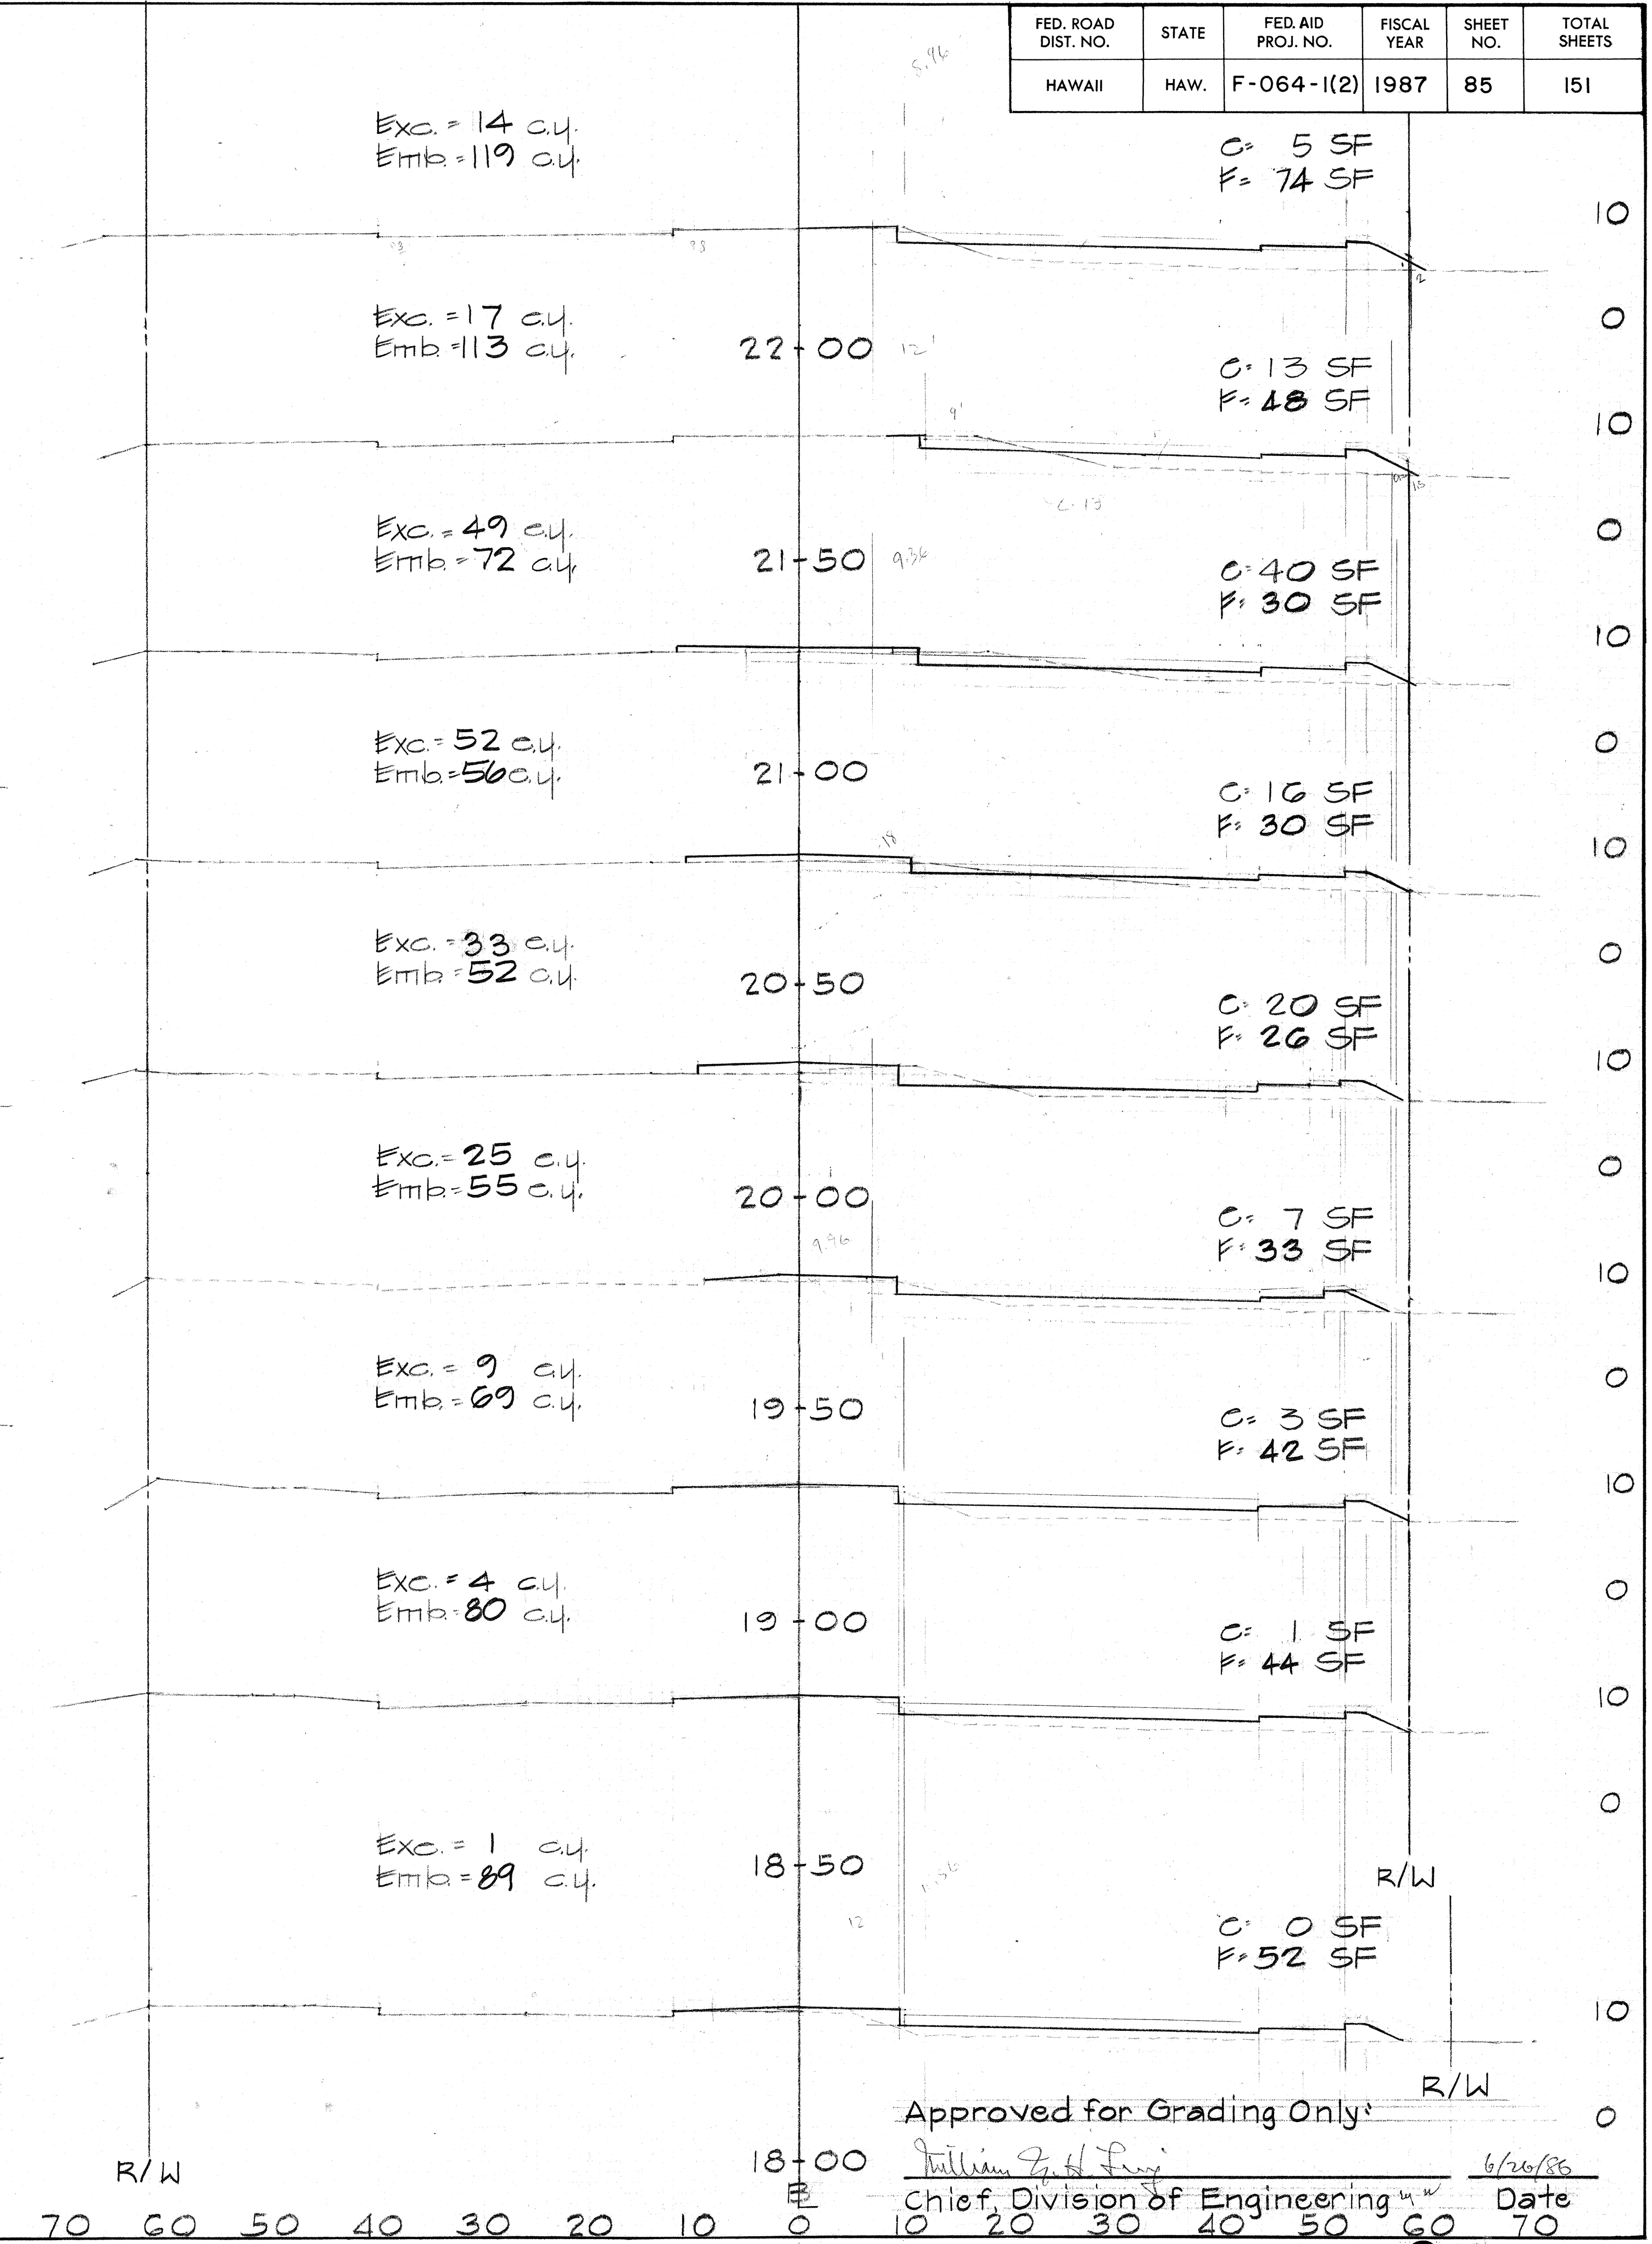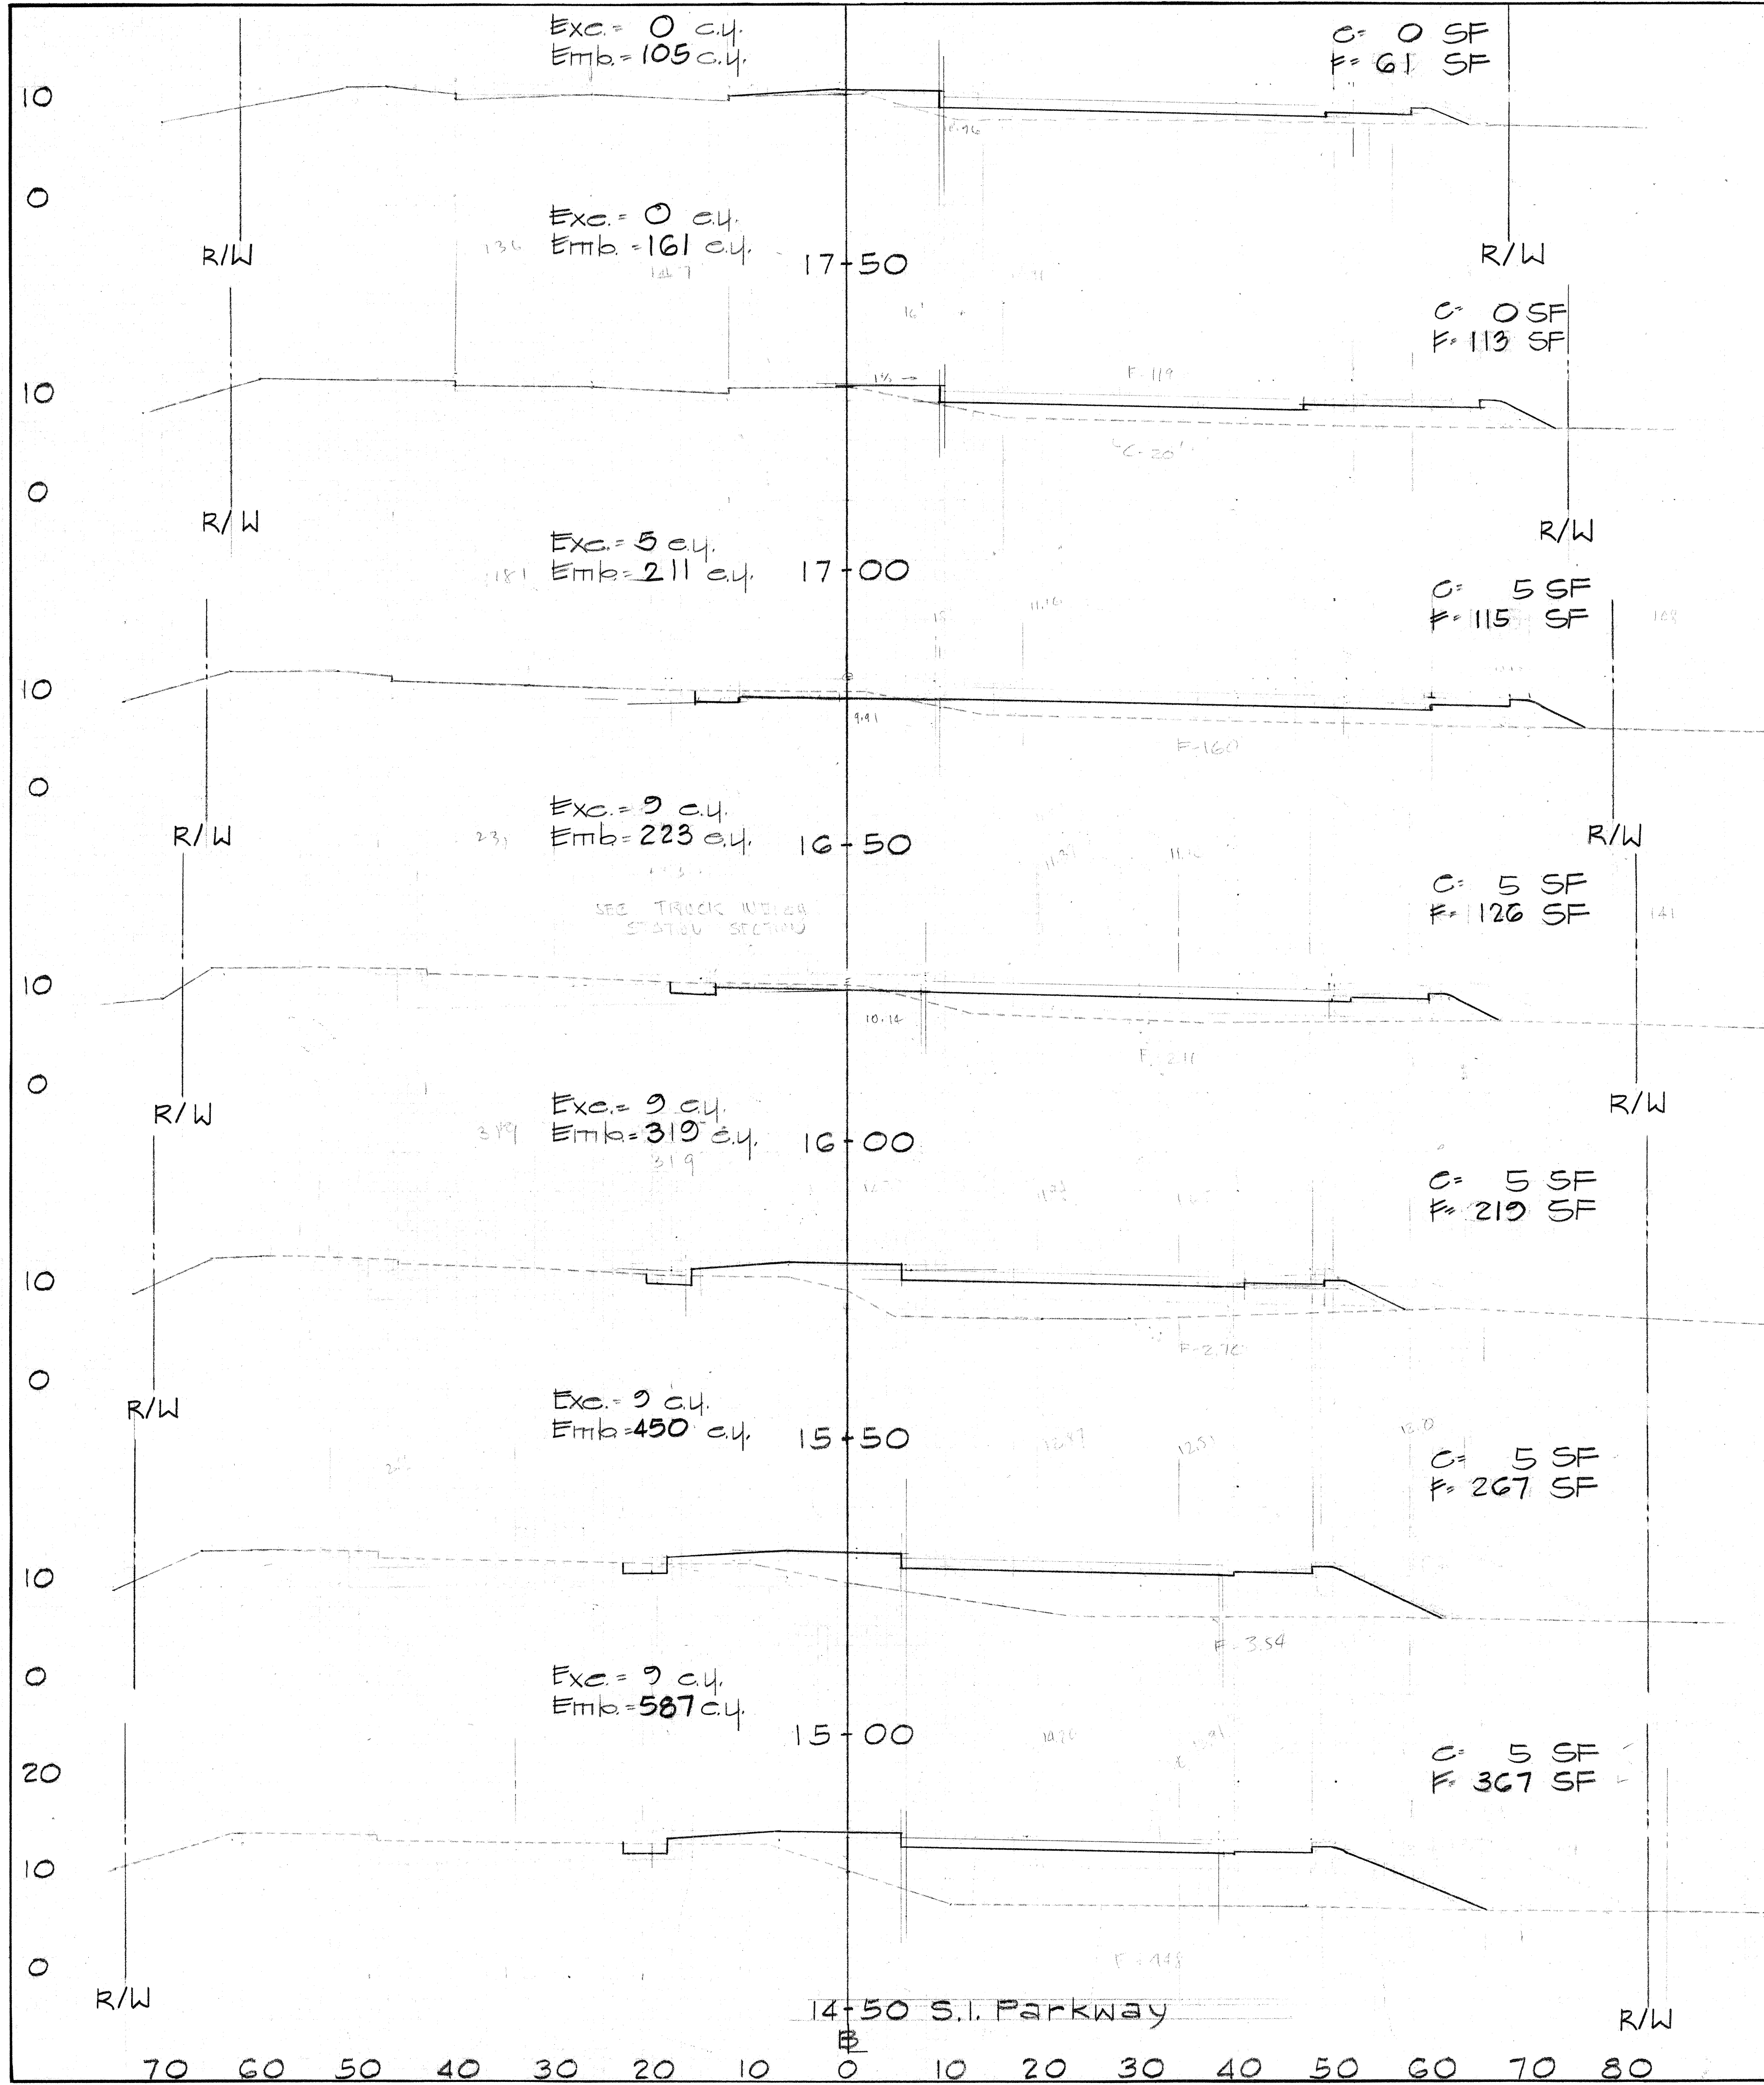


FED. ROAD DIST. NO.	STATE	FED. AID. PROJ. NO.	FISCAL YEAR	SHEET NO.	TOTAL SHEETS
HAWAII	HAW.	F-064-1(2)	1987	86	151

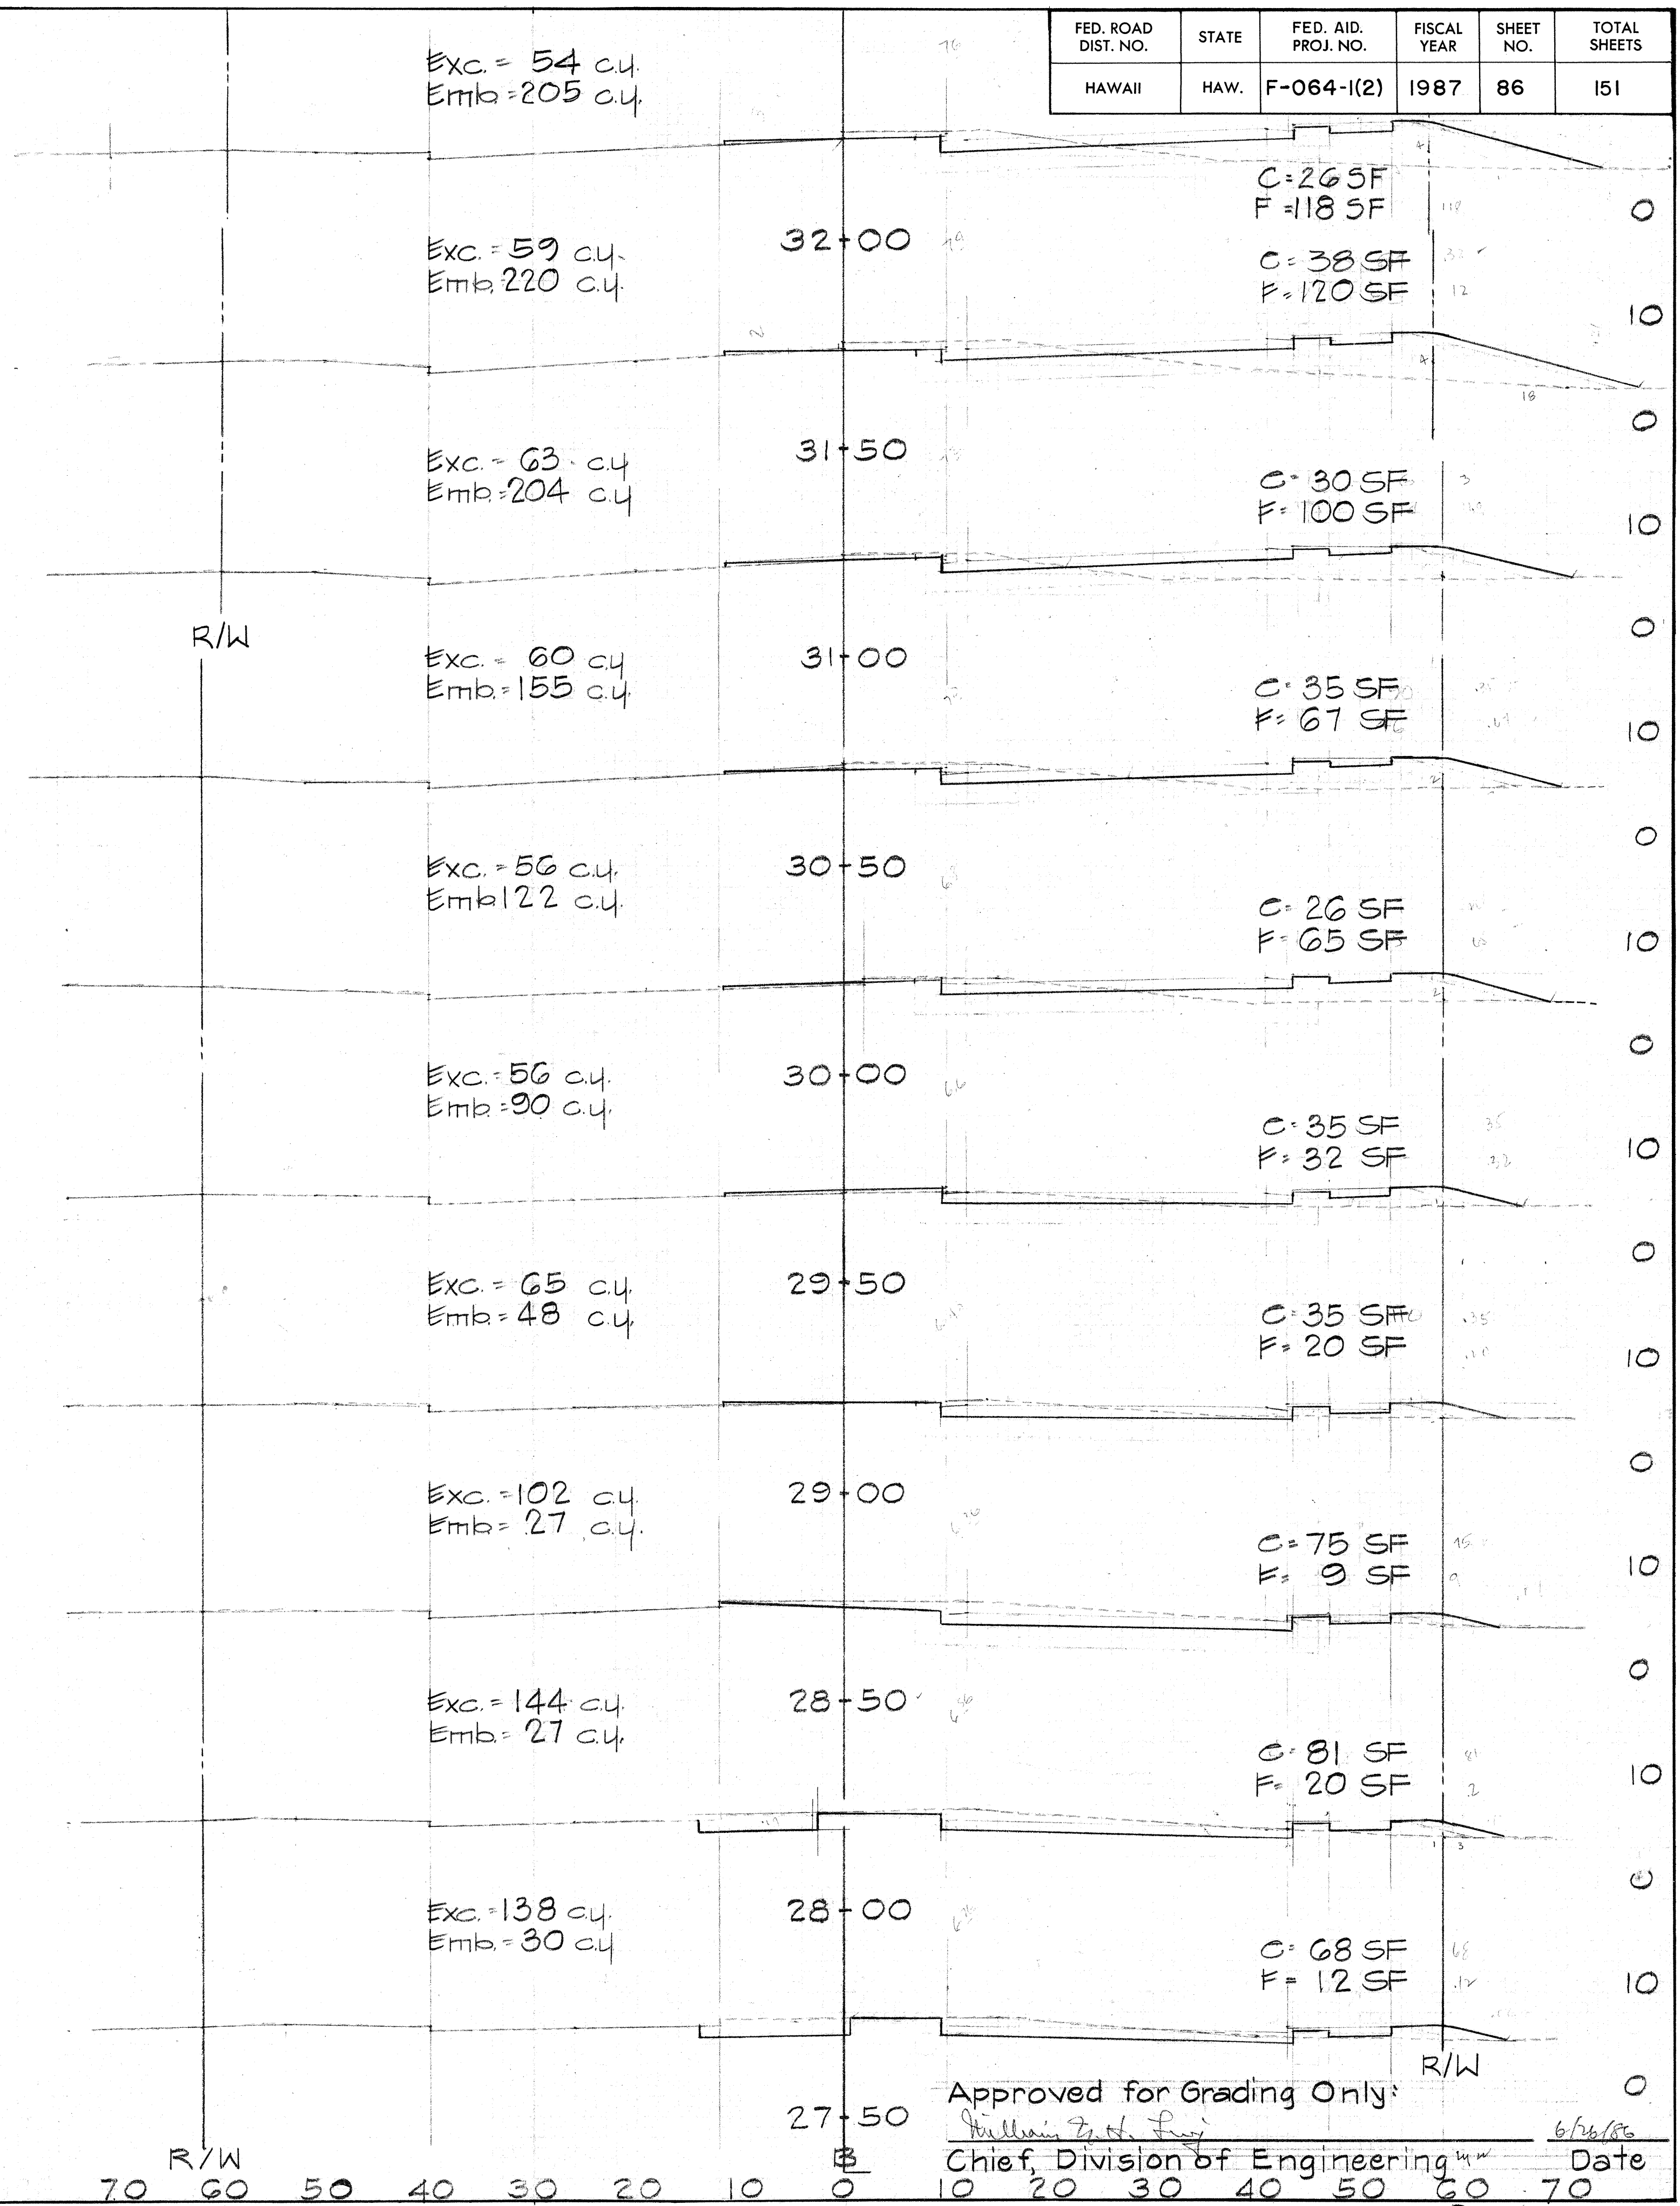
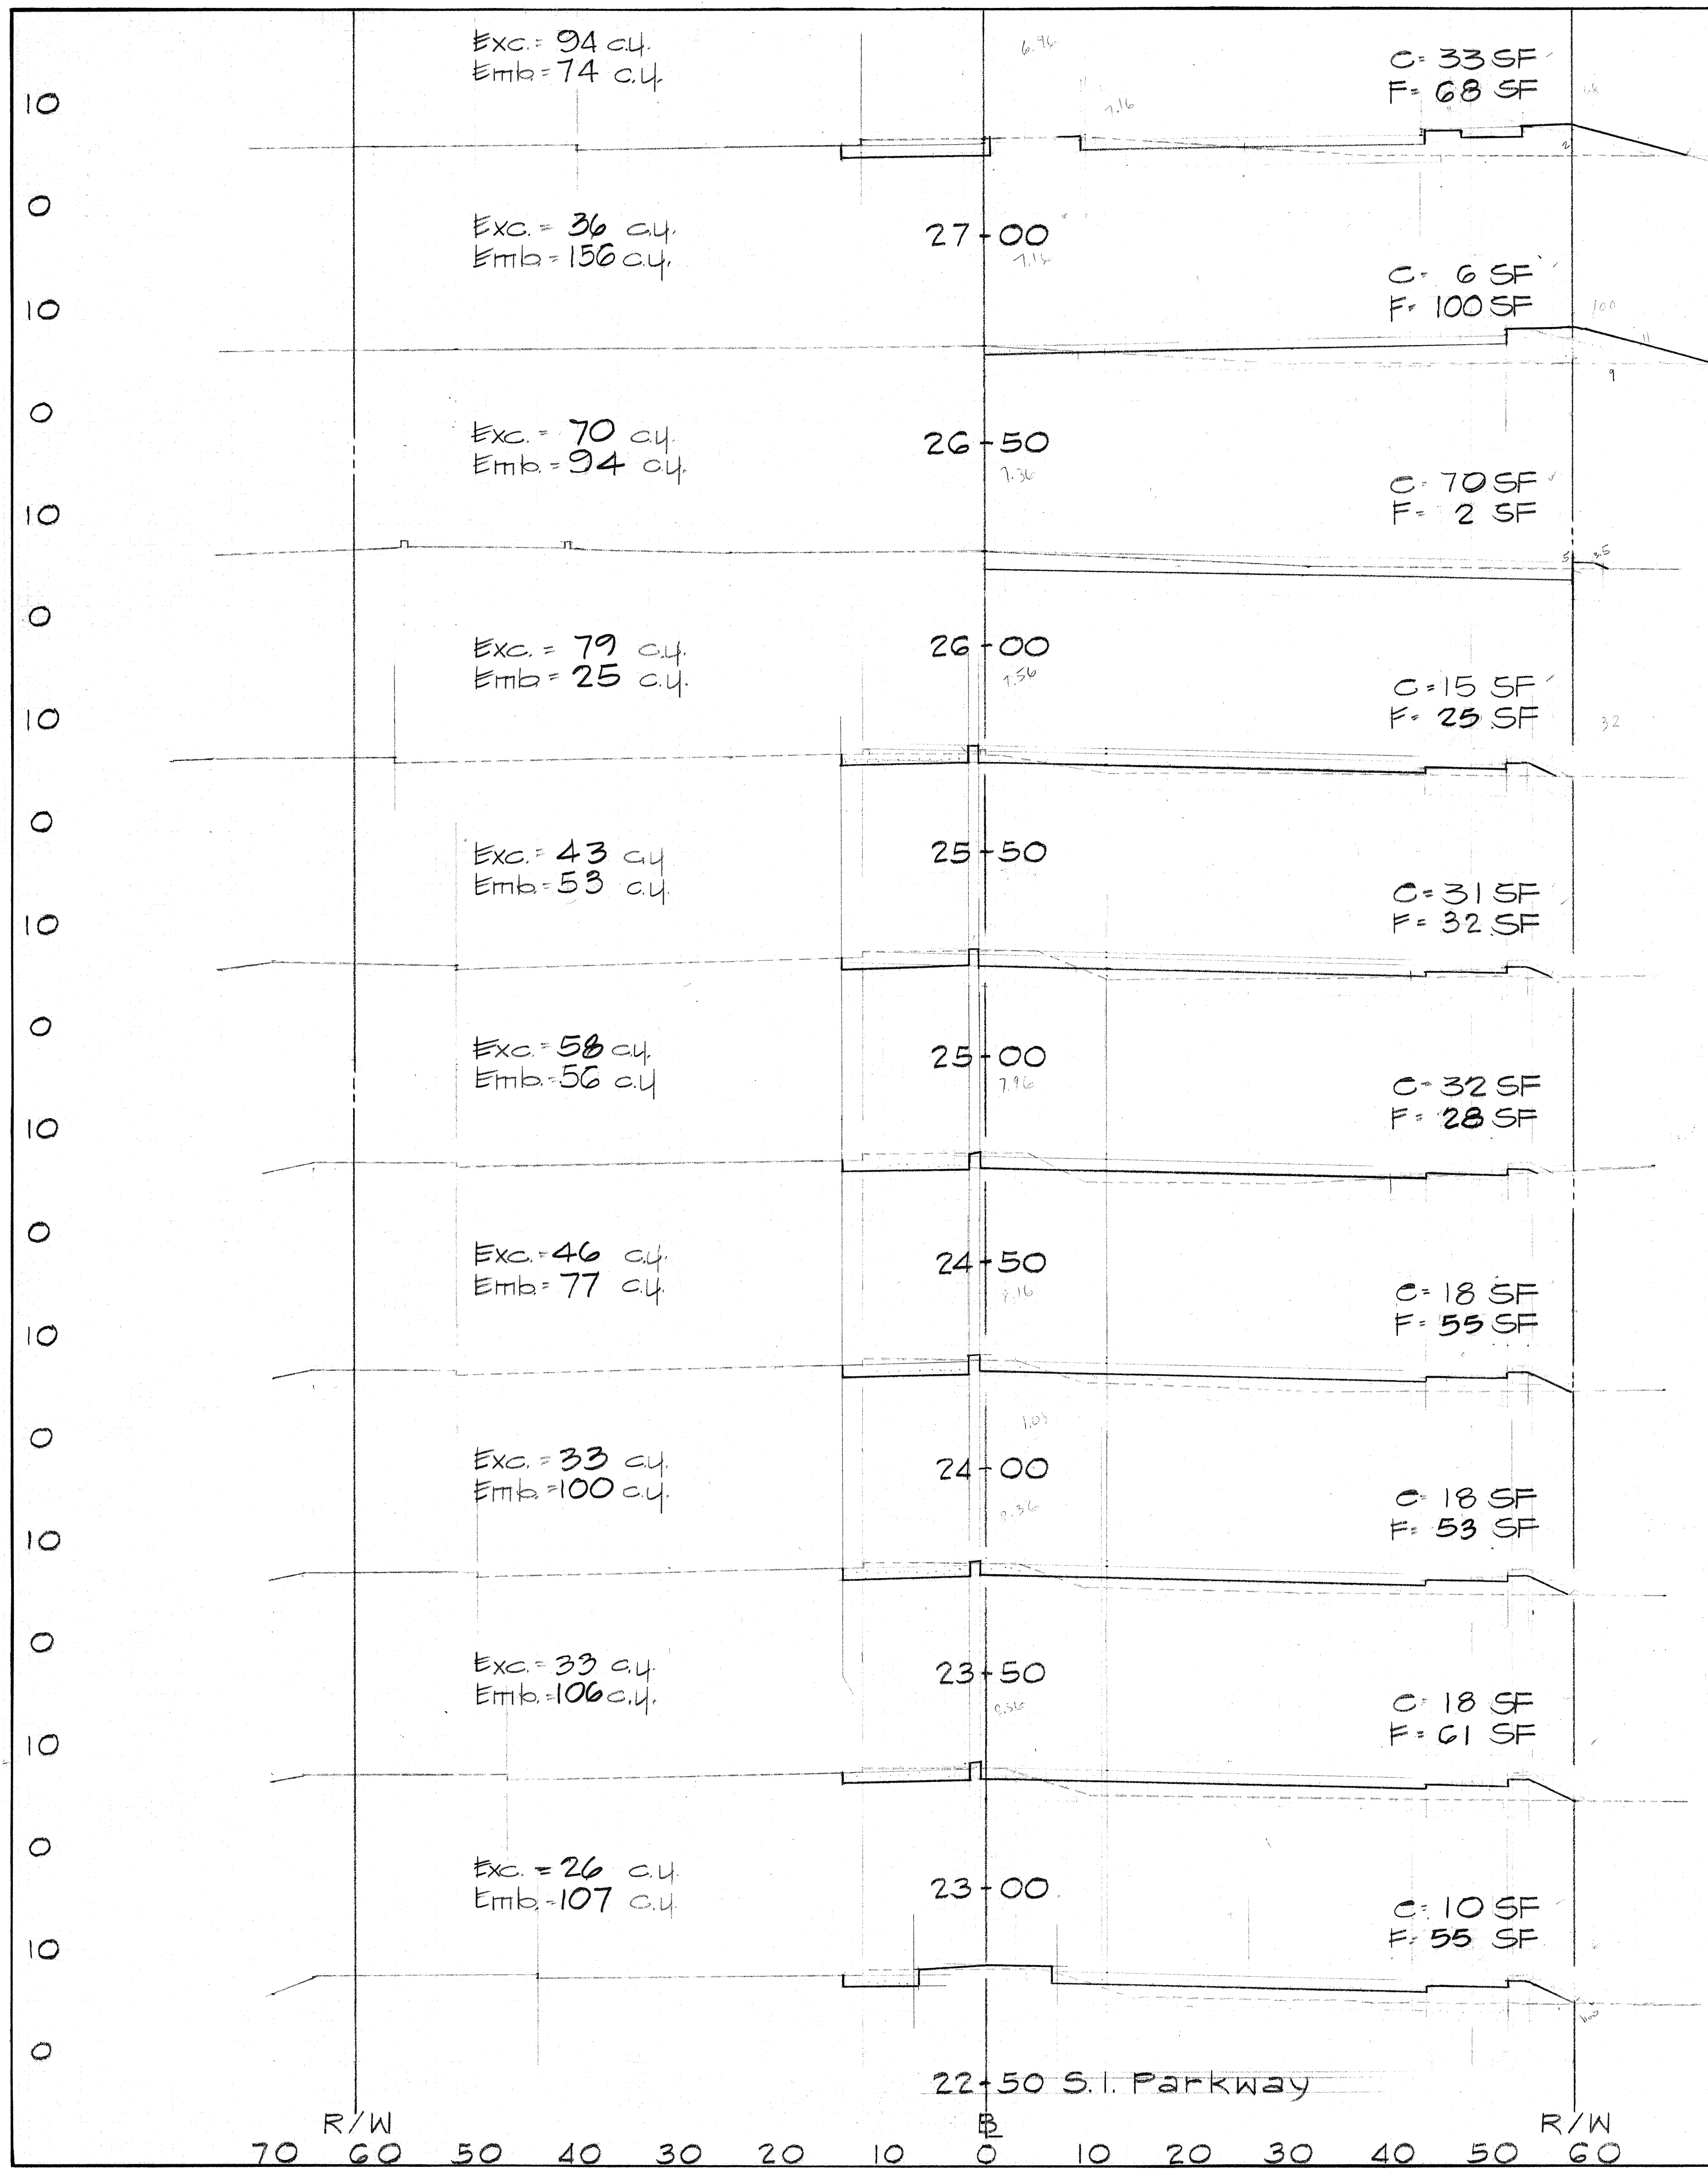


Approved for Grading Only:
 Chief, Division of Engineering
 Date

FED. ROAD DIST. NO.	STATE	FED. AID PROJ. NO.	FISCAL YEAR	SHEET NO.	TOTAL SHEETS
HAWAII	HAW.	F-064-1(2)	1987	87	151


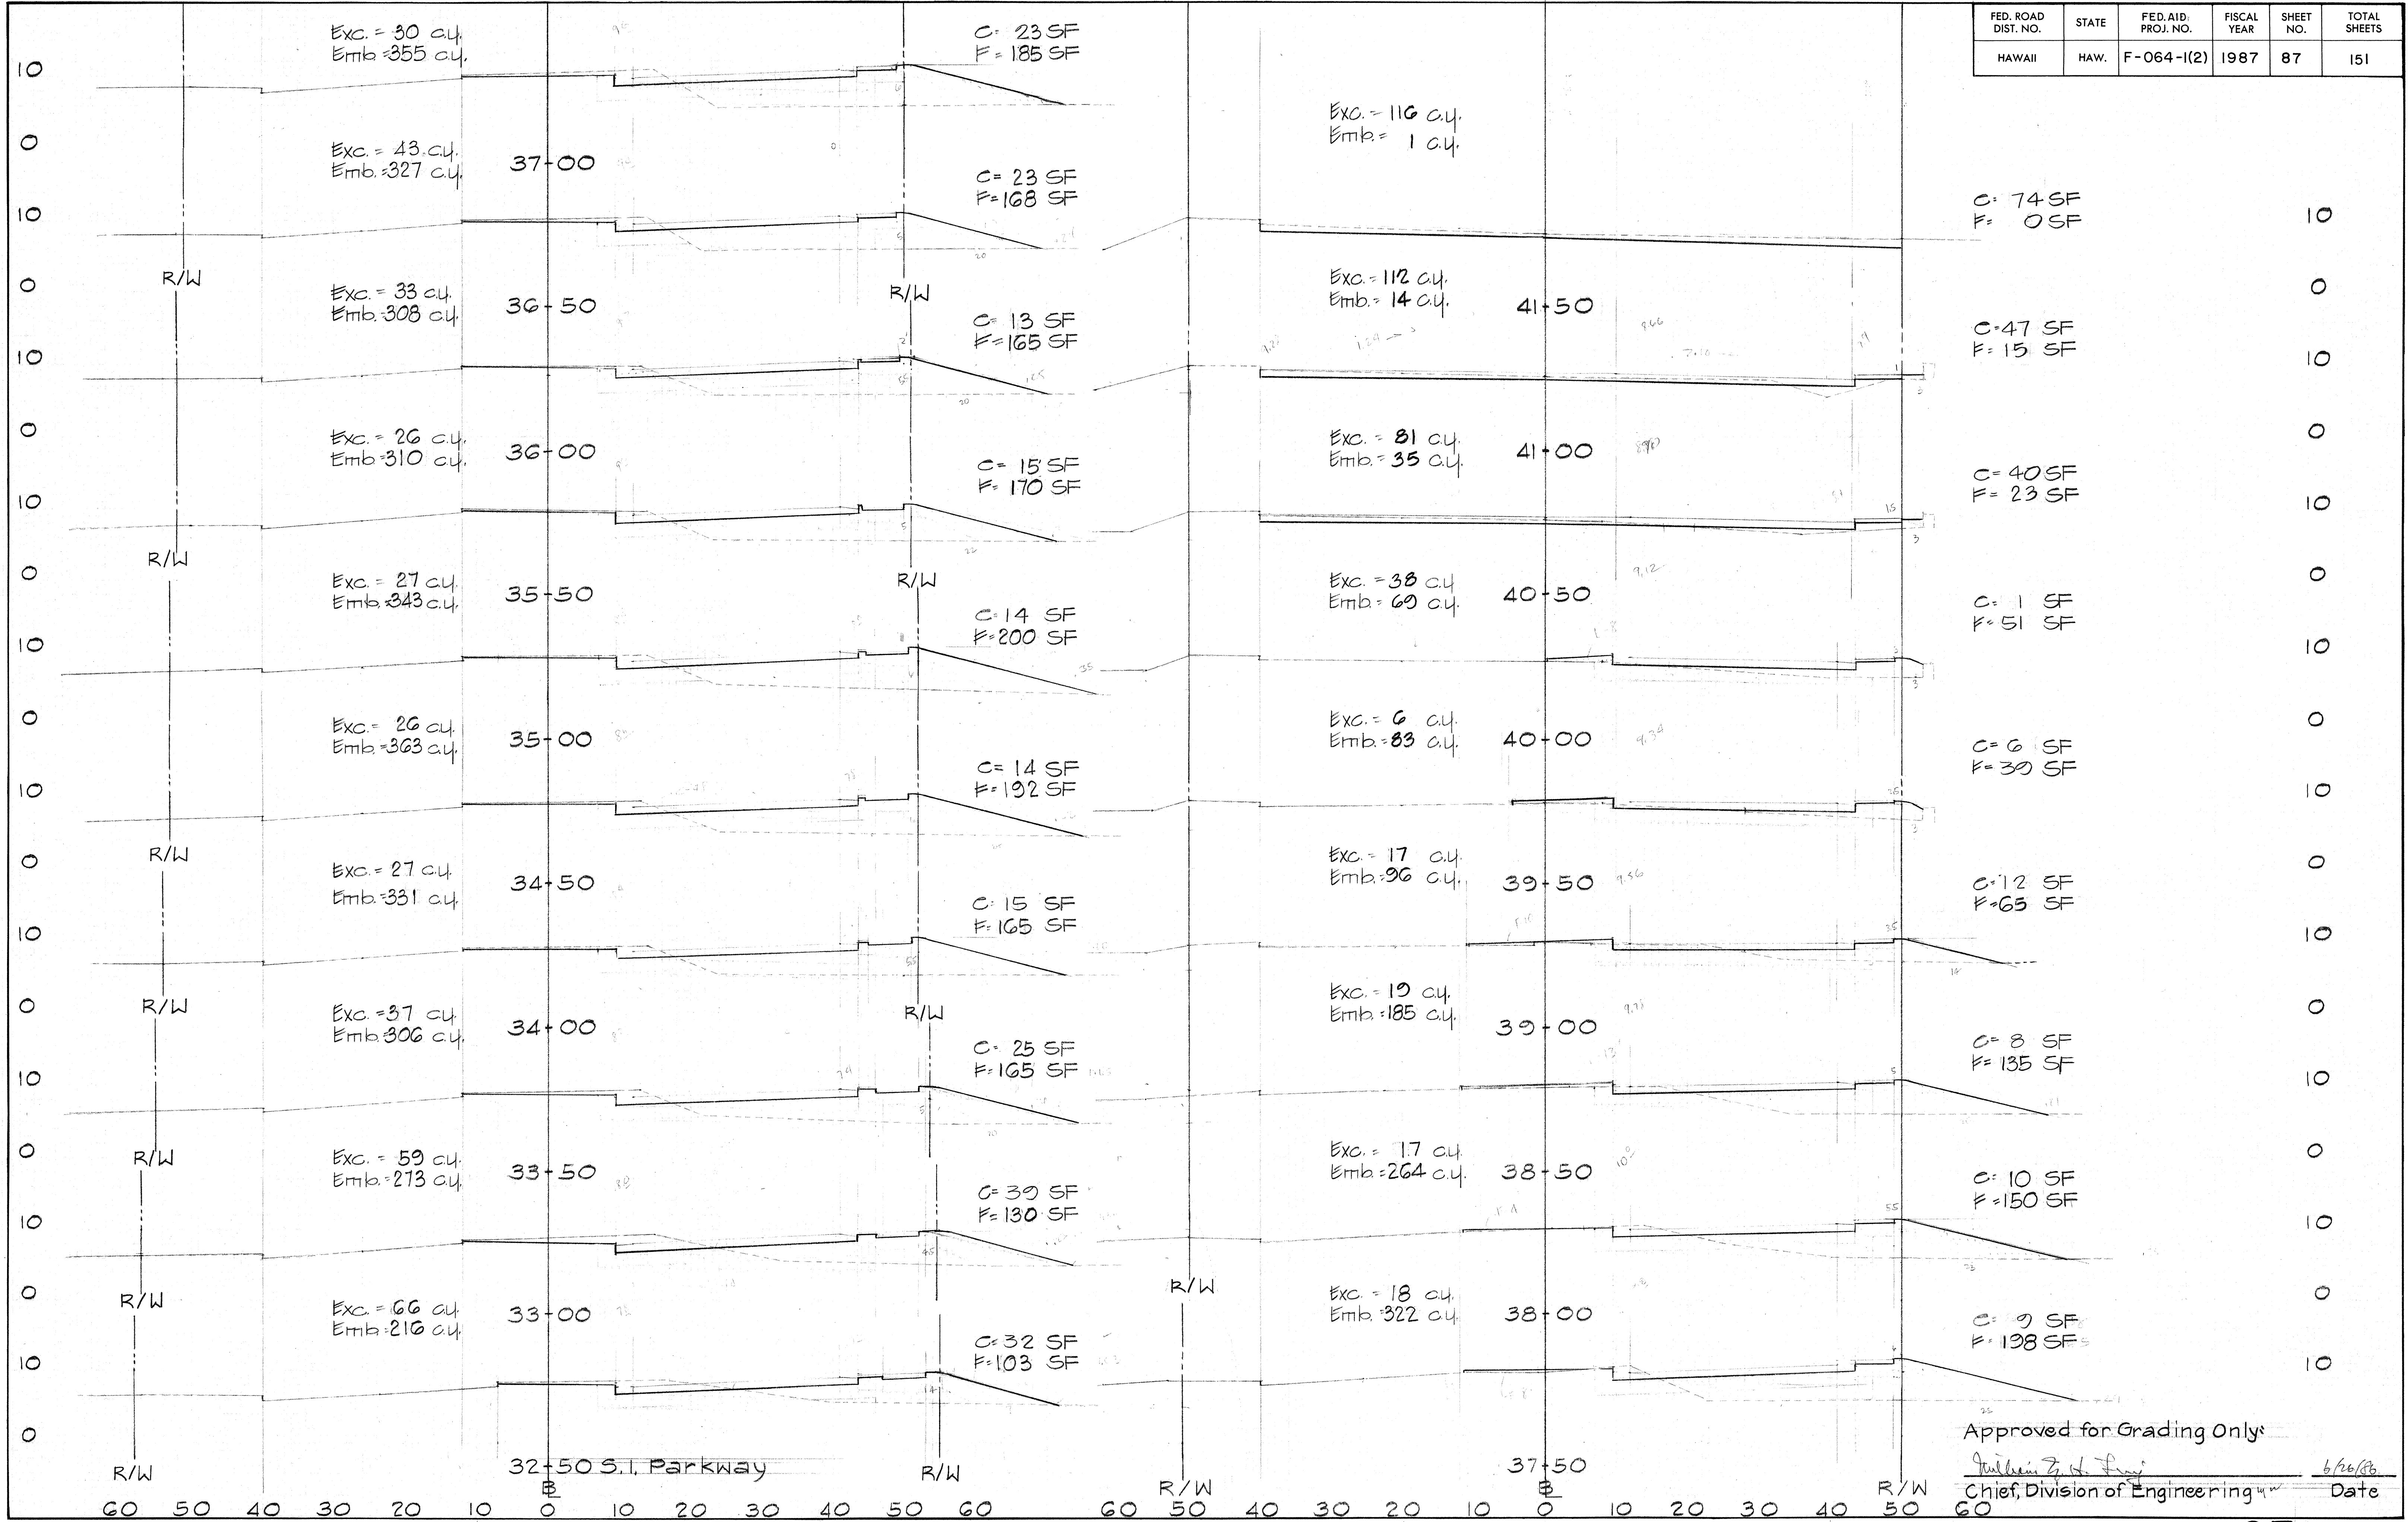


FED. ROAD DIST. NO.	STATE	FED. AID PROJ. NO.	FISCAL YEAR	SHEET NO.	TOTAL SHEETS
HAWAII	HAW.	F-064-1(2)	1987	88	151

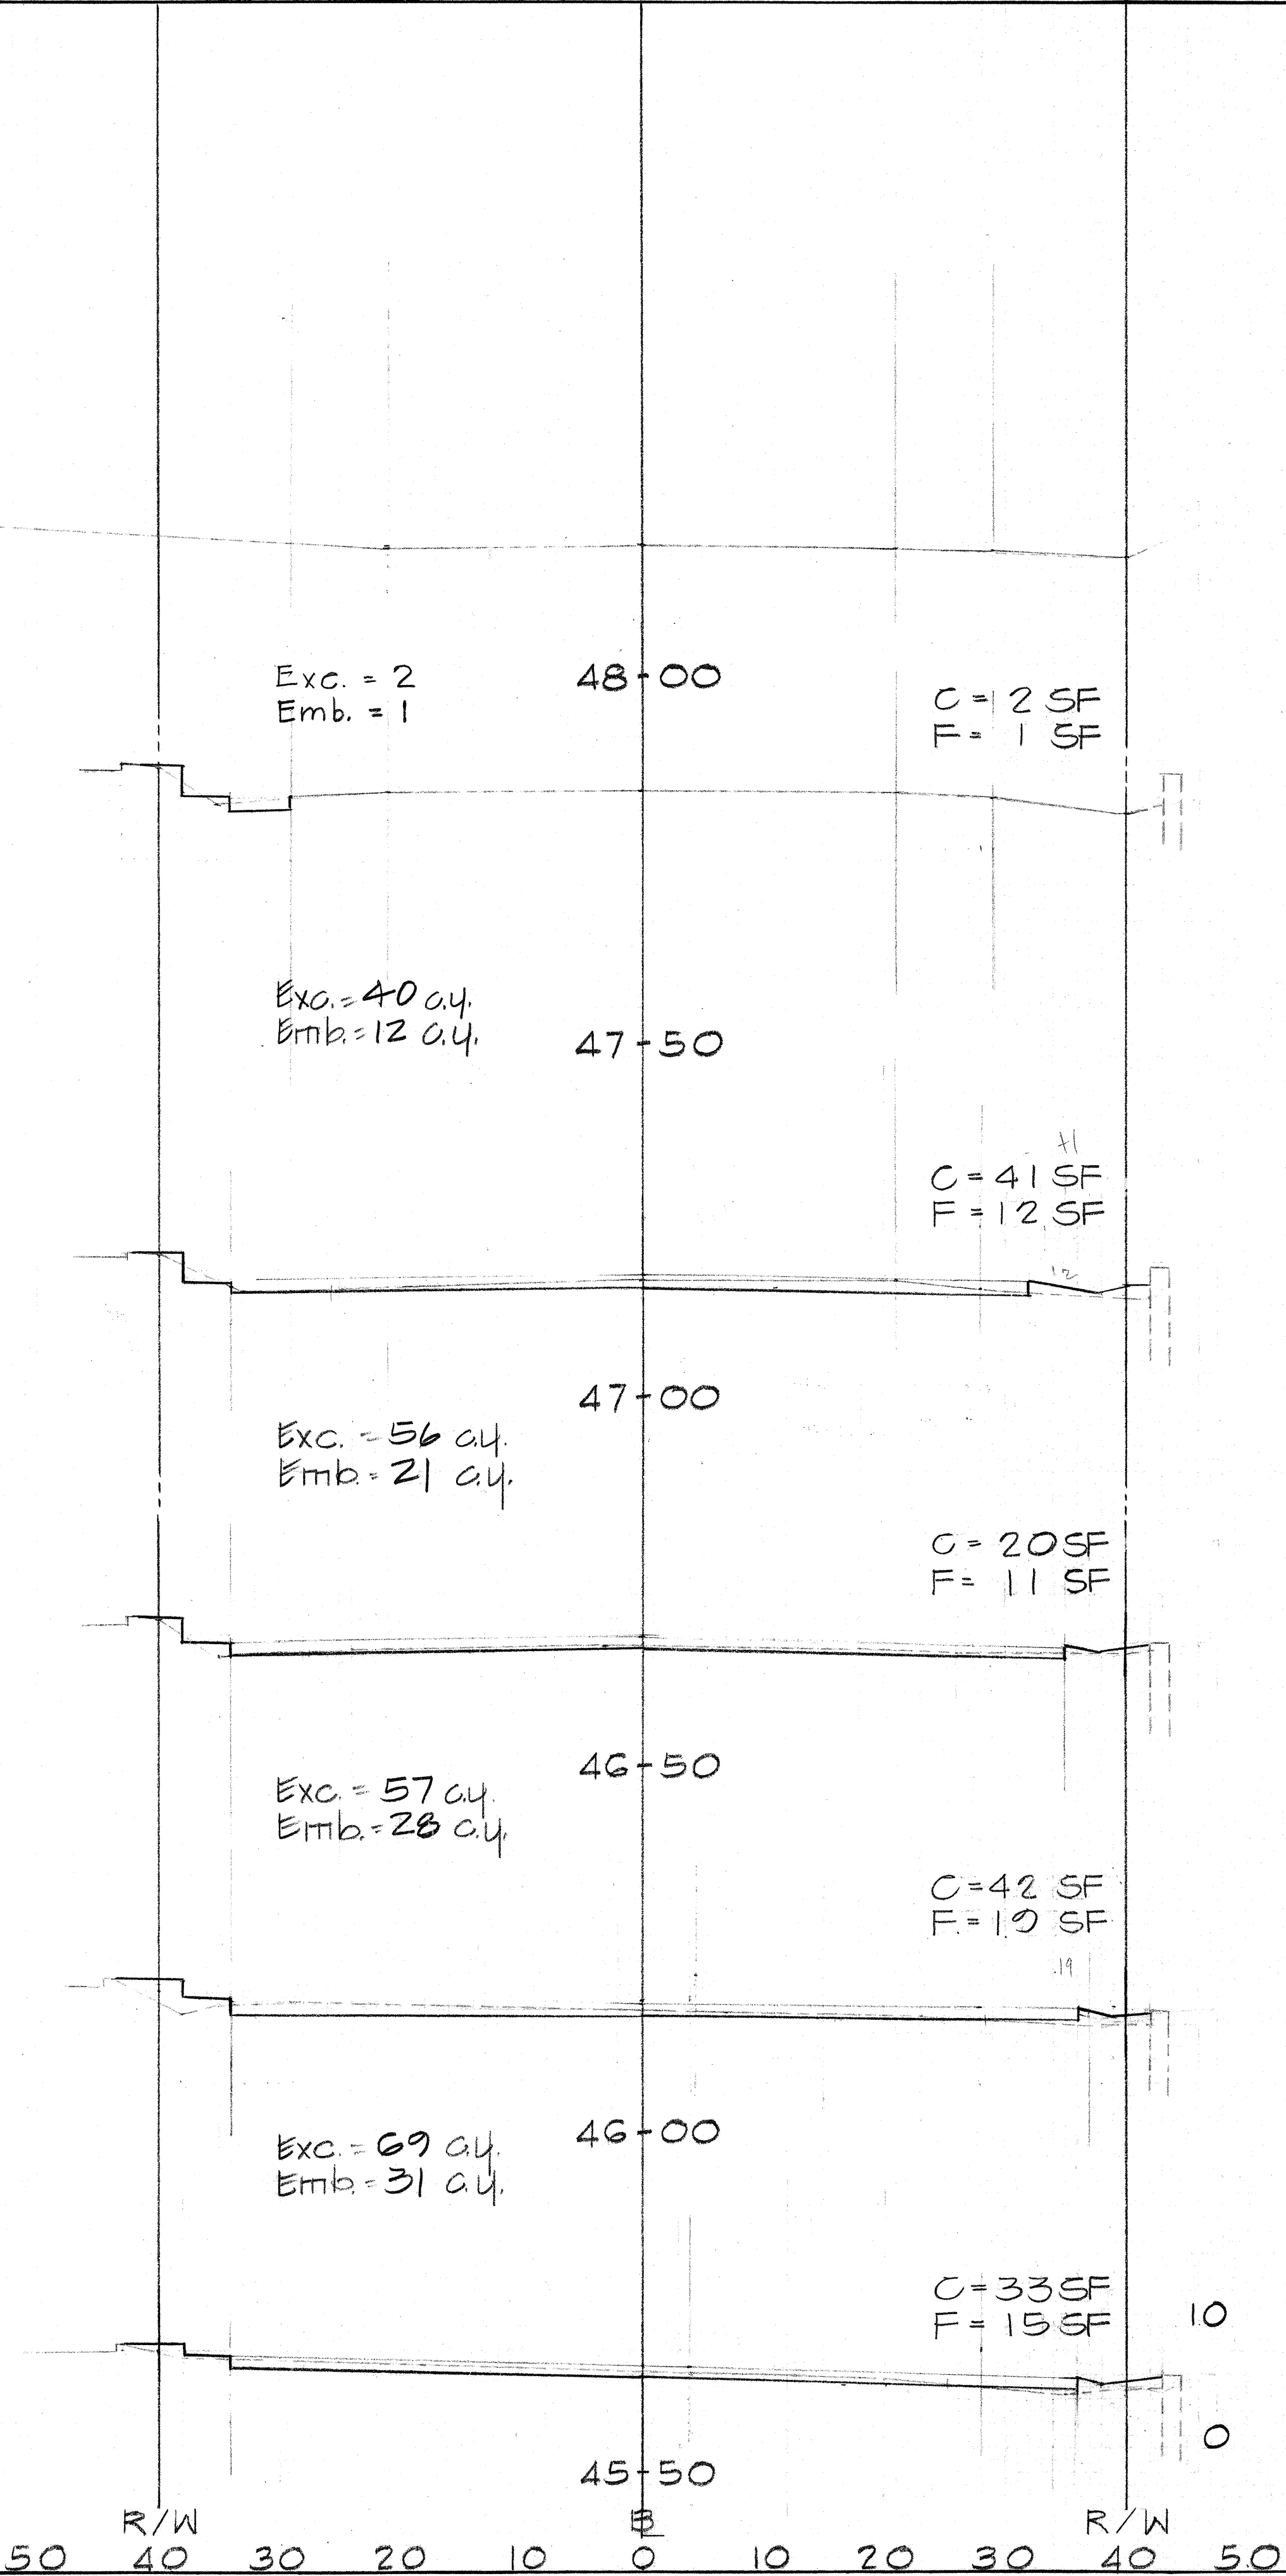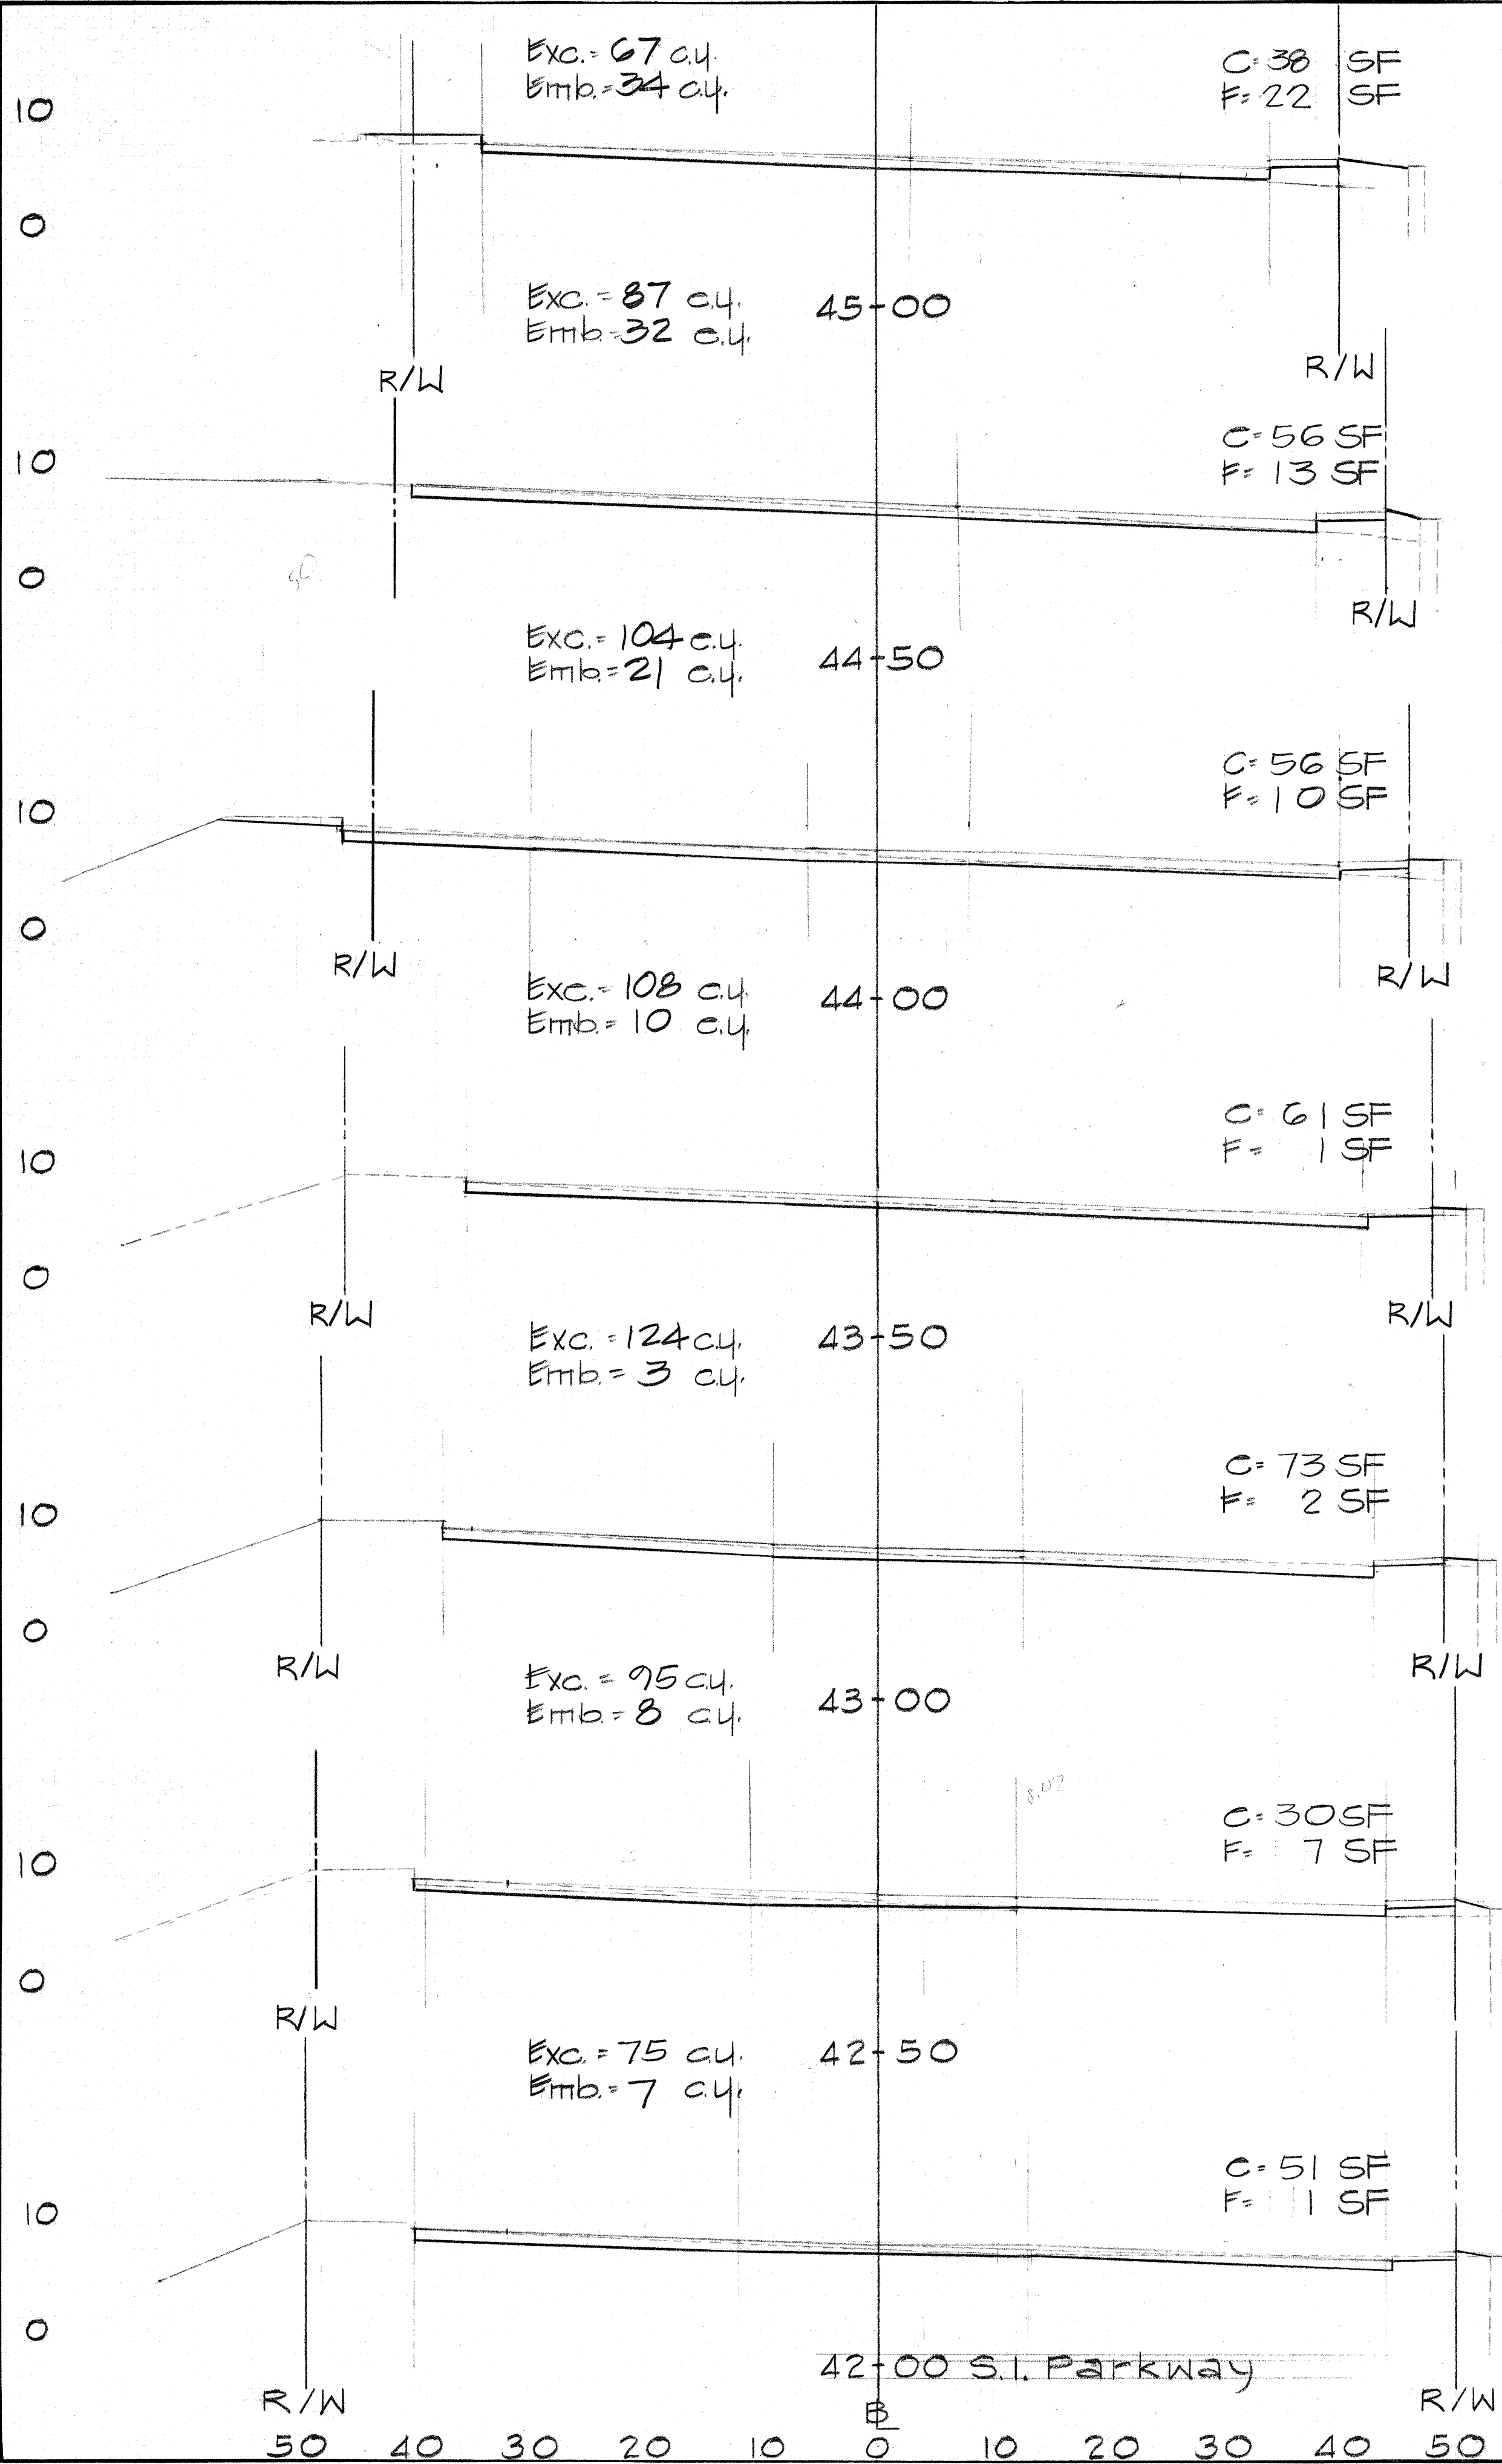

Approved for Grading Only:
William F. H. Long
Chief, Division of Engineering
6/26/88
Date

FED. ROAD DIST. NO.	STATE	FED. AID PROJ. NO.	FISCAL YEAR	SHEET NO.	TOTAL SHEETS
HAWAII	HAW.	F-064-1(2)	1987	89	151

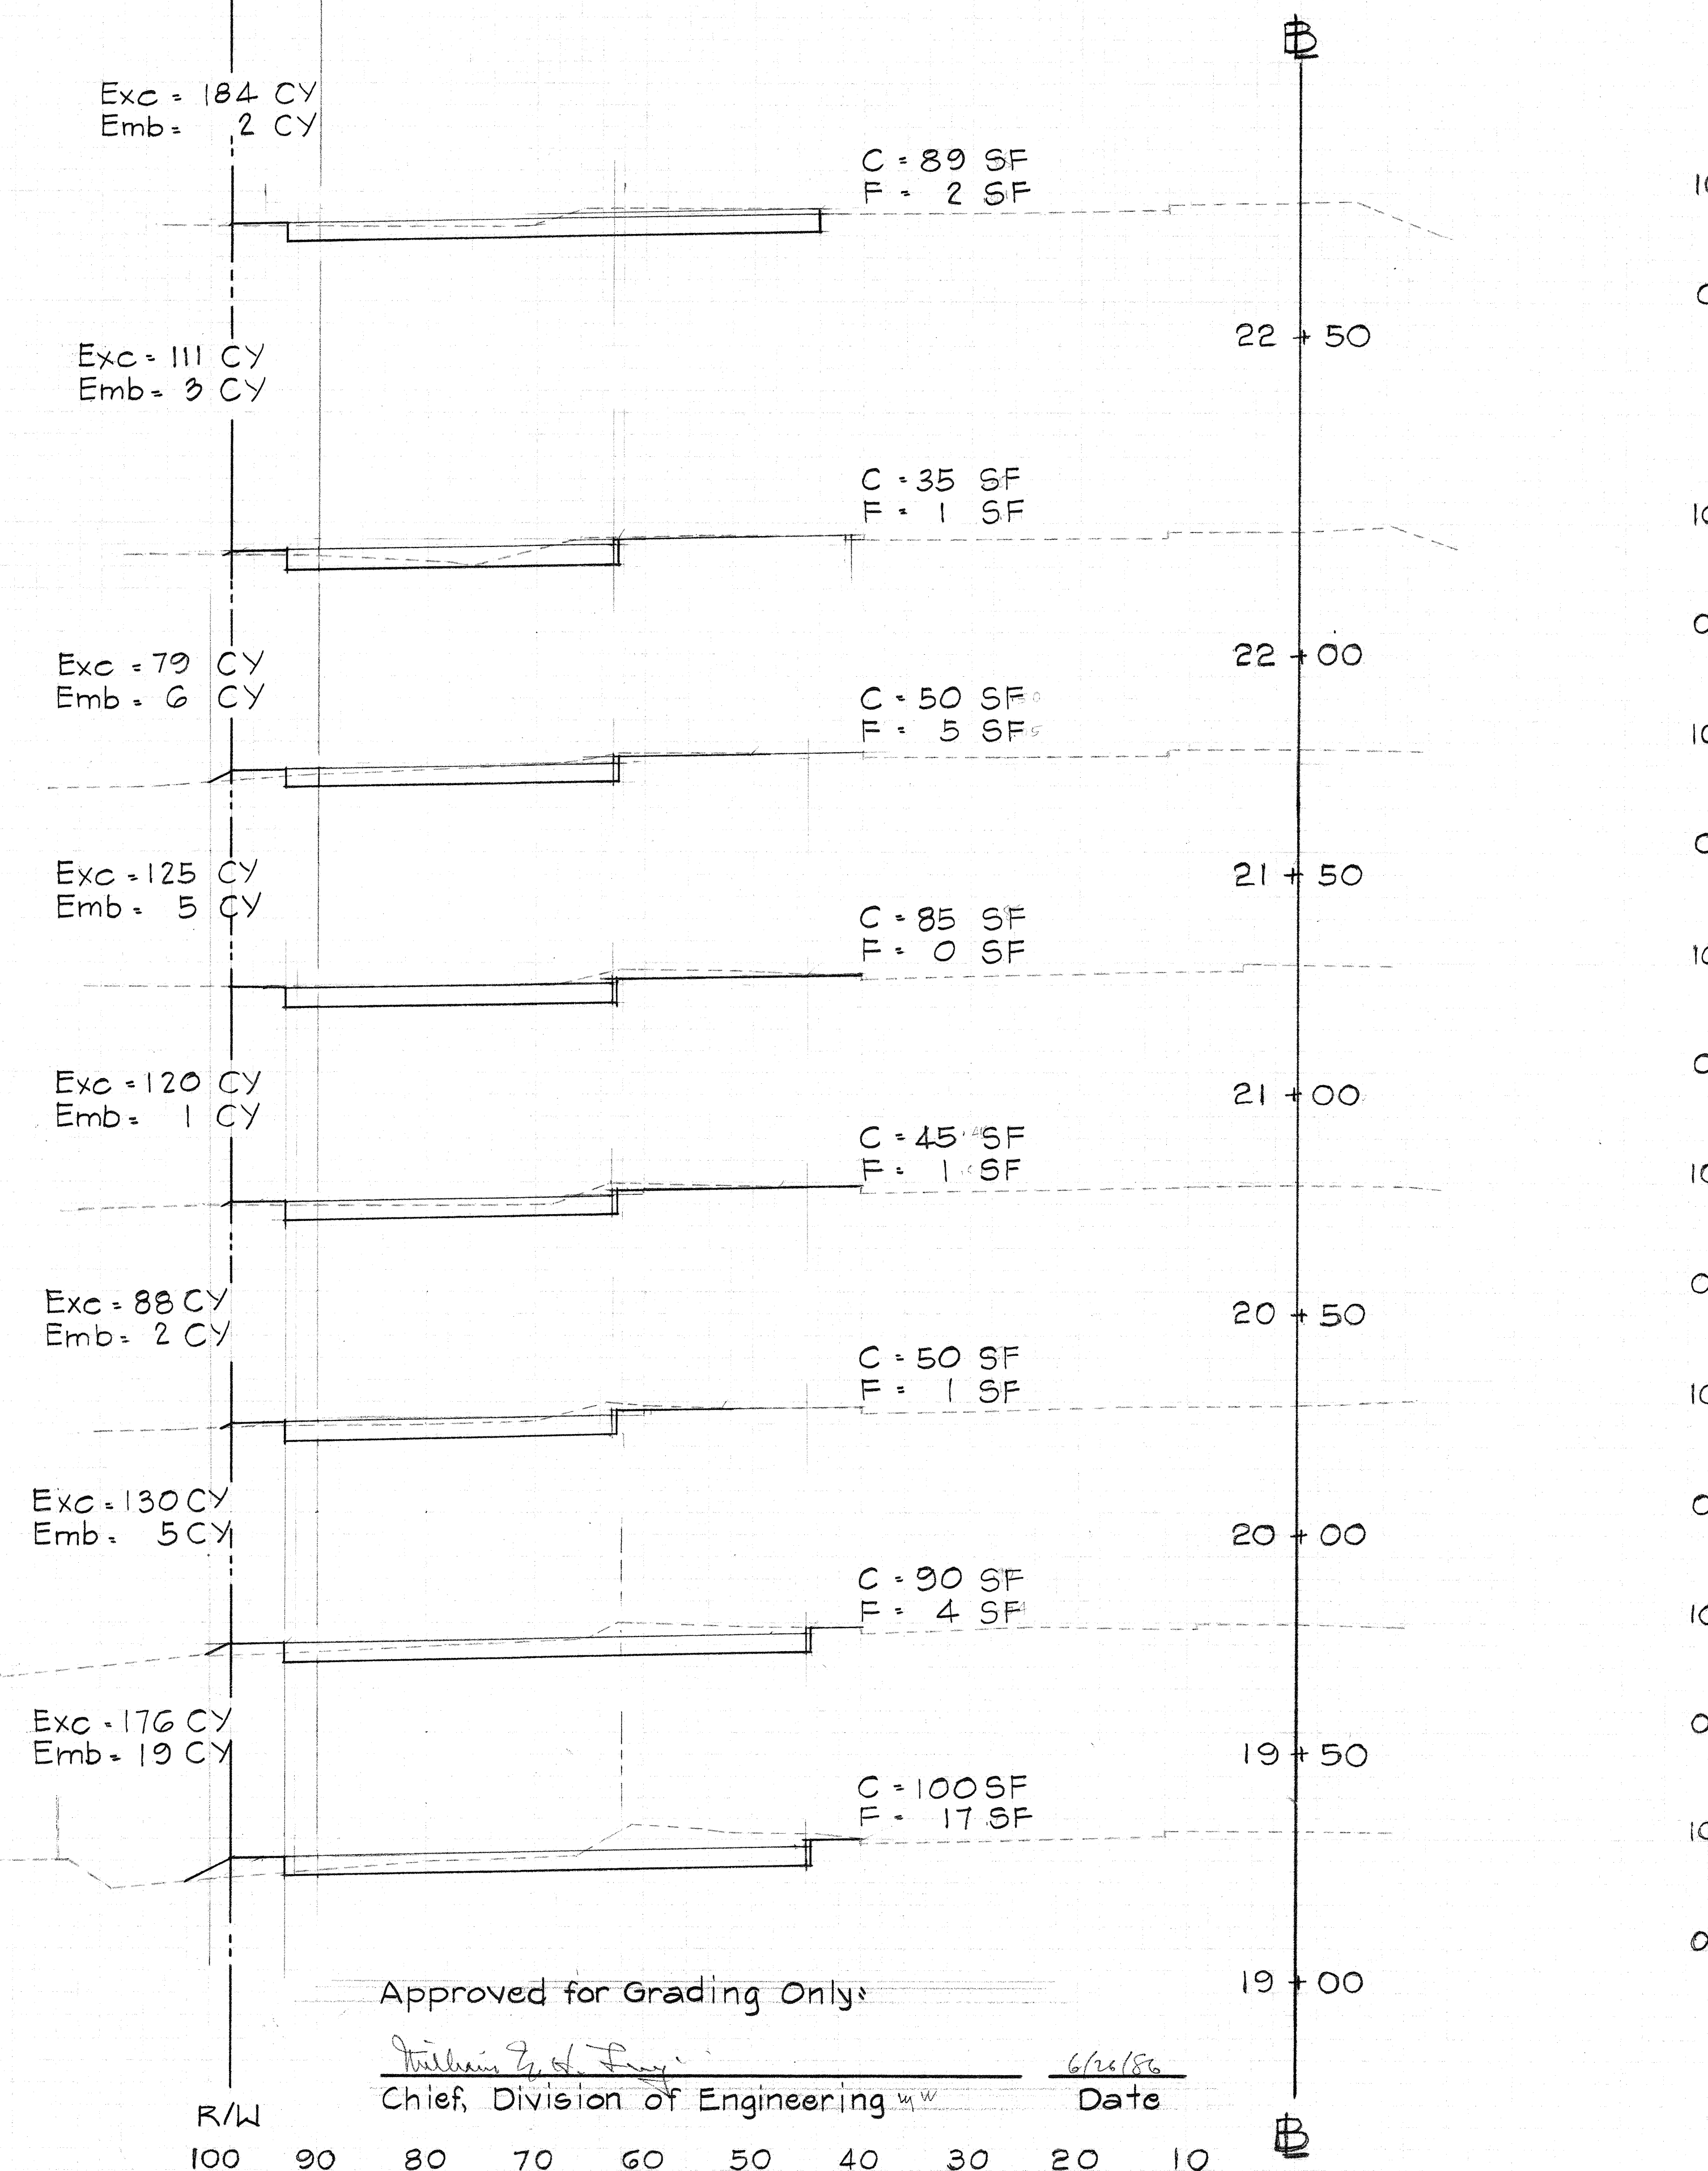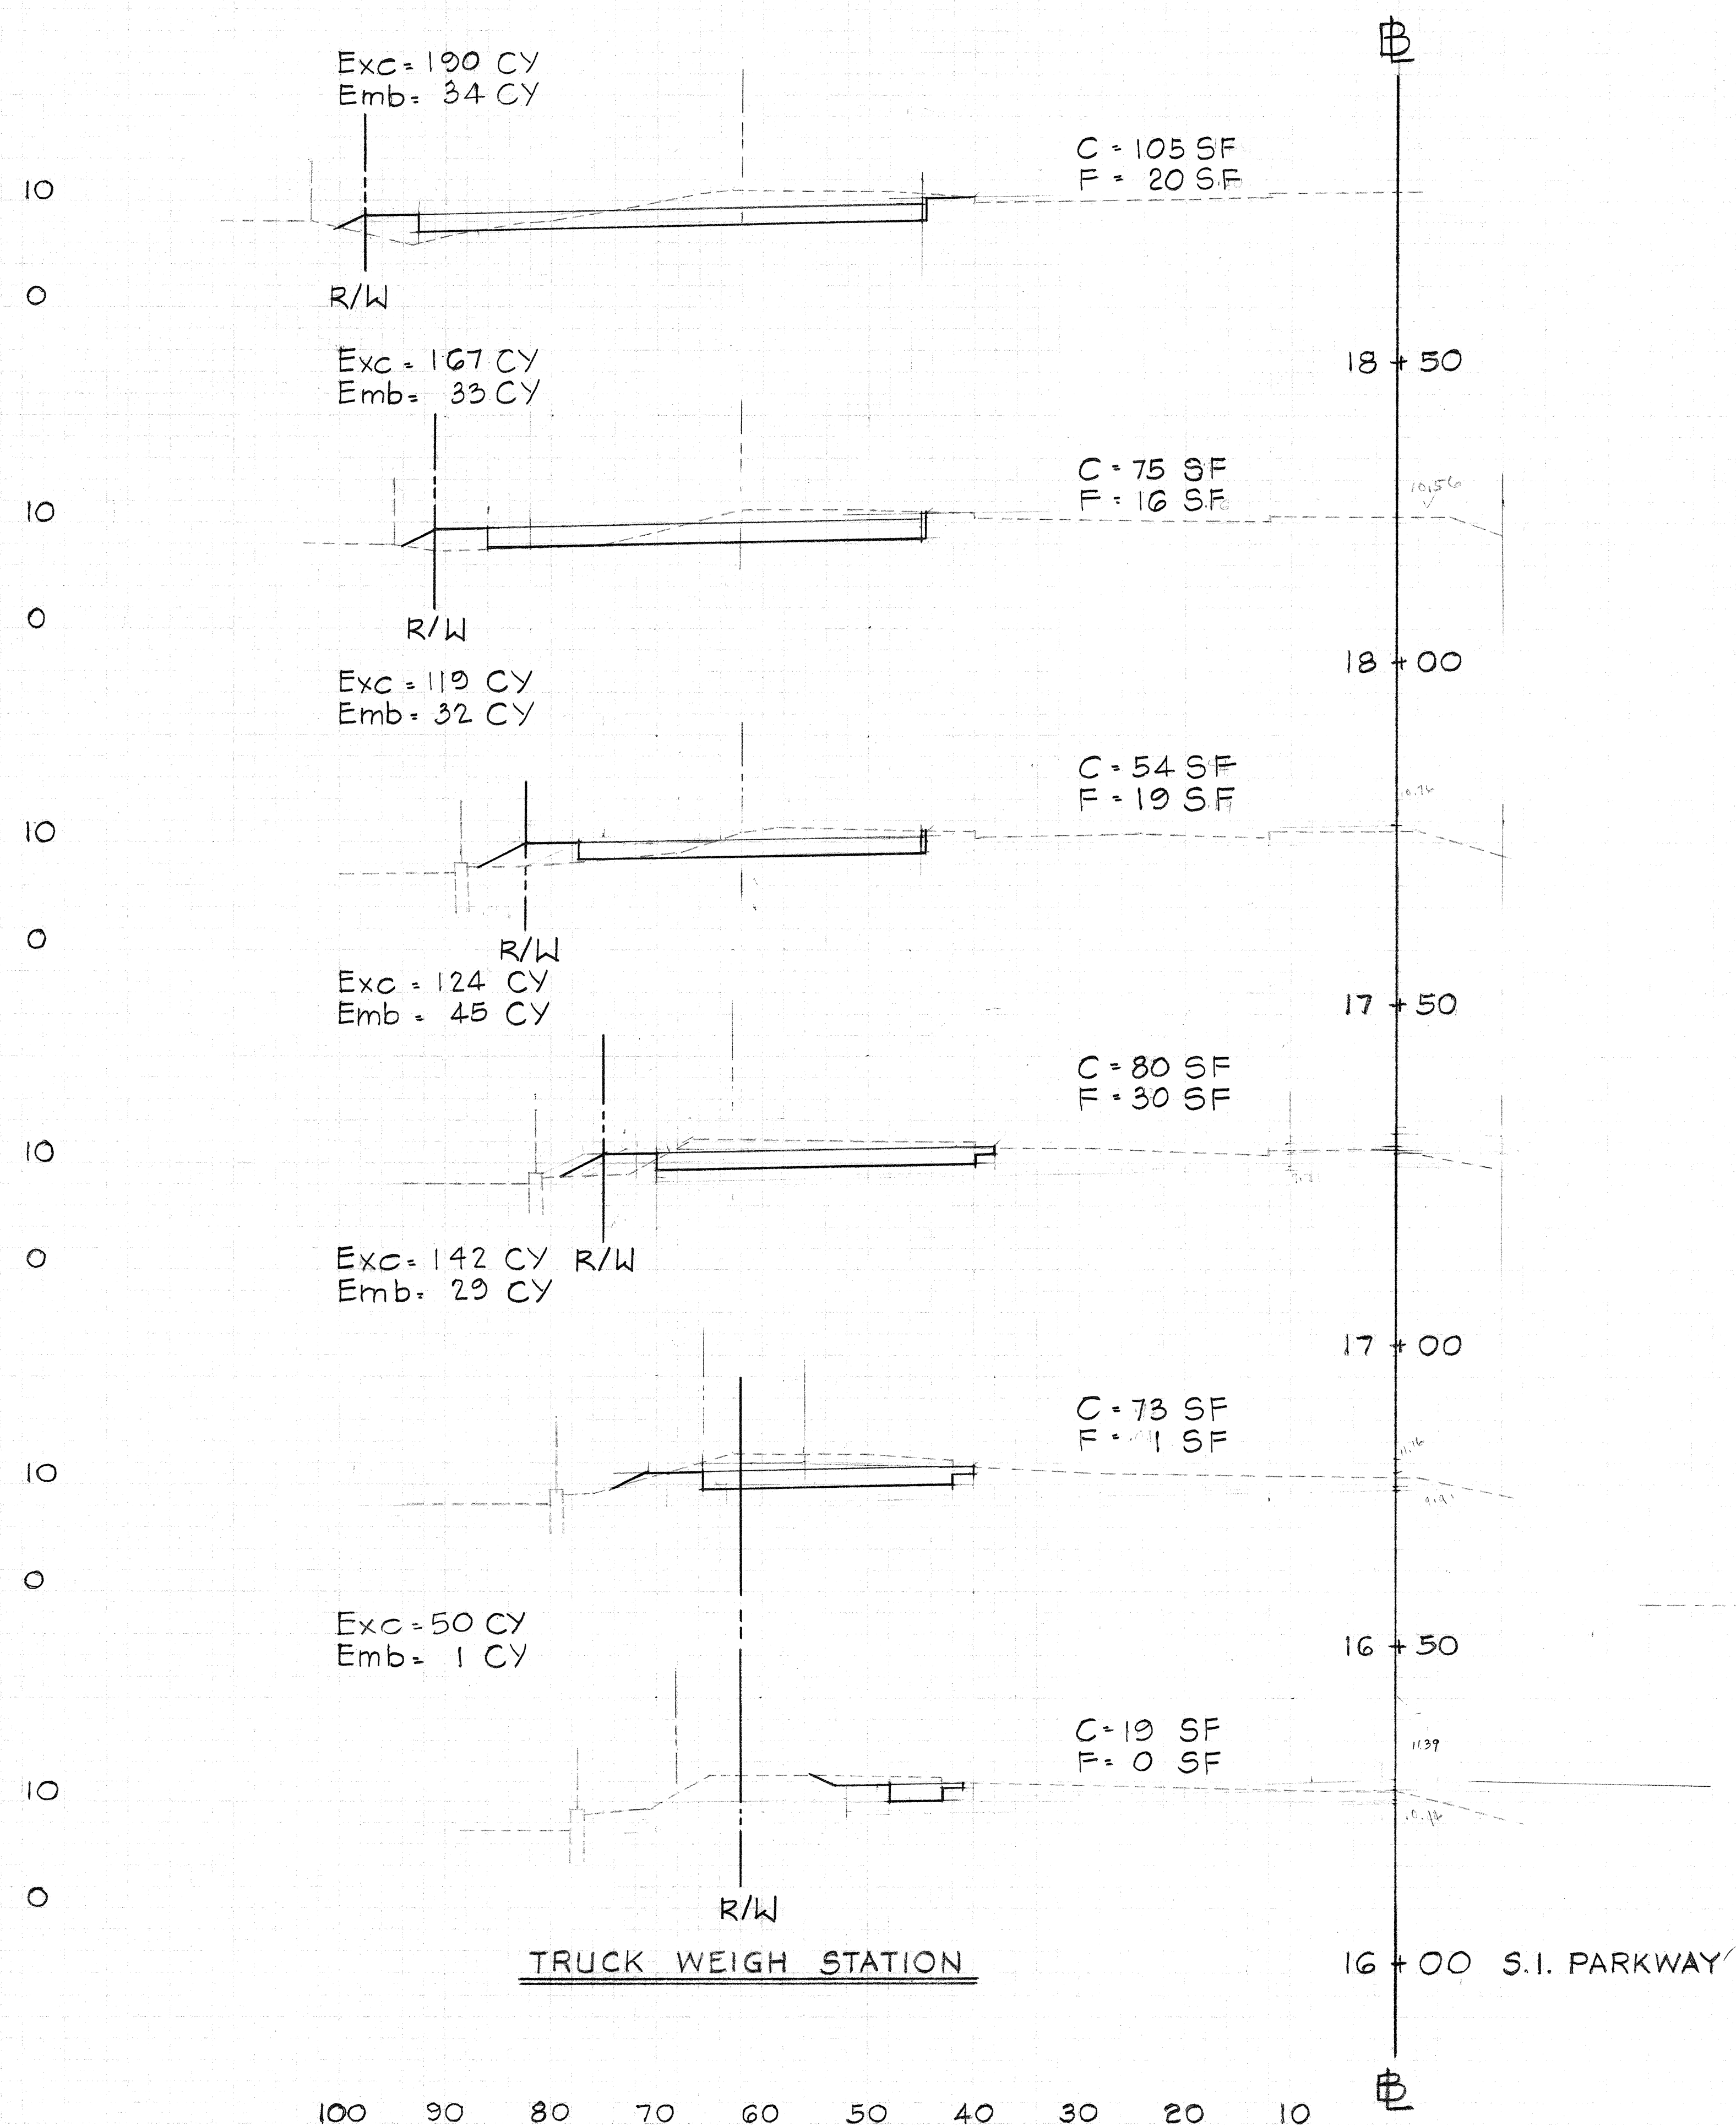



FED. ROAD DIST. NO.	STATE	FED. AID PROJ. NO.	FISCAL YEAR	SHEET NO.	TOTAL SHEETS
HAWAII	HAW.	F-064-1(2)	1987	90	151

EARTHWORK SUMMARY:

Total Excavation - 6,934 CY

Total Embankment - 15,469 CY

Total Graded Area - 11.65 Acs.

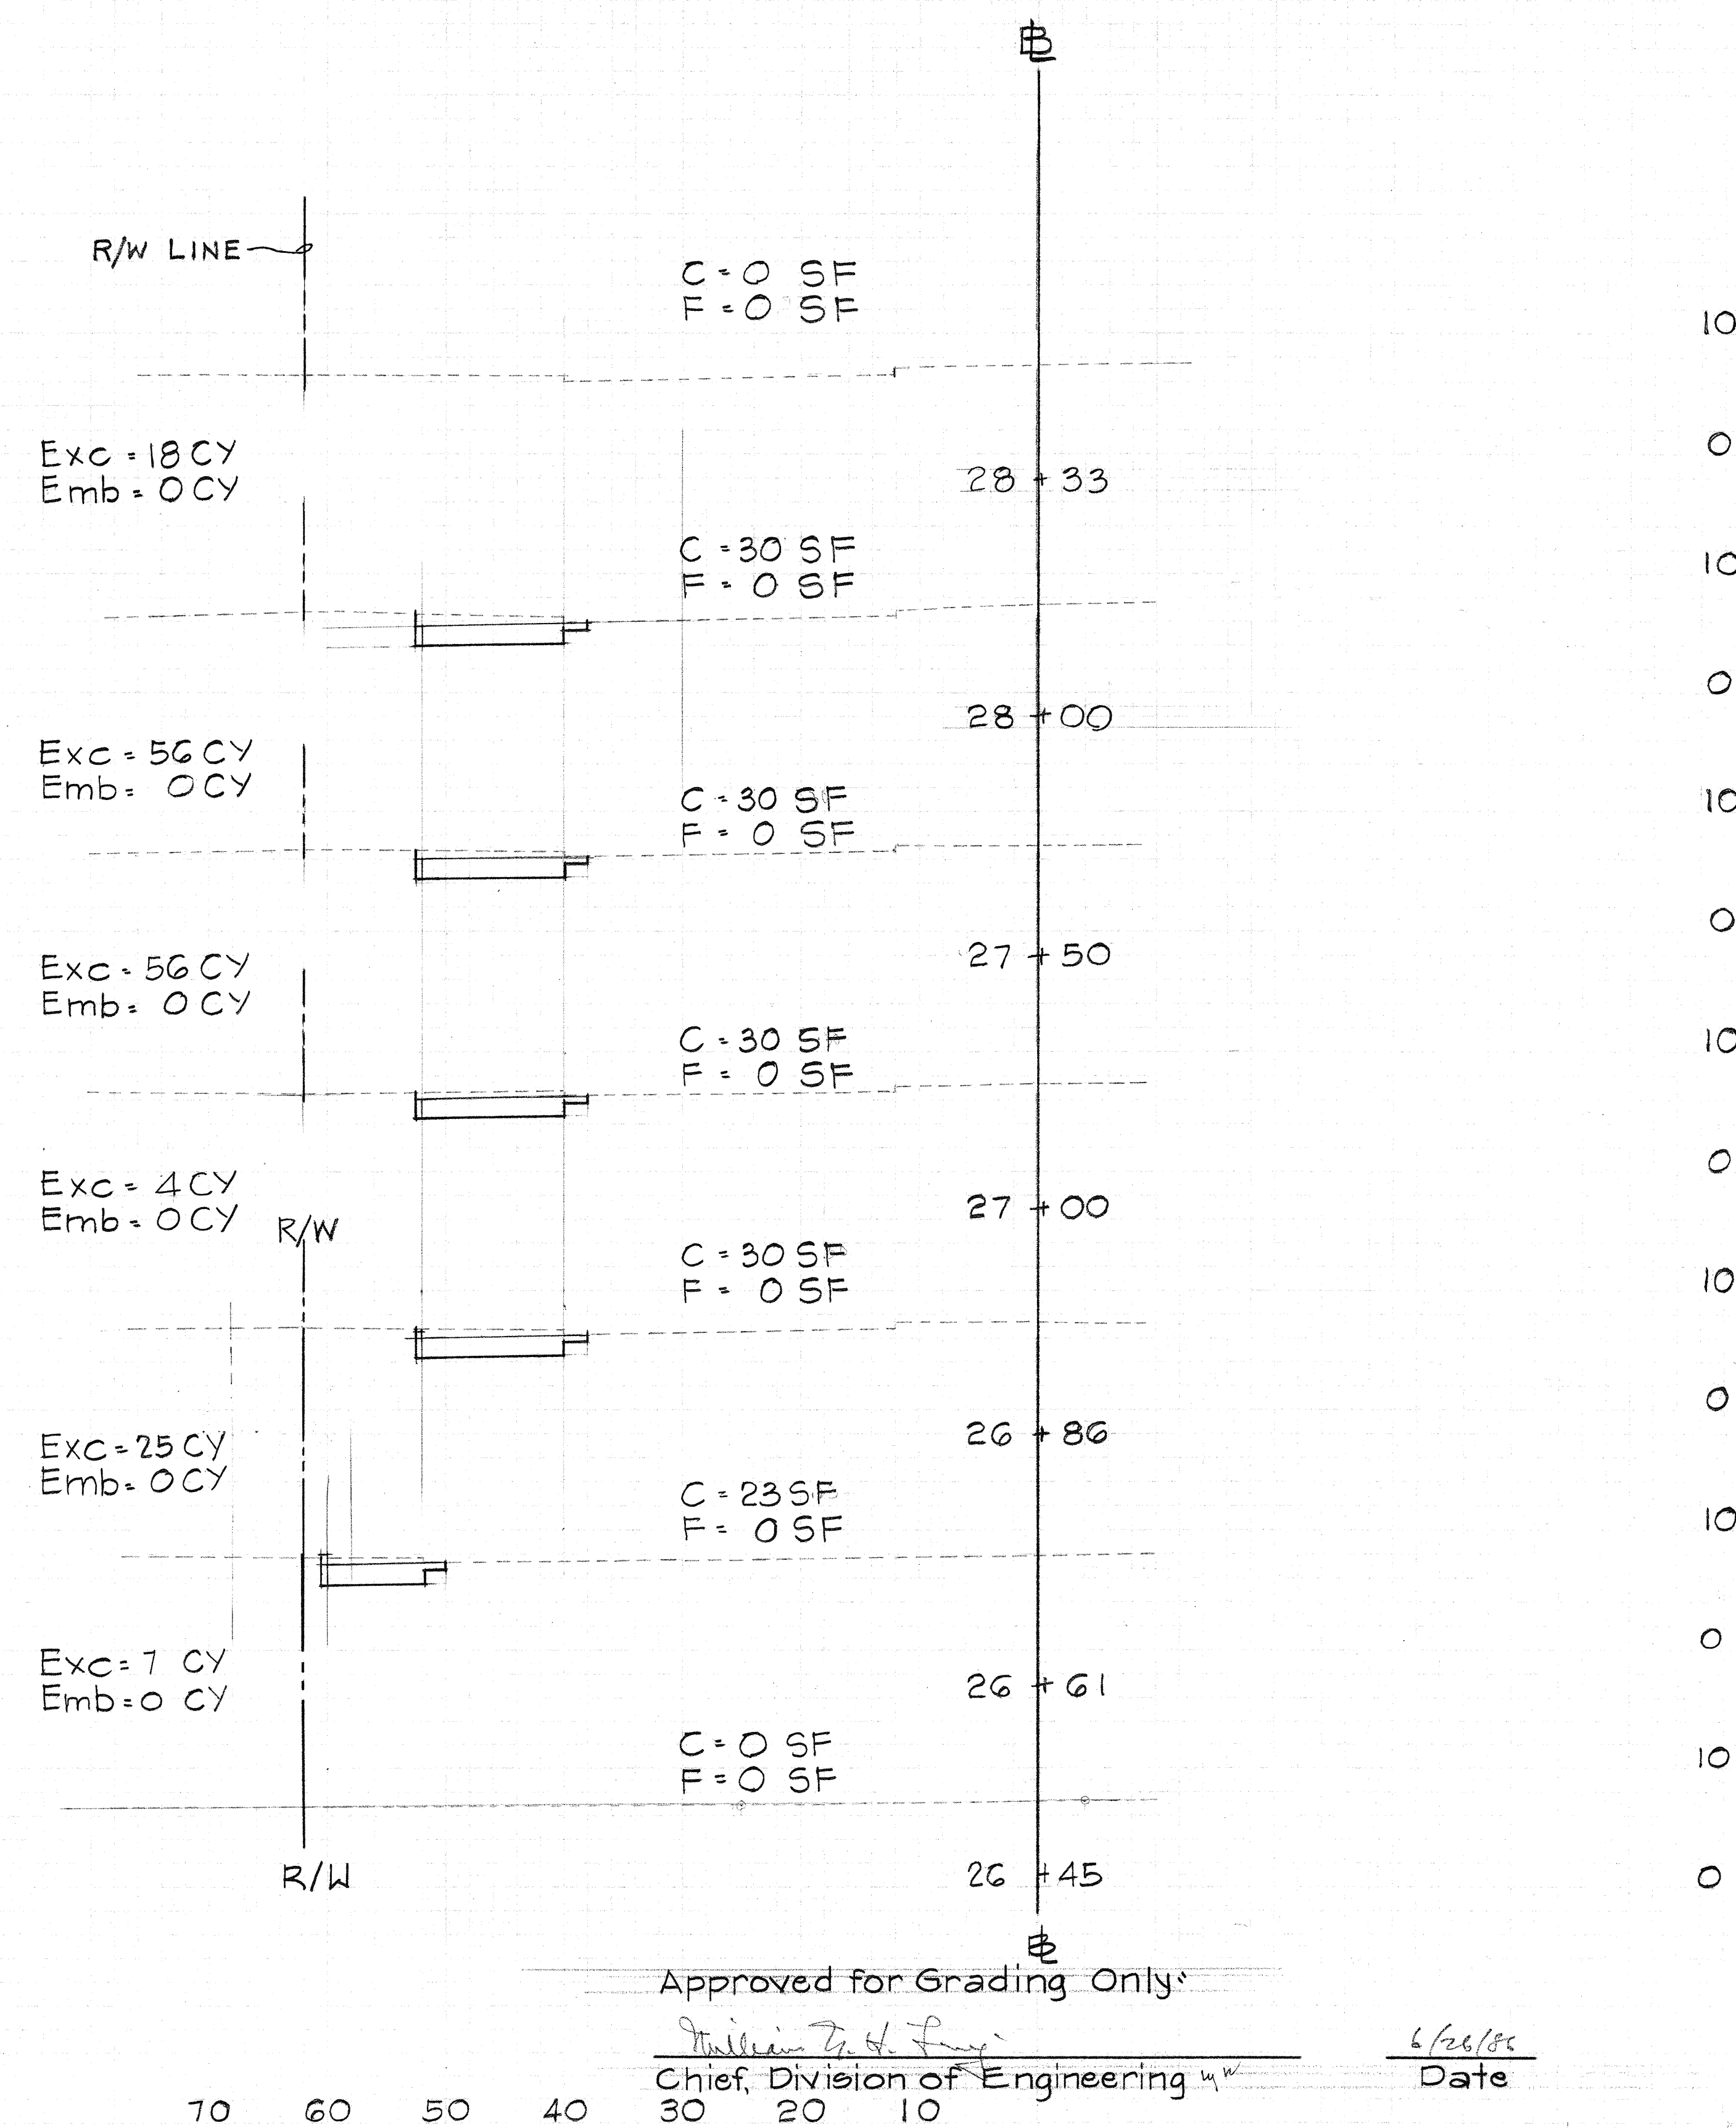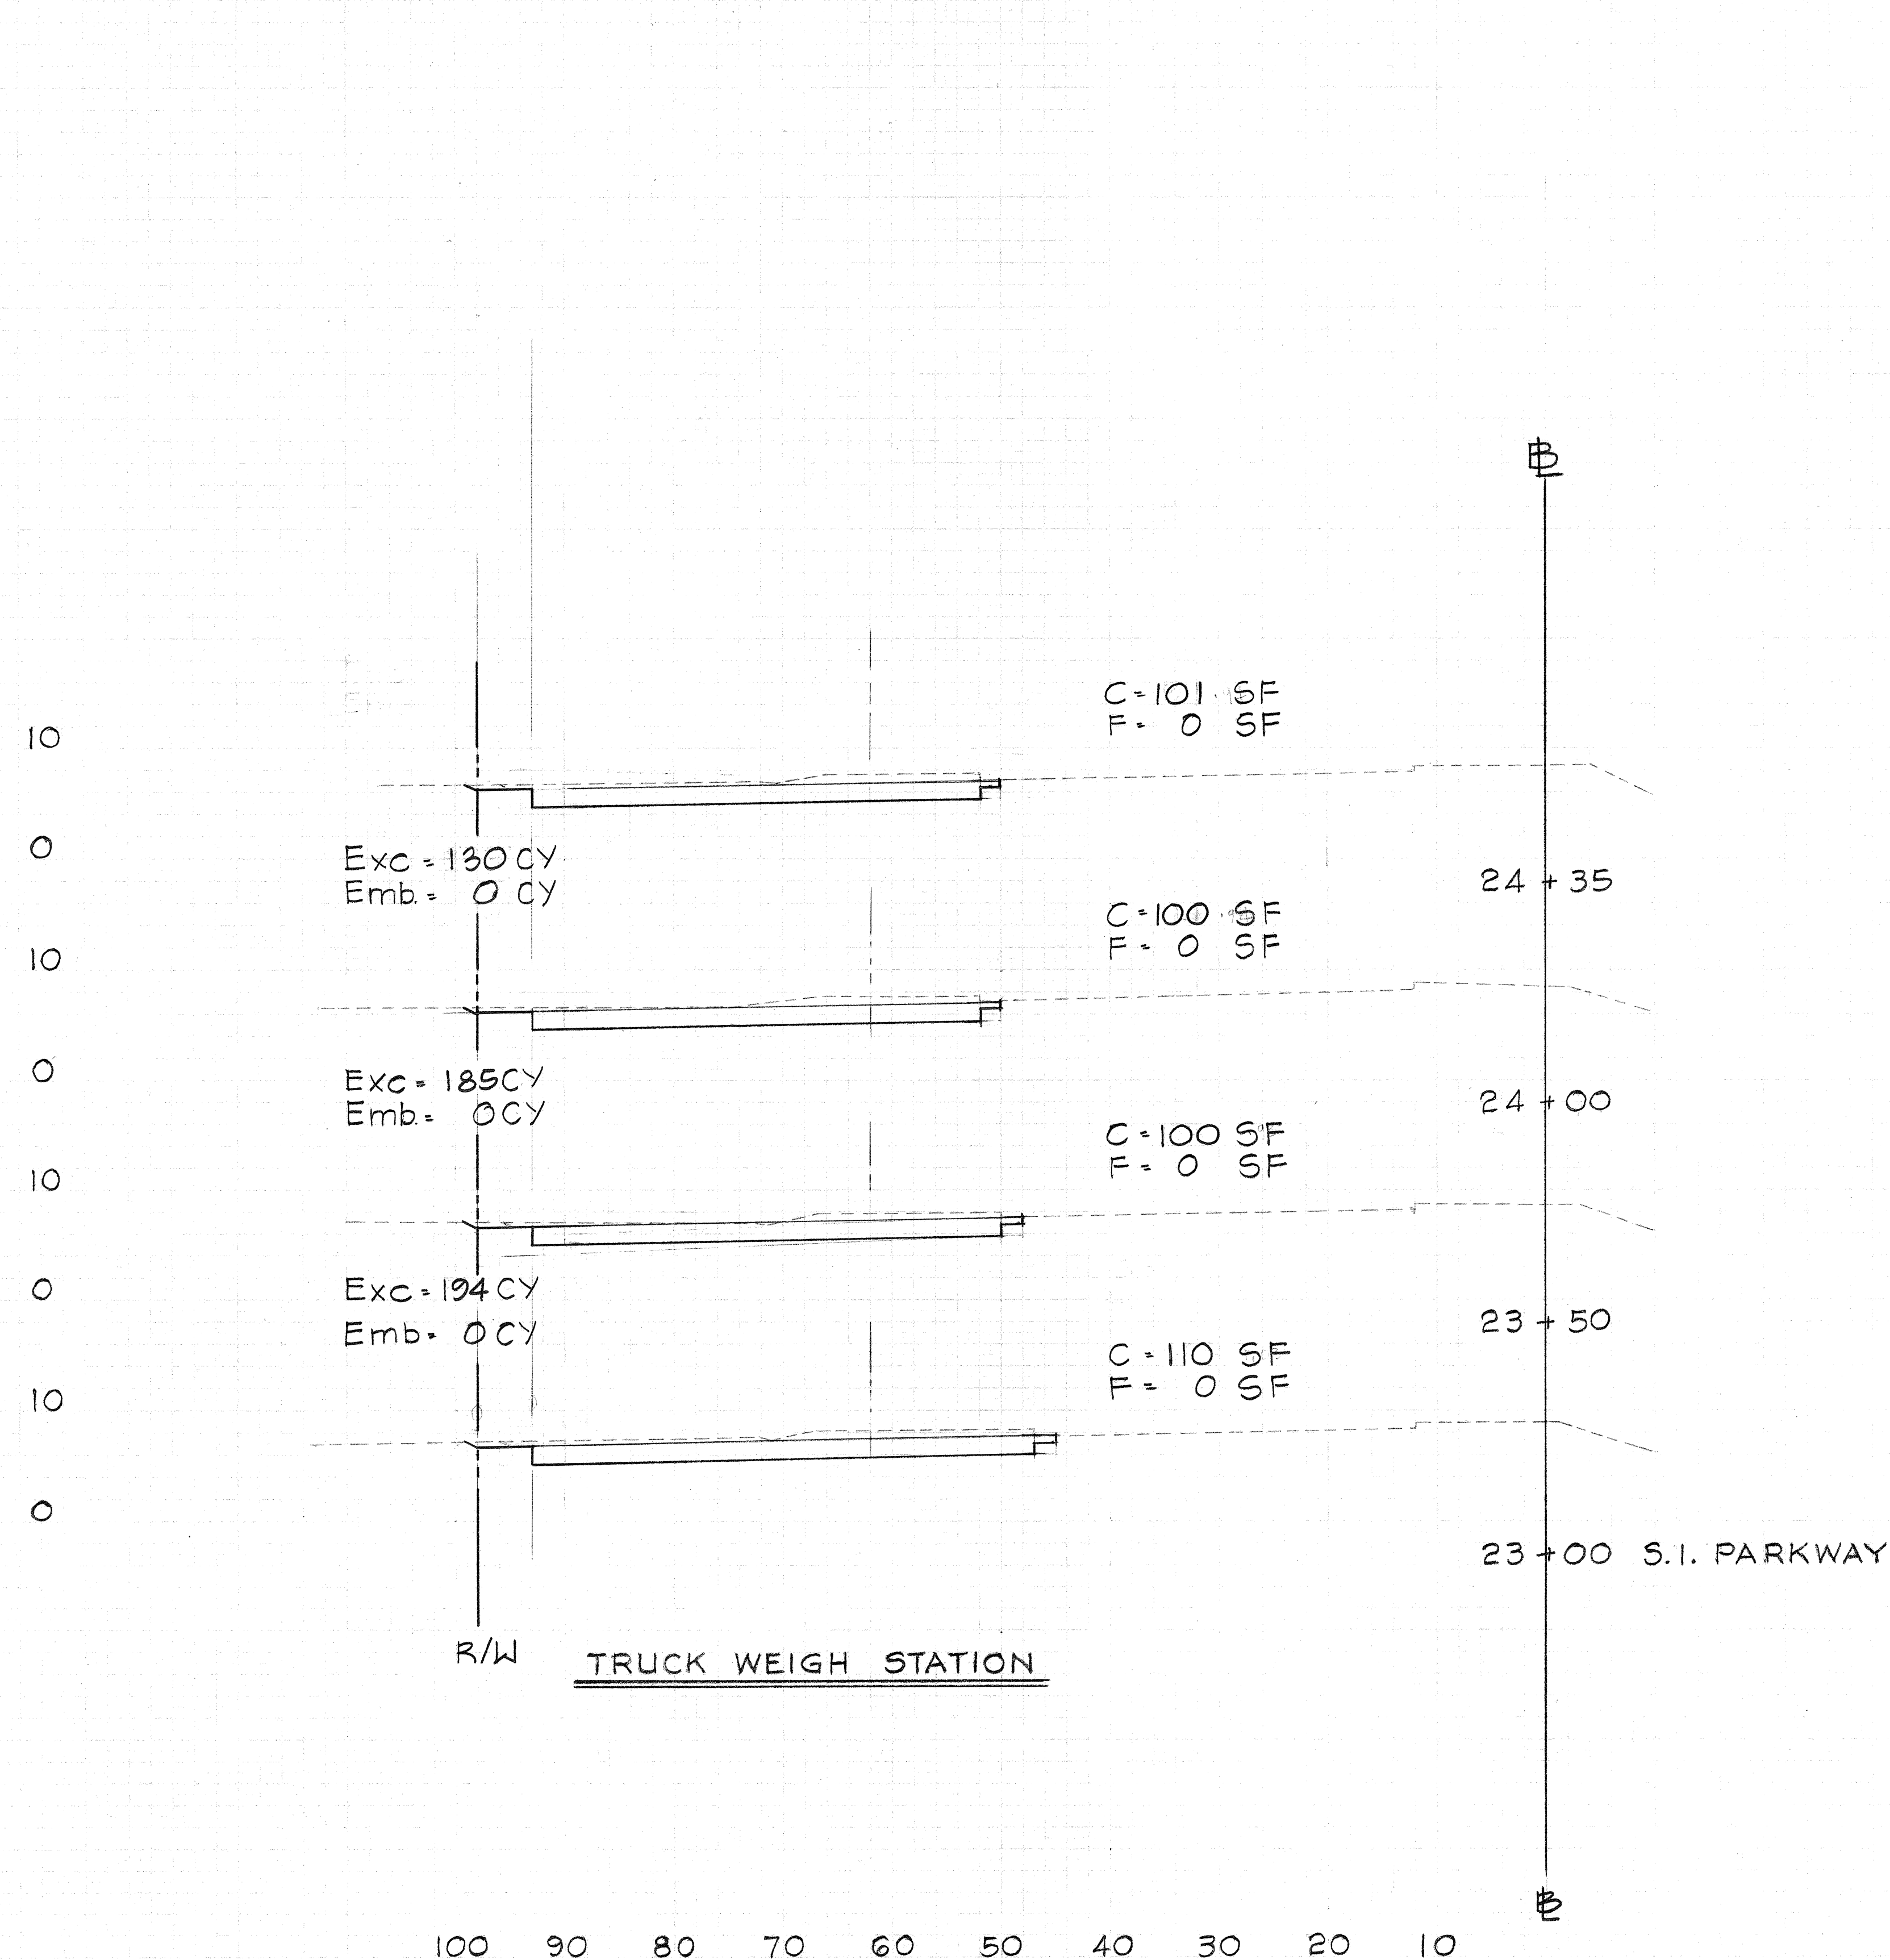

Approved for Grading Only

Chief, Division of Engineering

Date