

FED. ROAD DIST. NO.	STATE	FED. AID PROJ. NO.	FISCAL YEAR	SHEET NO.	TOTAL SHEETS
HAWAII	HAW.	F-064-1(2)	1987	11	151

Begin Project
 @ Sta. 35+00
 Provide Smooth Riding Connection. Match Exist. Pavt.
 6317.221 N
 6726.579 W
 "U.S.E. North Base" Δ

STA. 35+00 - 41+04

@ Sta. 35+00 to Sta. 35+50
 @ Sta. 38+15 to Sta. 38+95
 Construct Grade Adjustment Wall Type "B"
 @ Sta. 35+50 to Sta. 38+15
 @ Sta. 38+95 to Sta. 41+04
 Construct Grade Adjustment Wall Type "A" "B"


@ Sta. 41+21.47
 S.I. Access Road:
 Sta. 0+00 Road No. 2
 Install St. Monument
 See State Standard Detail

@ Sta. 41+40 to Sta. 45+00
 Construct Grade Adjustment Wall Type "C"

Pullover
 For Detail, See
 Sht. H 13


@ Sta. 46+50 to Sta. 48+00.27
 Install Type 2G Thru Gutter
 See Sht. H 21

@ Sta. 43+25 to Sta. 50+35
 Construct Grade Adjustment Wall Type "C"

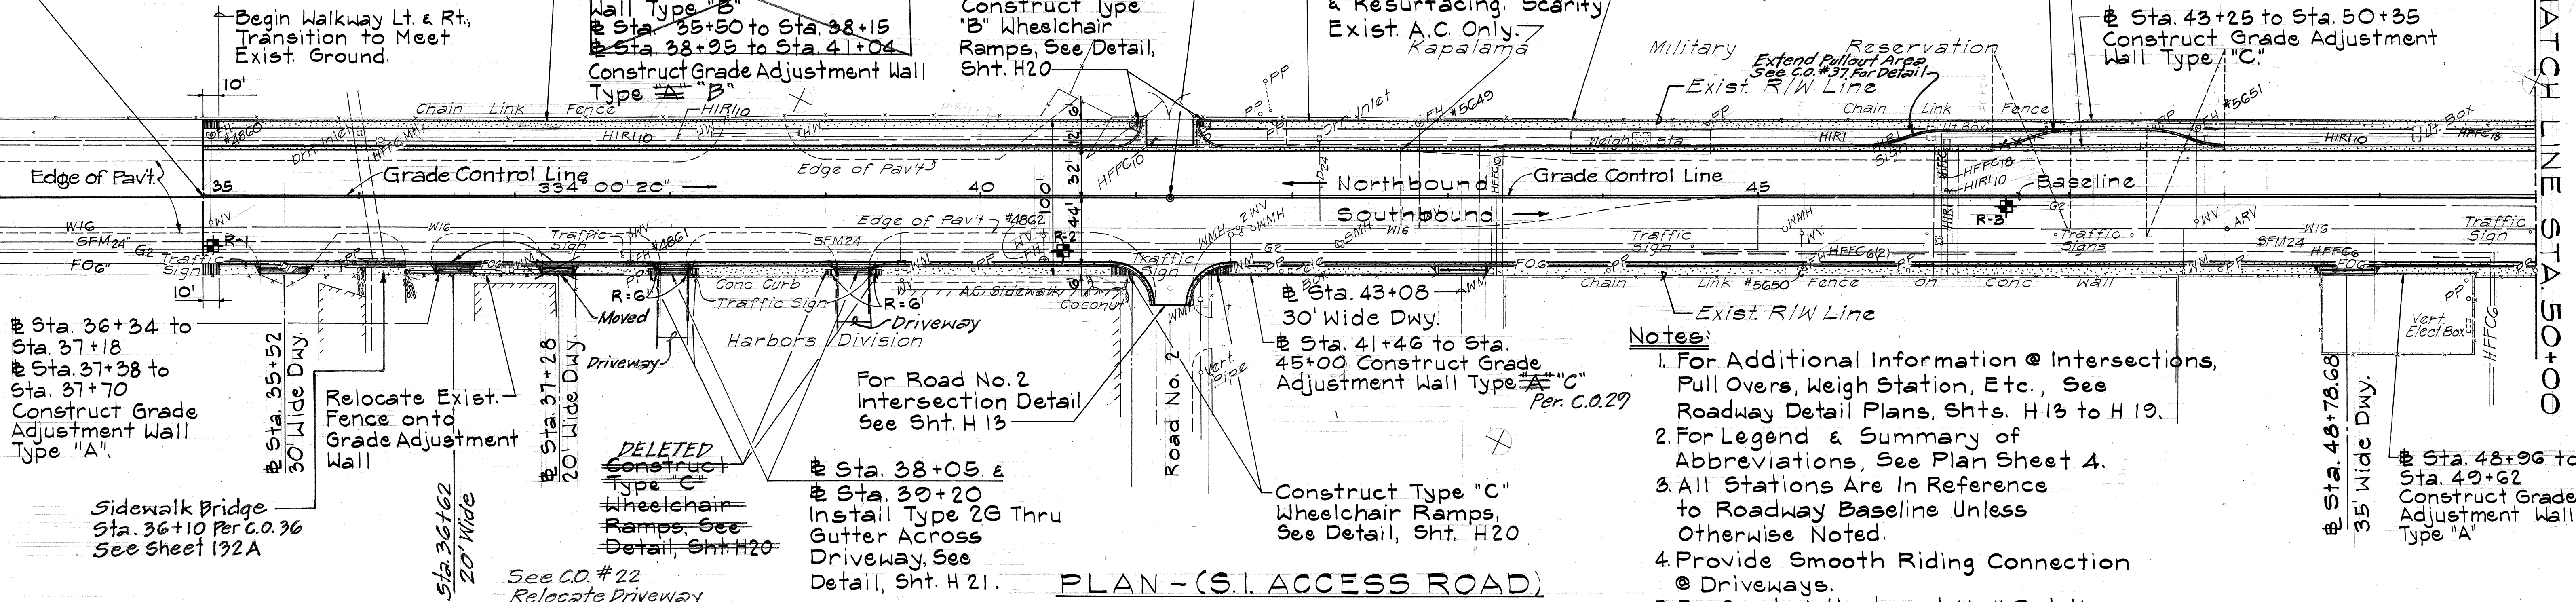


- Notes:
1. For Additional Information @ Intersections, Pull Overs, Weigh Station, Etc., See Roadway Detail Plans, Shts. H 13 to H 19.
 2. For Legend & Summary of Abbreviations, See Plan Sheet 4.
 3. All Stations Are In Reference to Roadway Baseline Unless Otherwise Noted.
 4. Provide Smooth Riding Connection @ Driveways.
 5. For Grade Adjustment Wall Details, See Sht. H 21.

PLAN - (S.I. ACCESS ROAD)

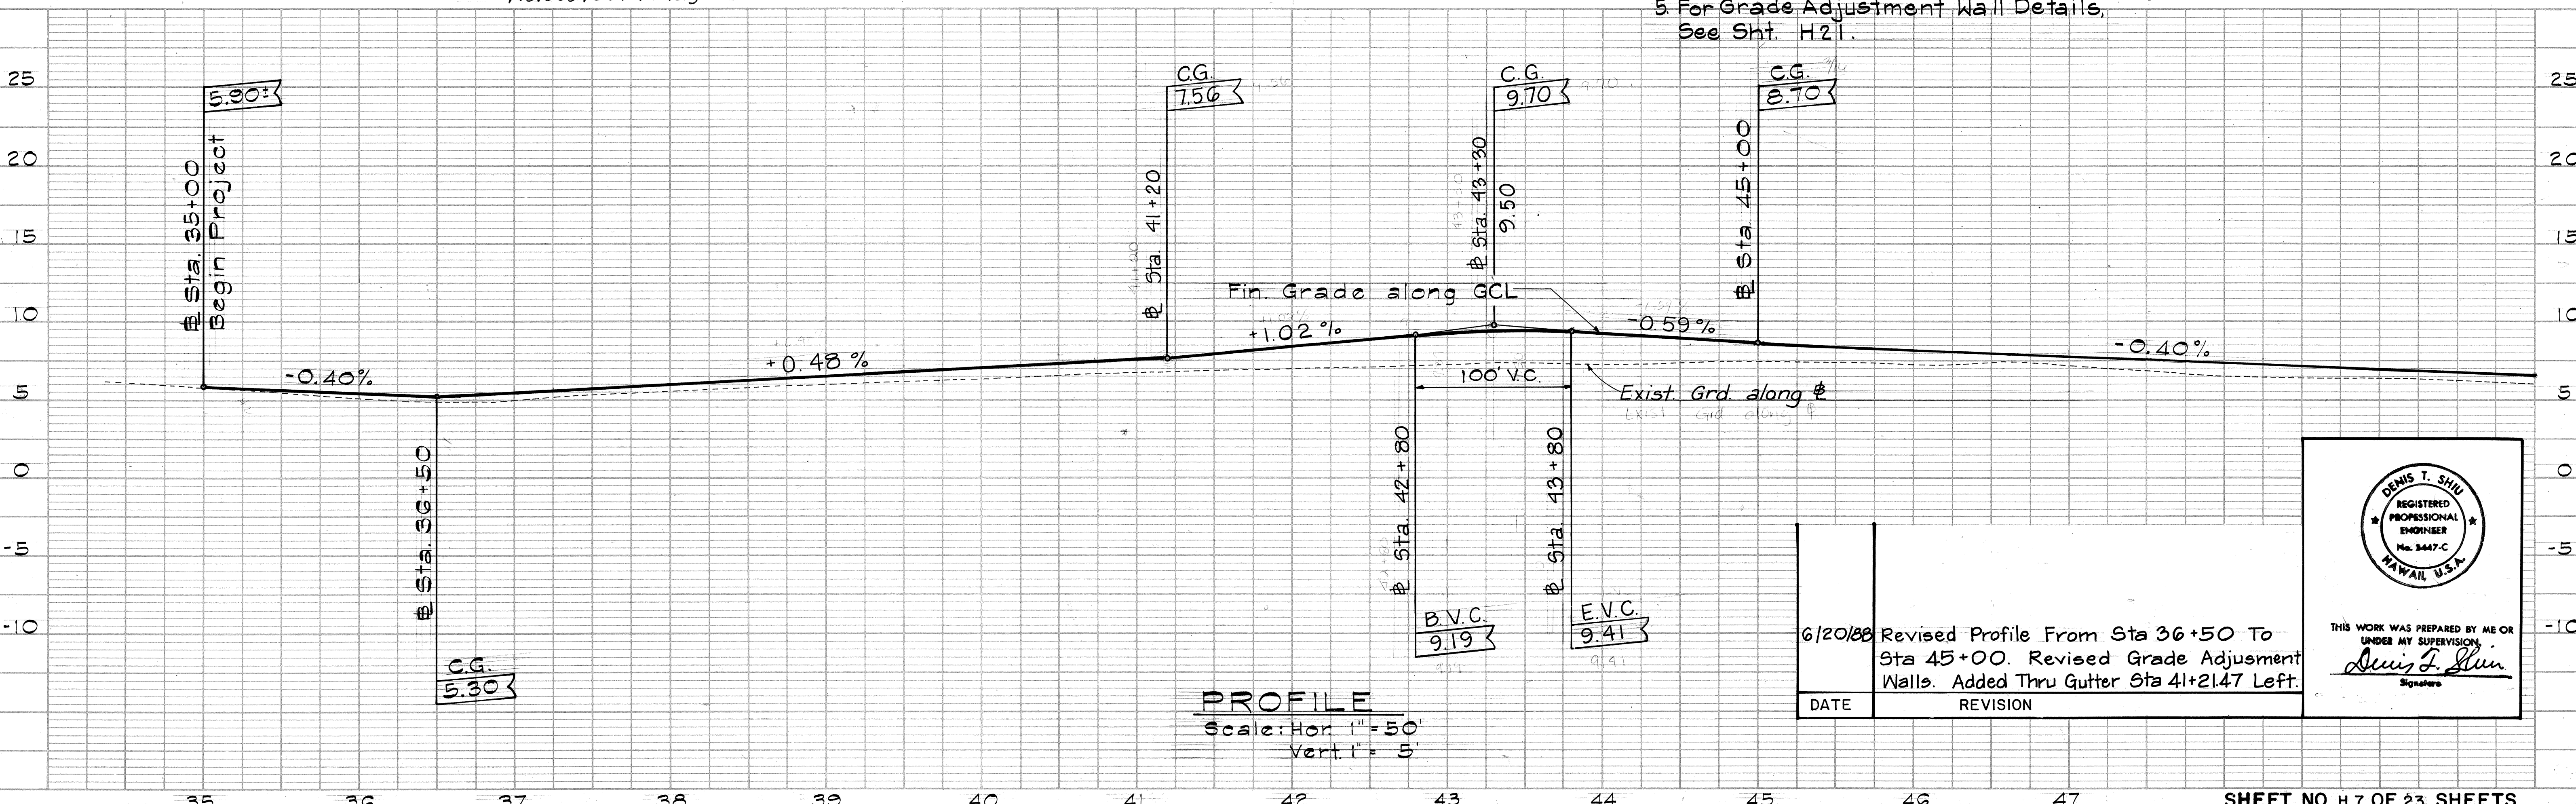

PROFILE
 Scale: Hor 1" = 50'
 Vert 1" = 5'

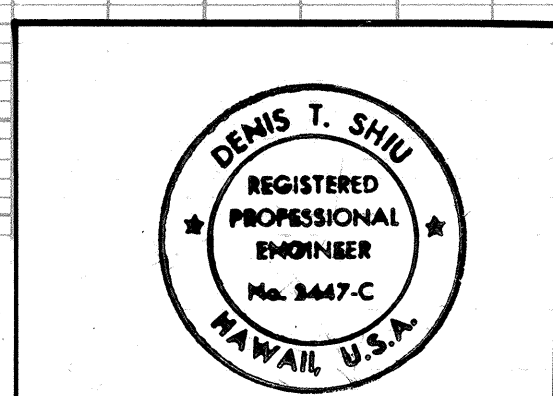


6/20/88 Revised Profile From Sta 36+50 To Sta 45+00. Revised Grade Adjustment Walls. Added Thru Gutter Sta 41+21.47 Left.


THIS WORK WAS PREPARED BY ME OR UNDER MY SUPERVISION
 Denis T. Shiu
 Signature

FED. ROAD DIST. NO.	STATE	FED. AID PROJ. NO.	FISCAL YEAR	SHEET NO.	TOTAL SHEETS
HAWAII	HAW.	F-064-1(2)	1987	14	151

CURVE DATA			
	⑥	⑦	⑧
Δ	80°16'00"	80°16'00"	9°25'09"
Δ/2	40°08'00"	40°08'00"	4°42'34.5"
R	564.44'	617.44'	170.53'
T	475.86'	520.55'	14.70'
C	727.64'	705.06'	20.48'
LC	790.73'	864.08'	20.51'

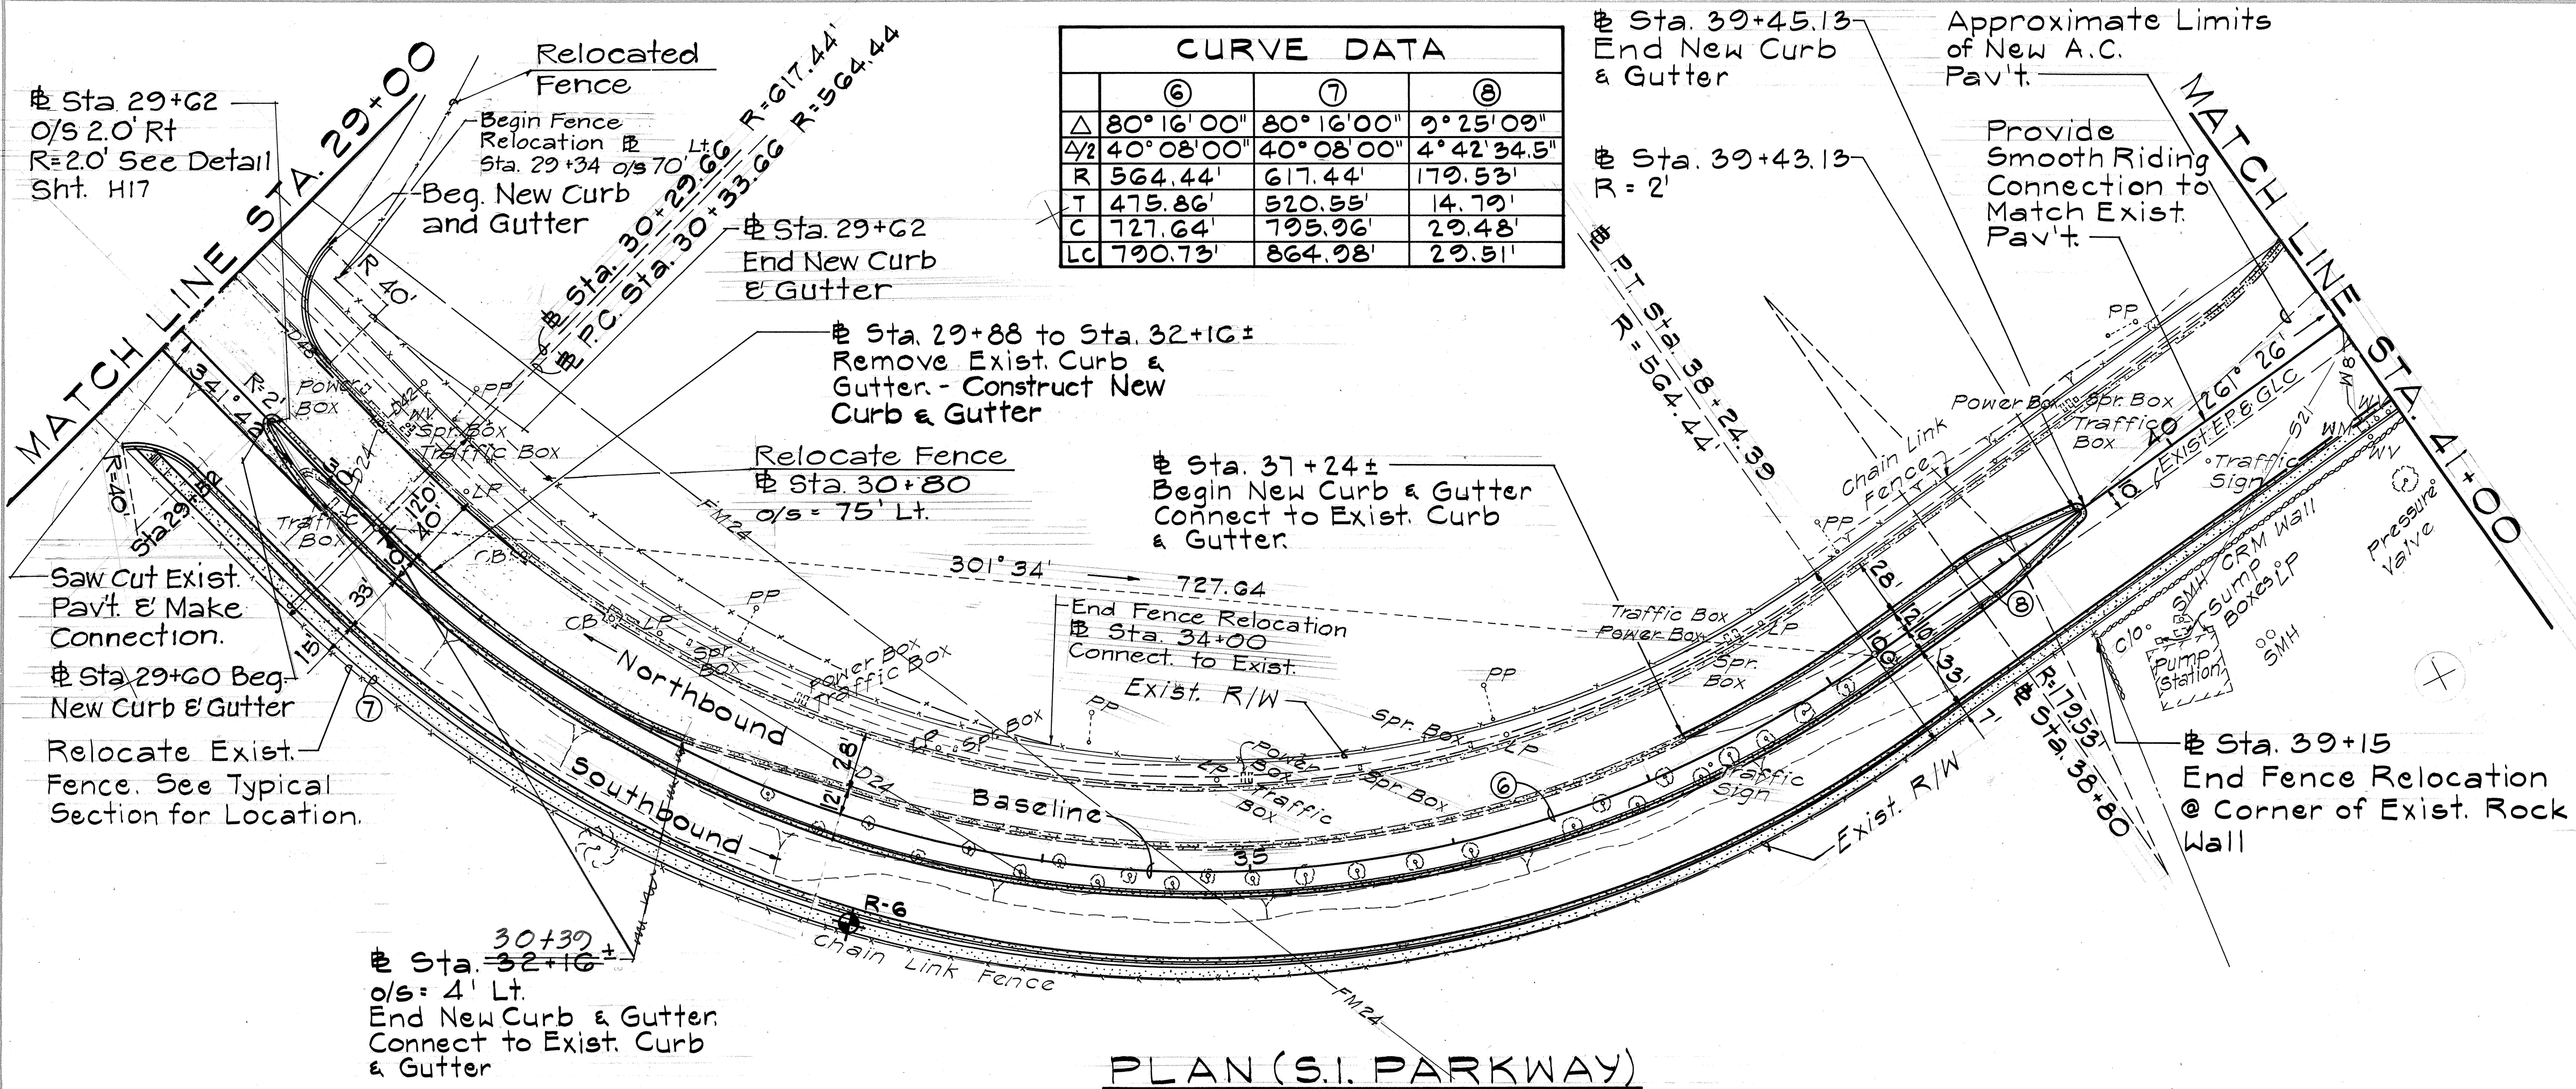


- Note:
1. Remove all Existing Trees with Trunks Less Than 18" From the Face of the Curb and Relocate to Center of Median. (Sta. 32+00± to Sta. 39+00.)
 2. All Stations are in Reference to the Roadway Baseline Unless Otherwise Noted.
 3. For Location of Grade Control Line, See Typical Roadway Sections.

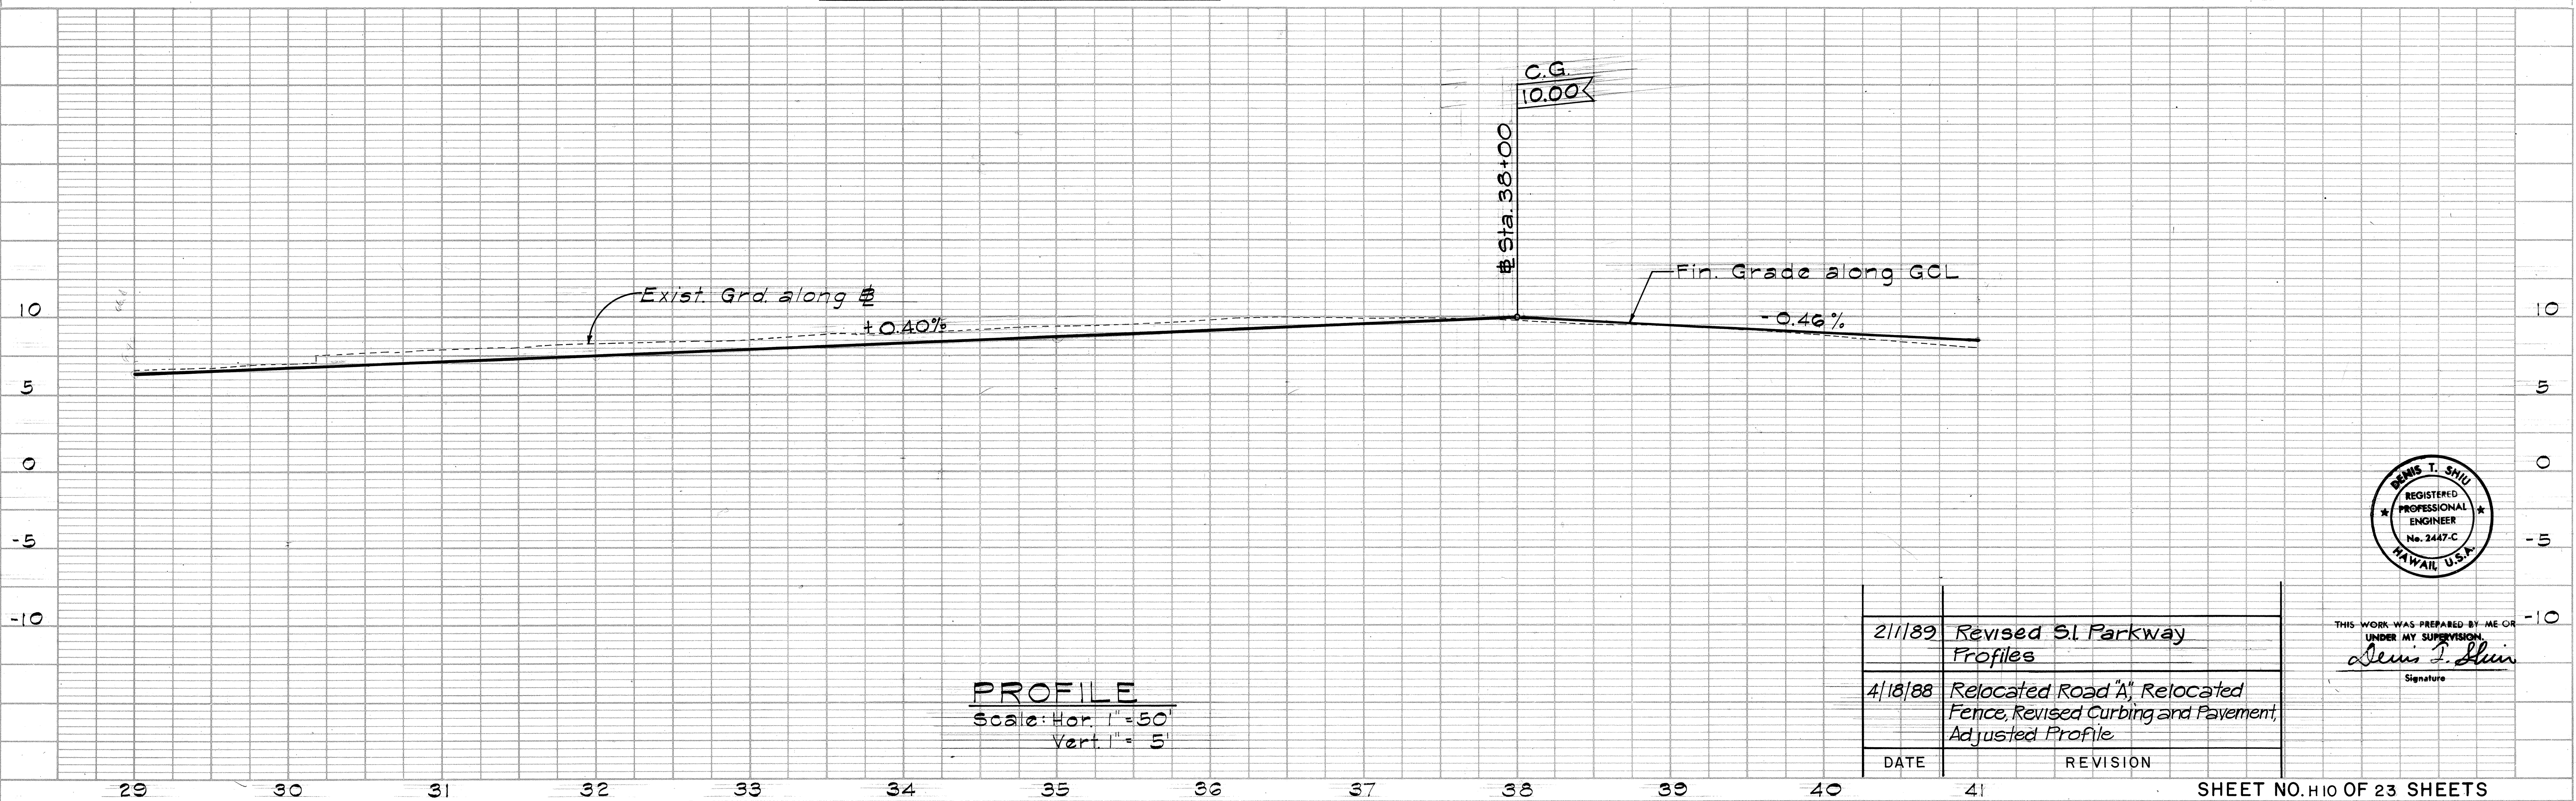

FED. ROAD DIST. NO.	STATE	FED. AID PROJ. NO.	FISCAL YEAR	SHEET NO.	TOTAL SHEETS
HAWAII	HAW.	F-064-1(2)	1987	15	151



PLAN	DATE	BY	DATE	BY	DATE
SURVEYED					
PLOTTED					
CHECKED					
NO. OF WAY CREED.					
NO.					

PROFILE	DATE	BY	DATE	BY	DATE
SURVEYED					
PLOTTED					
CHECKED					
NO. OF WAY CREED.					
NO.					

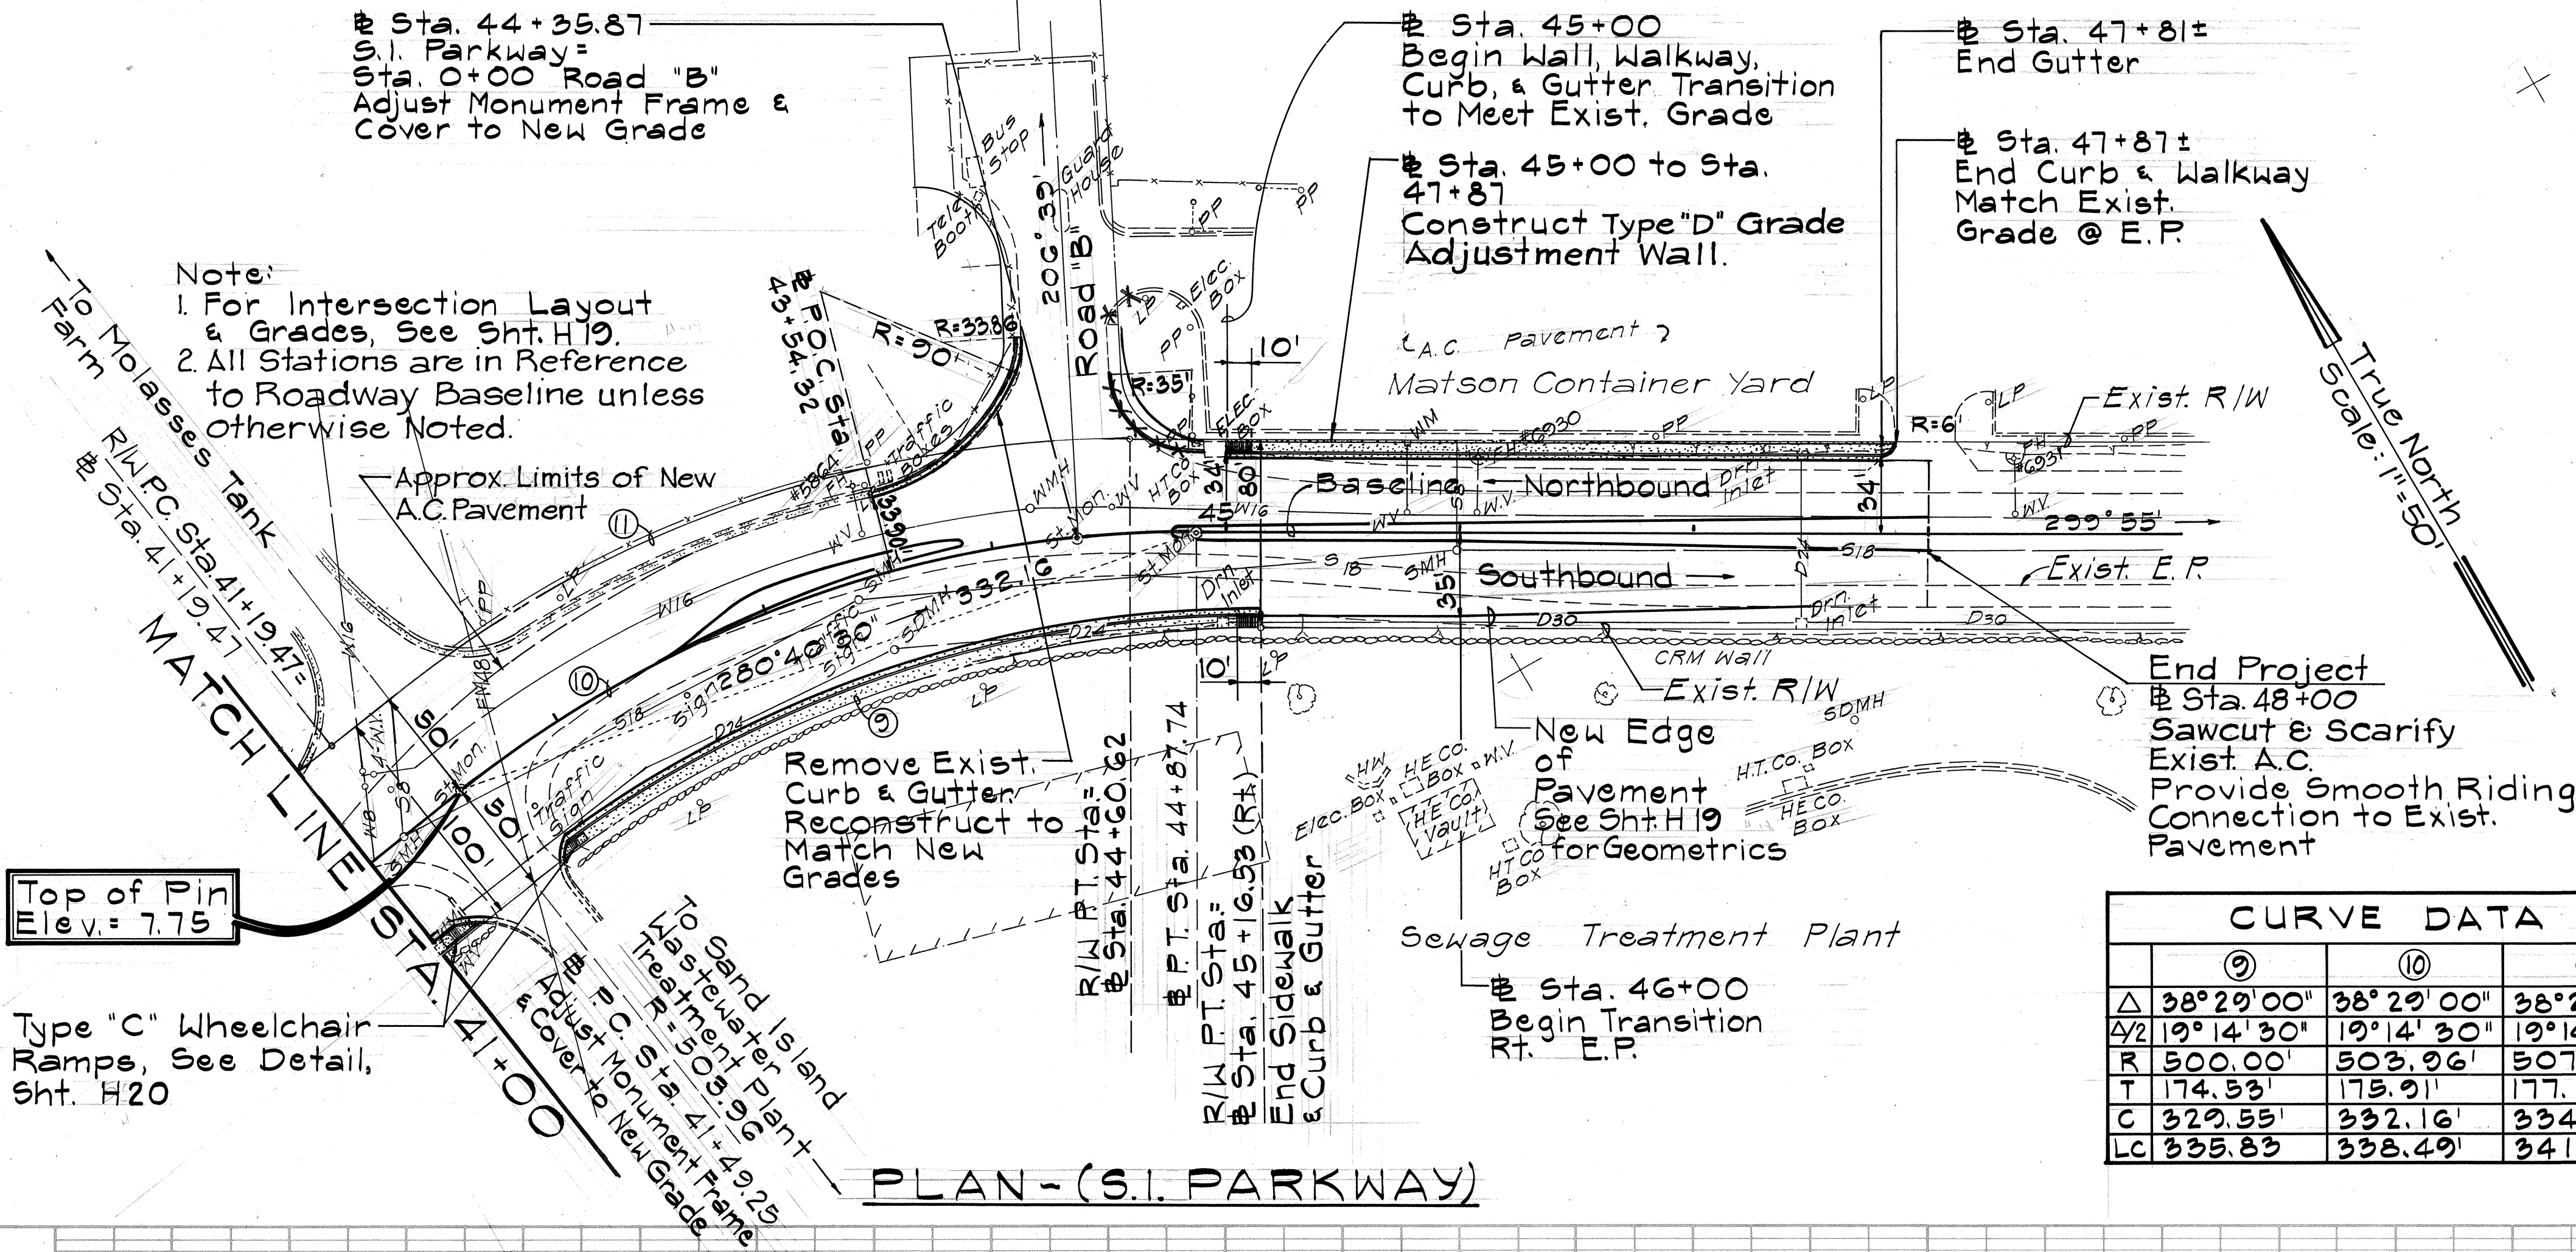

	⑨	⑩	⑪
Δ	38°29'00"	38°29'00"	38°29'00"
Δ/2	19°14'30"	19°14'30"	19°14'30"
R	300.00'	303.26'	307.22'
T	174.33'	175.21'	177.29'
C	329.55'	332.16'	334.77'
Lc	335.83'	338.49'	341.15'

Note:
For Location of Grade Control Line, See Typical Roadway Sections.

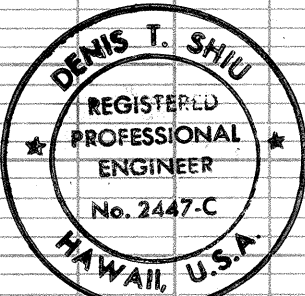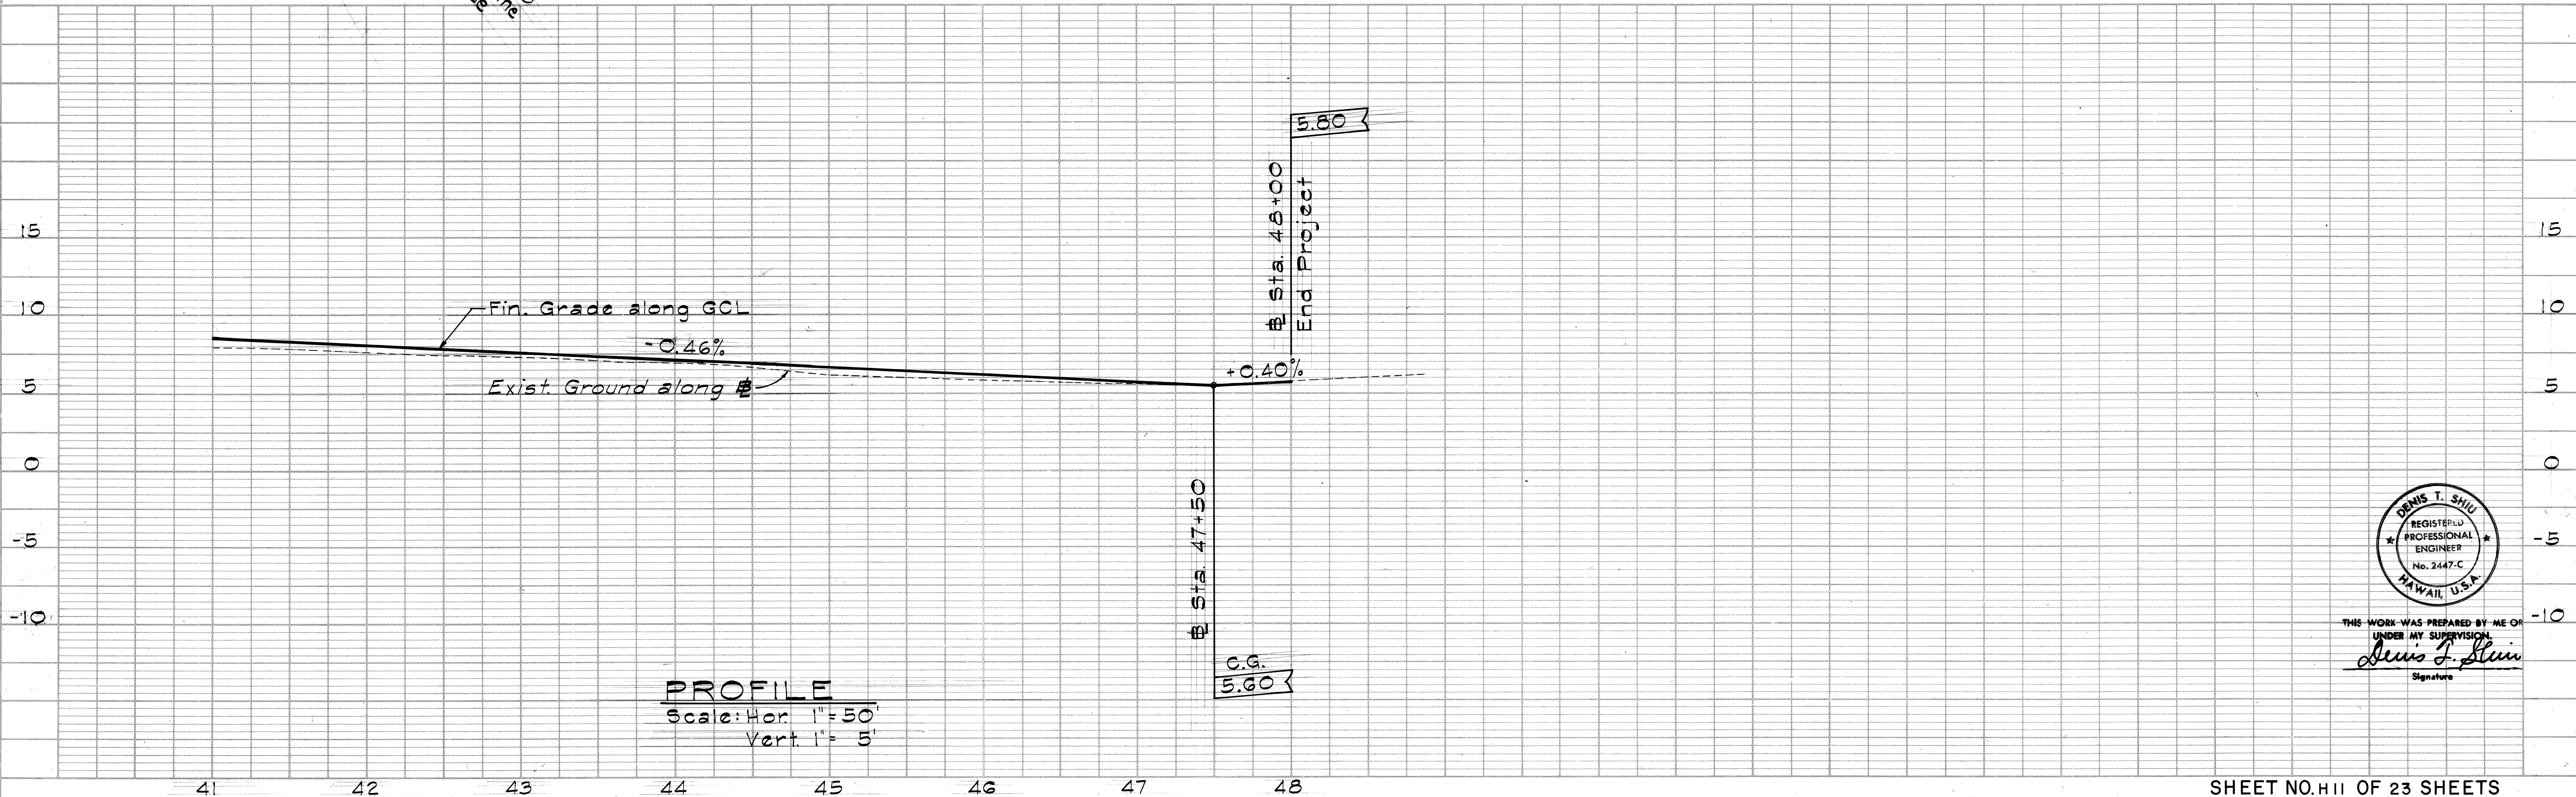

THIS WORK WAS PREPARED BY ME OR UNDER MY SUPERVISION
Dennis T. Shiu
Signature