


FED. ROAD DIST. NO.	STATE	PROJ. NO.	FISCAL YEAR	SHEET NO.	TOTAL SHEETS
HAWAII	HAW.	64A-01-87M	1987	5	15

True North
Scale: 1" = 20'

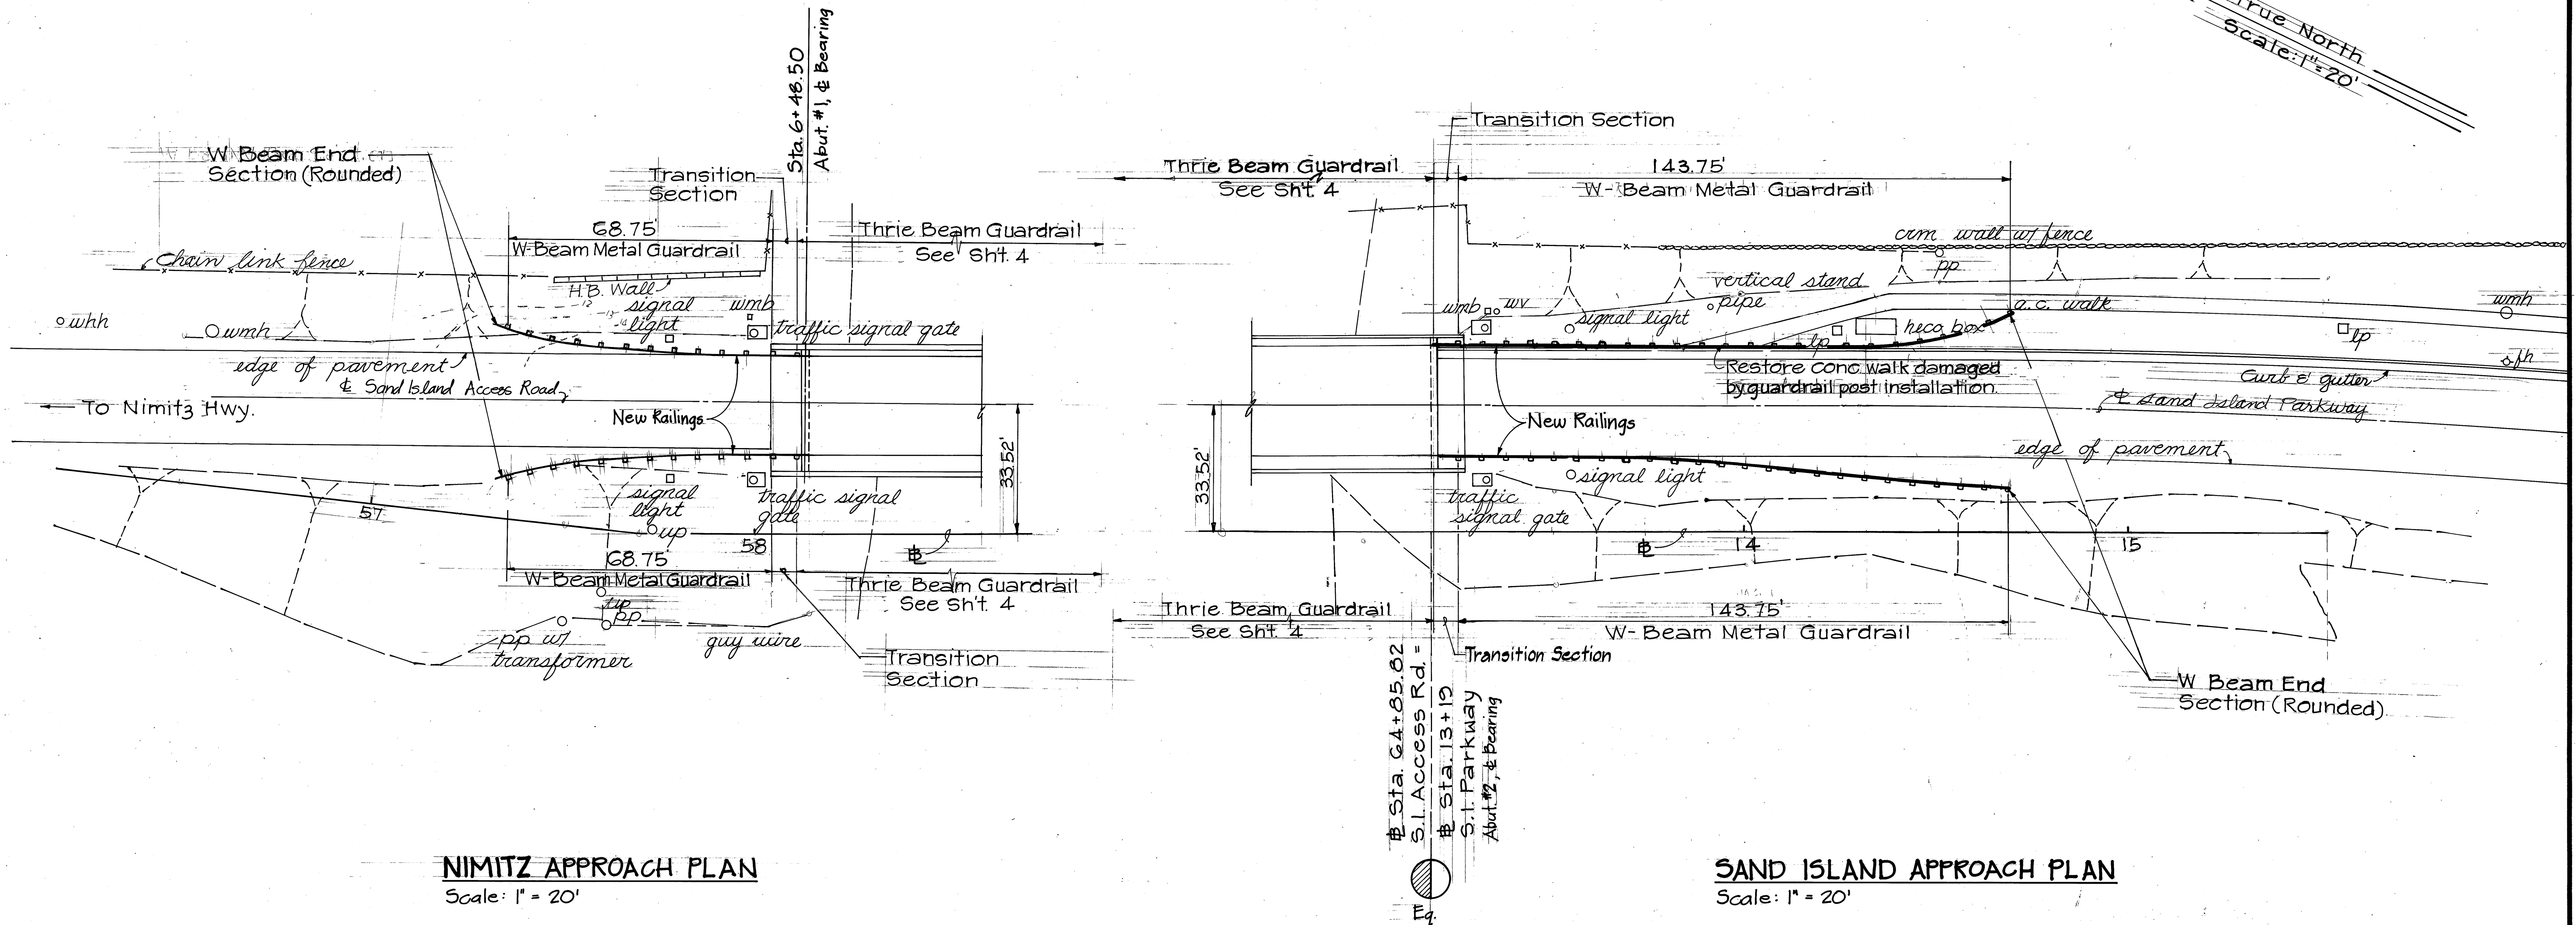

ORIGINAL	SURVEY PLOTTED BY	DATE
PLAN	DRAWN BY	
NOTE BOOK	DESIGNED BY	
	CHECKED BY	

WAYNE S. NAKASHIMA
REGISTERED PROFESSIONAL ENGINEER
No. 4542-S
HAWAII, U.S.A.

THIS WORK WAS PREPARED BY ME OR UNDER MY SUPERVISION

Wayne S. Nakashima

DATE	REVISION
STATE OF HAWAII DEPARTMENT OF TRANSPORTATION HIGHWAYS DIVISION	
BRIDGE APPROACH PLANS	
SAND ISLAND ACCESS ROAD SAND ISLAND BASCULE BRIDGE REHABILITATION PROJECT NO. 64A-01-87M	
SCALE: AS NOTED.	DATE: MAR. 31, 1987
SHEET NO. 1 OF 1 SHEETS	