



FED. ROAD DIST. NO.	STATE	PROJ. NO.	FISCAL YEAR	SHEET NO.	TOTAL SHEETS
HAWAII	HAW.	64A-01-87M	1987	4	15

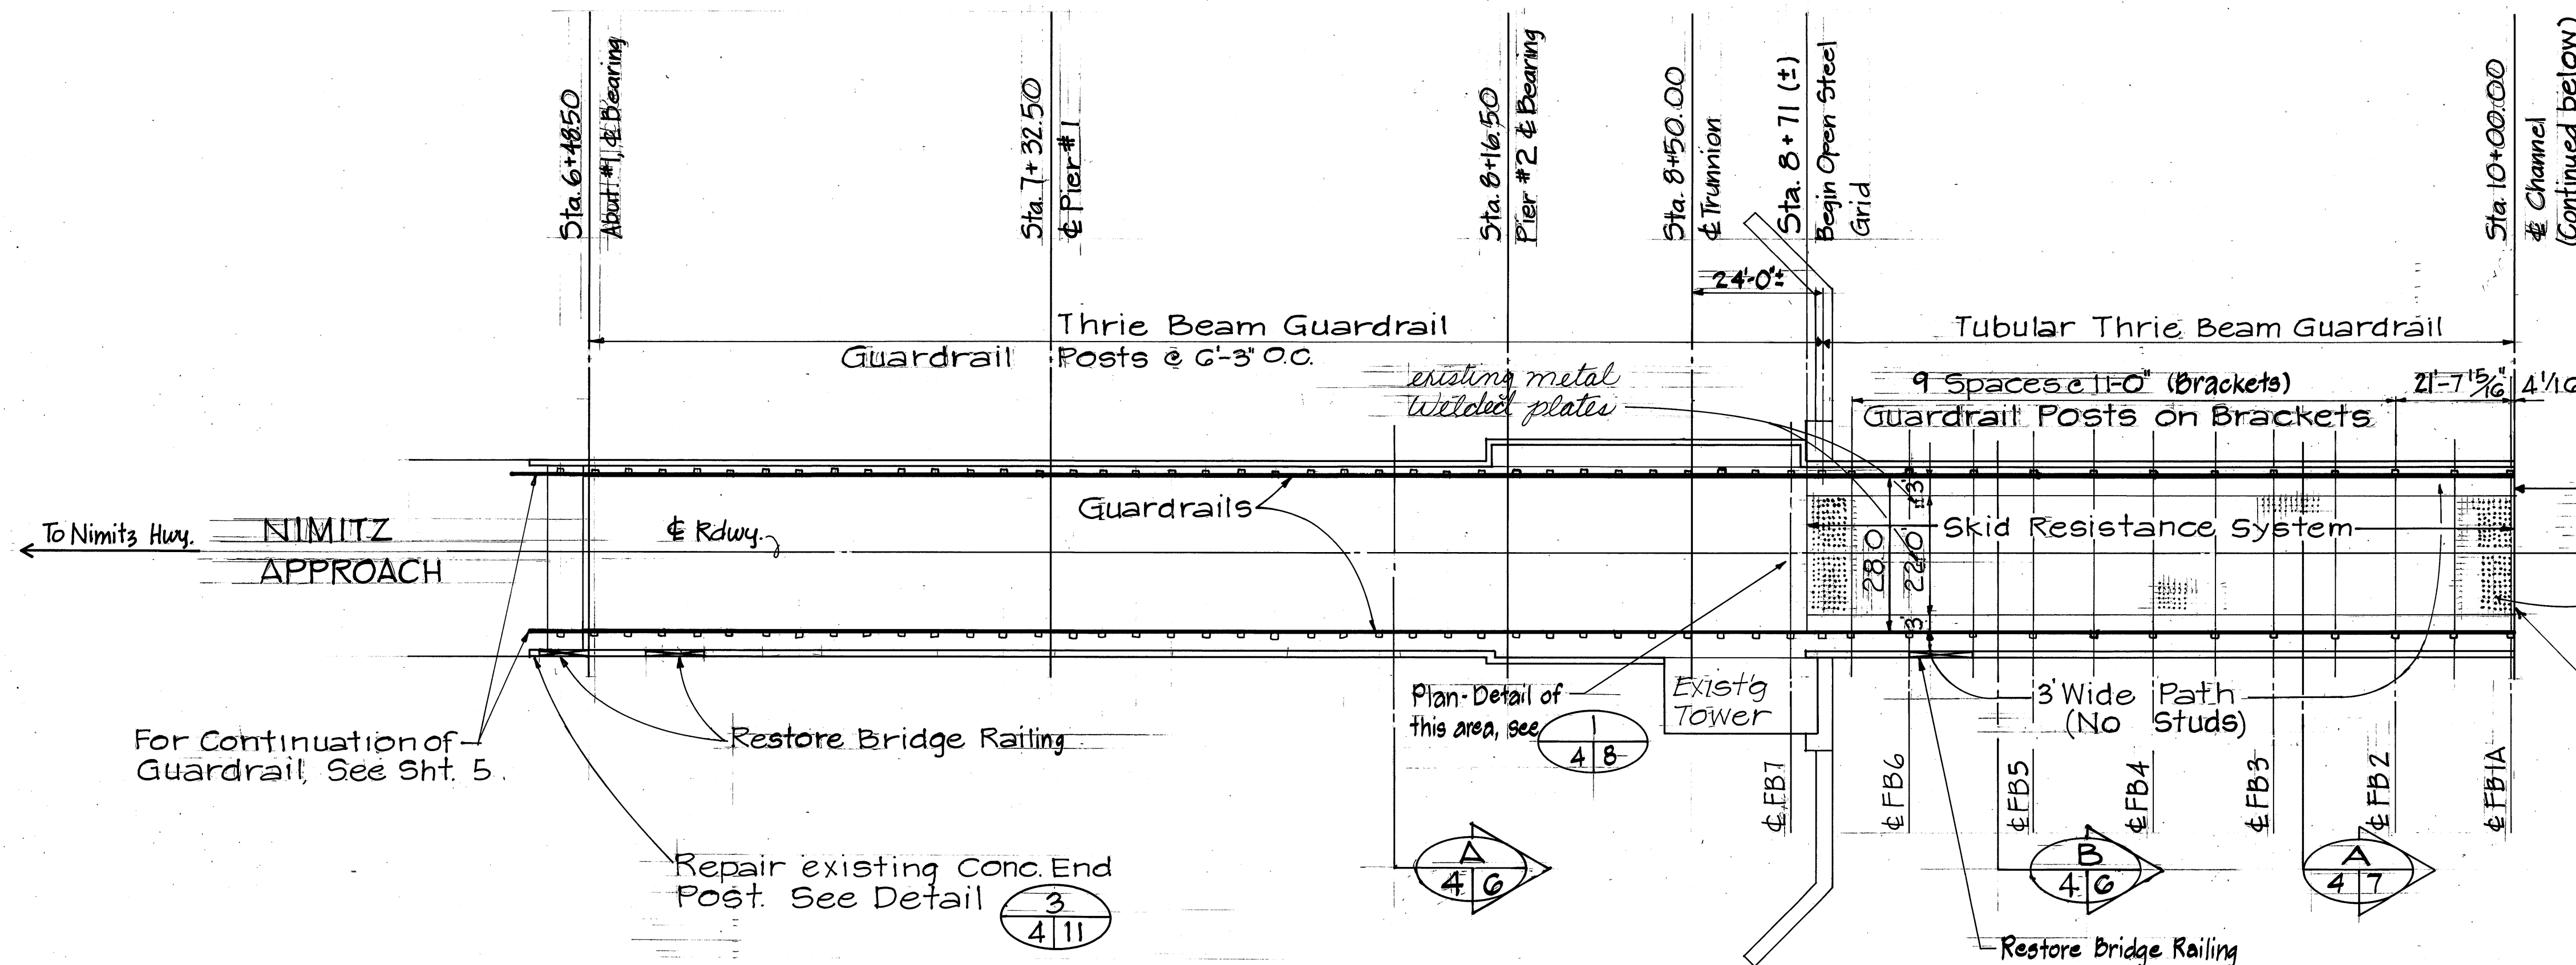


General Notes:

- The Contractor shall verify and check all dimensions and details shown on the drawings prior to commencing the construction work. Any discrepancy shall be immediately brought to the attention of the Engineer for clarification.
- All structural steel shall conform to ASTM A36 and shall be hot-dipped galvanized unless noted otherwise.

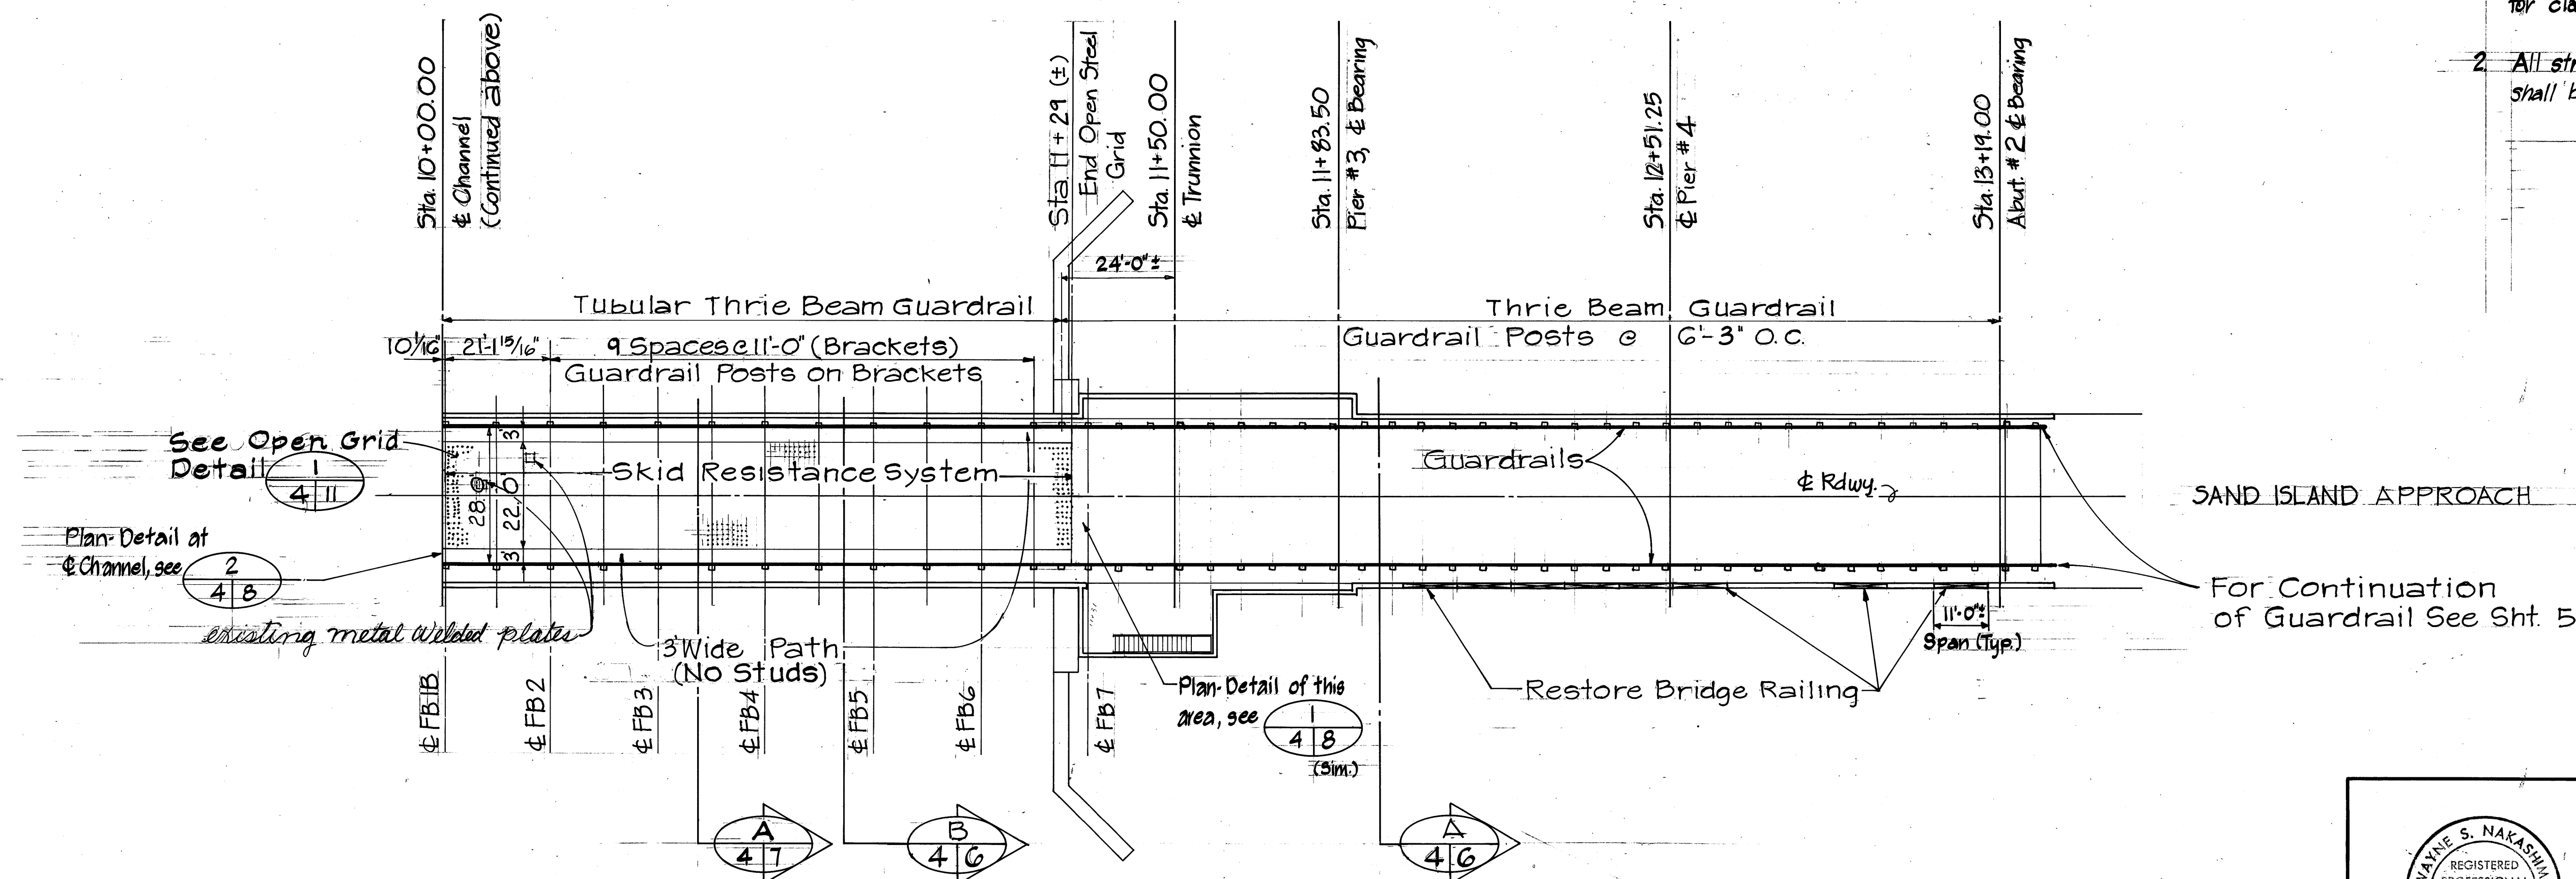

PLAN
Scale: 1" = 20'

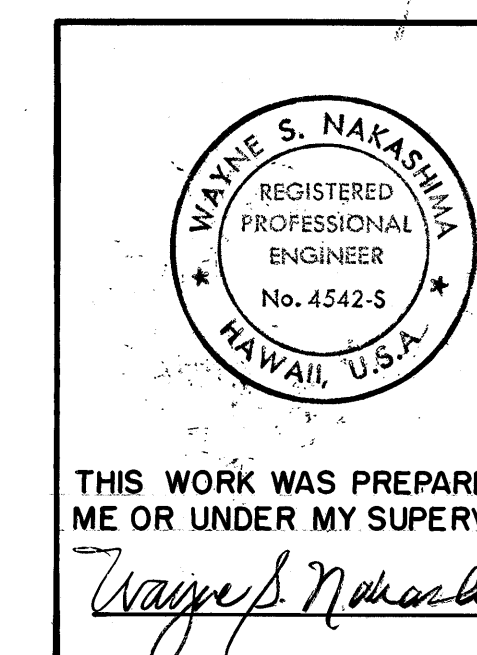

THIS WORK WAS PREPARED BY
ME OR UNDER MY SUPERVISION

Wayne S. Nakashima

DATE	REVISION
STATE OF HAWAII DEPARTMENT OF TRANSPORTATION HIGHWAYS DIVISION BRIDGE PLAN SAND ISLAND ACCESS ROAD SAND ISLAND BASCULE BRIDGE REHABILITATION PROJECT NO. 64A-01-87M SCALE: AS NOTED DATE: MAR. 31, 1987 SHEET NO. 1 OF 1 SHEETS	