



FED. ROAD DIST. NO.	STATE	PROJ. NO.	FISCAL YEAR	SHEET NO.	TOTAL SHEETS
HAWAII	HAW.	64A-01-87M	1987	6	15

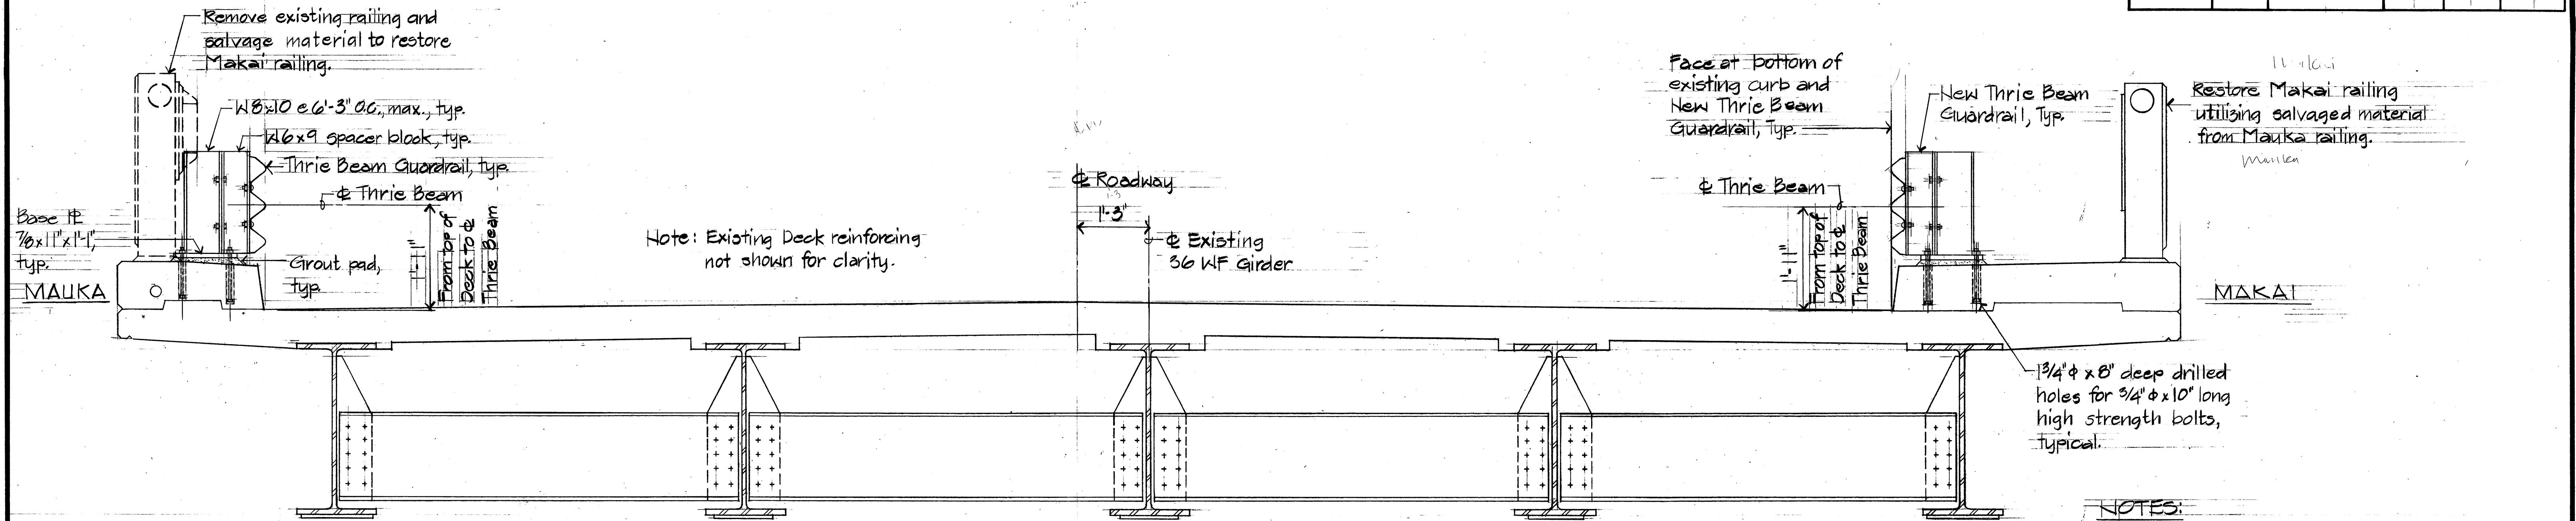

SECTION A
Scale: 3/4" = 1'-0"

- NOTES:
1. Thrie Beam Guardrail Details, see Sheet 7.
 2. Tubular Thrie Beam Guardrail Details, see Sheet 7.
 3. For Tubular Thrie Beam Guardrail Lap Splice Details, see Sheet 9.

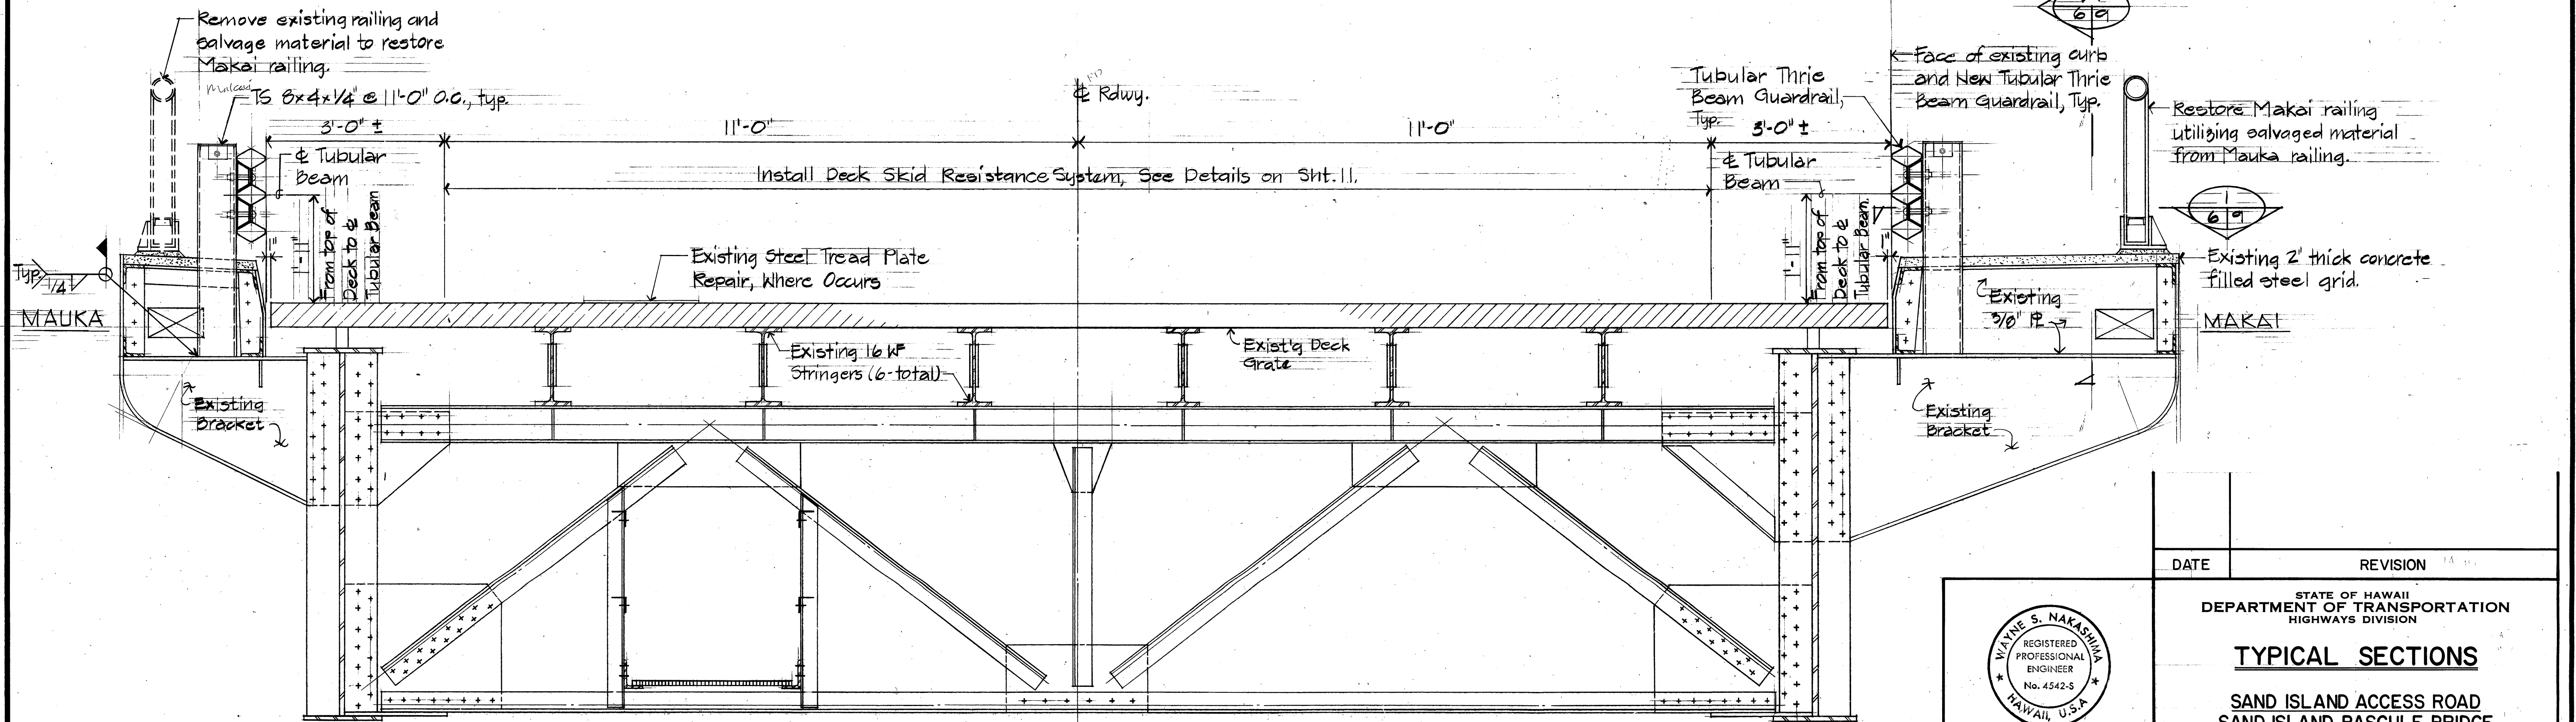

SECTION B (CONDITION AT FLOOR BEAMS)
Scale: 3/4" = 1'-0"

DATE	REVISION
STATE OF HAWAII DEPARTMENT OF TRANSPORTATION HIGHWAYS DIVISION	
TYPICAL SECTIONS	
SAND ISLAND ACCESS ROAD SAND ISLAND BASCULE BRIDGE REHABILITATION PROJECT NO. 64A-01-87M	
SCALE: AS NOTED	DATE: MAR. 31, 1987
SHEET NO. 1 OF 1 SHEETS	

WAYNE S. NAKASHIMA
REGISTERED
PROFESSIONAL
ENGINEER
No. 4542-S
HAWAII, U.S.A.

THIS WORK WAS PREPARED BY
ME OR UNDER MY SUPERVISION

Wayne S. Nakashima