	INDEX TO DRAWINGS
SHEET NO.	DESCRIPTION
1	TITLE SHEET
2	STANDARD PLANS SUMMARY
3	PAVEMENT MARKING LEGEND, DETAILS & NOTES
4	TRAFFIC SIGNAL LEGEND, DETAILS & NOTES
5 – 6	TRAFFIC SIGNAL PLANS
4	

STATE OF HAWAII

DEPARTMENT OF TRANSPORTATION


HIGHWAYS DIVISION HONOLULU, HAWAII

"AS BUILT"

PLANS FOR


SAND ISLAND ACCESS ROAD TRAFFIC SIGNALS VICINITY OF WEIGH STATION PROJECT NO. 64A-01-92

DISTRICT OF HONOLULU ISLAND OF OAHU

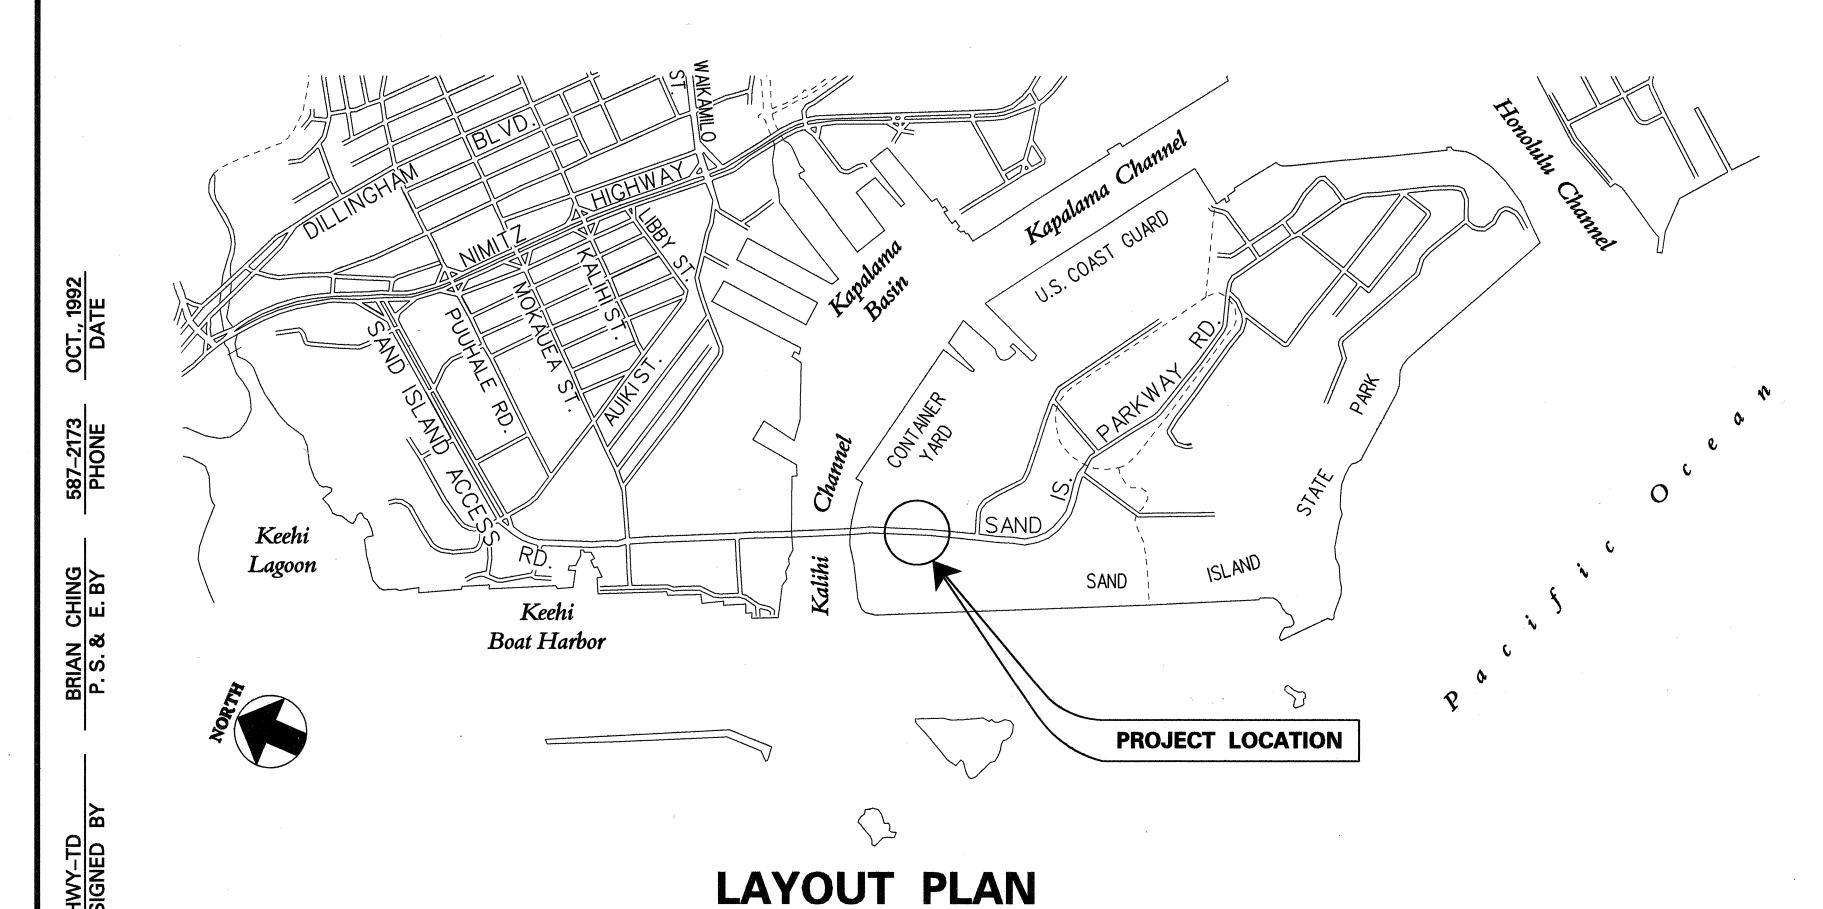

1000 **2000**

GRAFIC SCALE IN FEET

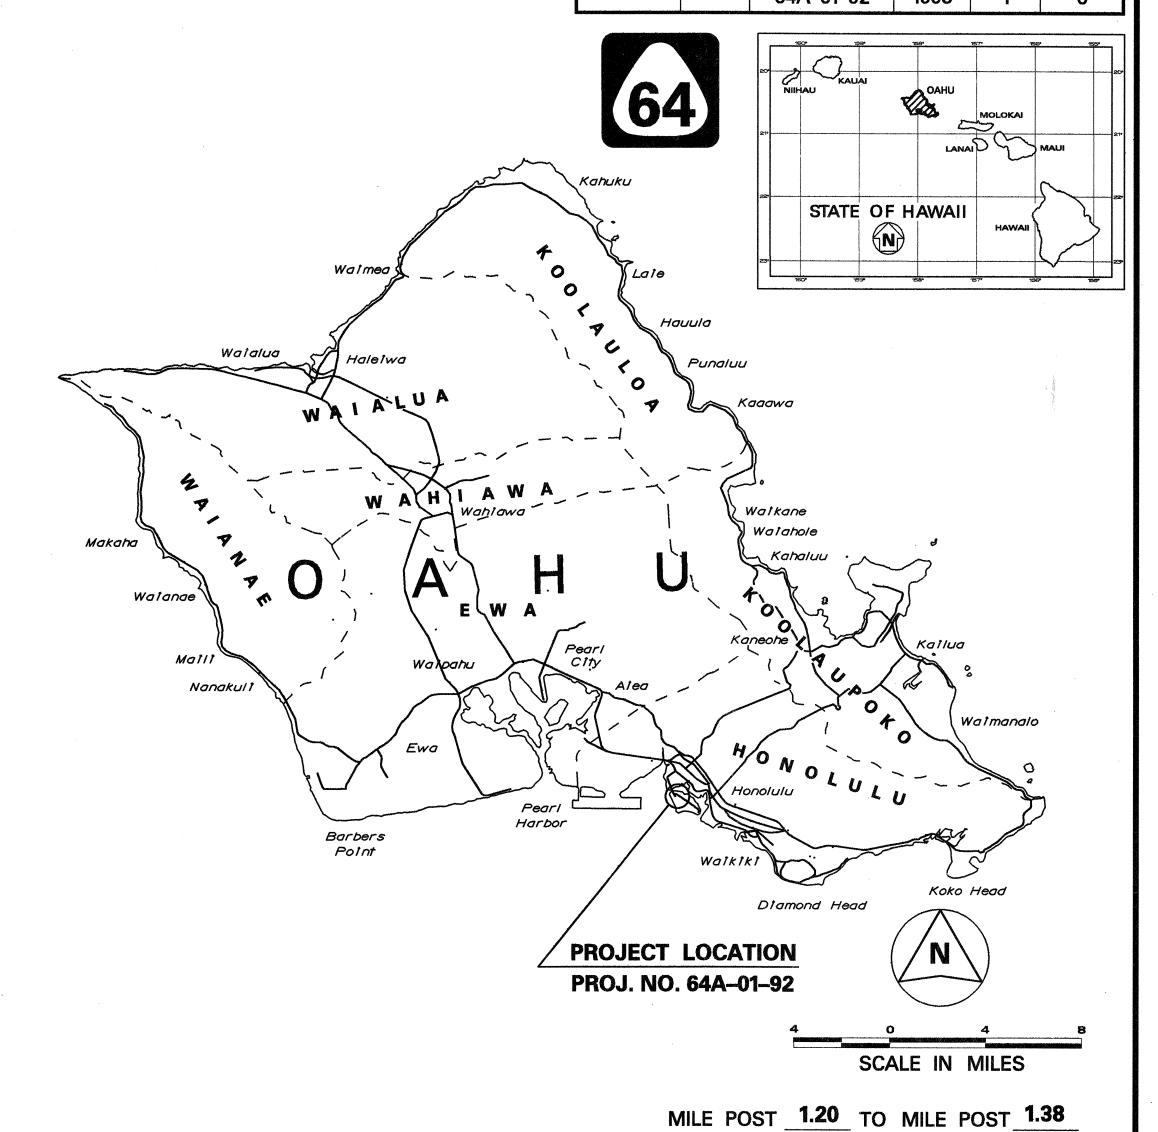

FED. ROAD DIST. NO.

CHANGES MADE DURING CONSTRUCTION HAVE
BEEN INCORPORATED ON THESE PLANS EXCEPT
CHANGES IN THE ORIGINAL THEORETICAL
QUANTITIES. FOR ACTUAL QUANTITIES, REFER TO
PROJECT LEDGER AND/OR COMPUTATION BOOK.

Howard C. U. Young 4/7/93
RESIDENT ENGINEER DATE

	DEPARTMENT OF TRANSPORTATION STATE OF HAWAII		
	APPROVED:		
	Hanns	11/16/97	
For DIR. OF TRANSPORTATION		DATÉ	

7.8-6-9