
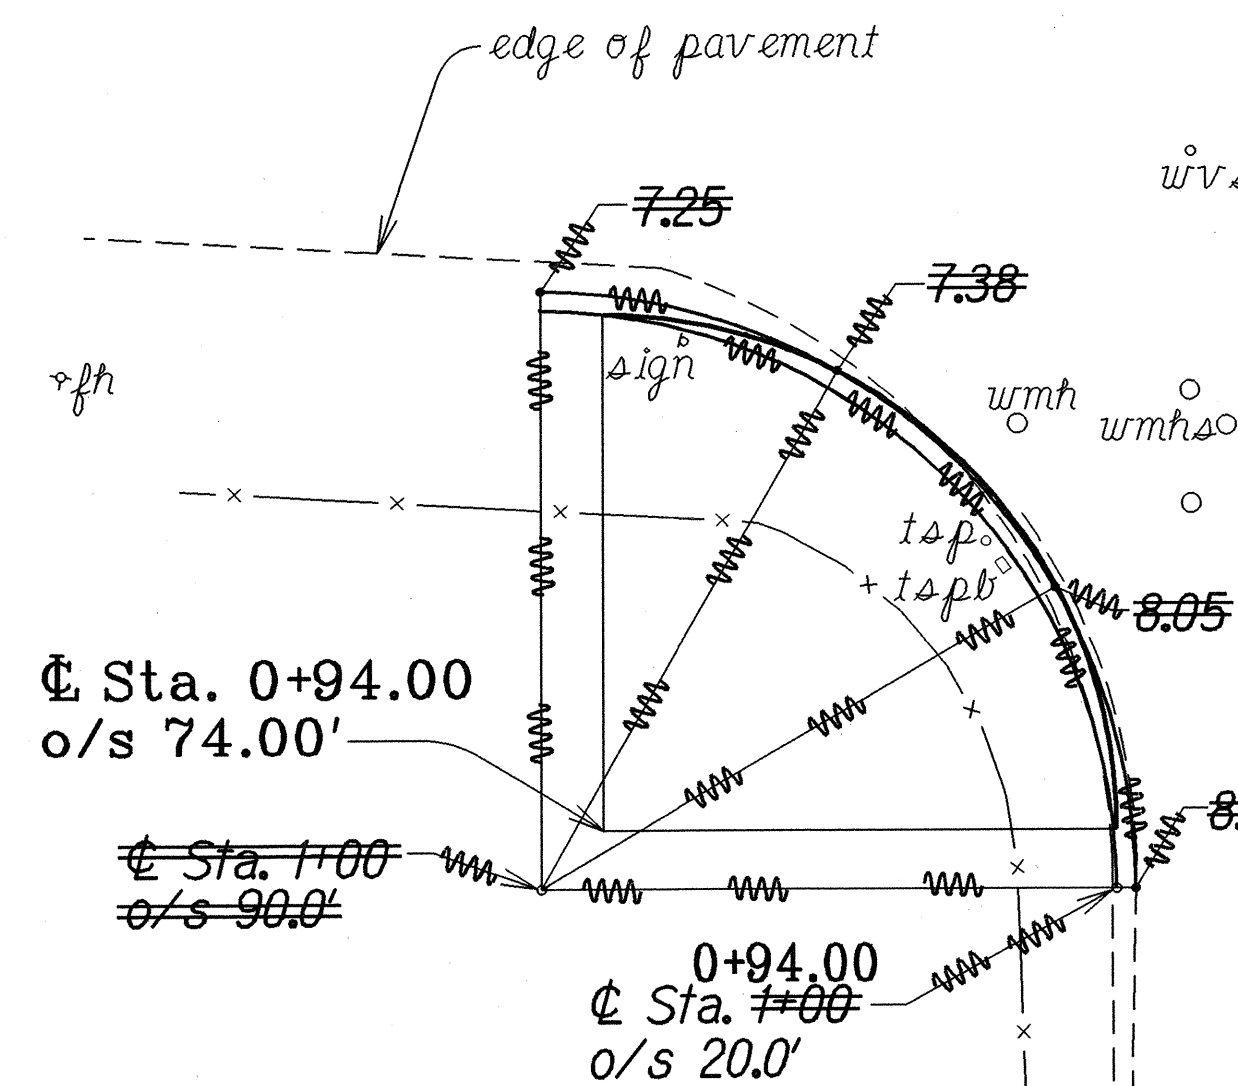


FED. ROAD DIST. NO.	STATE	FED. AID PROJ. NO.	FISCAL YEAR	SHEET NO.	TOTAL SHEETS
HAWAII	HAW.	STP-064-1(6)	1995	14	24

Demolish exist. conc. curb ramps, sidewalk, and curb and gutter and Reconstruct same to clear Bikelane.

Sand Island Access Road
Sta. ~~133+00~~ 132+95.12
Pahounui Street C Sta. 0+00 =
Auikei Street C Sta. 0+00

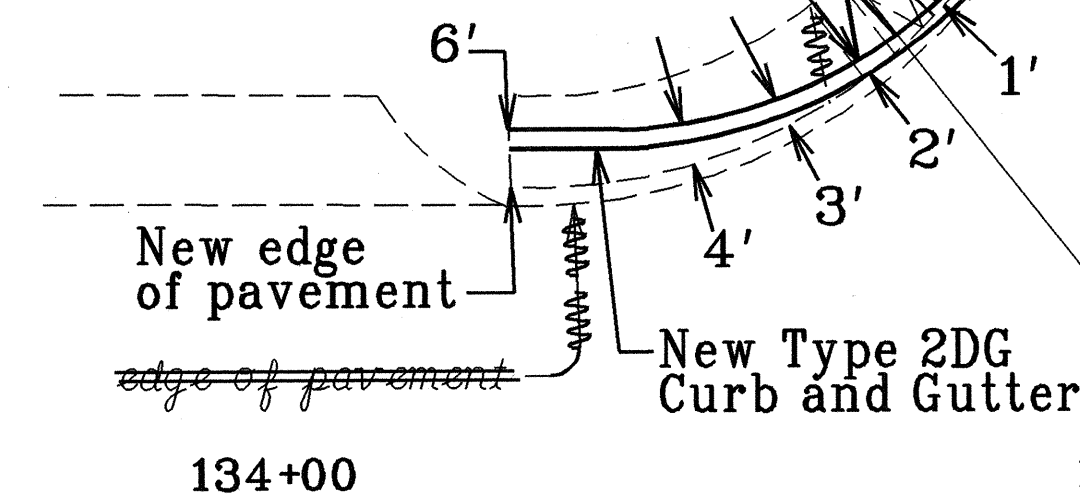

CURB CURVE DATA
 $\Delta = 90^{\circ}00'00''$
 $R = 60.00'$ 53.63'
 $T = 60.00'$ 53.63'
 $C = 84.85'$ 75.84'
 $Lc = 94.25'$ 84.24'

C CURB CURVE DATA
 $\Delta = 75^{\circ}00'00''$ 43° 19' 45"
 $R = 70.00'$ 34.21'
 $T = 53.77'$ 15.16'
 $C = 85.23'$ 27.72'
 $Lc = 91.63'$ 28.54'

D CURB CURVE DATA
 $\Delta = 46^{\circ}40'15''$
 $R = 70.00'$
 $T = 30.198'$
 $C = 55.46'$
 $Lc = 57.019'$

PAHOUNUI STREET AND AUIKEI STREET


Scale: 1" = 20'

LEGEND FOR AS-BUILT POSTINGS

~~~~~ Squiggly line for as-built deletion  
 == Double line for as-built deletion  
 Roadway Text for as-built posting


All revised elevations adjusted in field to slope to drain and tied into existing

**A CURB CURVE DATA**  
 $\Delta = 37^{\circ}00'00''$  33° 44' 04"  
 $R = 52.00'$  58.27'  
 $T = 49.35'$  17.67'  
 $C = 27.91'$  33.82'  
 $Lc = 78.96'$  34.31'

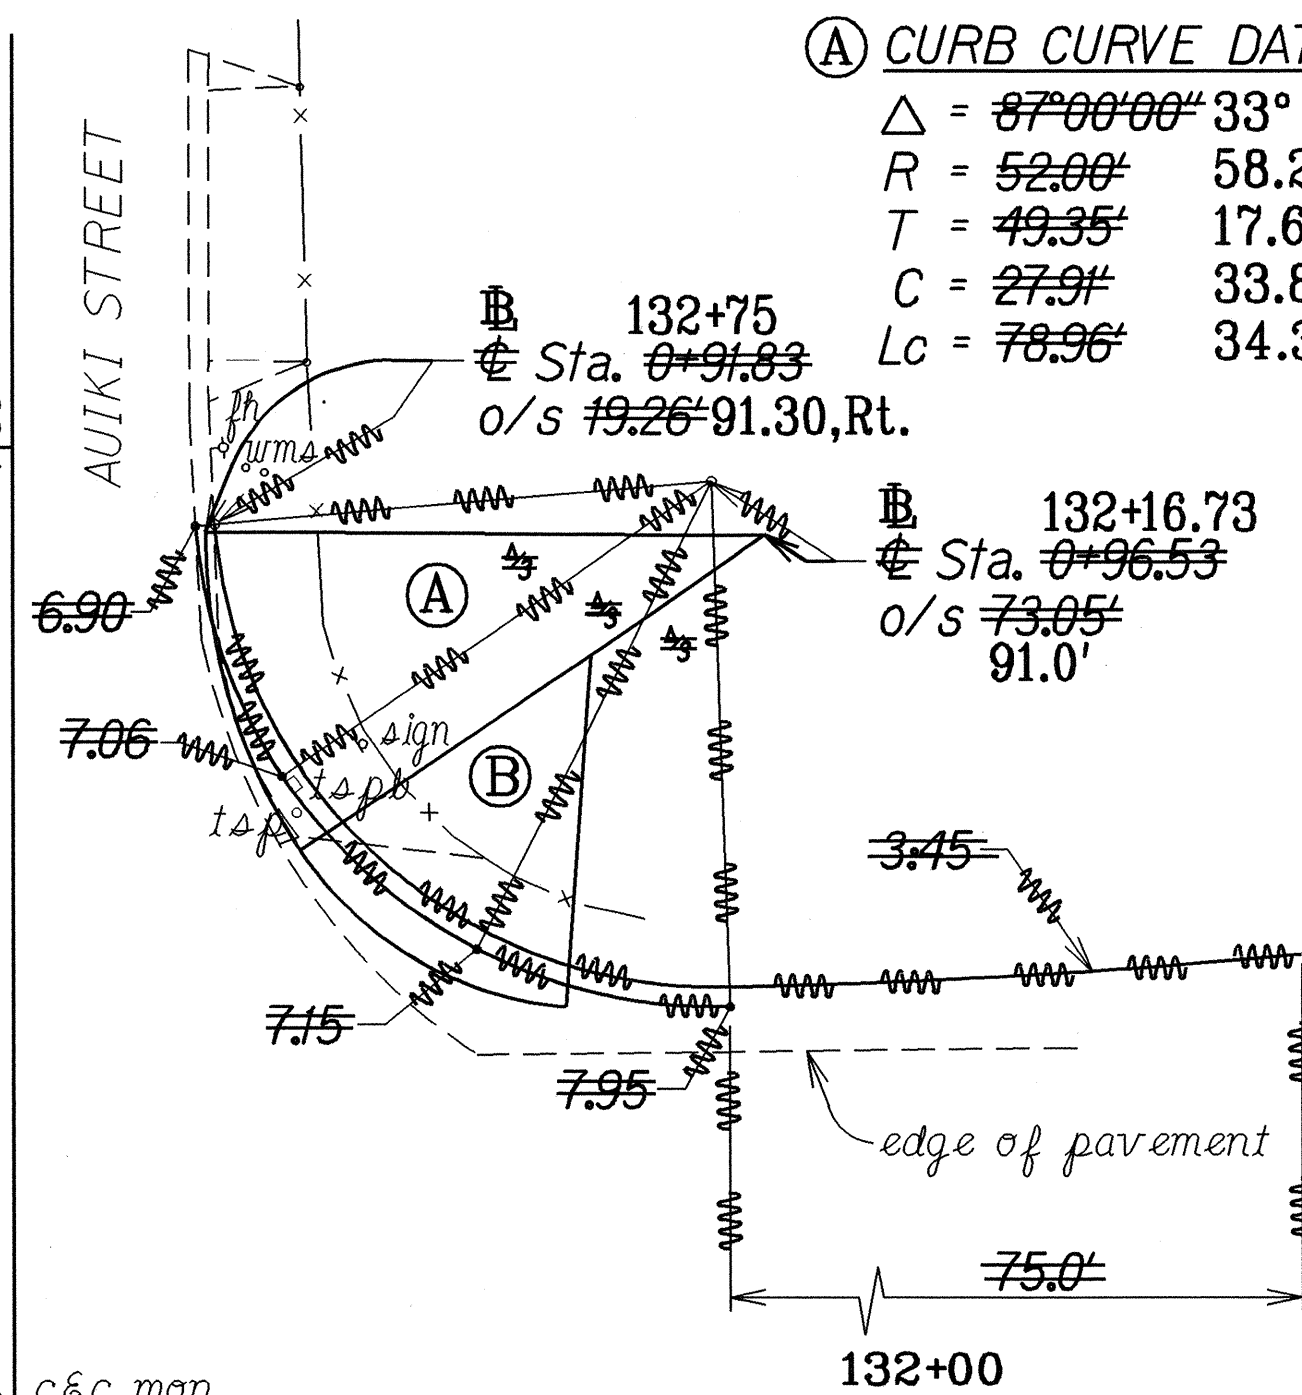

**B CURB CURVE DATA**  
 $\Delta = 56^{\circ}15'56''$   
 $R = 36.576'$   
 $T = 17.85'$   
 $C = 32.08'$   
 $Lc = 33.21'$

**E CURB CURVE DATA**  
 $\Delta = 36^{\circ}30'00''$  36° 52' 12"  
 $R = 58.00'$  66.00'  
 $T = 18.57'$  22.00'  
 $C = 36.33'$  41.74'  
 $Lc = 36.95'$  42.47'

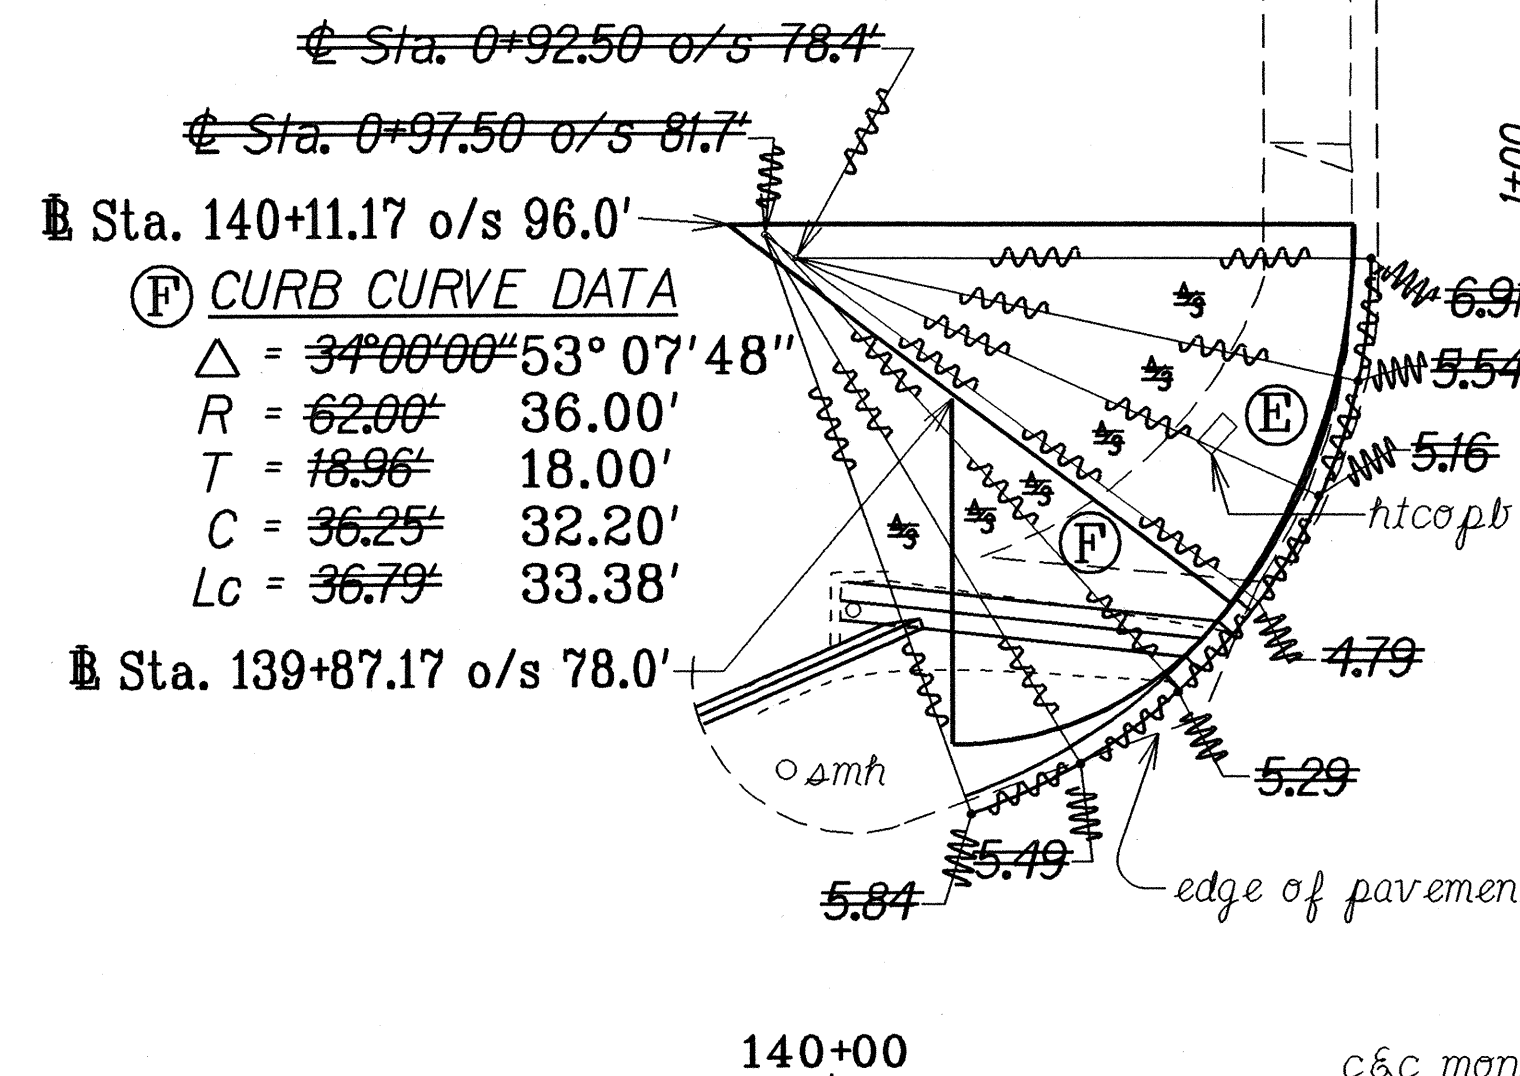


**CURB CURVE DATA**  
 $\Delta = 23^{\circ}00'00''$   
 $R = 70.00'$   
 $T = 14.24'$   
 $C = 27.92'$   
 $Lc = 28.10'$

### KALIWA STREET

Scale: 1" = 20'

Sand Island Access Road  
Sta. 139+09.50 25.06  
Kaliawa Street C Sta. 0+00

Sand Island Access Road  
Sta. 142+57 55.12  
Pahounui Drive C Sta. 0+00

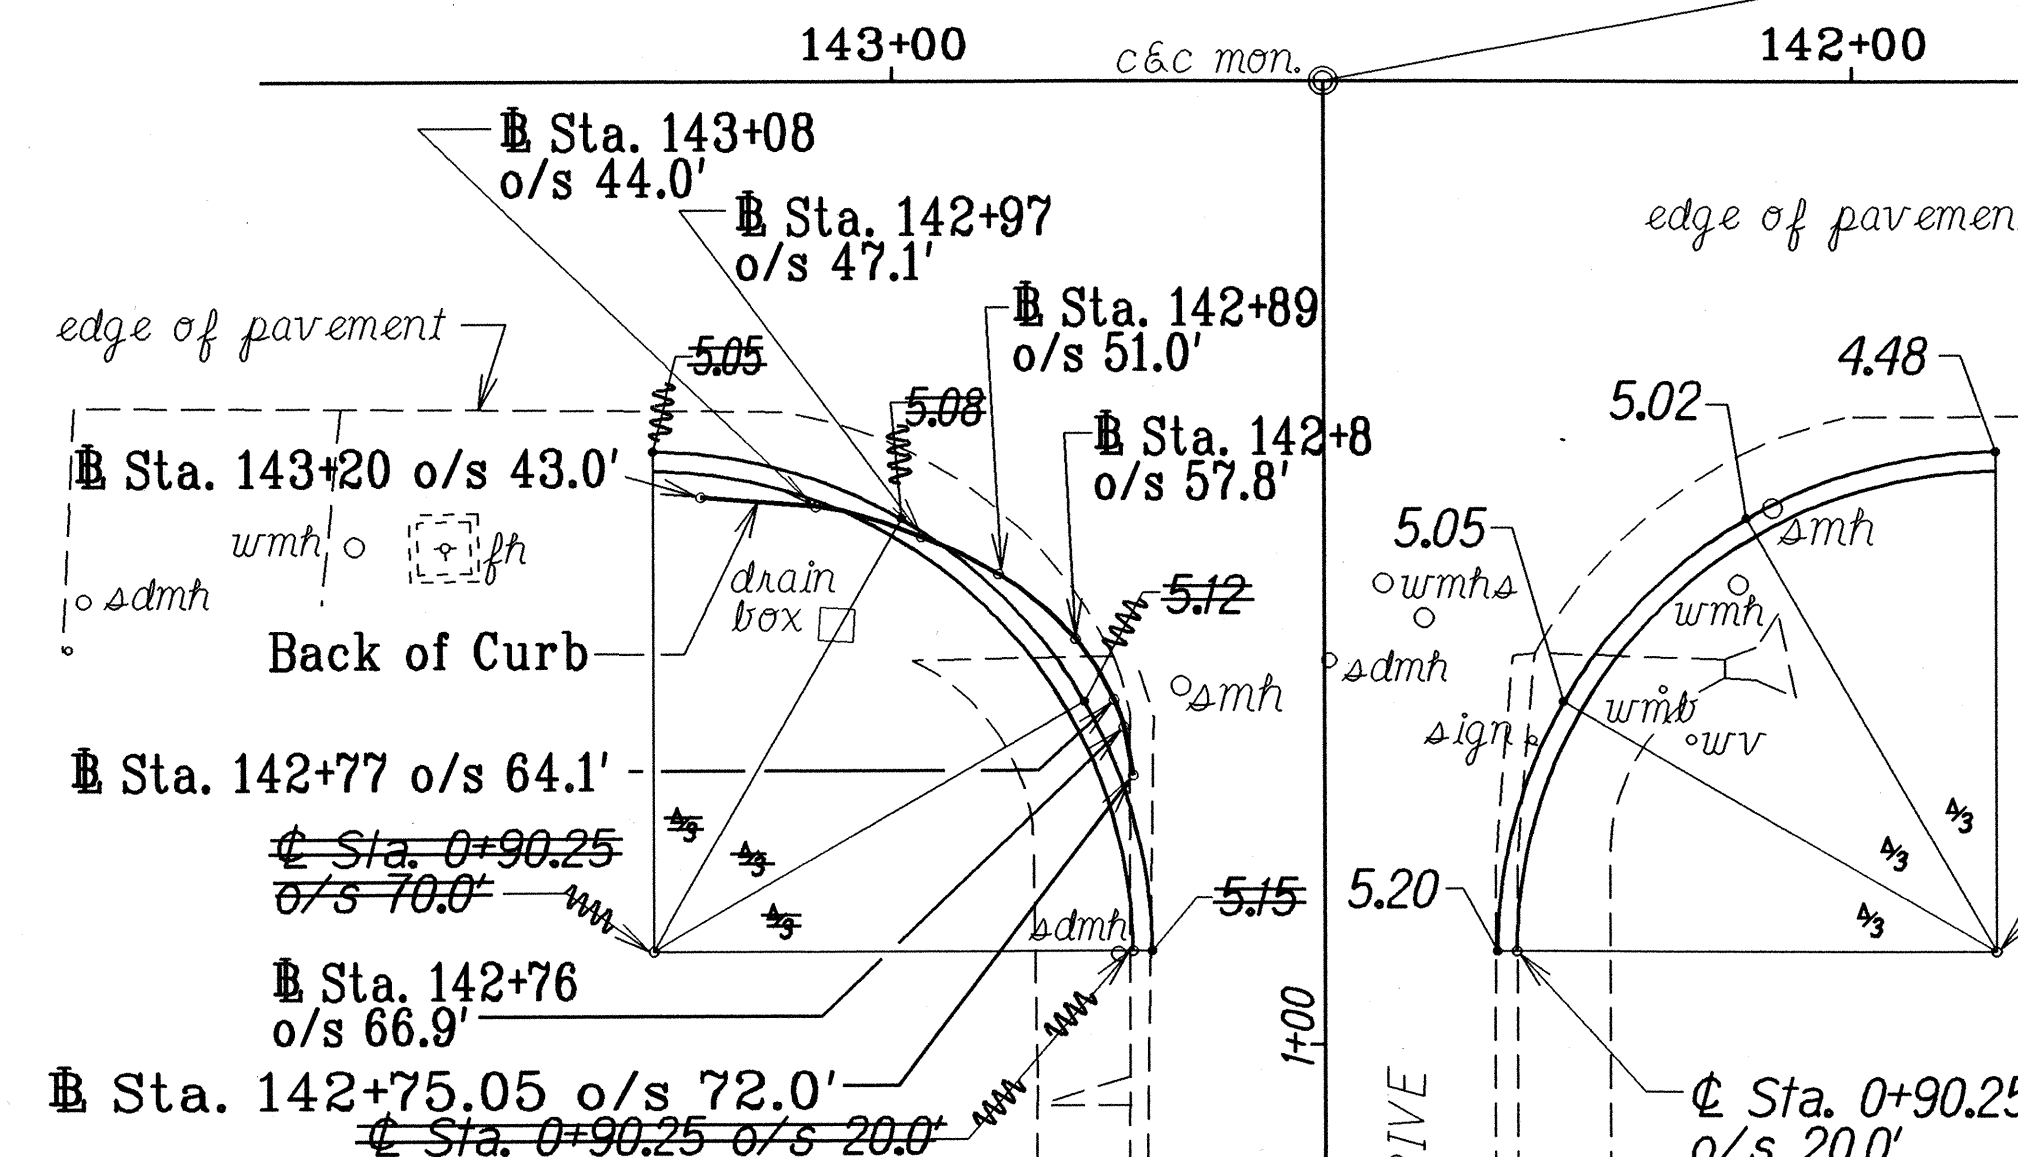

**CURB CURVE DATA**  
 $\Delta = 90^{\circ}00'00''$   
 $R = 50.00'$   
 $T = 50.00'$   
 $C = 70.71'$   
 $Lc = 78.54'$

**CURB CURVE DATA**  
 $\Delta = 90^{\circ}00'00''$   
 $R = 50.00'$   
 $T = 50.00'$   
 $C = 70.71'$   
 $Lc = 78.54'$

### PAHOUNUI DRIVE

Scale: 1" = 20'

STATE OF HAWAII  
 DEPARTMENT OF TRANSPORTATION  
 HIGHWAYS DIVISION  
**GRADE CONTROL**  
 SAND ISLAND ACCESS ROAD AND  
 SAND ISLAND PARKWAY RESURFACING  
 Sewage Treatment Plant to Nimitz Highway  
 Fed. Aid Project No. STP-064-1(6)

Scale: As Shown Date: Aug., 1994  
 SHEET No. 1 OF 1 SHEETS

"AS-BUILT"