


FED. ROAD DIST. NO.	STATE	FED. AID PROJ. NO.	FISCAL YEAR	SHEET NO.	TOTAL SHEETS
HAWAII	HAW.	STP-064-1(6)	1994	9	25

Nimitz Highway - Sand Island
Access Road Rt.
Install 2 New 6 (6x6) Loop Detectors

157+04 76
Sta. 156+40± to Sta. 155+29±
Remove 96' of existing curb
273'
157+04
Sta. 156+40± to Sta. 155+55±
Install 130± New Type 2A Curb.
Extend Existing Pavement Section
of 8½" ACB and 2½" AC Mix IV
to Adjacent Edge of Type 2A Curb
and to Driveway Edge.

New Type
2A Curb
w/3' w x 2" h
Curb Slot

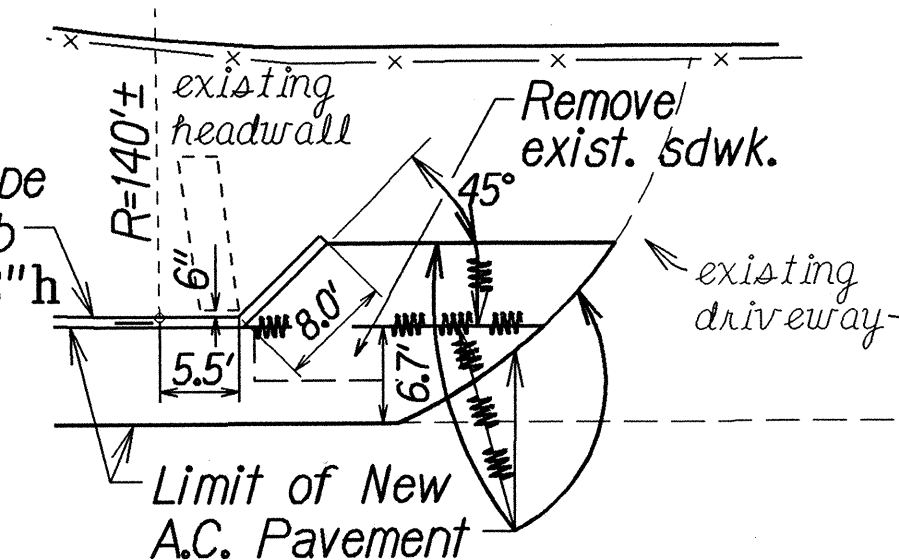


TRUE NORTH
SCALE: 1" = 40'

5 7
Sta. 152+07 to 148+69 Median
Construct New Curb, Type 2A and excavate
12" of median and backfill median with select
fill. Top of curb shall be 6" above finish
A.C. Mix IV Pavement.
Remove and dispose of all concrete posts
within median.

CURVE DATA



Δ = 85° 24'
Δ/2 = 42° 42'
R = 182.67'
T = 168.56'
C = 247.76'
Lc = 272.27'

DETAIL A
Not to Scale 919

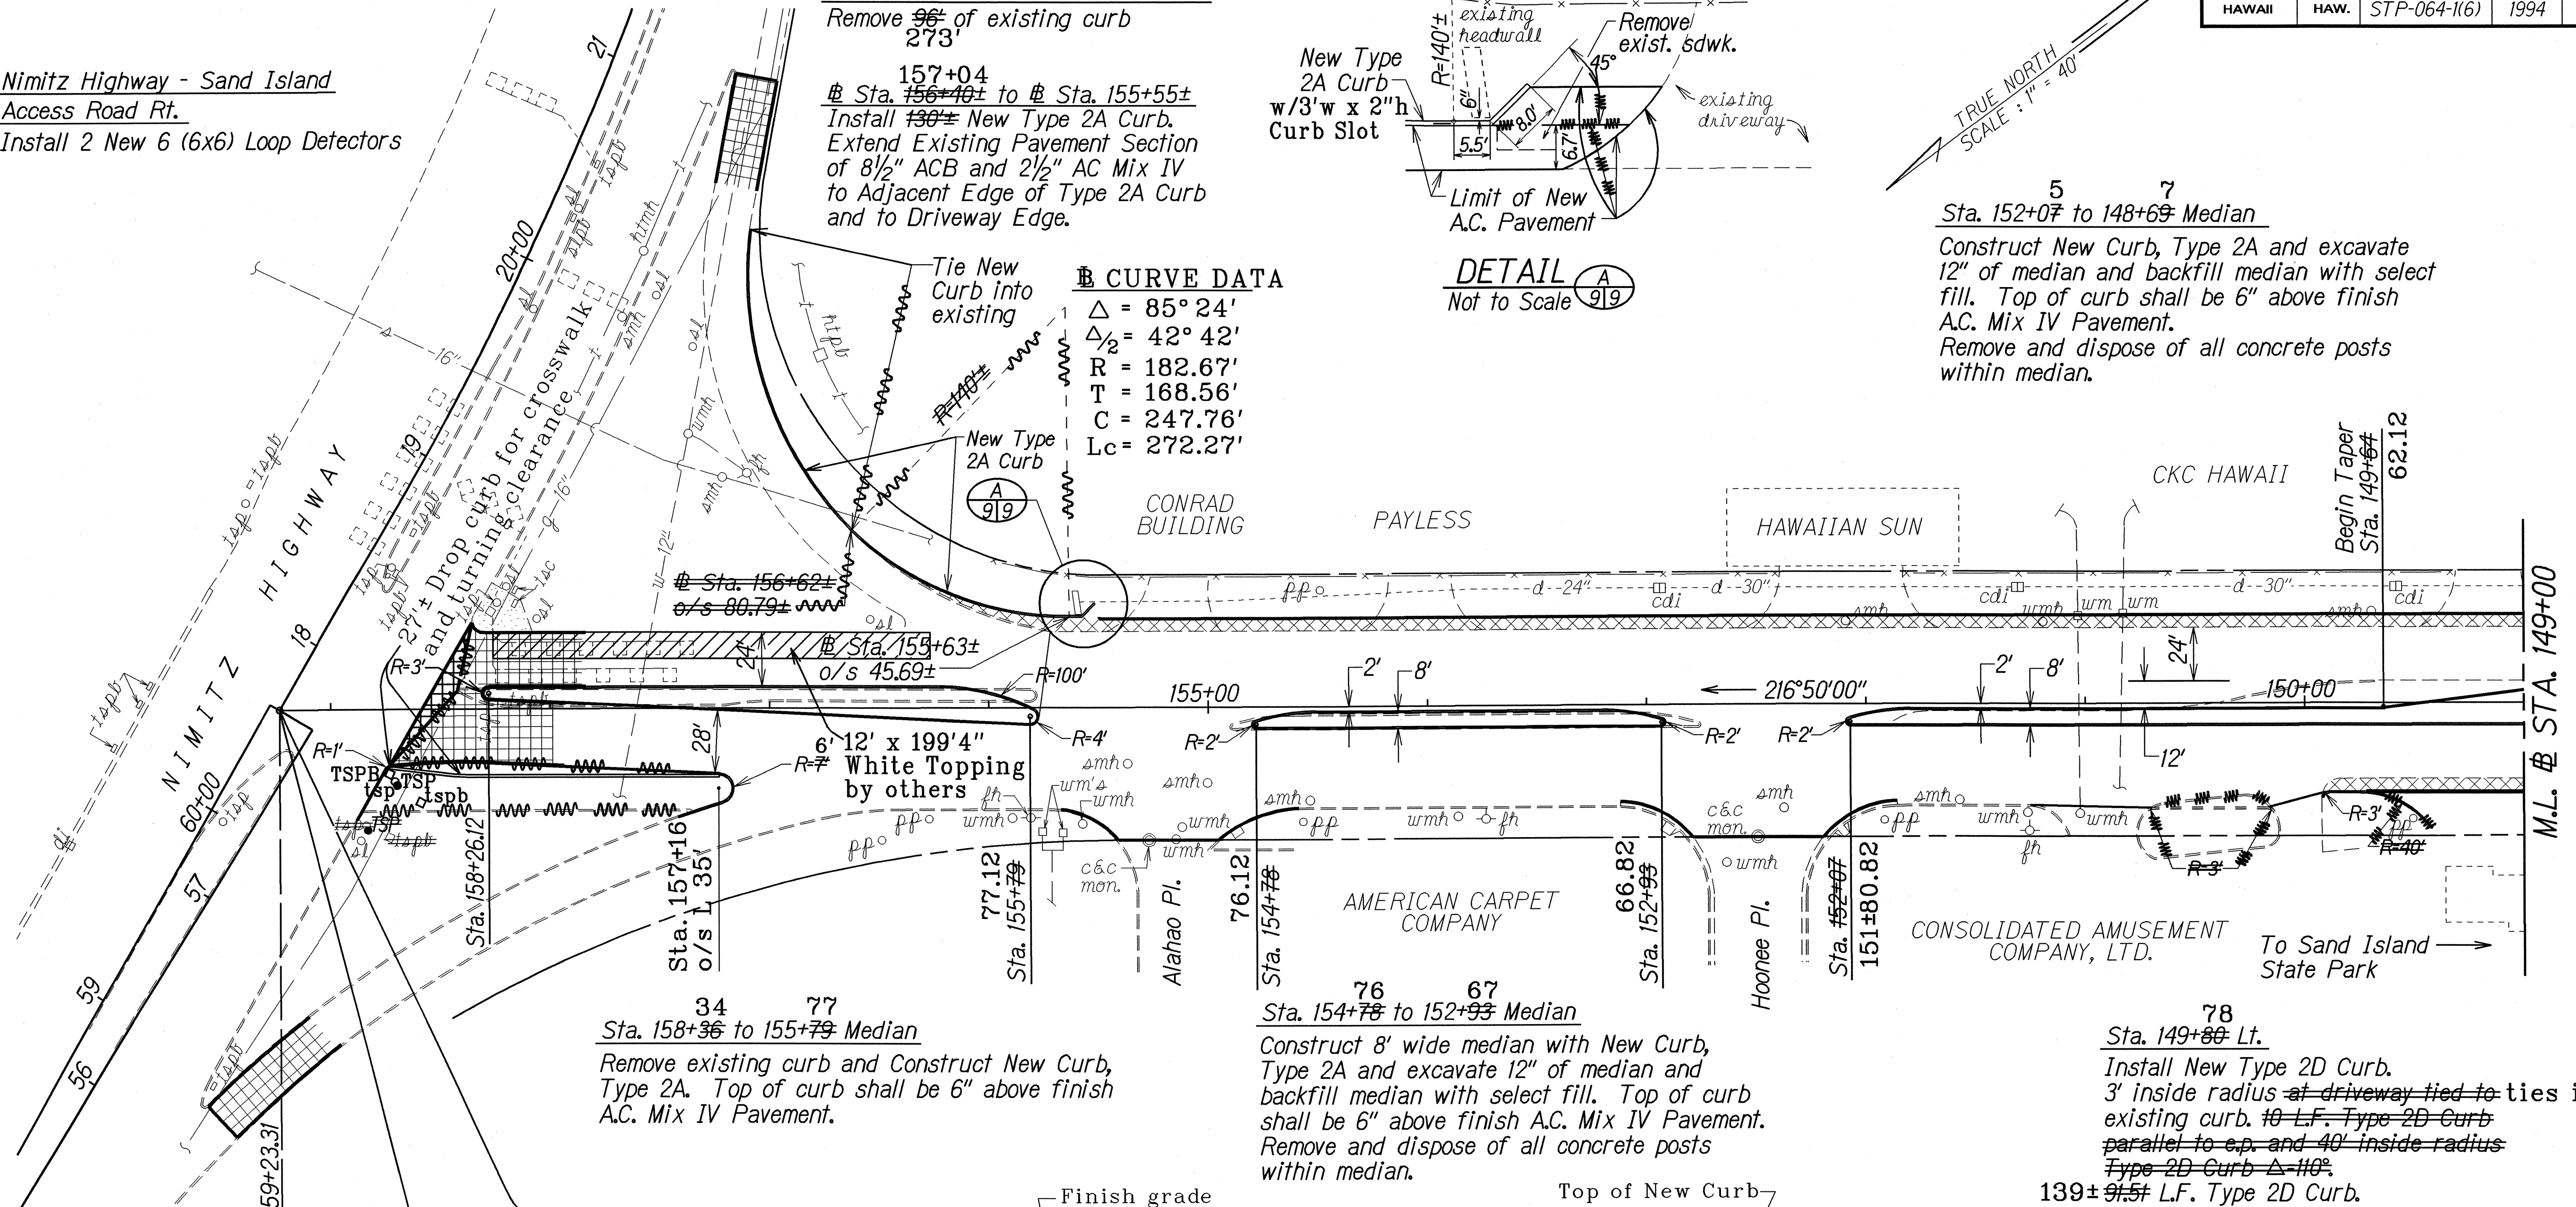

BEGIN PROJECT
Fed. Aid Proj. No. STP-064-1(6)
SAND ISLAND ACCESS ROAD
Sta. 159+23.31 =
NIMITZ HIGHWAY
Sta. 17+66.47

Sta. 158+80 to 155+78 Island Lt.
Install new Type 2A Curb.
170 L.F.
Remove and dispose 190 L.F. existing curb.
Relocate traffic signal pole to Sta. 158+83, o.s. 54.5' Lt.

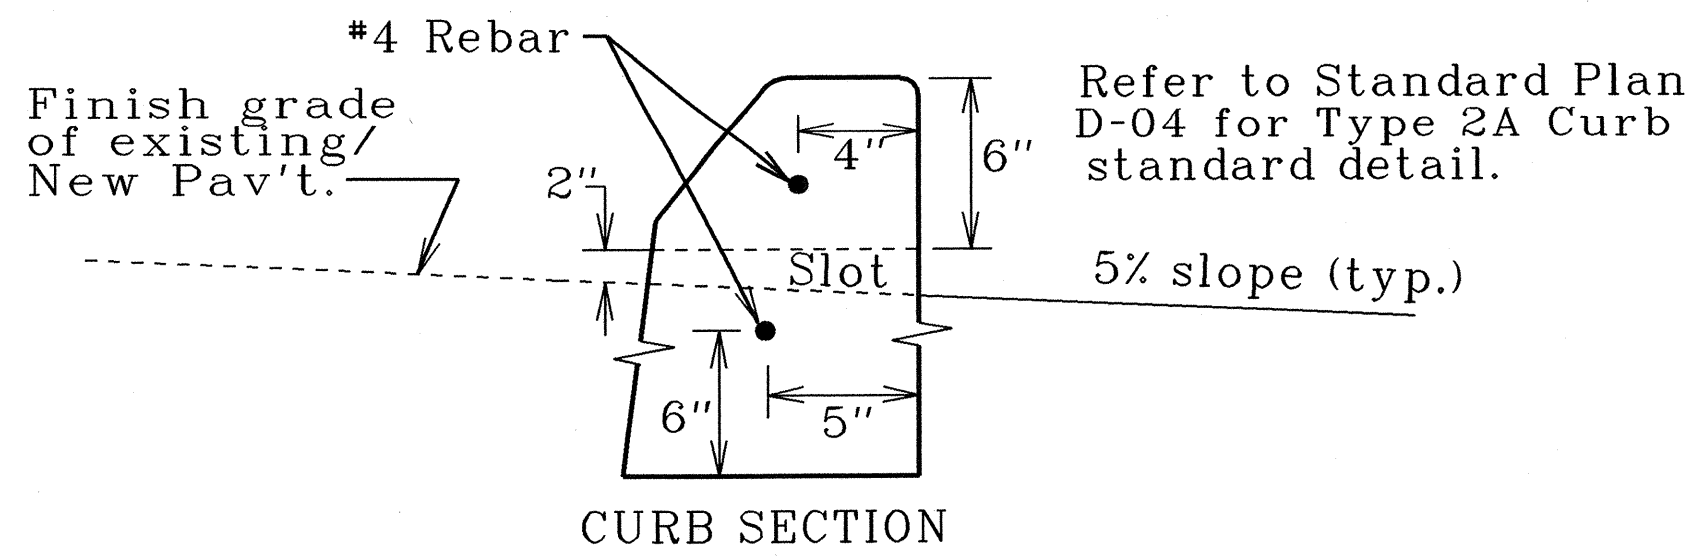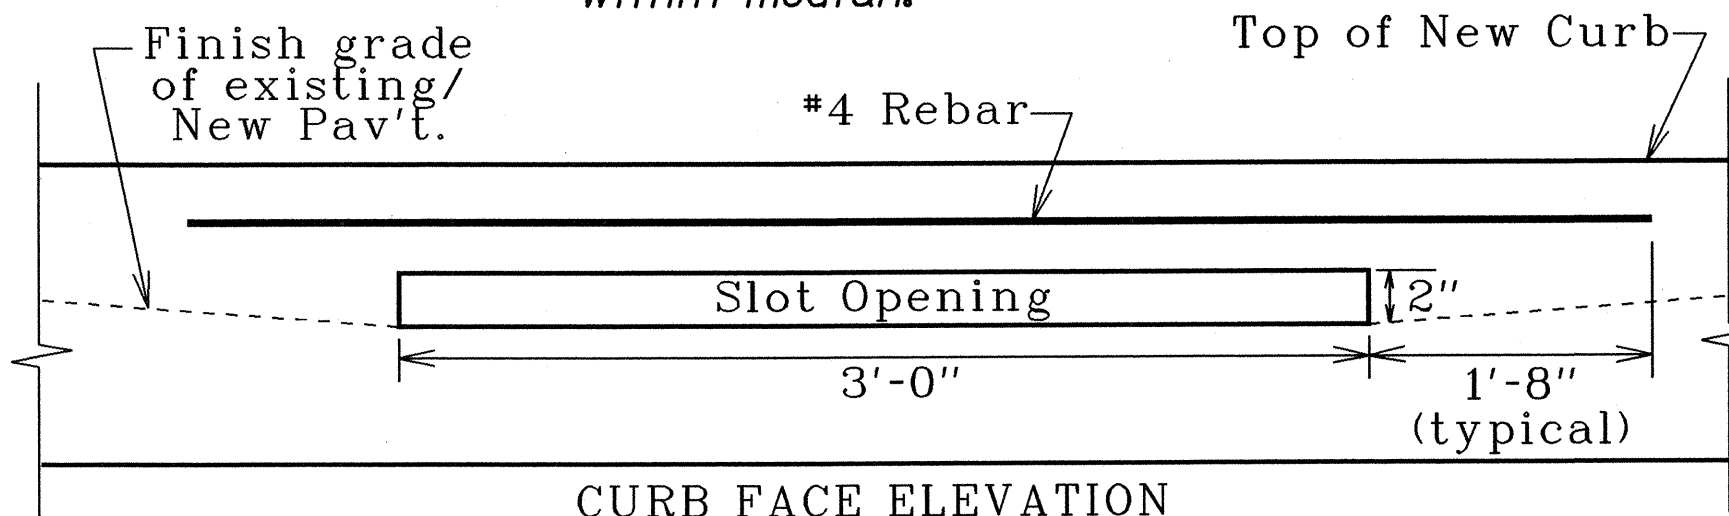

Sta. 150+40 Lt.
Install New Type 2D Curb.
3' inside radius at both ends
tied into existing curb.
59.5± L.F. Type 2D Curb.

78
Sta. 149+80 Lt.
Install New Type 2D Curb.
3' inside radius at driveway tied to ties into
existing curb. 10 L.F. Type 2D Curb
parallel to c.p. and 40' inside radius
Type 2D Curb Δ=110°.
139± 9.5± L.F. Type 2D Curb.


LEGEND FOR
AS-BUILT POSTINGS
Squiggly line for
as-built deletion
Double line for
as-built deletion
Roadway Text for as-built
posting

DATE	REVISION
2/28/96	Revise Concrete Curb, Type 2A, from Sta. 156+40± to Sta. 155+55±, Rt.
1/16/96	Revise Concrete Curb from Sta. 158+25± to Sta. 159+23.31
29	
STATE OF HAWAII DEPARTMENT OF TRANSPORTATION HIGHWAYS DIVISION ROADWAY PLAN SAND ISLAND ACCESS ROAD AND SAND ISLAND PARKWAY RESURFACING Nimitz Highway to Sewage Treatment Plant Fed. Aid Project No. STP-064-1(6) Scale: 1" = 40' Date: May, 1994	
SHEET No. 1 OF 5 SHEETS	

"AS-BUILT"

C.O. 9



FED. ROAD DIST. NO.	STATE	FED. AID PROJ. NO.	FISCAL YEAR	SHEET NO.	TOTAL SHEETS
HAWAII	HAW.	STP-064-1(6)	1994	10	25

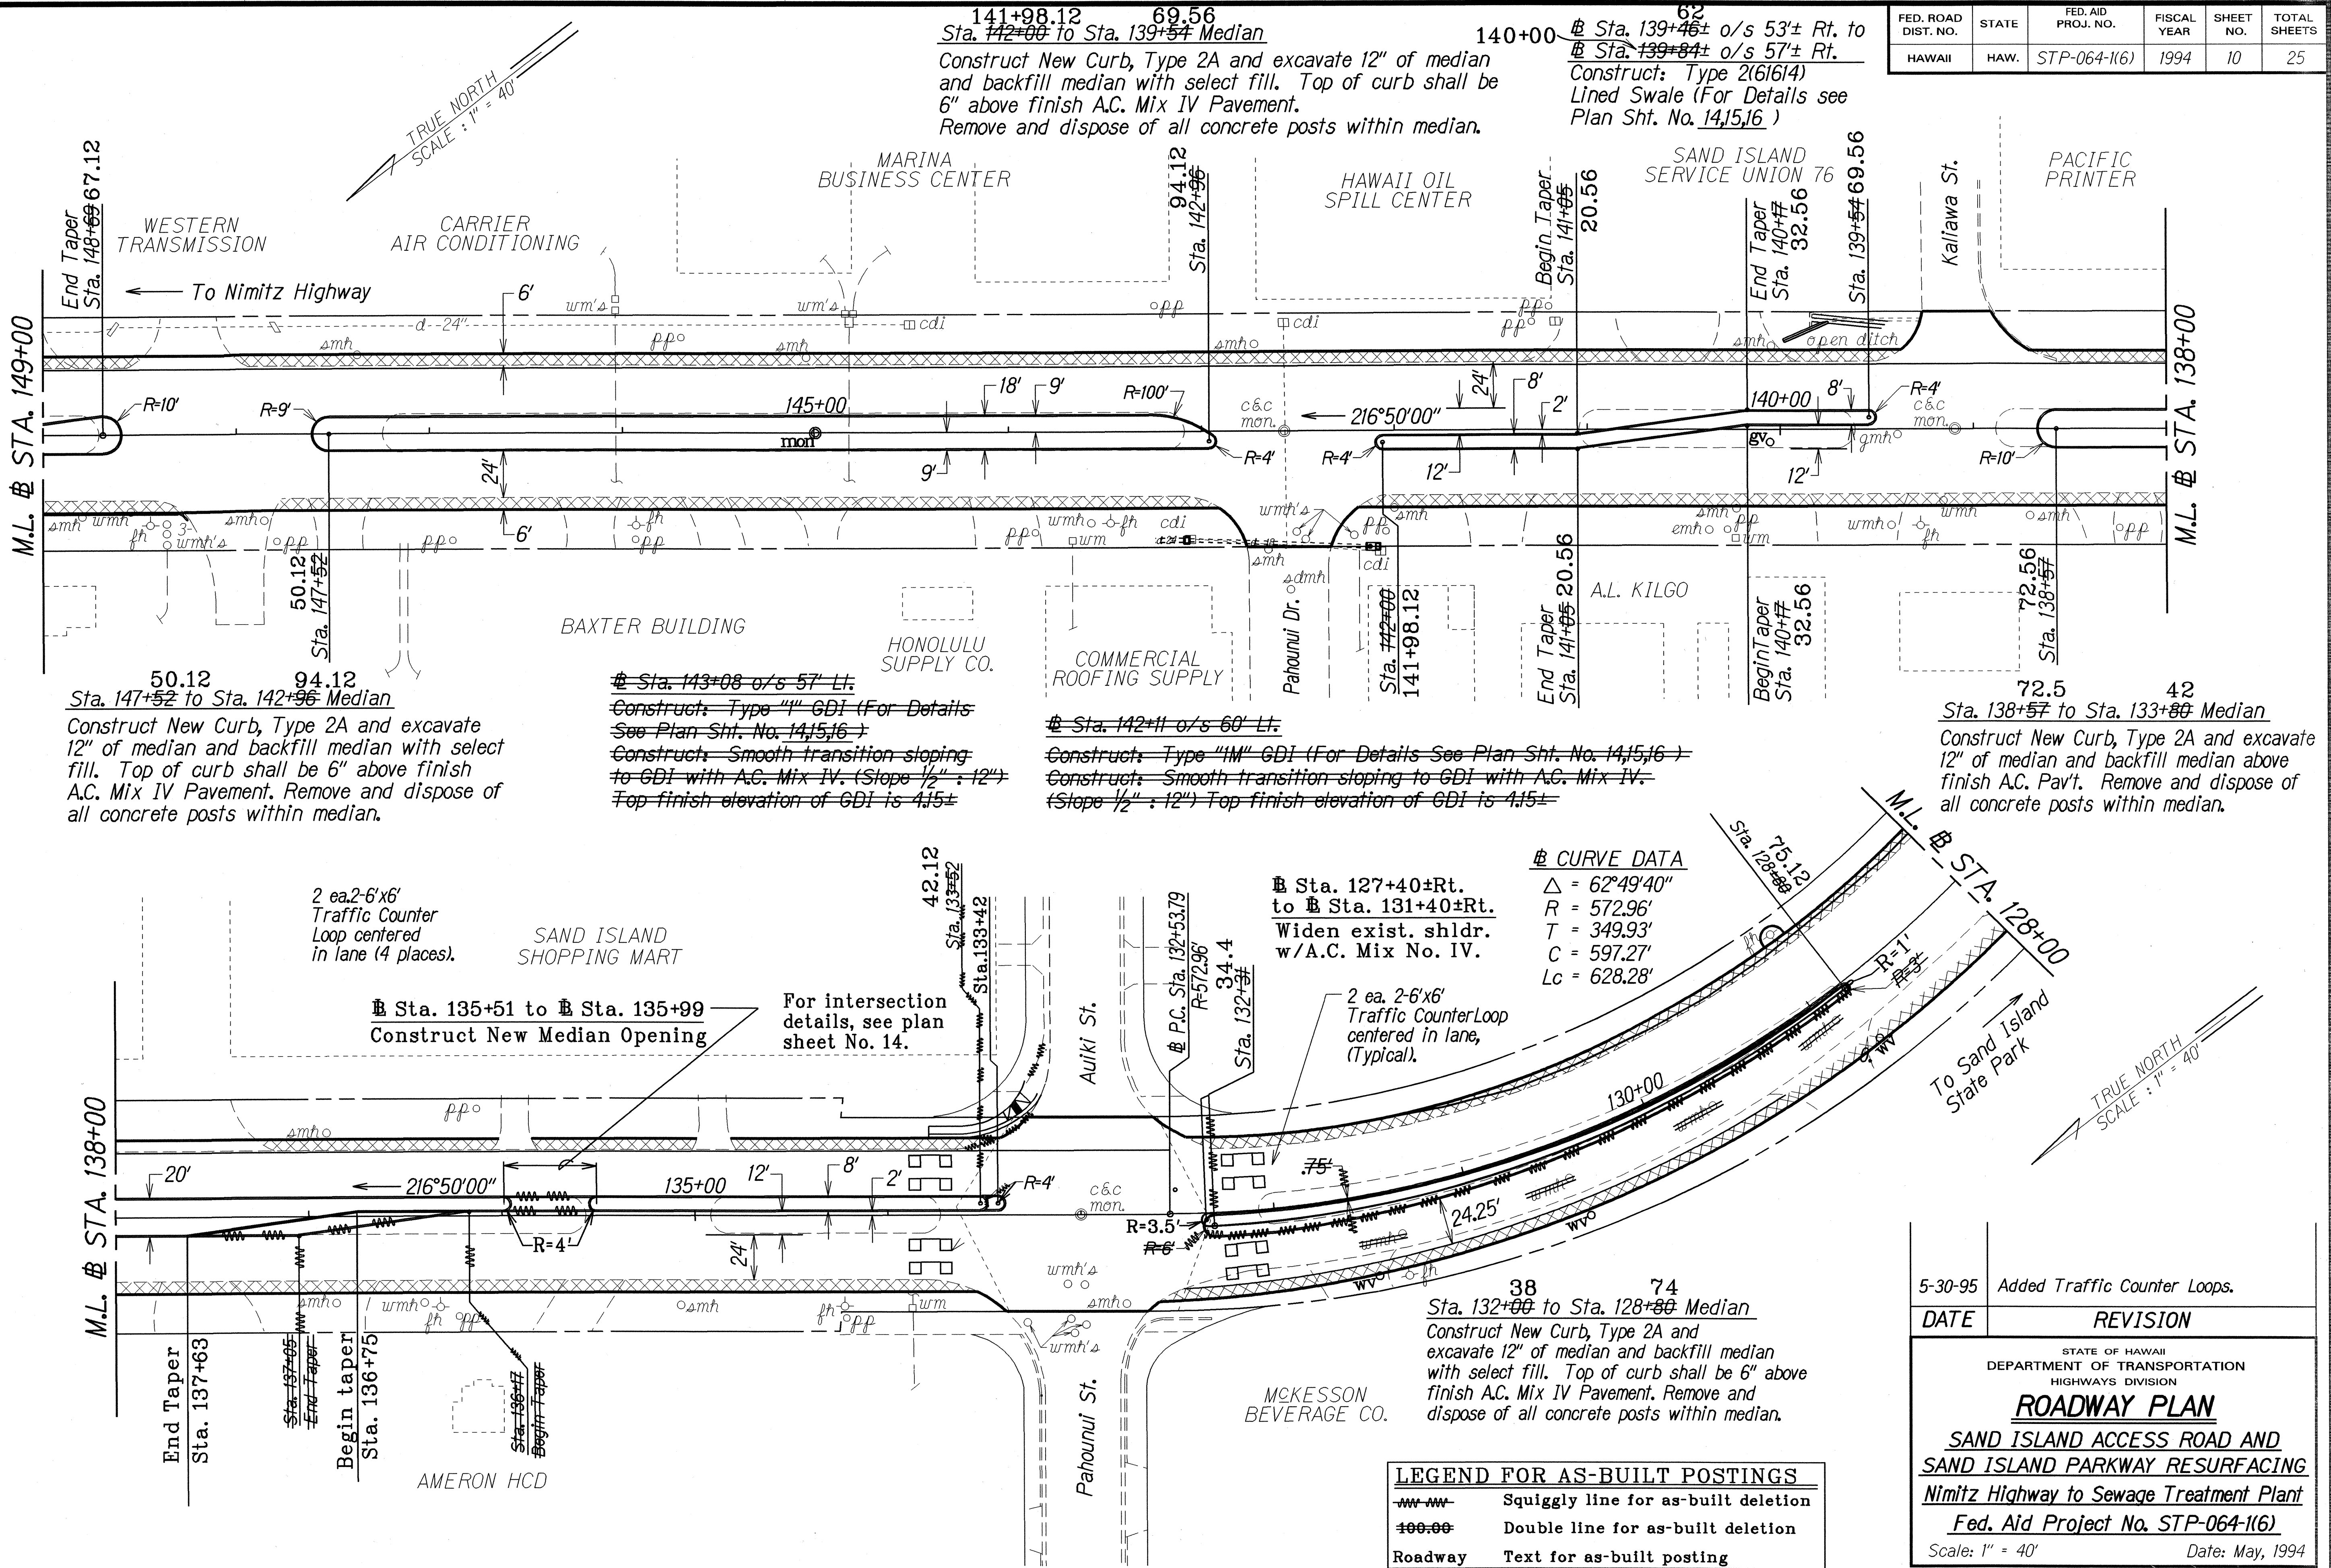

ORIGINAL	DATE
DESIGNED BY	15-10-95
TRACED BY	
NOTED BY	
QUANTITIES BY	
CHECKED BY	

5-30-95	Added Traffic Counter Loops.
DATE	REVISION
STATE OF HAWAII DEPARTMENT OF TRANSPORTATION HIGHWAYS DIVISION	
ROADWAY PLAN	
SAND ISLAND ACCESS ROAD AND SAND ISLAND PARKWAY RESURFACING	
Nimitz Highway to Sewage Treatment Plant	
Fed. Aid Project No. STP-064-1(6)	
Scale: 1\"/>	Date: May, 1994
SHEET No. 2 OF 5 SHEETS	

FED. ROAD DIST. NO.	STATE	FED. AID PROJ. NO.	FISCAL YEAR	SHEET NO.	TOTAL SHEETS
HAWAII	HAW.	STP-064-1(6)	1994	11	25

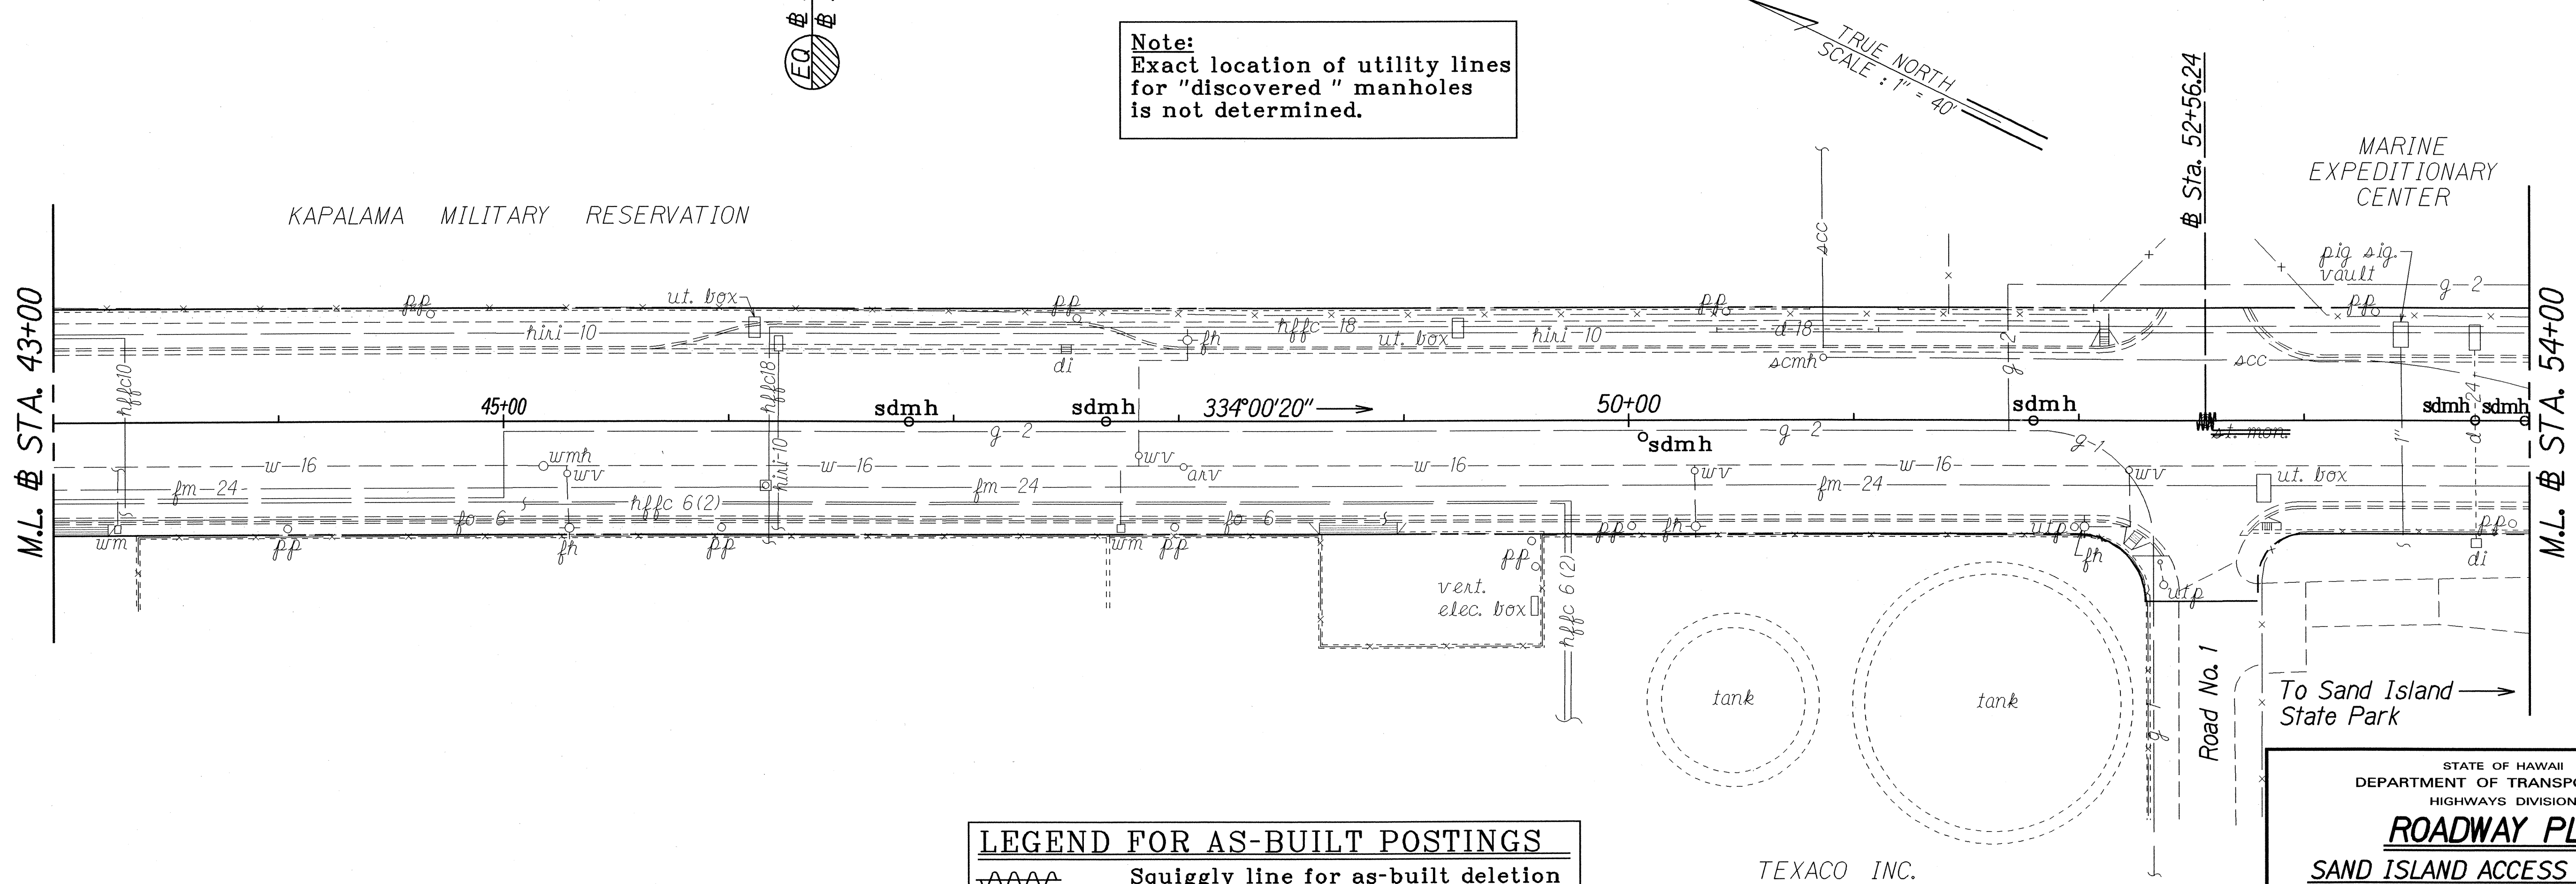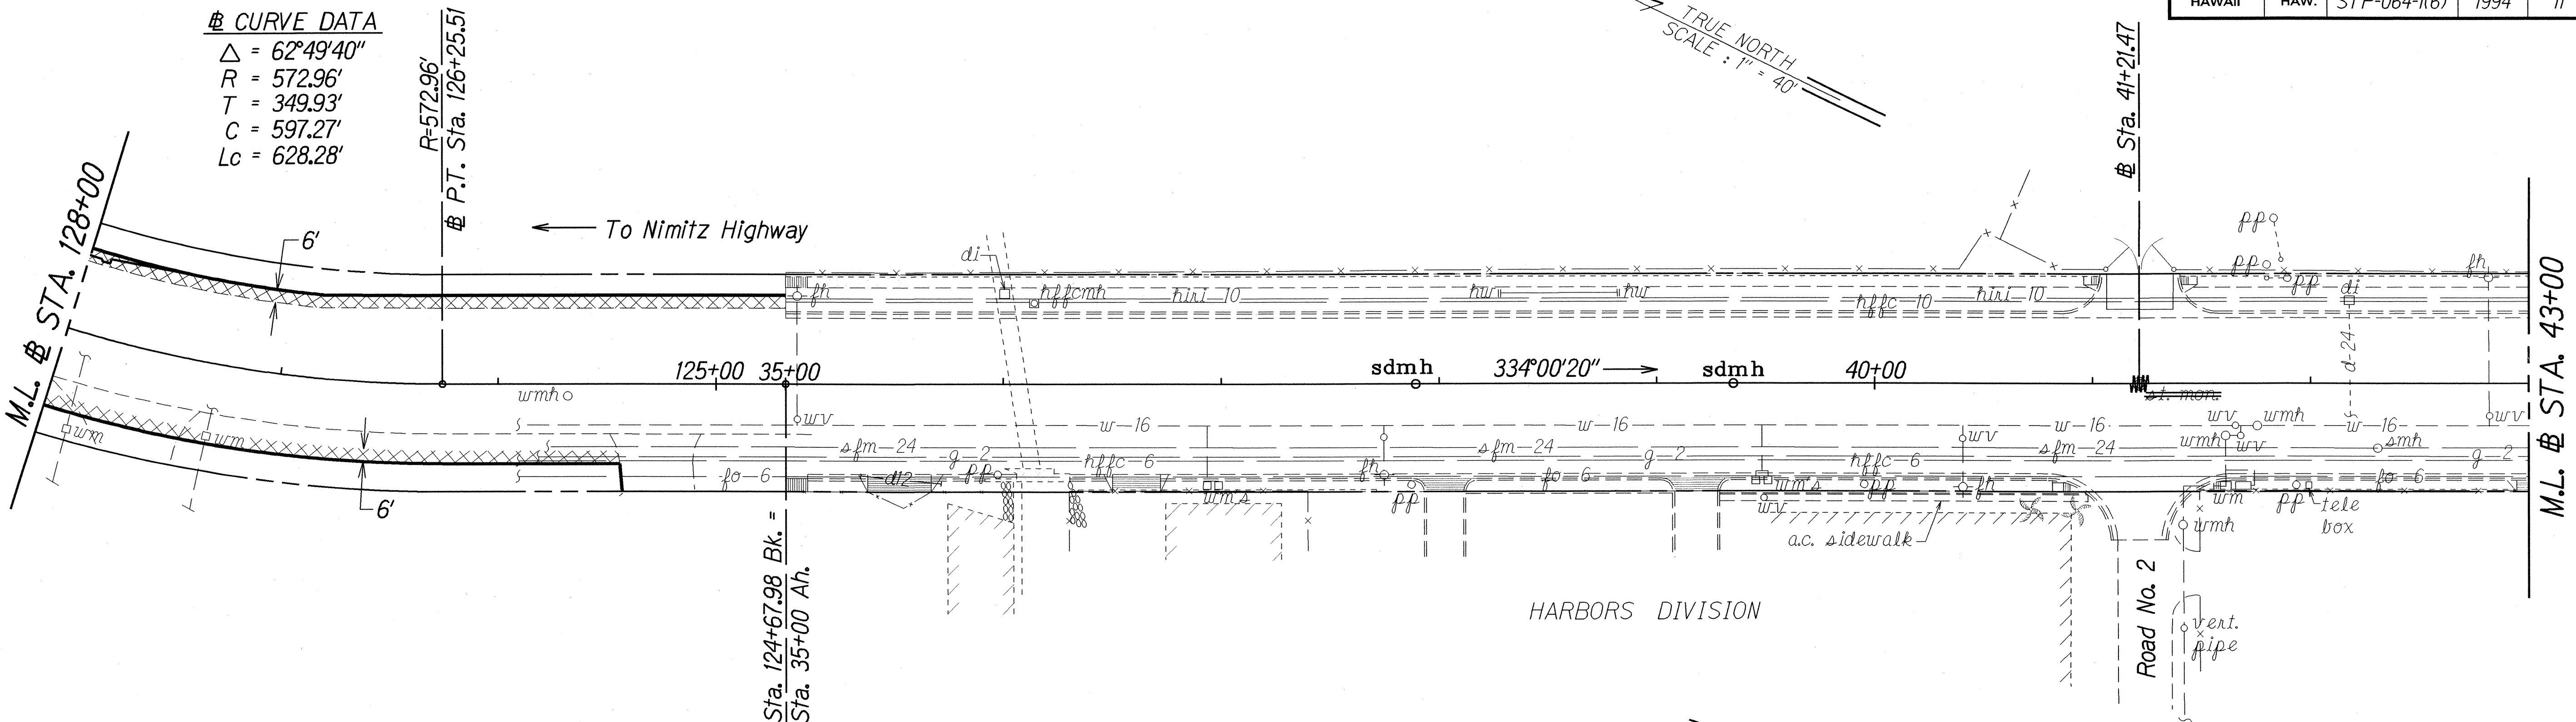

LEGEND FOR AS-BUILT POSTINGS	
	Squiggly line for as-built deletion
	Double line for as-built deletion
Roadway	Text for as-built posting

STATE OF HAWAII
DEPARTMENT OF TRANSPORTATION
HIGHWAYS DIVISION

ROADWAY PLAN

SAND ISLAND ACCESS ROAD AND
SAND ISLAND PARKWAY RESURFACING
Nimitz Highway to Sewage Treatment Plant
Fed. Aid Project No. STP-064-1(6)


Scale: 1" = 40'
Date: May, 1994

SHEET No. 3 OF 5 SHEETS

ORIGINAL PLAN	DATE
DESIGNED BY	12-28-94
DRAWN BY	
CHECKED BY	
IN CHARGE	

"AS-BUILT"

FED. ROAD DIST. NO.	STATE	FED. AID PROJ. NO.	FISCAL YEAR	SHEET NO.	TOTAL SHEETS
HAWAII	HAW.	STP-064-1(6)	1994	13	25

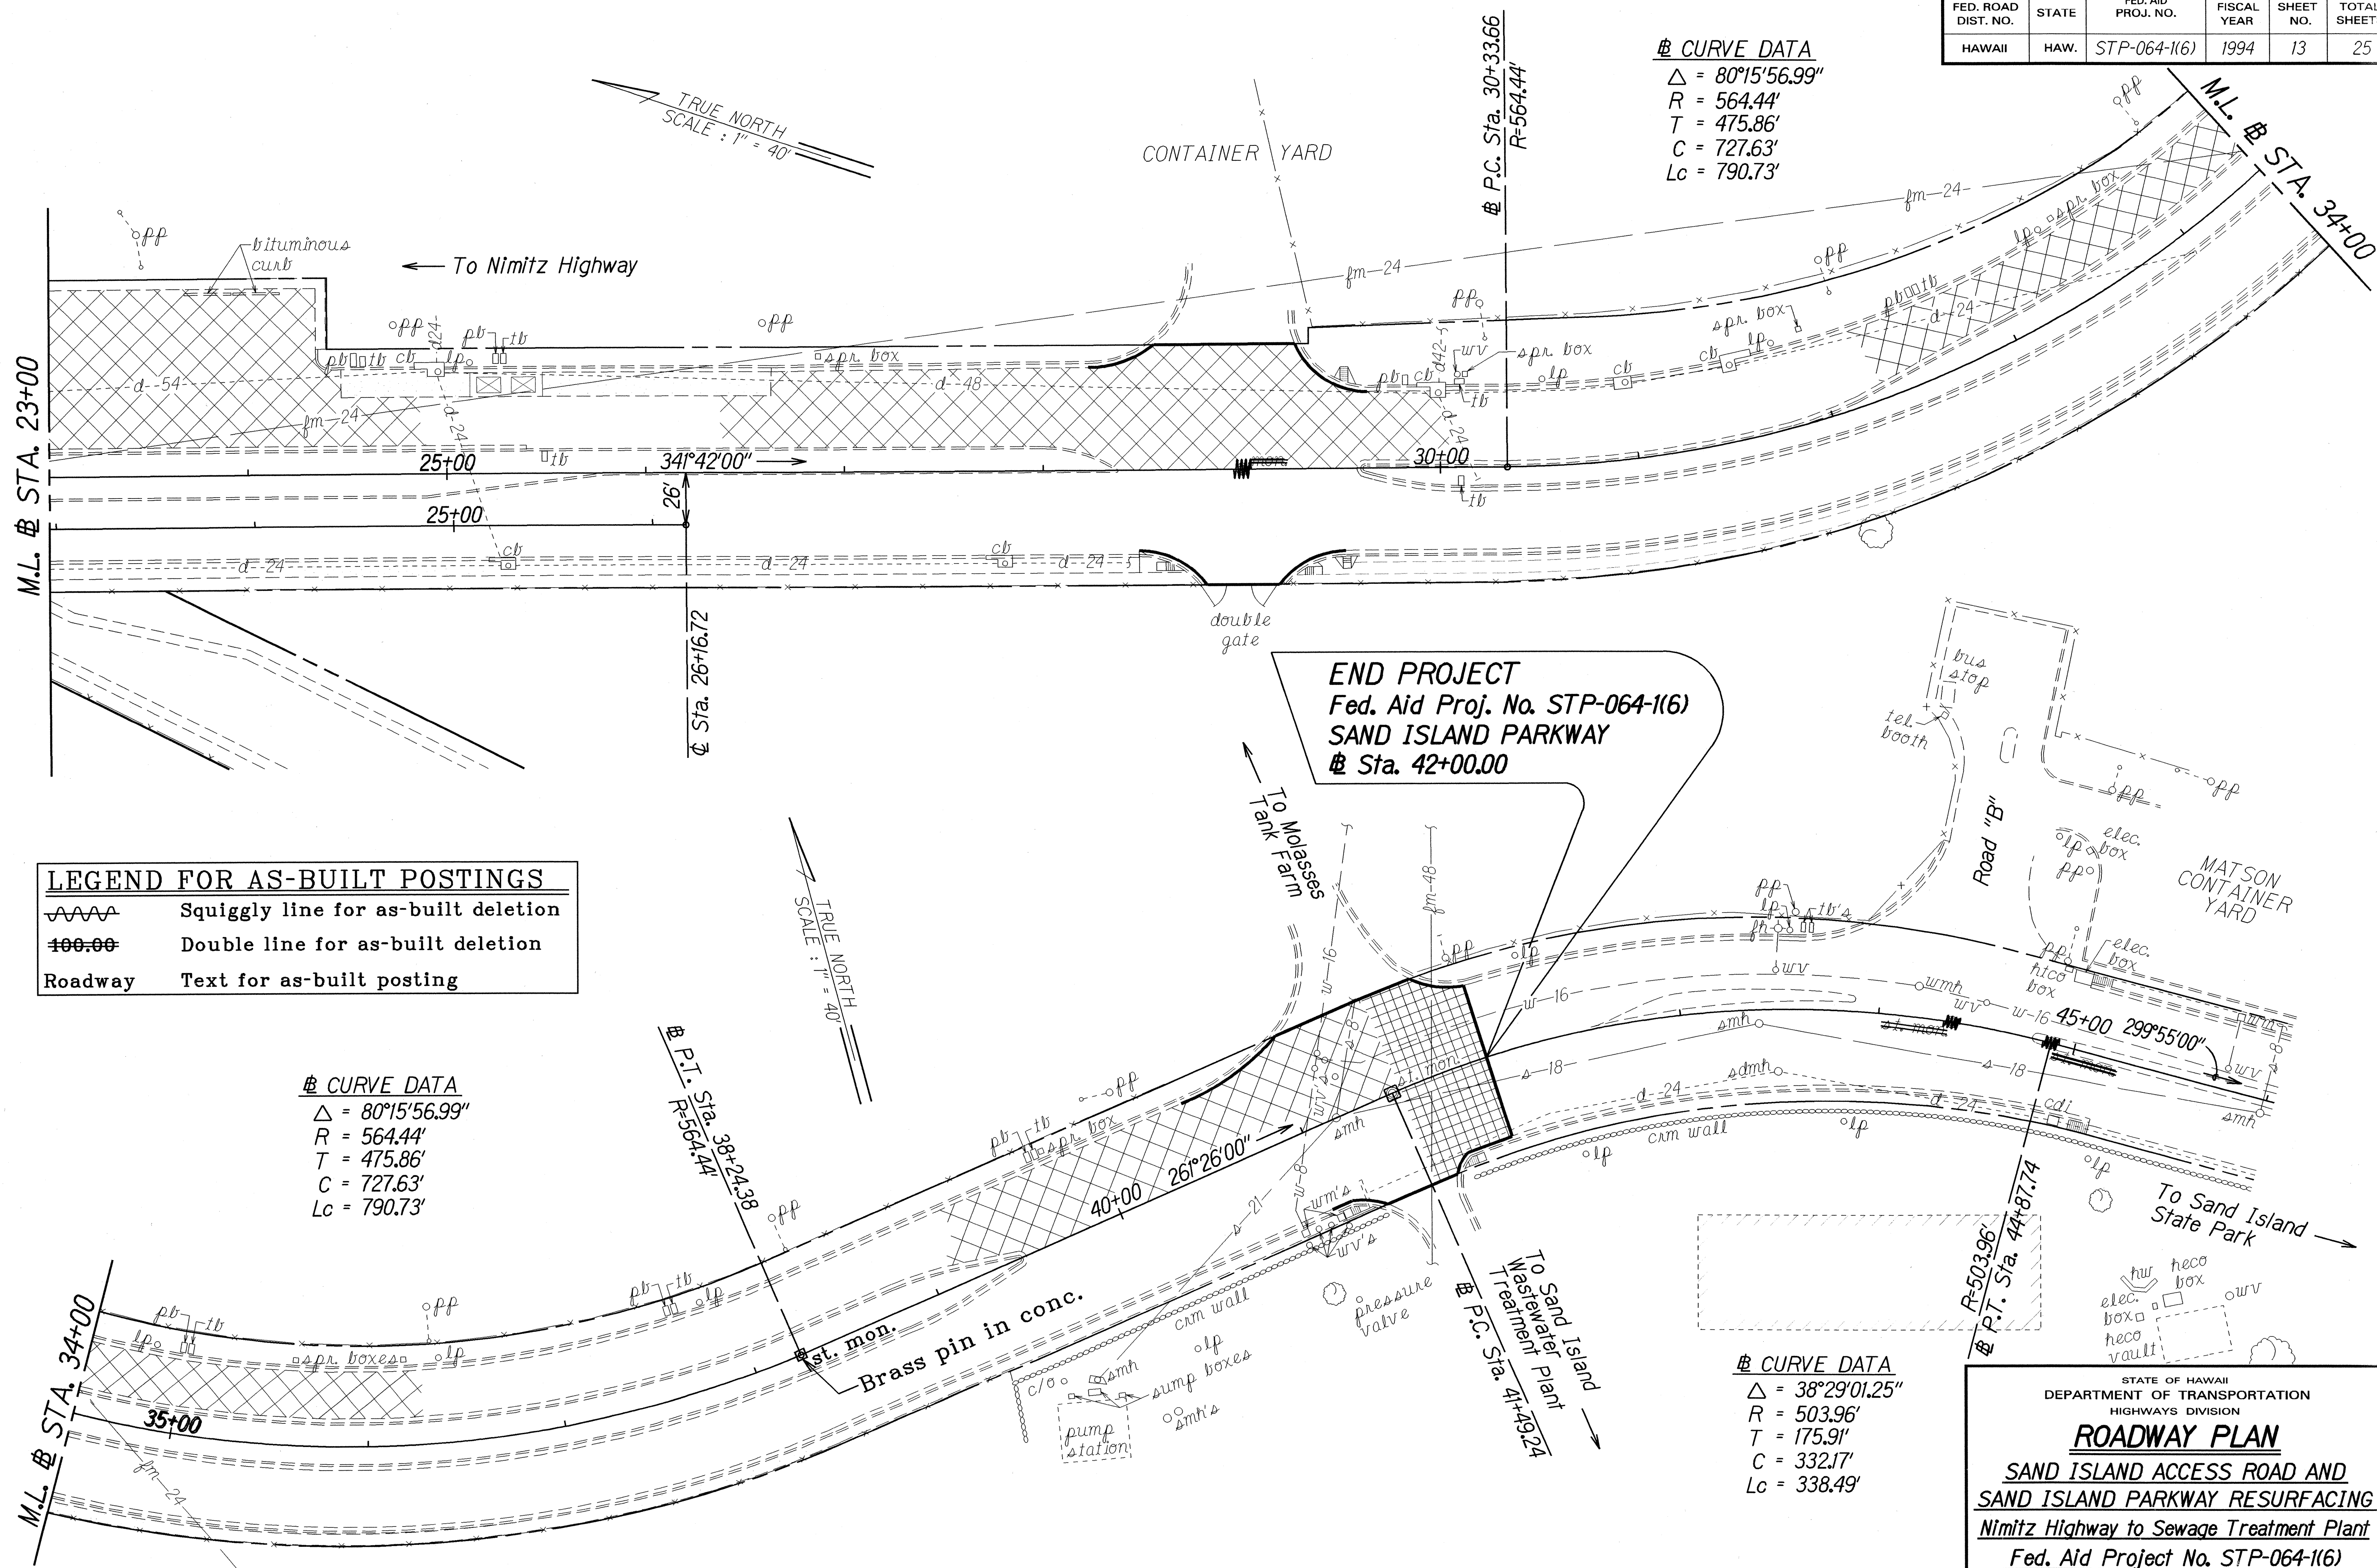

CURVE DATA
 $\Delta = 80^{\circ}15'56.99''$
 $R = 564.44'$
 $T = 475.86'$
 $C = 727.63'$
 $L_c = 790.73'$

LEGEND FOR AS-BUILT POSTINGS

	Squiggly line for as-built deletion
	Double line for as-built deletion
Roadway	Text for as-built posting

CURVE DATA
 $\Delta = 80^{\circ}15'56.99''$
 $R = 564.44'$
 $T = 475.86'$
 $C = 727.63'$
 $L_c = 790.73'$

CURVE DATA
 $\Delta = 38^{\circ}29'01.25''$
 $R = 503.96'$
 $T = 175.91'$
 $C = 332.17'$
 $L_c = 338.49'$

ORIGINAL PLAN	DATE
SURVEY PLOTTED BY	DATE
DRAWN BY	DATE
DESIGNED BY	DATE
CHECKED BY	DATE

STATE OF HAWAII
DEPARTMENT OF TRANSPORTATION
HIGHWAYS DIVISION

ROADWAY PLAN

SAND ISLAND ACCESS ROAD AND SAND ISLAND PARKWAY RESURFACING

Nimitz Highway to Sewage Treatment Plant

Fed. Aid Project No. STP-064-1(6)

Scale: 1" = 40' Date: May, 1994

"AS-BUILT"