

INDEX TO DRAWINGS	
SHEET NO.	DESCRIPTION
1	TITLE SHEET
2	STANDARD PLANS SUMMARY
3	GENERAL NOTES & LEGEND
4	NPDES GENERAL NOTES
5 - 8	TYPICAL SECTIONS
9 - 13	ROADWAY PLANS
14	GRADE CONTROL
15 - 17①	DRAINAGE PLANS & DETAILS
18 - 25	TRAFFIC PLANS

SHEET NO. ① 16S-1 IS A SUPPLEMENTARY SHEET TO THIS PROJECT. TOTAL SHEET COUNT AFTER "AS-BUILT" POSTING 26 SHEETS.

STATE OF HAWAII

DEPARTMENT OF TRANSPORTATION

HIGHWAYS DIVISION

HONOLULU, HAWAII

"AS-BUILT"

PLANS FOR

SAND ISLAND ACCESS ROAD AND


SAND ISLAND PARKWAY RESURFACING

NIMITZ HIGHWAY TO SEWAGE TREATMENT PLANT

FED. AID PROJ. NO. STP-064-1(6)

DISTRICT OF HONOLULU


ISLAND OF OAHU

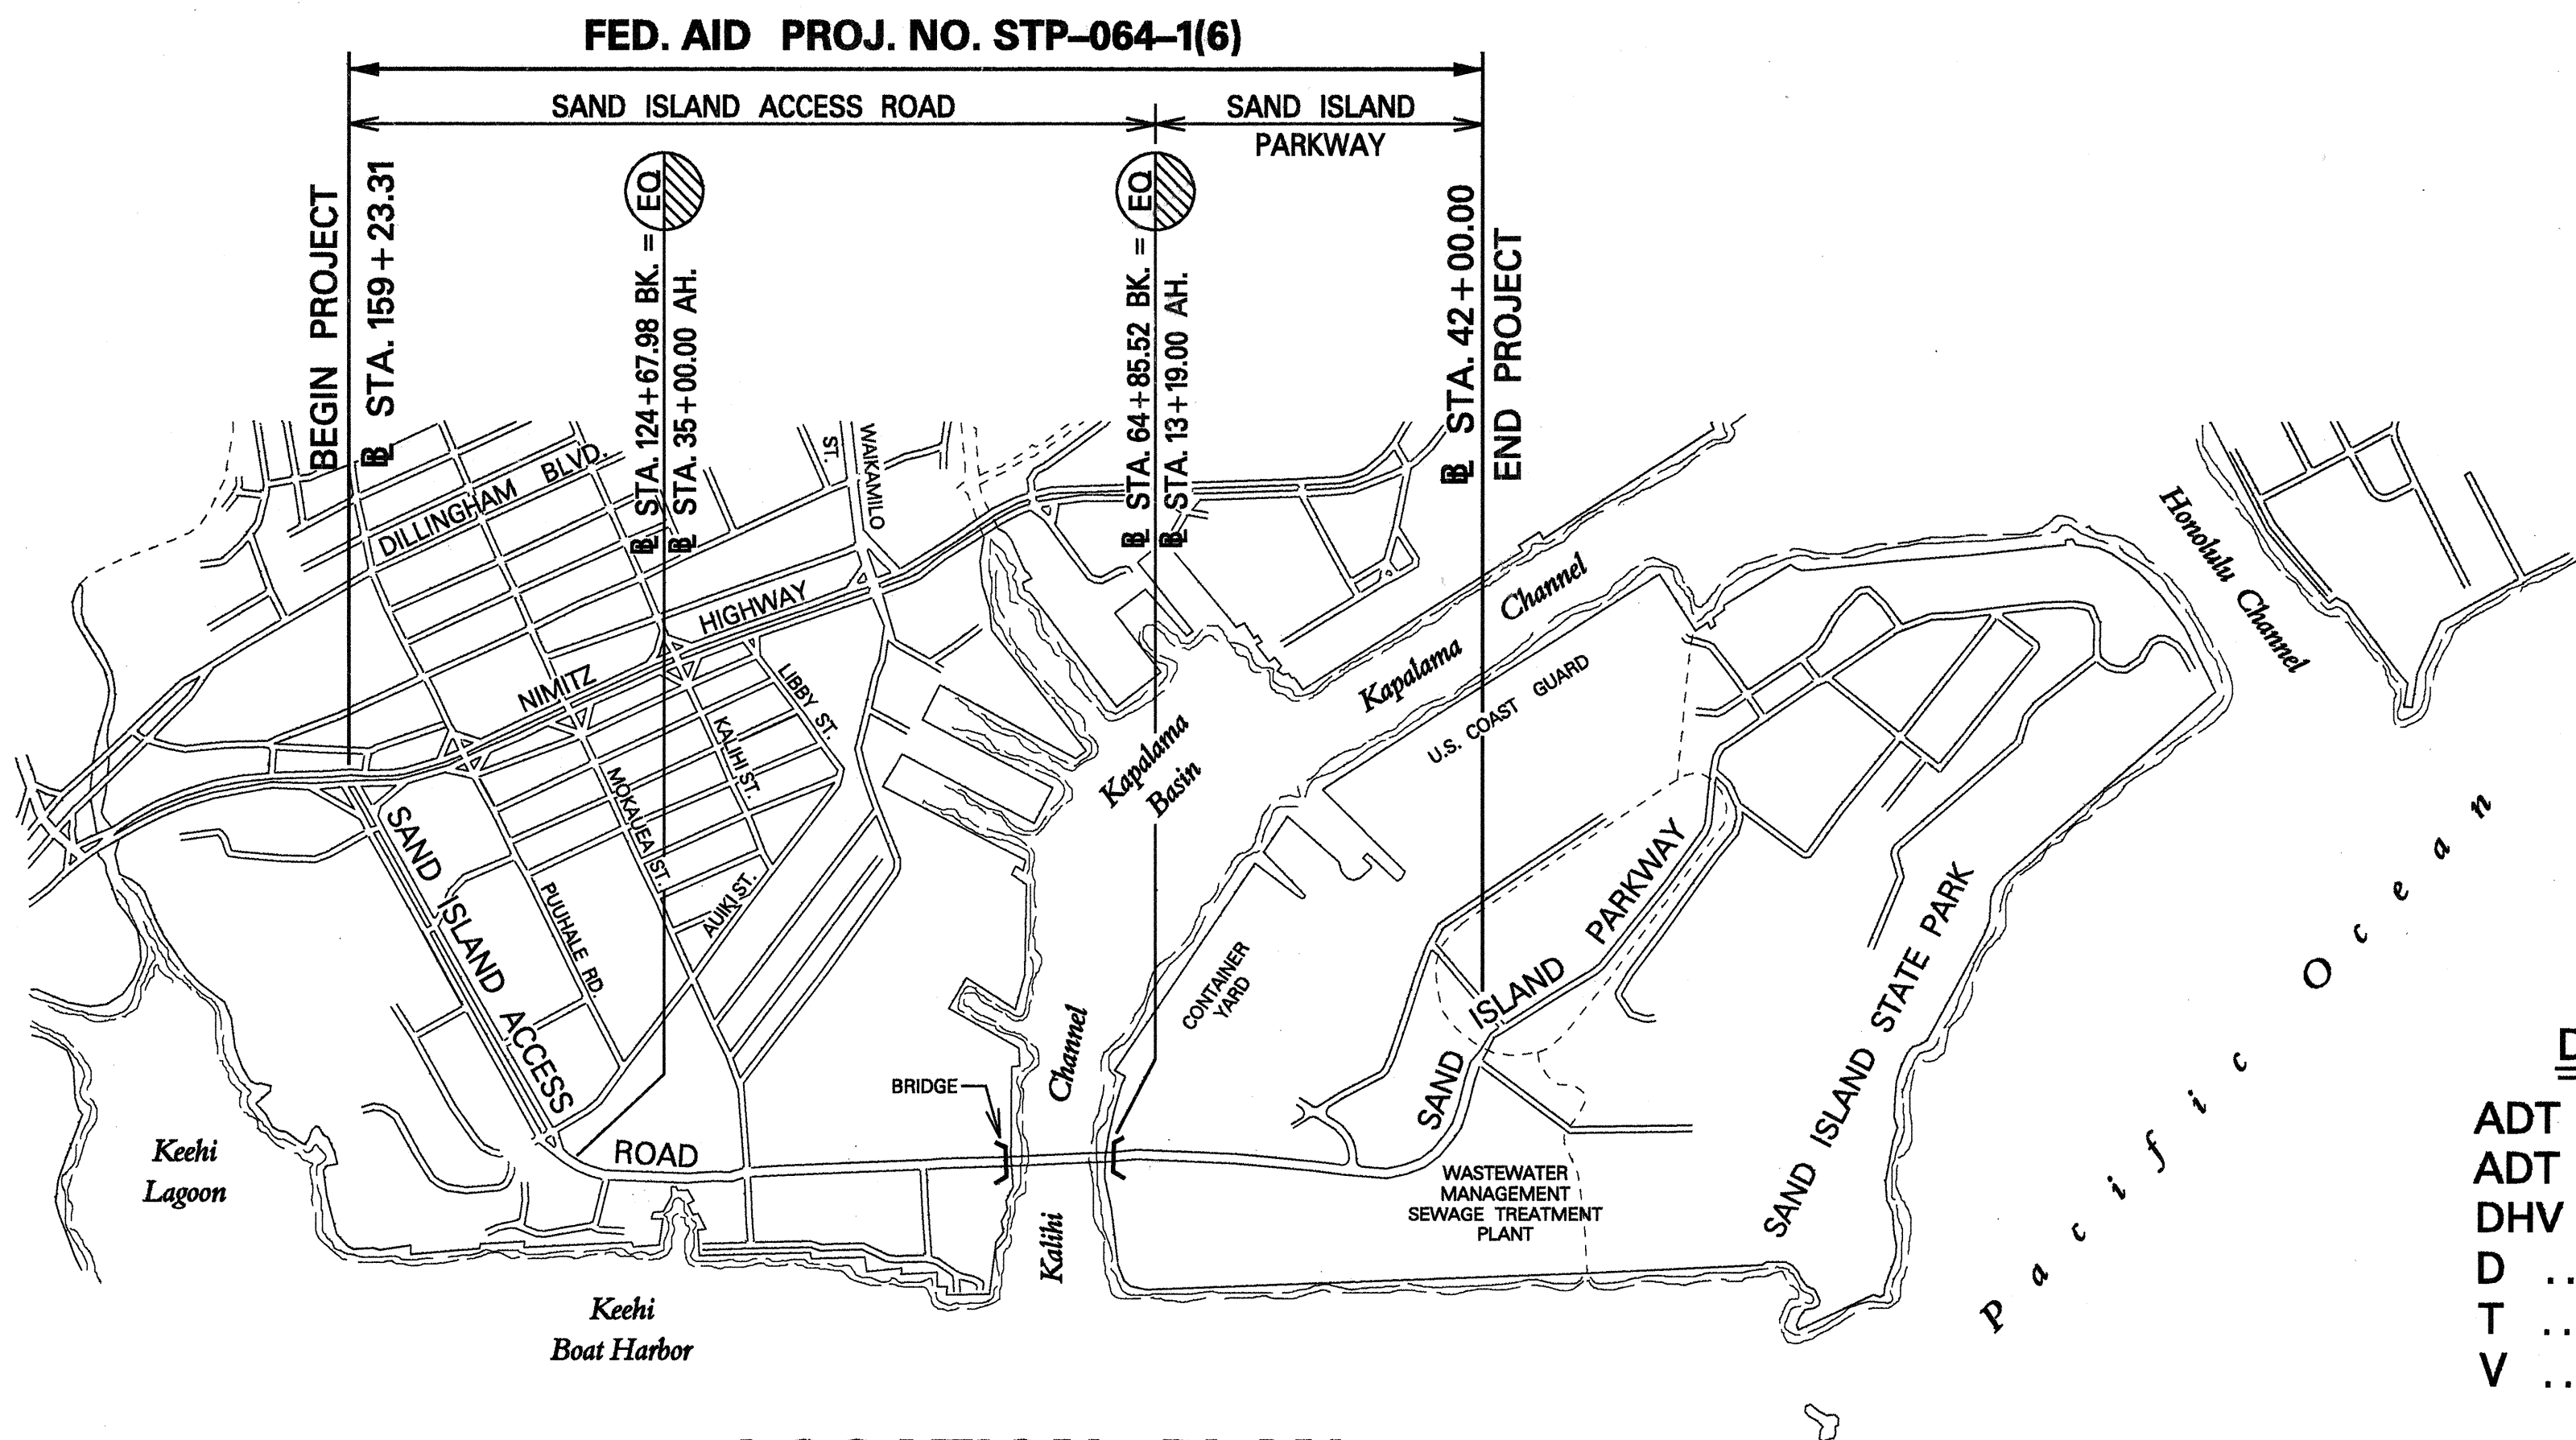



LOCATION PLAN

GROSS LENGTH OF PROJECT.....1.730 MILES


NET LENGTH OF PROJECT.....1.650 MILES

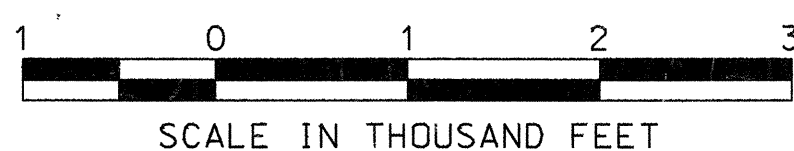

FED. ROAD DIST. NO.	STATE	FED. AID PROJ. NO.	FISCAL YEAR	SHEET NO.	TOTAL SHEETS
HAWAII	HAW.	STP-064-1(6)	1994	1	25

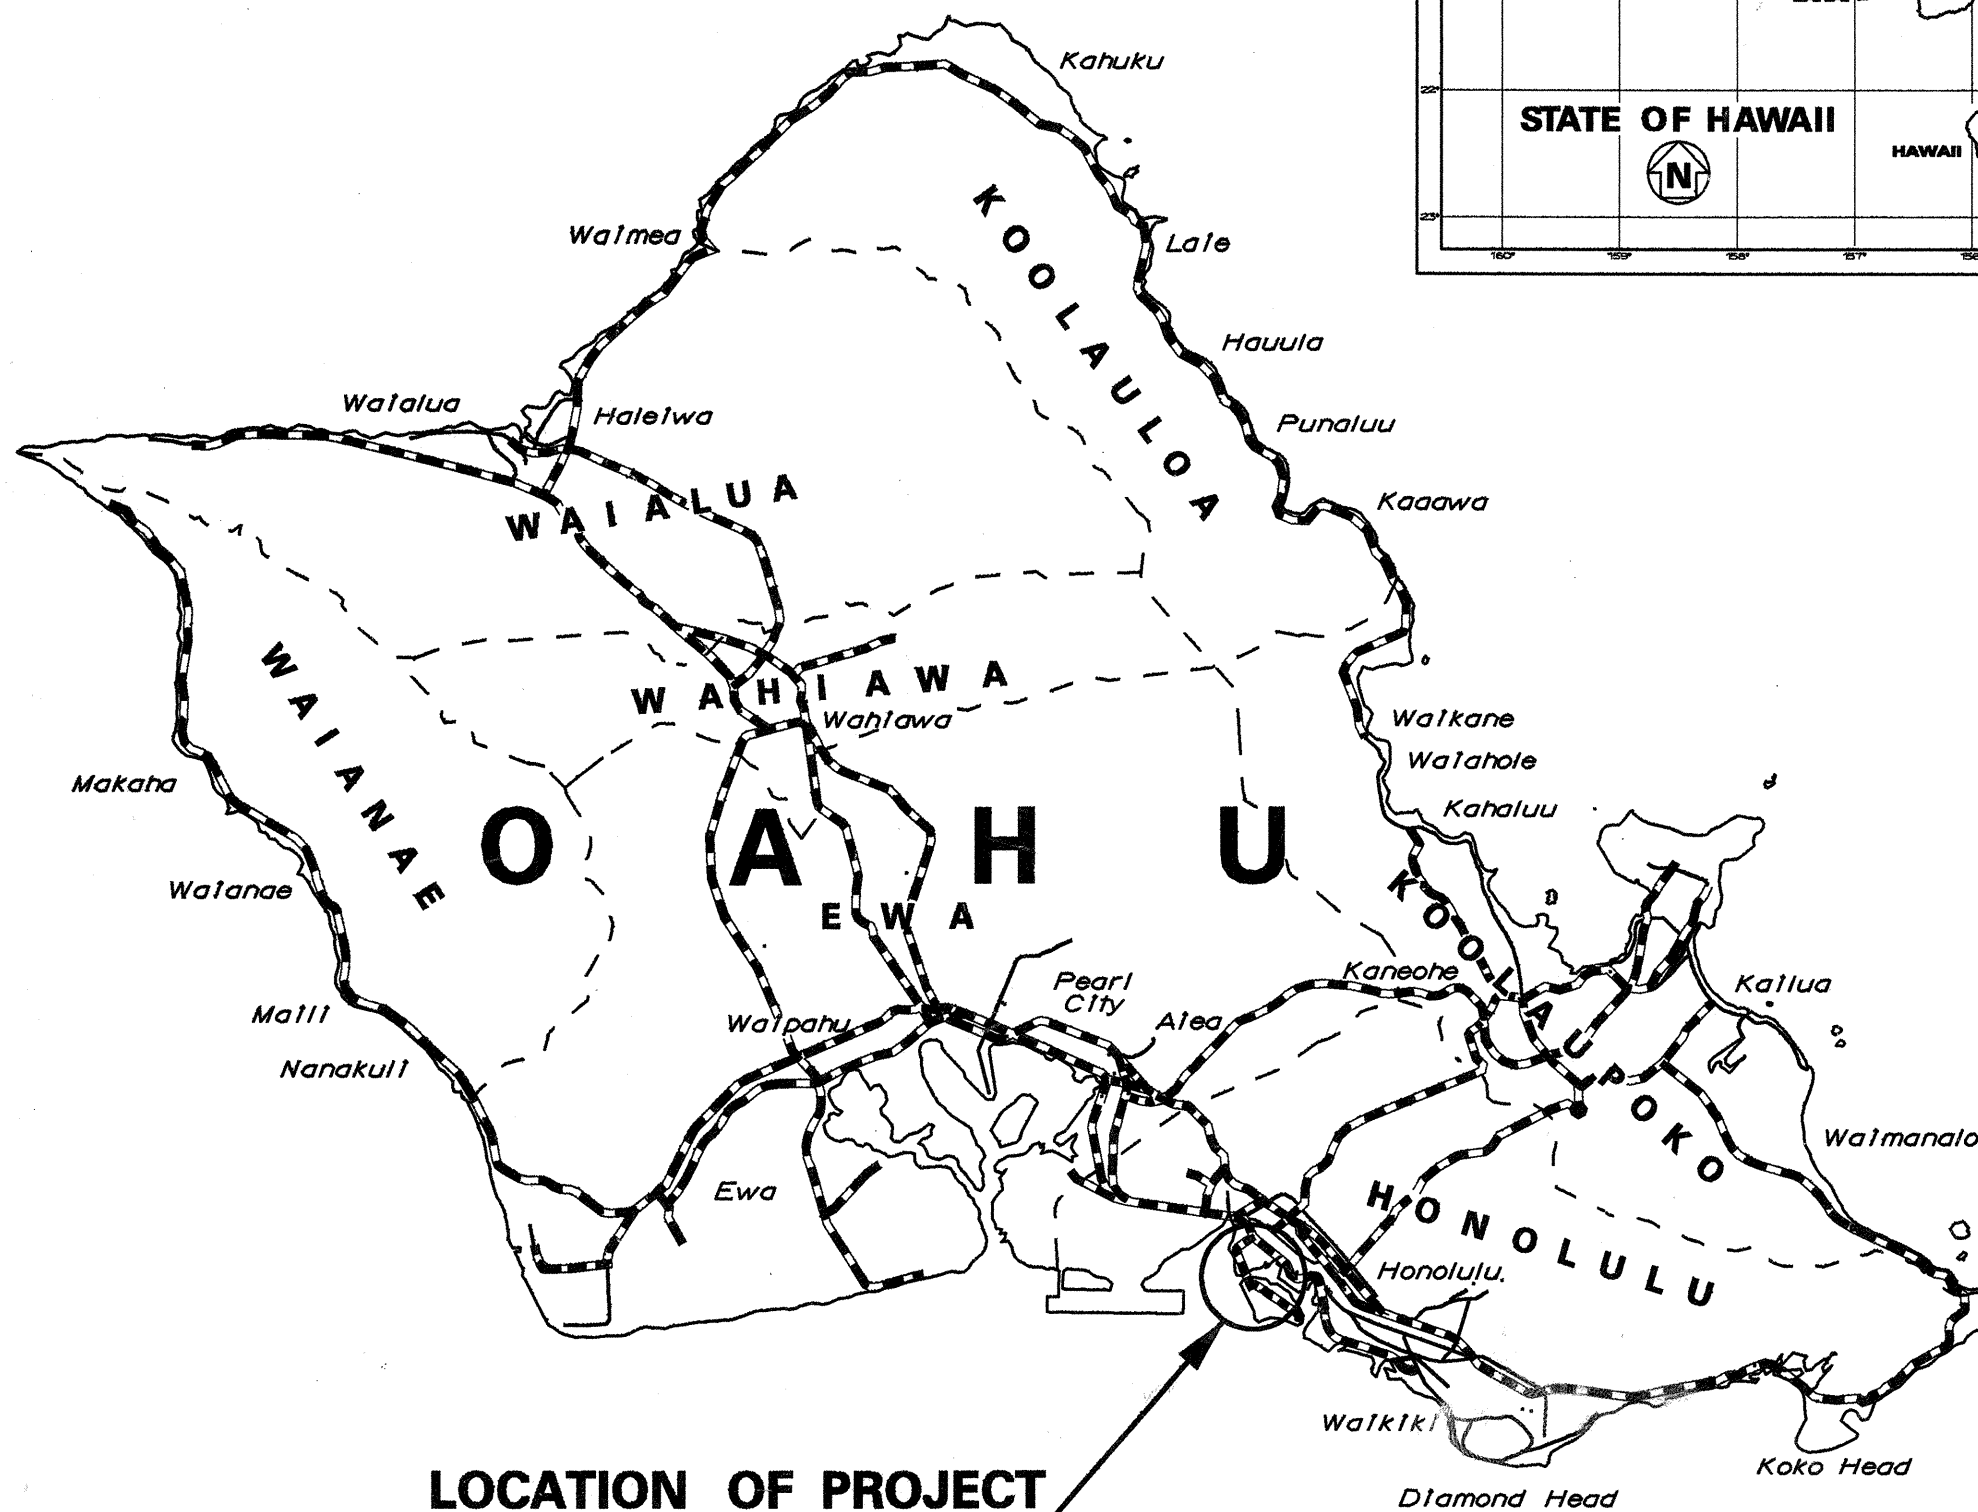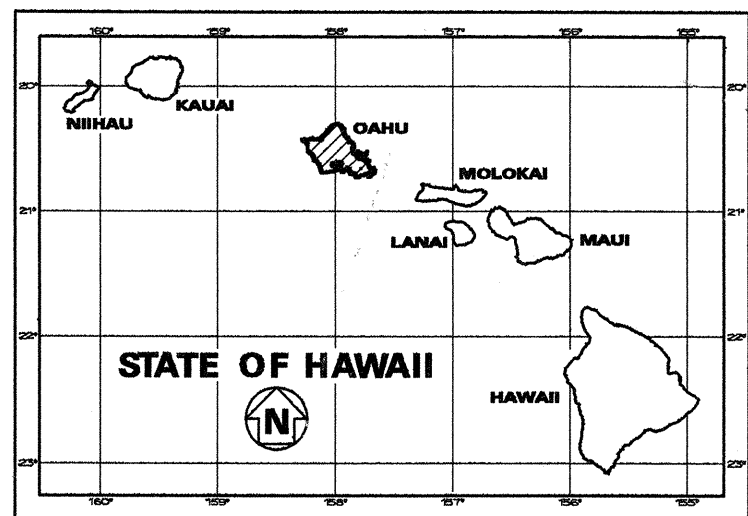

LOCATION OF PROJECT

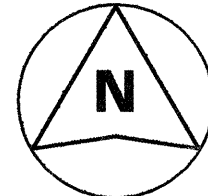

----- FEDERAL AID PROJECTS PREVIOUSLY CONSTRUCTED OR UNDER CONSTRUCTION

MILE POST 0.880 TO MILE POST 2.610

DESIGN DESIGNATION

ADT (1994).....23,300

ADT (2014).....34,500

DHV 3,100

D70/30

T 15.5 %

V 25 M.P.H.

CHANGES MADE DURING CONSTRUCTION HAVE BEEN INCORPORATED ON THESE PLANS EXCEPT CHANGES IN THE ORIGINAL THEORETICAL QUANTITIES. FOR ACTUAL QUANTITIES, REFER TO PROJECT LEDGER AND/OR COMPUTATION BOOK.

[Signature] 4/29/01
RESIDENT ENGINEER DATE

DEPARTMENT OF TRANSPORTATION

STATE OF HAWAII

APPROVED:

[Signature] 4/3/05

DIR. OF TRANSPORTATION DATE

DESIGN UNIT "E"

DESIGNED BY

R. TAKAESU

P. S. & E. BY

587-2249

PHONE

JAN., 1994

DATE