



FED. ROAD DIST. NO.	STATE	FED. AID PROJ. NO.	FISCAL YEAR	SHEET NO.	TOTAL SHEETS
HAWAII	HAW.	STP-064-1(6)	1994	5	25

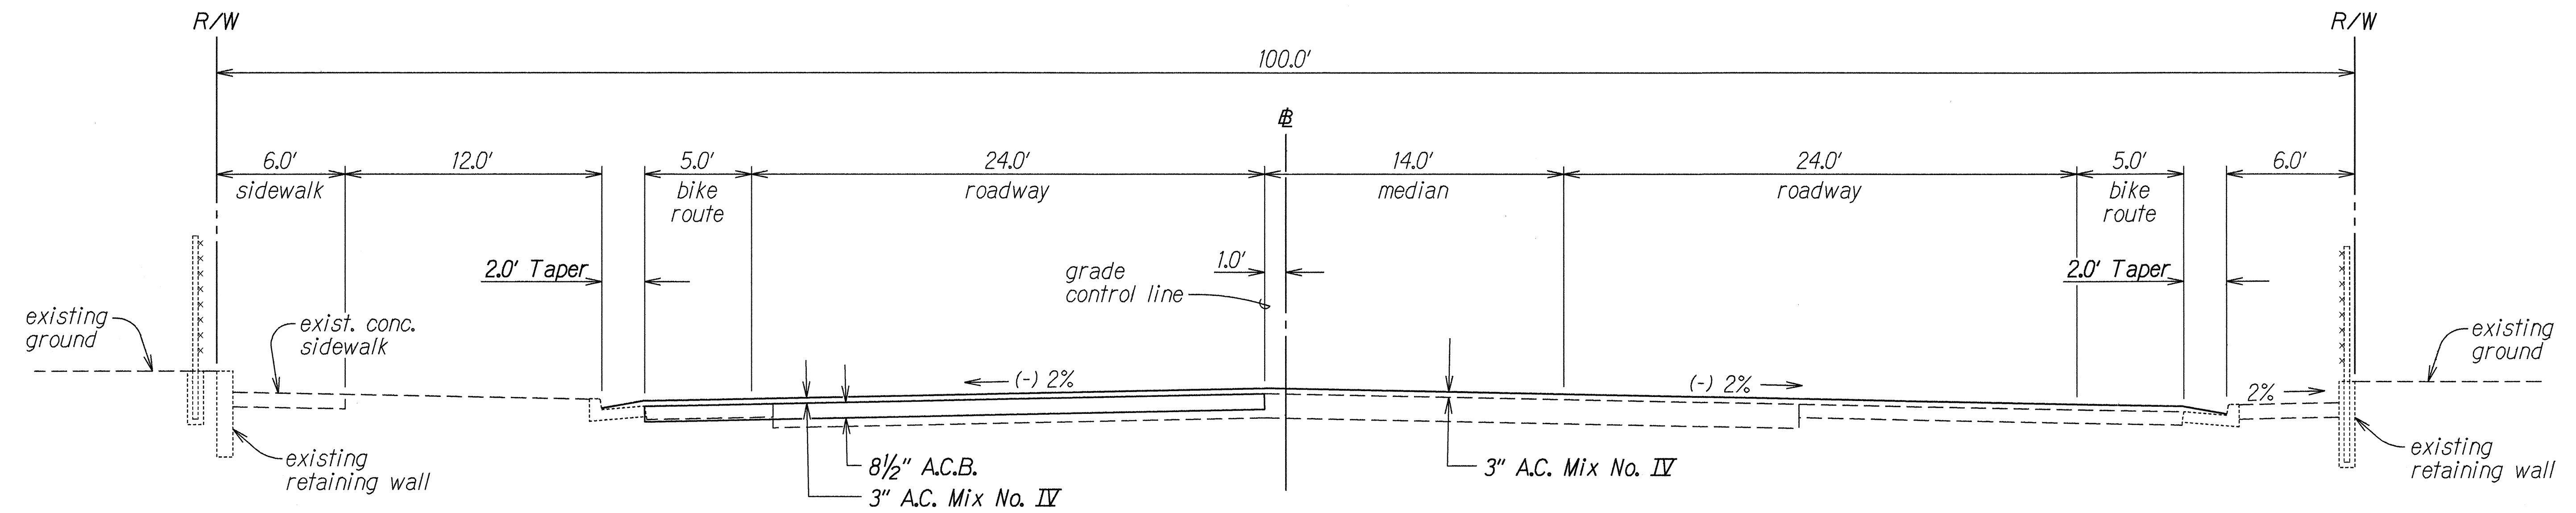

SAND ISLAND ACCESS ROAD
TYPICAL SECTION

Sta. 35+00 to Bridge
Scale: 1/4" = 1'-0"

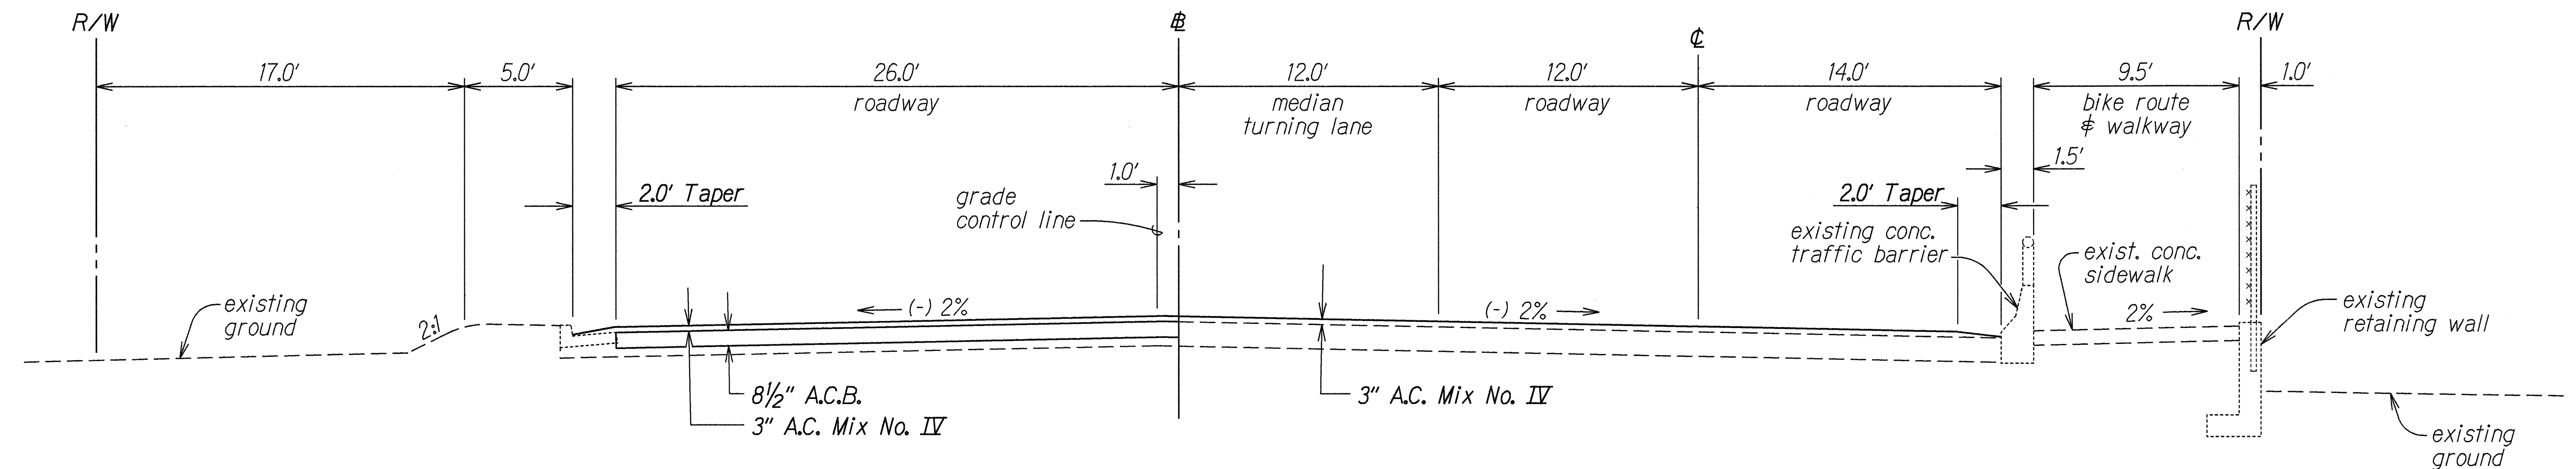

SAND ISLAND PARKWAY
TYPICAL SECTION

Bridge to Sta. 30+00
Scale: 1/4" = 1'-0"

Notes

1. For Curb Taper Details See Detail A, Plan Sheet No. 6
2. For Curb and Gutter Taper Details See Detail B, Plan Sheet No. 6

SURVEY PLOTTED BY	DATE
DRAWN BY	16-10-94
TRACED BY	
CHECKED BY	
ORIGINAL PLAN	
NOTE BOOK	
DATE	
BY	

STATE OF HAWAII
DEPARTMENT OF TRANSPORTATION
HIGHWAYS DIVISION


TYPICAL SECTION

**SAND ISLAND ACCESS ROAD AND
SAND ISLAND PARKWAY RESURFACING**
Nimitz Highway to Sewage Treatment Plant
Fed. Aid Project No. STP-064-1(6)

Scale: As Shown Date: March, 1994

SHEET No. 1 OF 4 SHEETS

FED. ROAD DIST. NO.	STATE	FED. AID PROJ. NO.	FISCAL YEAR	SHEET NO.	TOTAL SHEETS
HAWAII	HAW.	STP-064-1(6)	1994	6	25


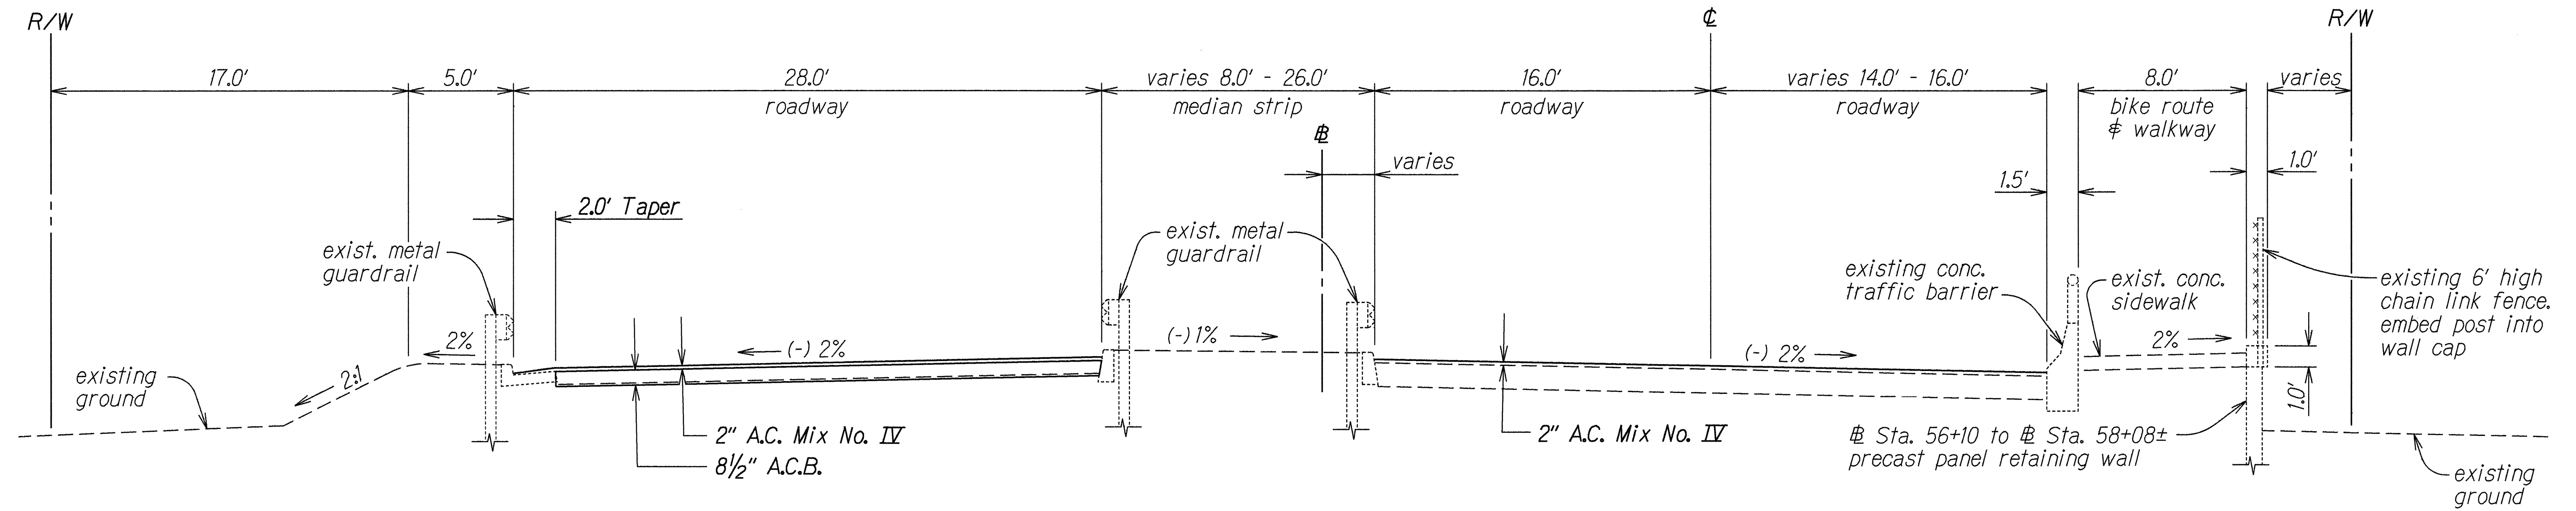


SAND ISLAND PARKWAY
TYPICAL SECTION

Sta. 30+00 to Sta. 40+00
Scale: 1/4" = 1'-0"

Notes

1. For Curb Taper Details See Detail A, Plan Sheet No. 6
2. For Curb and Gutter Taper Details See Detail B, Plan Sheet No. 6

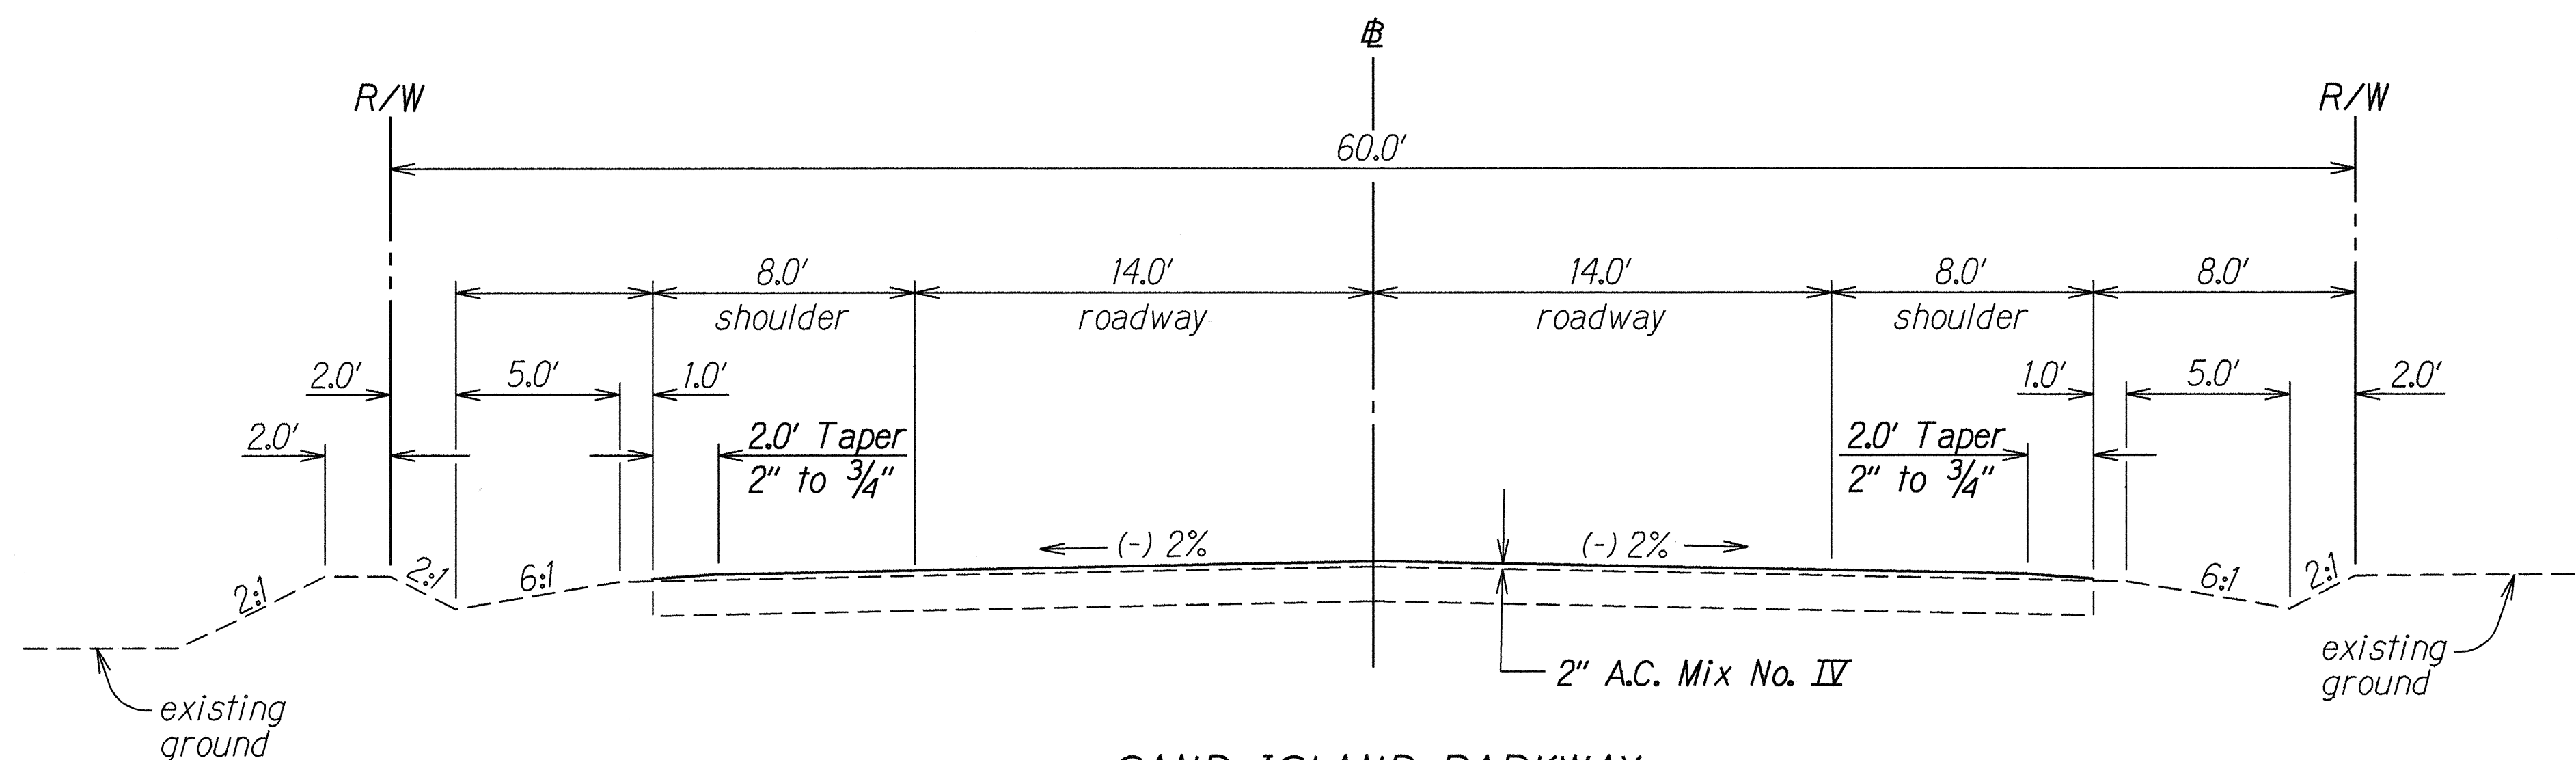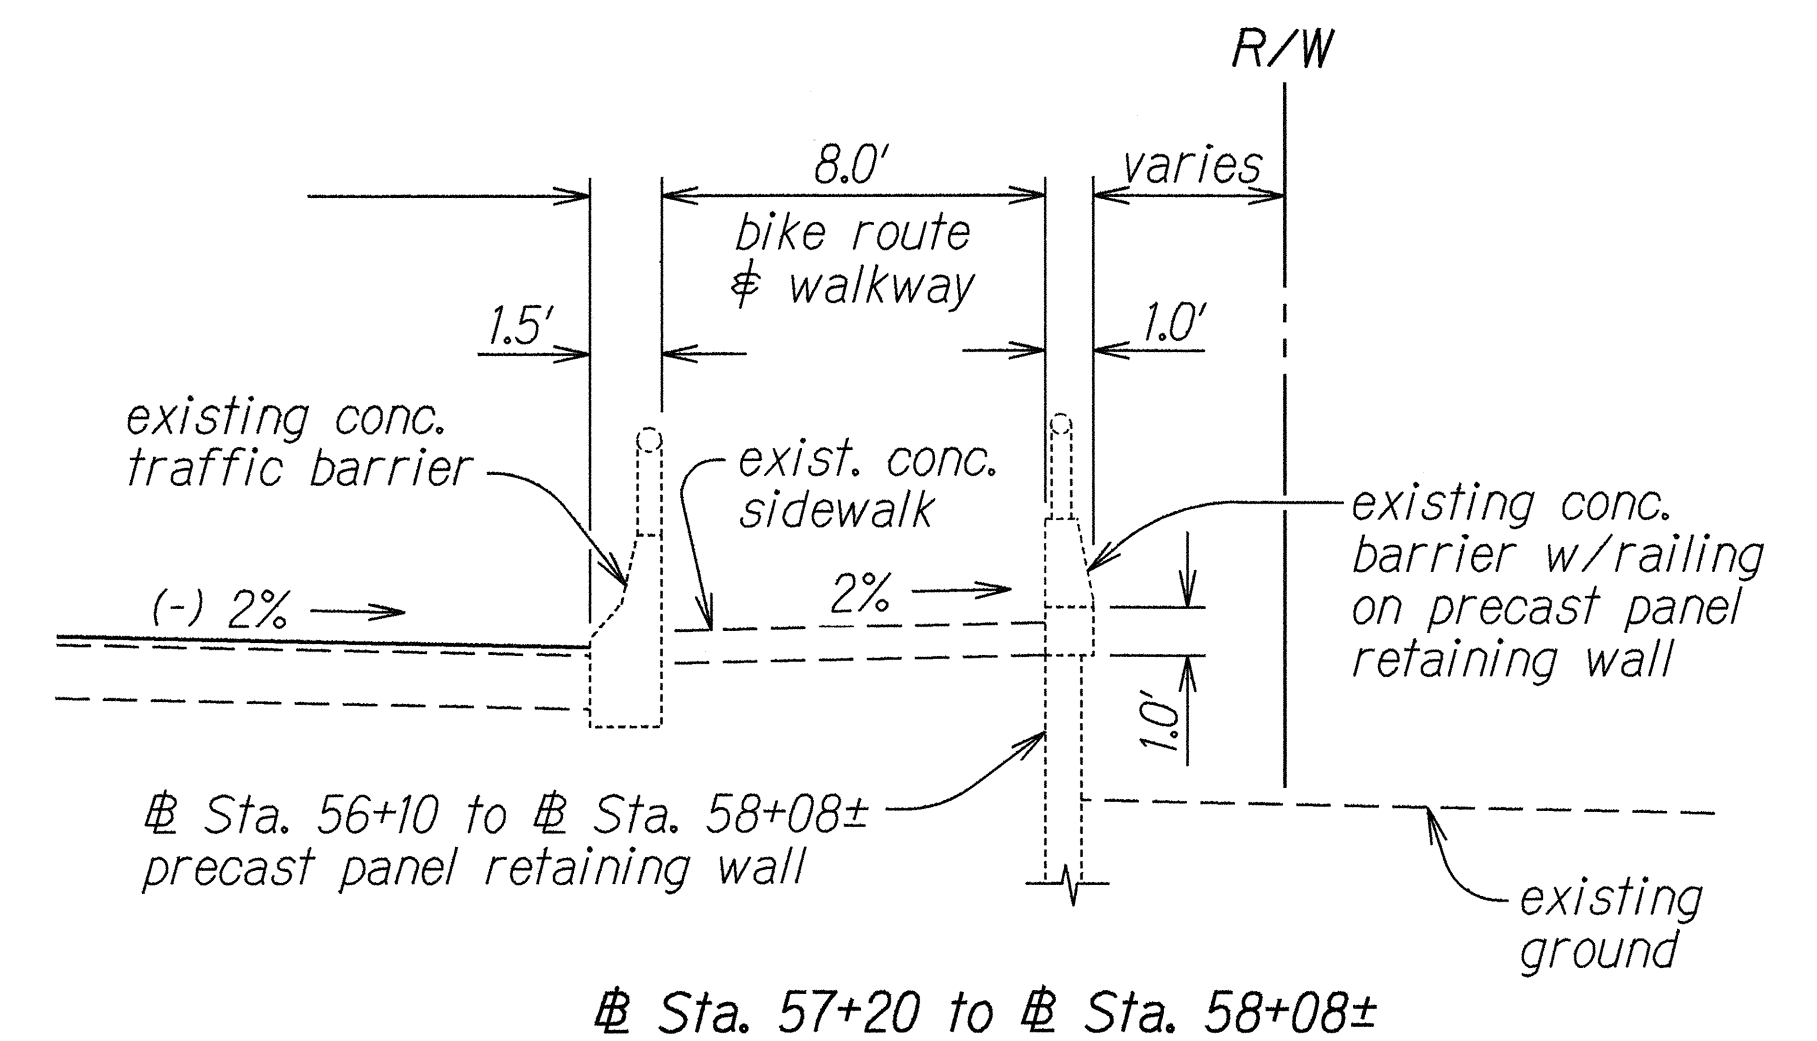

SAND ISLAND PARKWAY
TYPICAL SECTION

Sta. 40+00 to Sta. 42+00±
Scale: 1/4" = 1'-0"

STATE OF HAWAII
DEPARTMENT OF TRANSPORTATION
HIGHWAYS DIVISION

TYPICAL SECTION

**SAND ISLAND ACCESS ROAD AND
SAND ISLAND PARKWAY RESURFACING**

Nimitz Highway to Sewage Treatment Plant



Fed. Aid Project No. STP-064-1(6)

Scale: As Shown Date: March, 1994





SHEET No. 2 OF 4 SHEETS

ORIGINAL PLAN	DATE
16-00-94	
SURVEY PLOTTED BY	
DRAWN BY J. Matsunaga	
TRACED BY B. Takasawa	
QUANTITIES BY	
CHECKED BY	
NOTE BOOK	
004,000	
N. 3000/02	

FED. ROAD DIST. NO.	STATE	FED. AID PROJ. NO.	FISCAL YEAR	SHEET NO.	TOTAL SHEETS
HAWAII	HAW.	STP-064-1(6)	1994	7	25

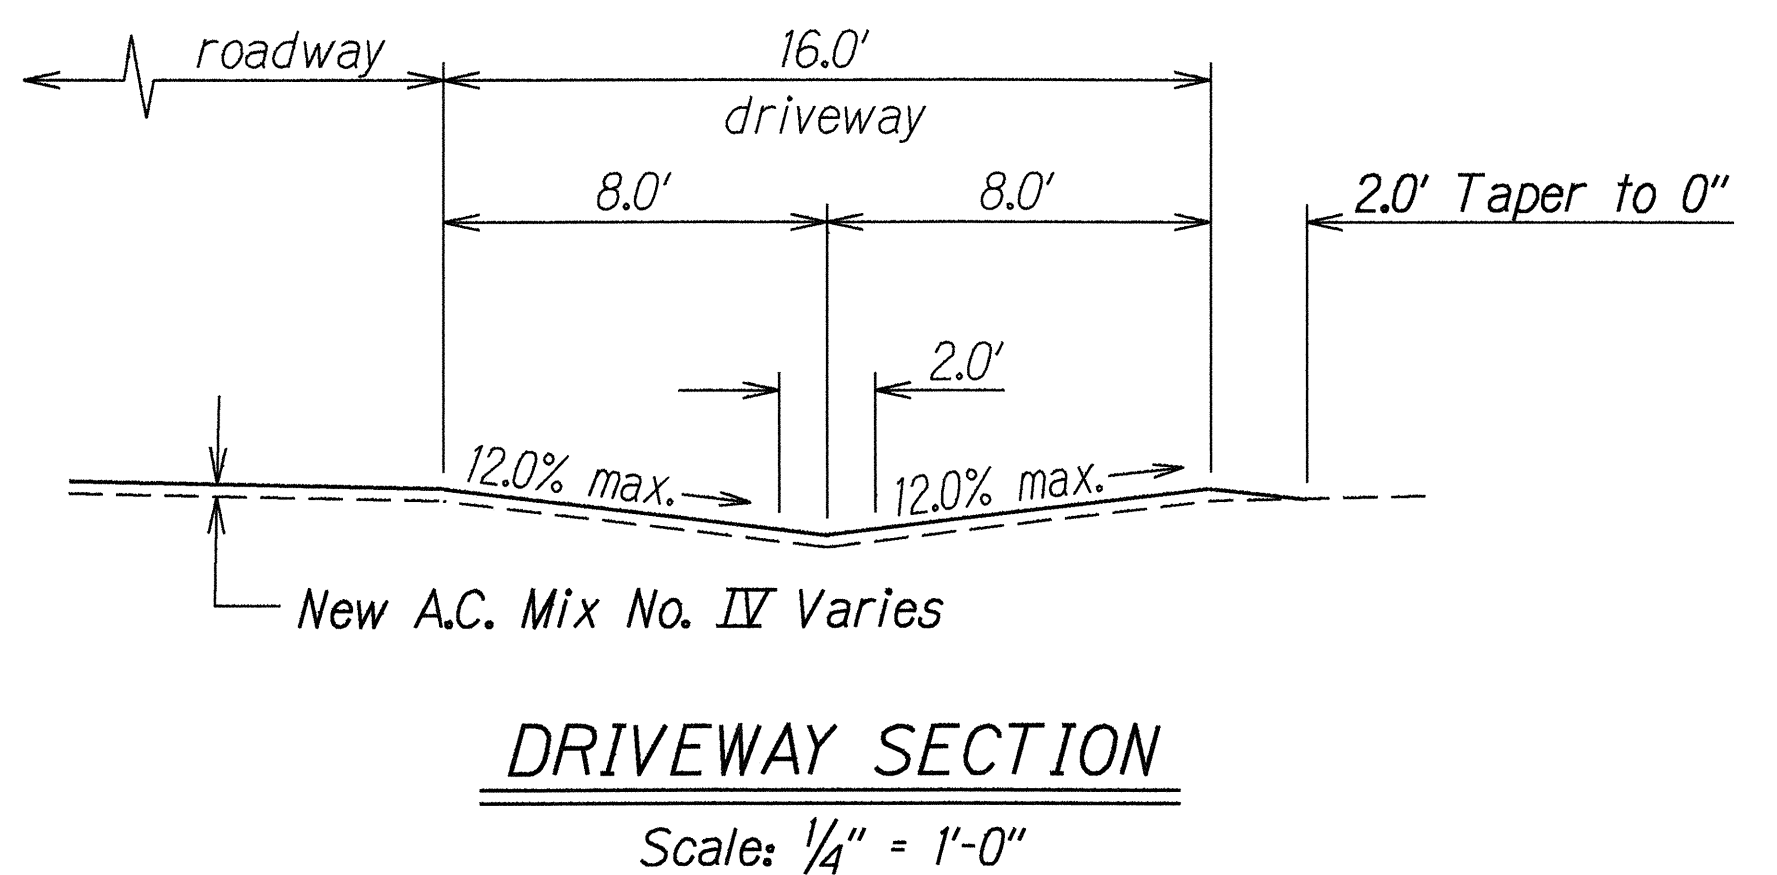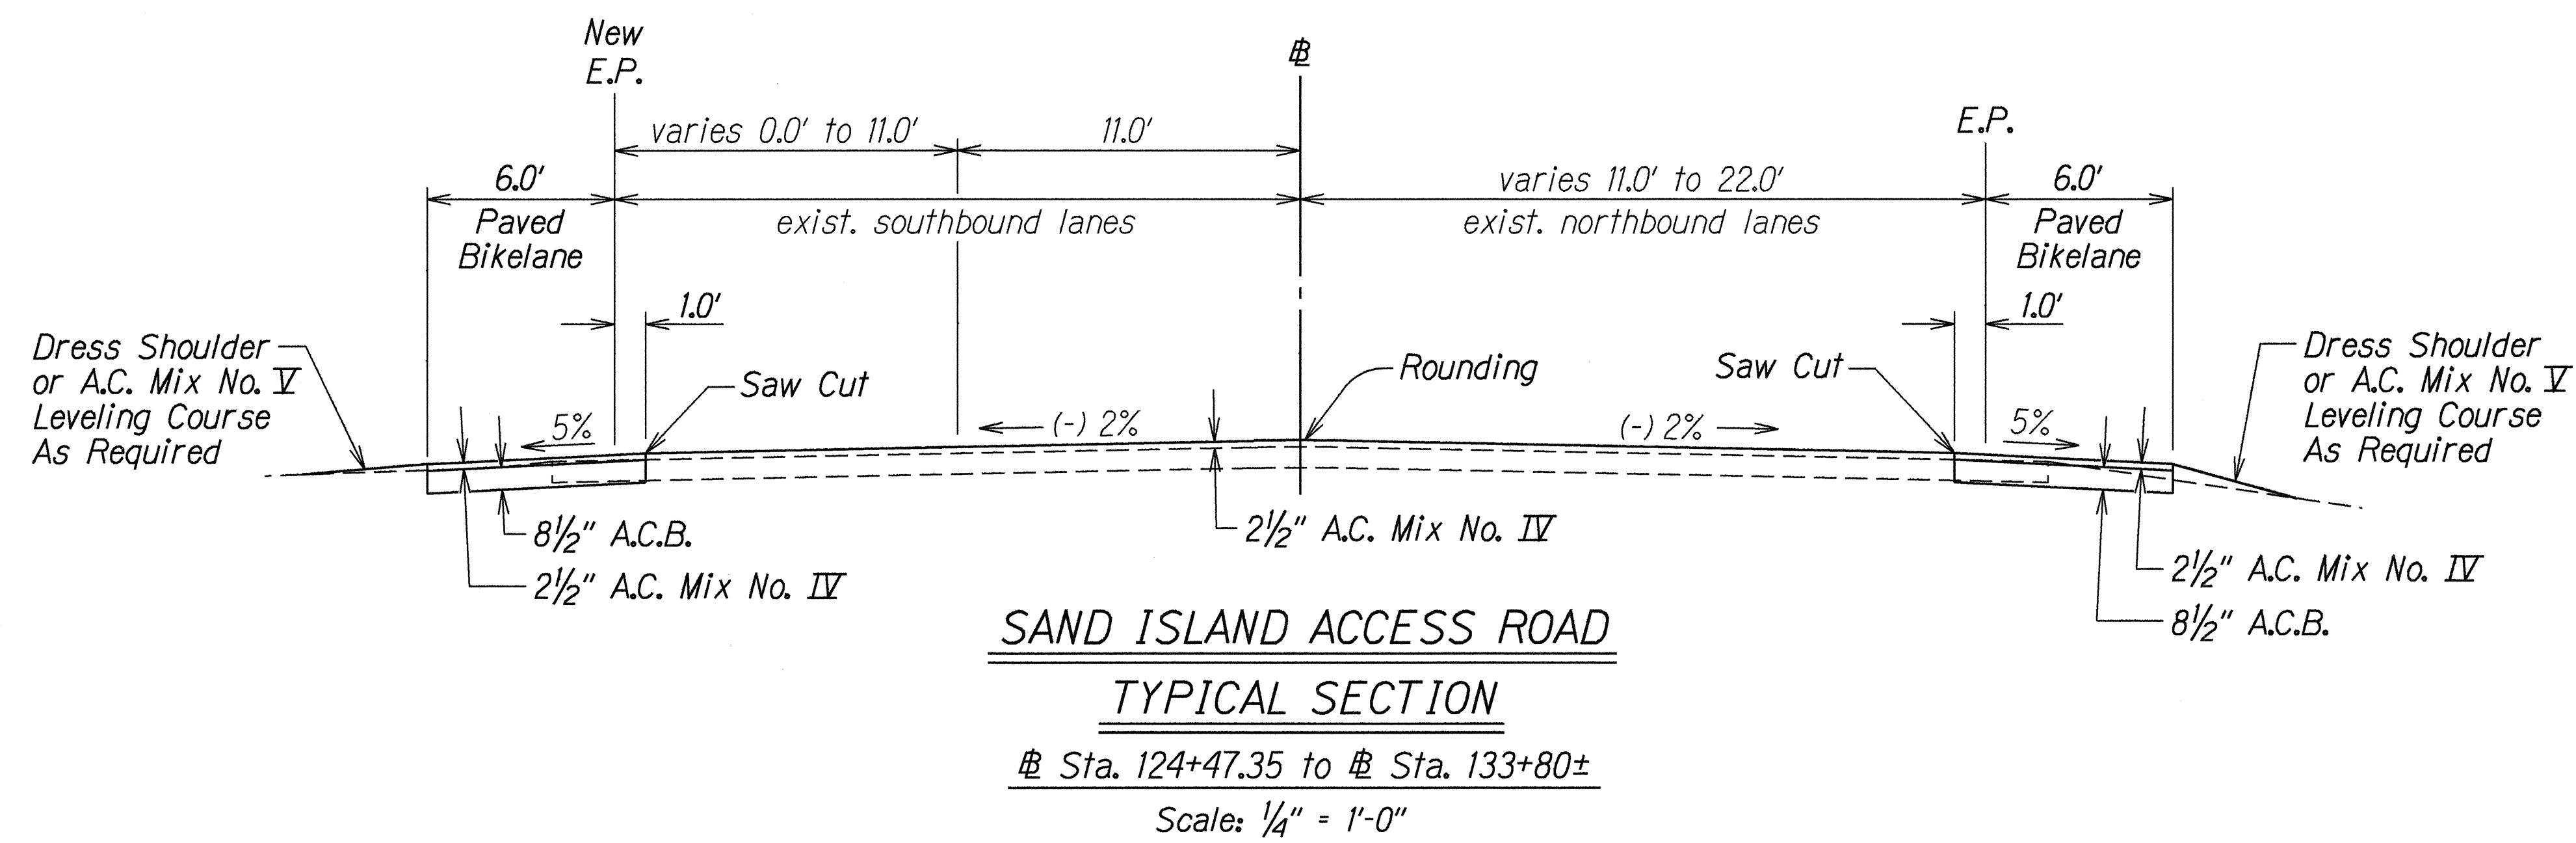

- Notes:**
- Sta. 49+10 to 42+90 I.B., Replace 1 1/2" Chemcrete overlay with 1 1/2" A.C. Mix No. IV then overlay with 2 1/2" A.C. Mix No. IV.

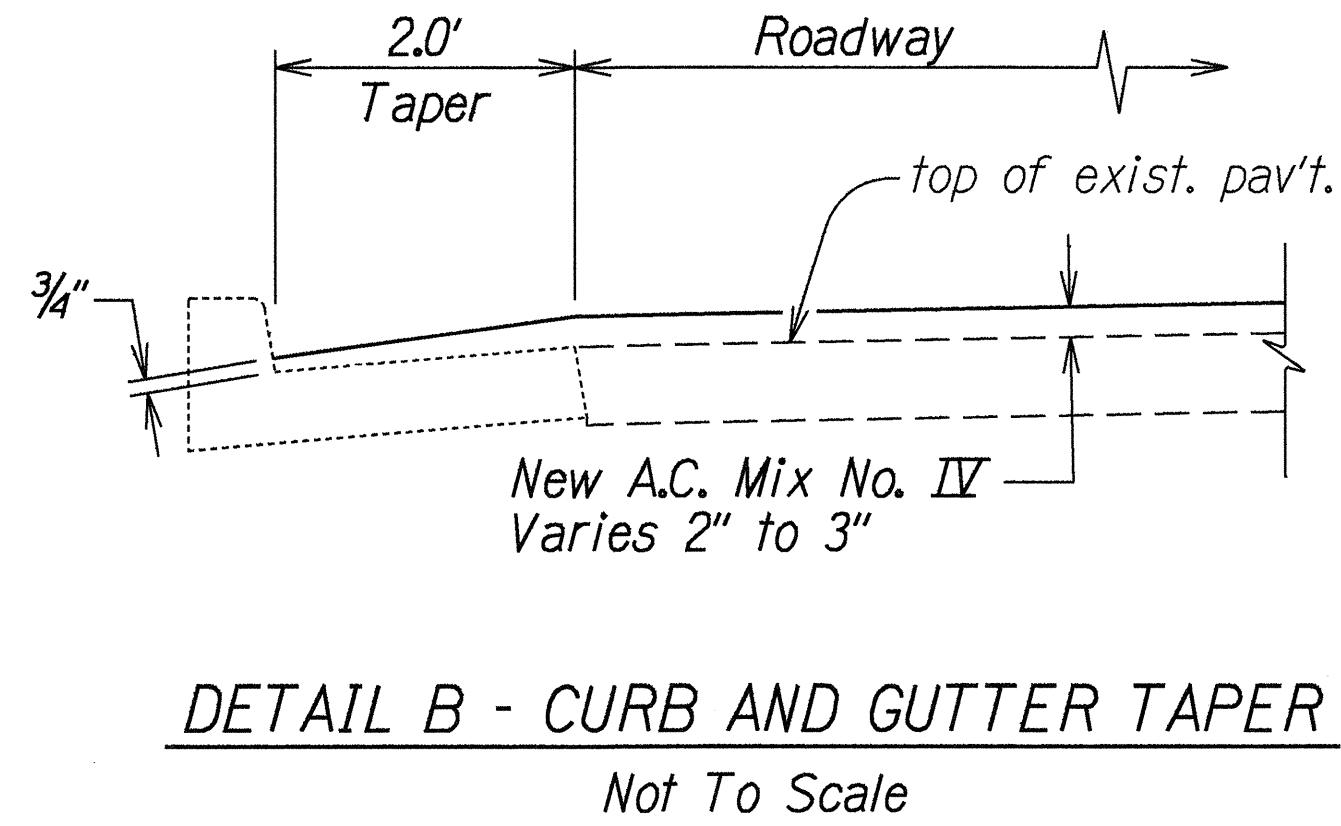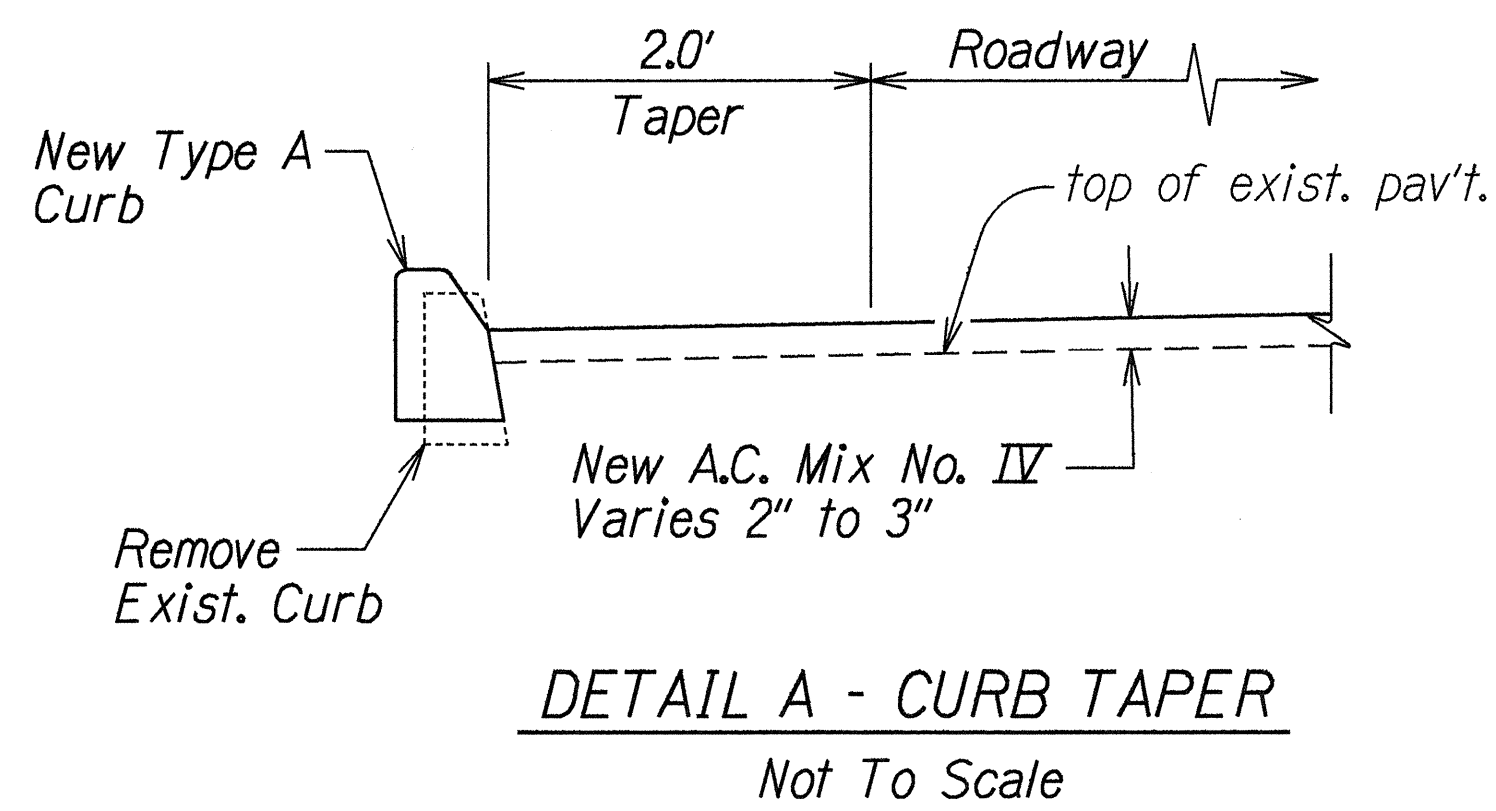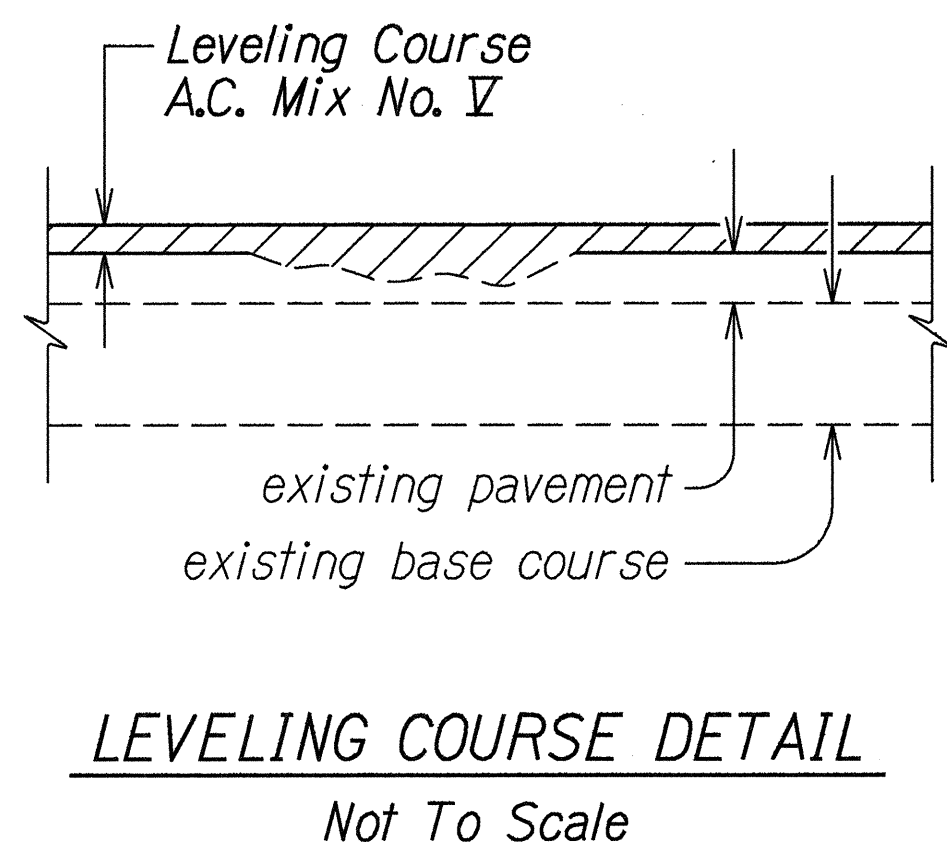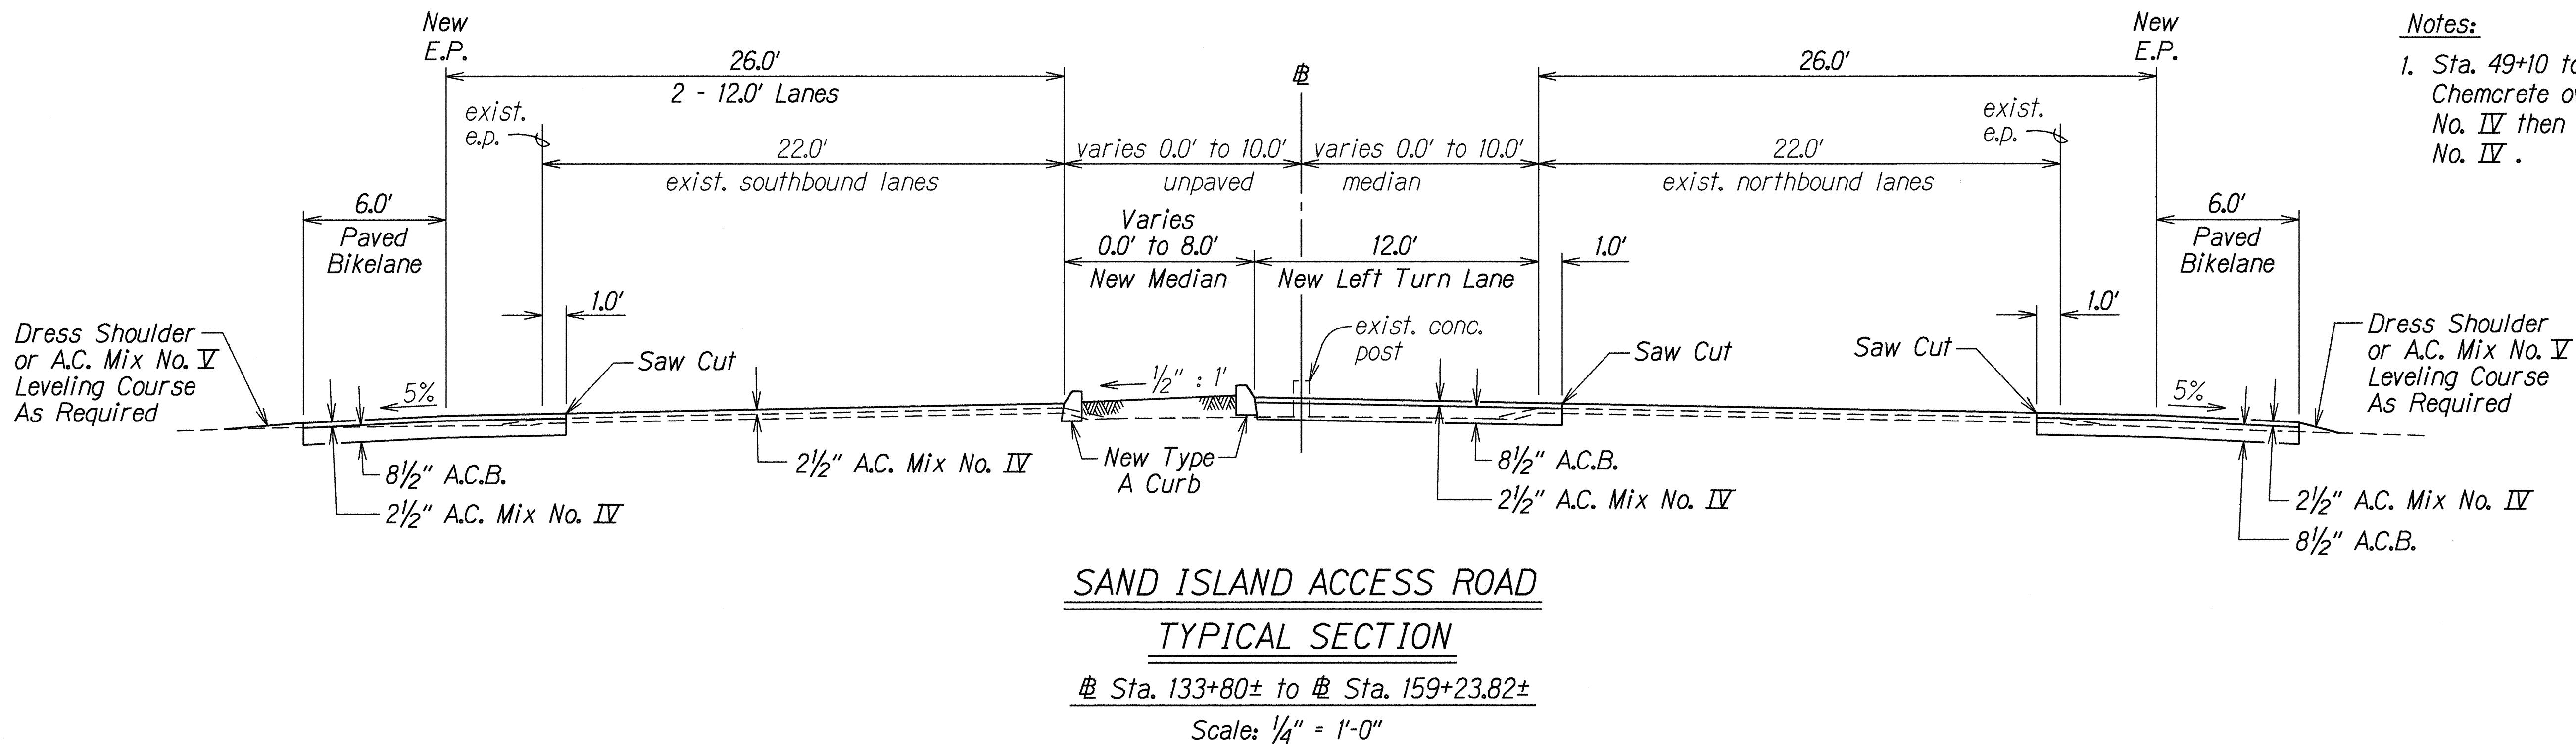

STATE OF HAWAII

DEPARTMENT OF TRANSPORTATION

HIGHWAYS DIVISION

TYPICAL SECTION

SAND ISLAND ACCESS ROAD AND

SAND ISLAND PARKWAY RESURFACING

Sewage Treatment Plant to Nimitz Highway

Fed. Aid Project No. STP-064-1(6)

Scale: As Shown

Date: March, 1994


SHEET No. 3

OF 4


SHEETS

ORIGINAL PLAN	DATE
SURVEY PLATTED BY	10-23-94
DRAWN BY	J. Matsunami
CHECKED BY	
NOTED BY	
QUANTITIES BY	
CHECKED BY	
DATE	






FED. ROAD DIST. NO.	STATE	FED. AID PROJ. NO.	FISCAL YEAR	SHEET NO.	TOTAL SHEETS
HAWAII	HAW.	STP-064-1(6)	1994	8	25

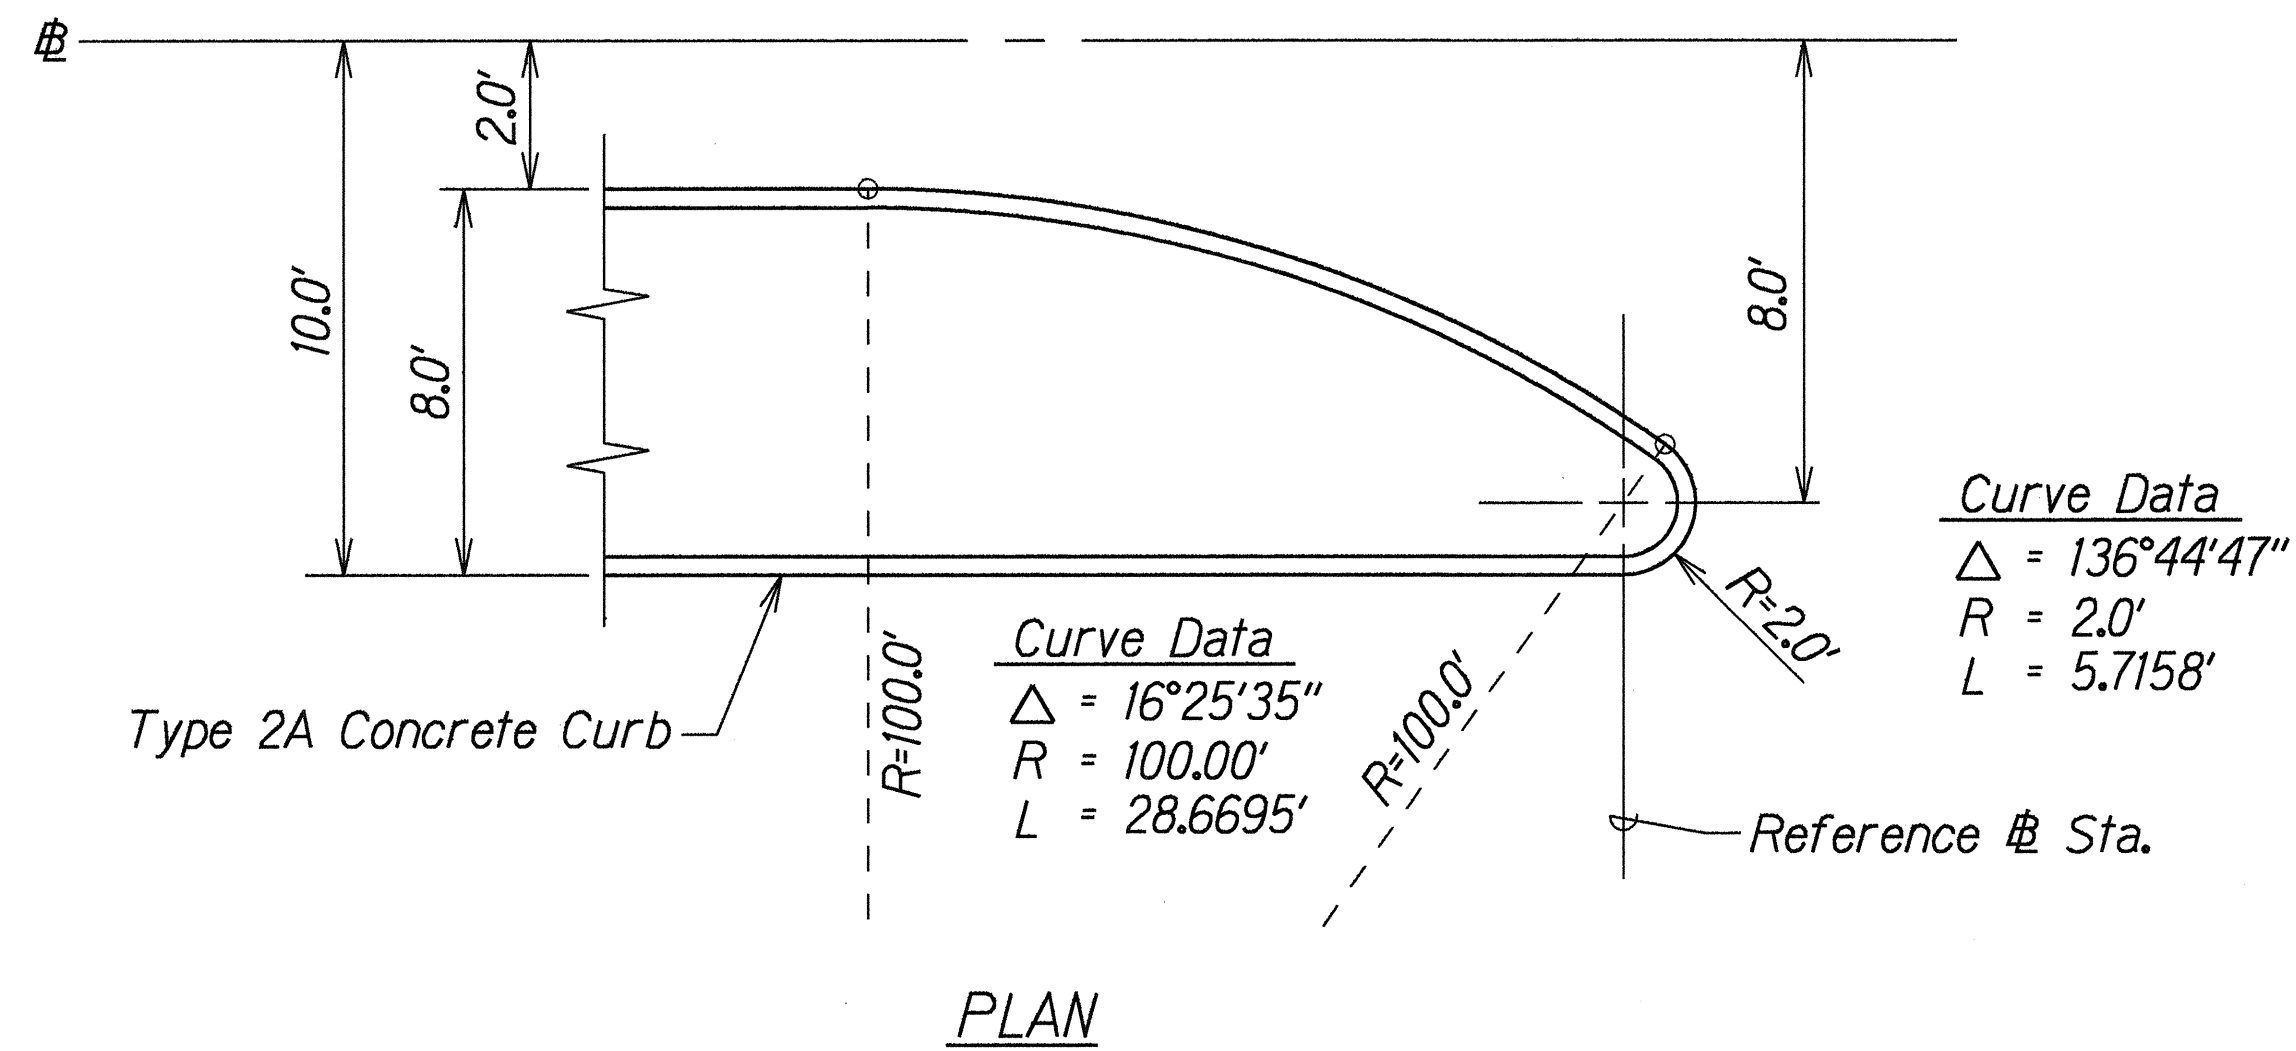

TYPICAL NOSE MEDIAN DETAIL
 AT STA. 154+78 AND STA. 152+93 AND STA. 152+07
 Not to Scale

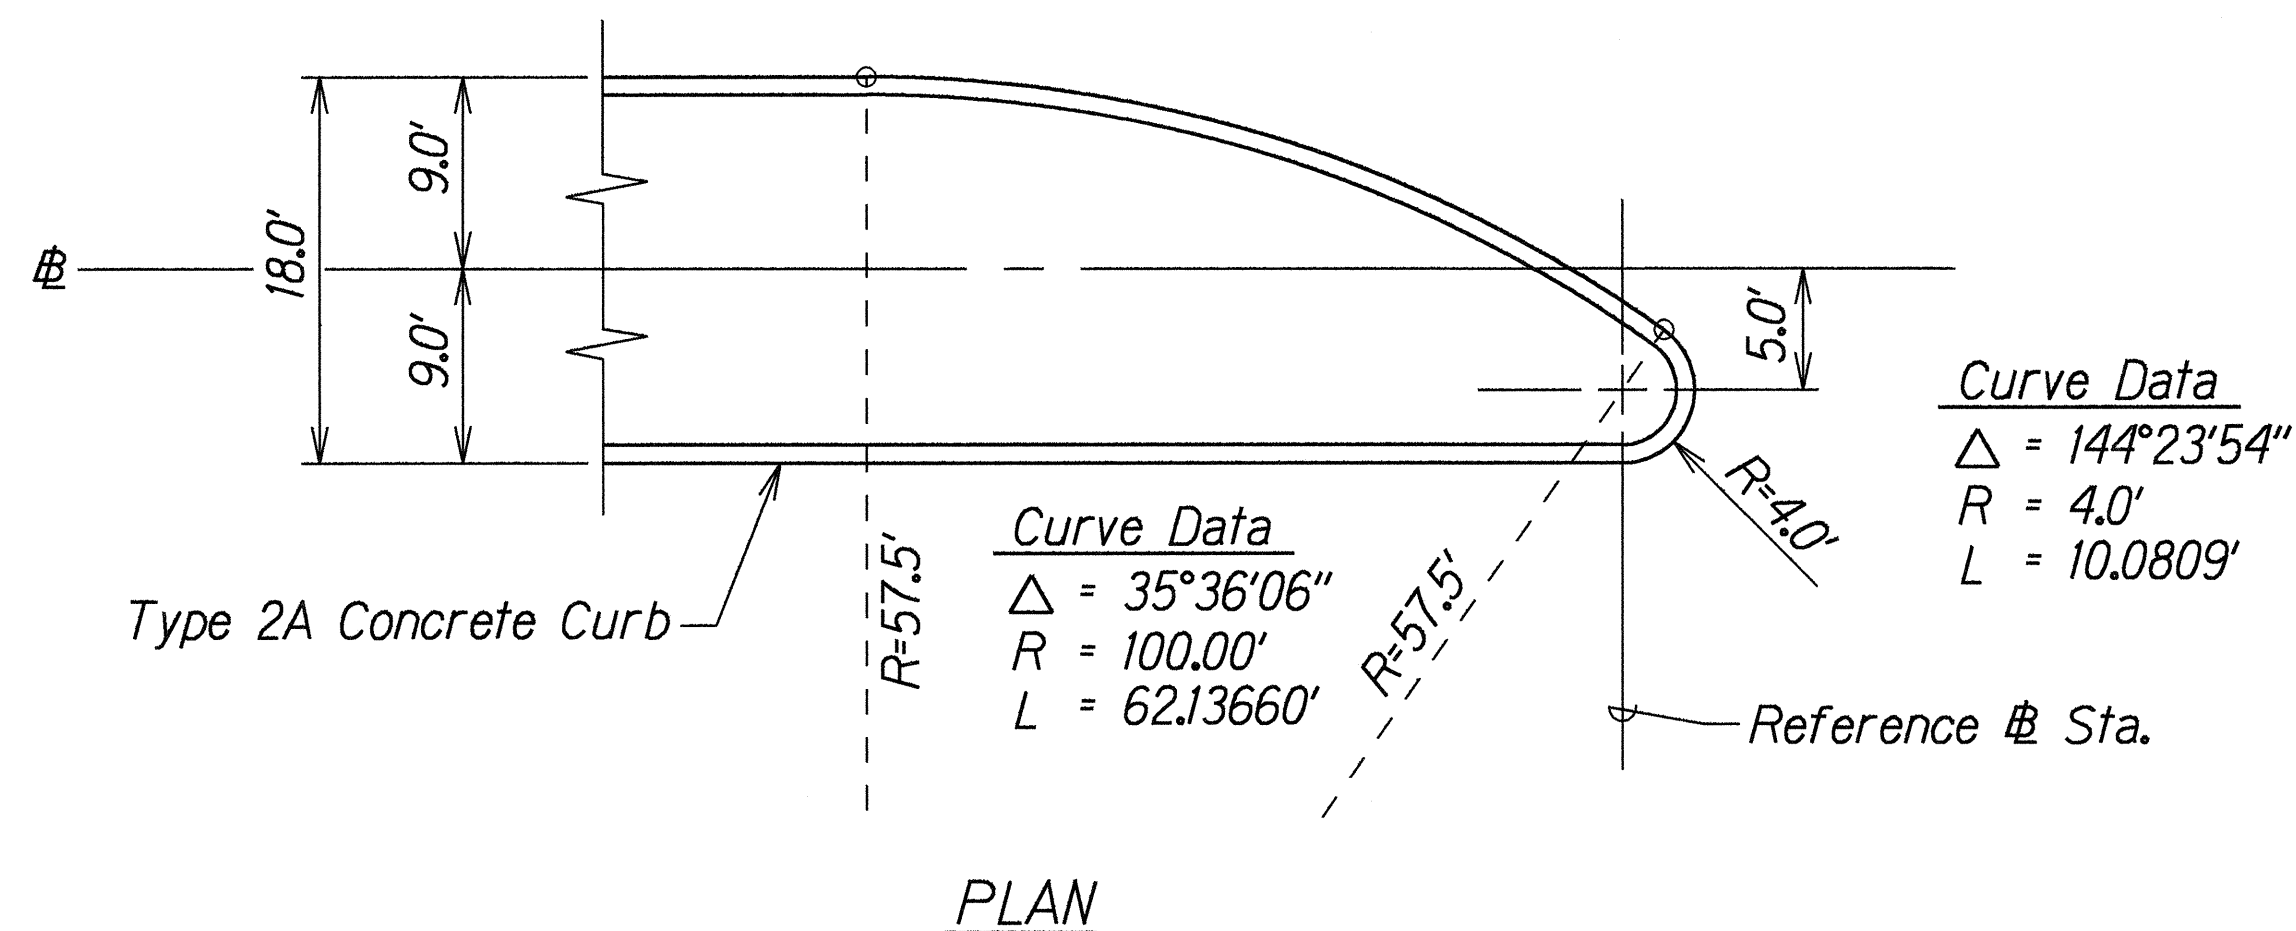

SAND ISLAND ACCESS ROAD NOSE MEDIAN DETAIL
 AT STA. 142+96 AND STA. 155+79 AND STA. 158+36
 Not to Scale

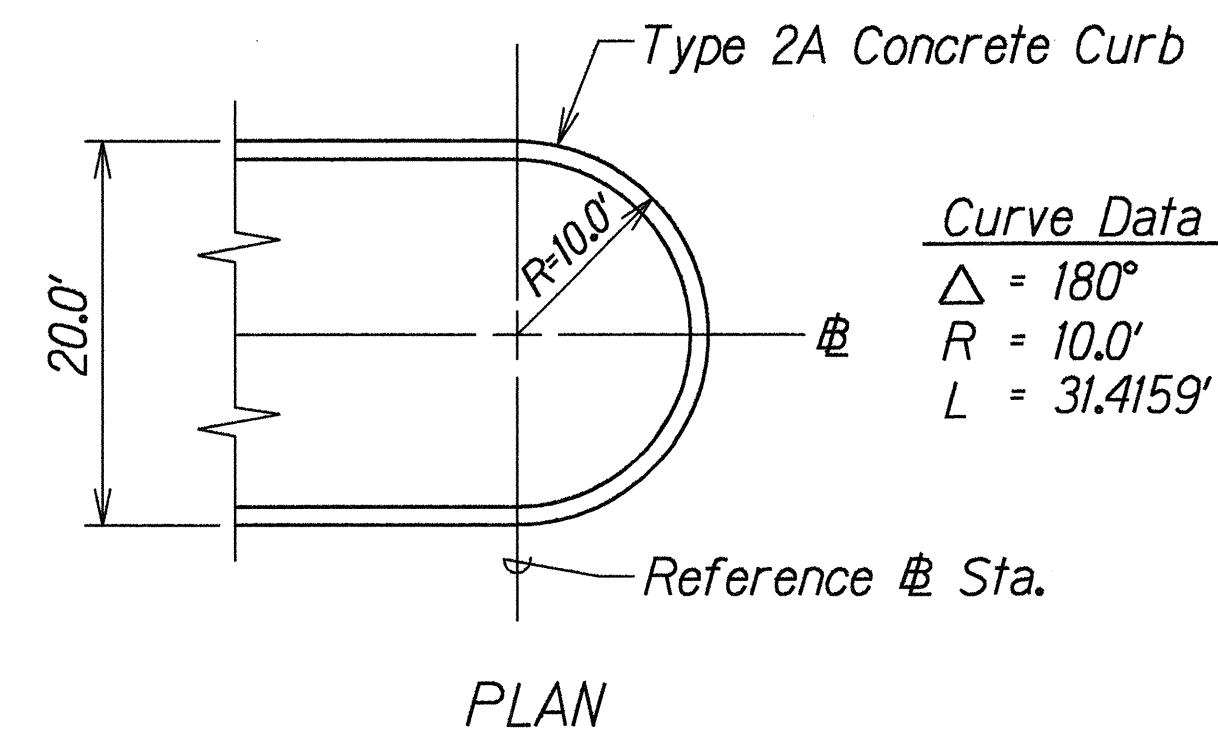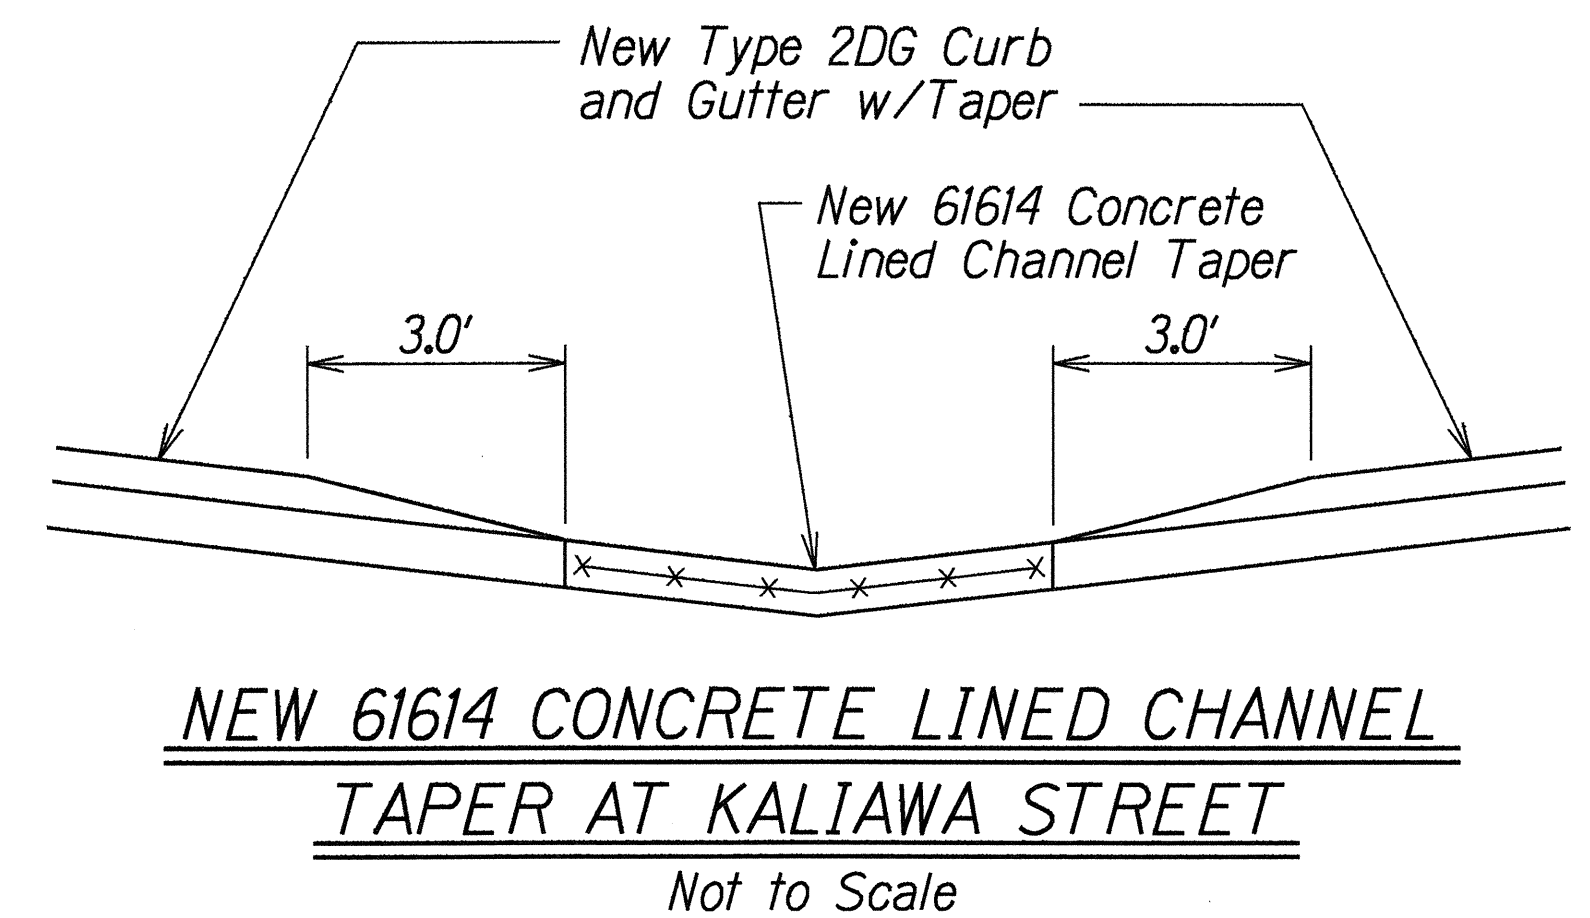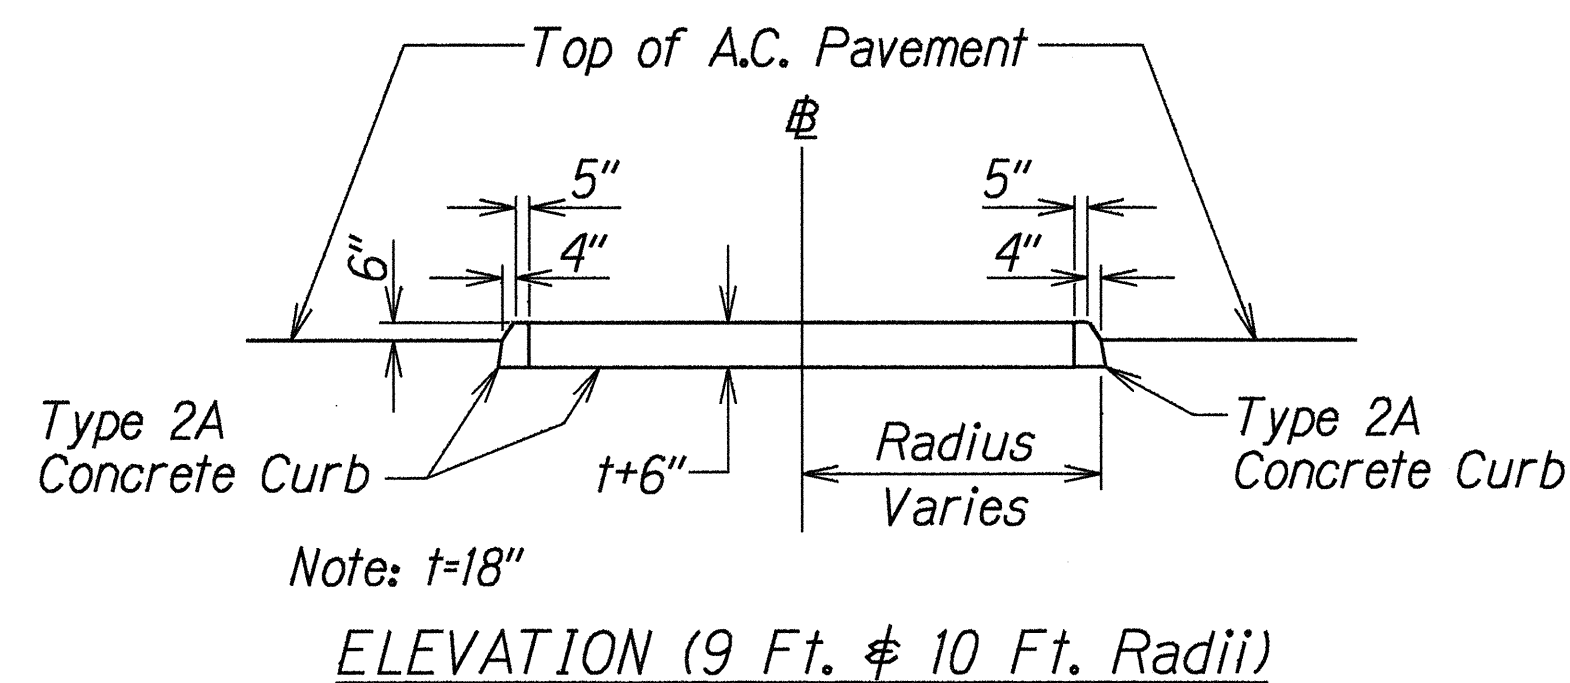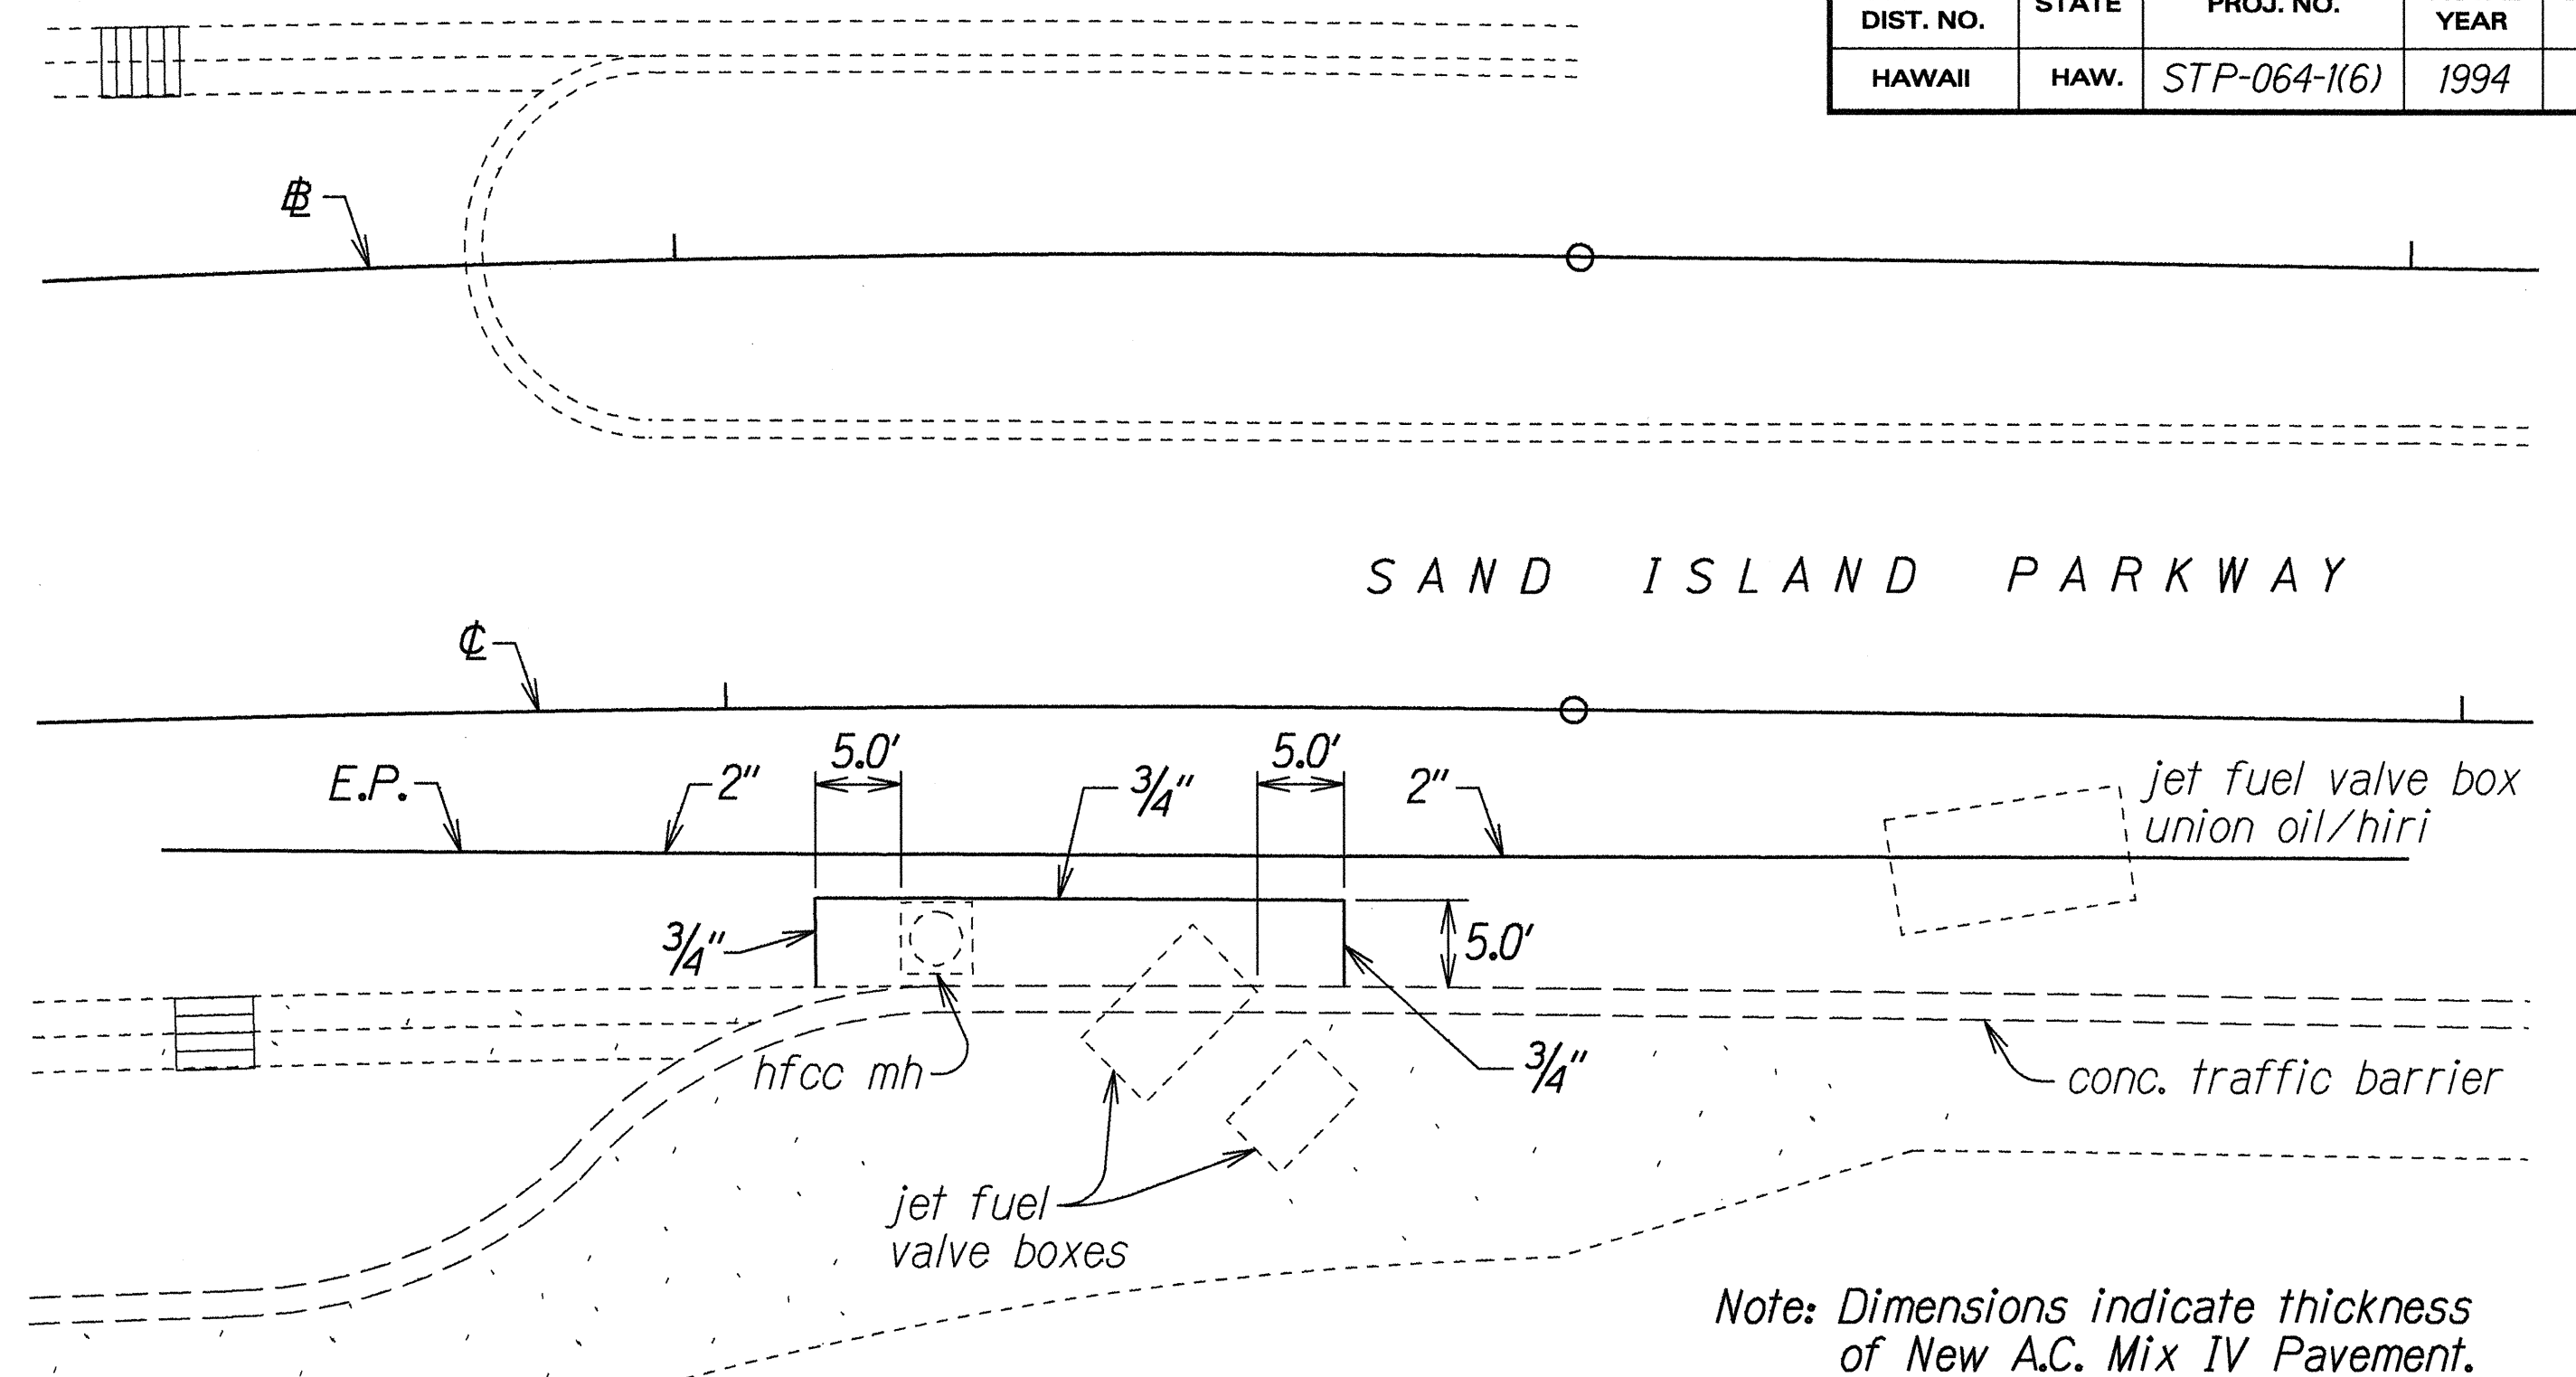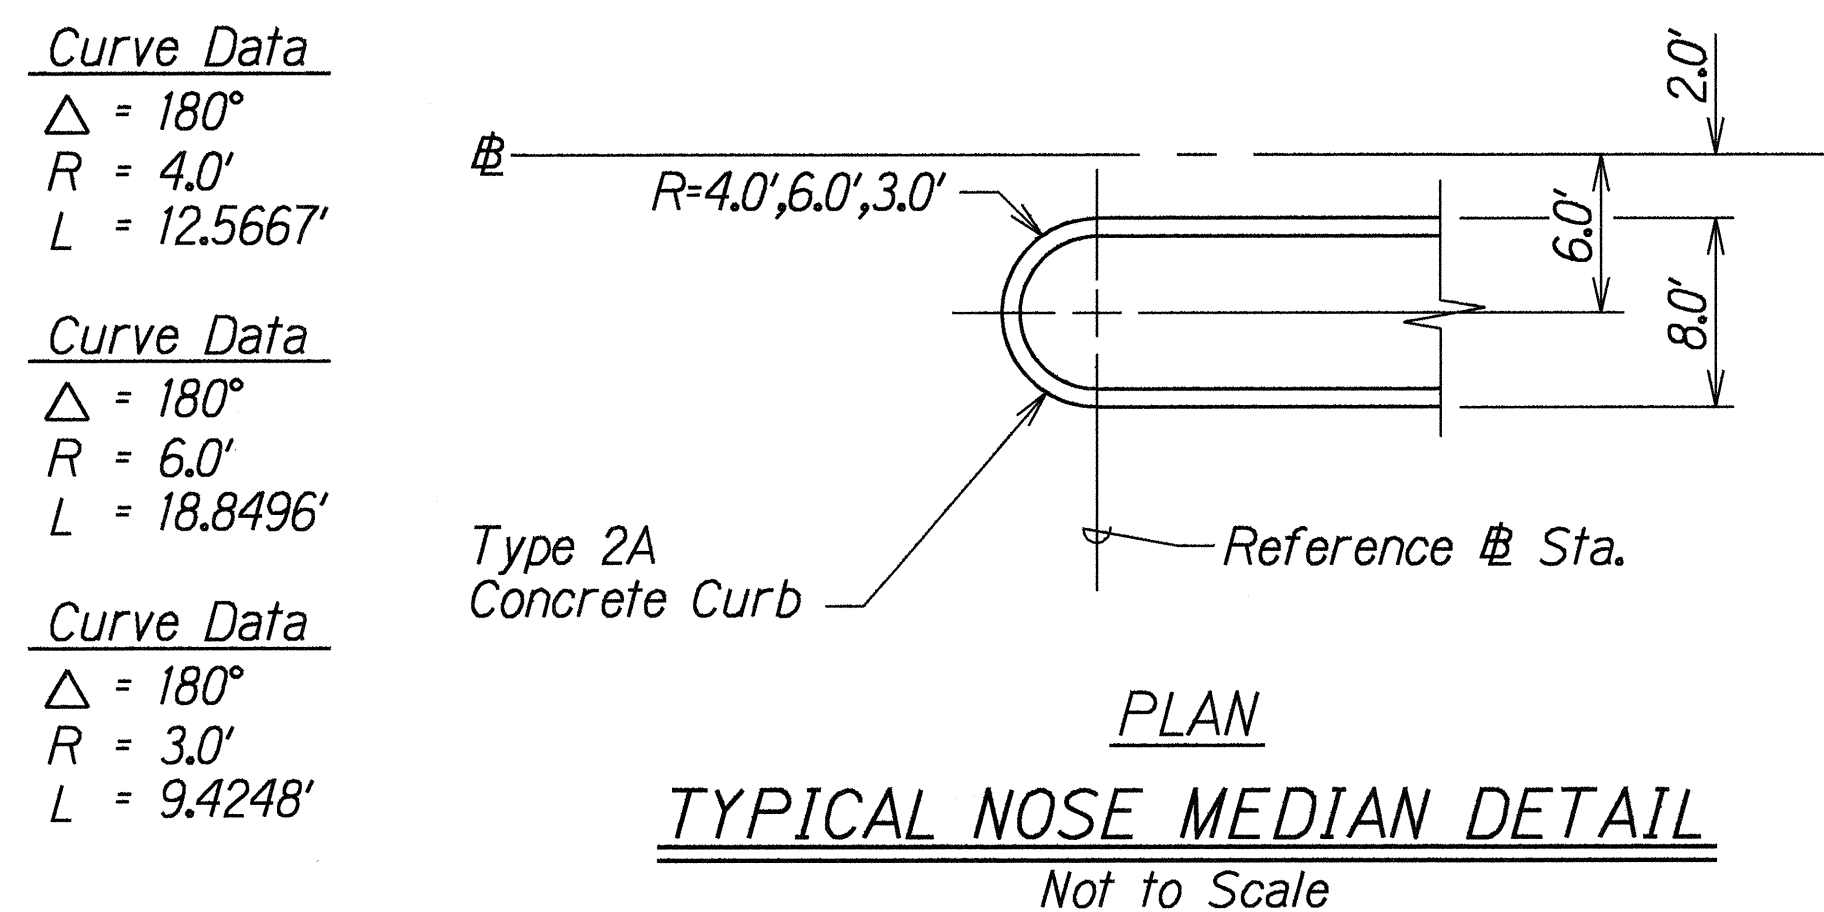

SAND ISLAND ACCESS ROAD NOSE MEDIAN DETAIL
 AT STA. 148+69 AND STA. 147+52 AND STA. 138+57
 Not to Scale

STATE OF HAWAII DEPARTMENT OF TRANSPORTATION HIGHWAYS DIVISION
TYPICAL DETAILS
SAND ISLAND ACCESS ROAD AND SAND ISLAND PARKWAY RESURFACING Nimitz Highway to Sewage Treatment Plant Fed. Aid Project No. STP-064-1(6)
Scale: As Shown Date: June, 1994
SHEET No. 4 OF 4 SHEETS