

STRUCTURAL GENERAL NOTES

FED. ROAD DIST. NO.	STATE	FED. AID PROJ. NO.	FISCAL YEAR	SHEET NO.	TOTAL SHEETS
HAWAII	HAW.	BR-064-I(3)	1991	7	38

1.

GENERAL SPECIFICATIONS: STATE OF HAWAII, DEPARTMENT OF TRANSPORTATION STANDARD SPECIFICATIONS FOR ROAD AND BRIDGE CONSTRUCTION, 1985 AND SPECIAL PROVISIONS PREPARED FOR THIS CONTRACT.
2.

DESIGN SPECIFICATIONS: AASHTO STANDARD SPECIFICATIONS FOR HIGHWAY BRIDGES, FOURTEENTH EDITION, 1989.
3.

DESIGN LOADS:

A.

DEAD LOAD: CONCRETE UNIT WEIGHT OF 160 PCF HAS BEEN ASSUMED FOR DEAD LOAD CALCULATIONS.

B.

LIVE LOAD: HS20-44 AND INTERSTATE LOADING.

C.

SEISMIC LOAD: SEISMIC PERFORMANCE CATEGORY B IN ACCORDANCE WITH AASHTO GUIDE SPECIFICATIONS FOR SEISMIC DESIGN OF HIGHWAY BRIDGES, 1983. MINIMUM ACCELERATION COEFFICIENT SHALL BE EQUAL TO 0.18.
4.

DESIGN STRESSES:

A.

ALLOWABLE CONCRETE STRESSES USED IN DESIGN SHALL CONFORM TO AASHTO STANDARD SPECIFICATIONS FOR HIGHWAY BRIDGES, 14TH EDITION, 1989 AND INTERIM SPECIFICATIONS OF 1989 THRU 1990.

CONCRETE	f'c	fc	LOCATION
CLASS A	3,000 PSI	1,200 PSI	ALL OTHER LOCATIONS
5,000	5,000 PSI	2,000 PSI	CONCRETE DECK SLAB
SEAL	3,000 PSI	1,200 PSI	PILE CONC. JACKET

B.

REINFORCING STEEL DESIGN STRESS: GRADE 40 AND 60, fs = 20,000 PSI.

5.

MATERIALS:

A.

ALL REINFORCING STEEL SHALL CONFORM TO THE REQUIREMENTS OF ASTM A615 AND SHALL BE DEFORMED. REINFORCING STEEL SHALL BE GRADE 40 OR 60, EXCEPT TIES AND STIRRUPS WHICH SHALL BE GRADE 40.

B.

ALL STRUCTURAL STEEL SHALL CONFORM TO THE REQUIREMENTS OF ASTM A36, UNLESS OTHERWISE NOTED.

C.

USE TYPE II CEMENT FOR ALL CONCRETE.

6.

REINFORCEMENT:

A.

THE MINIMUM CLEAR COVER FOR REINFORCING STEEL SHALL BE AS FOLLOWS UNLESS OTHERWISE SPECIFIED ON THE PLANS.

1)

DECK SLABS
TOP BARS - 1 1/2"
BOTTOM BARS - 1 1/2"

2)

VERTICAL BARS - 2"

B.

REINFORCING BARS SHALL BE DETAILED IN ACCORDANCE WITH "DETAILS AND DETAILING OF CONCRETE REINFORCEMENT" (ACI 315) UNLESS NOTED OTHERWISE.

C.

ALL DIMENSIONS RELATING TO REINFORCING BARS (I.E. SPACING OF BARS, ETC.) ARE TO CENTERS OF BARS UNLESS NOTED OTHERWISE.

D.

END HOOKS FOR REINFORCING STEEL TO BE STANDARD HOOK UNLESS NOTED OTHERWISE.

7.

STRUCTURAL STEEL:

A.

WORKMANSHIP SHALL BE IN ACCORDANCE WITH THE AISC MANUAL OF STEEL CONSTRUCTION 9TH EDITION.

B.

ALL WELDING SHALL BE PERFORMED BY CERTIFIED WELDERS IN ACCORDANCE WITH LATEST AWS STANDARDS.

C.

HIGH STRENGTH BOLTS AND NUTS SHALL CONFORM TO ASTM A325, GALVANIZED.

D.

CONNECTIONS SHALL DEVELOP THE FULL STRENGTH OF MEMBERS CONNECTED UNLESS OTHERWISE DETAILED. ANCHORS WELDED TO PLATE INSERTS EMBEDDED IN CONCRETE SHALL BE WELDED TO DEVELOP FULL STRENGTH OF THE ANCHORS.

E.

THE CONTRACTOR SHALL TAKE ADEQUATE MEASURES TO PREVENT EXCESSIVE HEAT BUILD UP AND CRACKING OF CONCRETE OR OTHER ATTACHED MATERIAL DUE TO WELDING. THE CONTRACTOR SHALL SUBMIT WELDING PROCEEDURES TO THE ENGINEER PRIOR TO COMMENCING WELDING WORK.

F.

SHOP DRAWINGS INDICATING FABRICATION AND ERECTION DIAGRAM SHALL BE SUBMITTED TO THE ENGINEER FOR REVIEW.

G.

USE E70 WELDING ELECTRODES.

H.

FOR CLEANING AND PAINTING REQUIREMENTS SEE SPECIFICATIONS.

8.

CONSTRUCTION METHODS:

A.

SEE STANDARD SPECIFICATIONS FOR ROAD AND BRIDGE CONSTRUCTION AND SPECIAL PROVISIONS.

B.

THE TOP OF CONCRETE DECK SLAB SHALL BE CONSTRUCTED TO CONFORM TO THE ROADWAY VERTICAL AND HORIZONTAL CURVES INDICATED ON THE PLANS.

C.

EXCEPT AS OTHERWISE NOTED ALL VERTICAL DIMENSIONS ARE MEASURED PLUMB.

D.

UNLESS NOTED OTHERWISE, ALL EXPOSED CONCRETE EDGES SHALL BE CHAMFERED 3/4" x 3/4".

E.

ALL BEARING SURFACES SHALL BE SET HORIZONTALLY LEVEL AND PLUMB.

9.

GENERAL NOTES:

A.

CONTRACTOR SHALL VERIFY ALL DIMENSIONS AND CONDITIONS AND SHALL NOTIFY THE ENGINEER IN WRITING OF ANY DISCREPANCIES OR CONFLICTS BEFORE COMMENCING WORK.

B.

DETAILS SHOWN ON THE DRAWINGS SHALL BE TYPICAL FOR ALL SIMILAR CONDITIONS. MODIFY DETAILS FOR SPECIAL CONDITIONS AS DIRECTED BY THE ENGINEER.

C.

THE CONTRACTOR SHALL BE FULLY RESPONSIBLE FOR THE METHODS OF CONSTRUCTION, QUALITY OF CONSTRUCTION, SAFETY OF WORKMEN, ADEQUACY OF FALSEWORK AND BRACING AND OTHER TEMPORARY ITEMS USED IN EXECUTING THE WORK.

D.

PLANS FOR THE EXISTING BASCULE BRIDGE ARE AVAILABLE FOR REVIEW PRIOR TO THE OPENING OF BIDS AT THE DEPARTMENT OF TRANSPORTATION, HIGHWAYS DIVISION.

E.

THE CONTRACTOR SHALL VISIT THE PROJECT SITE TO VERIFY ACTUAL CONDITIONS PRESENT PRIOR TO SUBMITTING BID.

F.

PRIOR TO STARTING THE WORK, THE CONTRACTOR SHALL VERIFY EXISTING CONDITIONS AS THE DRAWINGS WERE PREPARED FROM EXISTING "AS BUILT" DRAWINGS AND MIGHT NOT REFLECT ACTUAL FIELD CONDITIONS.

G.

WHERE EXISTING REINFORCEMENT WHICH IS TO REMAIN BUT IS DAMAGED AND CANNOT BE USED, THE COST TO PLACE EXPANSION ANCHORS, EPOXY FILLED HOLES OR OTHER METHODS TO ANCHOR NEW REINFORCEMENT SHALL BE CONSIDERED INCIDENTAL TO THE VARIOUS REINFORCING STEEL PAY ITEMS.

ESTIMATED QUANTITIES

ITEM NUMBER	ITEM DESCRIPTION	UNIT	QUANTITY
202.0441	REMOVAL OF ITEMS ON EXISTING NIMITZ APPROACH SPAN	L.S.	
202.0442	REMOVAL OF ITEMS ON EXISTING SAND ISLAND APPROACH SPAN	L.S.	
202.0443	REMOVAL OF ITEMS ON EXISTING BASCULE BRIDGE SPAN AND PIERS	L.S.	
501.0200	STRUCTURAL STEEL (225,700 LBS.)	L.S.	(225,700 LBS)
501.0301	OPEN GRID STEEL BRIDGE DECK	L.S.	(1,125 SQ FT)
501.0401	MISCELLANEOUS STRUCTURAL STEEL REPAIRS	F.A.	F.A.
502.2111	TREATED TIMBER (0.5 MFBM)	L.S.	0.5 MFB
503.1035	PILE CONCRETE JACKET	EACH	42
503.6001	CONCRETE IN APPROACH SPANS	L.S.	(305 CU YD)
503.6002	CONCRETE IN BASCULE BRIDGE SPAN	L.S.	(105 CU YD)
507.0101	TYPE 'A' METAL BRIDGE RAILING	LIN FT	530
507.5100	CONCRETE BRIDGE RAILING	LIN FT	860
511.1001	PAINTING BRIDGE (83,000 S.F.)	L.S.	83,800 SQ FT
512.1001	DECK EXPANSION JOINT	LIN FT	210
602.0091	REINFORCING STEEL IN APPROACH SPANS	L.S.	(135,000 LBS)
602.0092	REINFORCING STEEL IN BASCULE BRIDGE SPAN	L.S.	(3,100 LBS)
648.0100	SKID RESISTANCE SYSTEM (2590 S.F.)	L.S.	2,590 SQ FT
649.1000	DISPOSAL OF LEAD-CONTAINING PAINT	TON	105

INDEX TO BRIDGE DRAWINGS

SHEET NO.	DESCRIPTION
NI	STRUCTURAL GENERAL NOTES, ESTIMATED QUANTITIES AND INDEX TO BRIDGE DRAWINGS
S1	GENERAL PLAN AND ELEVATION
S2	EXISTING PARTIAL FRAMING PLANS AND REPAIR LOCATIONS
	BASCULE BRIDGE SPAN
S3	EXISTING PARTIAL FRAMING PLANS AND REPAIR LOCATIONS
	BASCULE BRIDGE SPAN
S4	REPAIR SCHEDULE
S5	JOINT AND REPAIR DETAILS
S6	FINISHED APPROACH SPANS FRAMING PLANS AND DECK ELEVATIONS
S7	FINISHED PARTIAL FRAMING PLANS BASCULE BRIDGE SPAN
S8	PARTIAL FRAMING PLANS, ADDED BRACING SECTIONS AND DETAILS BASCULE BRIDGE SPAN
S9	PARTIAL ROADWAY PLANS AT PIER 3 AND PIER 4
S10	CROSS SECTION AT ABUTMENT
S11	CROSS SECTION AT APPROACH SPANS
S12	APPROACH SPAN GIRDER ELEVATIONS AND SECTIONS
S13	SECTIONS
S14	CROSS SECTIONS AT BASCULE BRIDGE FLOOR BEAMS
S15	NEW METAL RAILING AND CONNECTION DETAILS
S16	MISCELLANEOUS DETAILS
S17	MAIN GIRDER - PARTIAL LONGITUDINAL ELEVATION
S18	MAIN GIRDER - PARTIAL LONGITUDINAL ELEVATION
S19	DECK EXPANSION JOINT DETAILS
S20	FENDER SECTIONS AND DETAILS
S21	GUARDRAIL END POST SECTIONS AND NOTES

SYMBOLS AND ABBREVIATIONS

ABUT. @ @ AZ	ABUTMENT AT AND AZIMUTH	DIA. DIAG. DET.	DIAMETER DIAGONAL DETAIL	HORIZ. HT.	HORIZONTAL HEIGHT	N.I.C. NO.,#	NOT IN CONTRACT NUMBER	SECT. SI SIM. SP. SS STA. STIRR. SQ. SYMM.	SECTION SAND ISLAND SIMILAR SPACE STAINLESS STEEL STATION STIRRUP SQUARE SYMMETRICAL
BAL. BET. BOT. BRG. BVC	BALANCE BETWEEN BOTTOM BEARING BEGIN VERTICAL CURVE	EA. E.F. E.F.V. E.W. EL., ELEV. E.P. EQ. EXIST. EXP. EVC.	EACH EACH FACE EACH FACE VERTICAL EACH WAY ELEVATION EDGE OF PAVEMENT EQUAL EXISTING EXPANSION END VERTICAL CURVE	HFFC	HONOLULU FUEL FACILITIES CORP.	O.B. O.C. O.F.V.	OUTBOUND ON CENTER OUTSIDE FACE VERTICAL OFF SET	P.I. PCF	POINT OF INTERSECTION PLATE POUNDS PER CUBIC FEET POUNDS PER SQUARE INCH POINT
C.G.S.	CENTERLINE CENTER OF GRAVITY OF STEEL	FIN. FTG. F.A. FT.	FINISH FOOTING FORCE ACCOUNT FOOT	JT.	JOINT	P.I. PCF	POINT OF INTERSECTION PLATE POUNDS PER CUBIC FEET POUNDS PER SQUARE INCH POINT	PSI	POUNDS PER CUBIC FEET POUNDS PER SQUARE INCH POINT
CG CONC. CONN. CONST. CONT. C.F., CU.FT. C.Y., CU.YD.	CHANGE GRADE CONCRETE CONNECTION CONSTRUCTION CONTINUOUS CUBIC FOOT CUBIC YARD	GR. GRD. G.R.P.	GUARD RAIL GROUND GROUTED RUBBLE PAVING	LIN. FT. LG. L.A. L.S. LB.	LINEAR FEET LONG LOW ALLOY LUMP SUM POUND	PT.	POINT	R=	RADIUS REINFORCEMENT REQUIRED
				MAX. MNY. MISC. MECH.	MAXIMUM MANY MISCELLANEOUS MECHANICAL	R=	RADIUS REINFORCEMENT REQUIRED	W/ WWF WV	WITH WELDED WIRE FABRIC WATER VALVE

A

SECTION OR DETAIL DESIGNATION

SI

SHEET NO. WHERE SECTION OR DETAIL IS SHOWN

1

SHEET NO. WHERE SECTION OR DETAIL ORIGINATES.

3

LIST OF WORK TO BE PERFORMED

3

REPAIR SCHEDULE

THIS WORK WAS PREPARED BY ME OR UNDER MY SUPERVISION


Roscoe O. Ford

STATE OF HAWAII
DEPARTMENT OF TRANSPORTATION
HIGHWAYS DIVISION
STRUCTURAL GENERAL NOTES,
ESTIMATED QUANTITIES & INDEX
TO BRIDGE DRAWINGS
SAND ISLAND BASCULE BRIDGE
REHABILITATION PHASE II
PROJECT NO. BR-064-I(3)
SCALE: AS NOTED DATE: MARCH 1991
SHEET No. NI OF S21 SHEETS


SURVEY PLOTTED BY	DATE
DRAWN BY	
TRACED BY	
DESIGNED BY	
QUANTITIES BY	
CHECKED BY	
ORIGINAL PLAN	No.

7

FED. ROAD DIST. NO.	STATE	FED. AID PROJ. NO.	FISCAL YEAR	SHEET NO.	TOTAL SHEETS
HAWAII	HAW.	BR-064-1(3)	1991	8	38

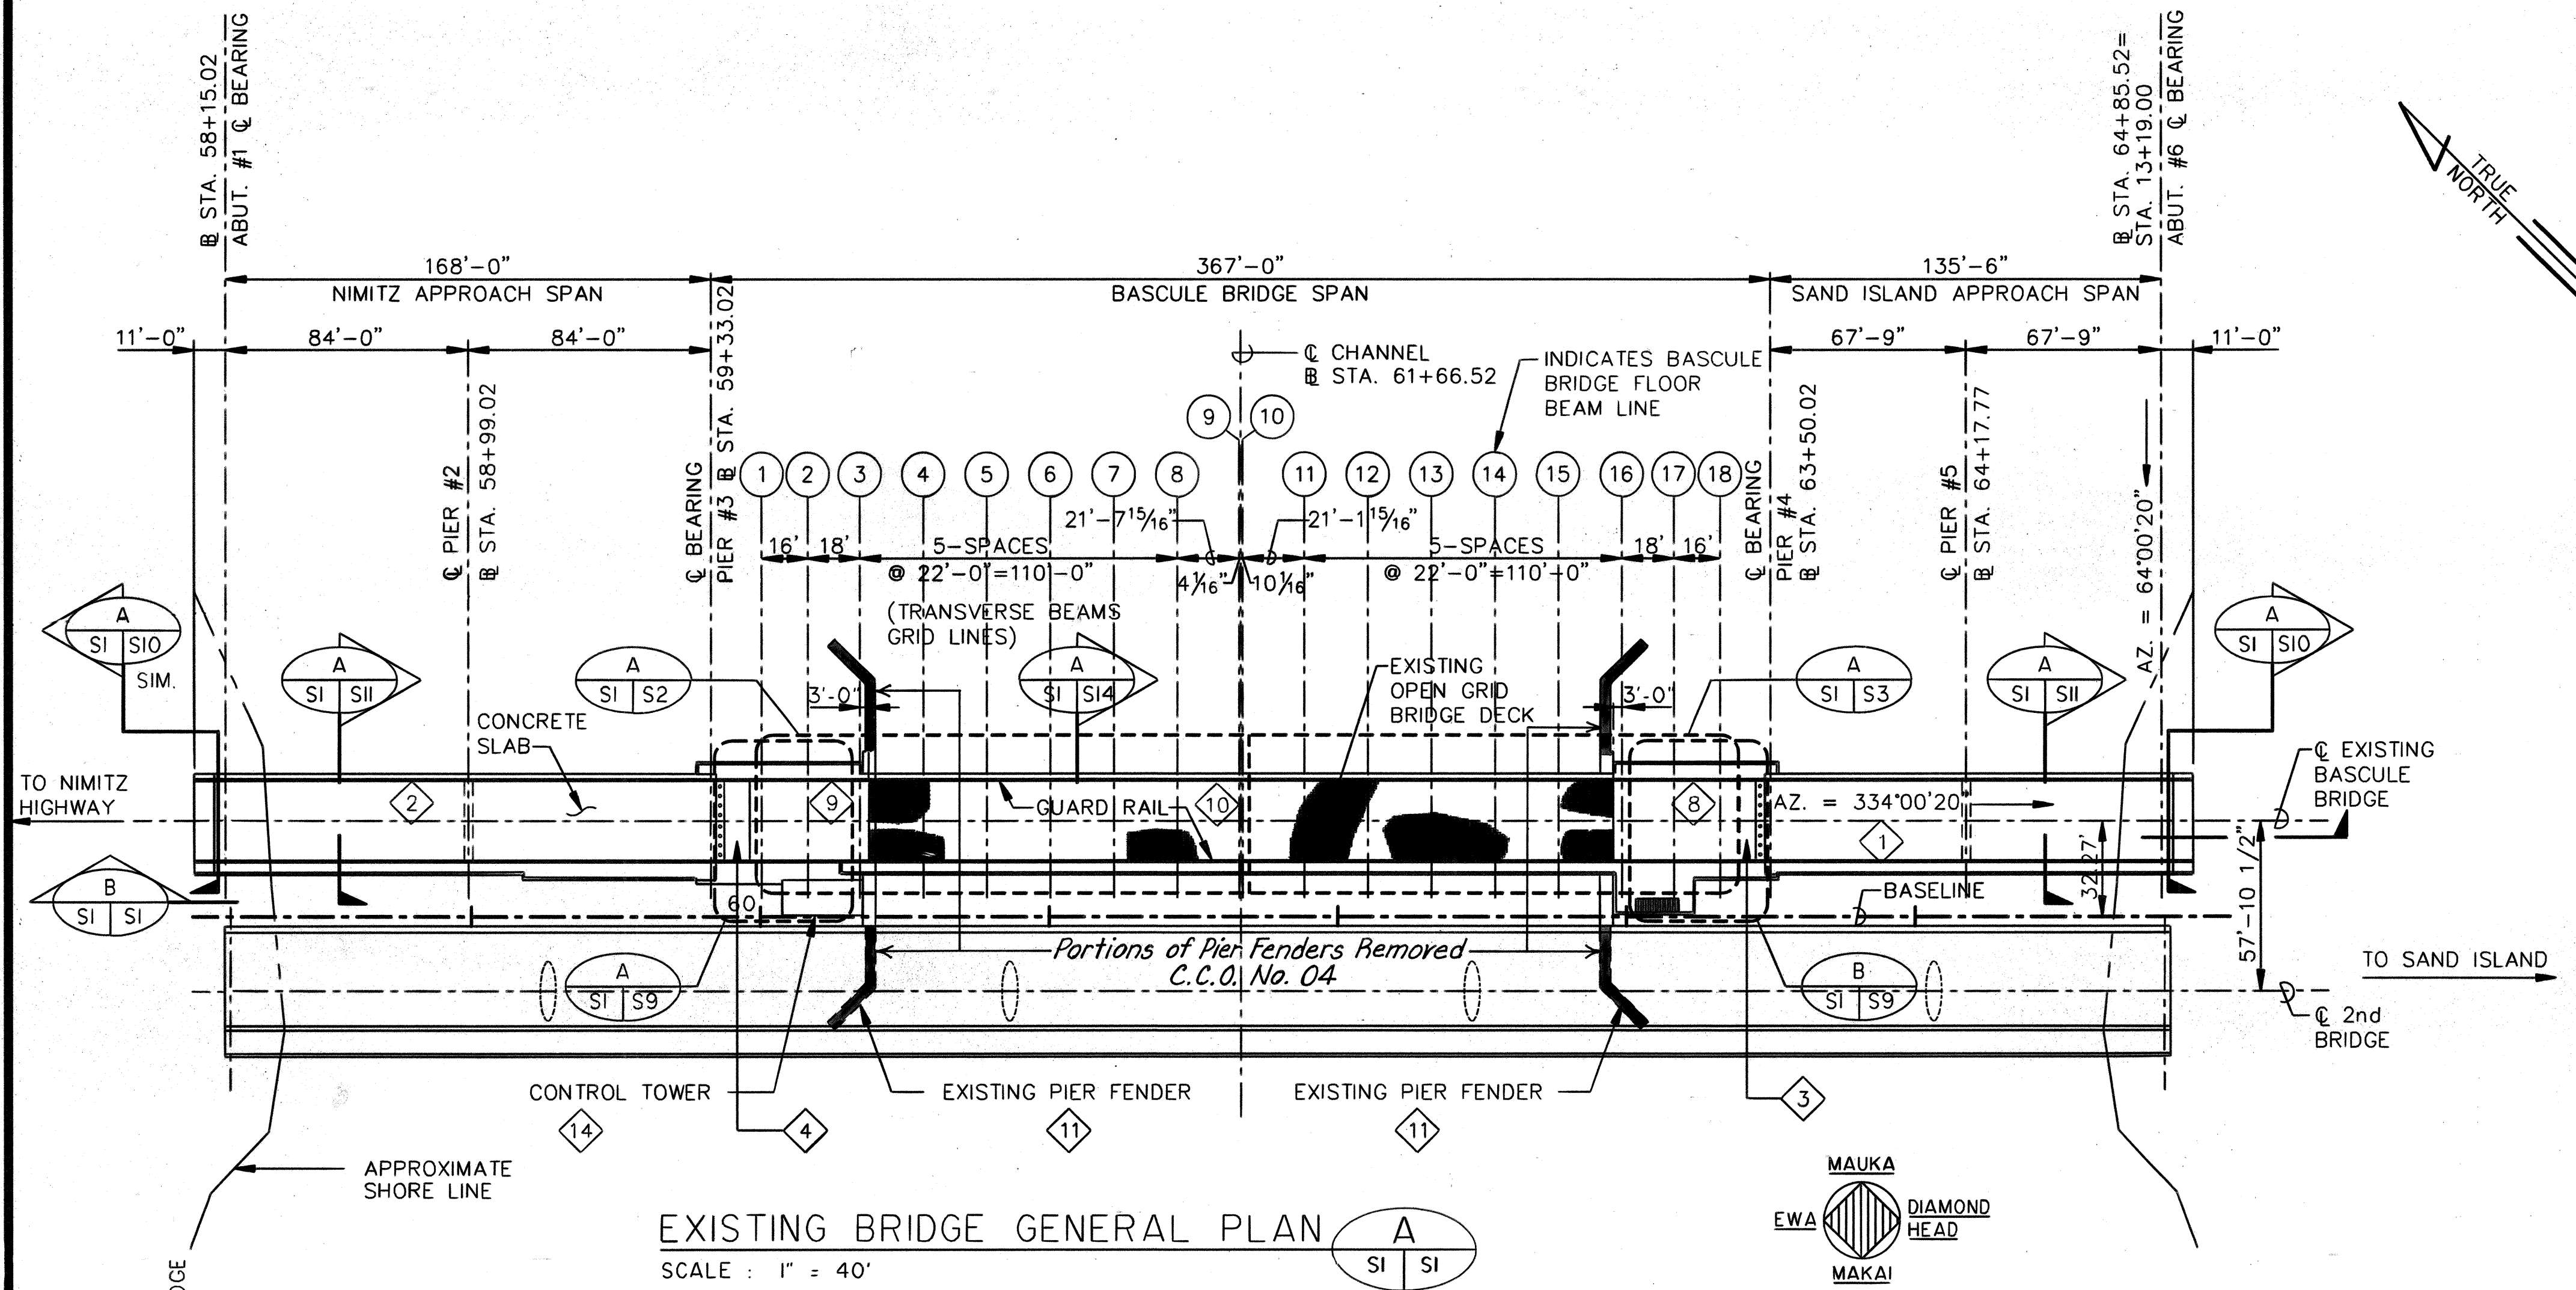

EXISTING BRIDGE GENERAL PLAN
SCALE: 1" = 40'

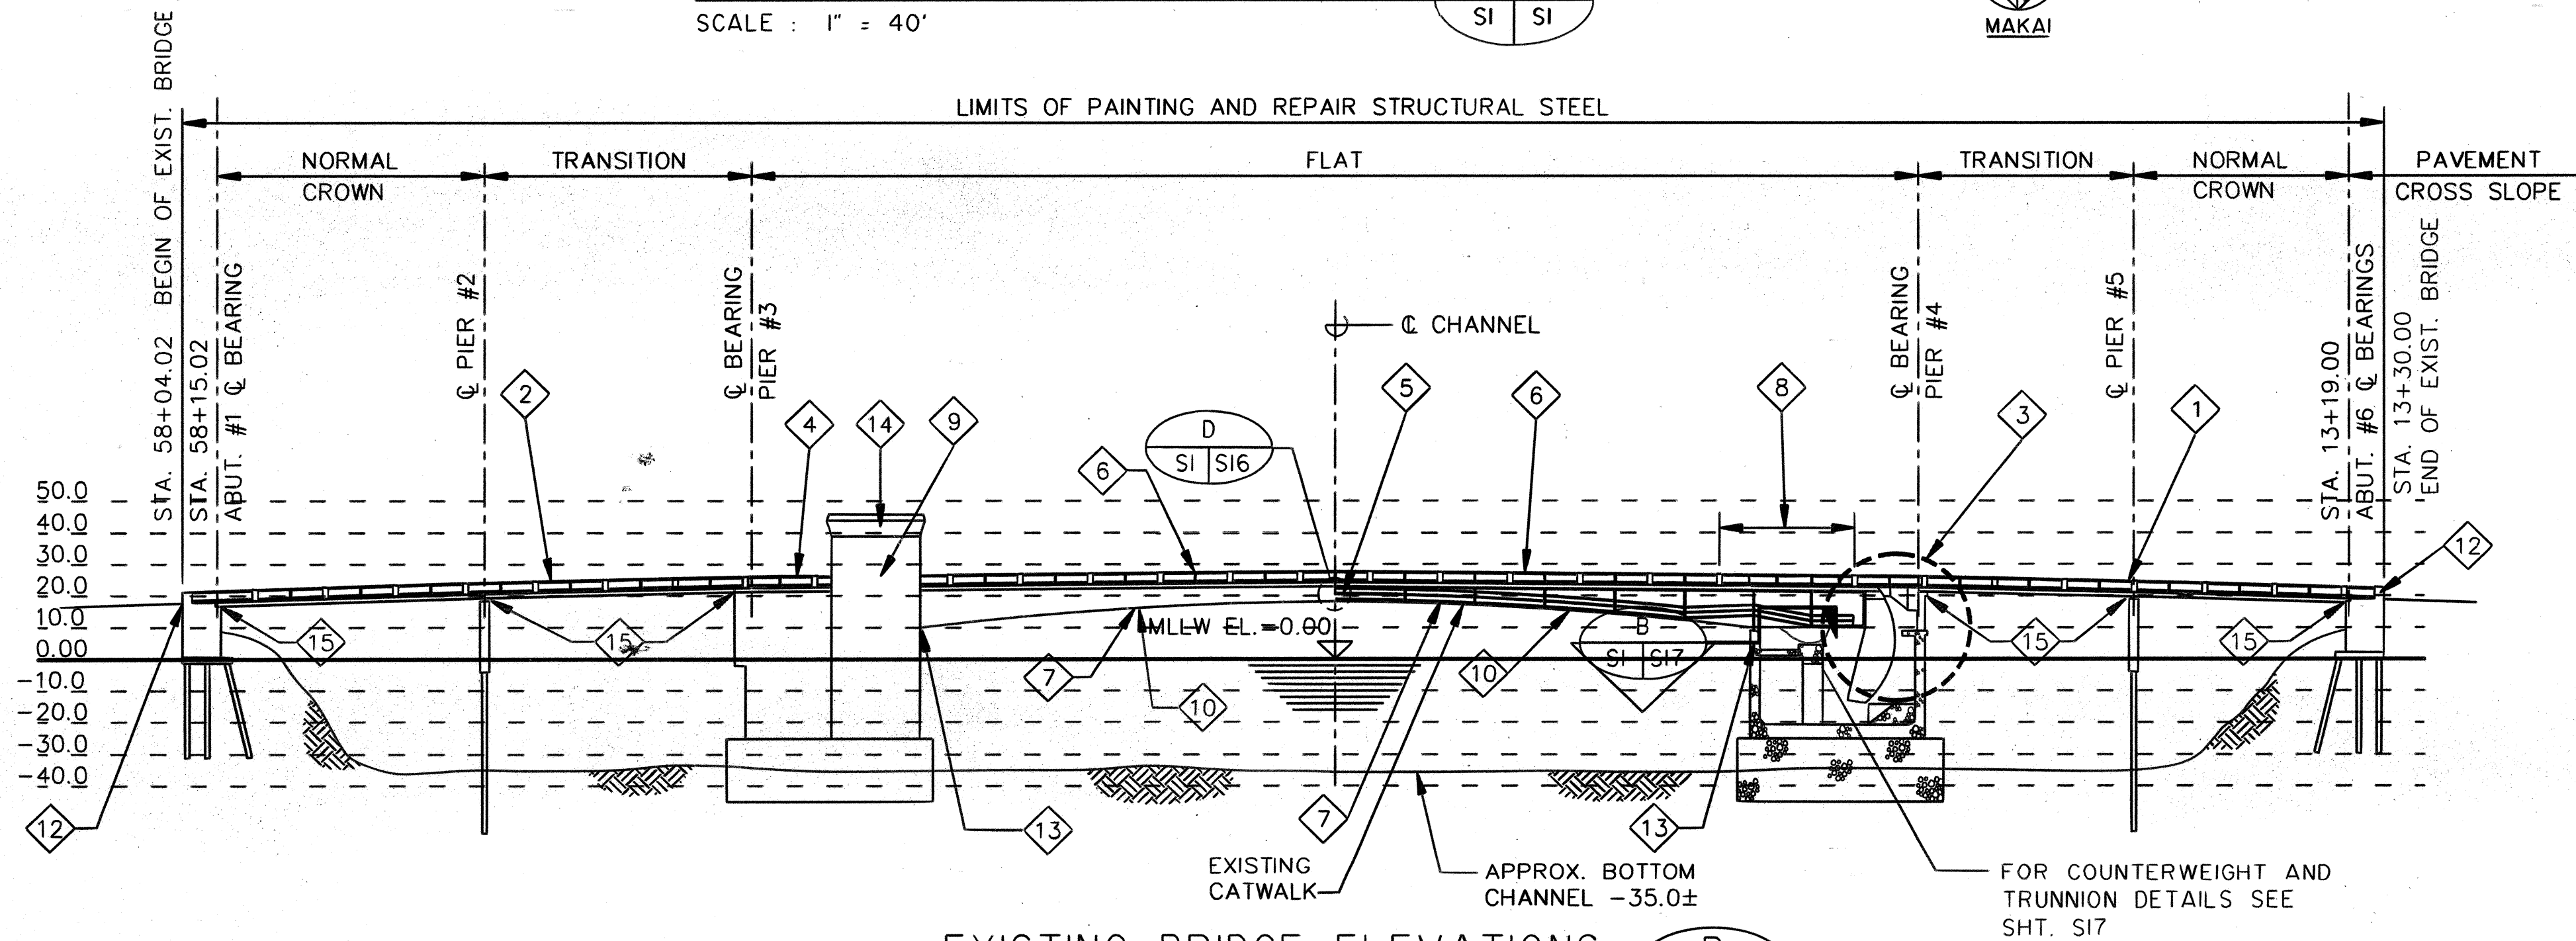


EXISTING BRIDGE ELEVATIONS
SCALE: 1" = 40'

12 INDICATES WORK ITEM TO BE PERFORMED.

LIST OF WORK TO BE PERFORMED

- 1 REMOVE CONCRETE DECK SLAB AT SAND ISLAND APPROACH & RECONSTRUCT. SEE S11, S10 & S6.
- 2 REMOVE CONCRETE DECK SLAB AT NIMITZ APPROACH & RECONSTRUCT. SEE S11, S10 & S6.
- 3 REPAIR SAND ISLAND COUNTERWEIGHT & POUR CONCRETE SLAB AT PIER 4. SEE S9, S16, & S17.
- 4 REPAIR NIMITZ COUNTERWEIGHT & POUR CONCRETE SLAB AT PIER 4. SEE S16.
- 5 LOCK CENTER HINGE AGAINST MOVEMENT. SEE S16.
- 6 REPAIR EXISTING OPEN GRID BRIDGE DECK. WIDEN BRIDGE, ADD STEEL BEAM AND NEW STEEL DECK. SEE S2.
- 7 REPAIR RUSTED AND/OR DETERIORATED STRUCTURE SEE S2, S3, S4, S5, S17, S18.
- 8 REMOVE EXISTING CONC. FILLED OPEN GRID DECK FROM SAND ISLAND SECTION; REPLACE WITH CONC. DECK SLAB, WIDEN BRIDGE. SEE S2, S3, S7 & S13.
- 9 REMOVE EXISTING CONC. FILLED OPEN GRID DECK FROM NIMITZ SECTION; REPLACE WITH CONC. DECK SLAB, WIDEN BRIDGE. SEE S2, S3, S7 & S13.
- 10 ADD BRACING TO MAIN GIRDER SYSTEM SEE S8.
- 11 JACKET PILES AND REPAIR FENDER SYSTEM. SEE S20.
- 12 MODIFY EXISTING RAILING AND CONSTRUCT NEW END POST SEE S21.
- 13 CLOSE TSUNAMI GATES SEE S17.
- 14 BOARD WINDOWS AT EXISTING CONTROL ROOM, SEE S16.
- 15 CONSTRUCT NEW END DIAPHRAGM AND RESTRAINERS.

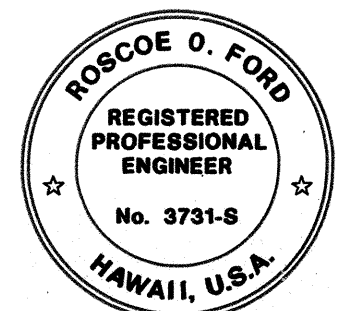

THIS WORK WAS PREPARED BY ME OR UNDER MY SUPERVISION

Roscoe O. Ford

STATE OF HAWAII
DEPARTMENT OF TRANSPORTATION
HIGHWAYS DIVISION

GENERAL PLAN AND ELEVATION





SAND ISLAND BASCULE BRIDGE
REHABILITATION PHASE II
PROJECT NO. BR-064-1(3)

SCALE: AS NOTED DATE: AUG. 15, 1991



SHEET No. S1 OF S21 SHEETS

DATE REVISION

FED. ROAD DIST. NO.	STATE	FED. AID PROJ. NO.	FISCAL YEAR	SHEET NO.	TOTAL SHEETS
HAWAII	HAW.	BR-064-1(3)	1991	9	38

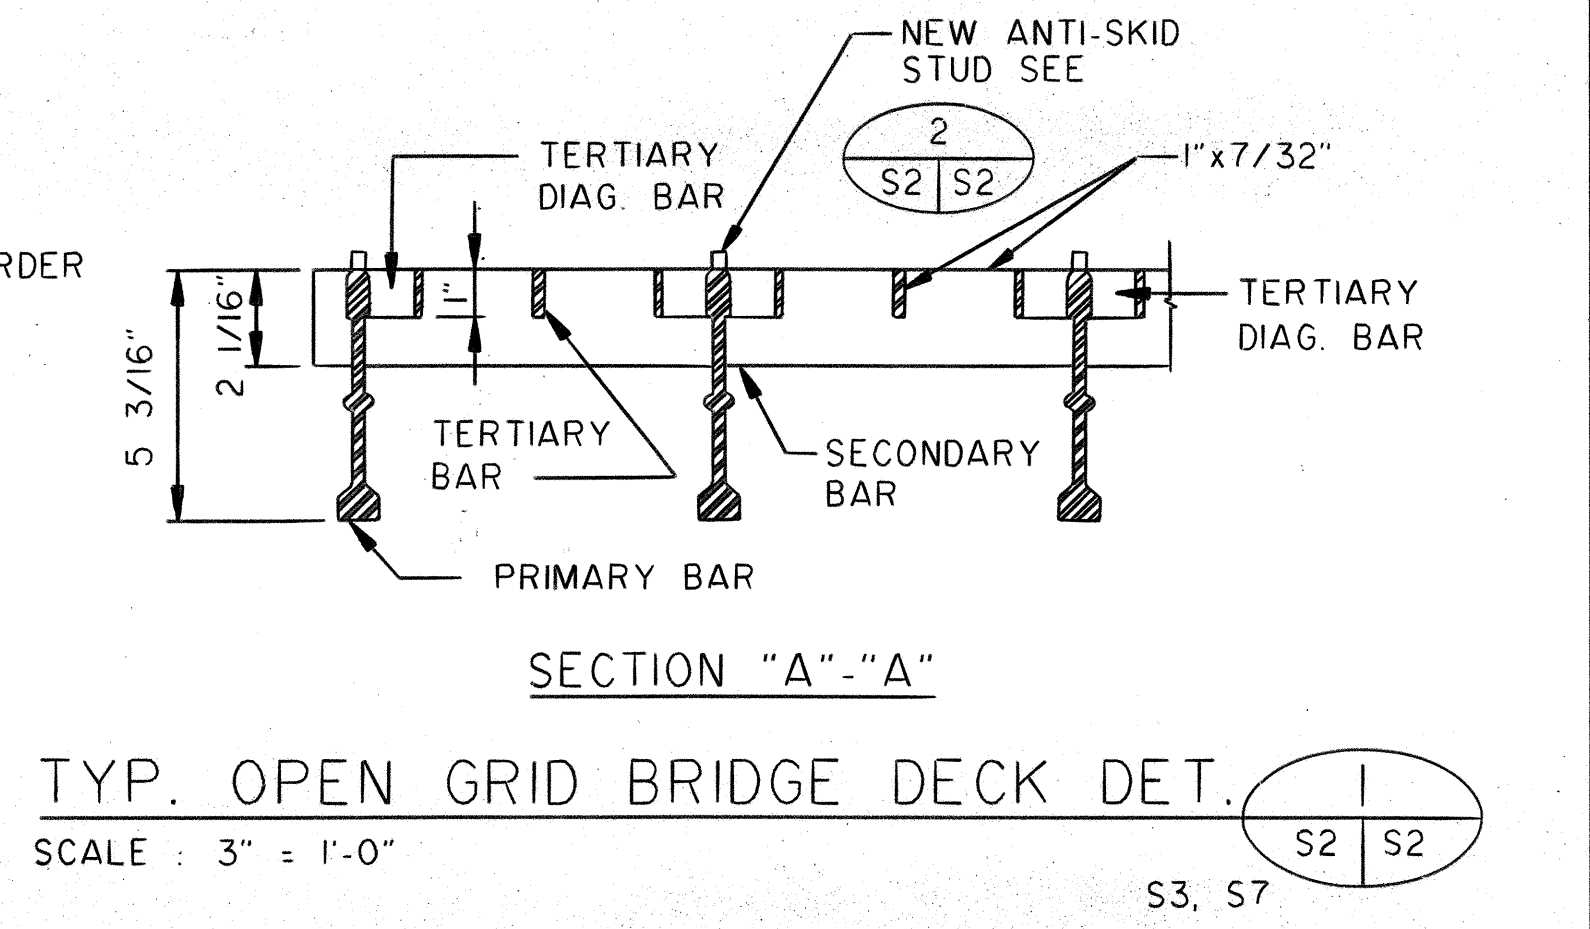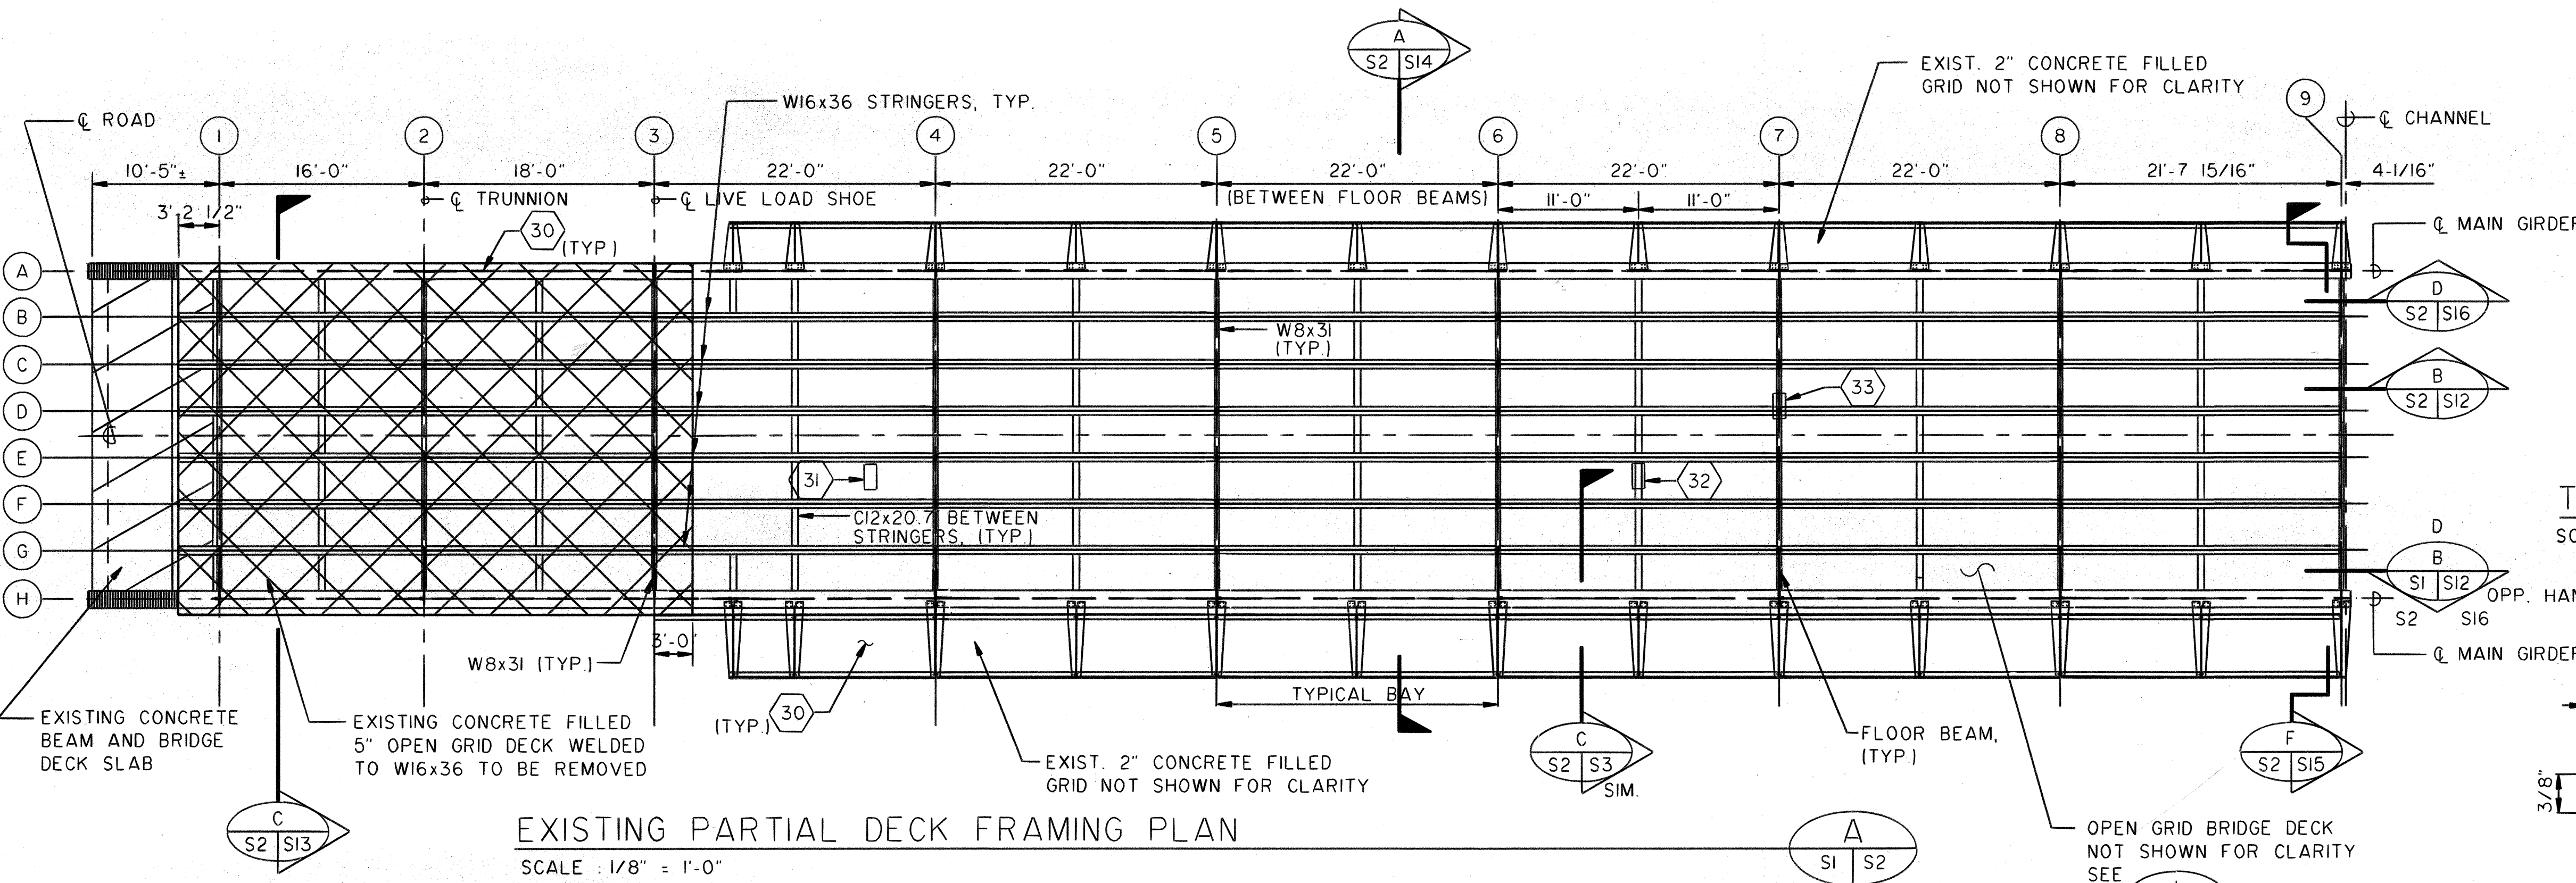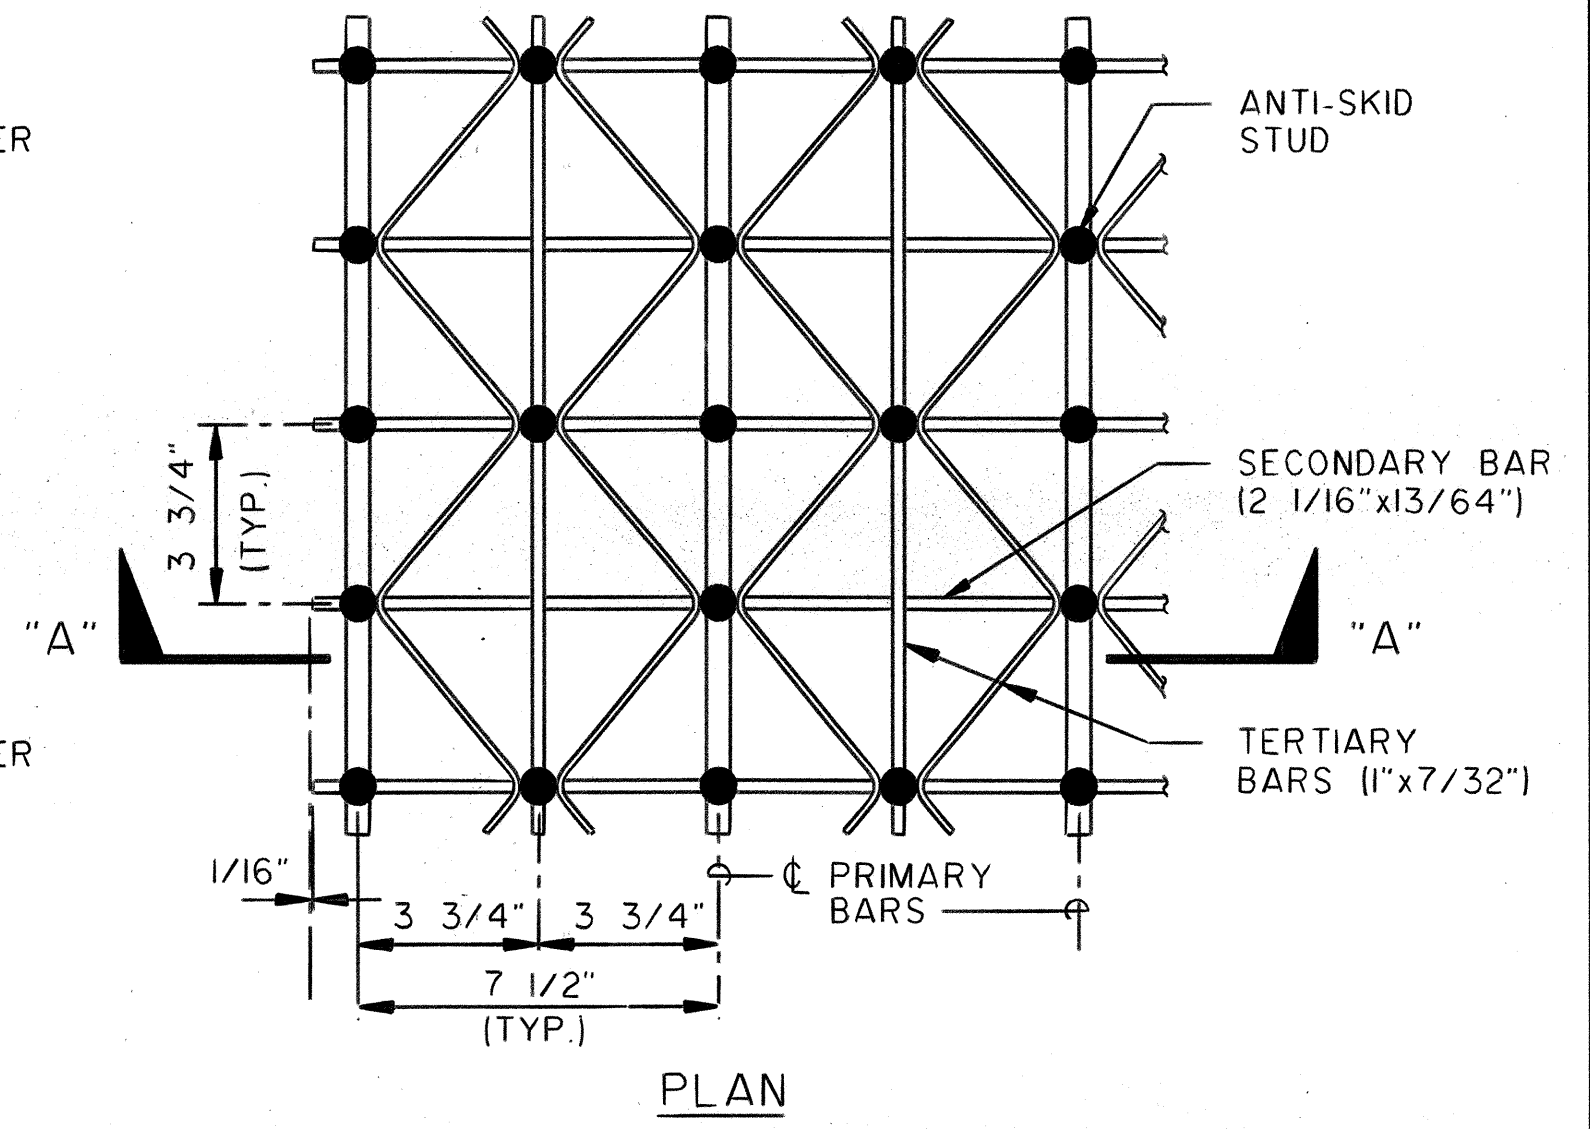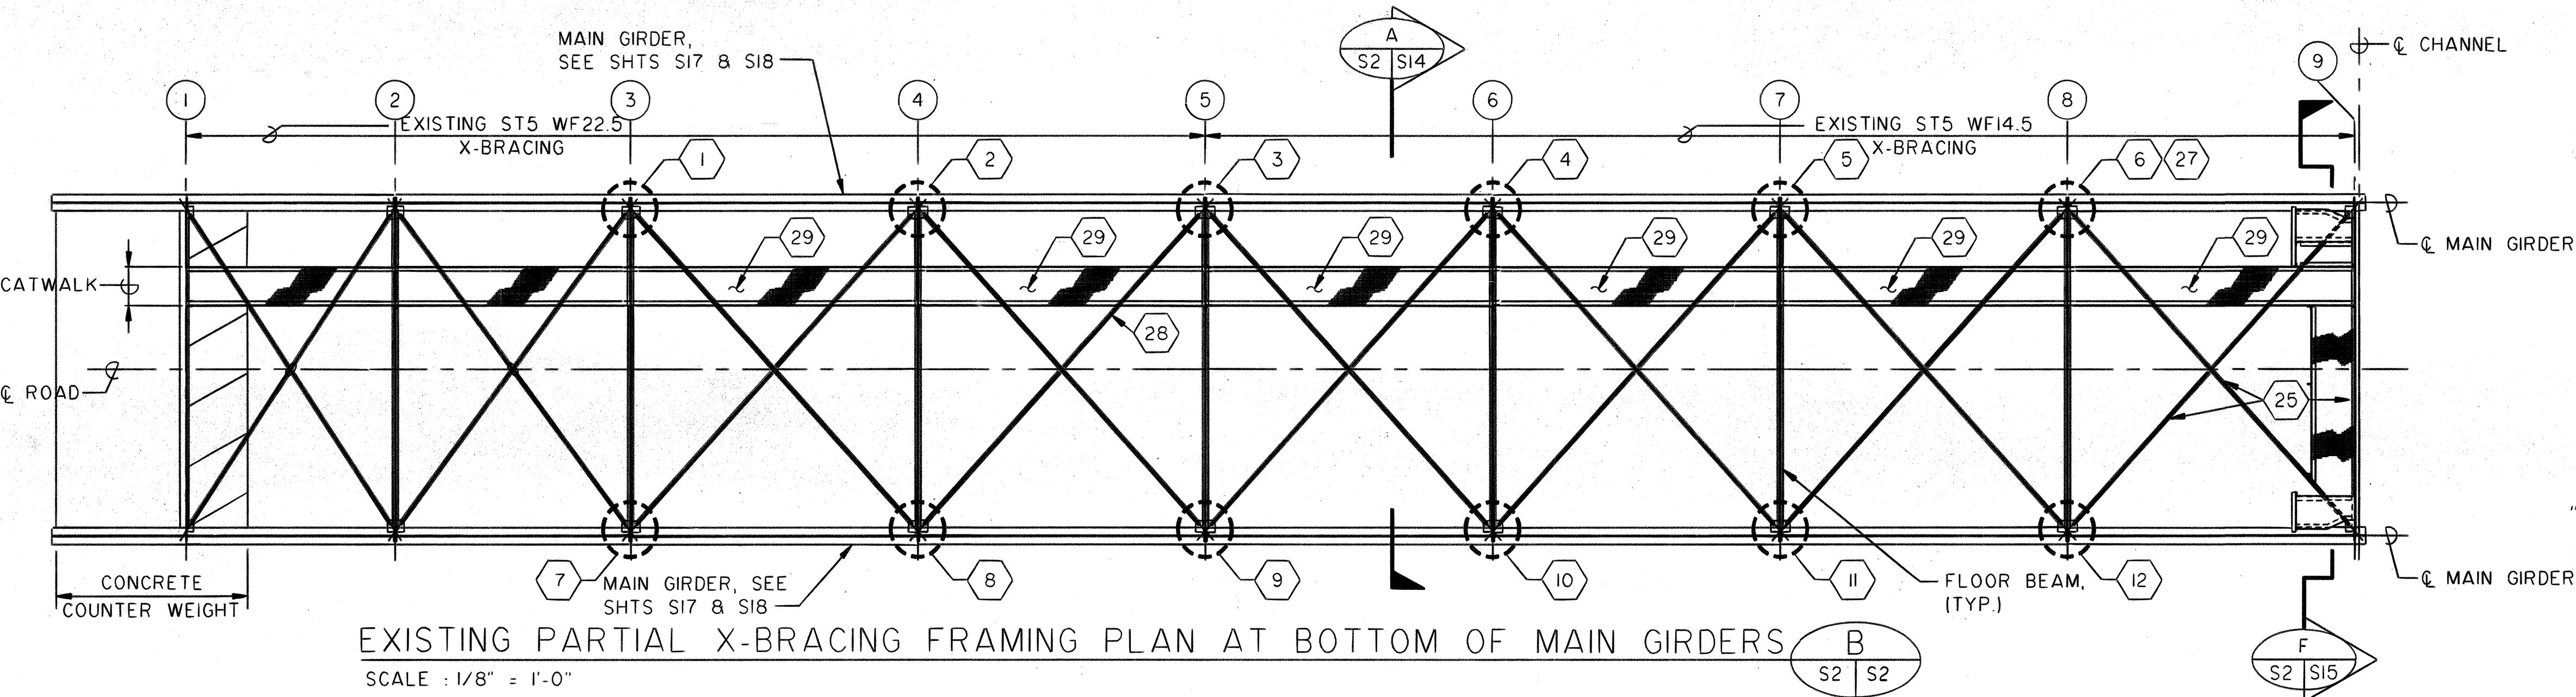


NOTES:
 1. (26) SYMBOL MARK, FOR REPAIR LOCATIONS SEE SHT. S4 FOR REPAIR SCHEDULE.

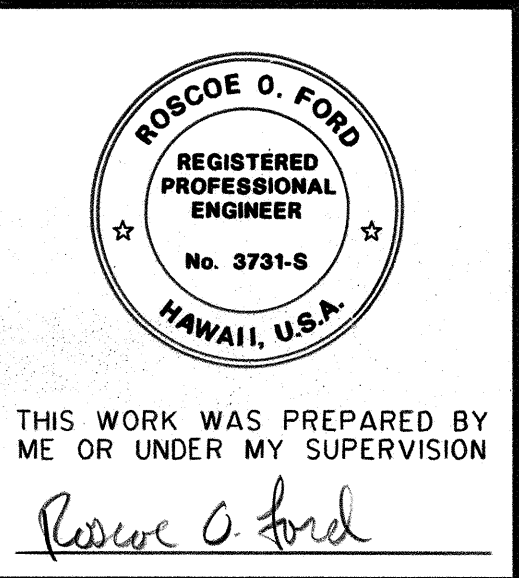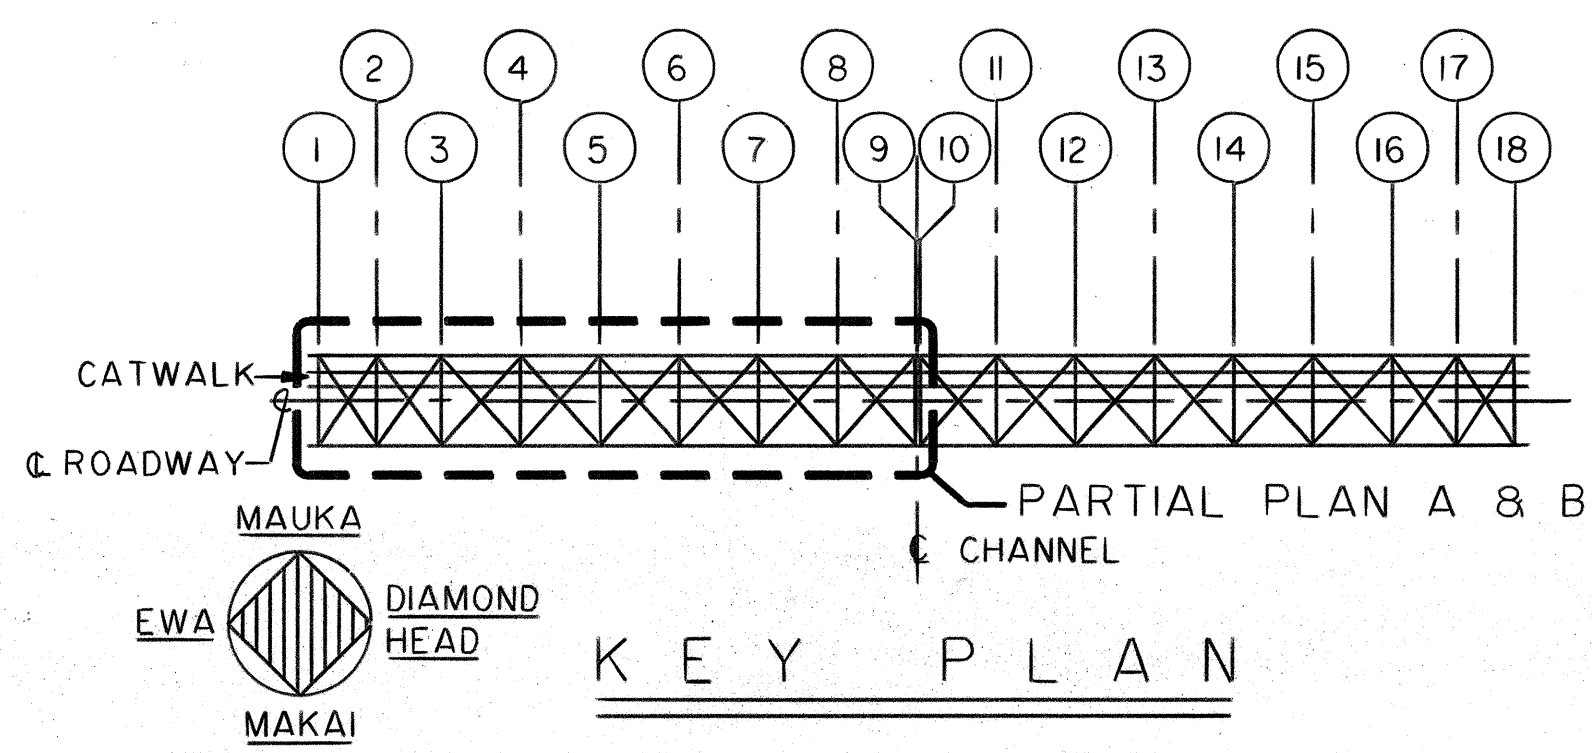


STATE OF HAWAII
 DEPARTMENT OF TRANSPORTATION
 HIGHWAYS DIVISION
 EXISTING PARTIAL FRAMING PLANS
 AND LOCATIONS
 BASCULE BRIDGE SPAN
 SAND ISLAND BASCULE BRIDGE
 REHABILITATION PHASE II
 PROJECT NO. BR-064-1(3)
 SCALE: AS NOTED DATE: AUG. 15, 1991
 SHEET No. S2 OF S21 SHEETS

SURVEY PLOTTED BY	DATE
DRAWN BY	
DESIGNED BY	
QUANTITIES BY	
CHECKED BY	
ORIGINAL PLAN	
NO.	


FED. ROAD DIST. NO.	STATE	FED. AID PROJ. NO.	FISCAL YEAR	SHEET NO.	TOTAL SHEETS
HAWAII	HAW.	BR-064-1(3)	1991	10	38

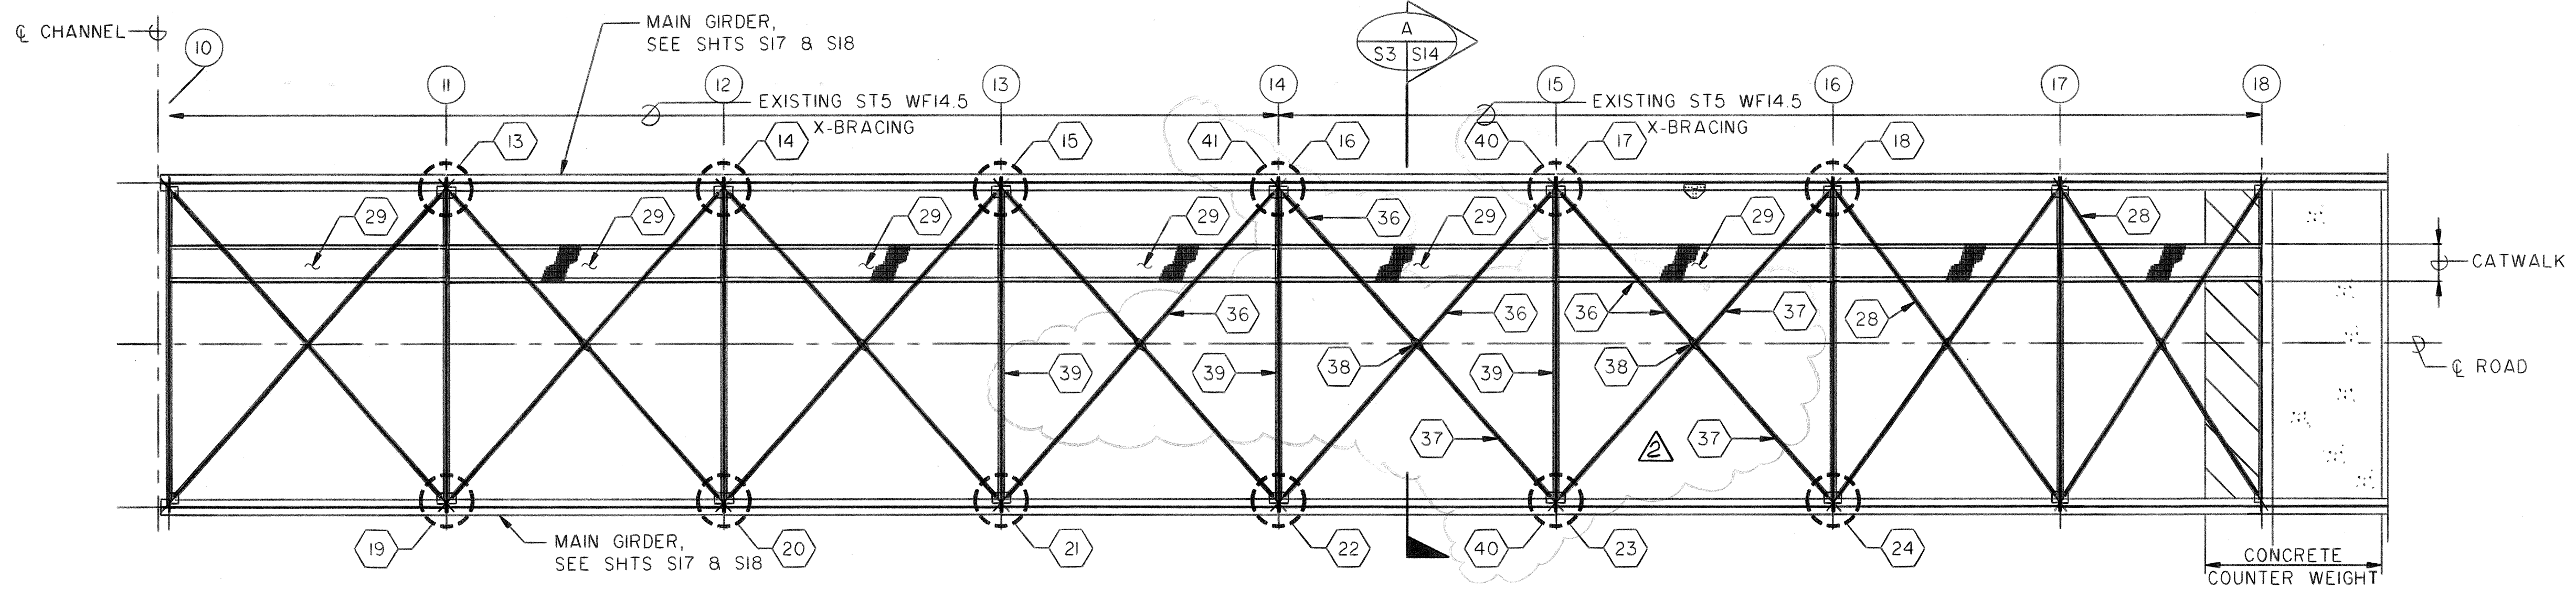

EXIST. PARTIAL X-BRACING FRAMING PLAN AT BOTTOM OF MAIN GIRDERS
SCALE : 1/8" = 1'-0"

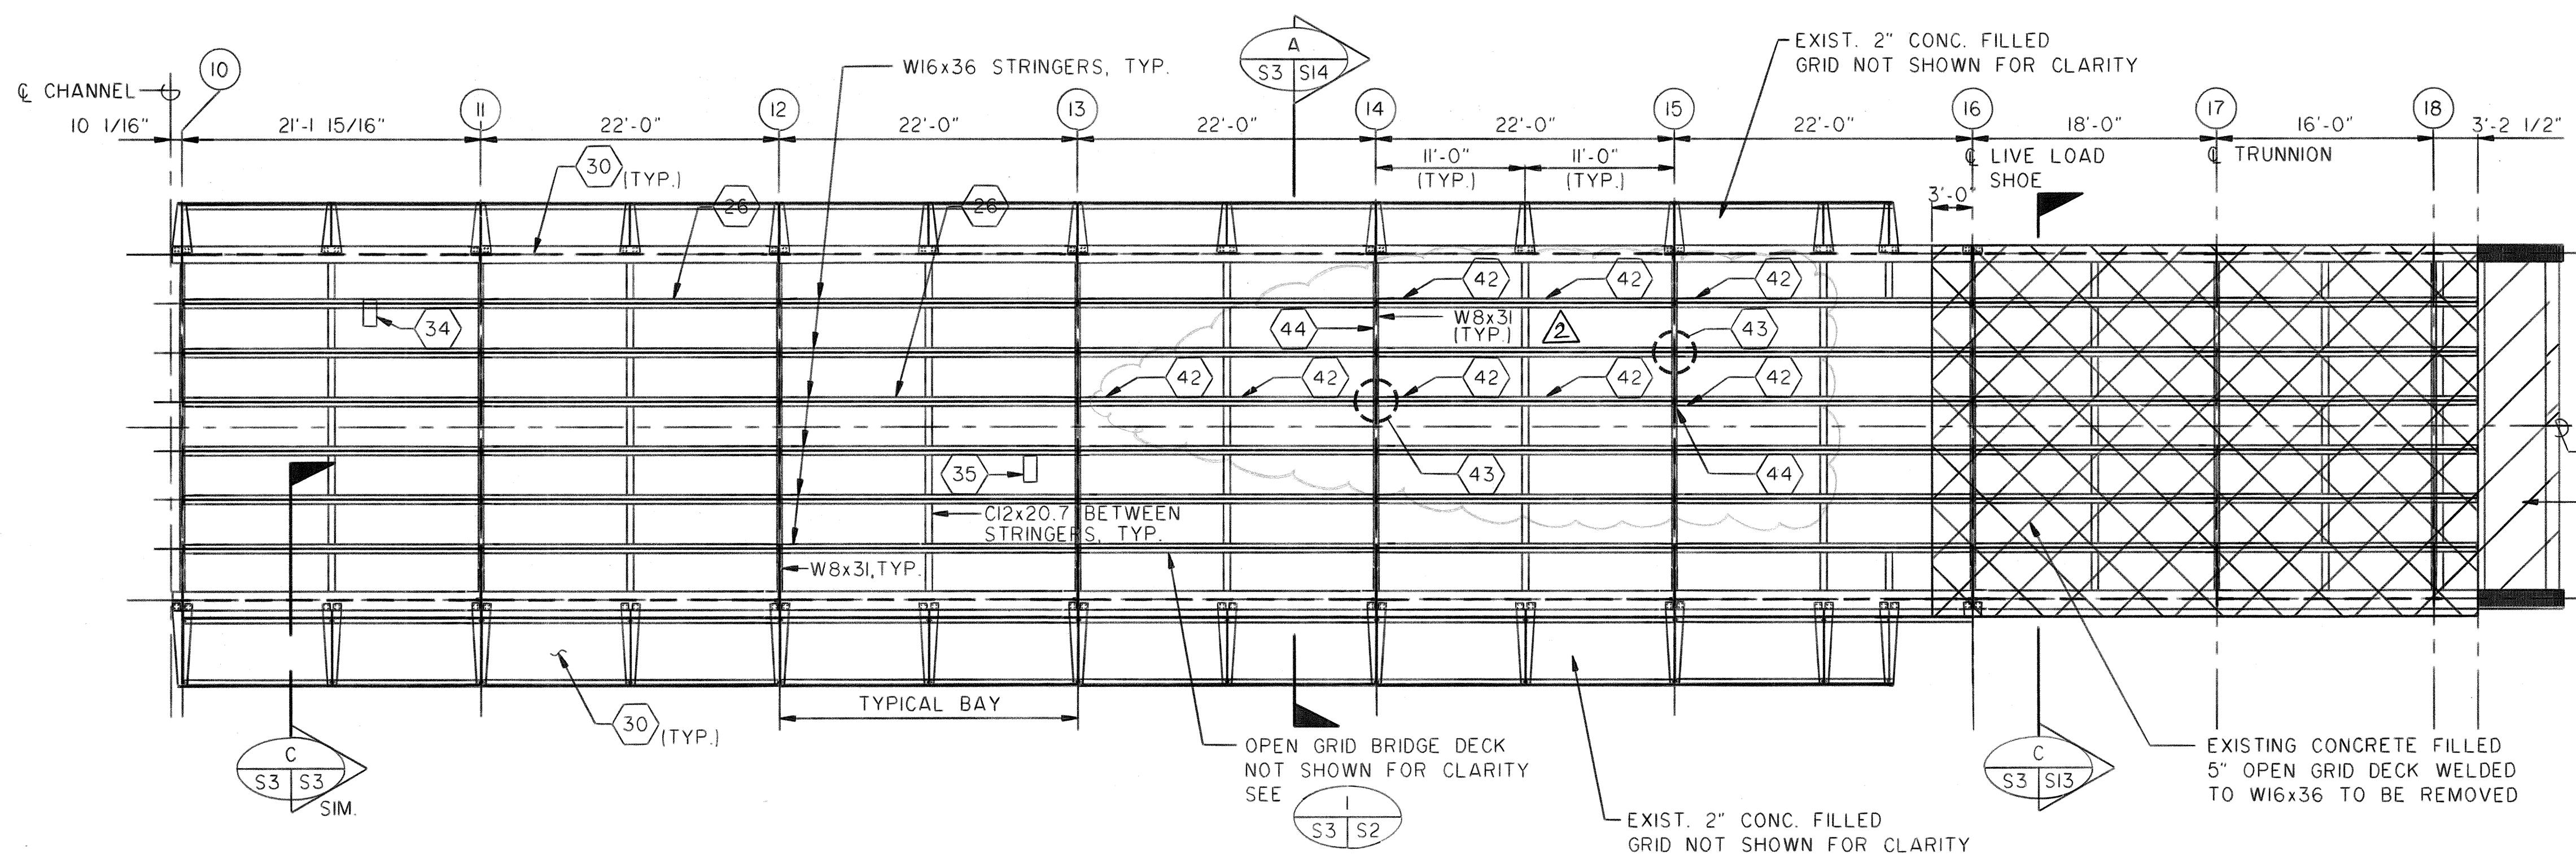


EXIST. PARTIAL DECK FRAMING PLAN
SCALE : 1/8" = 1'-0"

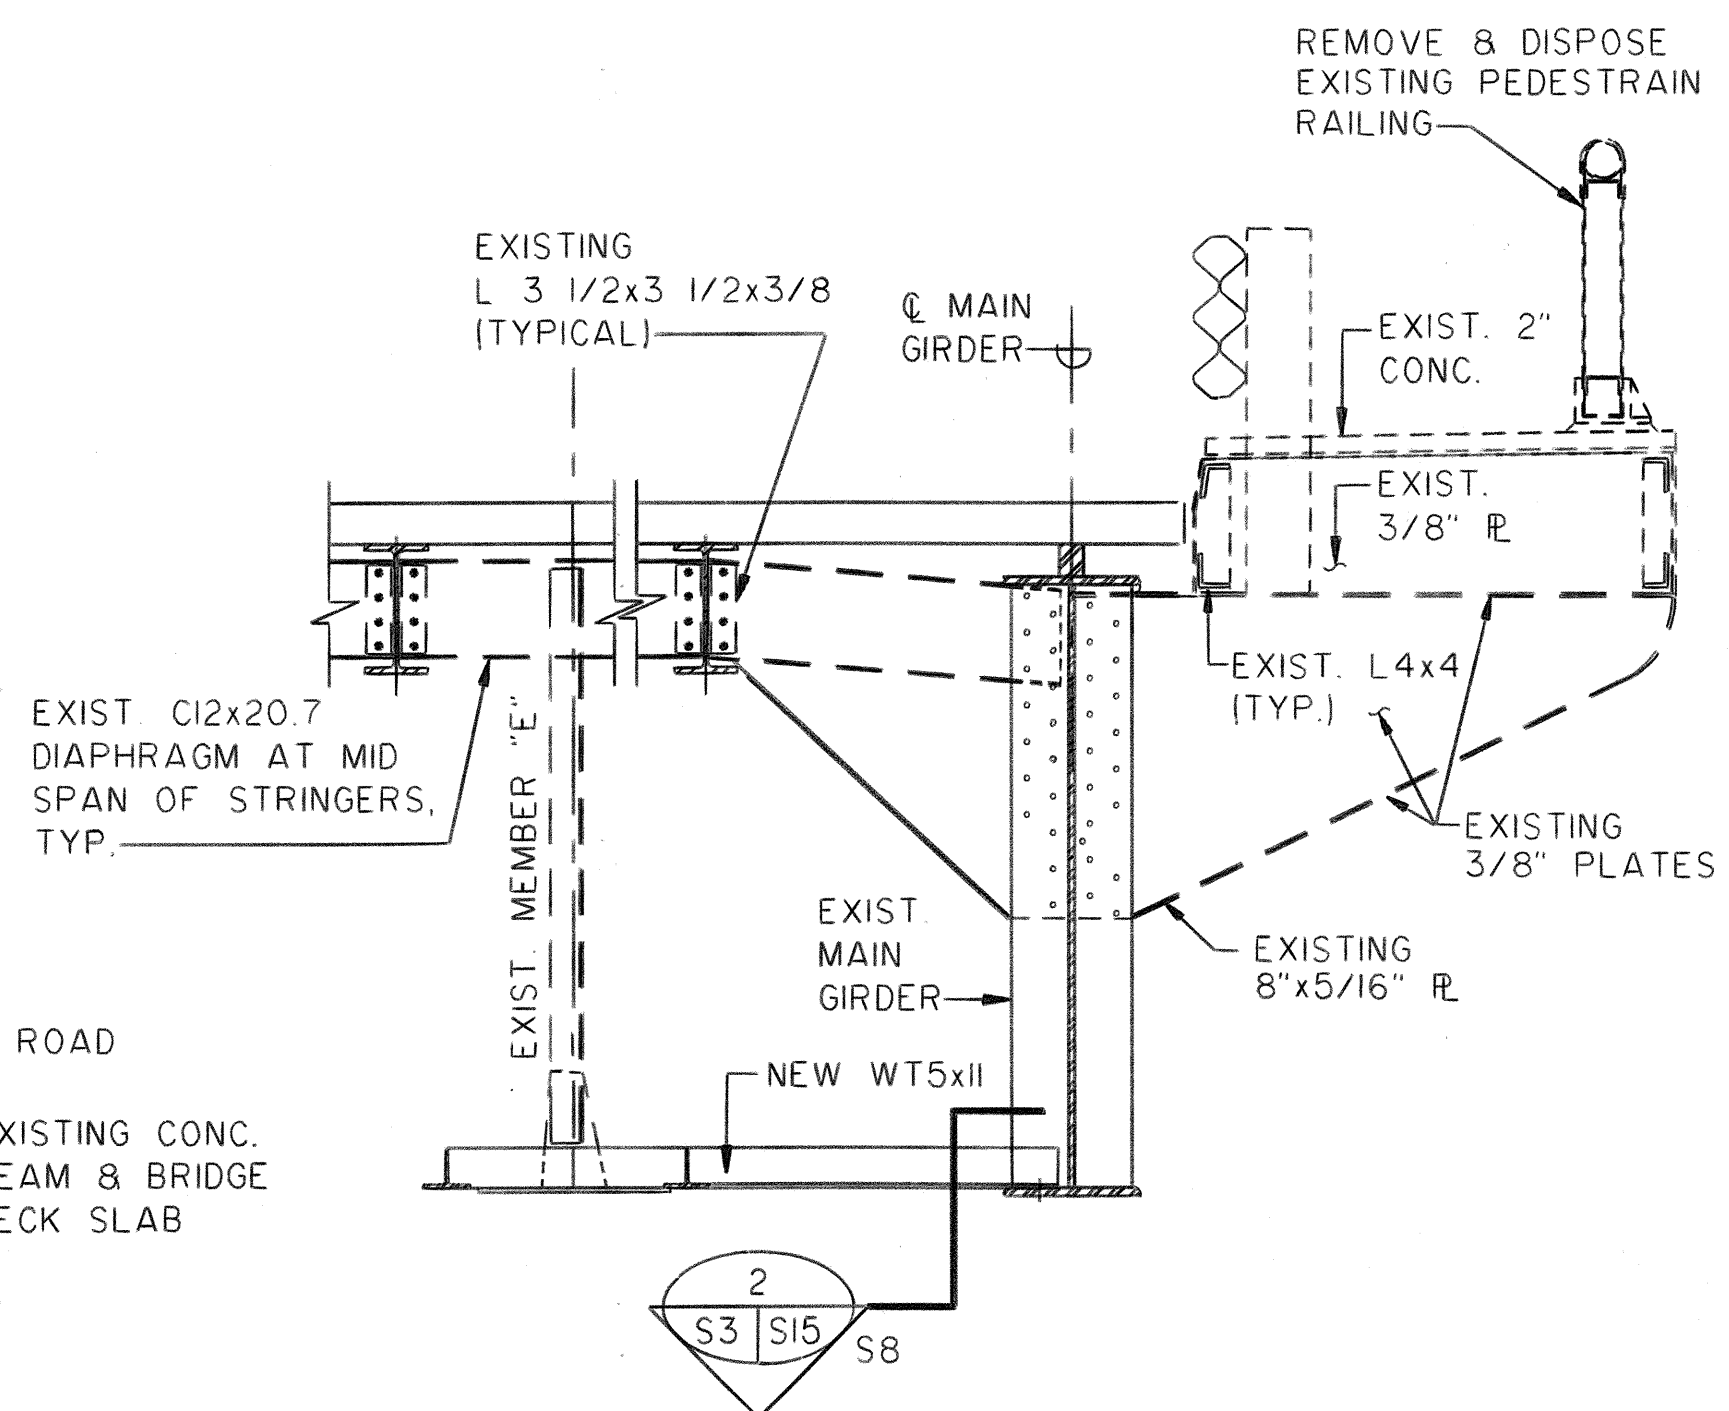

SECTION AT DIAPHRAGM C
SCALE : 1/2"=1'-0"

NOTES:
1. (26) SYMBOL MARK, FOR REPAIR LOCATIONS SEE SHT. S4 FOR REPAIR SCHEDULE.

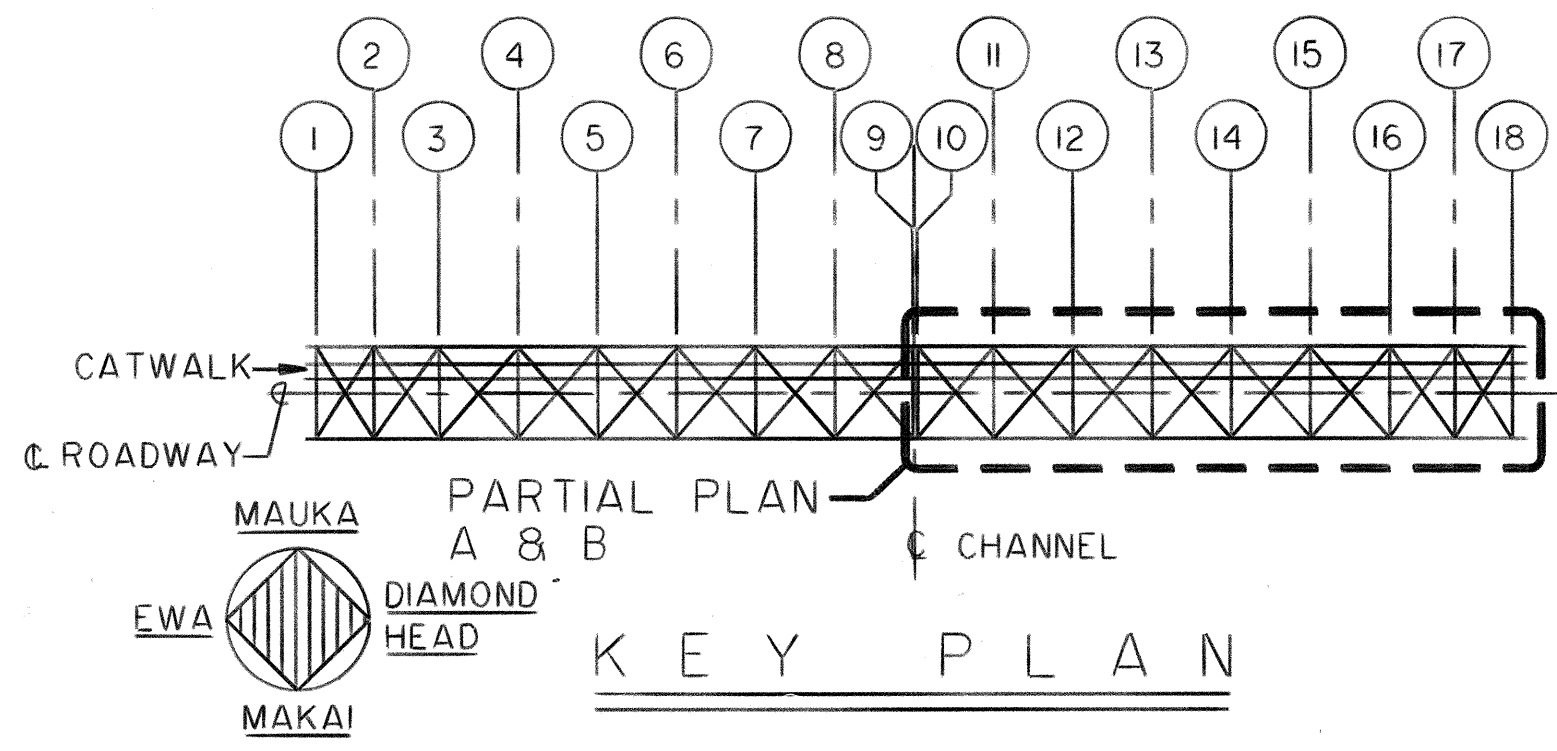

DATE	REVISION
5/4/92	ADDED REPAIR SYMBOLS

THIS WORK WAS PREPARED BY ME OR UNDER MY SUPERVISION

Roscoe O. Ford

STATE OF HAWAII
DEPARTMENT OF TRANSPORTATION
HIGHWAYS DIVISION

EXIST. PART. FRAMING PLANS
AND REPAIR LOCATIONS
BASCULE BRIDGE SPAN
SAND ISLAND BASCULE BRIDGE
REHABILITATION PHASE II
PROJECT NO. BR-064-1(3)

SCALE: AS NOTED DATE: MARCH 1991


SHEET NO. S3 OF S21 SHEETS


ORIGINAL PLAN	DATE
DRAWN BY	
DESIGNED BY	
NOTED BY	
CHECKED BY	
NO.	

REPAIR SCHEDULE

FED. ROAD DIST. NO.	STATE	FED. AID PROJ. NO.	FISCAL YEAR	SHEET NO.	TOTAL SHEETS
HAWAII	HAW.	BR-064-1(3)	1991	11	38

MARK	DESCRIPTION OF REPAIRS	DETAIL	MARK	DESCRIPTION OF REPAIRS	DETAIL	MARK	DESCRIPTION OF REPAIRS	DETAIL	MARK	DESCRIPTION OF REPAIRS	DETAIL
1	REMOVE AND REPLACE EXISTING RUST DAMAGED BOLTS: NOS. 5, 13, 23, 24, 25, 28, 60, 61, 62, 63, 77 & 89.	B&D S4 S5	18	REMOVE AND REPLACE EXISTING RUST DAMAGED BOLTS: NOS. 3, 4, 12, 17, 18, 19, 20, 21, 22, 29, 30, 31, 33, 57, 58, 59, 60, 61, 62, 63, 77 & 89.	B&D S4 S5	35	REPAIR OPEN GRID FLOOR-WELD NEW 1"x7/32"x1'-2" AND 3'-1"x7/32"x0'-5" PLATES.	SEE NOTE 1 THIS SHEET			
2	REMOVE AND REPLACE EXISTING RUST DAMAGED BOLTS: NOS. 5, 6, 13, 23, 24, 25, 26, 27, 28, 57, 58, 59, 60, 61, 62, 63, 77 & 89.	B&D S4 S5	19	REMOVE AND REPLACE EXISTING RUST DAMAGED BOLTS: NOS. 3, 4, 12, 63, 77 & 89.	A&C S4 S5	36	REPLACE WT WITH NEW WT 5x22.5				
3	REMOVE AND REPLACE EXISTING RUST DAMAGED BOLTS: NOS. 5, 6, 13, 23, 24, 25, 26, 51, 52, 53, 57, 58, 59, 60, 61, 62, 63, 77 & 89.	B&D S4 S5	20	REMOVE AND REPLACE EXISTING RUST DAMAGED BOLTS: NOS. 2, 3, 4, 12, 17, 18, 19, 77 & 89.	A&C S4 S5	37	WELD PLATE TO WT WEB	J S4 S5			
4	REMOVE AND REPLACE EXISTING RUST DAMAGED BOLTS: NOS. 5, 13, 14, 23, 24, 25, 26, 57, 58, 59, 60, 61, 62, 63, 77 & 89.	B S4 S5	21	REMOVE AND REPLACE EXISTING RUST DAMAGED BOLTS: NOS. 4, 12, 77 & 89.	A&C S4 S5	38	REPLACE VERTICAL GUSSET PLATE AT CROSS CONNECTION	A S4 S5A			
5	REMOVE AND REPLACE EXISTING RUST DAMAGED BOLTS: NOS. 5, 13, 14, 23, 24, 25, 26, 52, 53, 57, 58, 59, 60, 61, 77 & 89.	B&D S4 S5	22	REMOVE AND REPLACE EXISTING RUST DAMAGED BOLTS: NOS. 3, 4, 12, 17, 19, 20, 61, 62, 63, 77 & 89.	A&C S4 S5	39	REPLACE DOUBLE ANGLE FULL LENGTH				
6	REMOVE AND REPLACE EXISTING RUST DAMAGED BOLTS: NOS. 5, 6, 13, 23, 24, 25, 51, 52, 57, 58, 59, 60, 61, 77 & 89.	B&D S4 S5	23	REMOVE AND REPLACE EXISTING RUST DAMAGED BOLTS: NOS. 3, 4, 12, 17, 18, 19, 20, 21, 22, 57, 58, 59, 60, 61, 62, 63, 77 & 89.	A&C S4 S5	40	REPLACE 3/8 INCH THICK GUSSET PLATE	D S4 S5			
7	REMOVE AND REPLACE EXISTING RUST DAMAGED BOLTS: NOS. 4, 22, 57, 58, 59, 60, 61, 62, 63 & 77.	A&C S4 S5	24	REMOVE AND REPLACE EXISTING RUST DAMAGED BOLTS: NOS. 17, 18, 19, 20, 21, 61, 62, 63, 77 & 89.	A&C S4 S5	41	CUT AND REMOVE BOTTOM 6" OF 3/8 INCH GUSSET PLATE AND REPLACE WITH SAME, BUTT WELDED TO REMAINING PLATE	B S4 S5			
8	REMOVE AND REPLACE EXISTING RUST DAMAGED BOLTS: NOS. 17, 18, 19, 20, 21, 57, 58, 59, 60, 61, 62 & 63.	A&C S4 S5	25	NOT USED		42	ADD L6x3 1/2x1/4 PLATE ONE SIDE OF TOTAL LENGTH OF STEEL BEAM WEB AND 3 FEET LONG OPPOSITE SIDE AT CONNECTION TO FLOOR BEAM EACH SIDE OF CONNECTION	K S4 S5 C S4 S5A			
9	REMOVE AND REPLACE EXISTING RUST DAMAGED BOLTS: NOS. 4, 19, 20, 21, 57, 58, 59, 60, 61, 77 & 89.	A&C S4 S5	26	PATCH HOLE WITH WELD ON PLATE AND PAINT TO MINIMIZE FUTURE RUST DAMAGE.	E S4 S5	43	ADD L4x3x1/4x3'-0" TWO SIDES OF STEEL BEAM WEB	K S4 S5 C S4 S5A			
10	REMOVE AND REPLACE EXISTING RUST DAMAGED BOLTS: NOS. 4, 77 & 89.	A&C S4 S5	27	PATCH HOLE WITH WELD ON PLATE AND PAINT TO MINIMIZE FUTURE RUST DAMAGE.	H S4 S5	44	ADD L4x3x1/4x3'-0" TWO SIDES OF W8x31	D S4 S5A			
11	REMOVE AND REPLACE EXISTING RUST DAMAGED BOLTS: NOS. 4, 77 & 89.	A&C S4 S5	28	PATCH HOLE WITH WELD ON PLATE AND PAINT TO MINIMIZE FUTURE RUST DAMAGE.	F S4 S5						
12	REMOVE AND REPLACE EXISTING RUST DAMAGED BOLTS: NOS. 2, 3, 4, 12, 77 & 89.	A&C S4 S5	29	REMOVE EXISTING CATWALK STEEL GRATING AND REPLACE. REPLACE CATWALK GRATING BETWEEN FLOOR BEAM LINES 3 THRU 16.	A S4 S14						
13	REMOVE AND REPLACE EXISTING RUST DAMAGED BOLTS: NOS. 3, 4, 12, 17, 18, 19, 46, 61, 62, 77 & 89.	B&D S4 S5	30	DEMOLISH AND REMOVE EXISTING SIDEWALK AND CURB.	A S4 S14						
14	REMOVE AND REPLACE EXISTING RUST DAMAGED BOLTS: NOS. 2, 3, 4, 10, 11, 12, 17, 18, 19, 20, 30, 31, 45, 46, 57, 58, 59, 60, 61, 62 & 63.	B&D S4 S5	31	REPAIR OPEN GRID FLOOR-WELD NEW 1"x7/32"x1'-6", 1"x7/32"x1'-3", 5'-1"x7/32"x0'-5" AND 2'-1/16"x13/64"x1'-7". RESET 2 PIECES AND WELD.	SEE NOTE 1 THIS SHEET						
15	REMOVE AND REPLACE EXISTING RUST DAMAGED BOLTS: NOS. 2, 3, 4, 5, 6, 10, 11, 12, 17, 18, 19, 20, 23, 24, 25, 26, 30, 31, 45, 46, 53, 57, 58, 59, 60, 61, 62, 63, 77 & 89.	B&D S4 S5	32	REPAIR OPEN GRID FLOOR-WELD NEW 1"x7/32"x1'-0" PLATE.	SEE NOTE 1 THIS SHEET						
16	REMOVE AND REPLACE EXISTING RUST DAMAGED BOLTS: NOS. 5, 13, 17, 18, 19, 20, 23, 24, 25, 26, 29, 30, 31, 32, 43, 44, 45, 57, 58, 59, 60, 61, 62, 63, 77 & 89.	B&D S4 S5	33	REPAIR OPEN GRID FLOOR-WELD NEW 1"x7/32"x2'-6" PLATE.	SEE NOTE 1 THIS SHEET						
17	REMOVE AND REPLACE EXISTING RUST DAMAGED BOLTS: NOS. 2, 3, 4, 10, 11, 12, 17, 18, 19, 20, 21, 22, 23, 24, 25, 26, 27, 28, 29, 30, 31, 32, 33, 44, 45, 46, 47, 57, 58, 59, 60, 61, 62, 63, 77 & 89.	B&D S4 S5	34	REPAIR OPEN GRID FLOOR-WELD NEW 1"x7/32"x0'-8" PLATE.	SEE NOTE 1 THIS SHEET						
						2 5/4/92	ADDED REPAIRS TO SCHEDULE				
						DATE	REVISION				

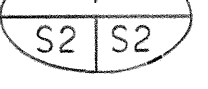- NOTES:
1. FIELD VERIFY CONFIGURATION OF BAR ARRANGEMENT FOR REPAIR. PRIOR TO FABRICATION SEE  FOR TYPICAL DECK DETAIL.
2. WORK INDICATED ON THIS SHEET TO BE PAID FOR UNDER PAY ITEM 501.0200 STRUCTURAL STEEL.

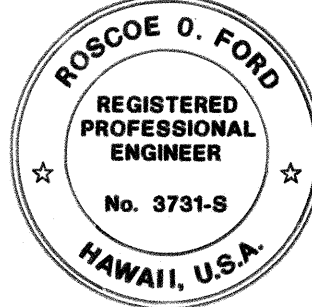

THIS WORK WAS PREPARED BY ME OR UNDER MY SUPERVISION

Roscoe O. Ford

STATE OF HAWAII
DEPARTMENT OF TRANSPORTATION
HIGHWAYS DIVISION

REPAIR SCHEDULE

SAND ISLAND BASCULE BRIDGE
REHABILITATION PHASE II

PROJECT NO. BR-064-1(3)


SCALE: AS NOTED DATE: MARCH 1991

SHEET No. 54 OF 521 SHEETS


C.O. 11

SURVEY PLOTTED BY	DATE
DRAWN BY	
TRACED BY	
QUANTITIES BY	
CHECKED BY	
ORIGINAL PLAN	
NOTEBOOK	
No.	


FED. ROAD DIST. NO.	STATE	FED. AID PROJ. NO.	FISCAL YEAR	SHEET NO.	TOTAL SHEETS
HAWAII	HAW.	BR-064-1(3)	1991	12	38

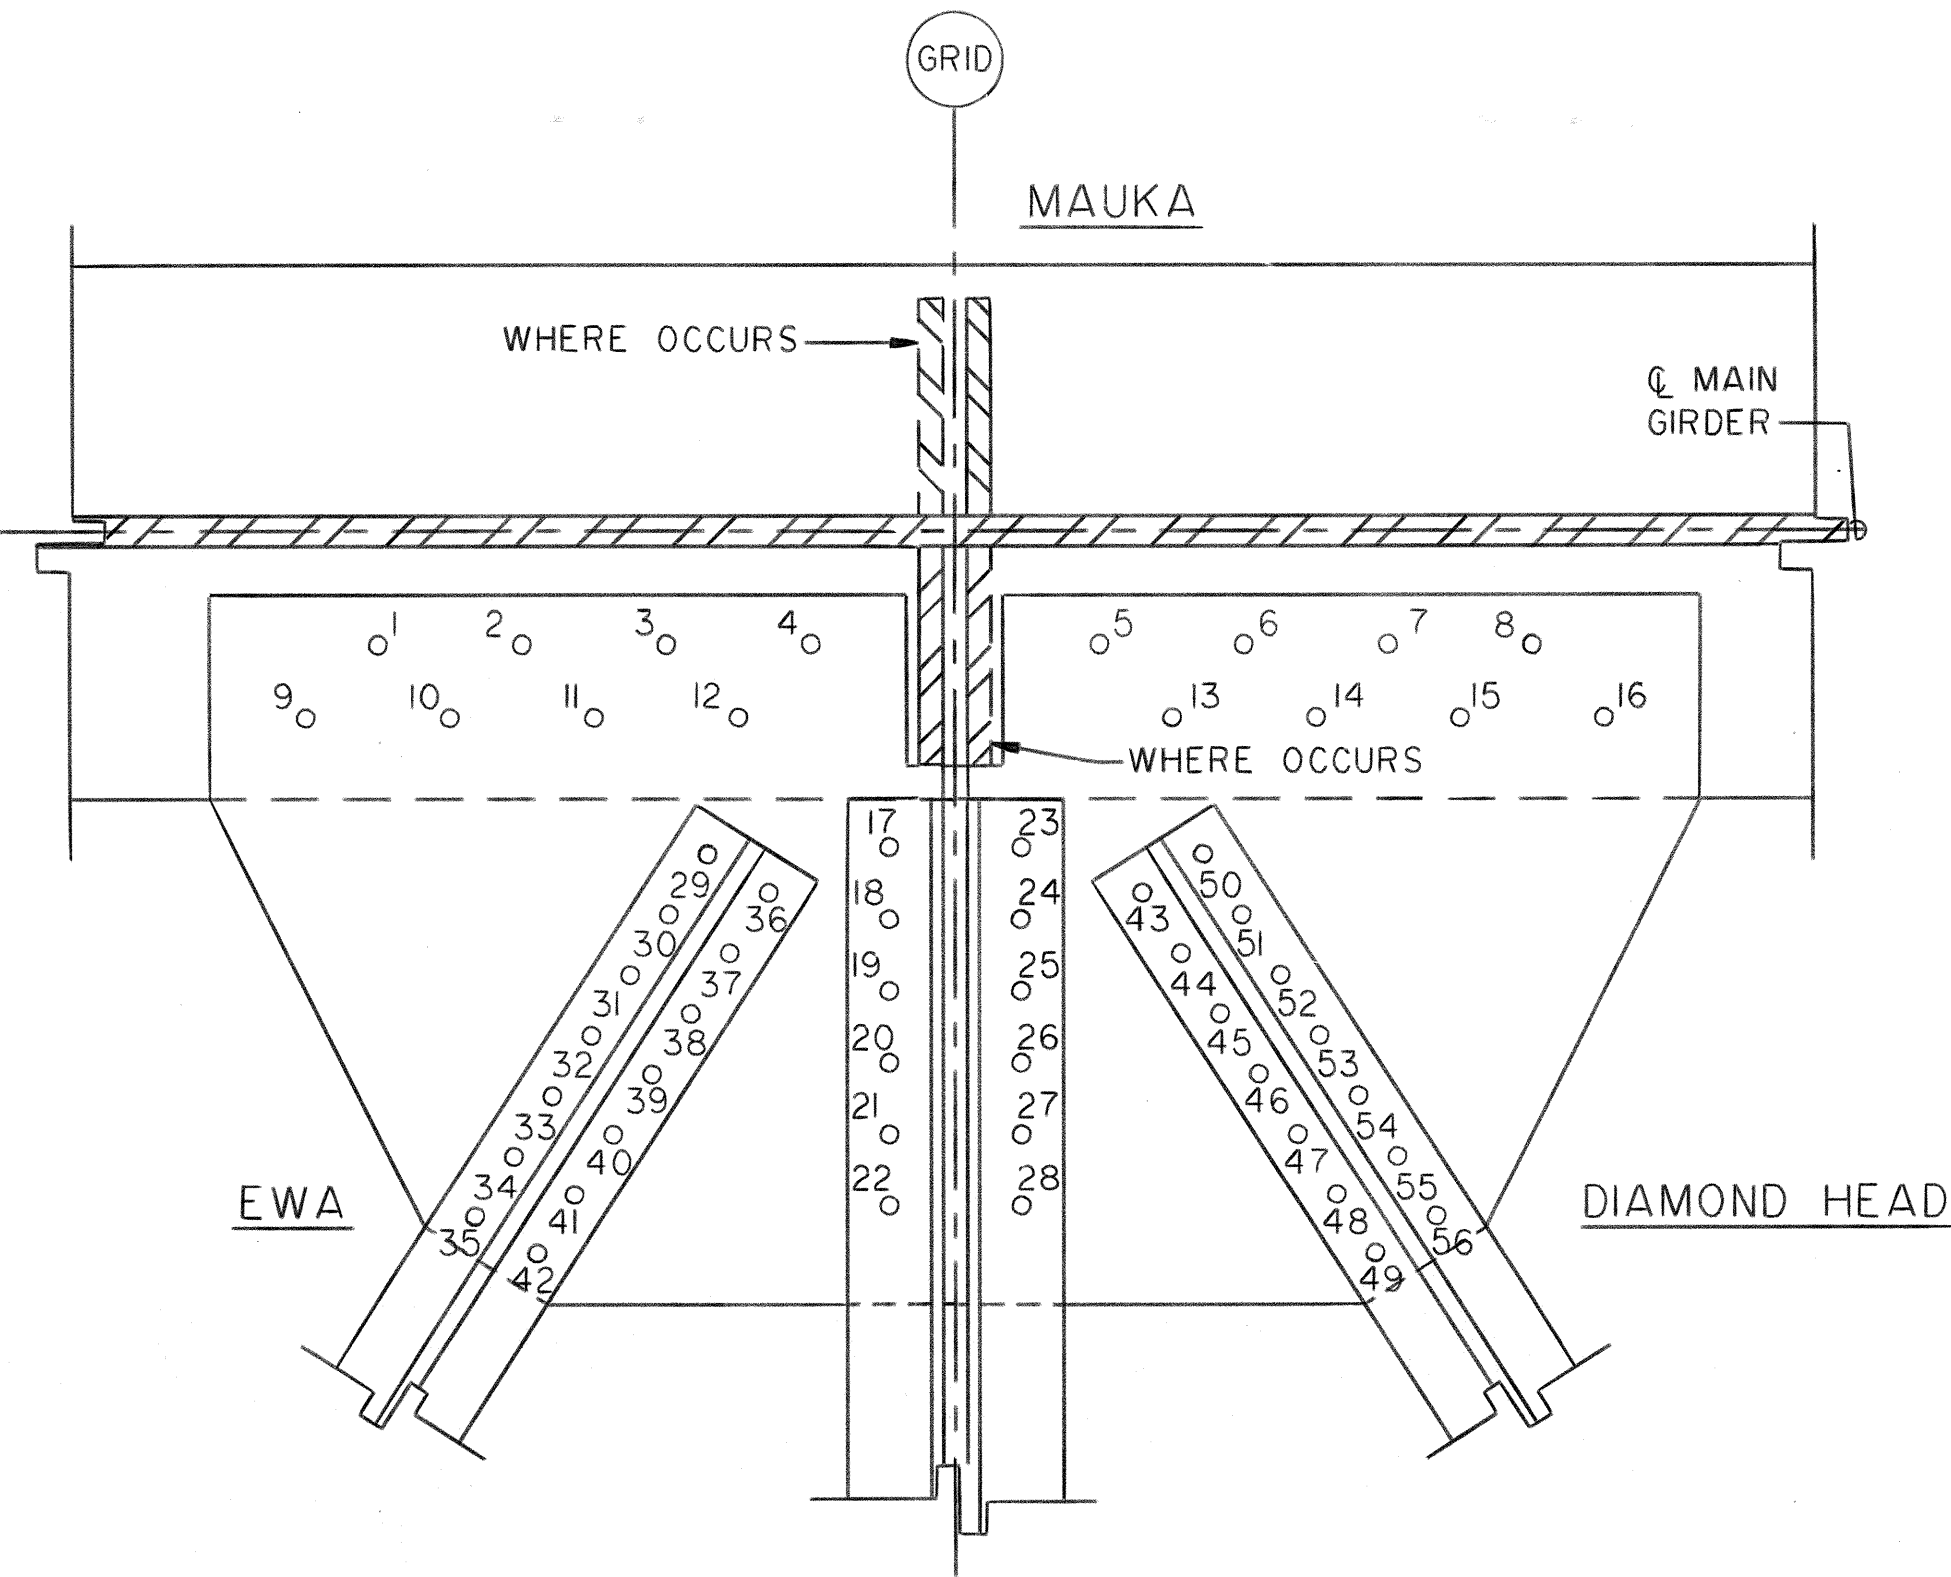


PLAN - SECTION B
SCALE : 1 1/2" = 1'-0"

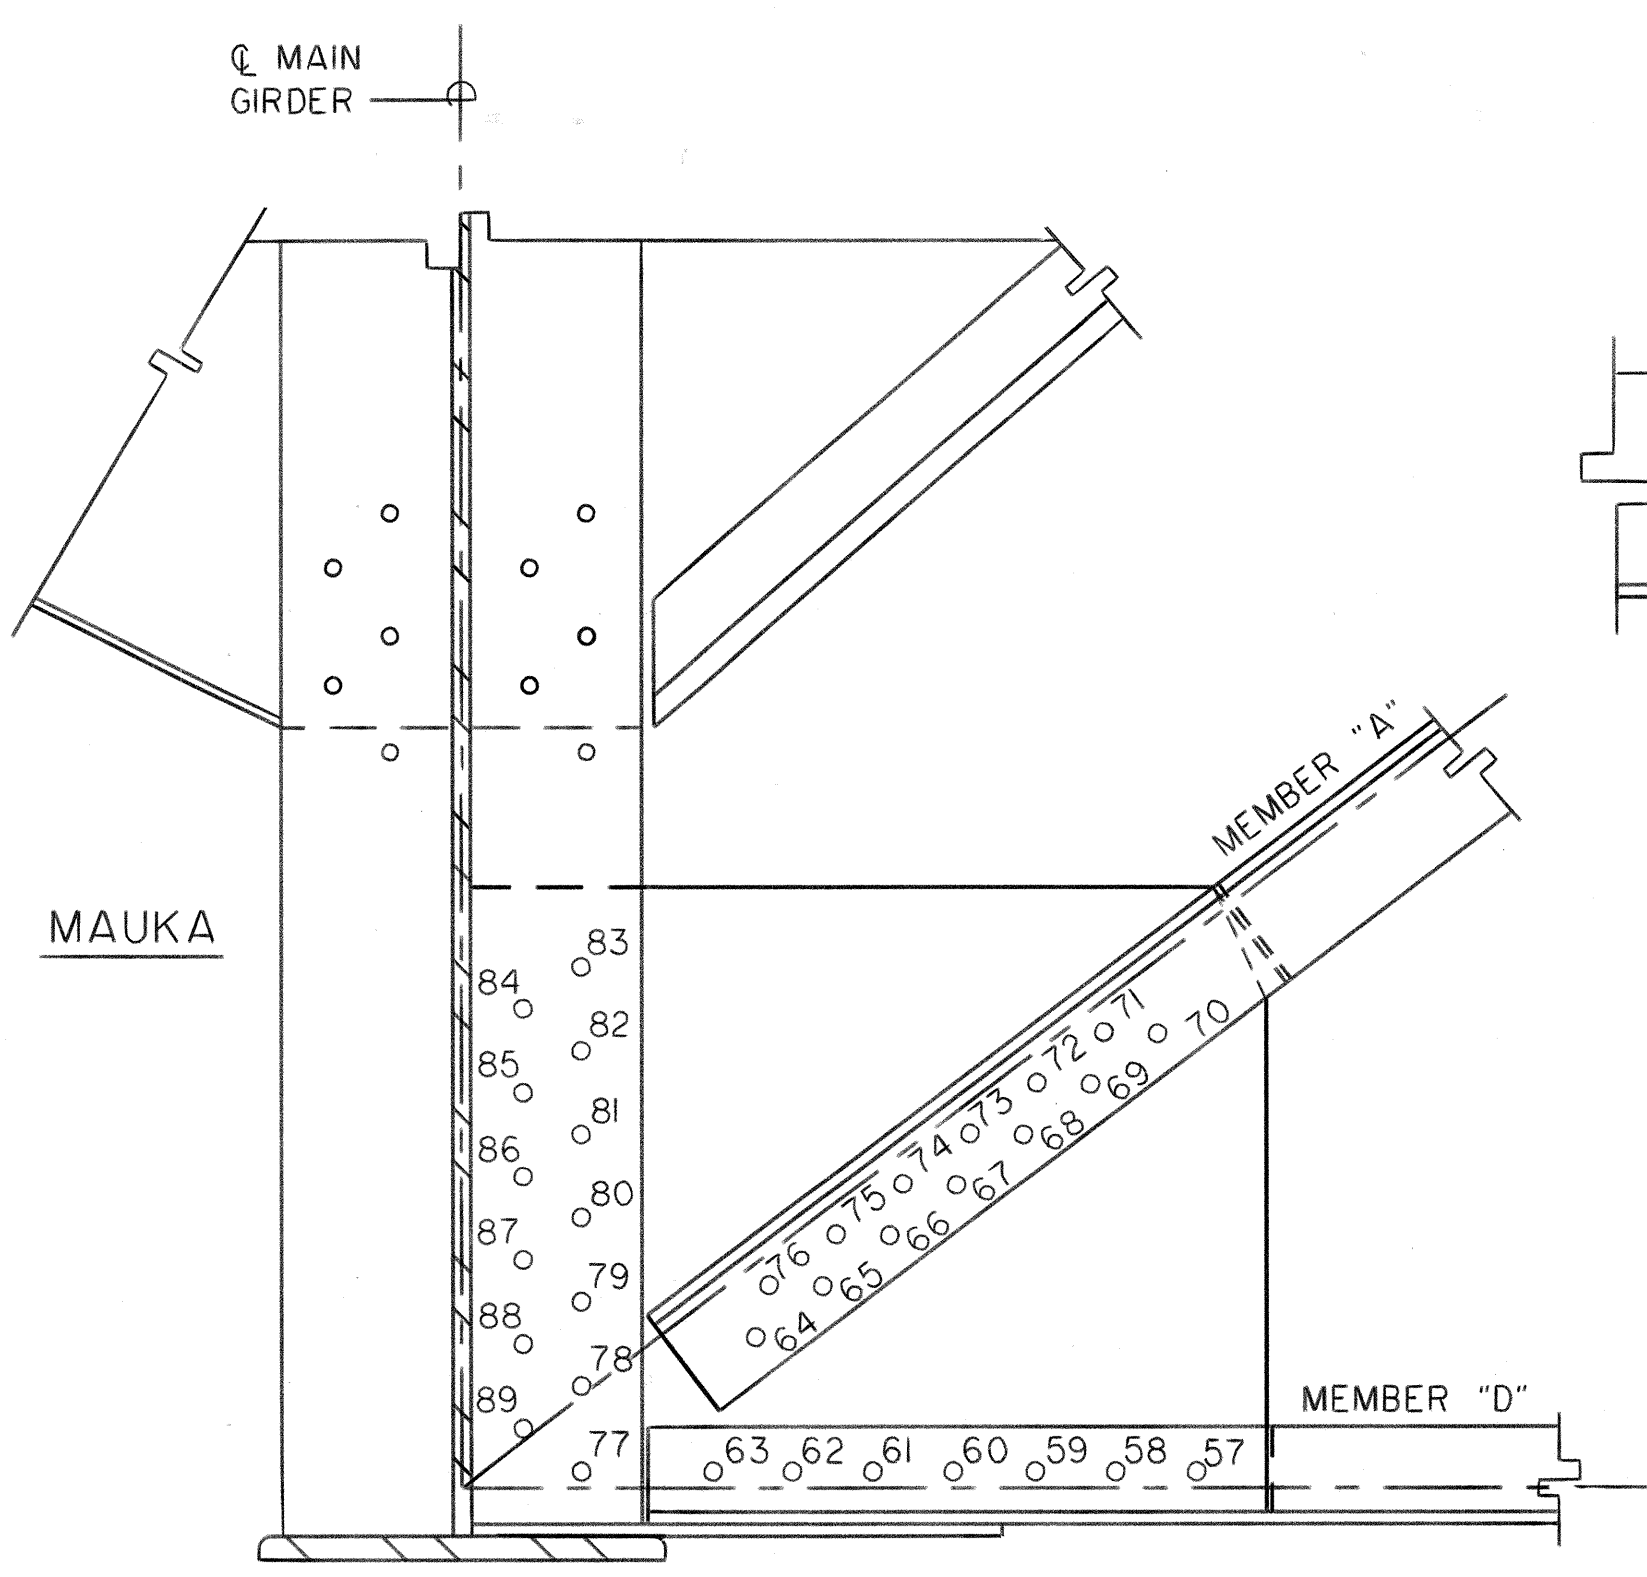


NOTE: ALL BOLTS 7/8"Ø ASTM A325, GALVANIZED HIGH STRENGTH BOLTS.

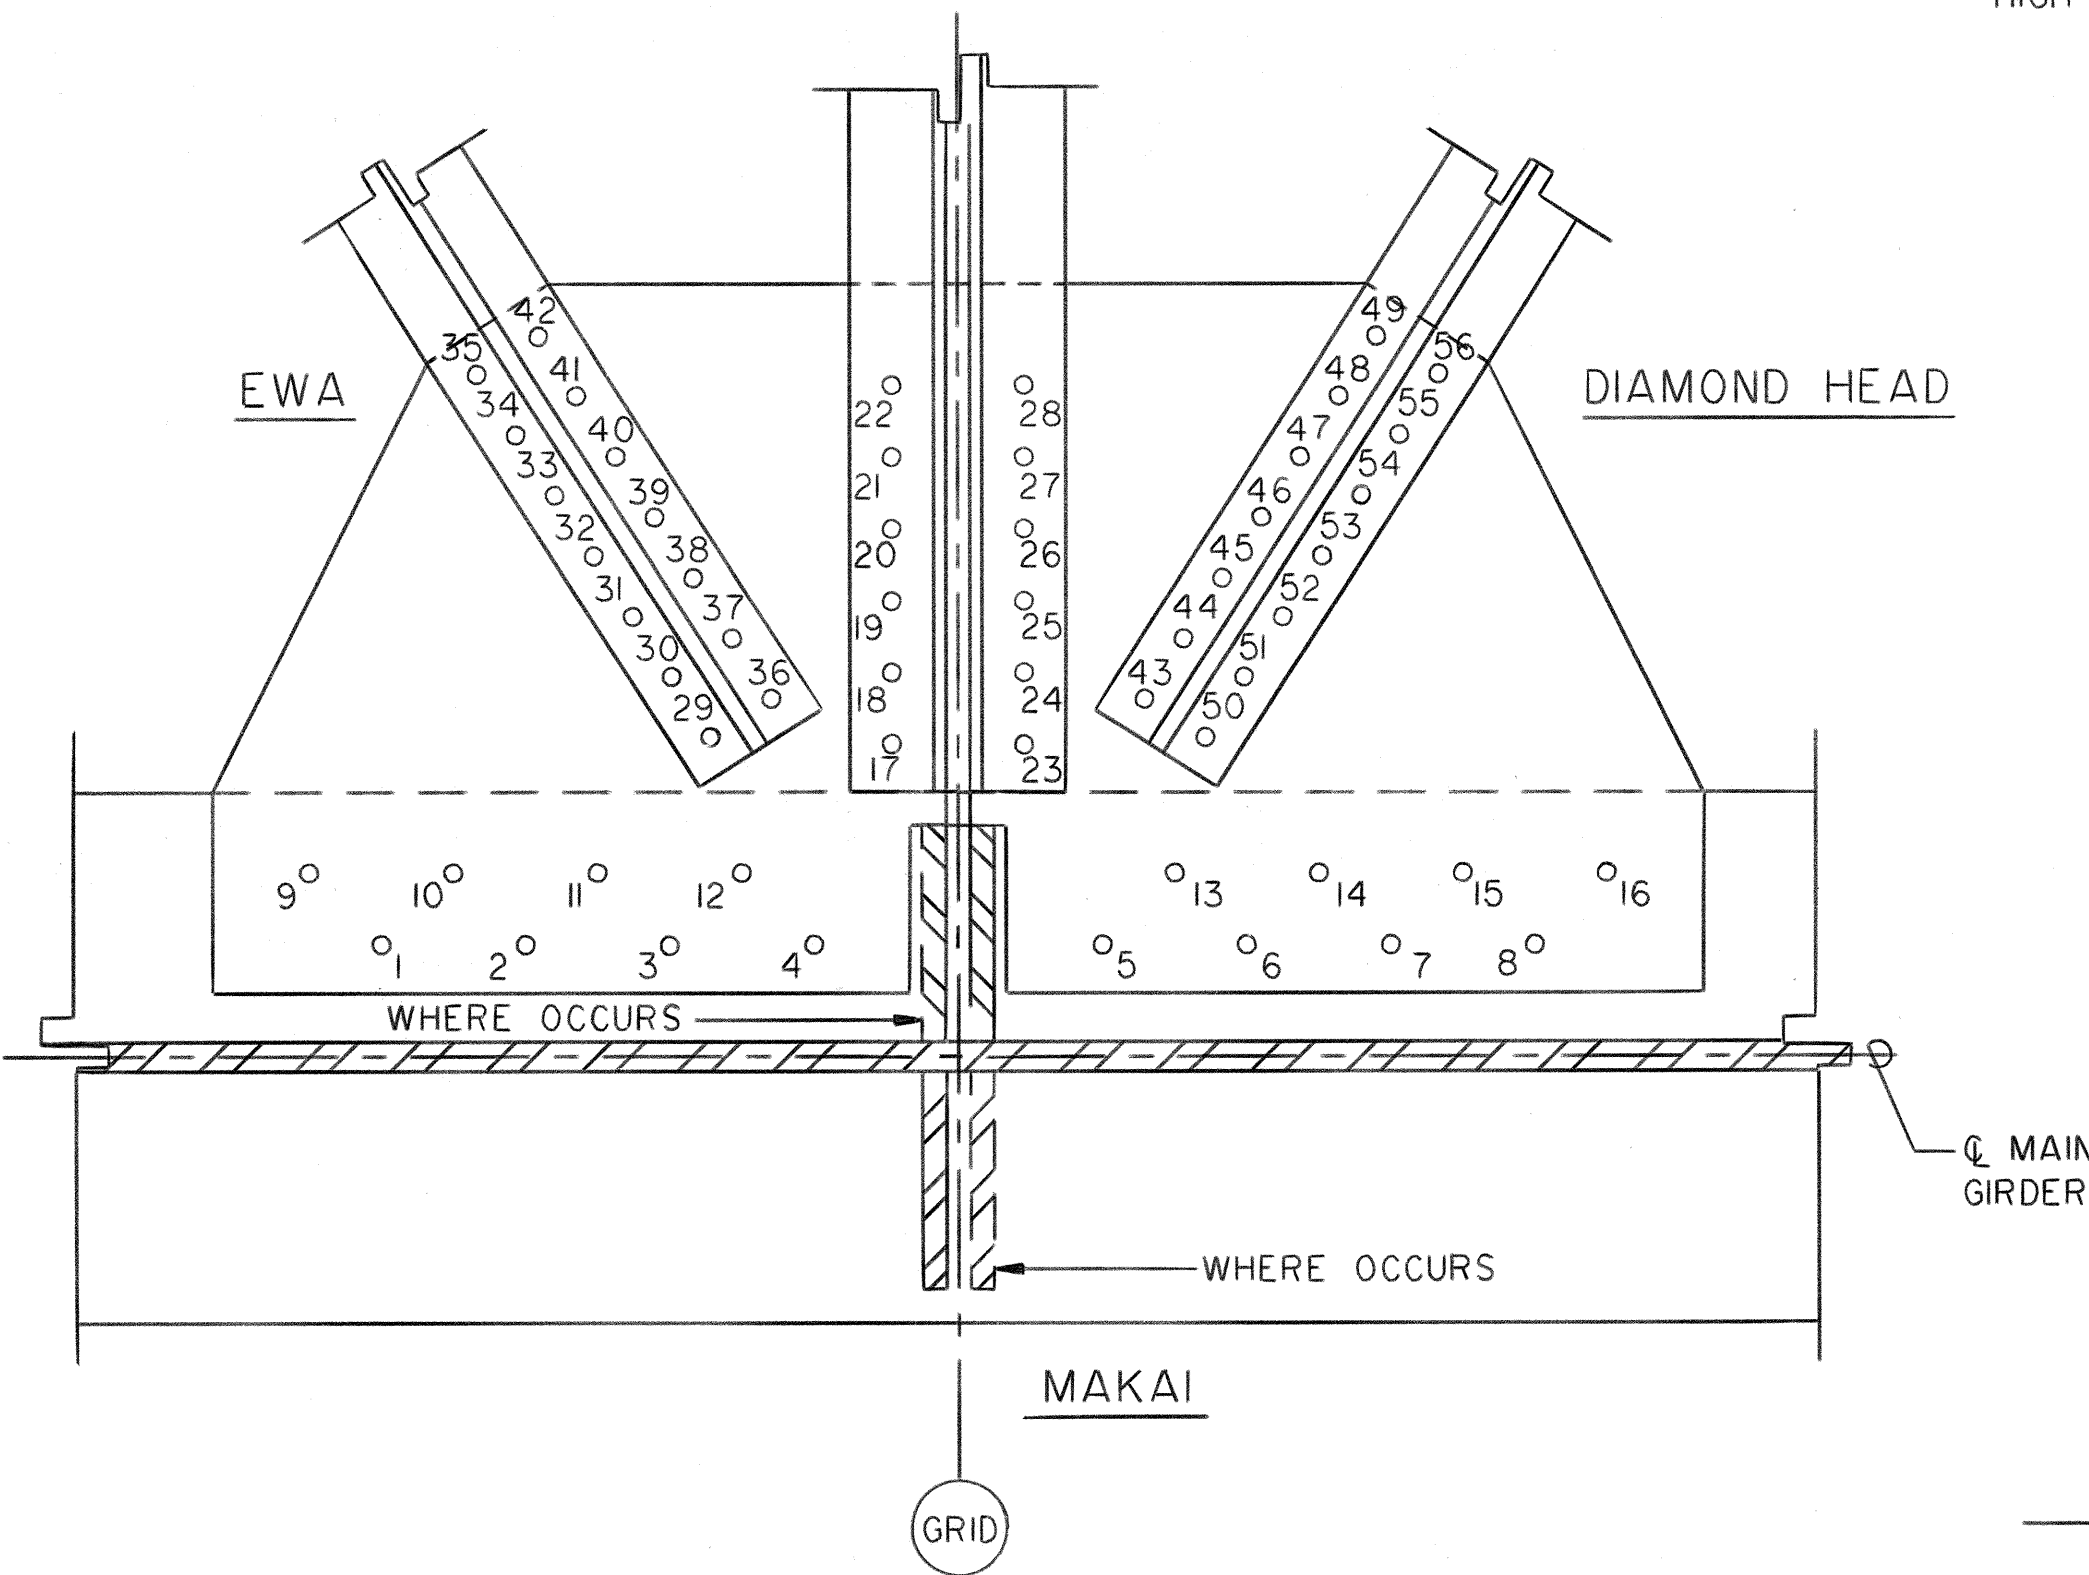


PLAN - SECTION A
SCALE : 1 1/2" = 1'-0"

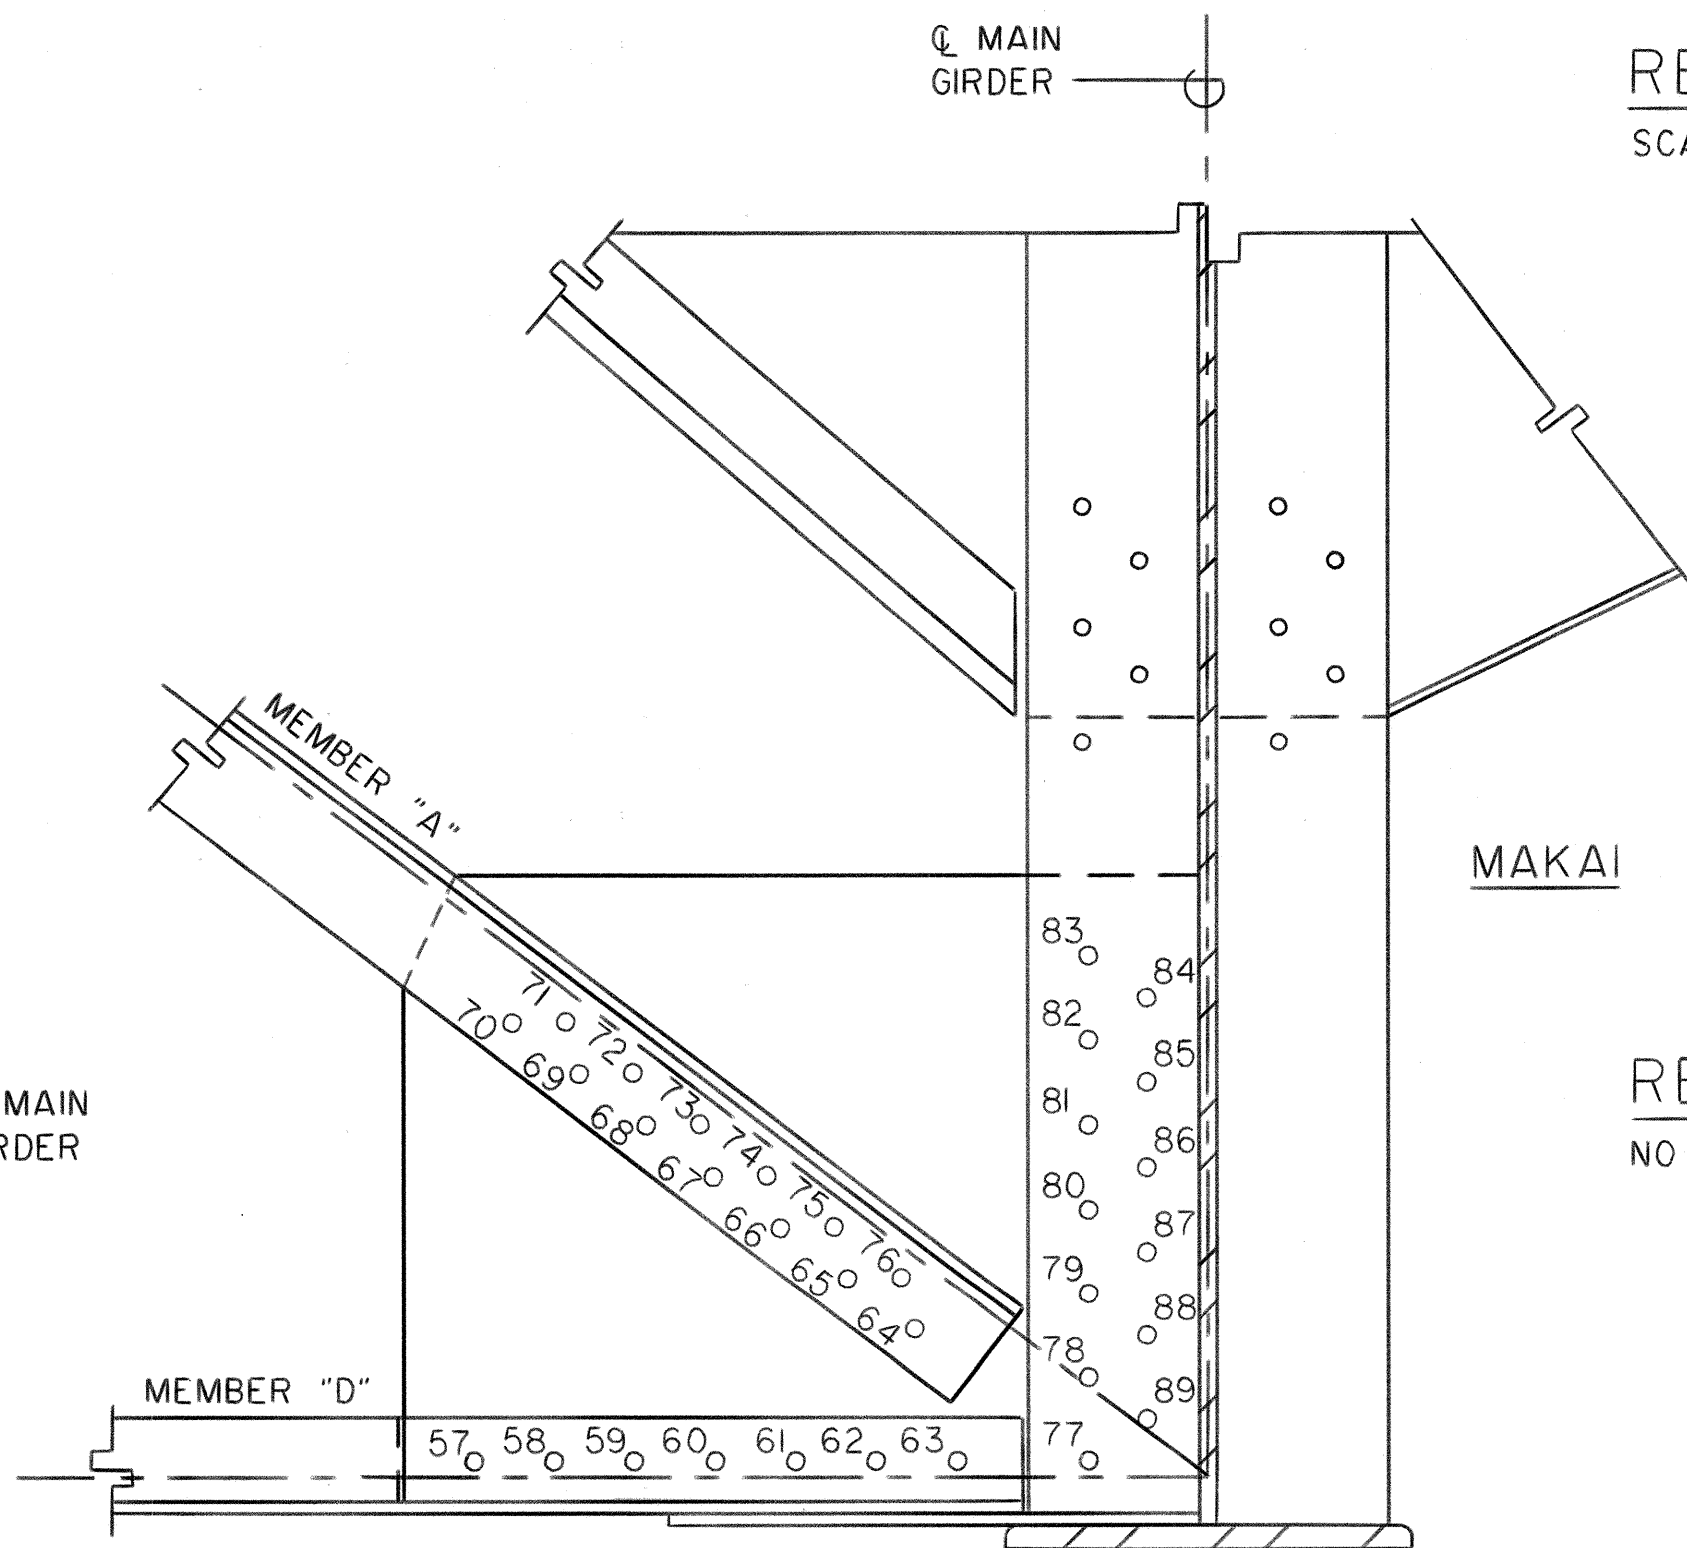


ELEVATION - SECTION C
SCALE : 1 1/2" = 1'-0"

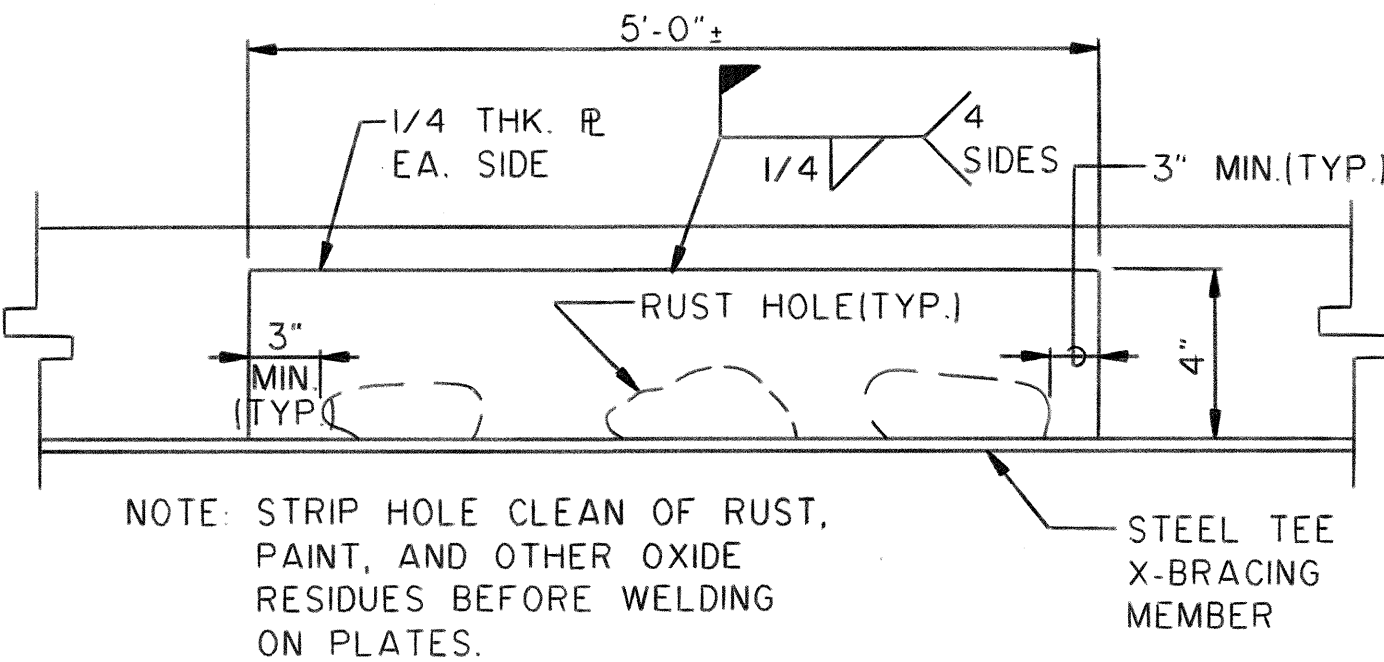


REPAIR DETAIL-ELEVATION H
NO SCALE

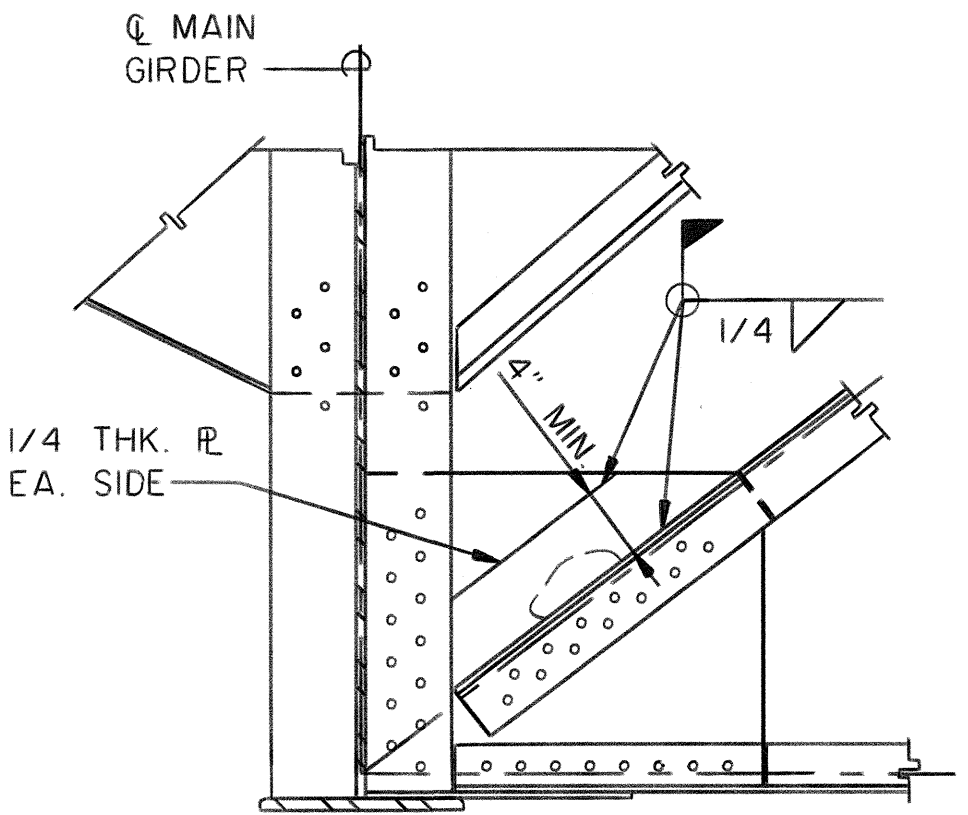


REPAIR DETAIL-ELEVATION F
SCALE : 3/4" = 1'-0"

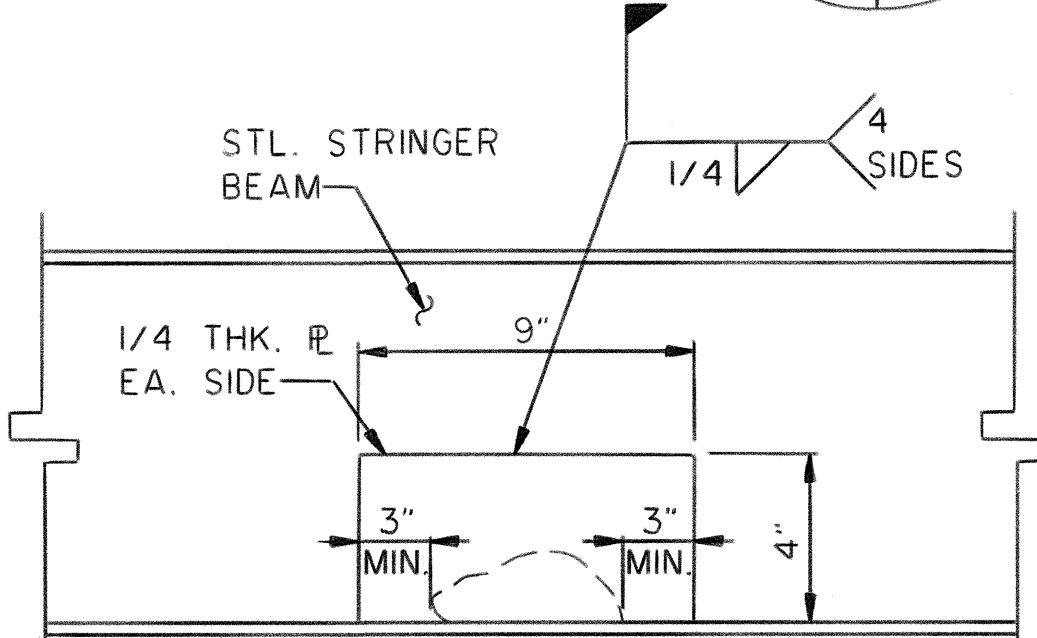


REPAIR DETAIL-ELEVATION E
NO SCALE

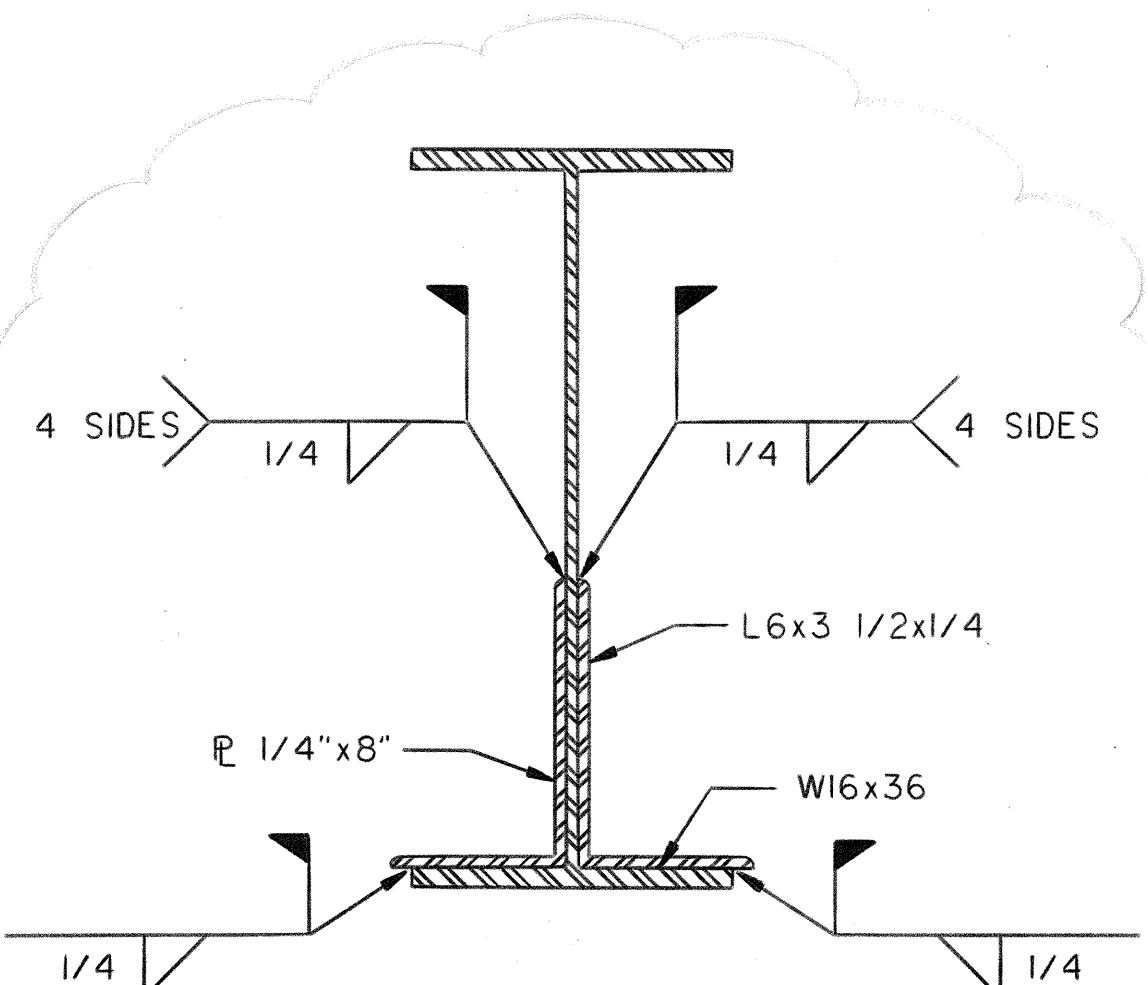

REPAIR DETAIL-ELEVATION K
NO SCALE

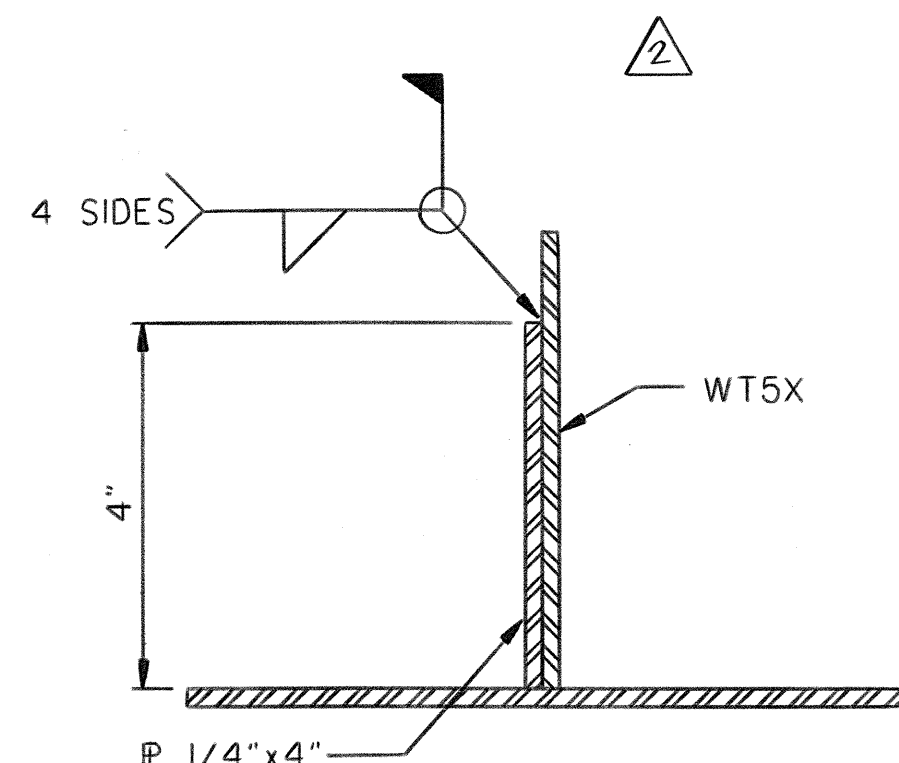

REPAIR DETAIL-ELEVATION J
NO SCALE

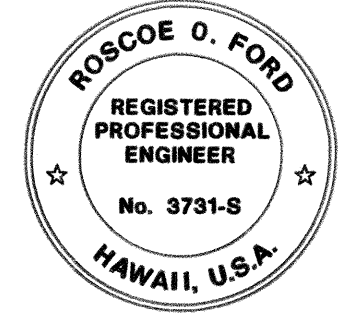

THIS WORK WAS PREPARED BY ME OR UNDER MY SUPERVISION
Roboe O. Ford


STATE OF HAWAII
DEPARTMENT OF TRANSPORTATION
HIGHWAYS DIVISION
JOINT AND REPAIR DETAILS

SAND ISLAND BASCULE BRIDGE
REHABILITATION PHASE II
PROJECT NO. BR-064-1(3)
SCALE: AS NOTED DATE: MARCH 1991
SHEET NO. 55 OF 521 SHEETS


DATE
5/4/92

REVISION


FED. ROAD DIST. NO.	STATE	FED. AID PROJ. NO.	FISCAL YEAR	SHEET NO.	TOTAL SHEETS
HAWAII	HAW.	BR-064-1(3)	1991	12	38

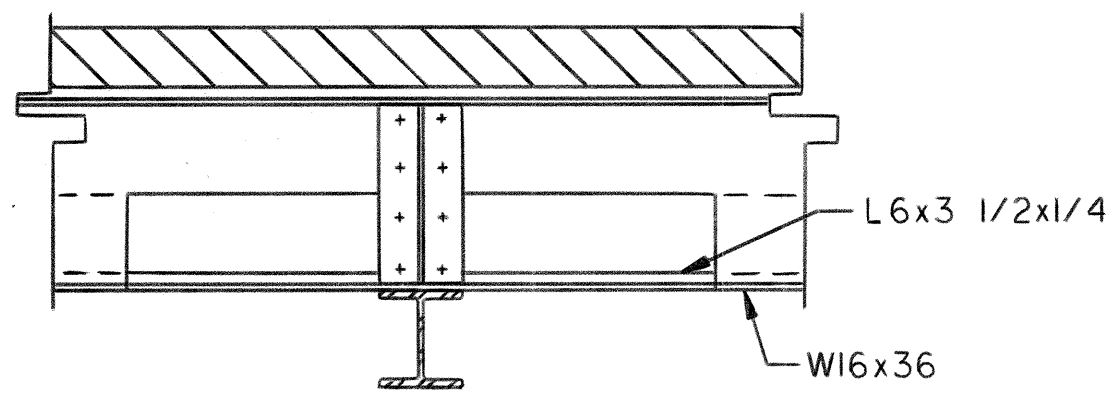


SECTION C
SCALE : 3/4" = 1'-0"

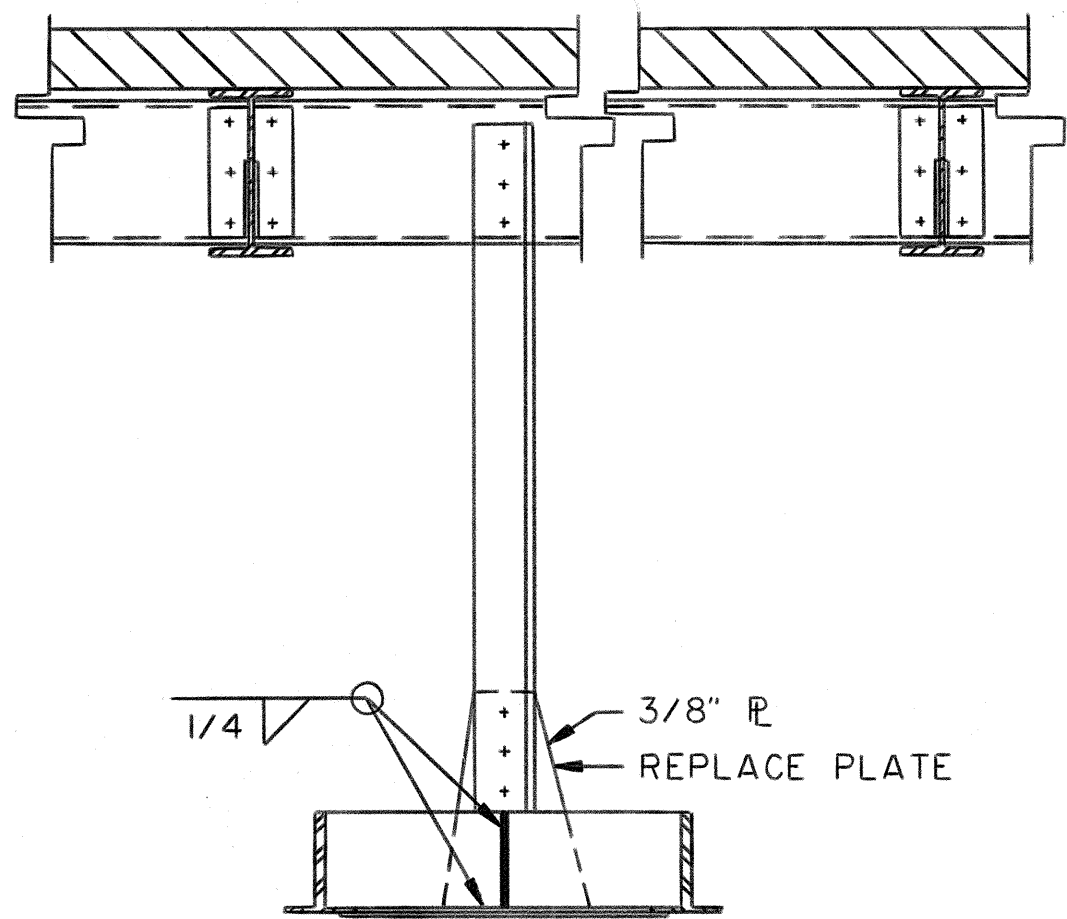

SECTION B
SCALE : 3/4" = 1'-0"

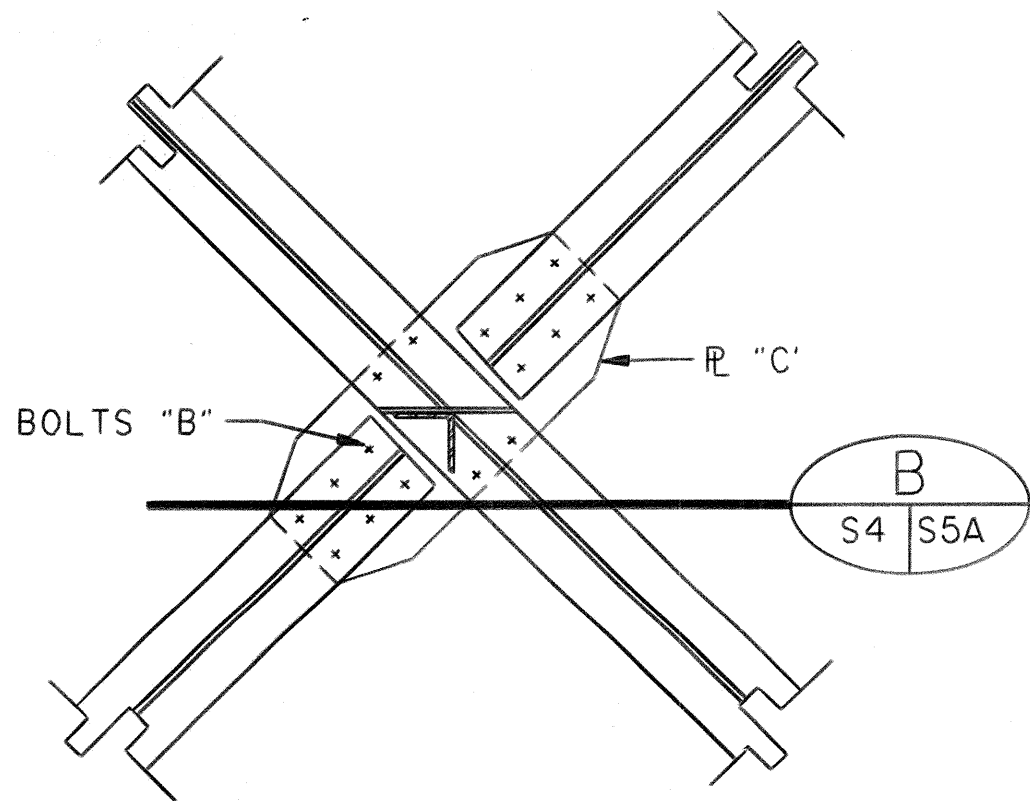

PLAN - SECTION A
SCALE : 3/4" = 1'-0"

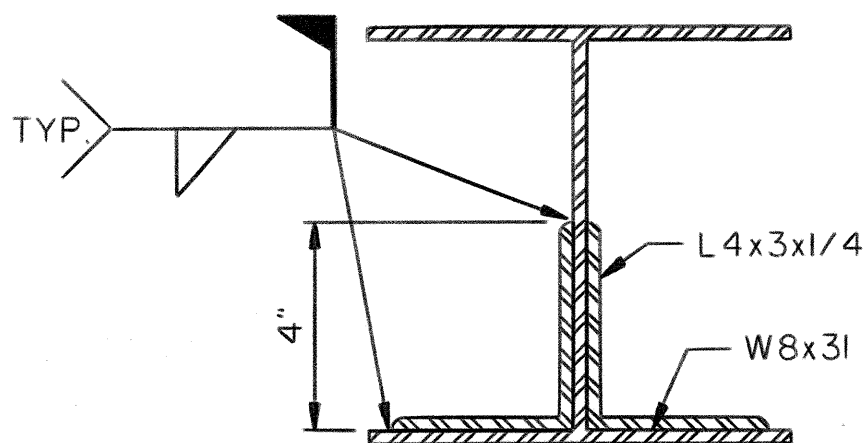

SECTION D
NO SCALE

THIS WORK WAS PREPARED BY ME OR UNDER MY SUPERVISION

Roscoe O. Ford


STATE OF HAWAII
DEPARTMENT OF TRANSPORTATION
HIGHWAYS DIVISION
JOINT AND REPAIR DETAILS

SAND ISLAND BASCULE BRIDGE
REHABILITATION PHASE II
PROJECT NO. BR-064-1(3)
SCALE: AS NOTED DATE: MARCH 1991
SHEET No. S5A OF S21 SHEETS


5/4/92
DATE

ADDED THIS SHEET
REVISION


FED. ROAD DIST. NO.	STATE	FED. AID PROJ. NO.	FISCAL YEAR	SHEET NO.	TOTAL SHEETS
HAWAII	HAW.	BR-064-1(3)	1991	13	38

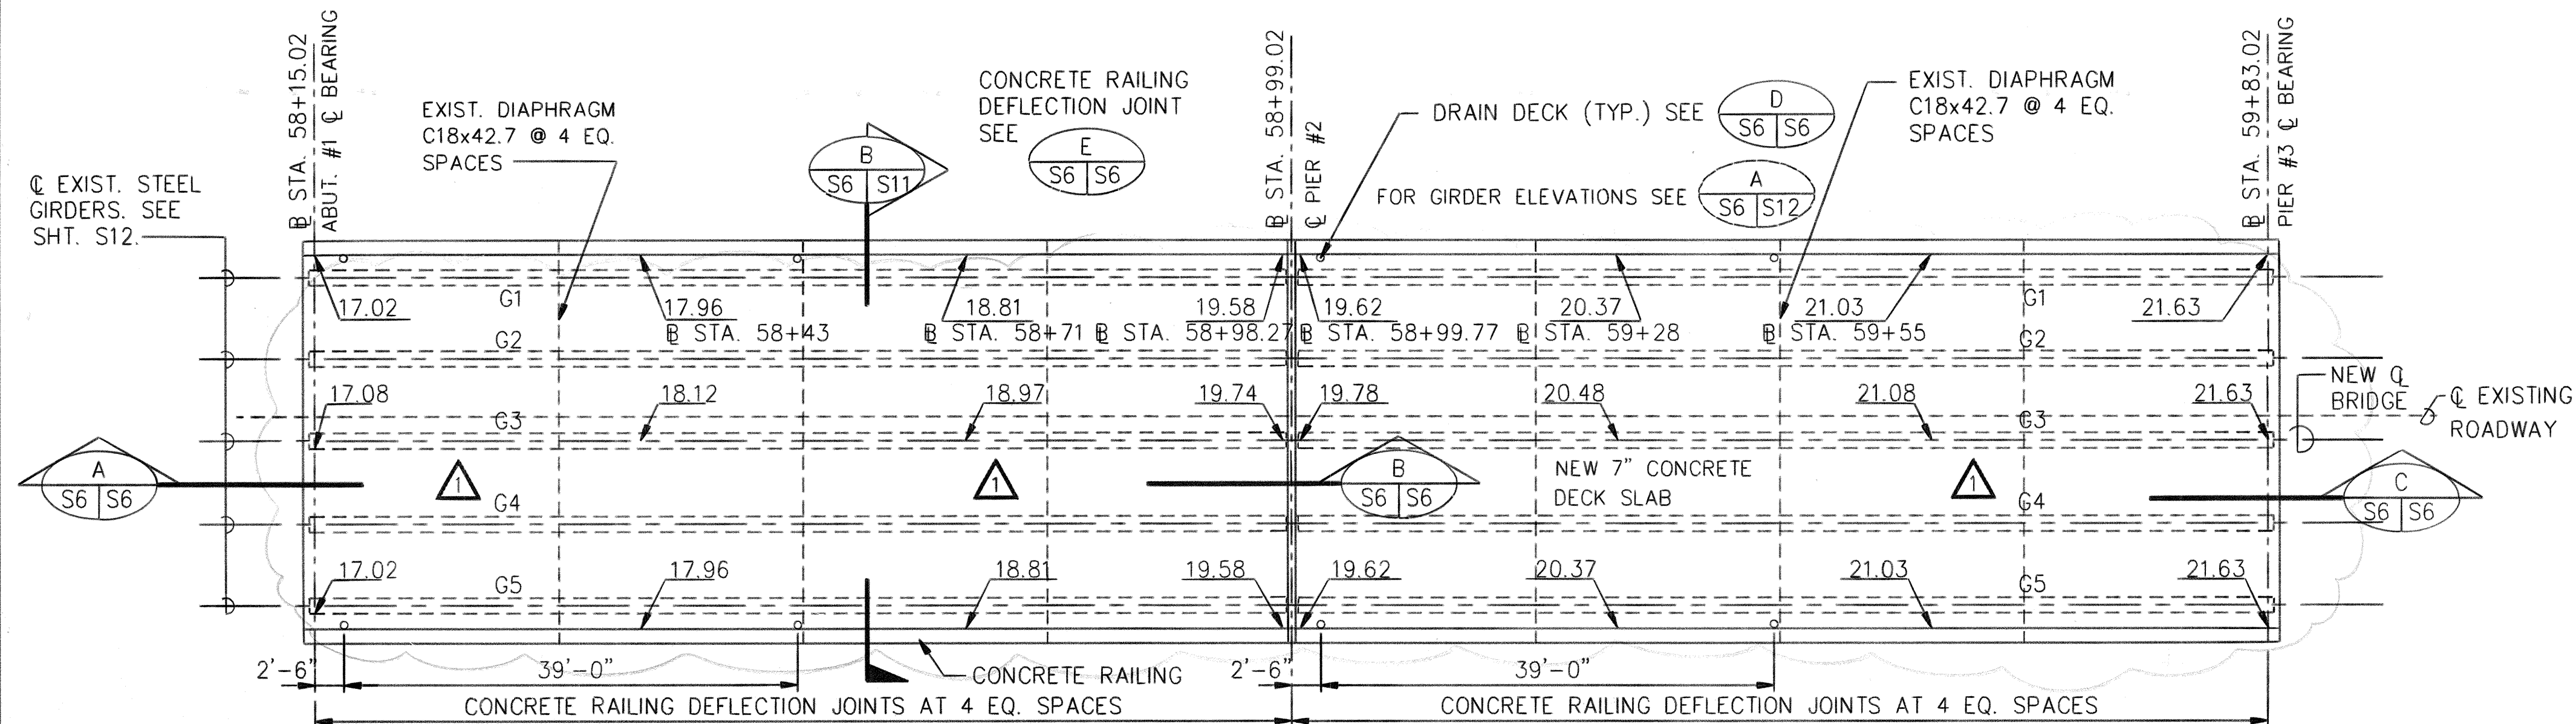


PLAN - FINISH GRADES AT NIMITZ APPROACH
SCALE: 1" = 10'-0"

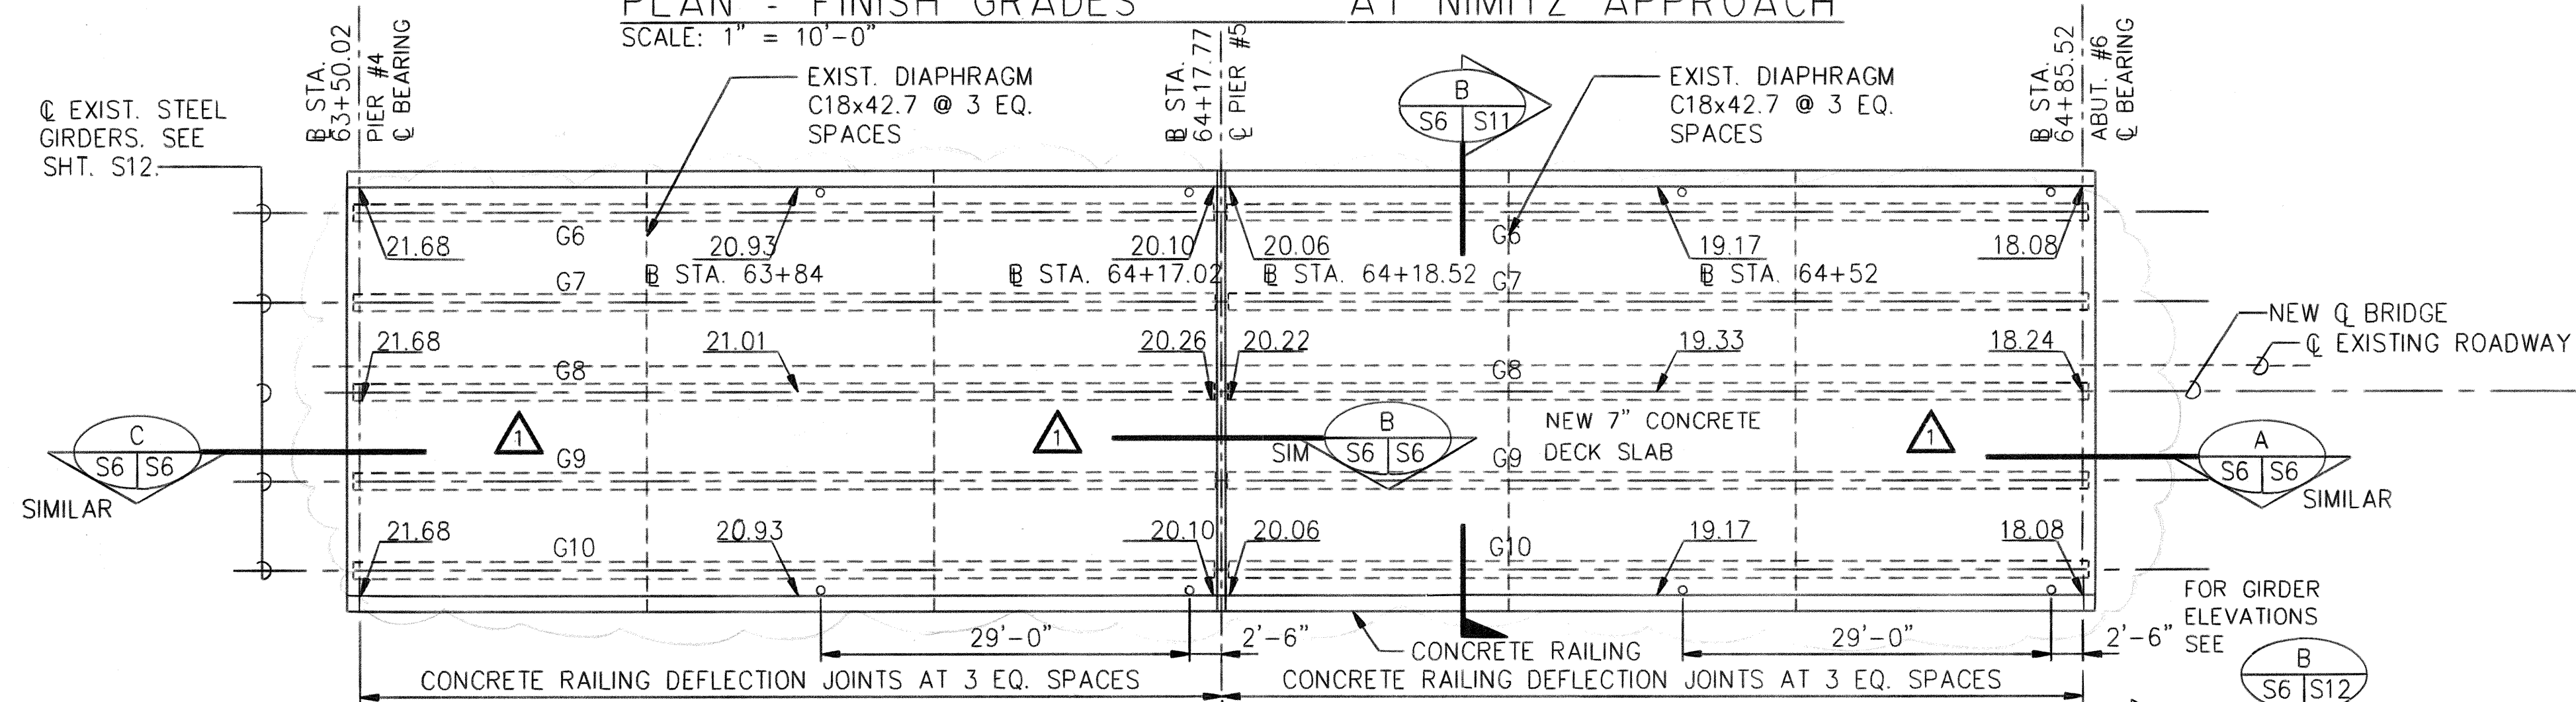


PLAN - FINISH GRADES SAND ISLAND APPROACH
SCALE: 1" = 10'-0"

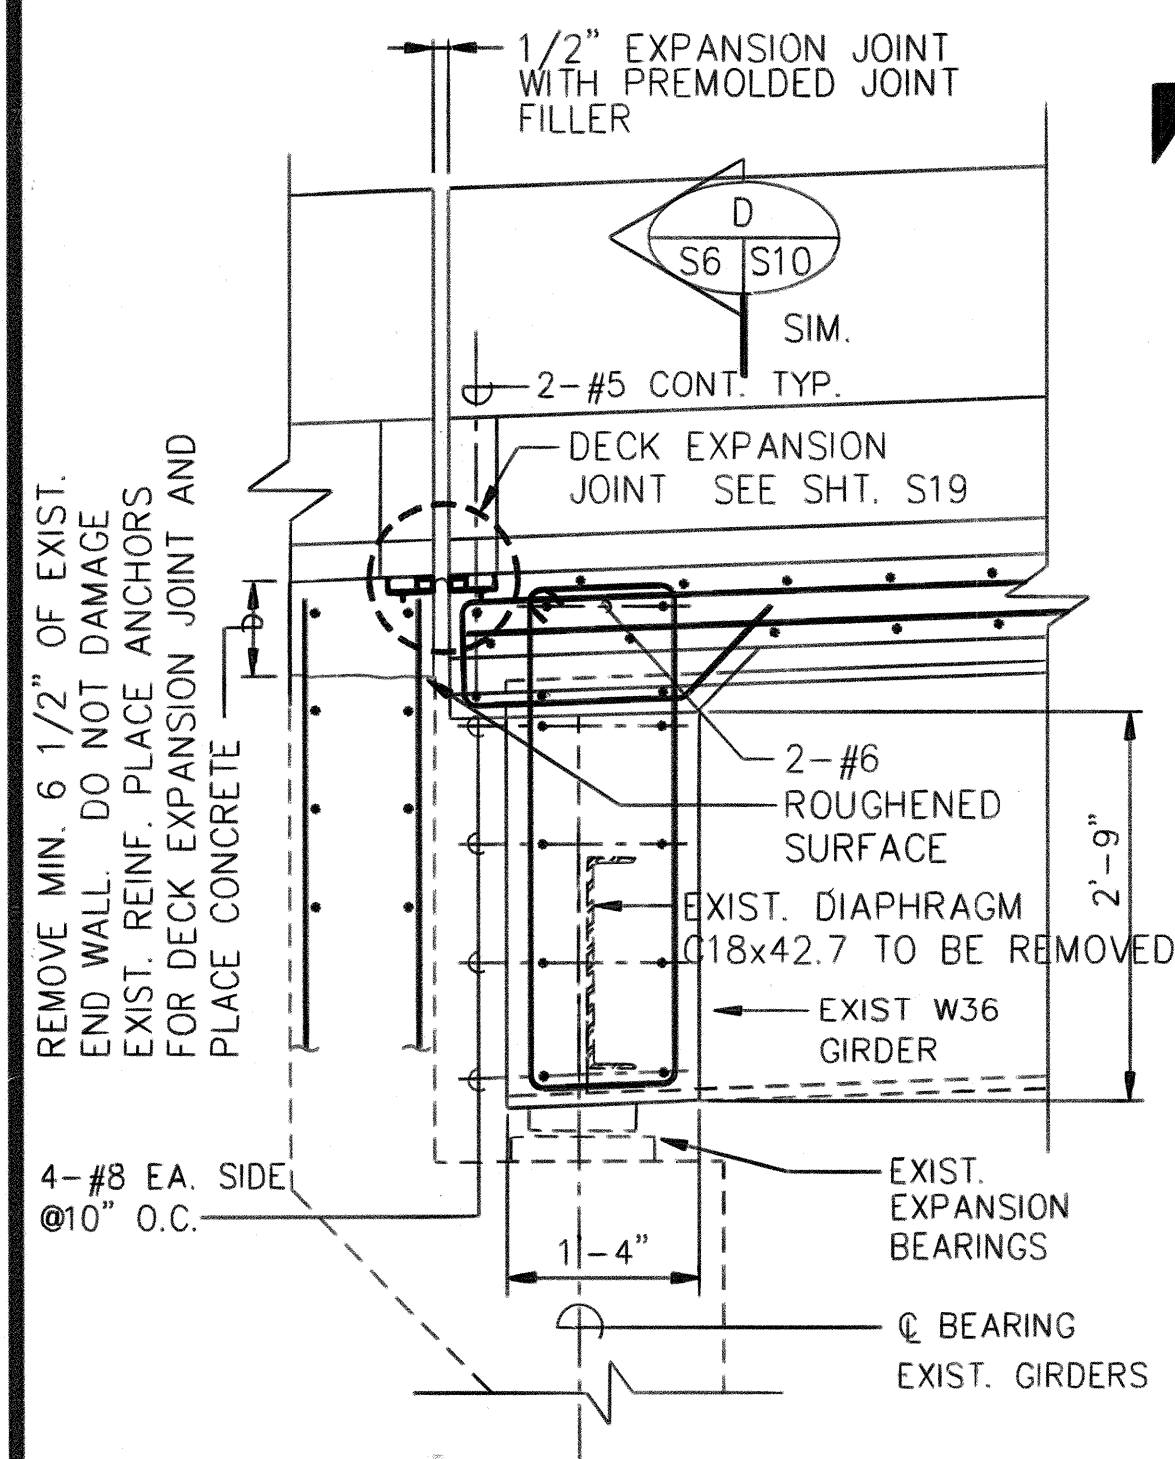


SECTION A
SCALE: 3/4" = 1'-0"
S10

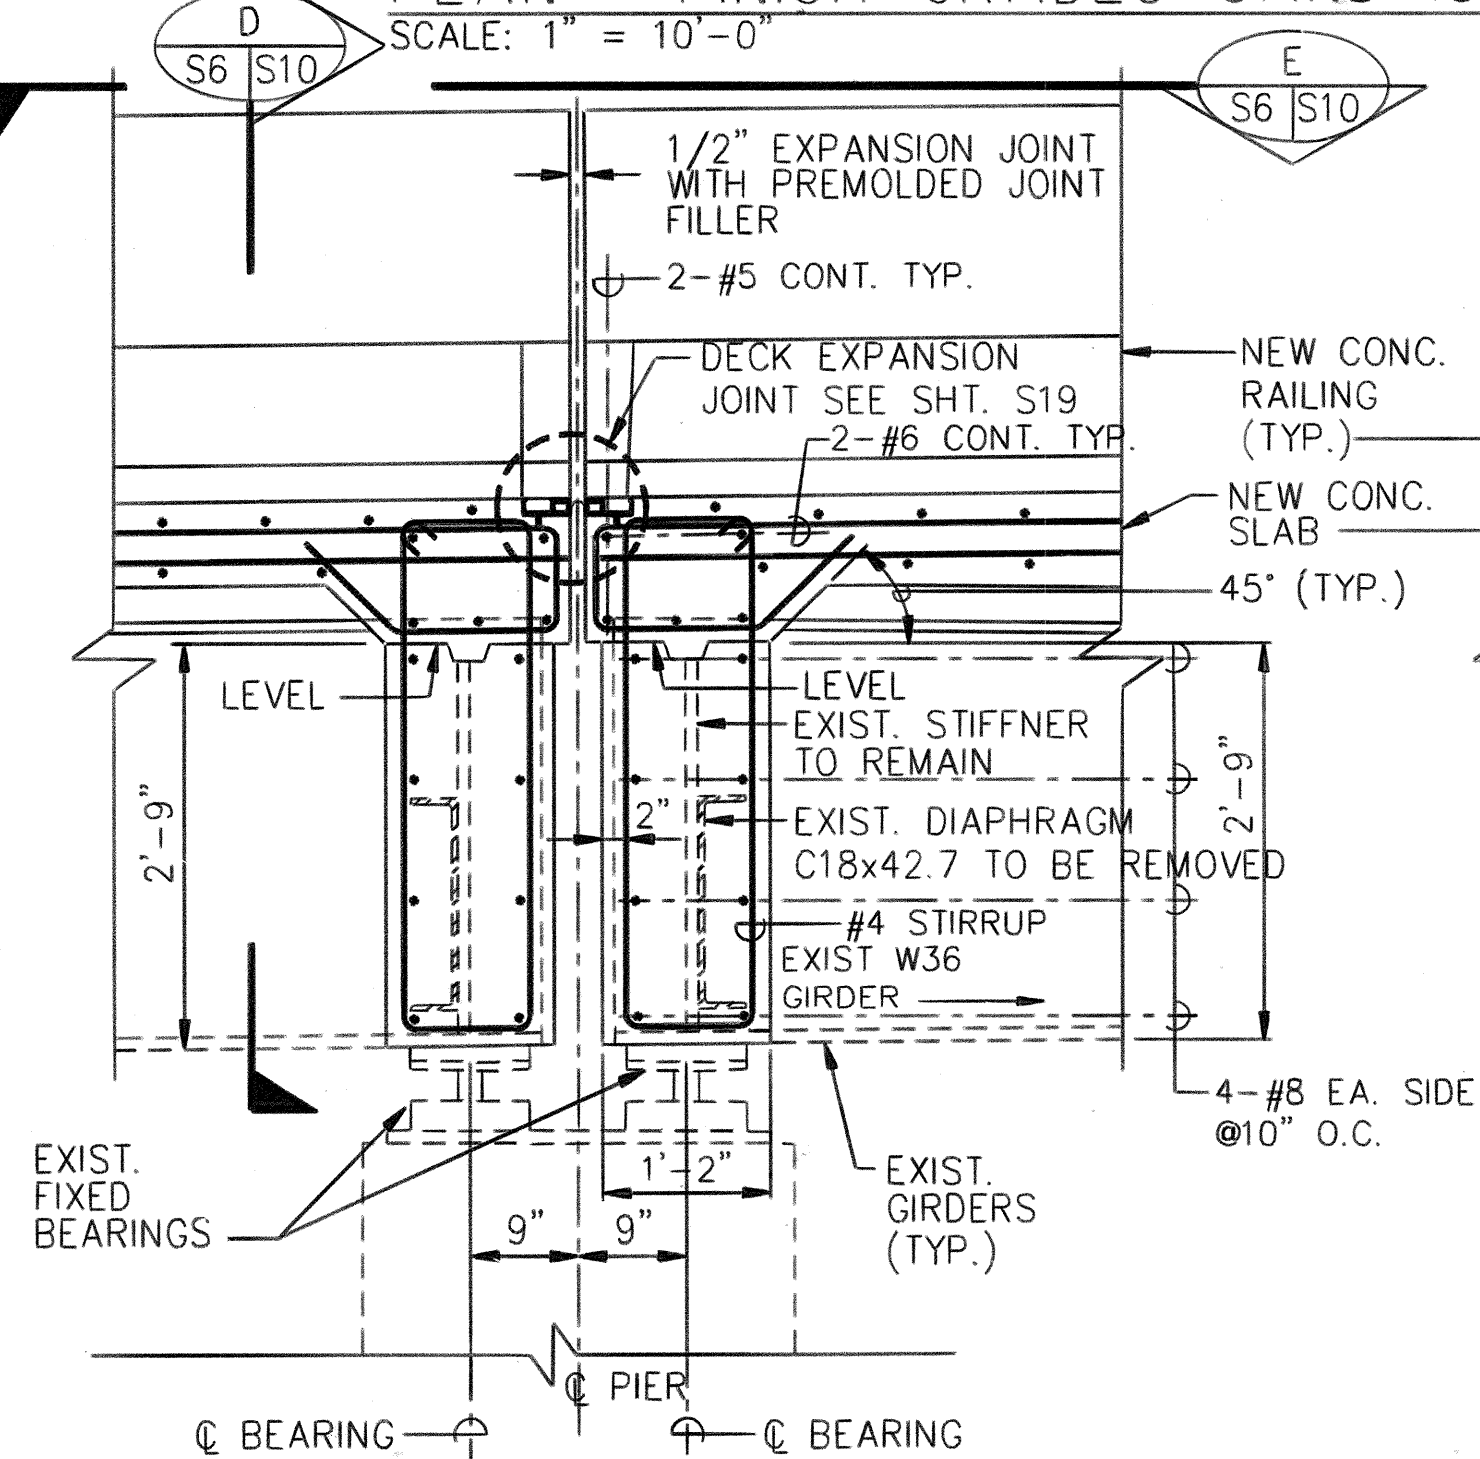


SECTION B
SCALE: 3/4" = 1'-0"
S10

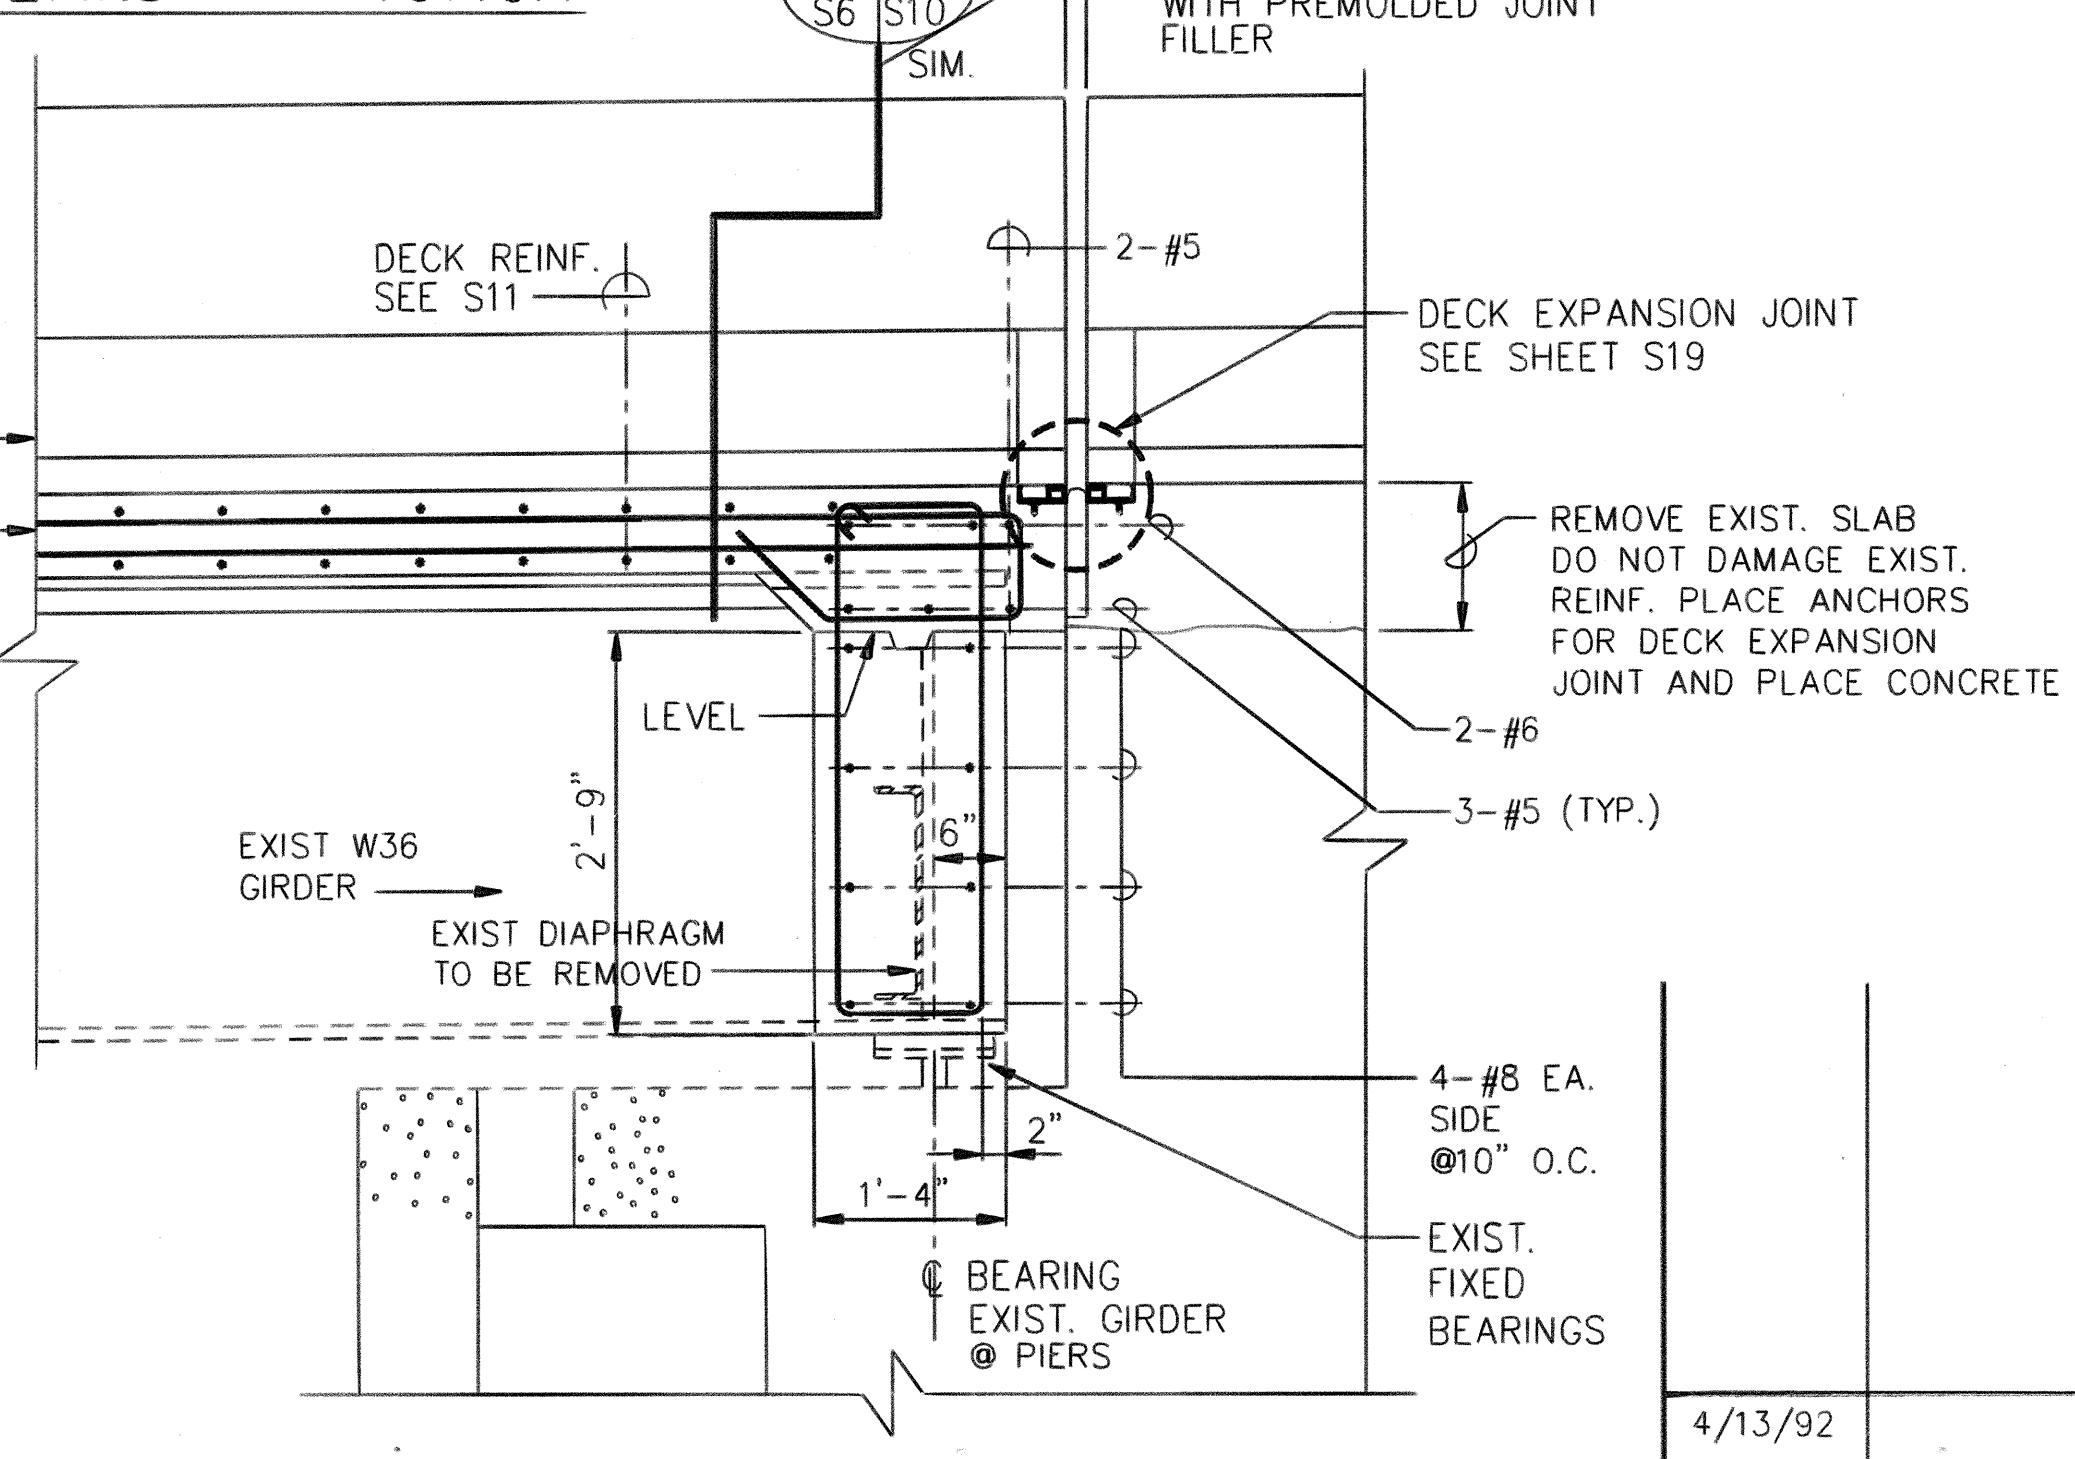


SECTION C
SCALE: 3/4" = 1'-0"
S16

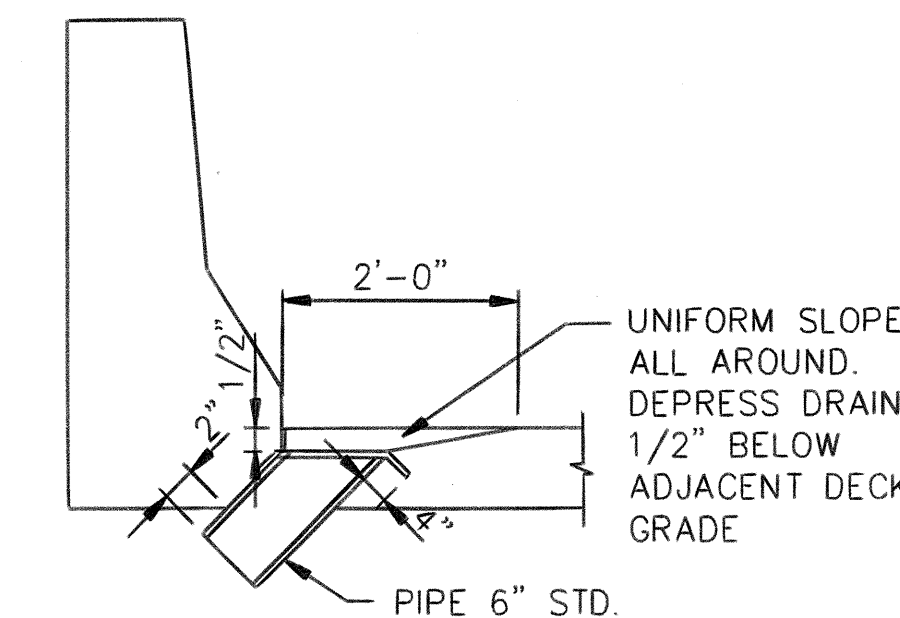

SECTION AT CONC. RAILING
NO SCALE
S6 S6

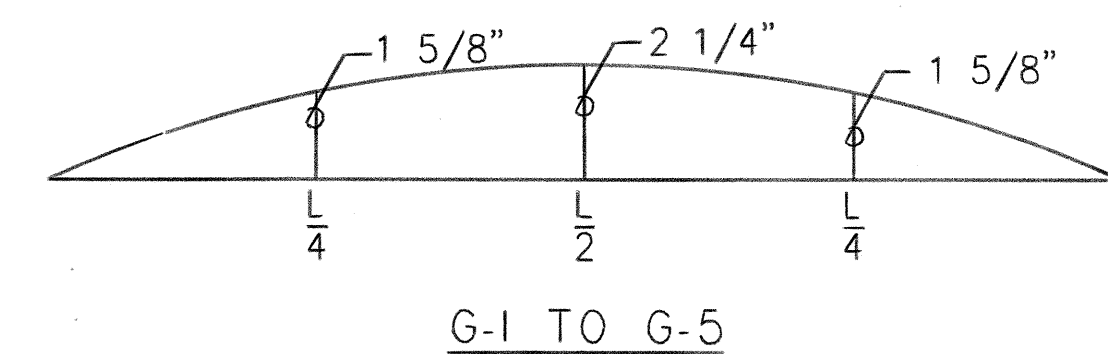


G-1 TO G-5

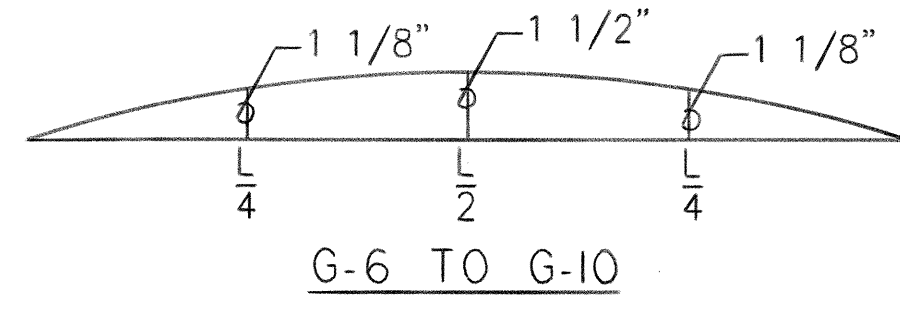


G-6 TO G-10

ORIGINAL CAMBER DIAGRAMS
NO SCALE
S6 S6

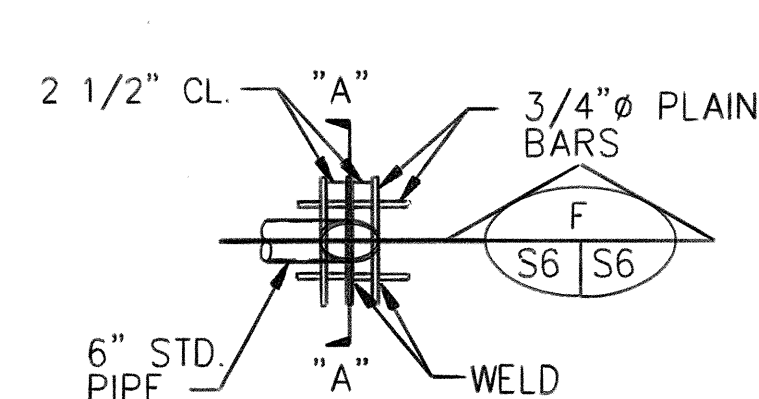


PLAN

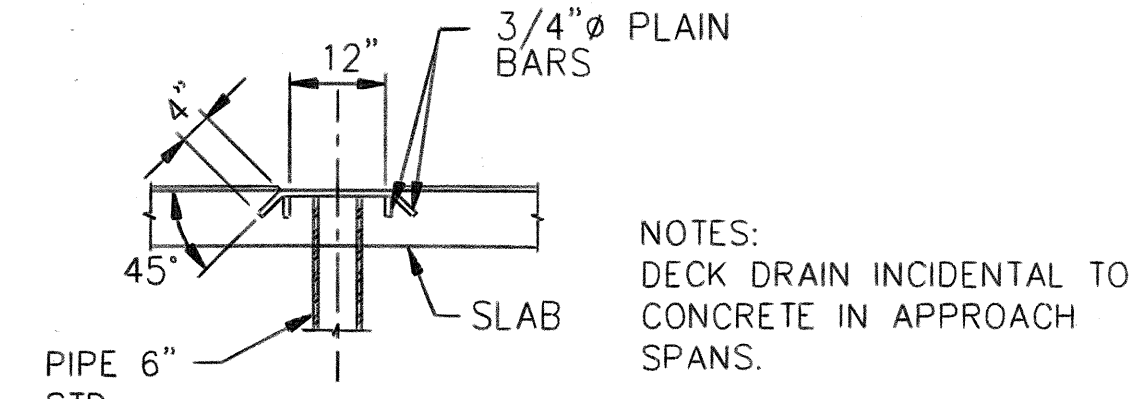

SECTION "A-A"

TYPICAL DECK DRAIN DETAILS
SCALE: 1/2" = 1'-0"
S11 S6 S6

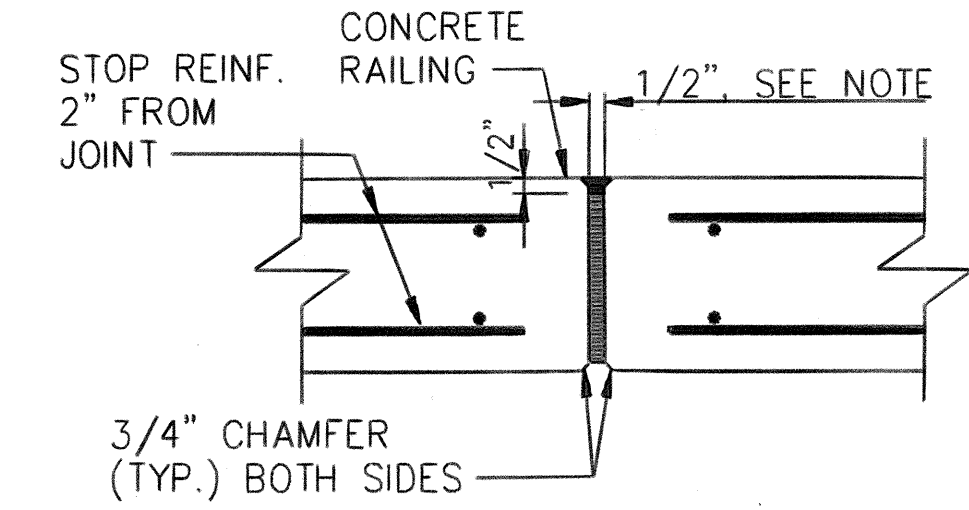

NOTE:
1/2" PREMOLDED JOINT FILLER WITH 1/2" JOINT SEALER AT CONCRETE RAILING DEFLECTION JOINT. 3/4" PREMOLDED JOINT FILLER AT DECK EXPANSION JOINT.

CONCRETE RAILING DEFLECTION JOINT
SCALE: 3" = 1'-0"

SECTION E
S6 S6



THIS WORK WAS PREPARED BY ME OR UNDER MY SUPERVISION

Roscoe O. Ford


STATE OF HAWAII
DEPARTMENT OF TRANSPORTATION
HIGHWAYS DIVISION
FINISHED APPROACH SPANS
FRAMING PLANS AND DECK
ELEVATIONS
SAND ISLAND BASCULE BRIDGE
REHABILITATION PHASE II
PROJECT NO. BR-064-1(3)
SCALE: AS NOTED DATE: MARCH 1991
SHEET No. S6 OF S21 SHEETS

4/13/92
DATE


REVISOR
REVISION

C.O.13


FED. ROAD DIST. NO.	STATE	FED. AID PROJ. NO.	FISCAL YEAR	SHEET NO.	TOTAL SHEETS
HAWAII	HAW.	BR-064-1(3)	1991	14	38

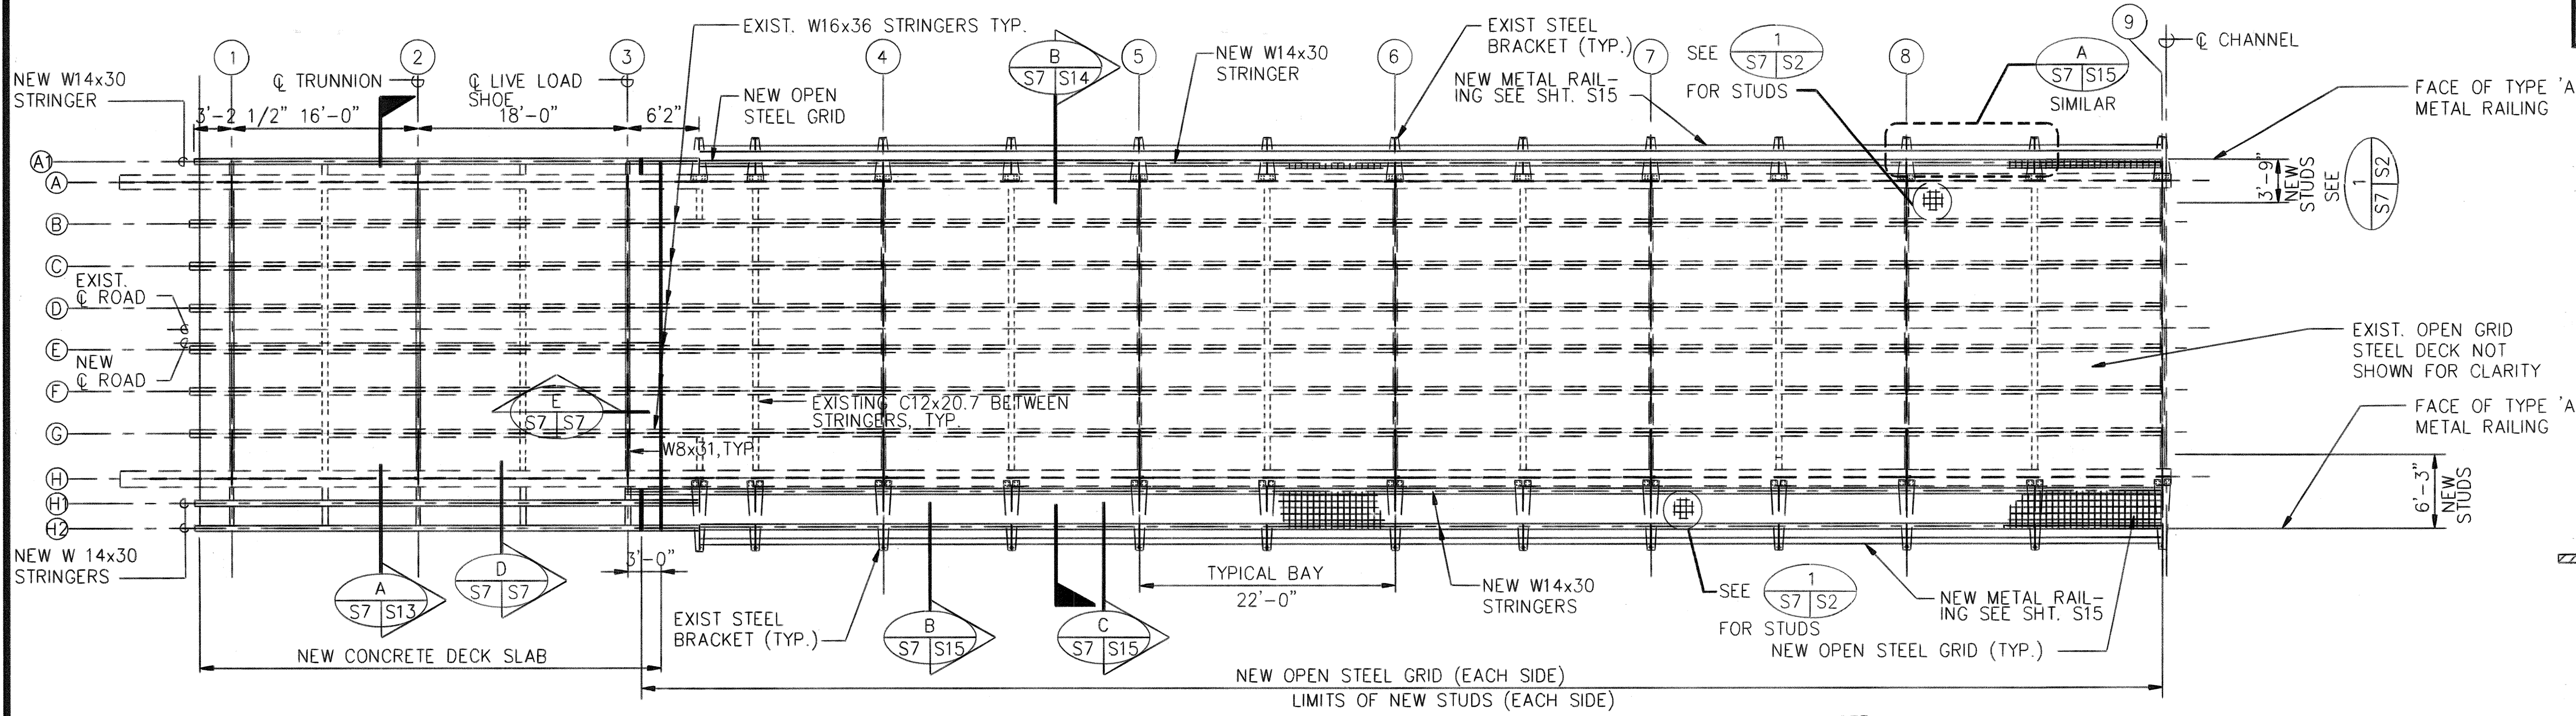


NEW DECK FRAMING PLAN - NIMITZ SIDE OF BASCULE BRIDGE SPAN
SCALE : 1/8" = 1'-0"

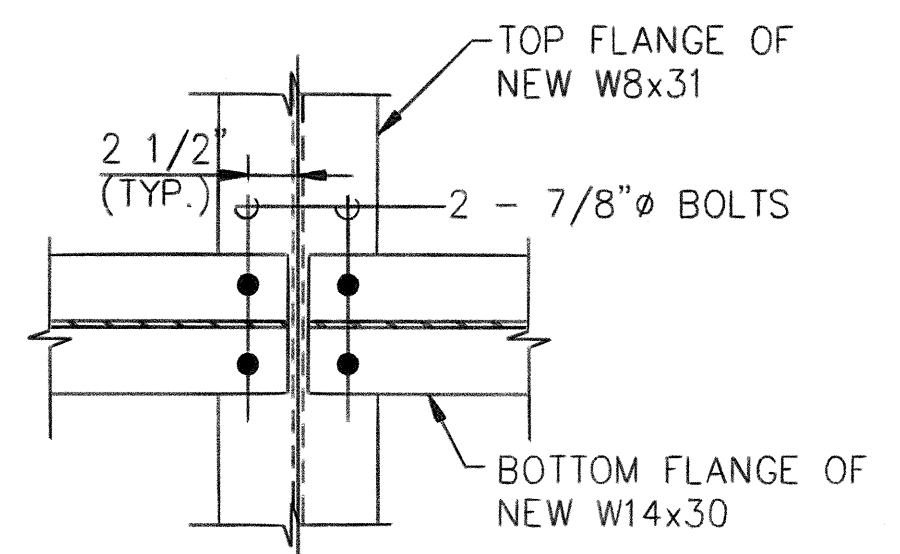


DETAIL C
SCALE : NONE

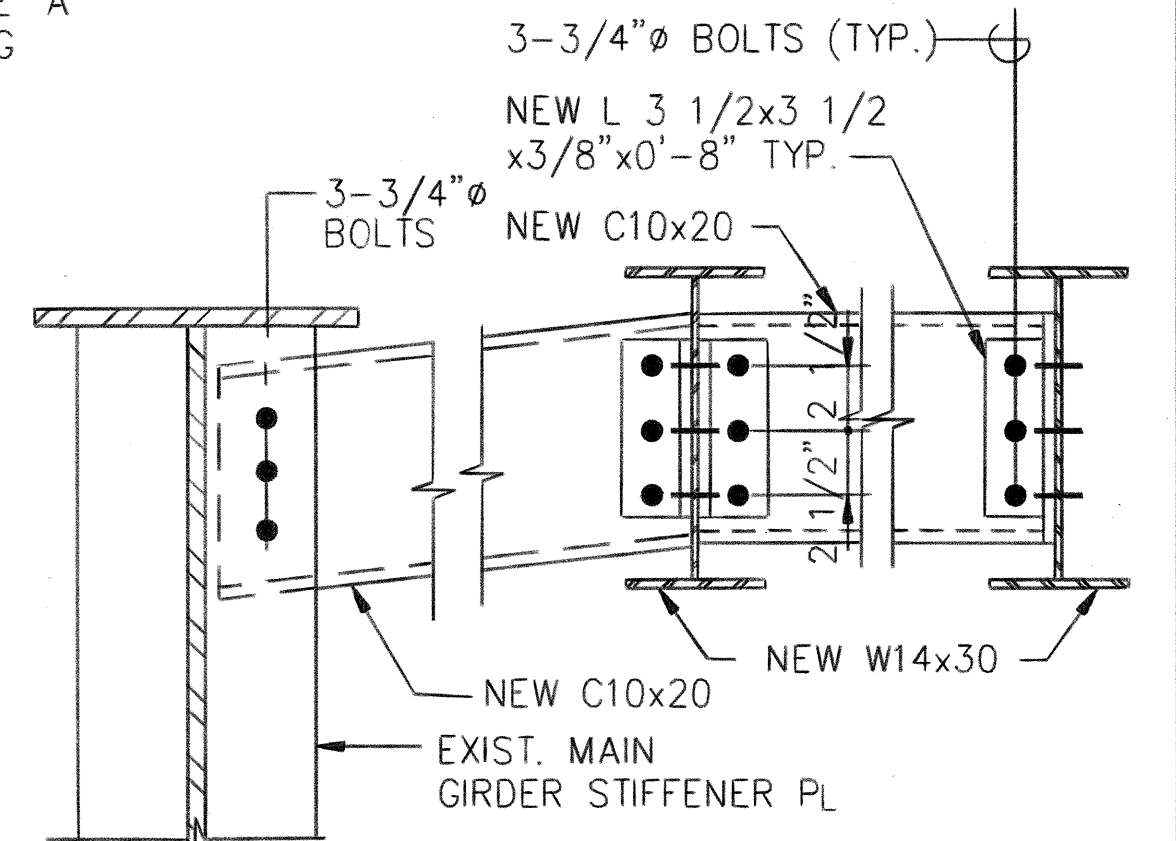

DETAIL D
SCALE : NONE

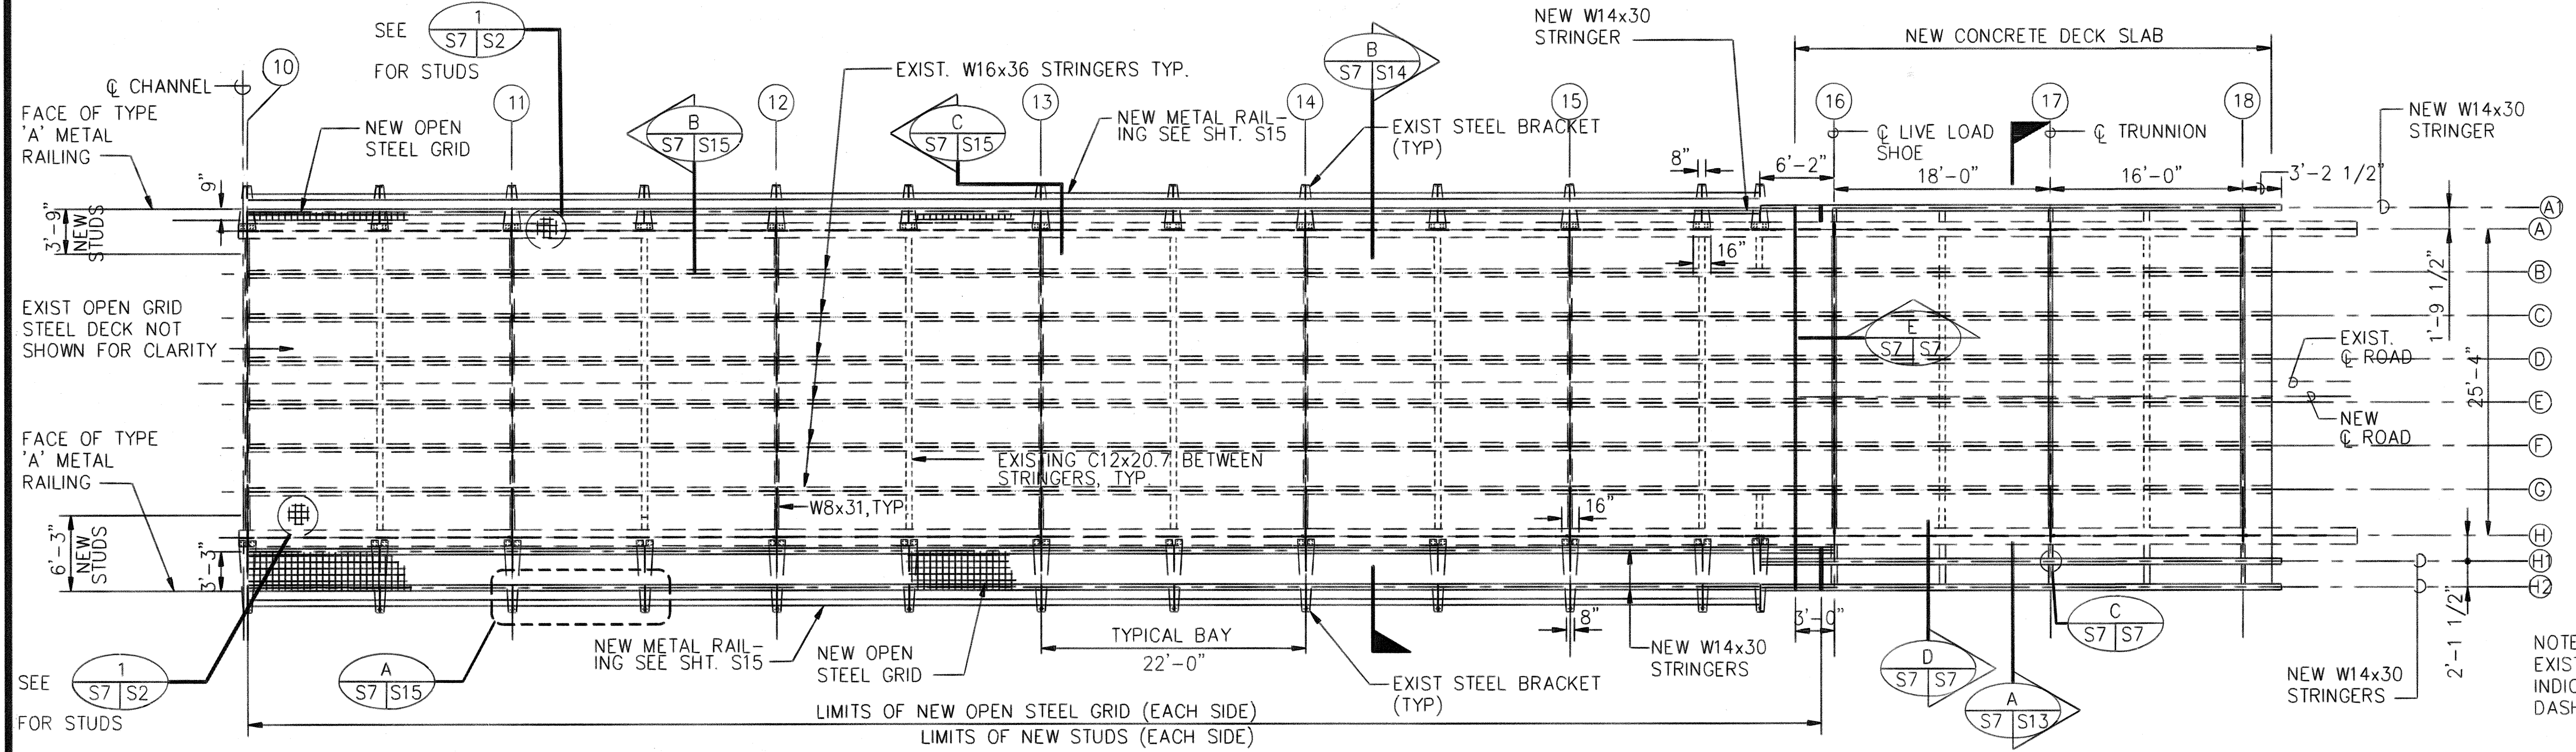

NEW DECK FRAMING PLAN - SAND ISLAND SIDE OF BASCULE BRIDGE SPAN
SCALE : 1/8" = 1'-0"

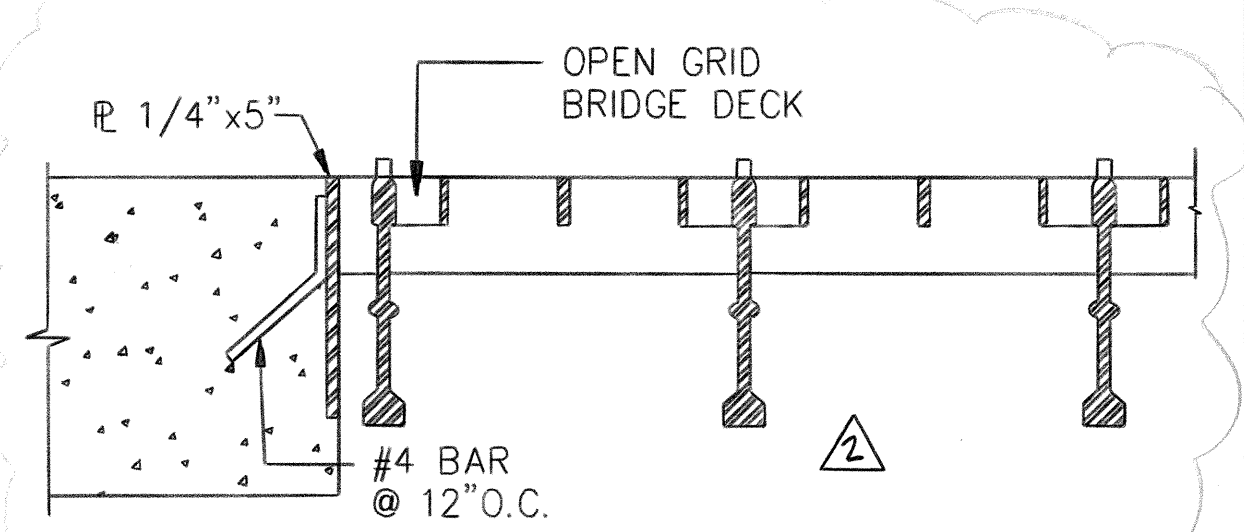

SECTION E
SCALE : 3" = 1'-0"

NOTE:
EXISTING MEMBERS
INDICATED WITH
DASHED LINES.




THIS WORK WAS PREPARED BY
ME OR UNDER MY SUPERVISION
Roscoe O. Ford

STATE OF HAWAII
DEPARTMENT OF TRANSPORTATION
HIGHWAYS DIVISION
**FINISHED PARTIAL FRAMING
PLANS, BASCULE BRIDGE
SPAN**
SAND ISLAND BASCULE BRIDGE
REHABILITATION PHASE II
PROJECT NO. BR-064-1(3)
SCALE: AS NOTED DATE: MARCH 1991
SHEET No. S7 OF S21 SHEETS


5/1/92
DATE
ADDED DETAIL
REVISION

SURVEY PLOTTED BY
DATE
DRAWN BY
DESIGNED BY
NOTED BY
QUANTITIES BY
CHECKED BY
ORIGINAL PLAN
NO.


FED. ROAD DIST. NO.	STATE	FED. AID PROJ. NO.	FISCAL YEAR	SHEET NO.	TOTAL SHEETS
HAWAII	HAW.	BR-064-I(3)	1991	15	38

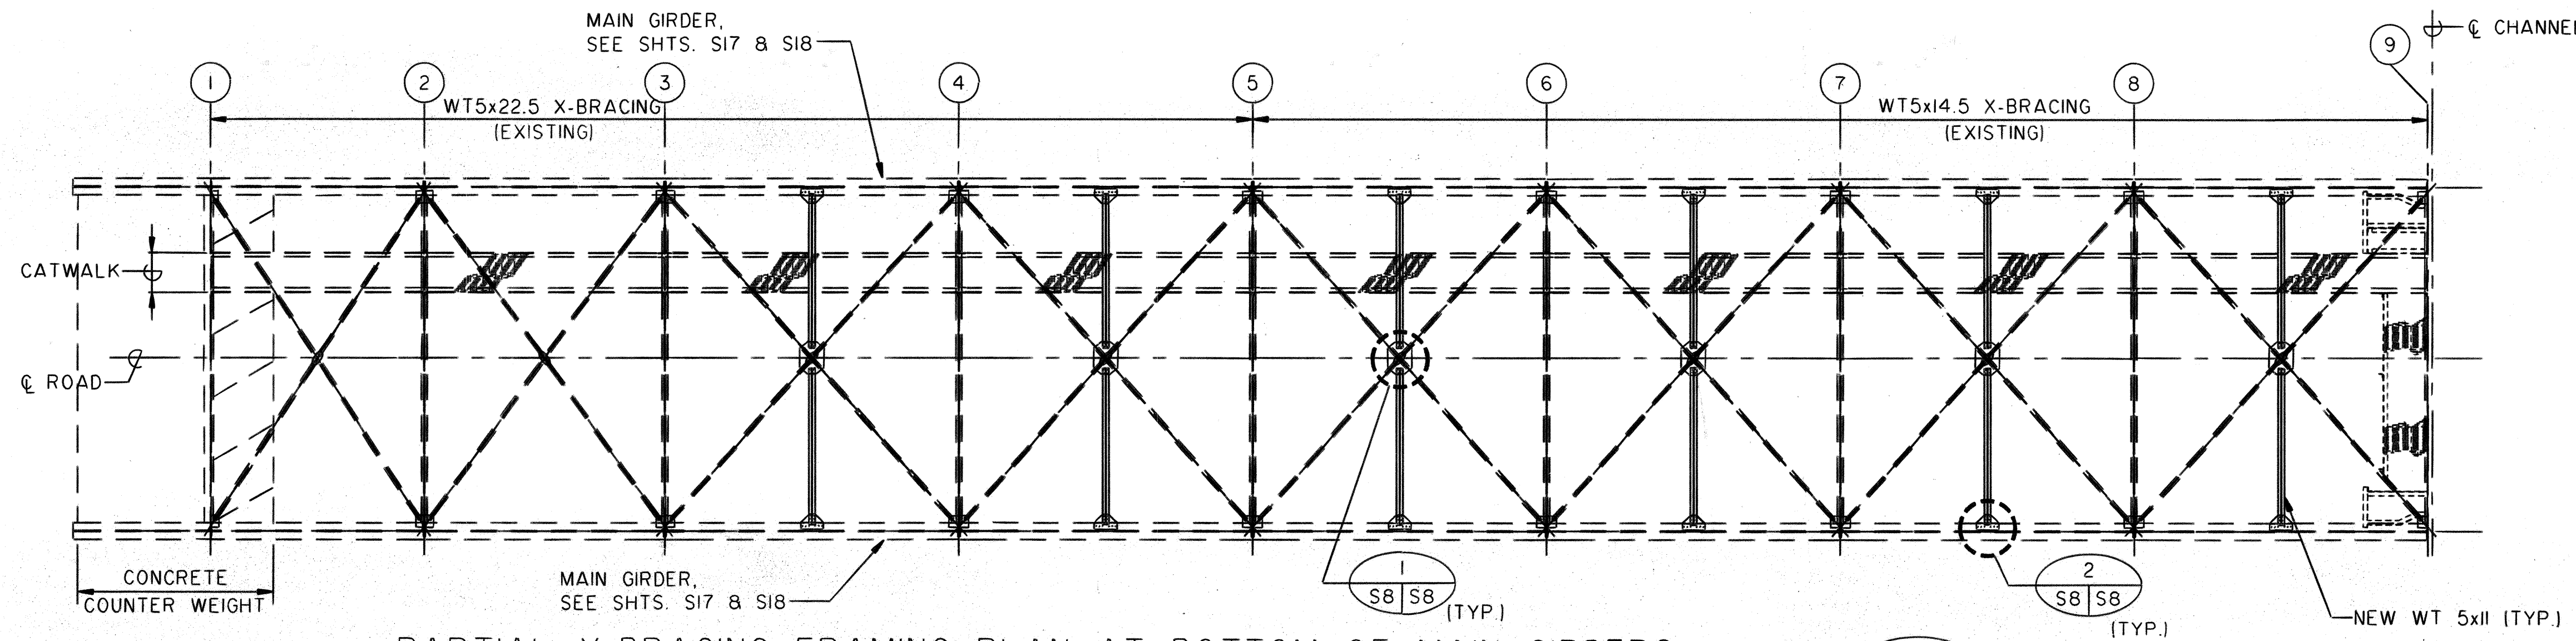


PARTIAL X-BRACING FRAMING PLAN AT BOTTOM OF MAIN GIRDERS
SCALE : 1/8" = 1'-0"

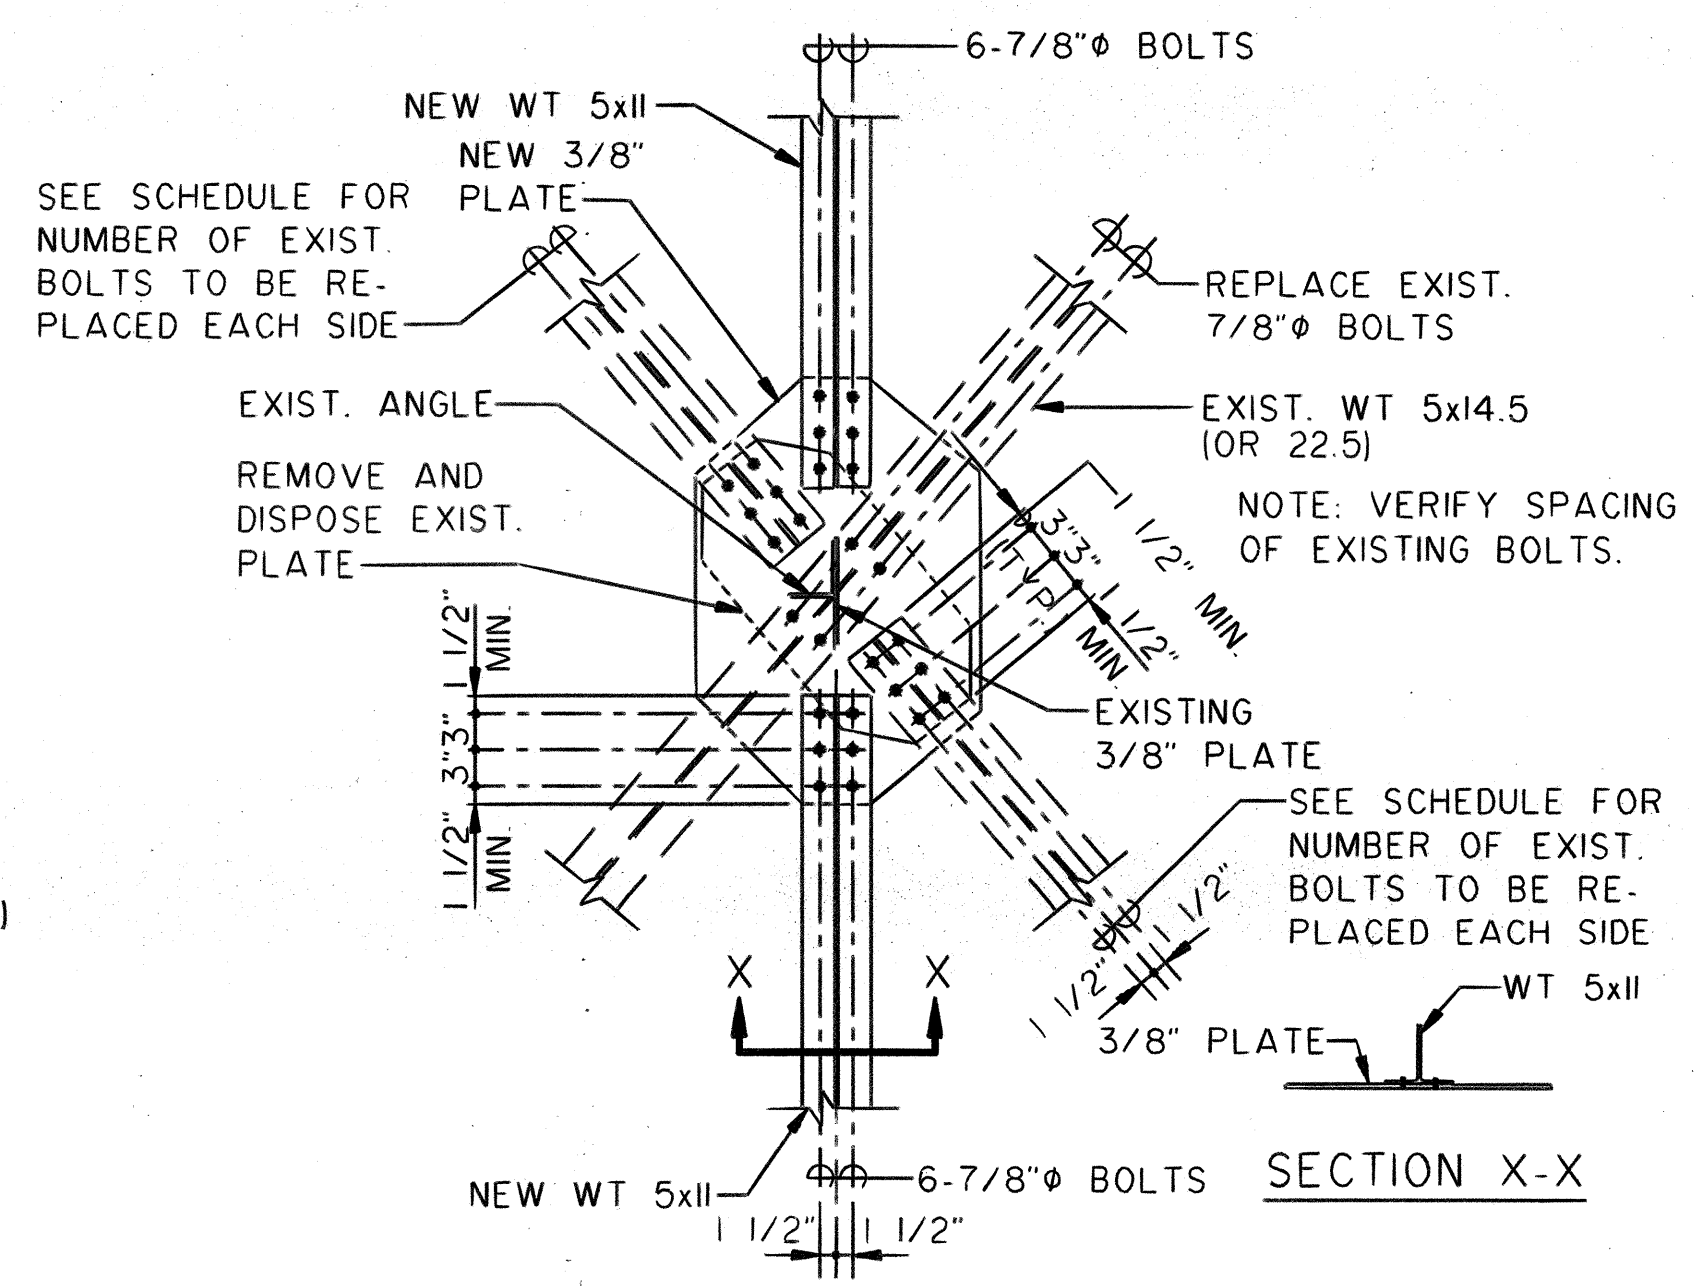

DETAIL - CONNECTION
SCALE : 3/4" = 1'-0"

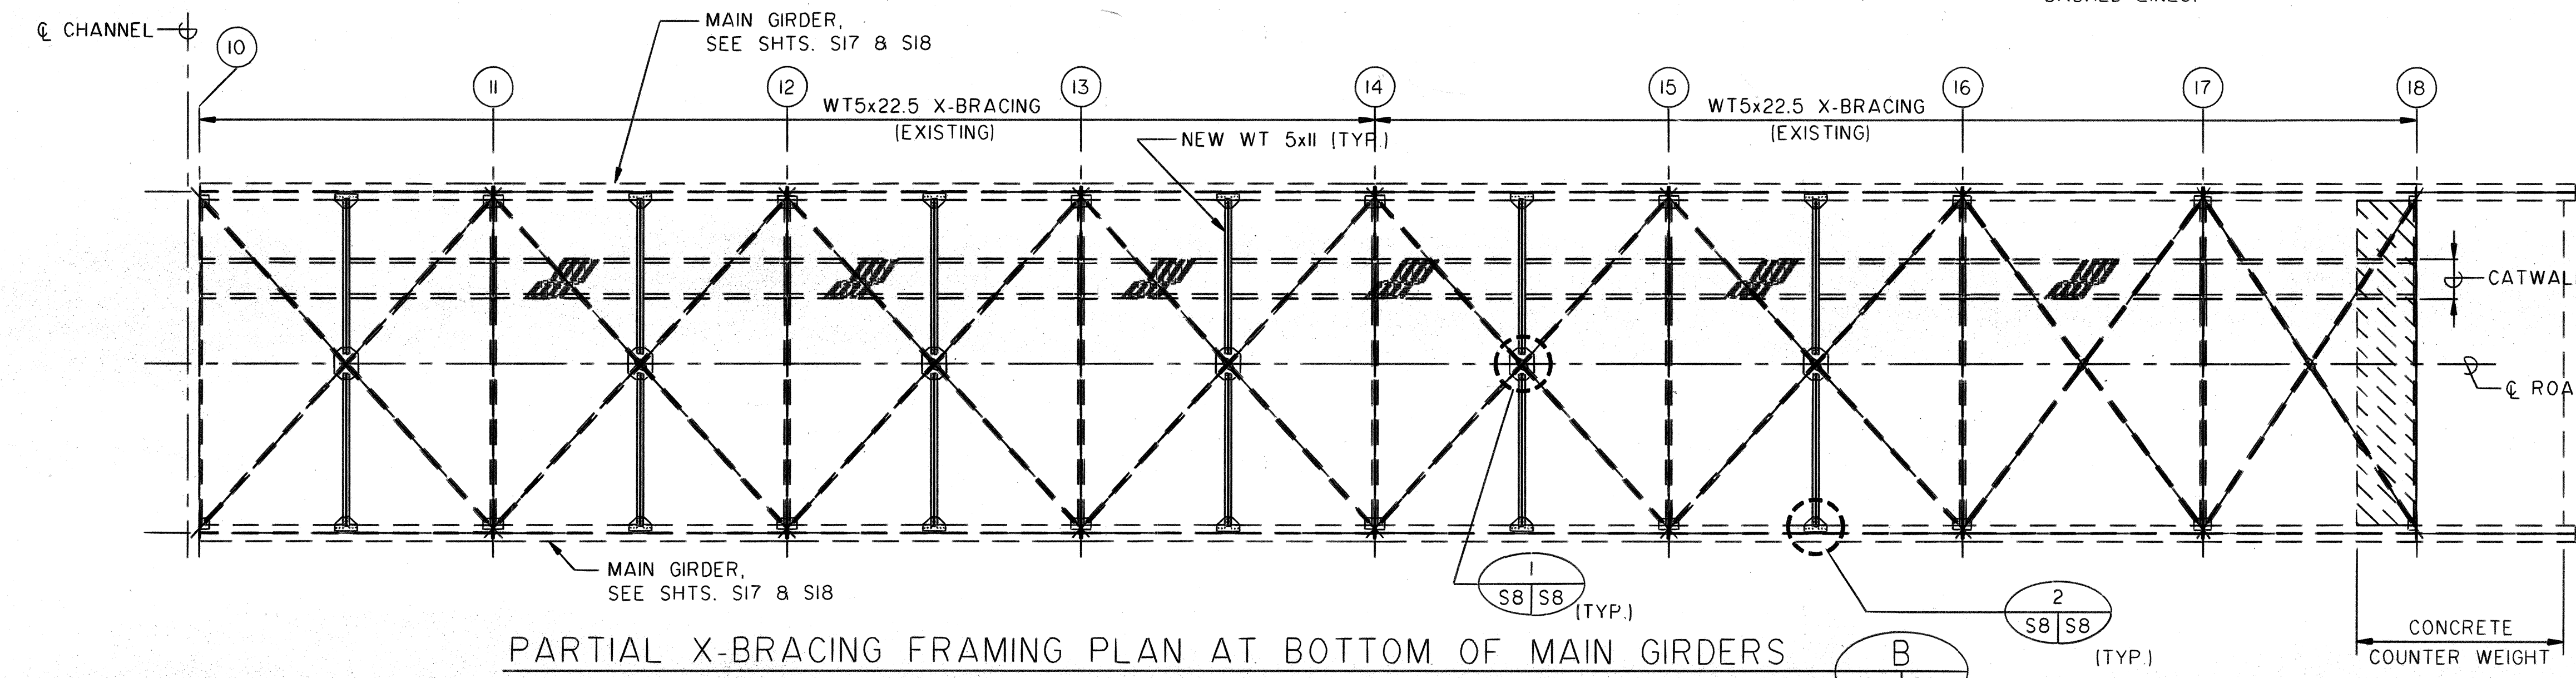


PARTIAL X-BRACING FRAMING PLAN AT BOTTOM OF MAIN GIRDERS
SCALE : 1/8" = 1'-0"

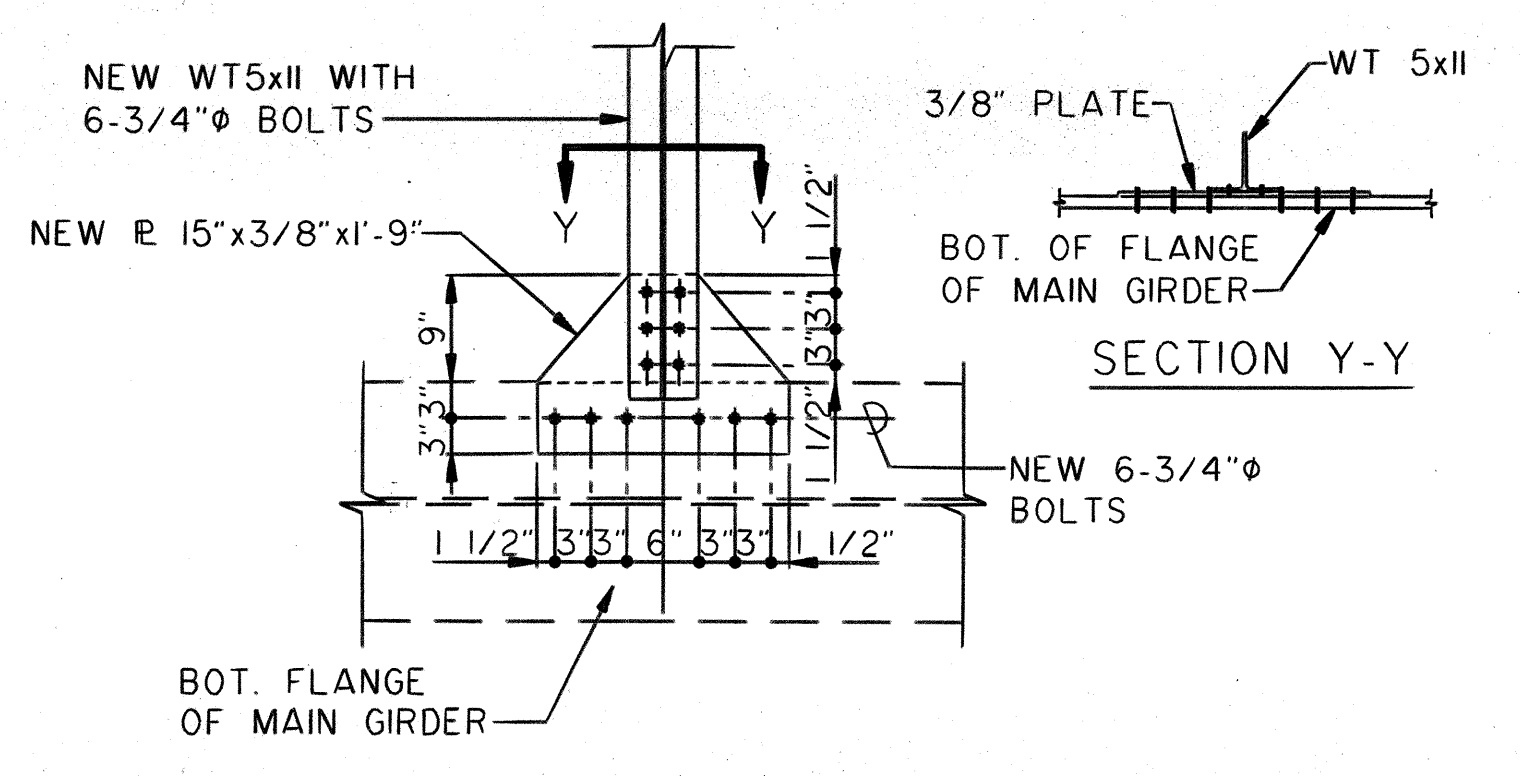


DETAIL - CONNECTION
SCALE : 3/4" = 1'-0"

NOTES:


- 26 SYMBOL MARK, SEE SHT. S4 FOR REPAIR SCHEDULE

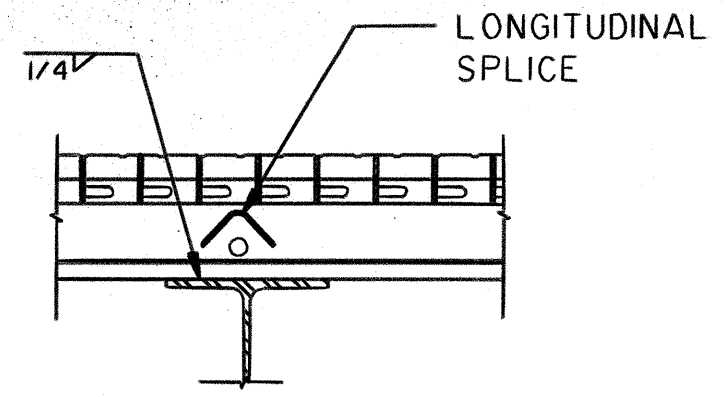


SECTION E
SCALE : 1 1/2" = 1'-0"

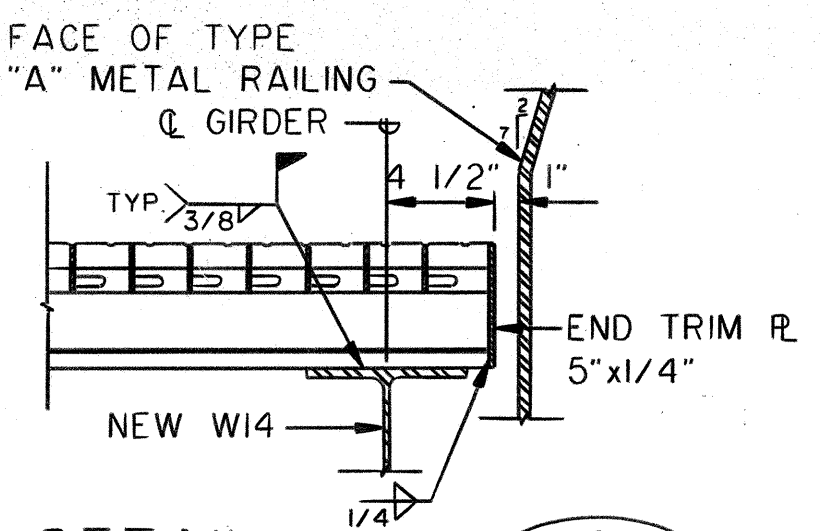


DETAIL C
SCALE : 1 1/2" = 1'-0"

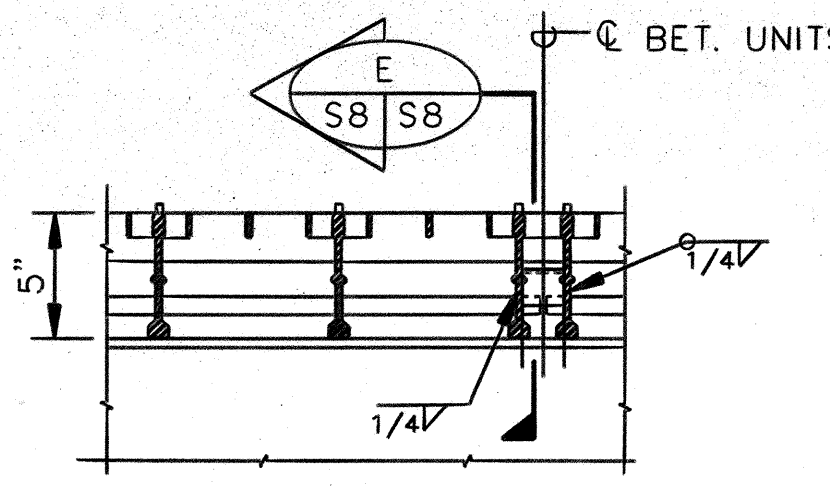

SECTION D
SCALE : 1 1/2" = 1'-0"

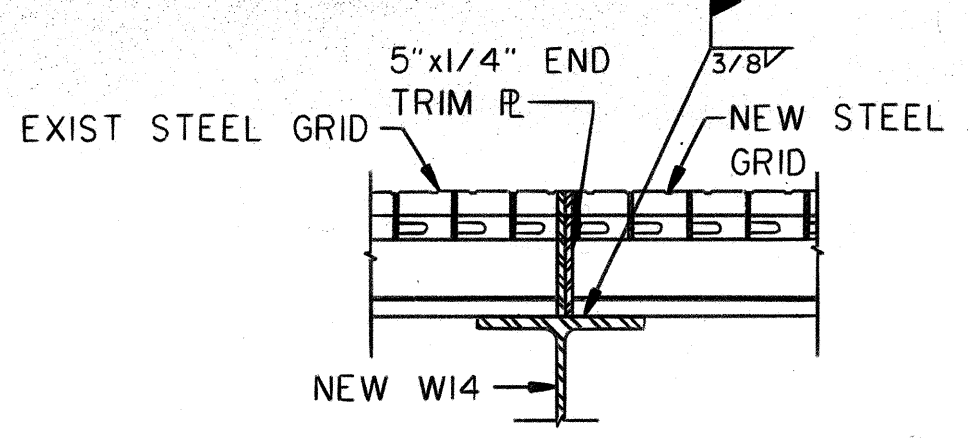

DETAIL F
SCALE : 1 1/2" = 1'-0"

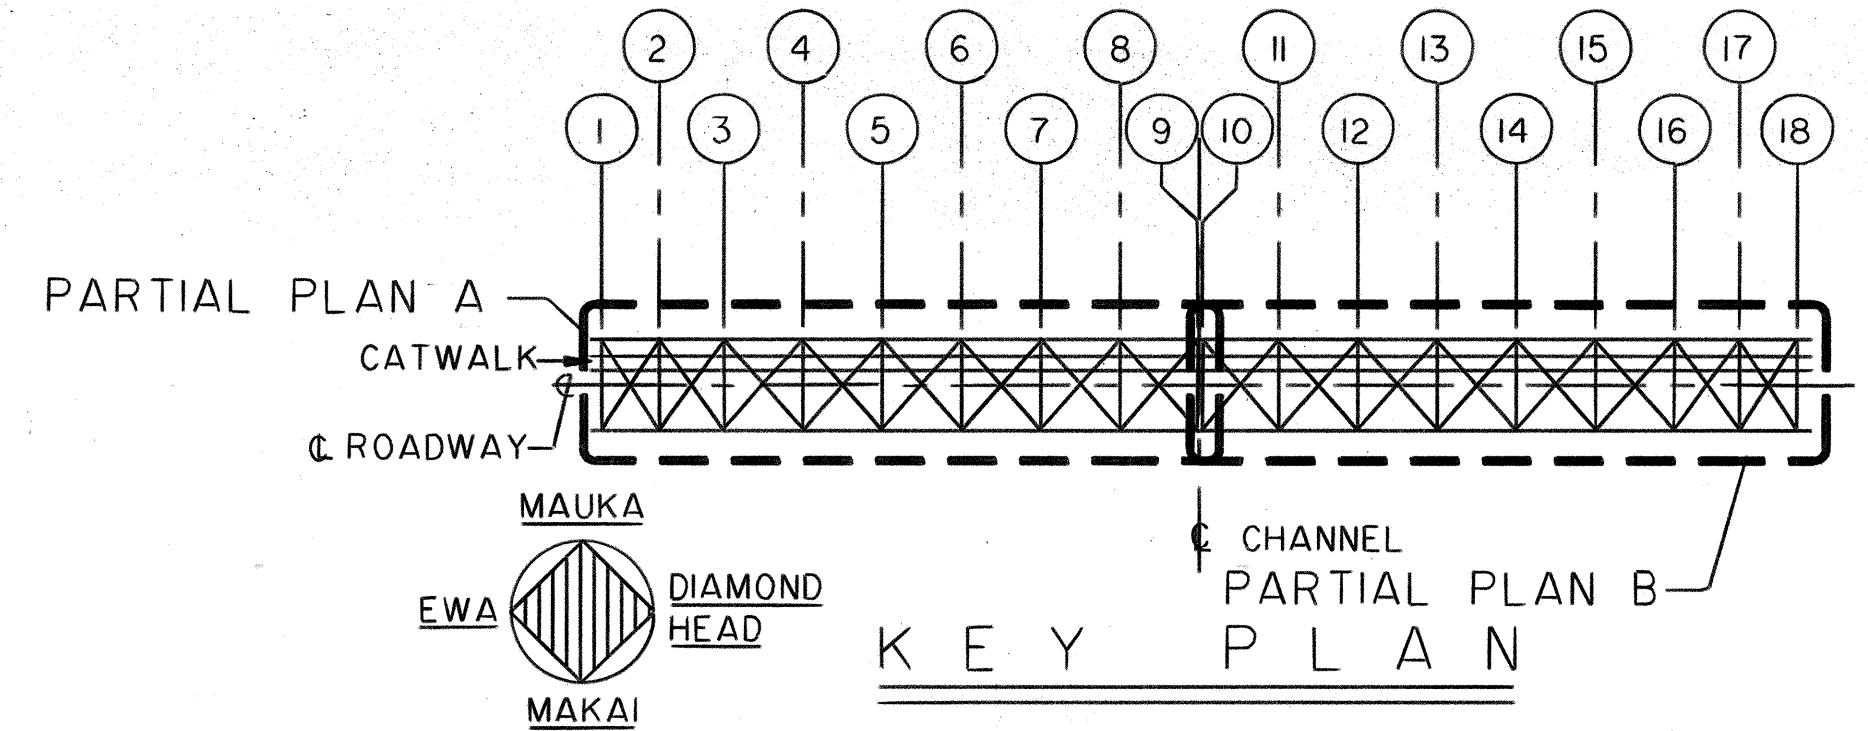

KEY PLAN

LOCATION	NO. BOLTS	SIZE
3-4, 15-16	12	7/8"
4-5, 14-15	10	7/8"
5-6, 13-14	8	7/8"
6-7, 12-13	6	7/8"
7-8, 11-12	6	7/8"
8-9, 10-11	6	7/8"

ROSCOE O. FORD
REGISTERED PROFESSIONAL ENGINEER
No. 3731-S
HAWAII, U.S.A.

THIS WORK WAS PREPARED BY ME OR UNDER MY SUPERVISION


Roscoe O. Ford

STATE OF HAWAII
DEPARTMENT OF TRANSPORTATION
HIGHWAYS DIVISION


PARTIAL FRAMING PLANS
ADDED BRACING SECTION AND
DETAILS, BASCULE BRIDGE SPAN
SAND ISLAND BASCULE BRIDGE
REHABILITATION PHASE II
PROJECT NO. BR-064-I(3)
SCALE: AS NOTED DATE: AUG. 15, 1991

SHEET NO. S8 OF S21 SHEETS



FED. ROAD DIST. NO.	STATE	FED. AID PROJ. NO.	FISCAL YEAR	SHEET NO.	TOTAL SHEETS
HAWAII	HAW.	BR-064-1(3)	1991	16	38

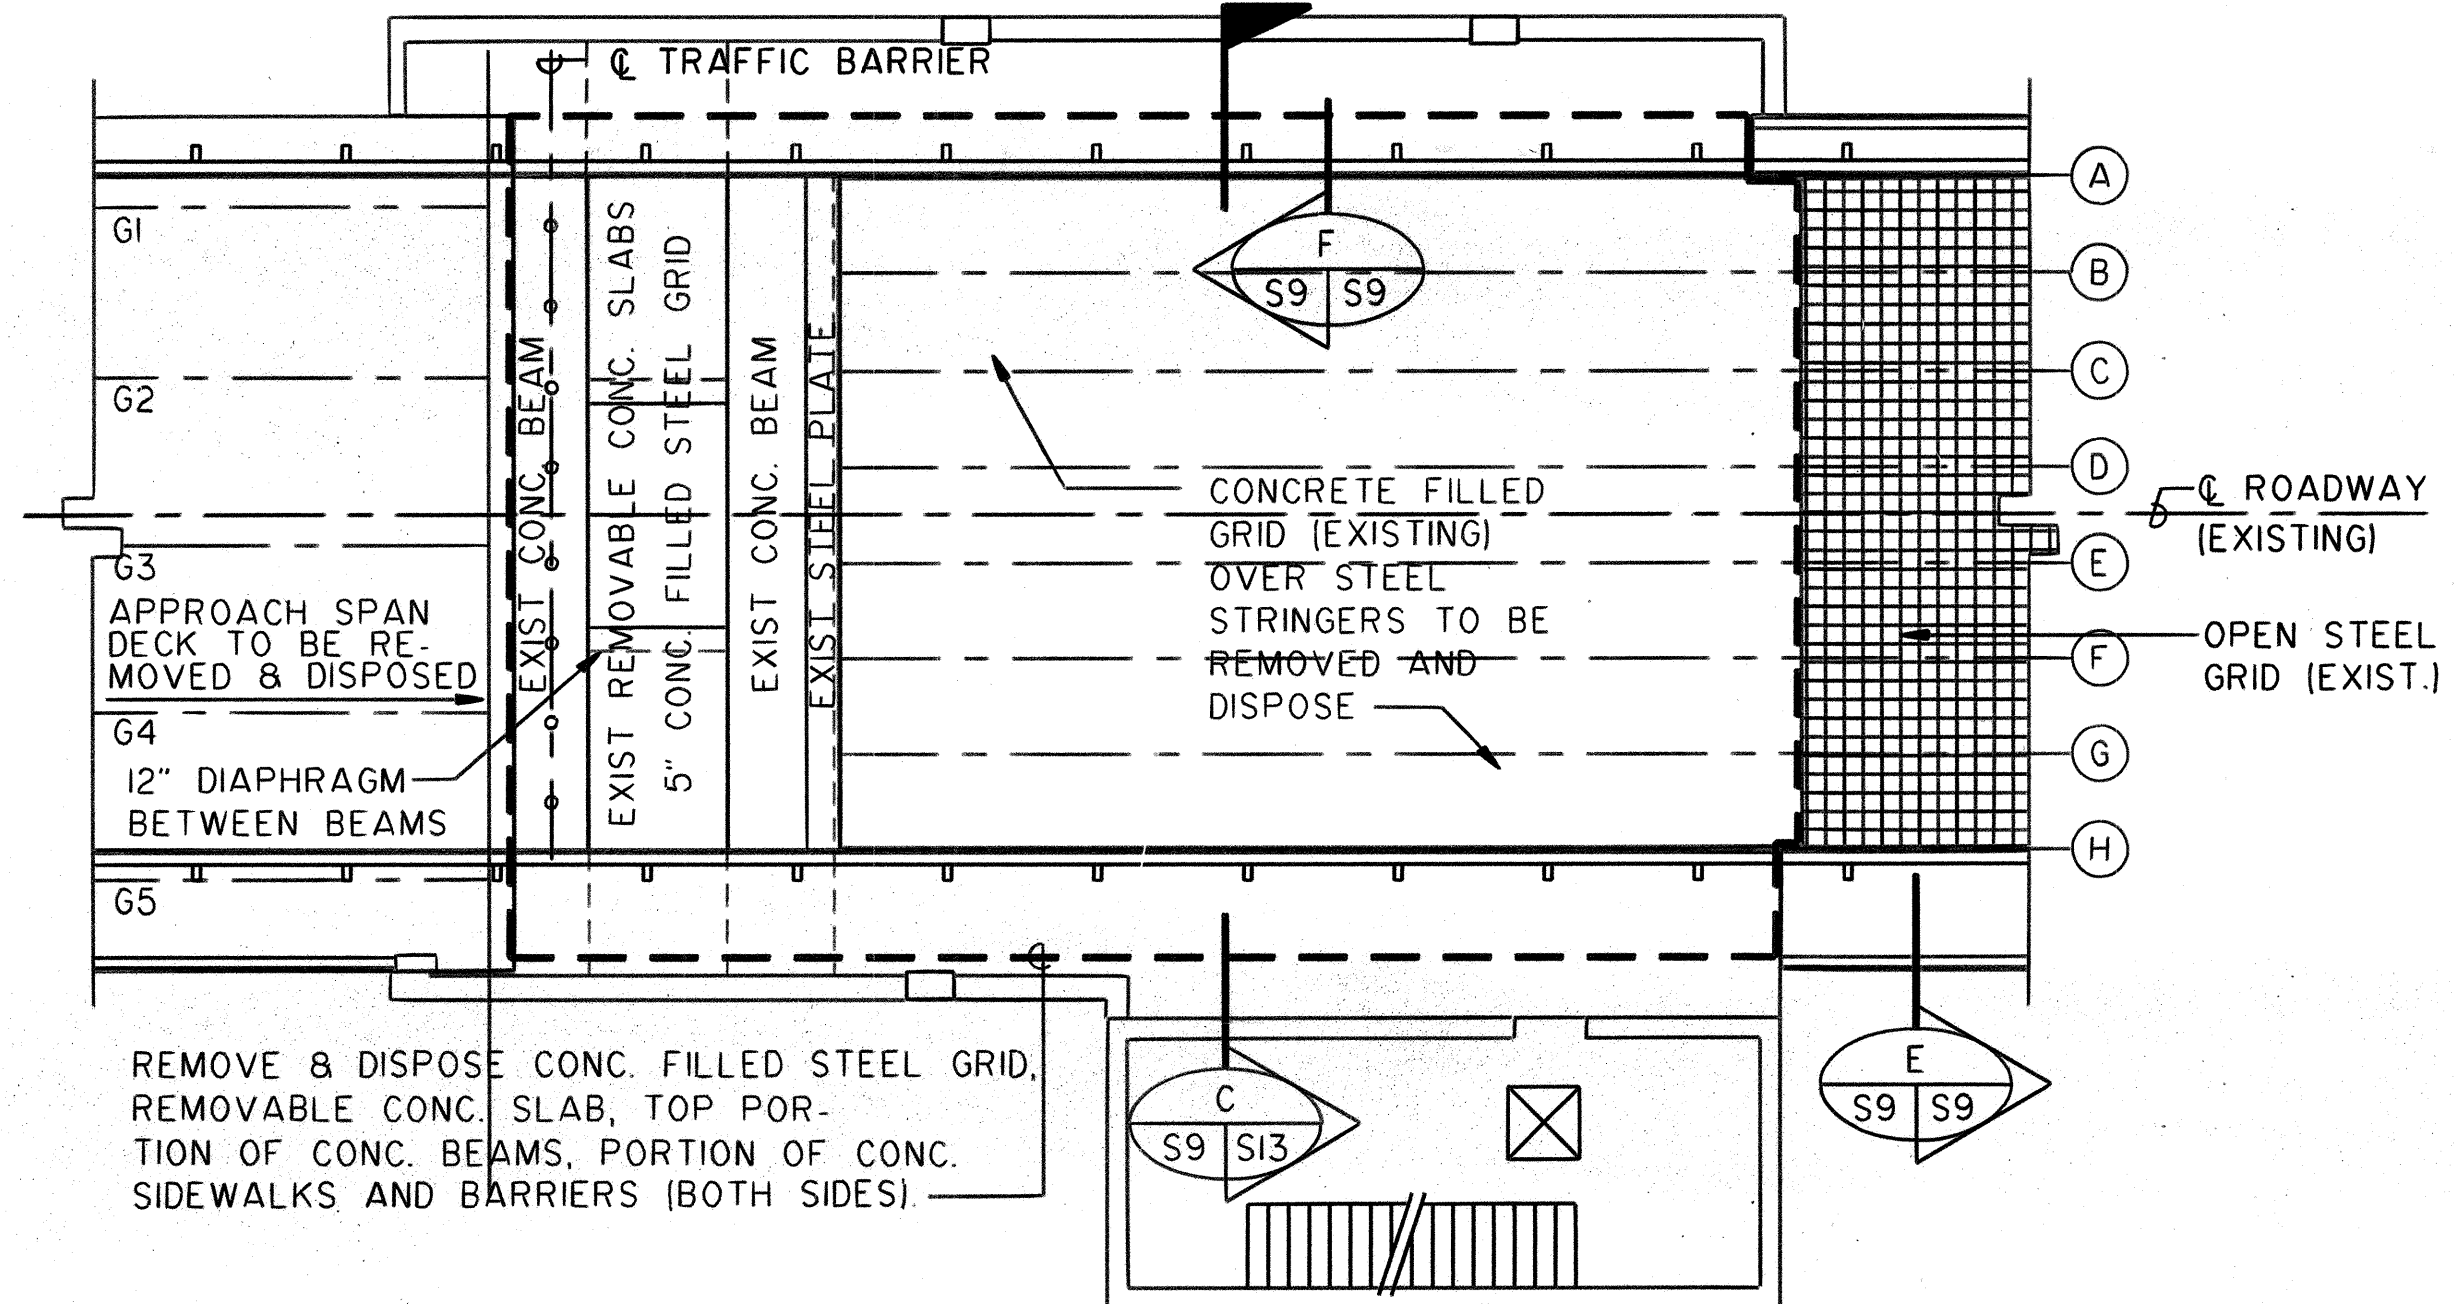


DEMOLITION PLAN OF EXIST ROADWAY AT PIER 3
SCALE: 1/8" = 1'-0"

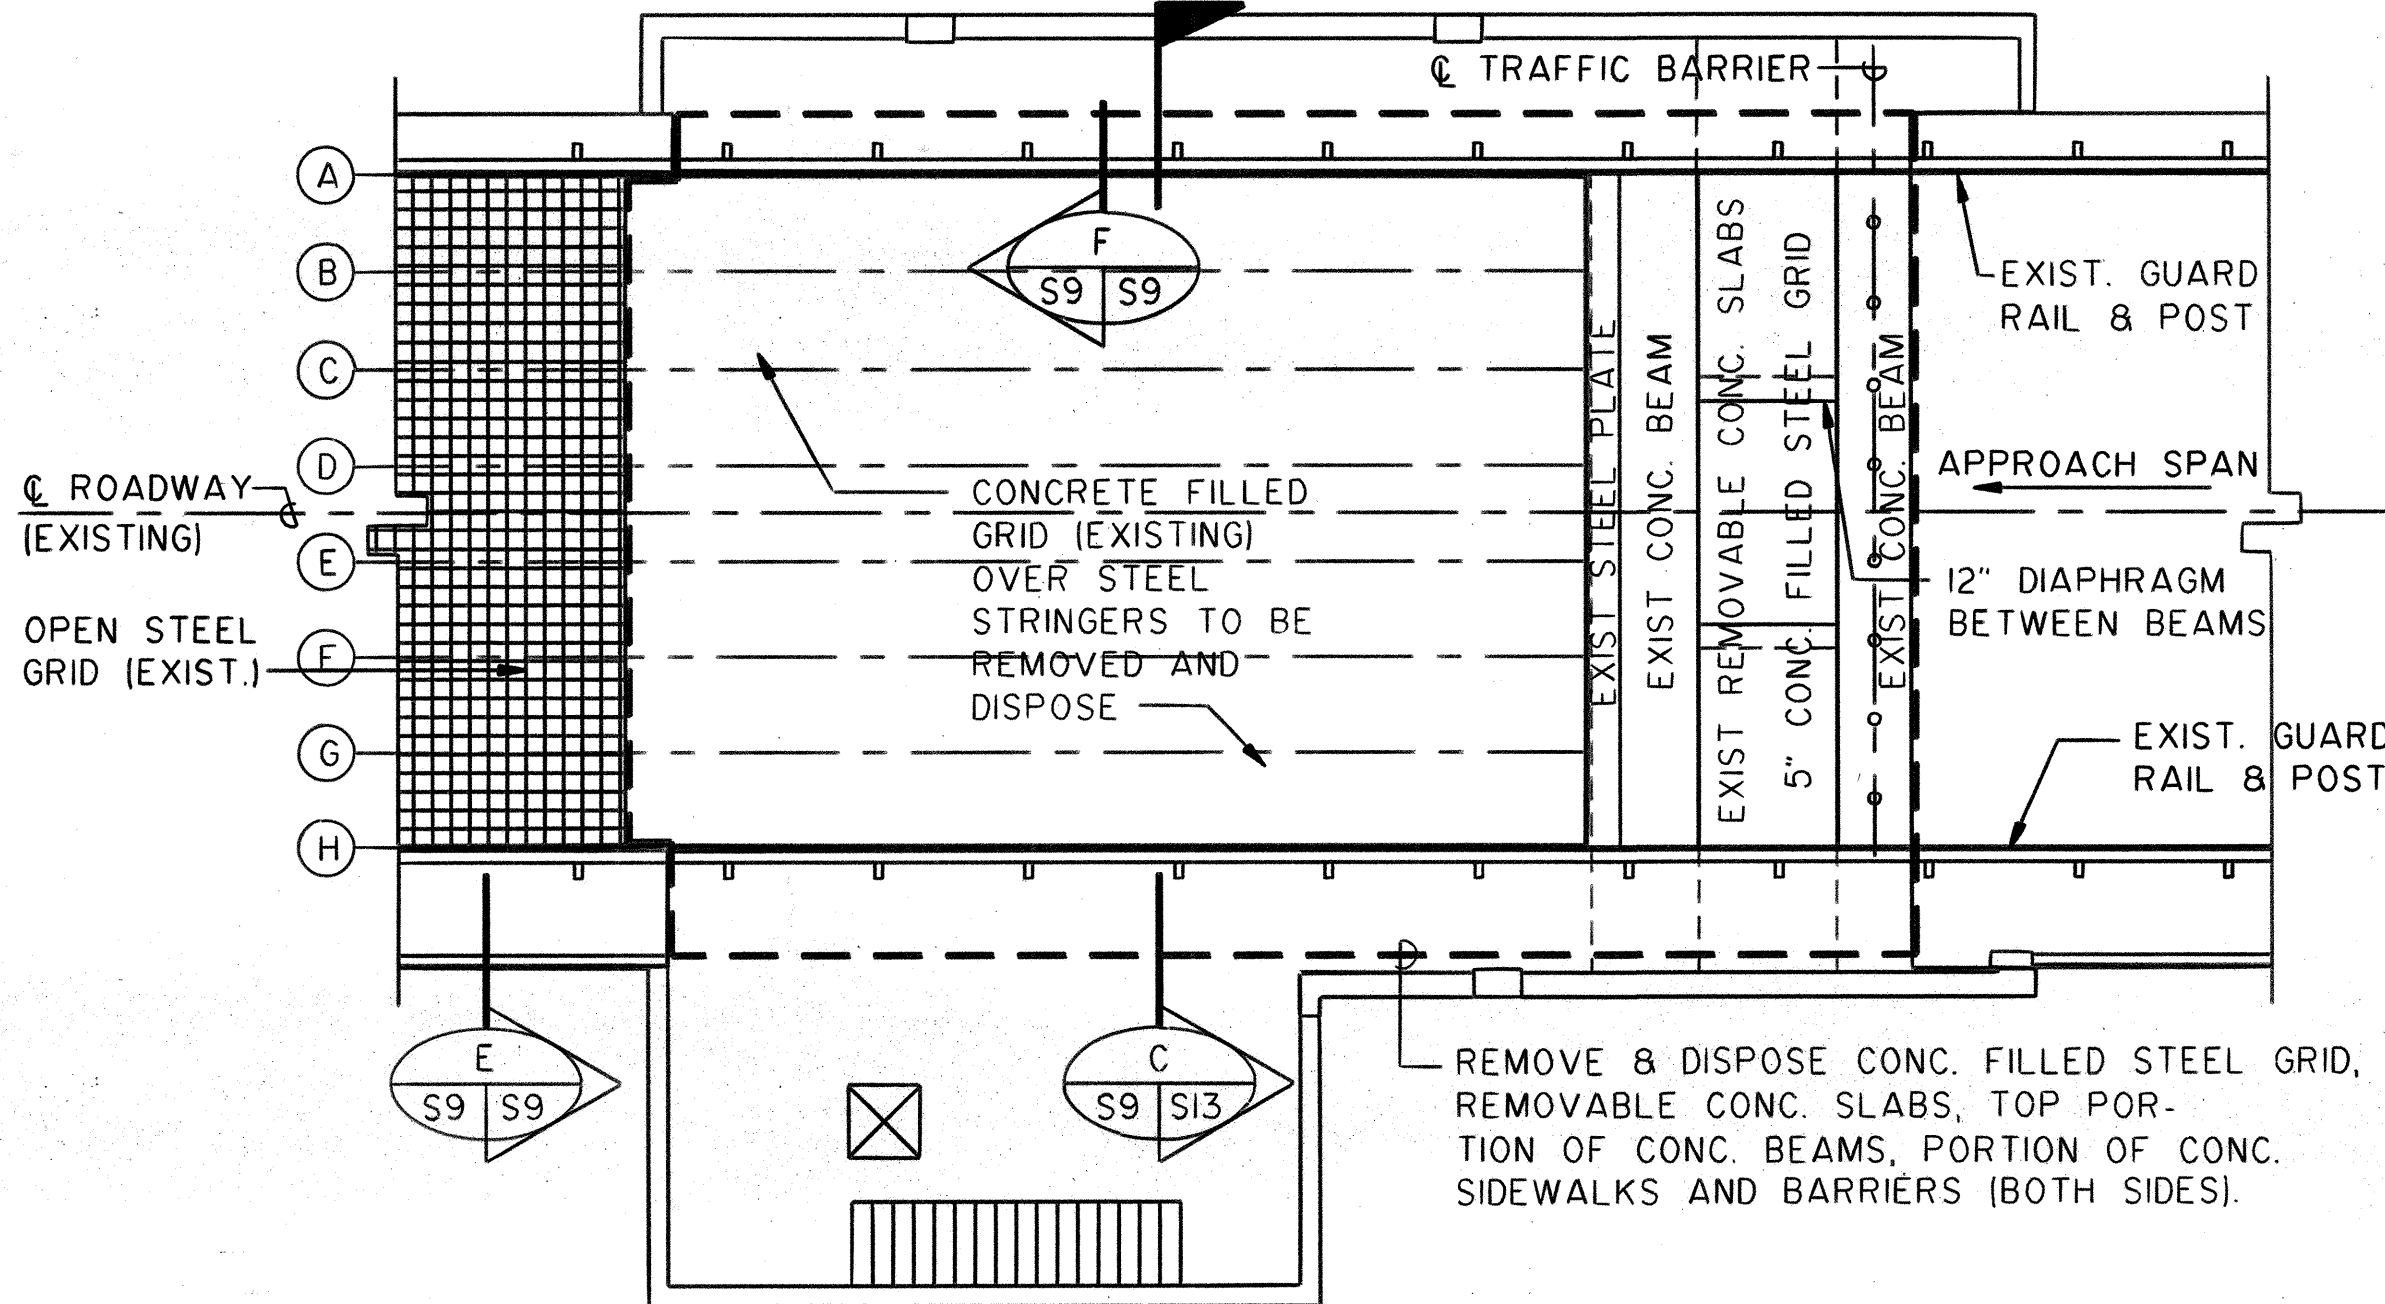



DEMOLITION PLAN OF EXIST ROADWAY AT PIER 4
SCALE: 1/8" = 1'-0"

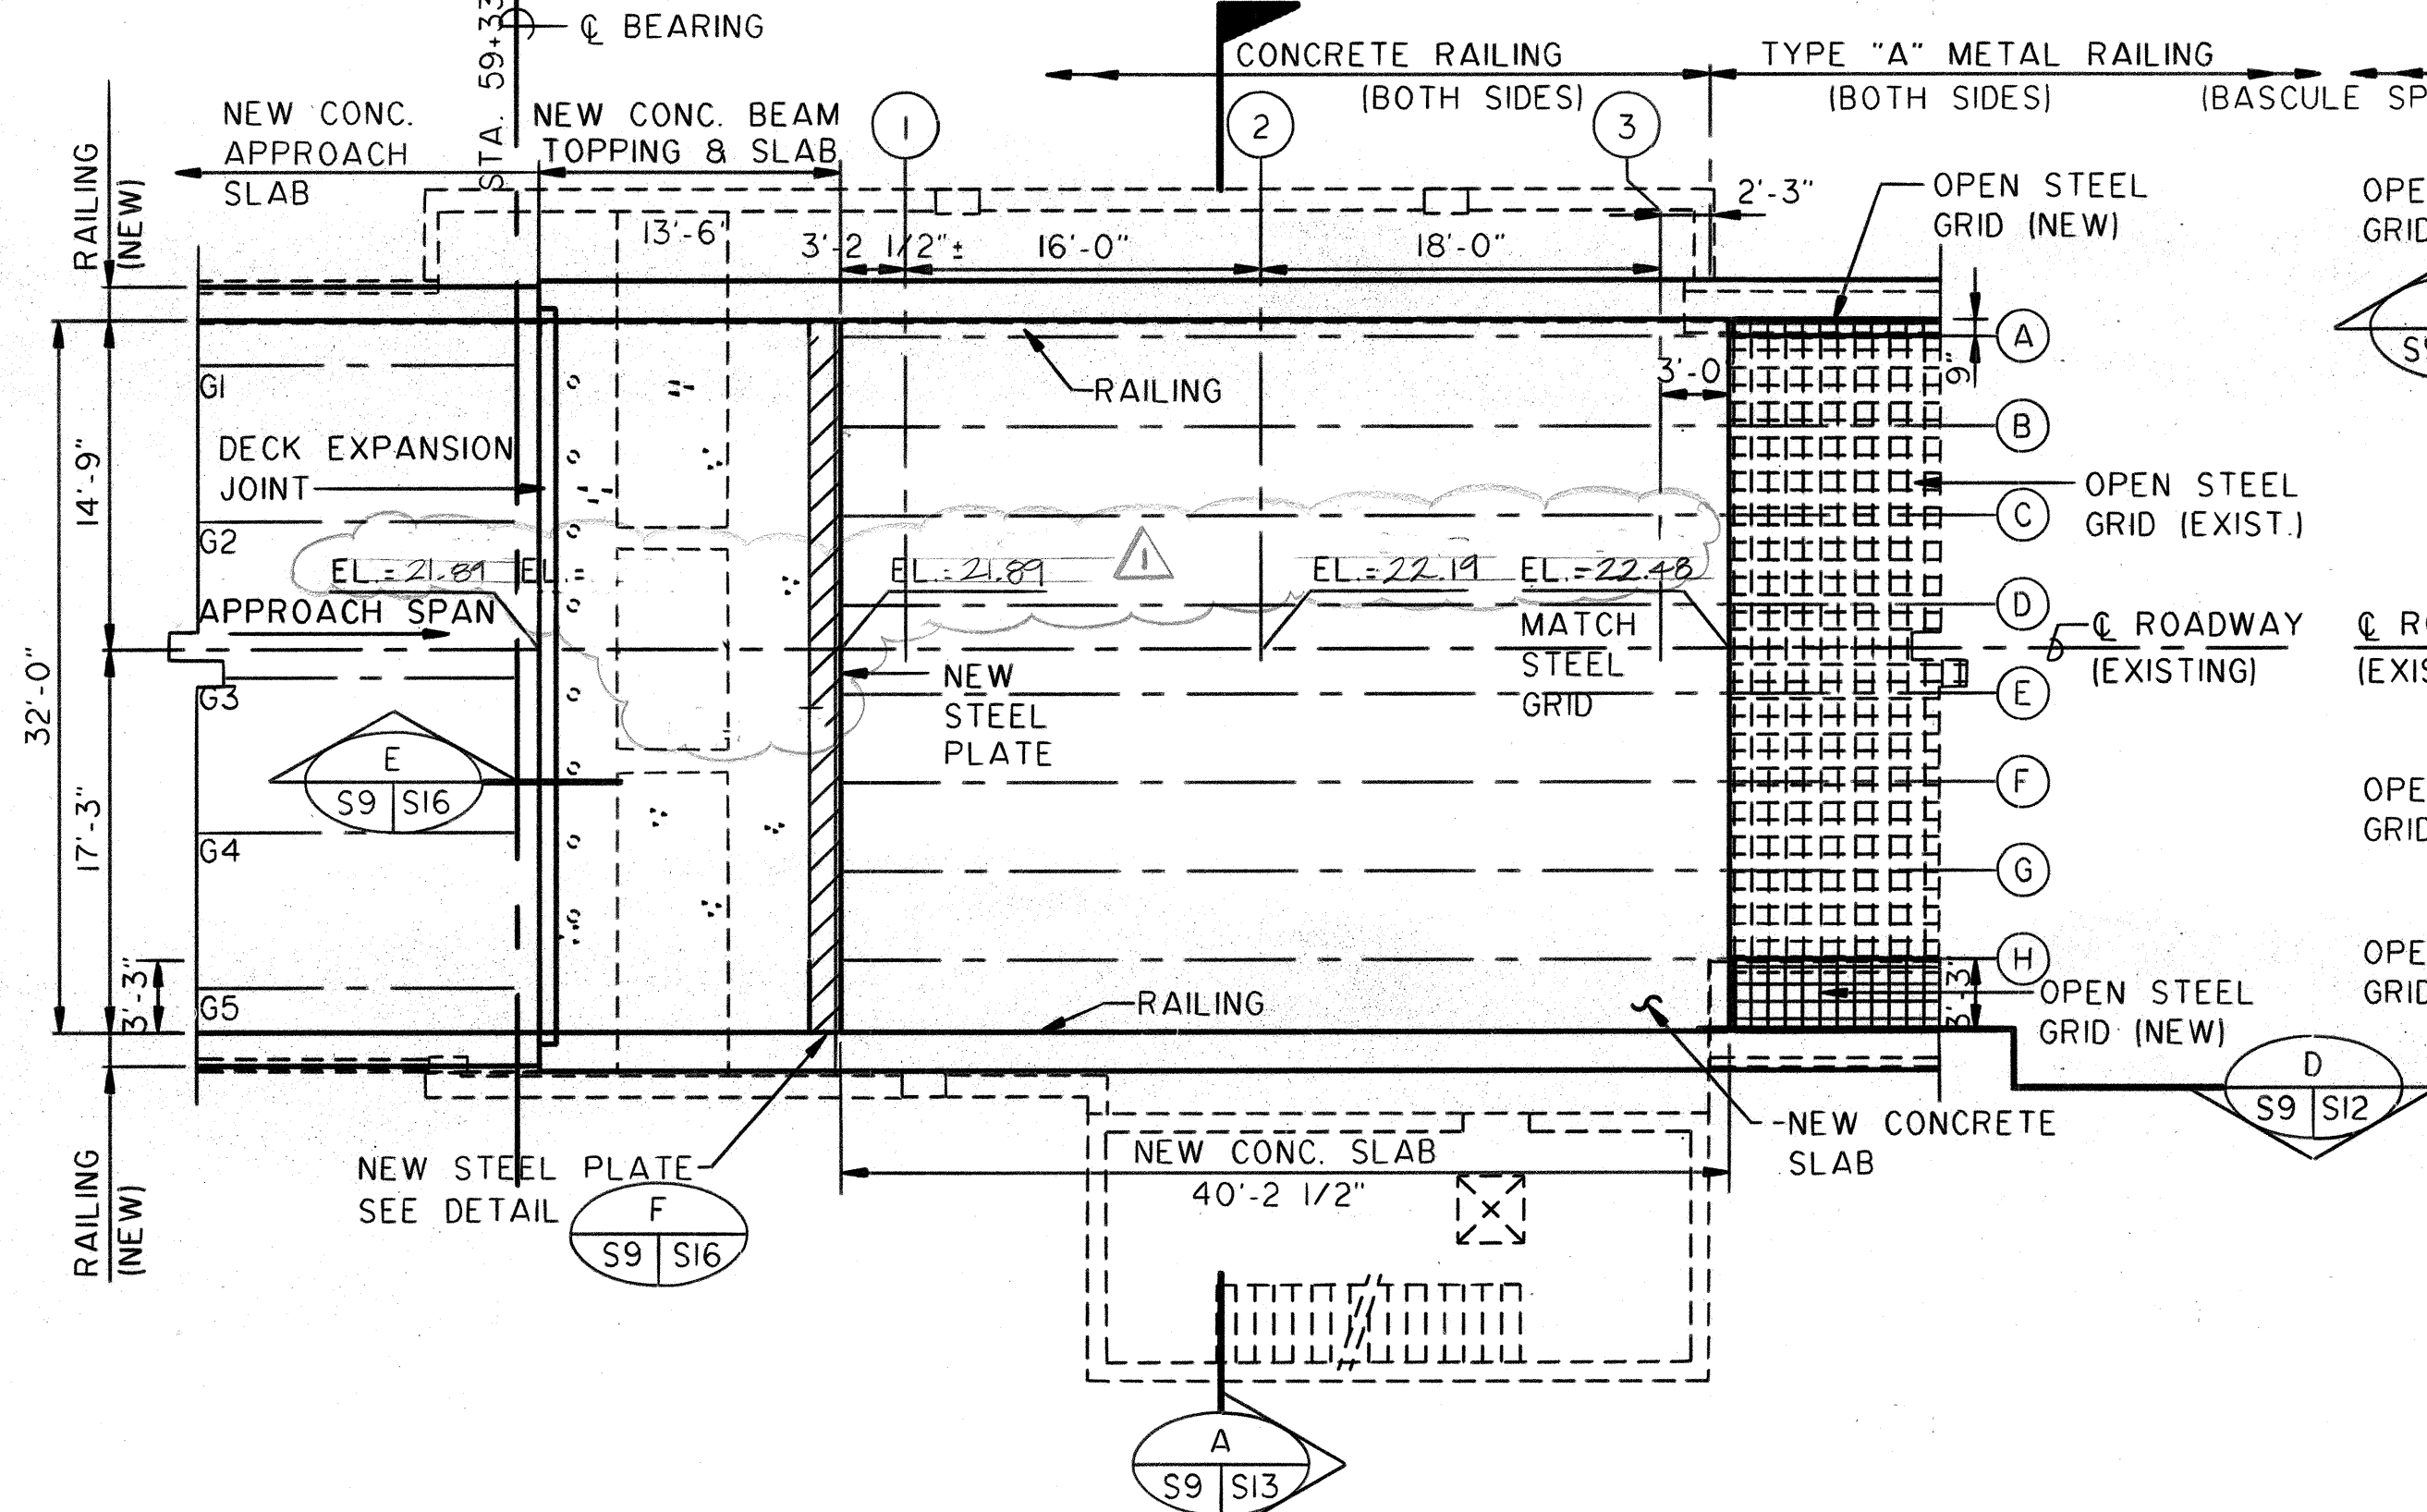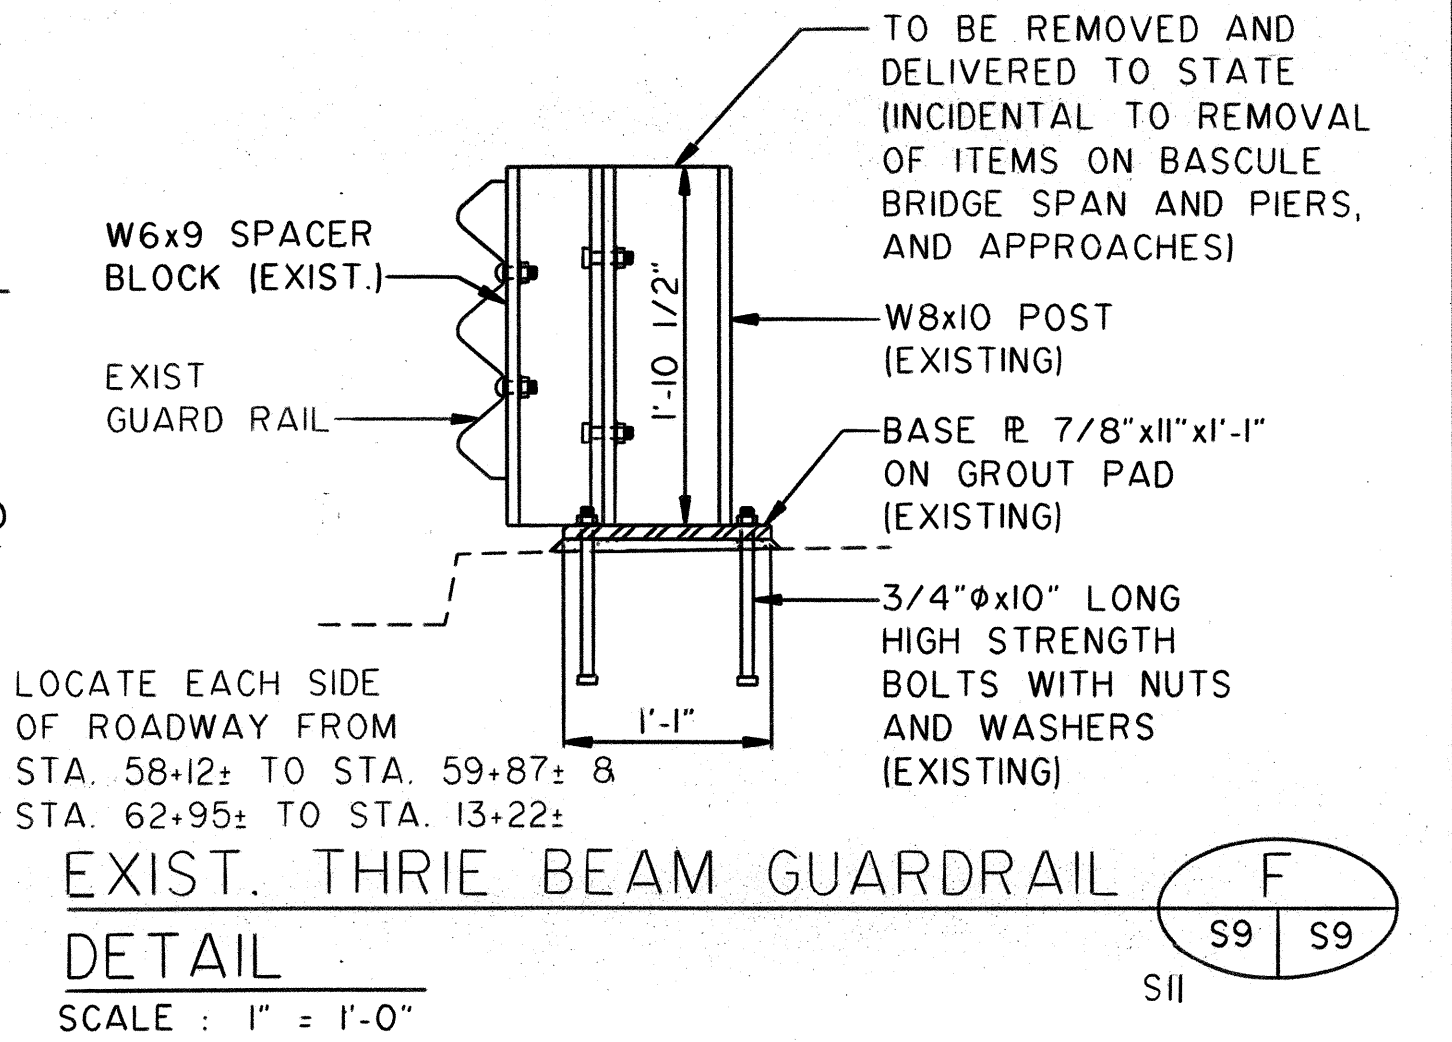

PARTIAL ROADWAY PLAN AT PIER 3
SCALE: 1/8" = 1'-0"

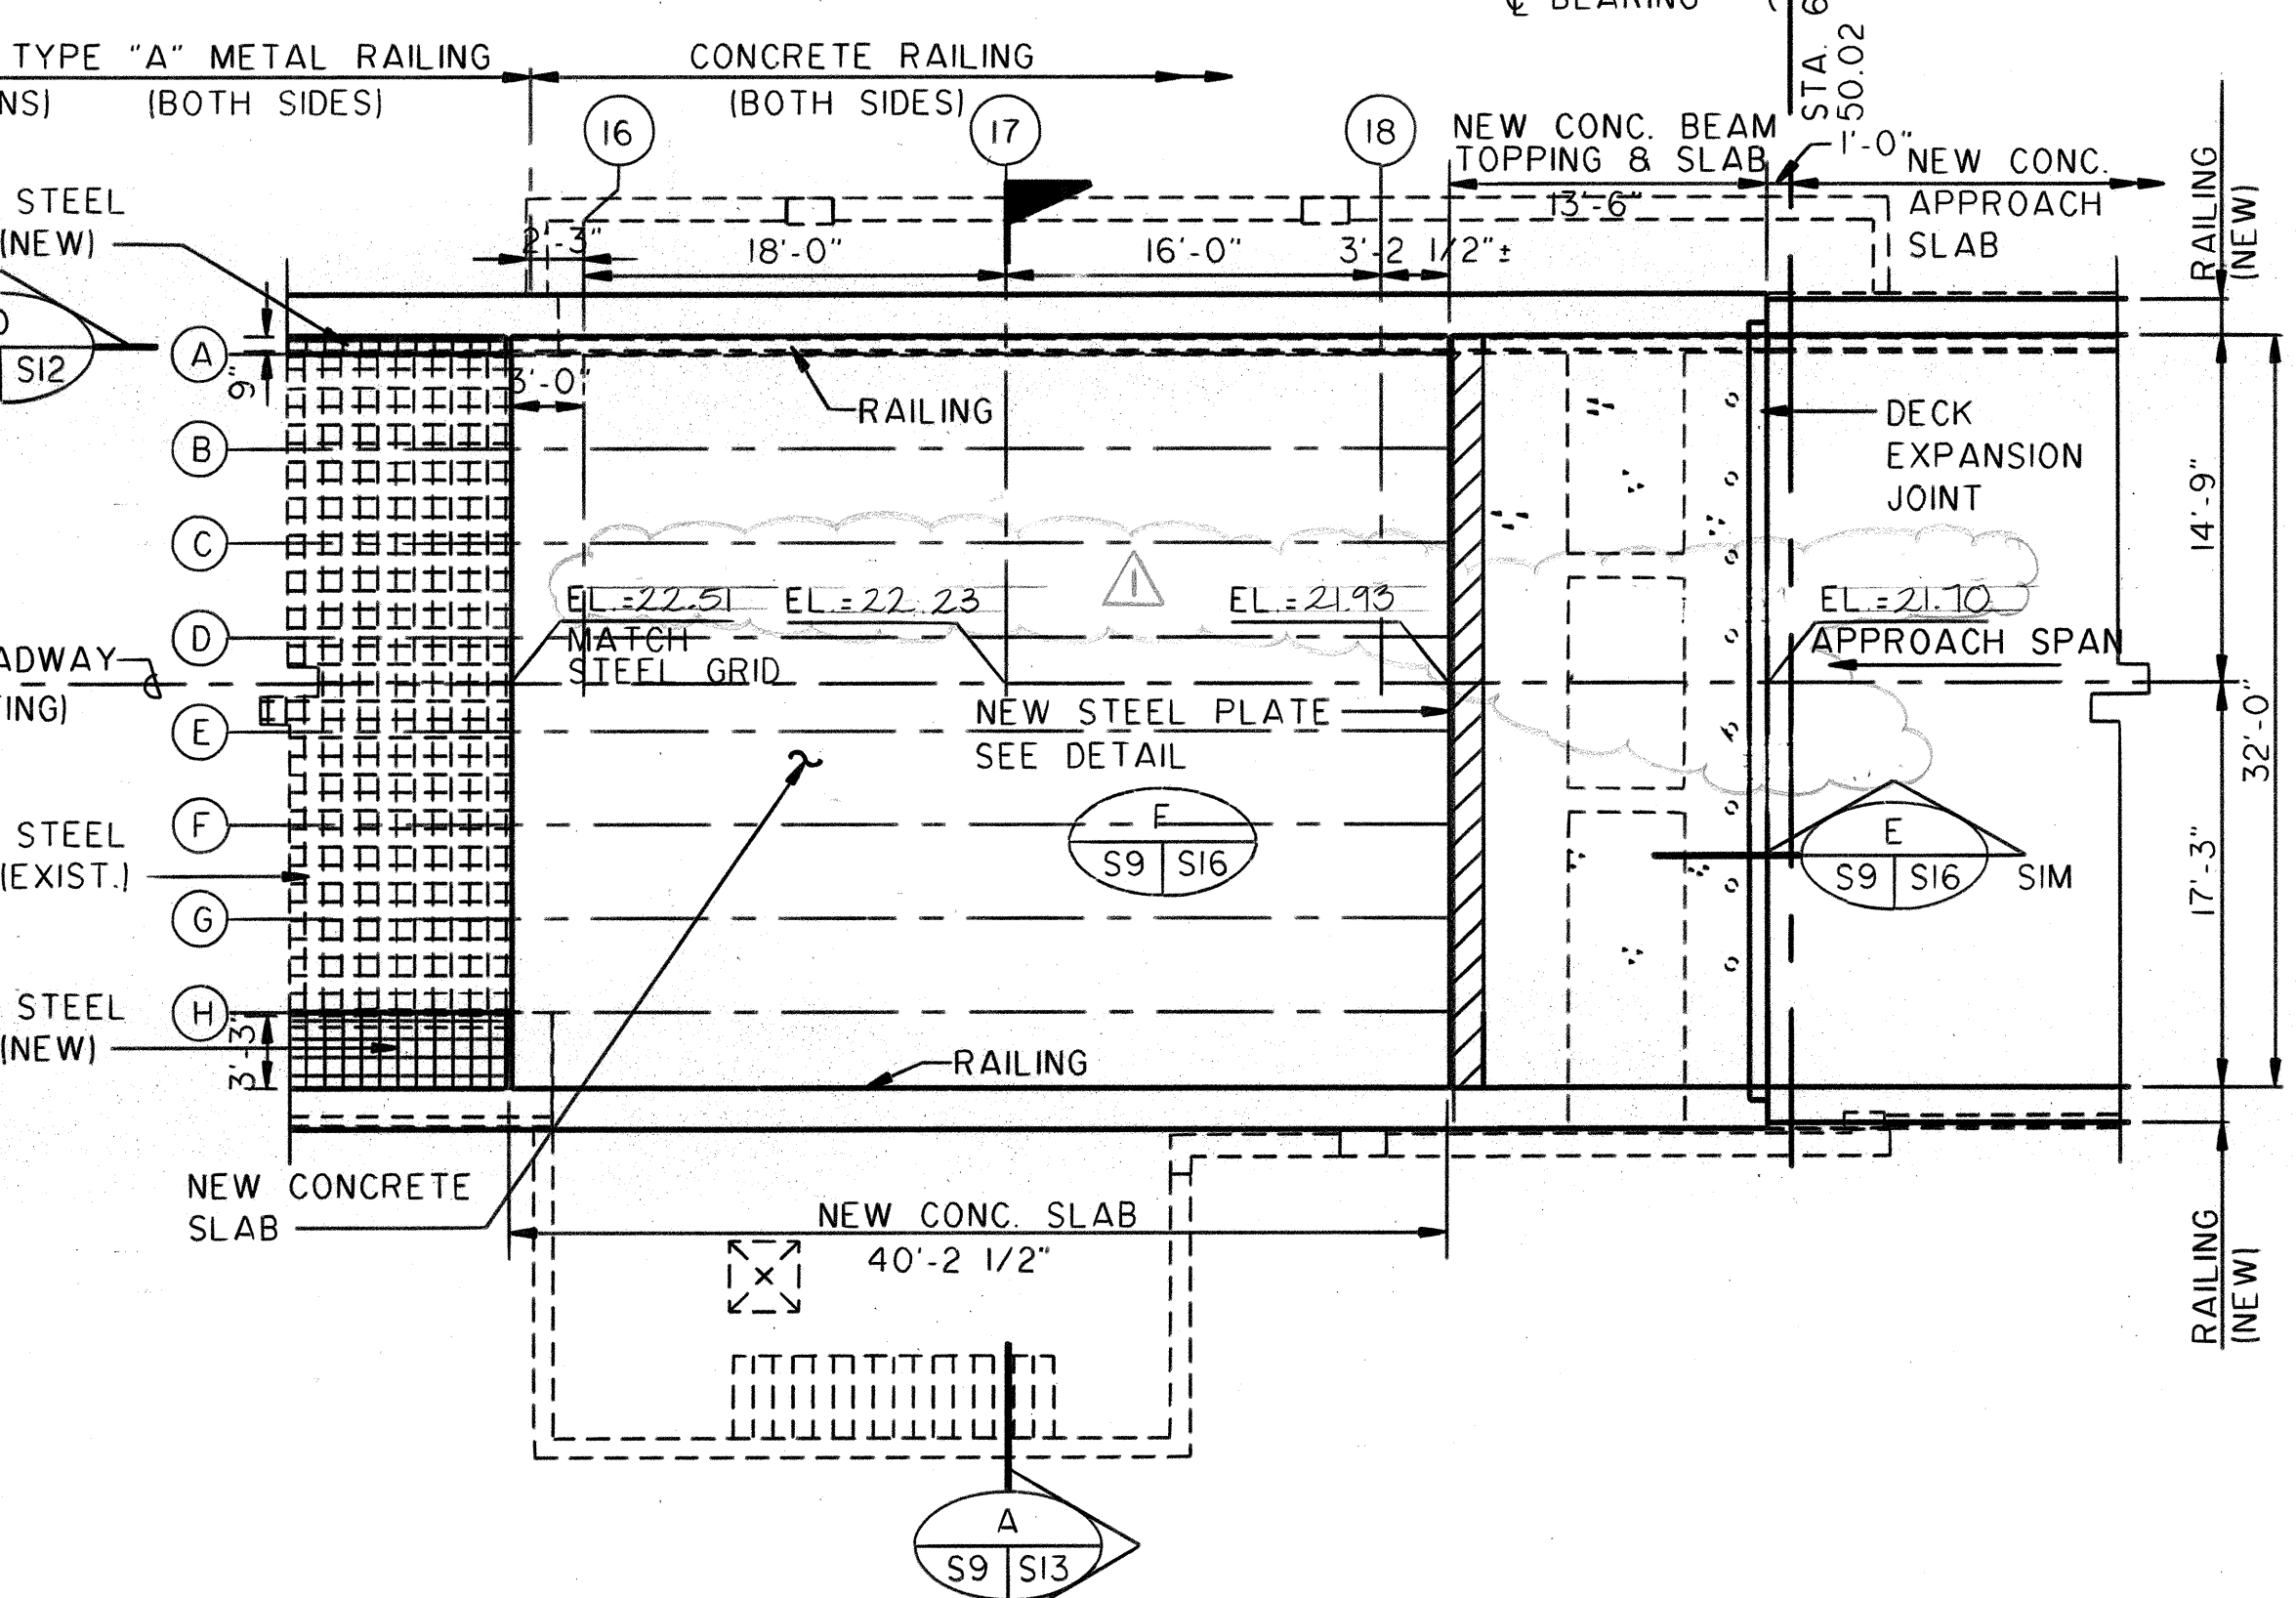

PARTIAL ROADWAY PLAN AT PIER 4
SCALE: 1/8" = 1'-0"

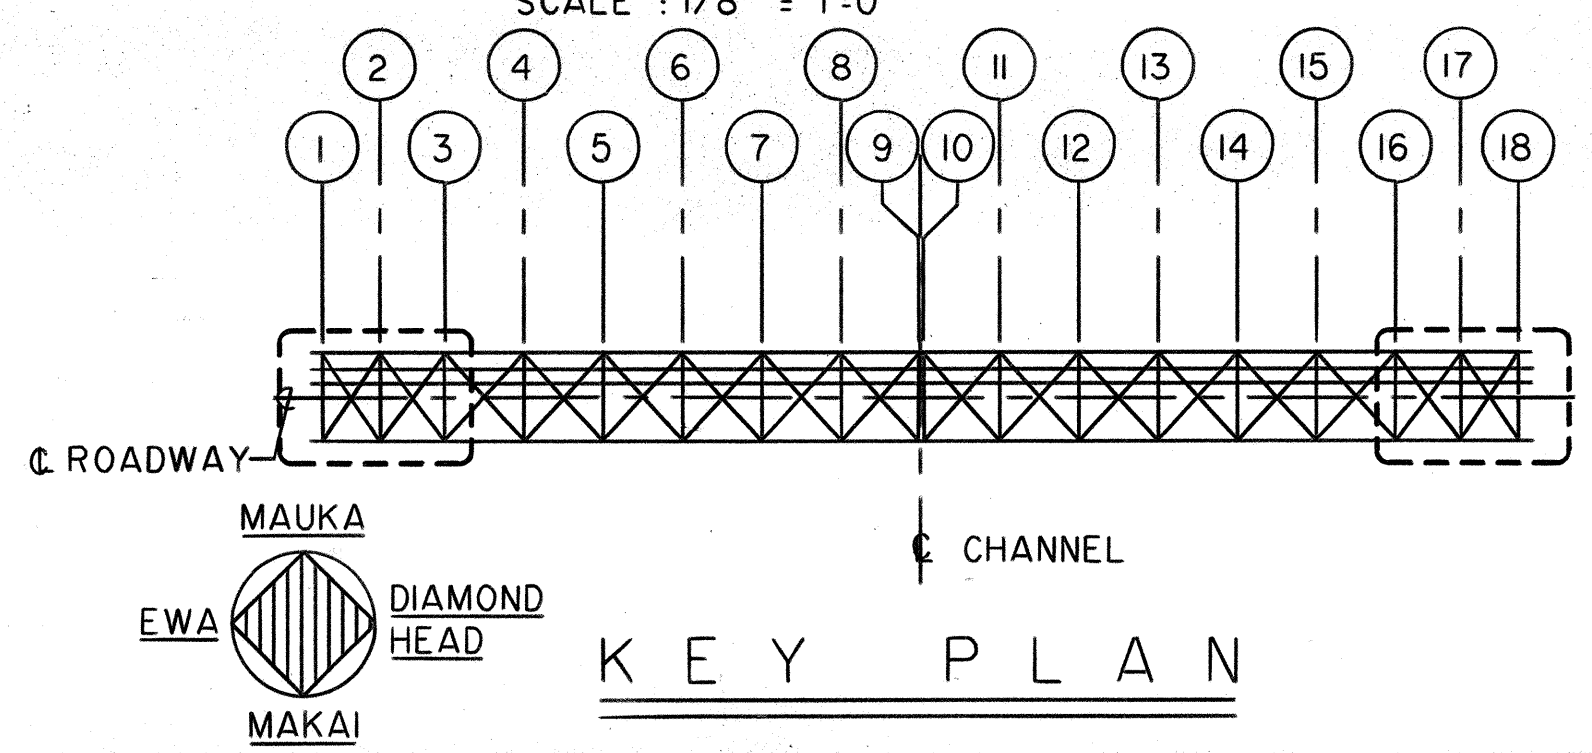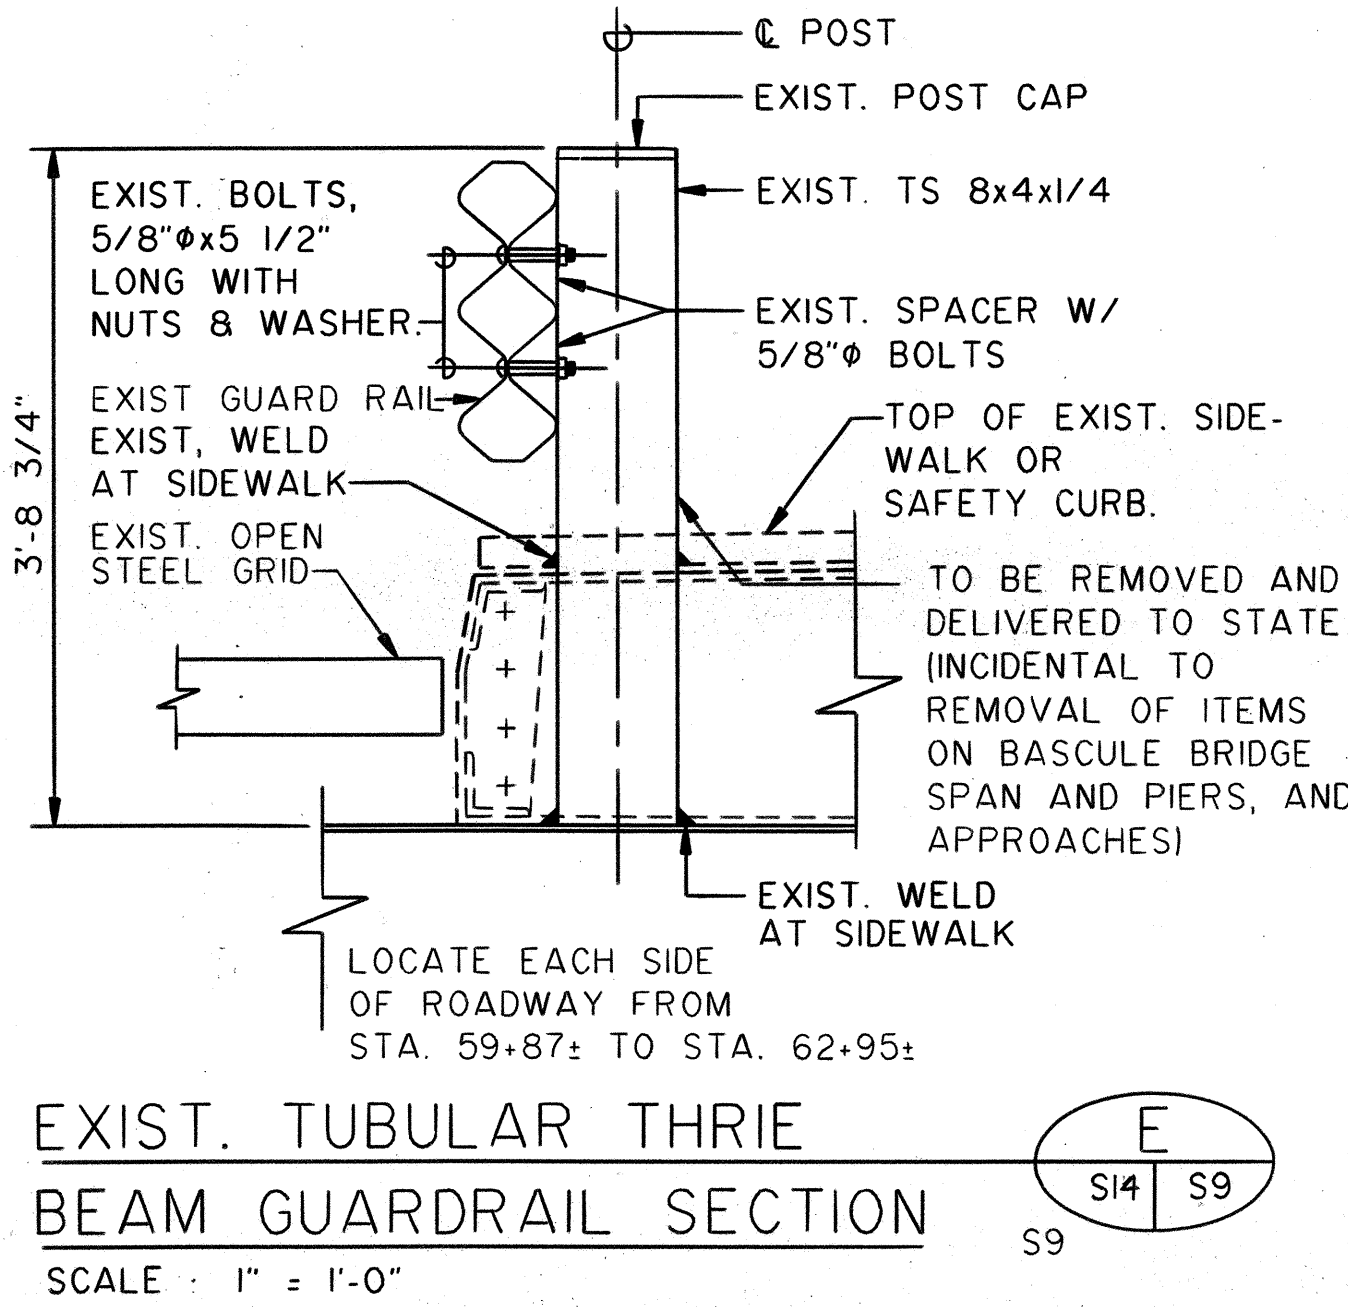

DATE	REVISION
4/13/92	REVISED GRADES

ROSCOE O. FORD
REGISTERED PROFESSIONAL ENGINEER
No. 3791-S
HAWAII, U.S.A.

THIS WORK WAS PREPARED BY ME OR UNDER MY SUPERVISION

Roscoe O. Ford

STATE OF HAWAII
DEPARTMENT OF TRANSPORTATION
HIGHWAYS DIVISION


PARTIAL ROADWAY PLANS
AT PIER 3 AND PIER 4

SAND ISLAND BASCULE BRIDGE
REHABILITATION PHASE II
PROJECT NO. BR-064-1(3)
SCALE: AS NOTED DATE: AUG. 15, 1991


SHEET No. S9 OF S21 SHEETS

SURVEY PLOTTED BY: _____ DATE: _____
DRAWN BY: _____
DESIGNED BY: _____
QUANTITIES BY: _____
CHECKED BY: _____


FED. ROAD DIST. NO.	STATE	FED. AID PROJ. NO.	FISCAL YEAR	SHEET NO.	TOTAL SHEETS
HAWAII	HAW.	BR-064-1(3)	1991	17	38

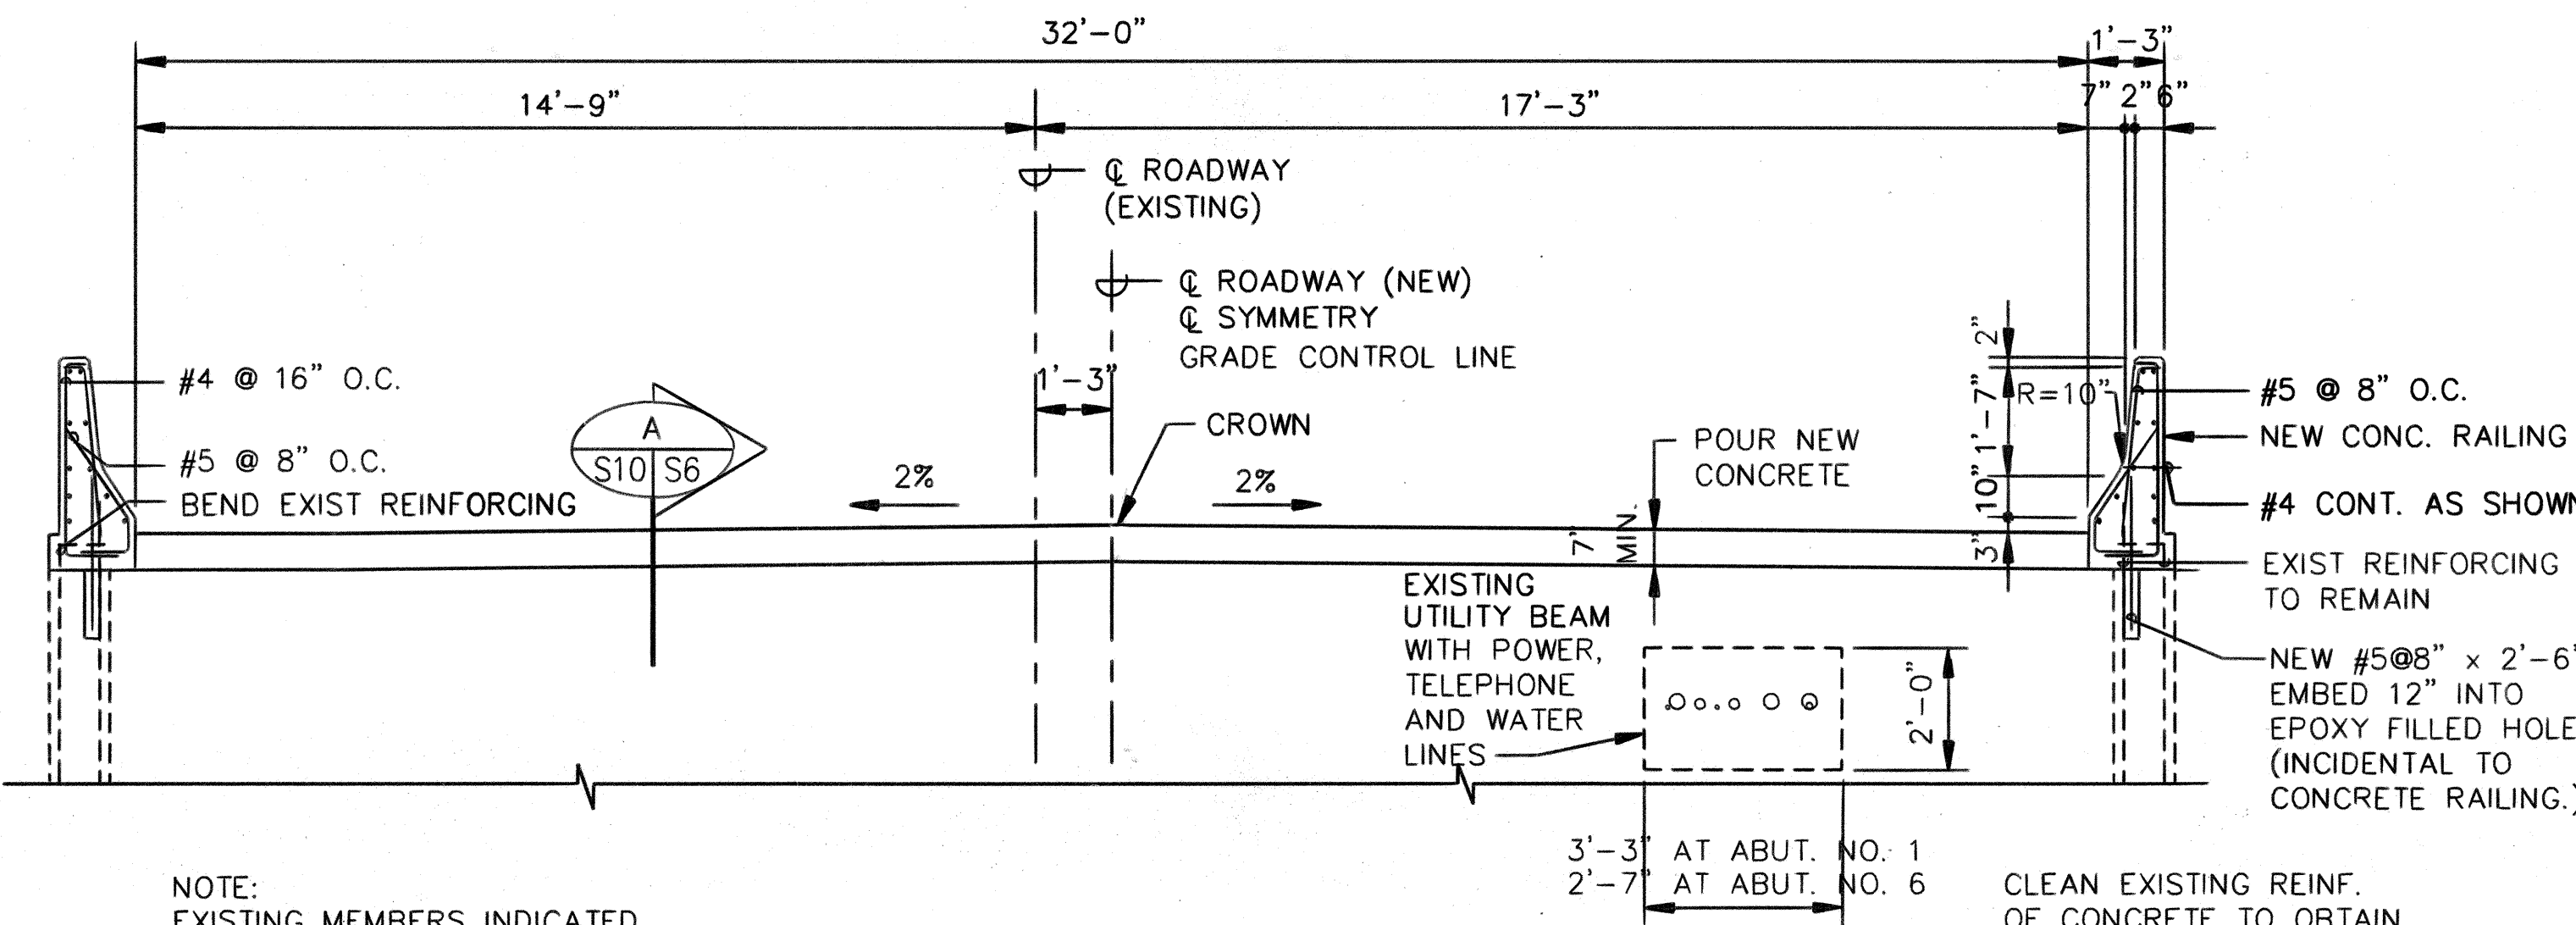


NEW SECTION AT ABUTMENT **B**
SCALE : 3/8" = 1'-0"

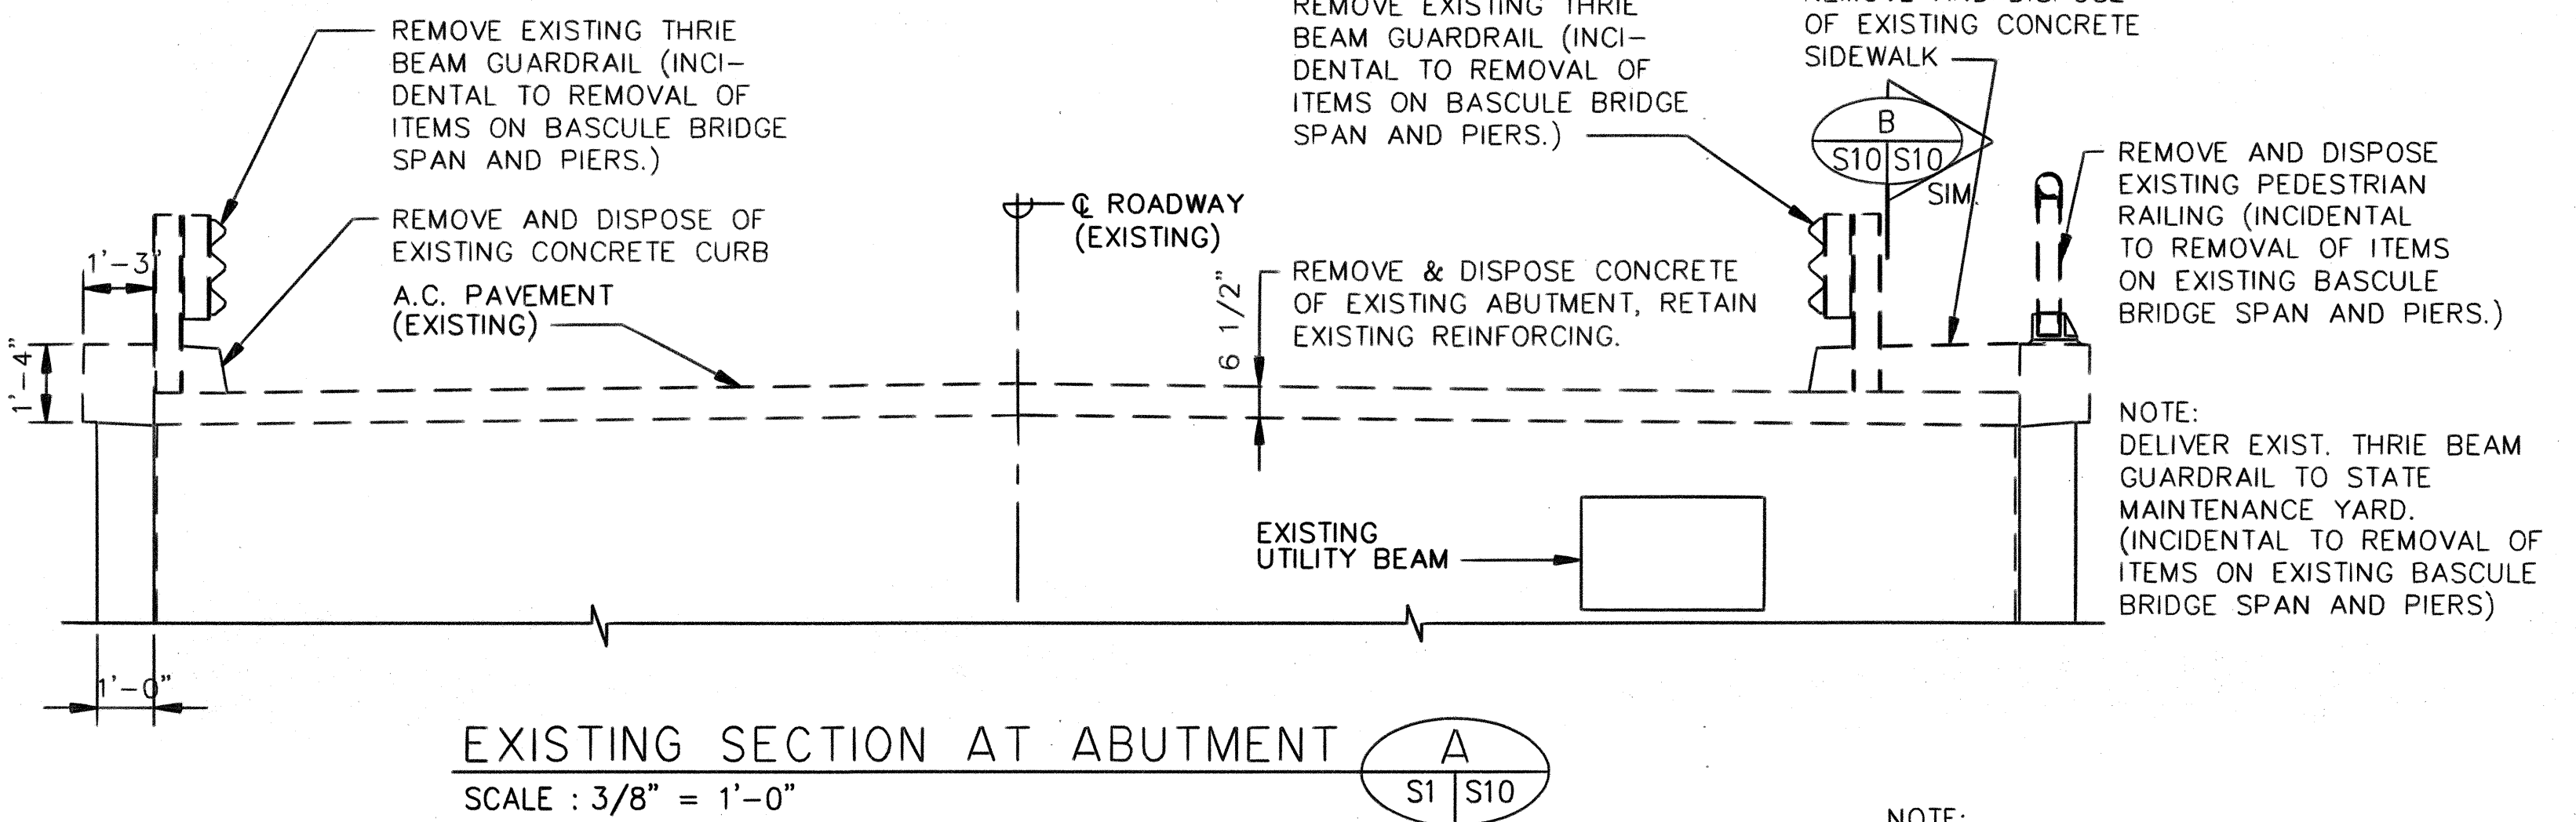


EXISTING SECTION AT ABUTMENT **A**
SCALE : 3/8" = 1'-0"

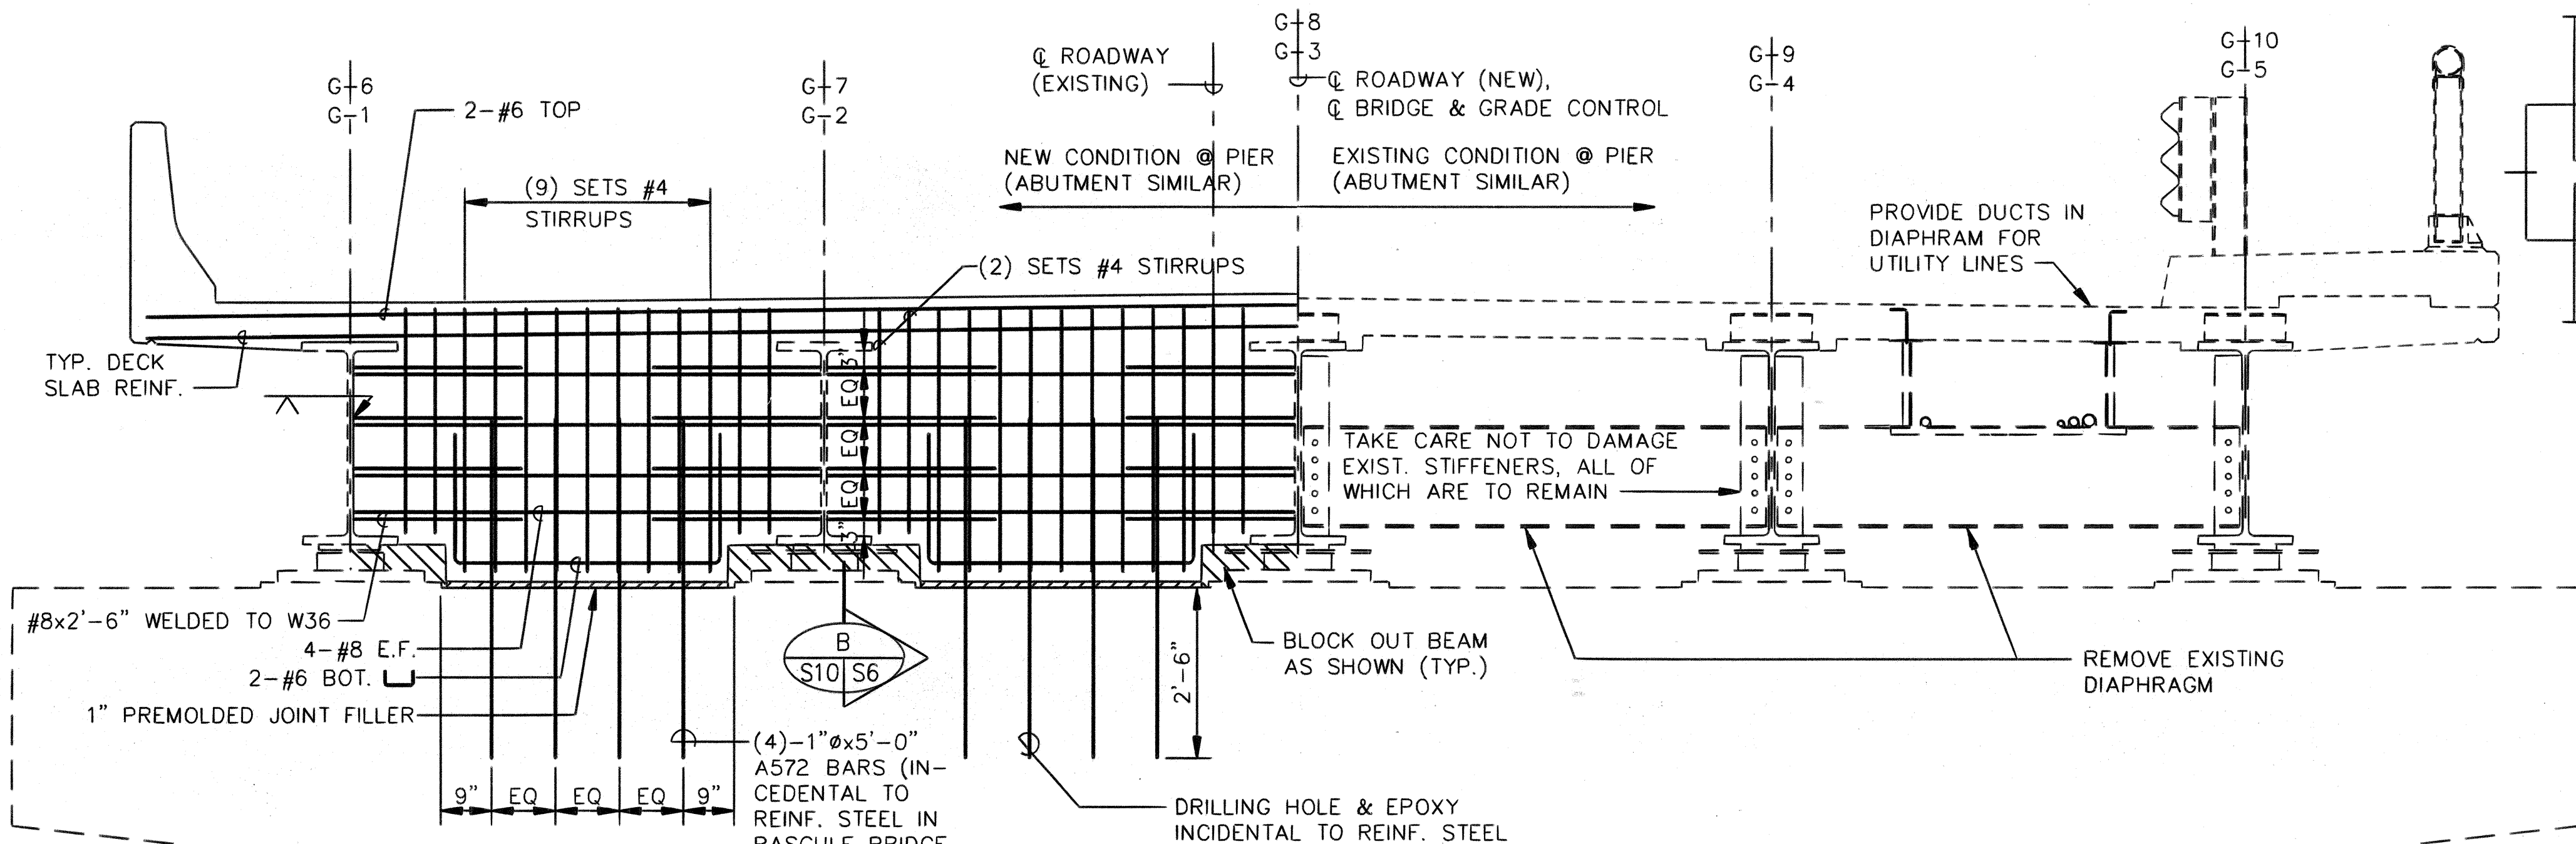


SECTION **D**
SCALE : 1/2" = 1'-0"

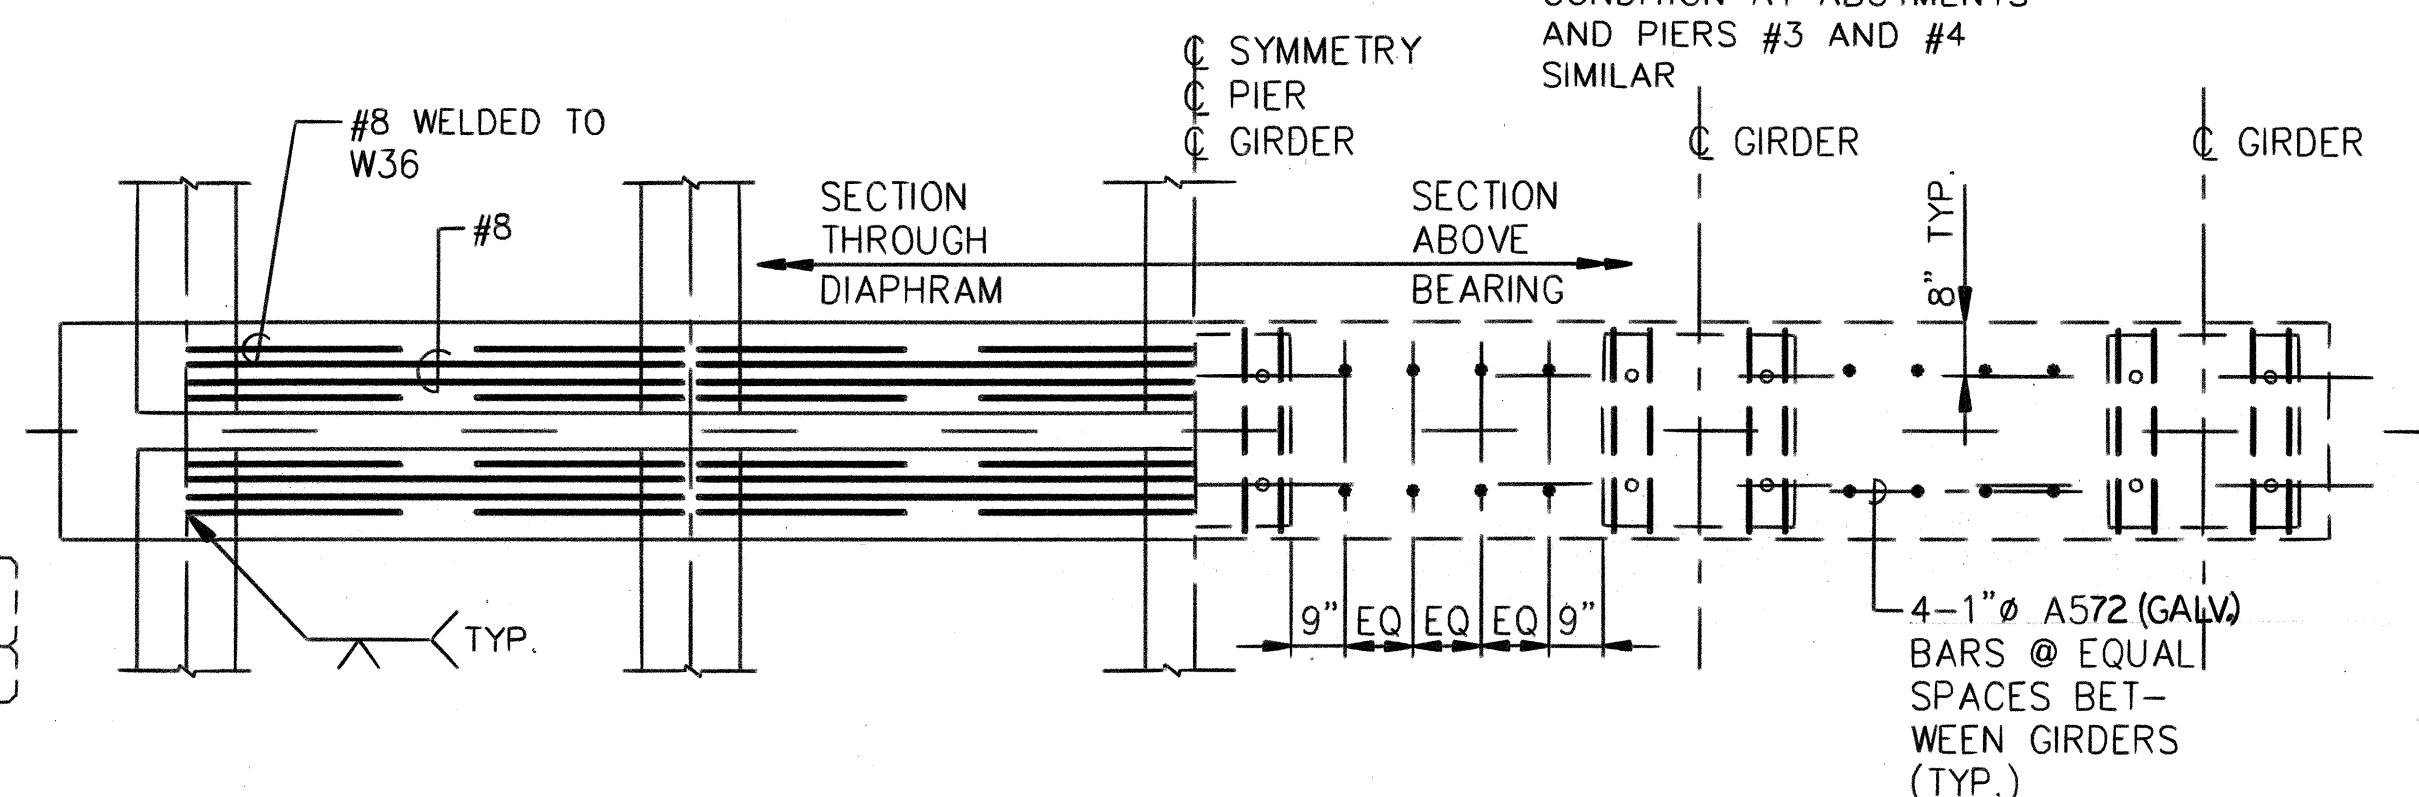


SECTION **E**
SCALE : 3/8" = 1'-0"

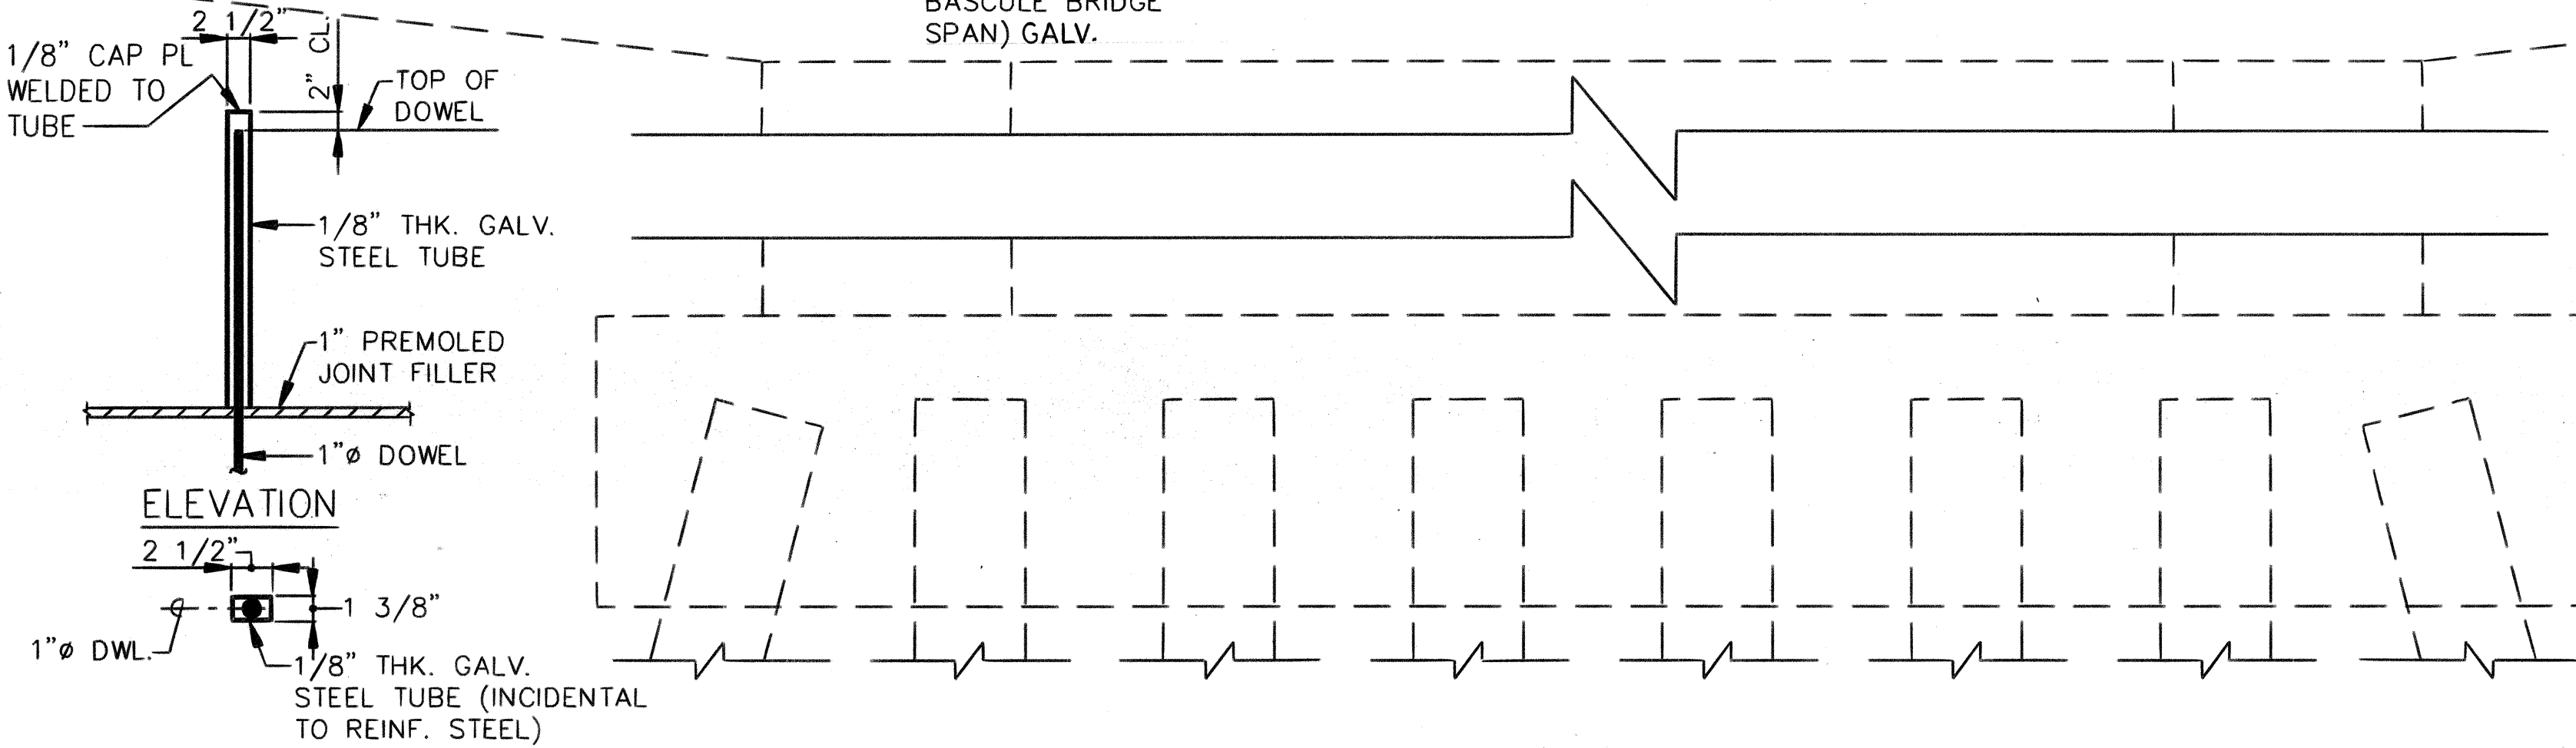

EXP. BEARING DET. **F**
NOT TO SCALE

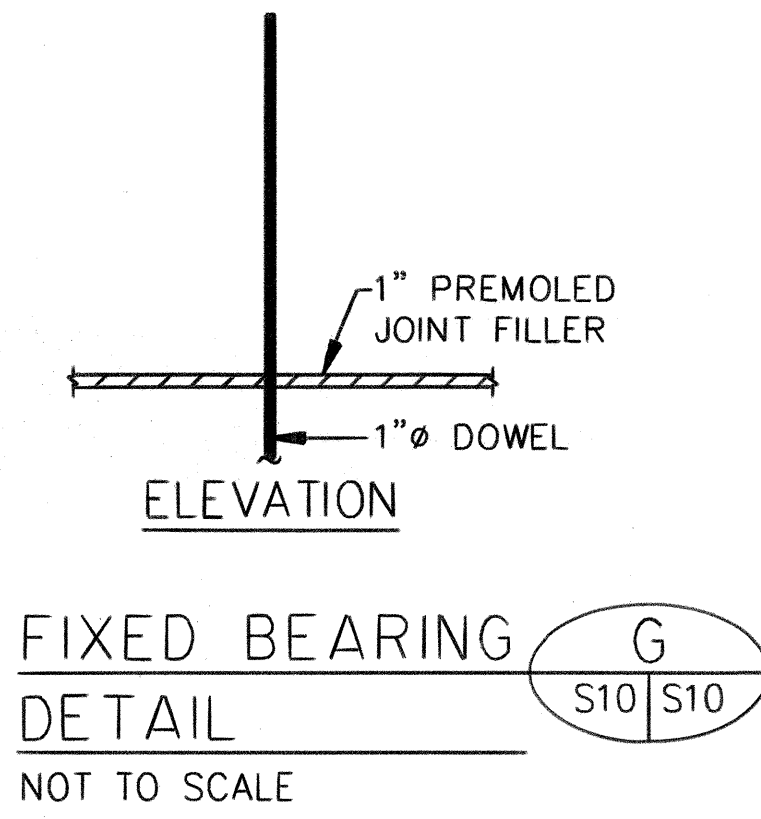

FIXED BEARING DETAIL **G**
NOT TO SCALE

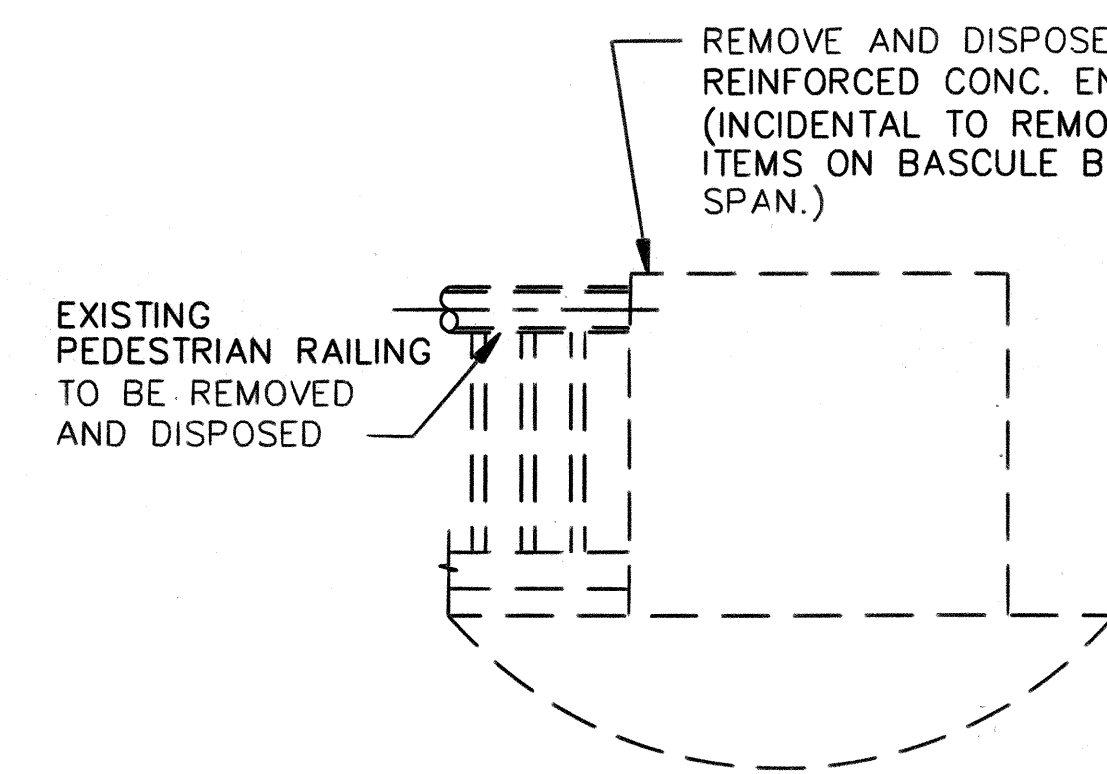

END-POST ELEVATION **C**
SCALE : 1/2" = 1'-0"

THIS WORK WAS PREPARED BY ME OR UNDER MY SUPERVISION

Robcoe O. Ford

STATE OF HAWAII
DEPARTMENT OF TRANSPORTATION
HIGHWAYS DIVISION

CROSS SECTION
AT ABUTMENT

SAND ISLAND BASCULE BRIDGE
REHABILITATION PHASE II
PROJECT NO. BR-064-1(3)

SCALE: AS NOTED DATE: AUG. 15, 1991

SHEET No. S10 OF S21 SHEETS

SURVEY PLOTTED BY	DATE
DRAWN BY	
DESIGNED BY	
CHECKED BY	
ORIGINAL PLAN	
NOTED	
QUANTITIES BY	
CHECKED BY	

2'-6"

28'-0"

35'-6"

5'-0"

G+6
G-1

REMOVE EXISTING THRIE BEAM GUARDRAIL (INCIDENTAL TO REMOVAL OF ITEMS ON APPROACH SPAN).

REMOVE & DISPOSE EXISTING CURB (INCIDENTAL TO REMOVAL OF ITEMS ON APPROACH SPAN).

F
SII | S9

G+7
G-2

EXISTING C5x6.7 SHEAR CONNECTORS DO NOT DAMAGE DURING SLAB REMOVAL. REPAIR ANY DAMAGED SHEAR CONNECTIONS AT NO COST TO THE STATE.

DEMOLISH & DISPOSE OF EXISTING CONCRETE APPROACH DECK SLAB AND SLAB REINFORCING

6 1/2"

ROADWAY (EXISTING)

G+8
G-3

EXISTING #5@12" O.C. TRUSS BAR

EXISTING #5@12" O.C.

EXISTING #4@12" O.C. E.F.

G+9
G-4

REMOVE EXISTING THRIE BEAM GUARDRAIL (INCIDENTAL TO REMOVAL OF ITEMS ON APPROACH SPAN).

REMOVE & DISPOSE EXISTING SIDEWALK (INCIDENTAL TO REMOVAL OF ITEMS ON APPROACH SPAN).

G+10
G-5

REMOVE & DISPOSE EXISTING PEDESTRIAN RAILING (INCIDENTAL TO REMOVAL OF ITEMS ON APPROACH SPAN).

F
SII | S9

C18x42.7, TYP. (EXISTING)

EXISTING 36 WF 230 GIRDER, TYP. (NIMITZ APPROACH)

EXISTING 36 WF 160 GIRDER, TYP. (SAND ISLAND APPROACH)

ALL STEEL GIRDERS ARE TO REMAIN IN PLACE

EXISTING #5@12" O.C.

EXISTING BEAM BEYOND

EXISTING STEEL COVER PLATE, TYP.

CONDUIT HANGERS SPACED AT 22'-0" O.C. SUPPORT CONDUIT ON EXIST. C18x42.7 DIAPHRAGMS, EQUALLY SPACED BETWEEN HANGERS.


NOTE: DELIVER EXIST. THRIE BEAM GUARDRAIL TO STATE MAINTENANCE YARD. (INCIDENTAL TO REMOVAL OF ITEMS ON APPROACH SPAN.)

EXISTING MEMBERS TO BE REMOVED AND DISPOSED, INDICATED WITH DASHED LINES

EXISTING APPROACH DECK SECTION A


SCALE 3/4" = 1'-0"

SI | SII

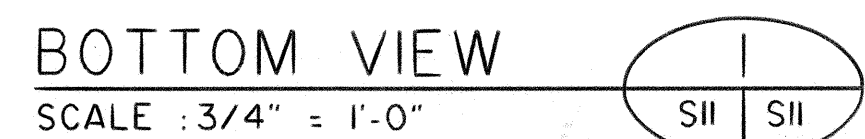


SHEET No. 511 OF 521 SHEETS


FED. ROAD DIST. NO.	STATE	FED. AID PROJ. NO.	FISCAL YEAR	SHEET NO.	TOTAL SHEETS
HAWAII	HAW.	BR-064-1(3)	1991	19	38

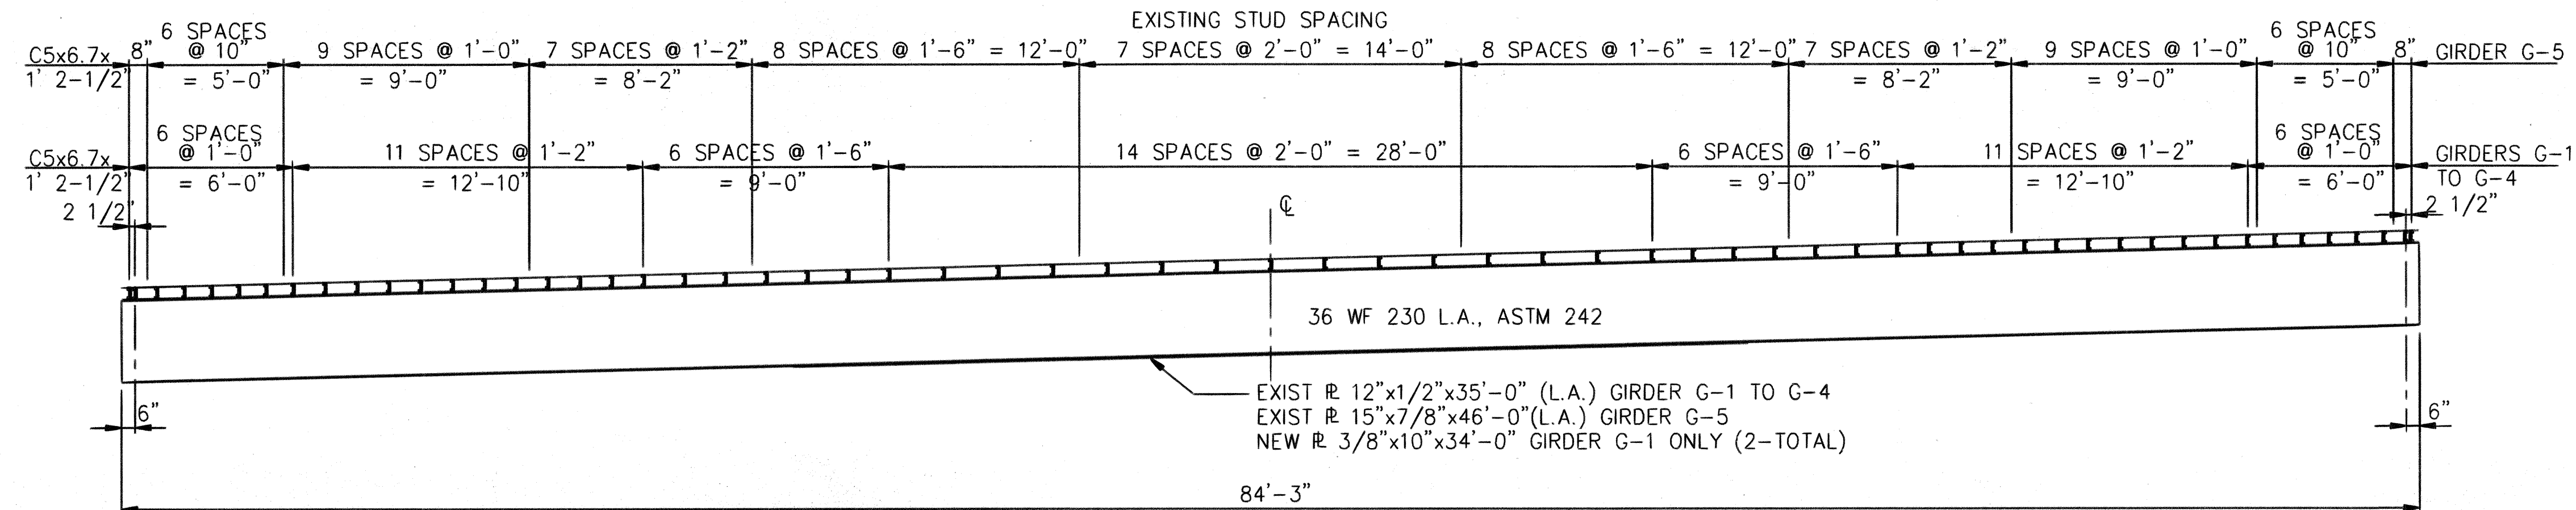


EXIST. GIRDER G-1 TO G-5
SCALE: 1/4" = 1'-0"

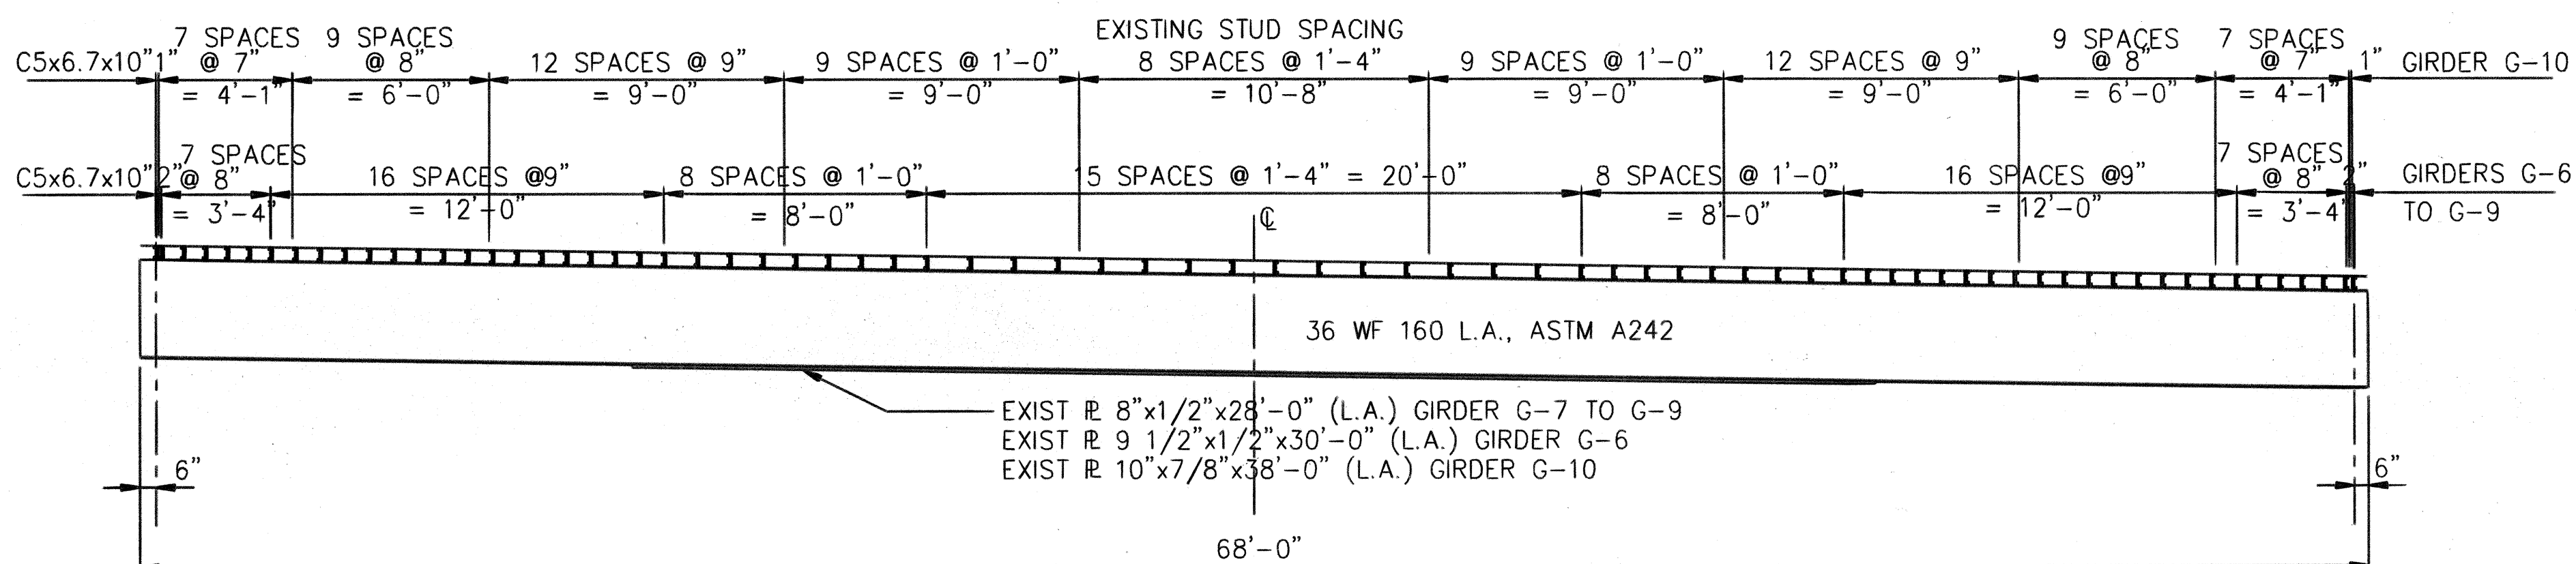


EXIST. GIRDER G-6 TO G-10
SCALE: 1/4" = 1'-0"

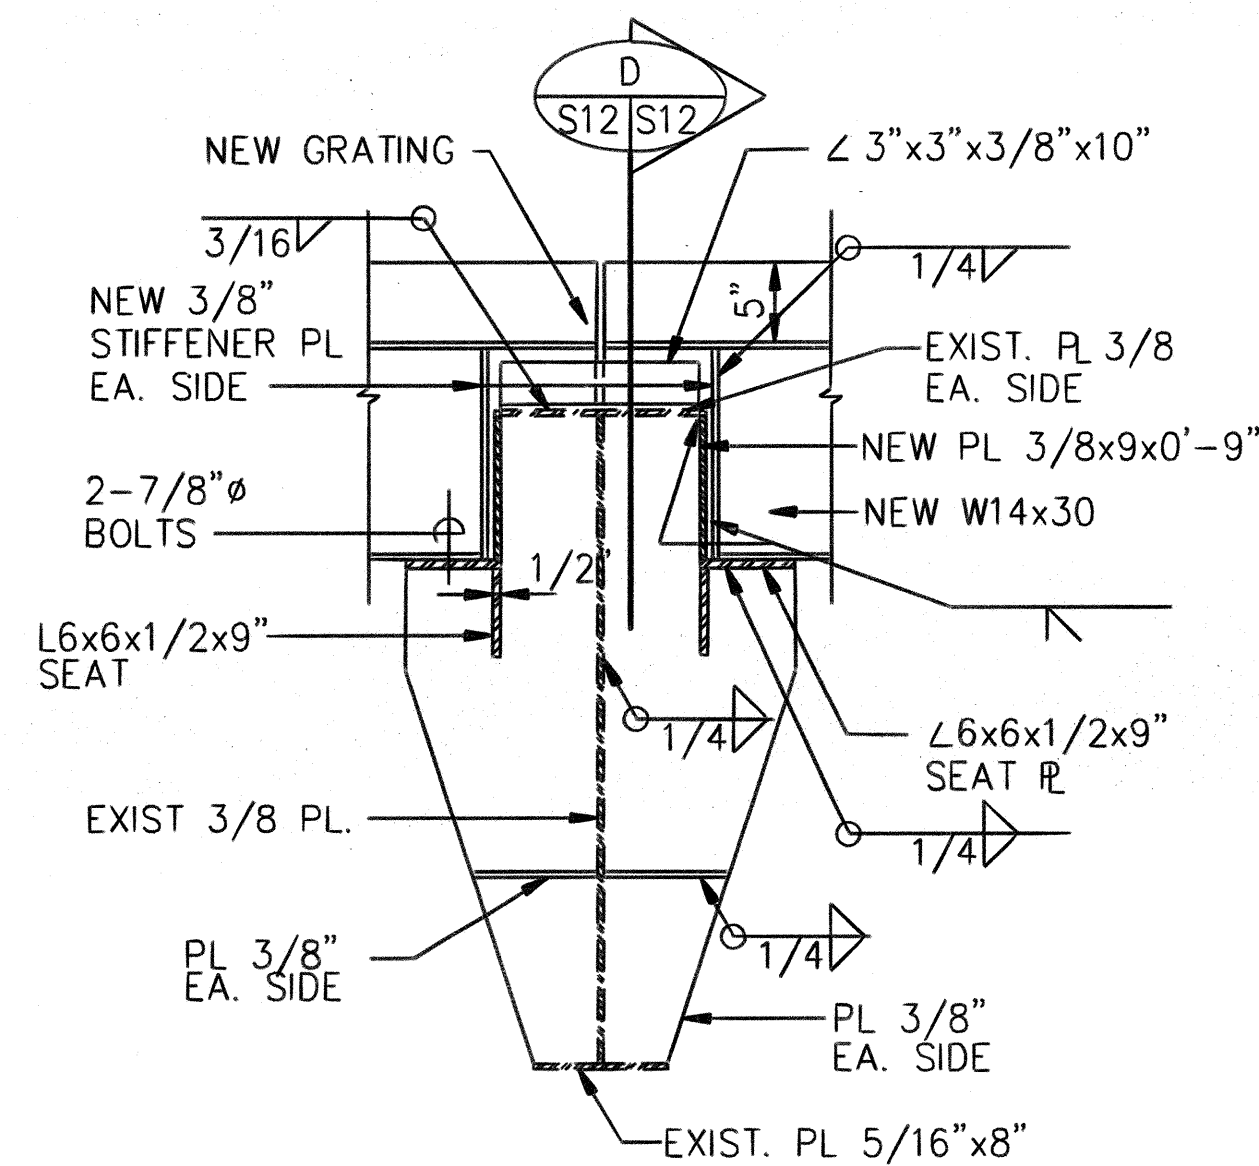


SECTION C
SCALE: 1" = 1'-0"

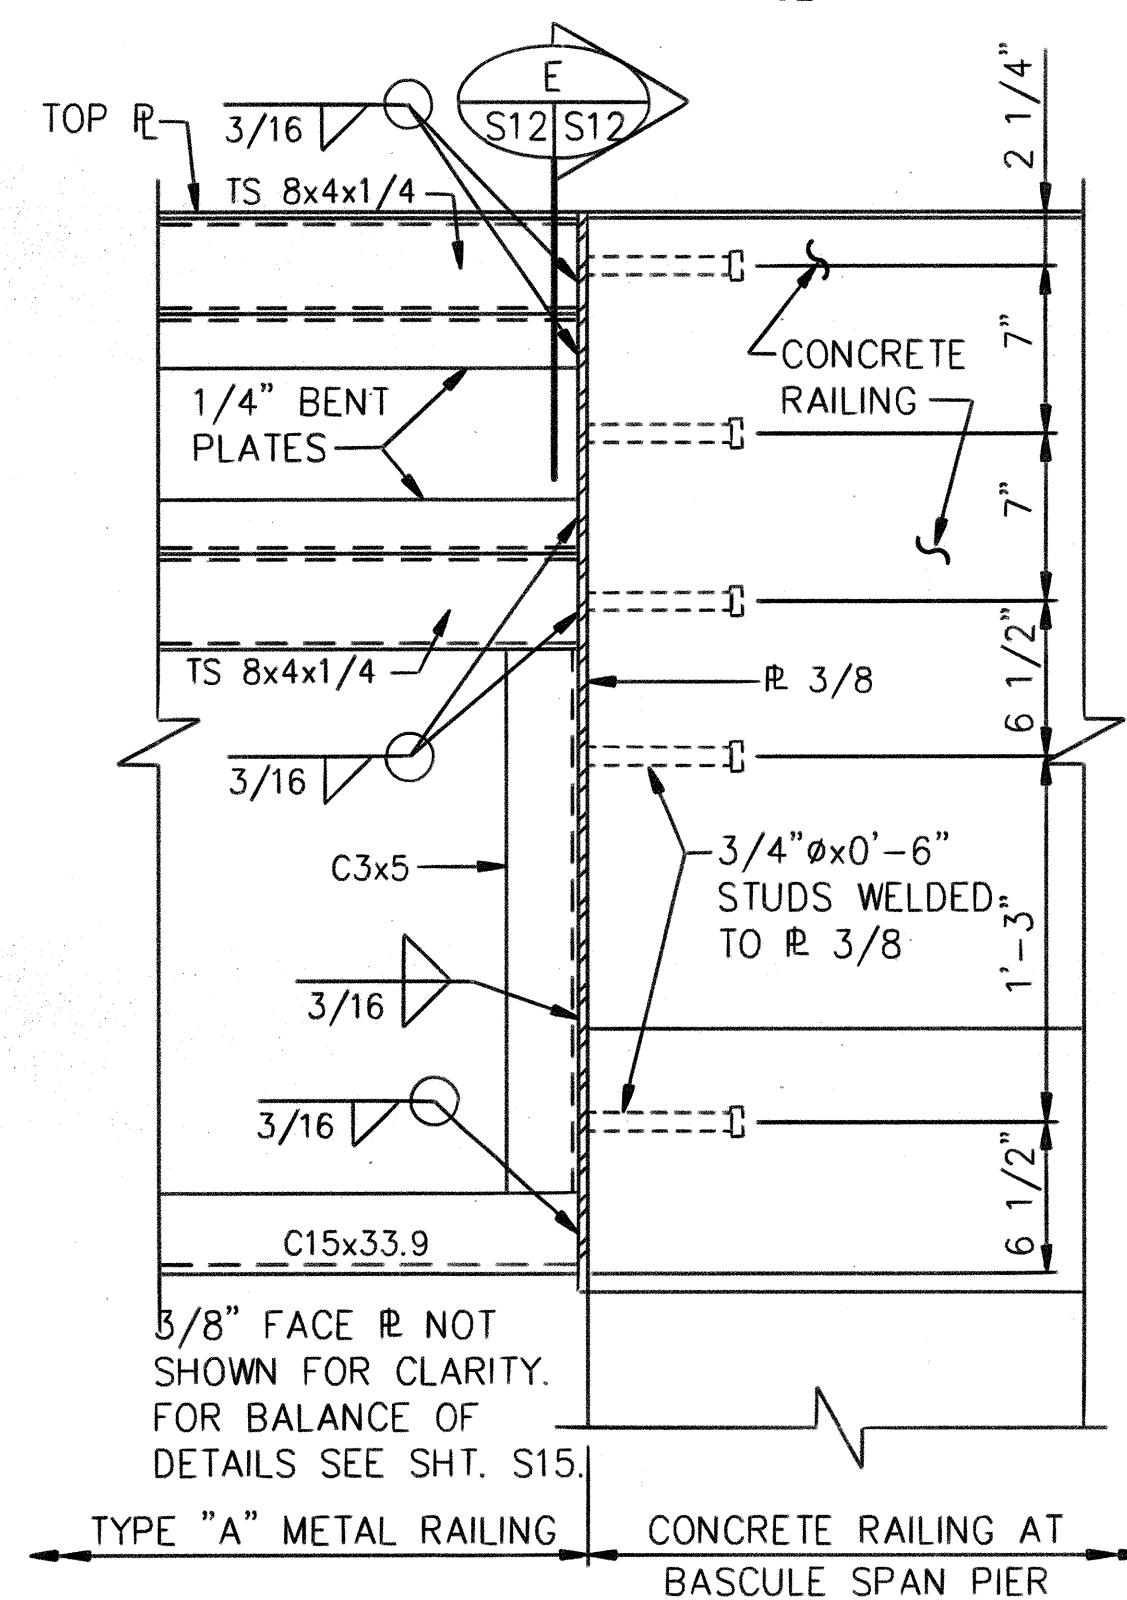

SECTION D
SCALE: 1 1/2" = 1'-0"

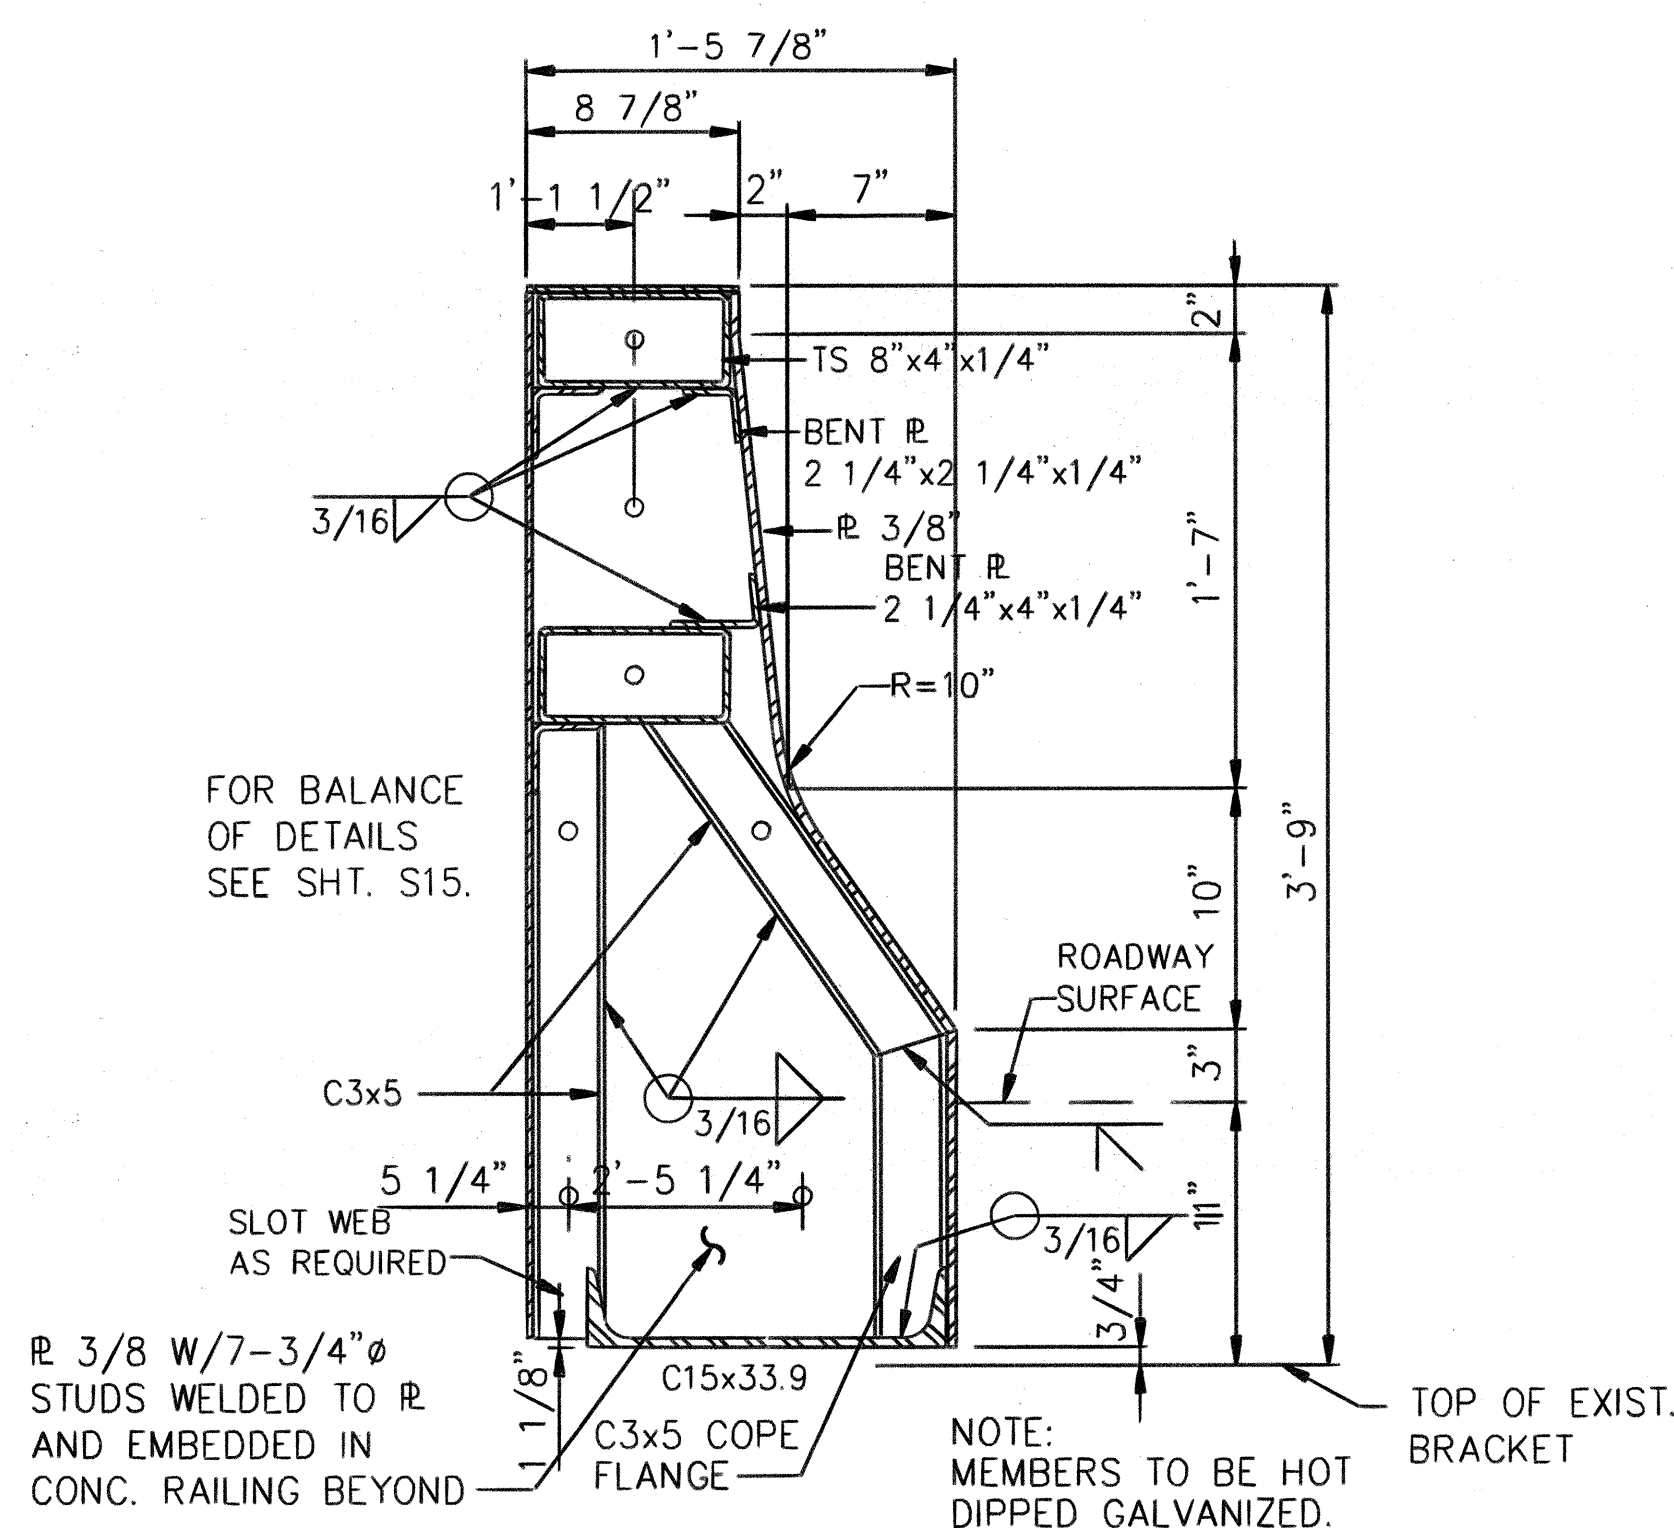

SECTION E
SCALE: 1 1/2" = 1'-0"

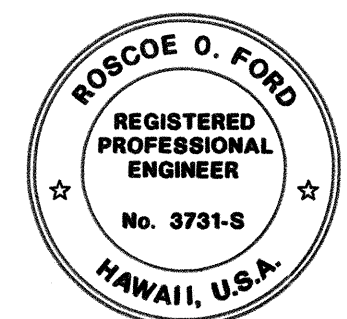

THIS WORK WAS PREPARED BY ME OR UNDER MY SUPERVISION



Roscoe O. Ford

STATE OF HAWAII
DEPARTMENT OF TRANSPORTATION
HIGHWAYS DIVISION
**APPROACH SPAN GIRDER
ELEVATIONS AND SECTIONS**

SAND ISLAND BASCULE BRIDGE
REHABILITATION PHASE II
PROJECT NO. BR-064-1(3)
SCALE: AS NOTED DATE: AUG. 15, 1991
SHEET No. S12 OF S21 SHEETS

DATE REVISION


FED. ROAD DIST. NO.	STATE	FED. AID PROJ. NO.	FISCAL YEAR	SHEET NO.	TOTAL SHEETS
HAWAII	HAW.	BR-064-1(3)	1991	20	38

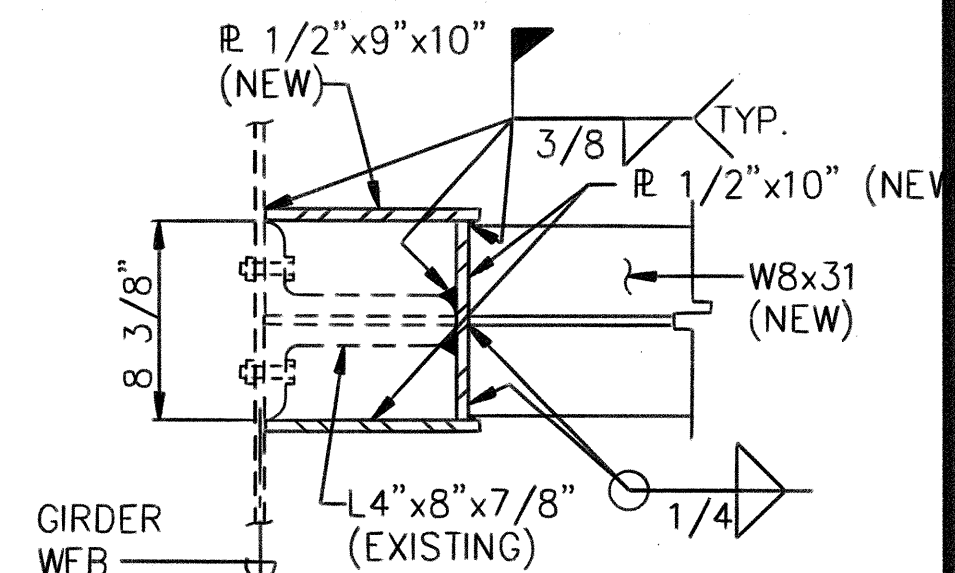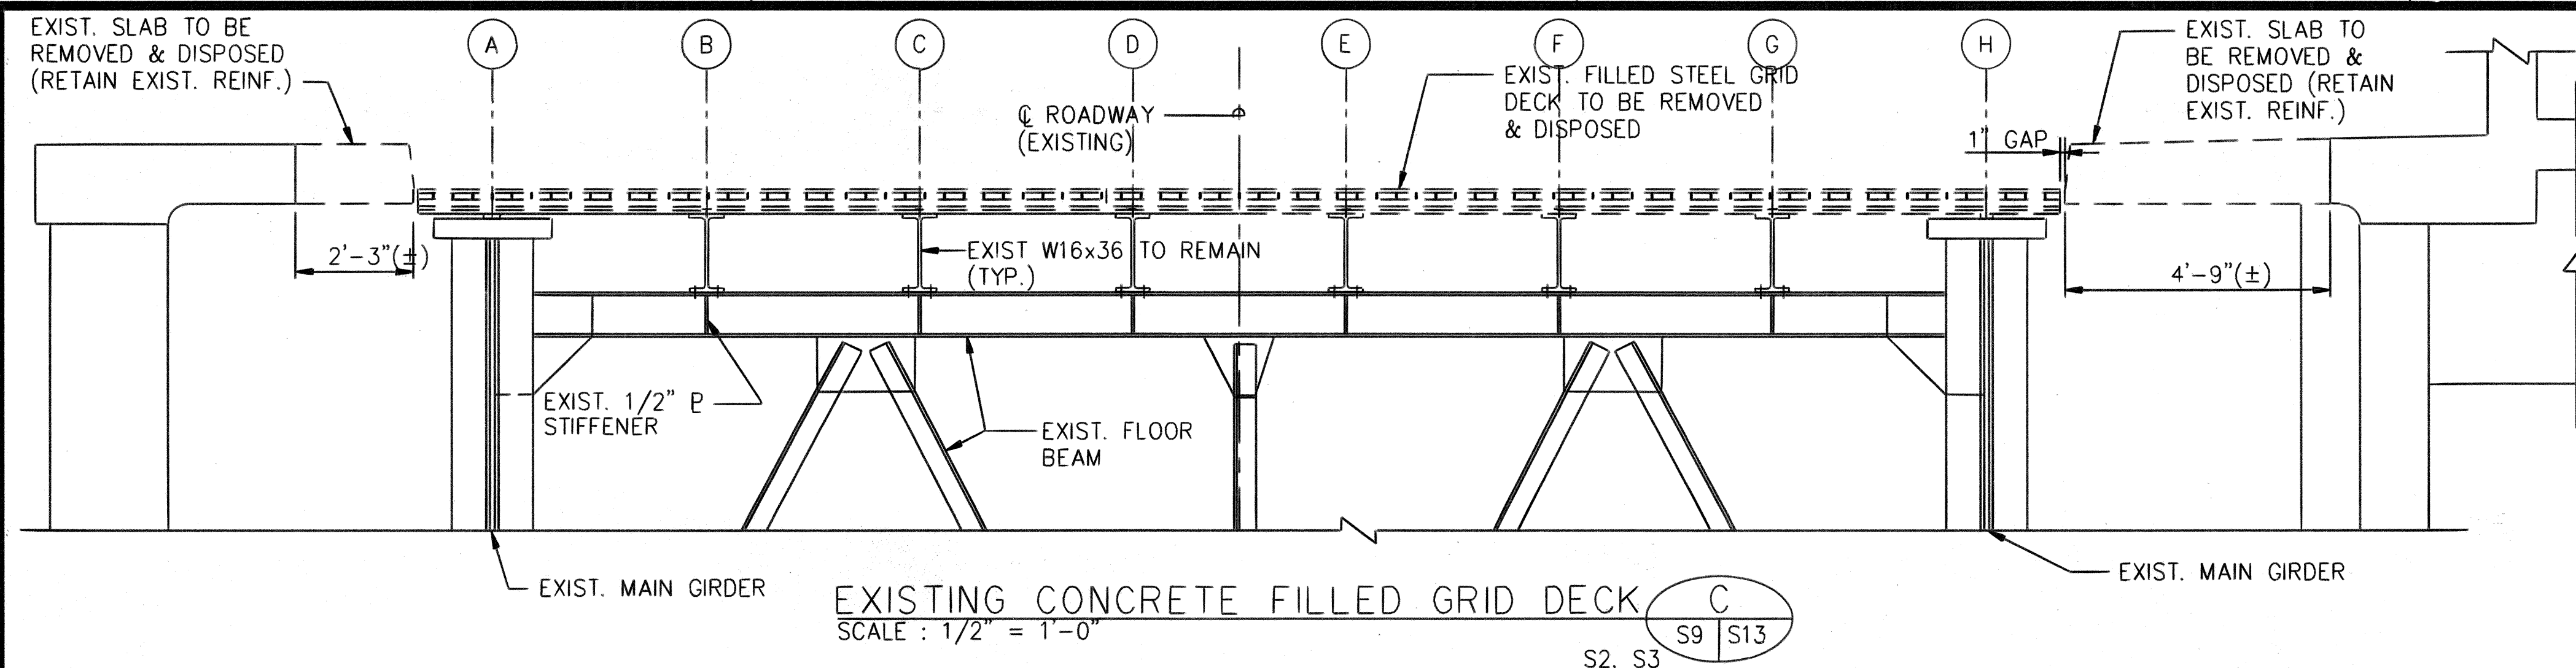


PLAN - SECTION B
SCALE : 1 1/2" = 1'-0" S13 | S13

NOTES:


1. REMOVE PORTION OF EXISTING
PIER. RETAIN REINFORCING
TO BEND INTO NEW CONC.
GUARD RAIL.

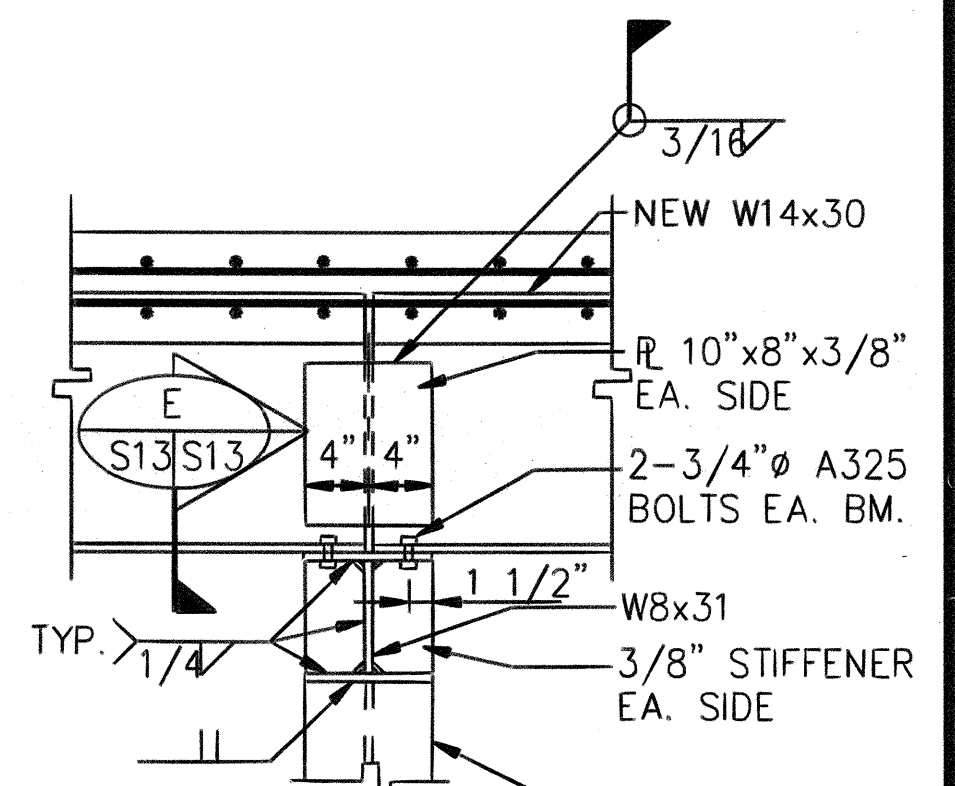

SECTION D
SCALE : 1" = 1'-0" S13 | S13

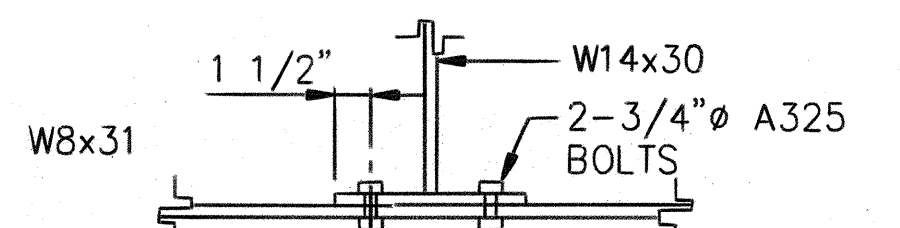

SECTION E
SCALE : 1 1/2" = 1'-0" S13 | S13

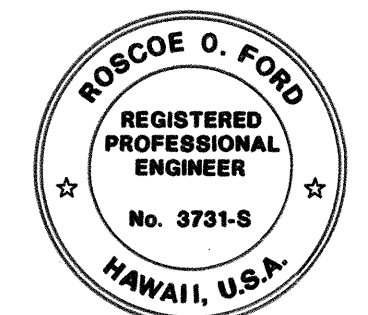

THIS WORK WAS PREPARED BY
ME OR UNDER MY SUPERVISION

Roscoe C. Ford

STATE OF HAWAII
DEPARTMENT OF TRANSPORTATION
HIGHWAYS DIVISION
SECTIONS

SAND ISLAND BASCULE BRIDGE
REHABILITATION PHASE II
PROJECT NO. BR-064-I(3)

SCALE: AS NOTED DATE: AUG. 15, 1991

SHEET No. S13 OF S21 SHEETS

DATE	REVISION
------	----------

SHEET No. S13 OF S21 SHEETS

20

NOTE:
EXISTING MEMBERS
INDICATED WITH
DASHED LINES.





SECTION
SCALE : 1/2" = 1'-0"

A
S9 | S13
S7

C.C.O. No. 3
For Details, See
Plan Sht. No. 205-1.

ORIGINAL PLAN	SURVEY PLOTTED BY _____	DATE _____
NOTEBOOK	DRAWN BY _____	" _____
	TRACED BY _____	" _____
	DESIGNED BY _____	" _____
	QUANTITIES BY _____	" _____
	CHECKED BY _____	" _____
No. _____		

FED. ROAD DIST. NO.	STATE	FED. AID PROJ. NO.	FISCAL YEAR	SHEET NO.	TOTAL SHEETS
HAWAII	HAW.	BR-004-1(3)	1991	205-1	38

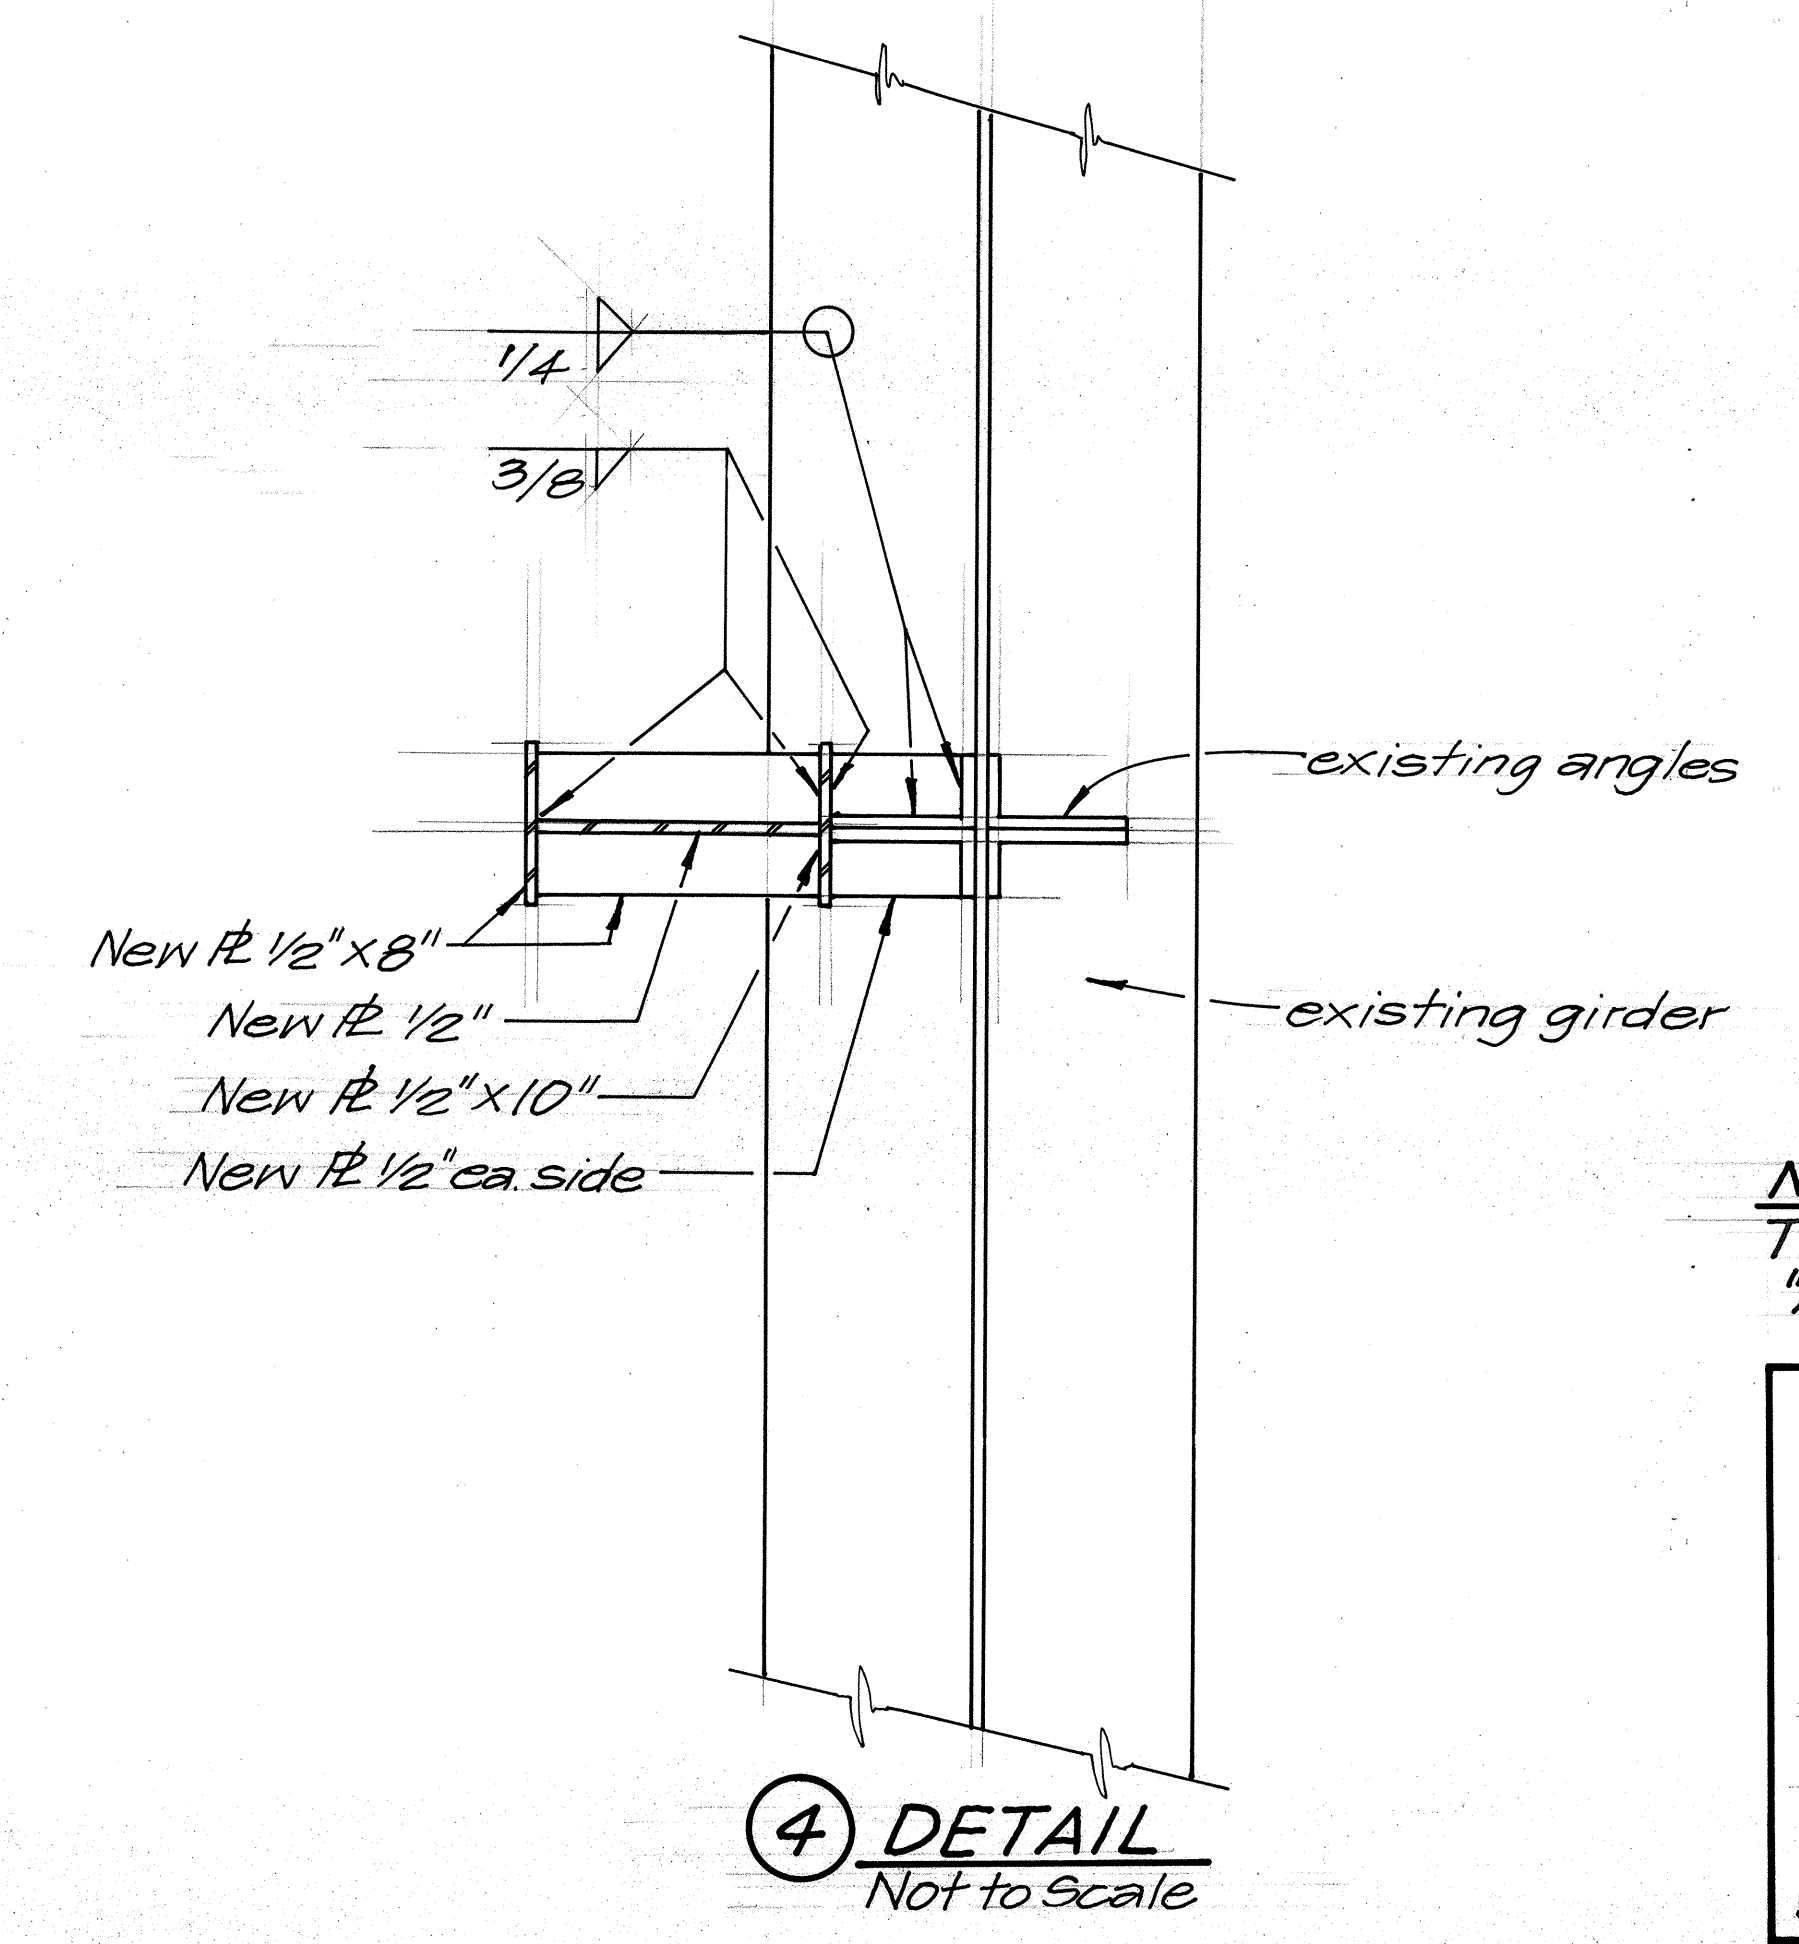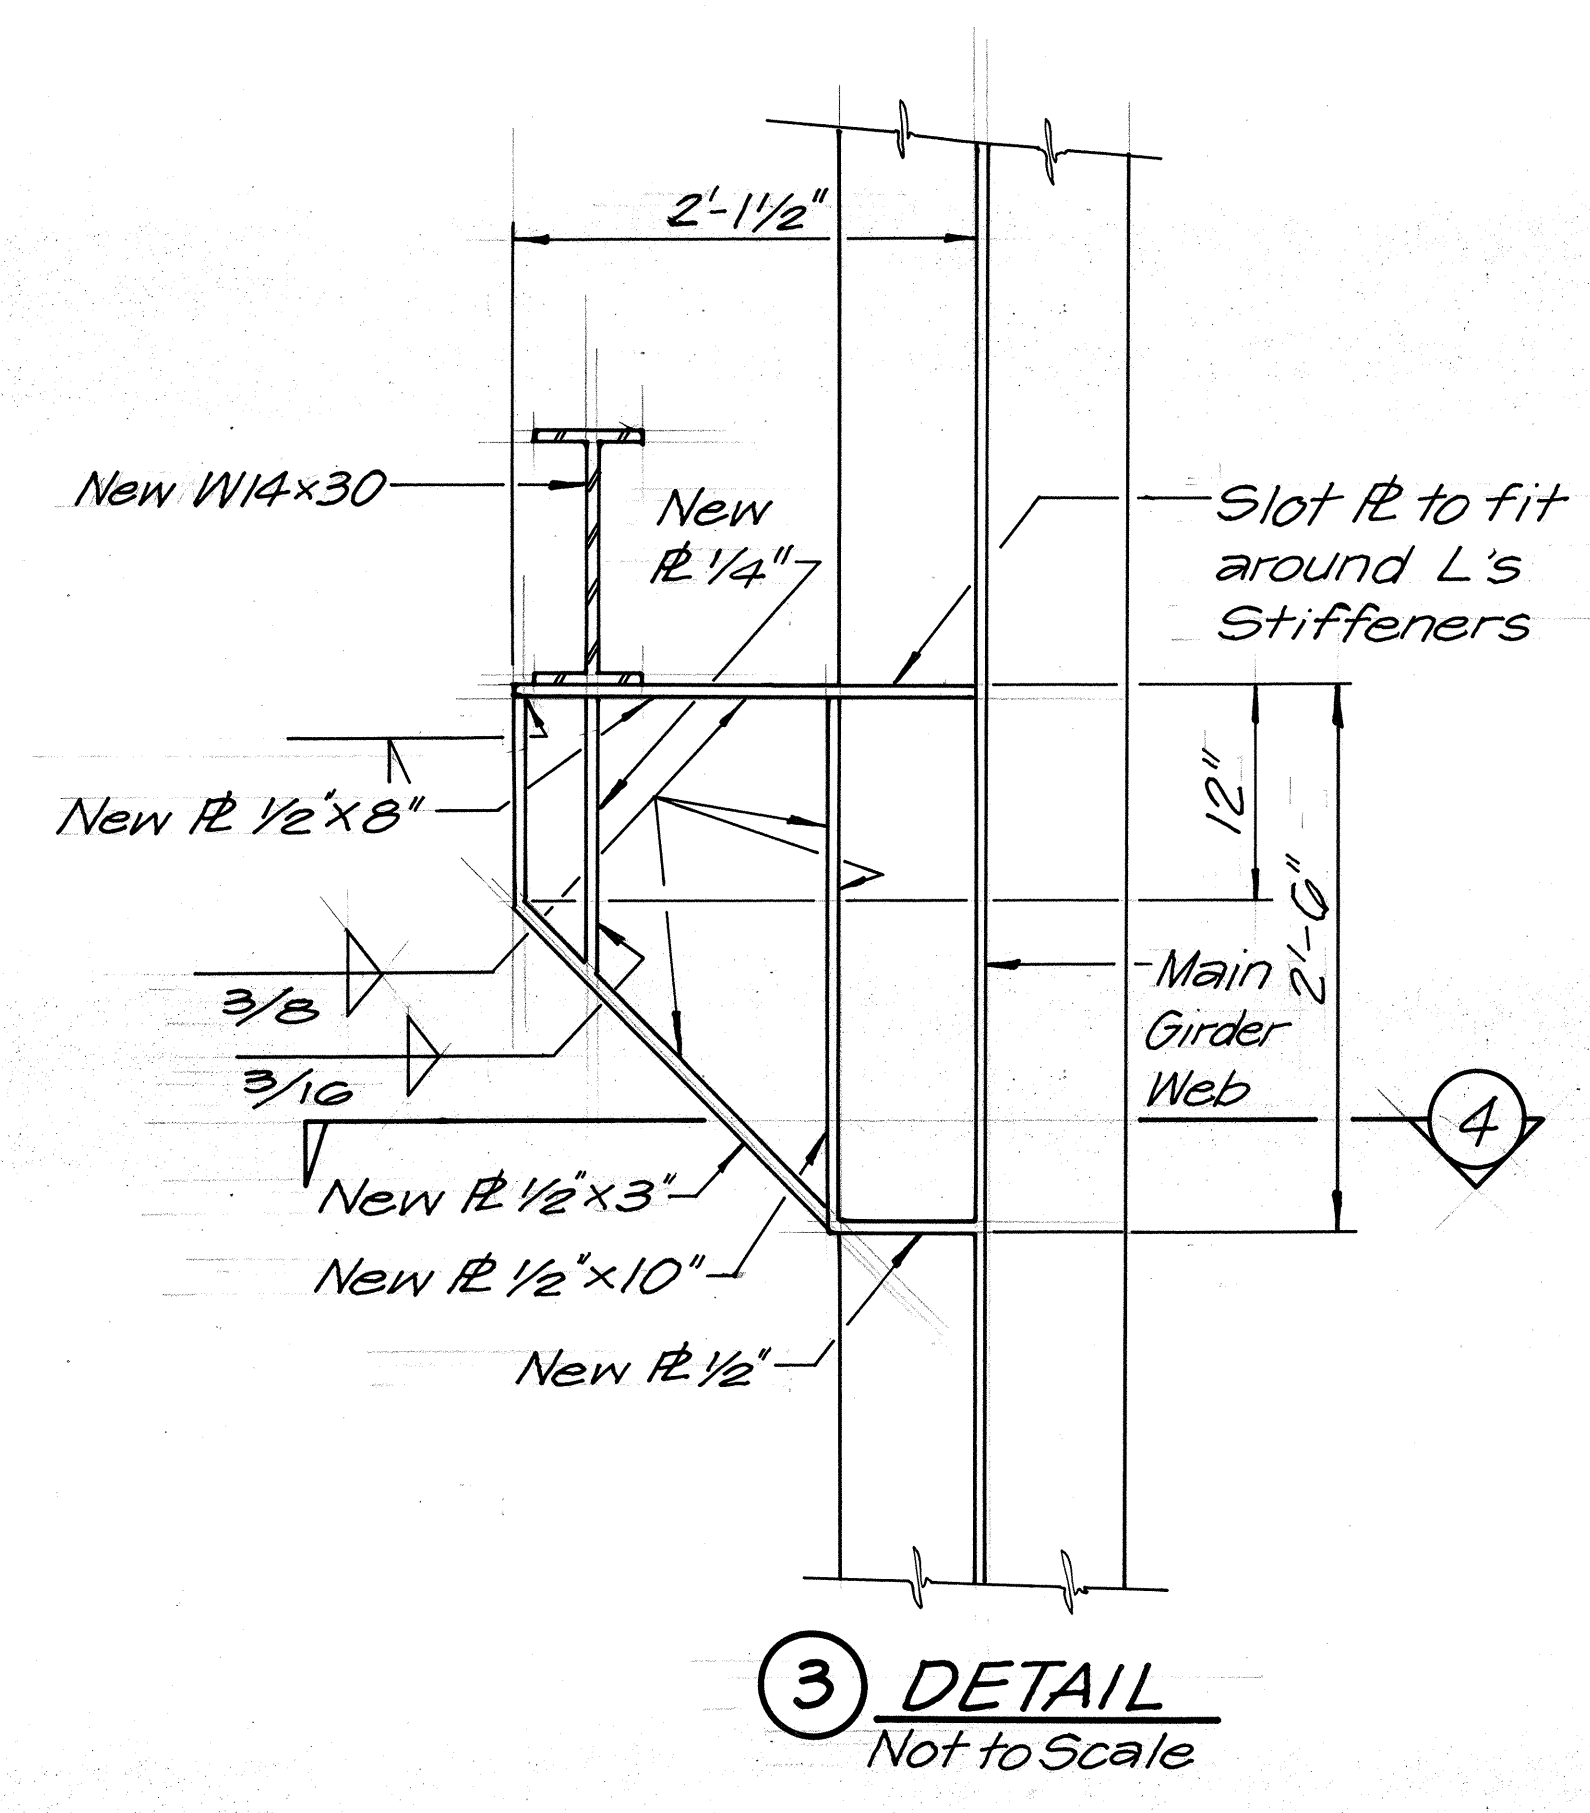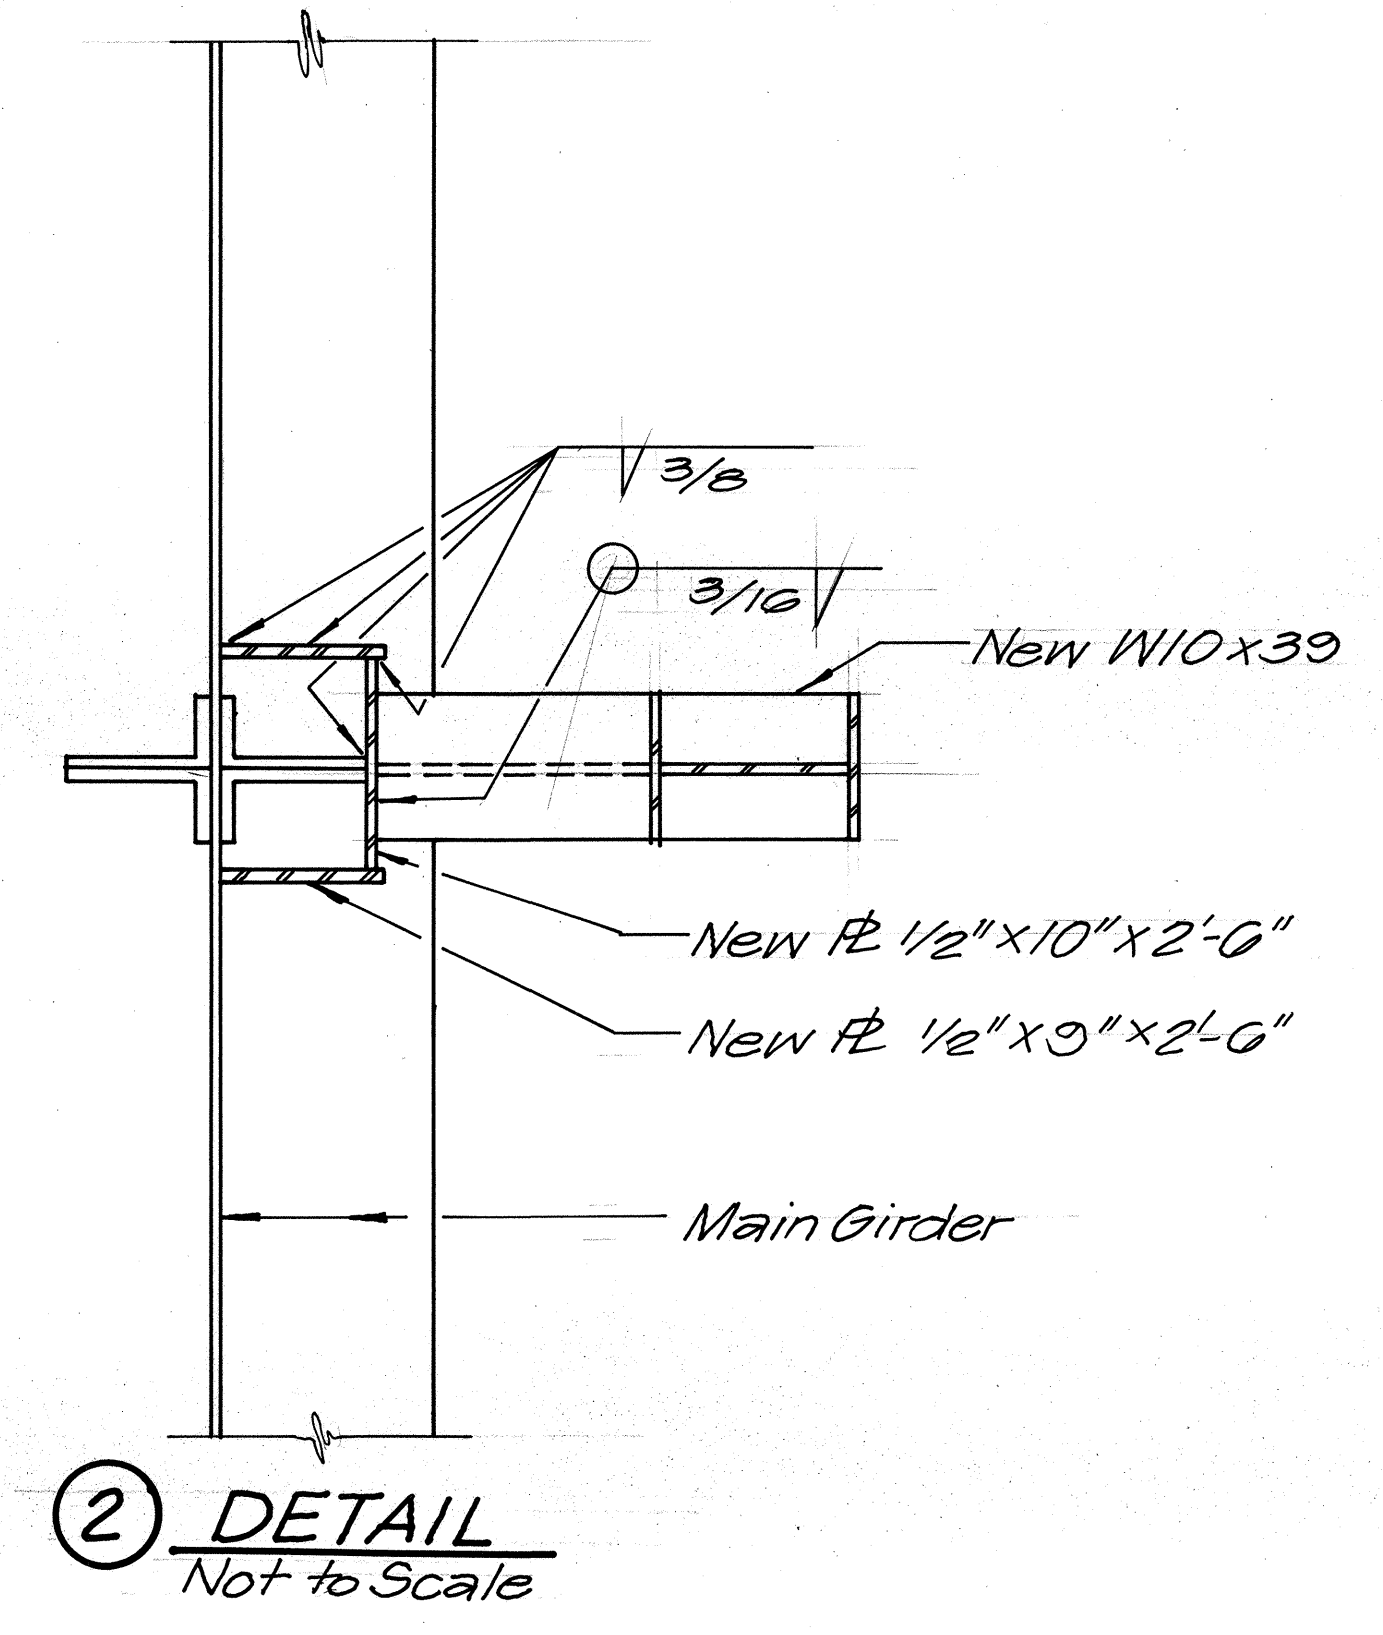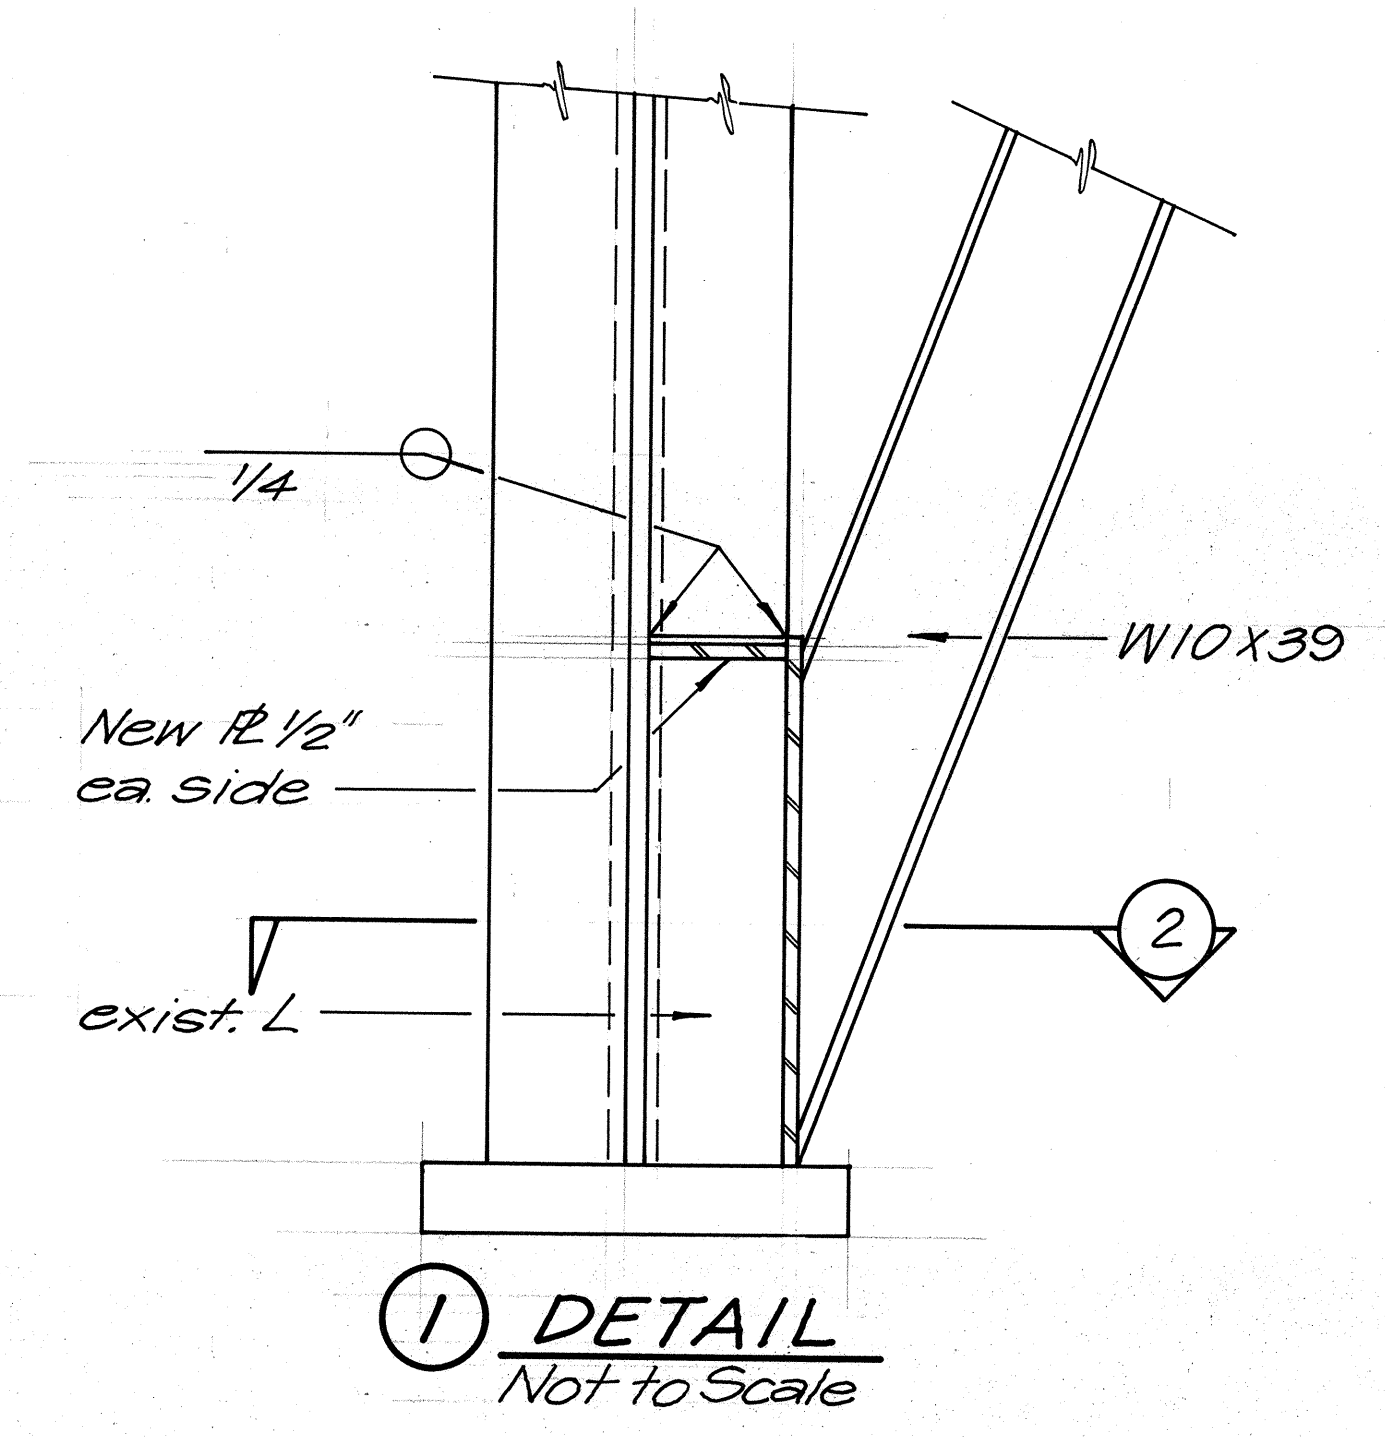

NOTE:
This tracing prepared during
"As-Built" posting.

STATE OF HAWAII
DEPARTMENT OF TRANSPORTATION
HIGHWAYS DIVISION


DETAILS

SAND ISLAND BASCULE BRIDGE
REHABILITATION PHASE II
PROJECT NO. BR-004-1(3)
Scale: As Noted Date: Feb, 1990

SHEET No. 1 OF 1 SHEETS

ORIGINAL PLAN	SURVEY PLOTTED BY	DATE
NOTE BOOK	DRAWN BY	
	DESIGNED BY	
	QUANTITIES BY	
	CHECKED BY	

FED. ROAD DIST. NO.	STATE	FED. AID PROJ. NO.	FISCAL YEAR	SHEET NO.	TOTAL SHEETS
HAWAII	HAW.	BR-064-1(3)	1991	22	38

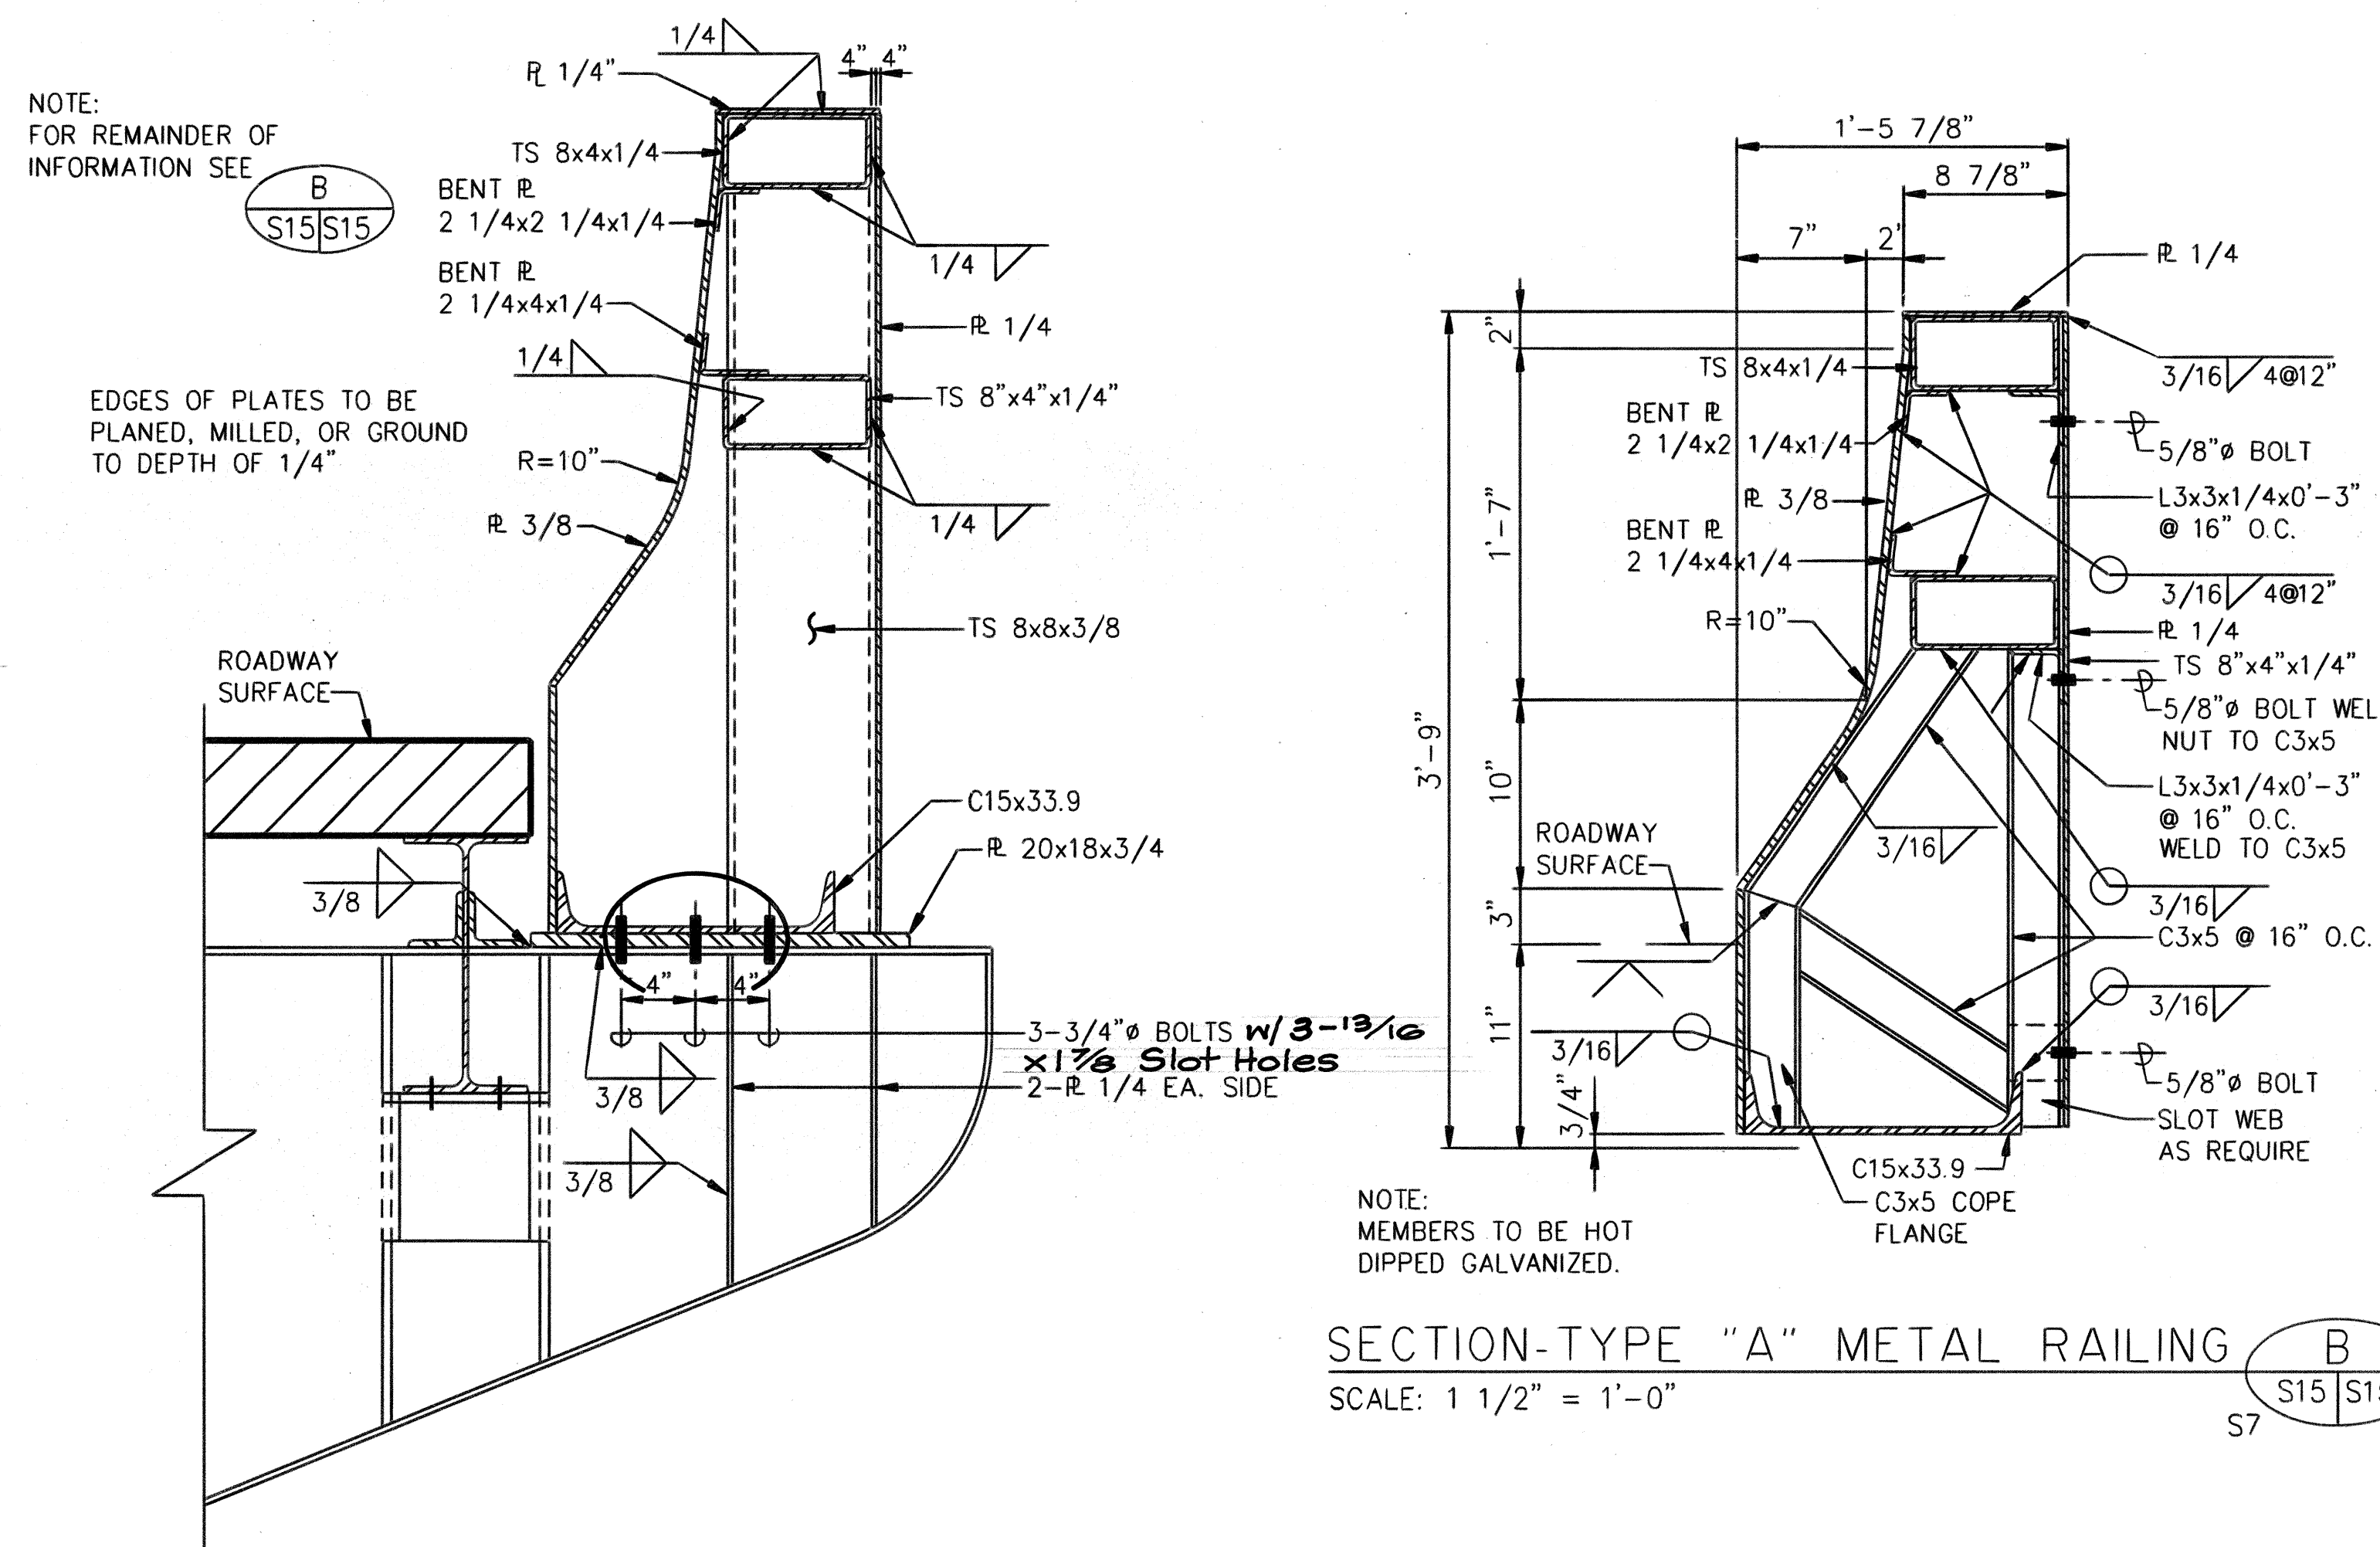


SECTION-TYPE "A" METAL RAILING

SCALE: 1 1/2" = 1'-0"


67

B

S15 S15

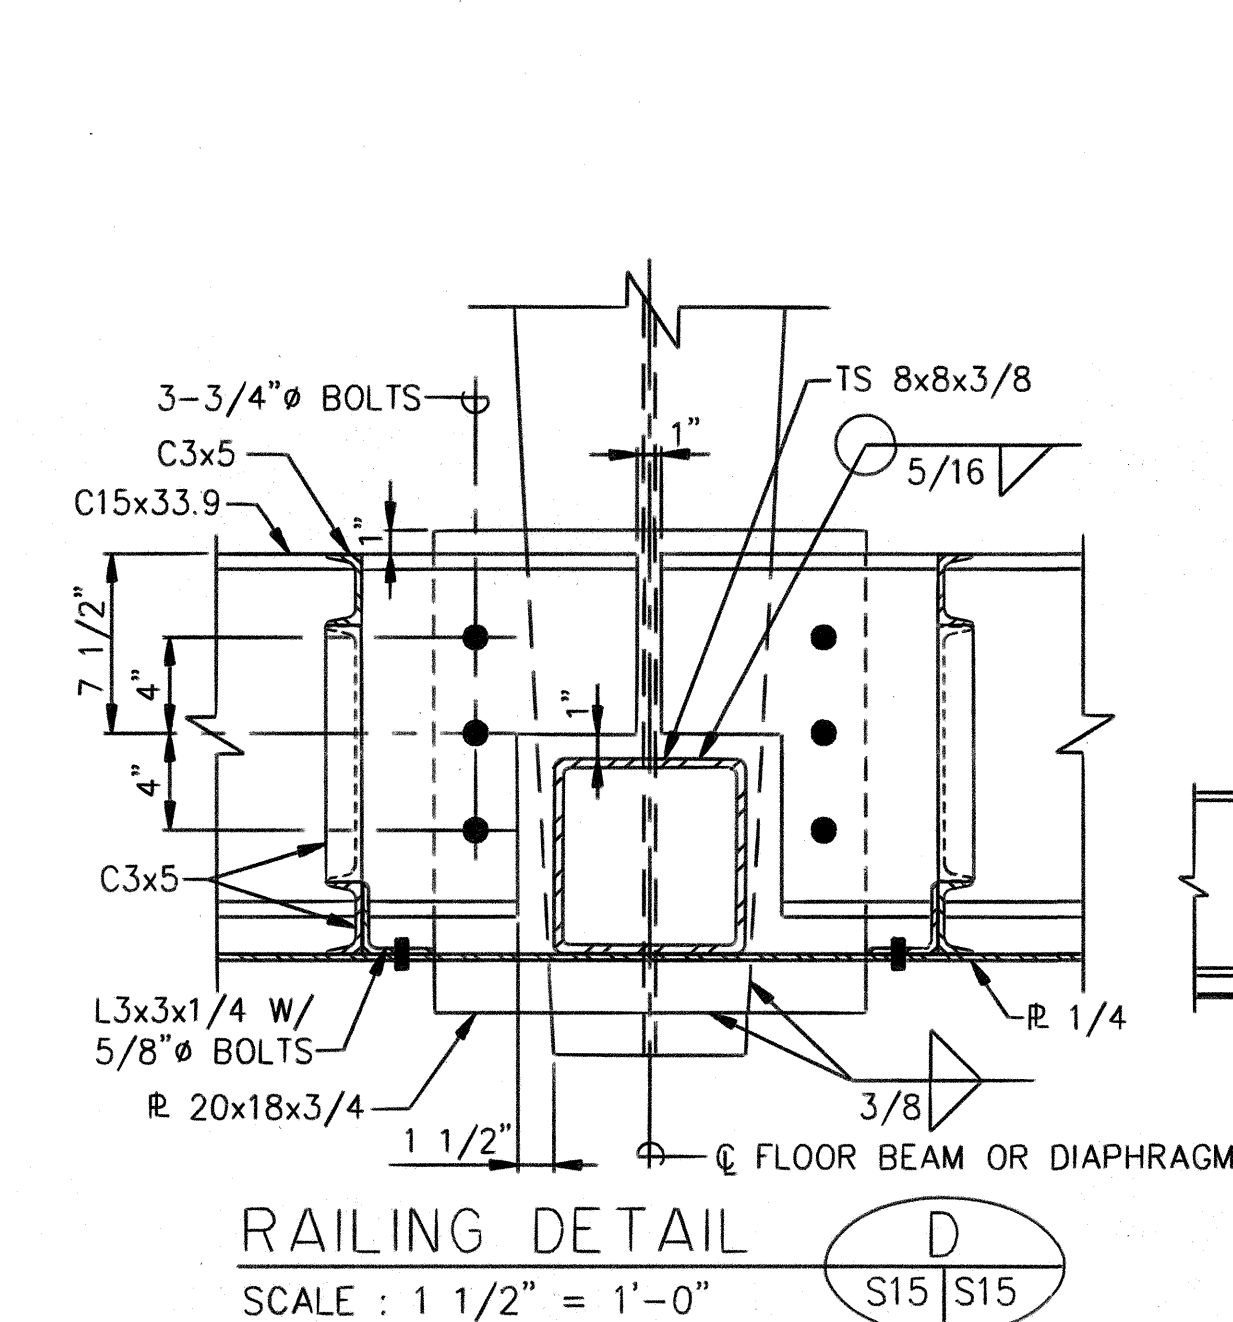

RAILING DETAIL

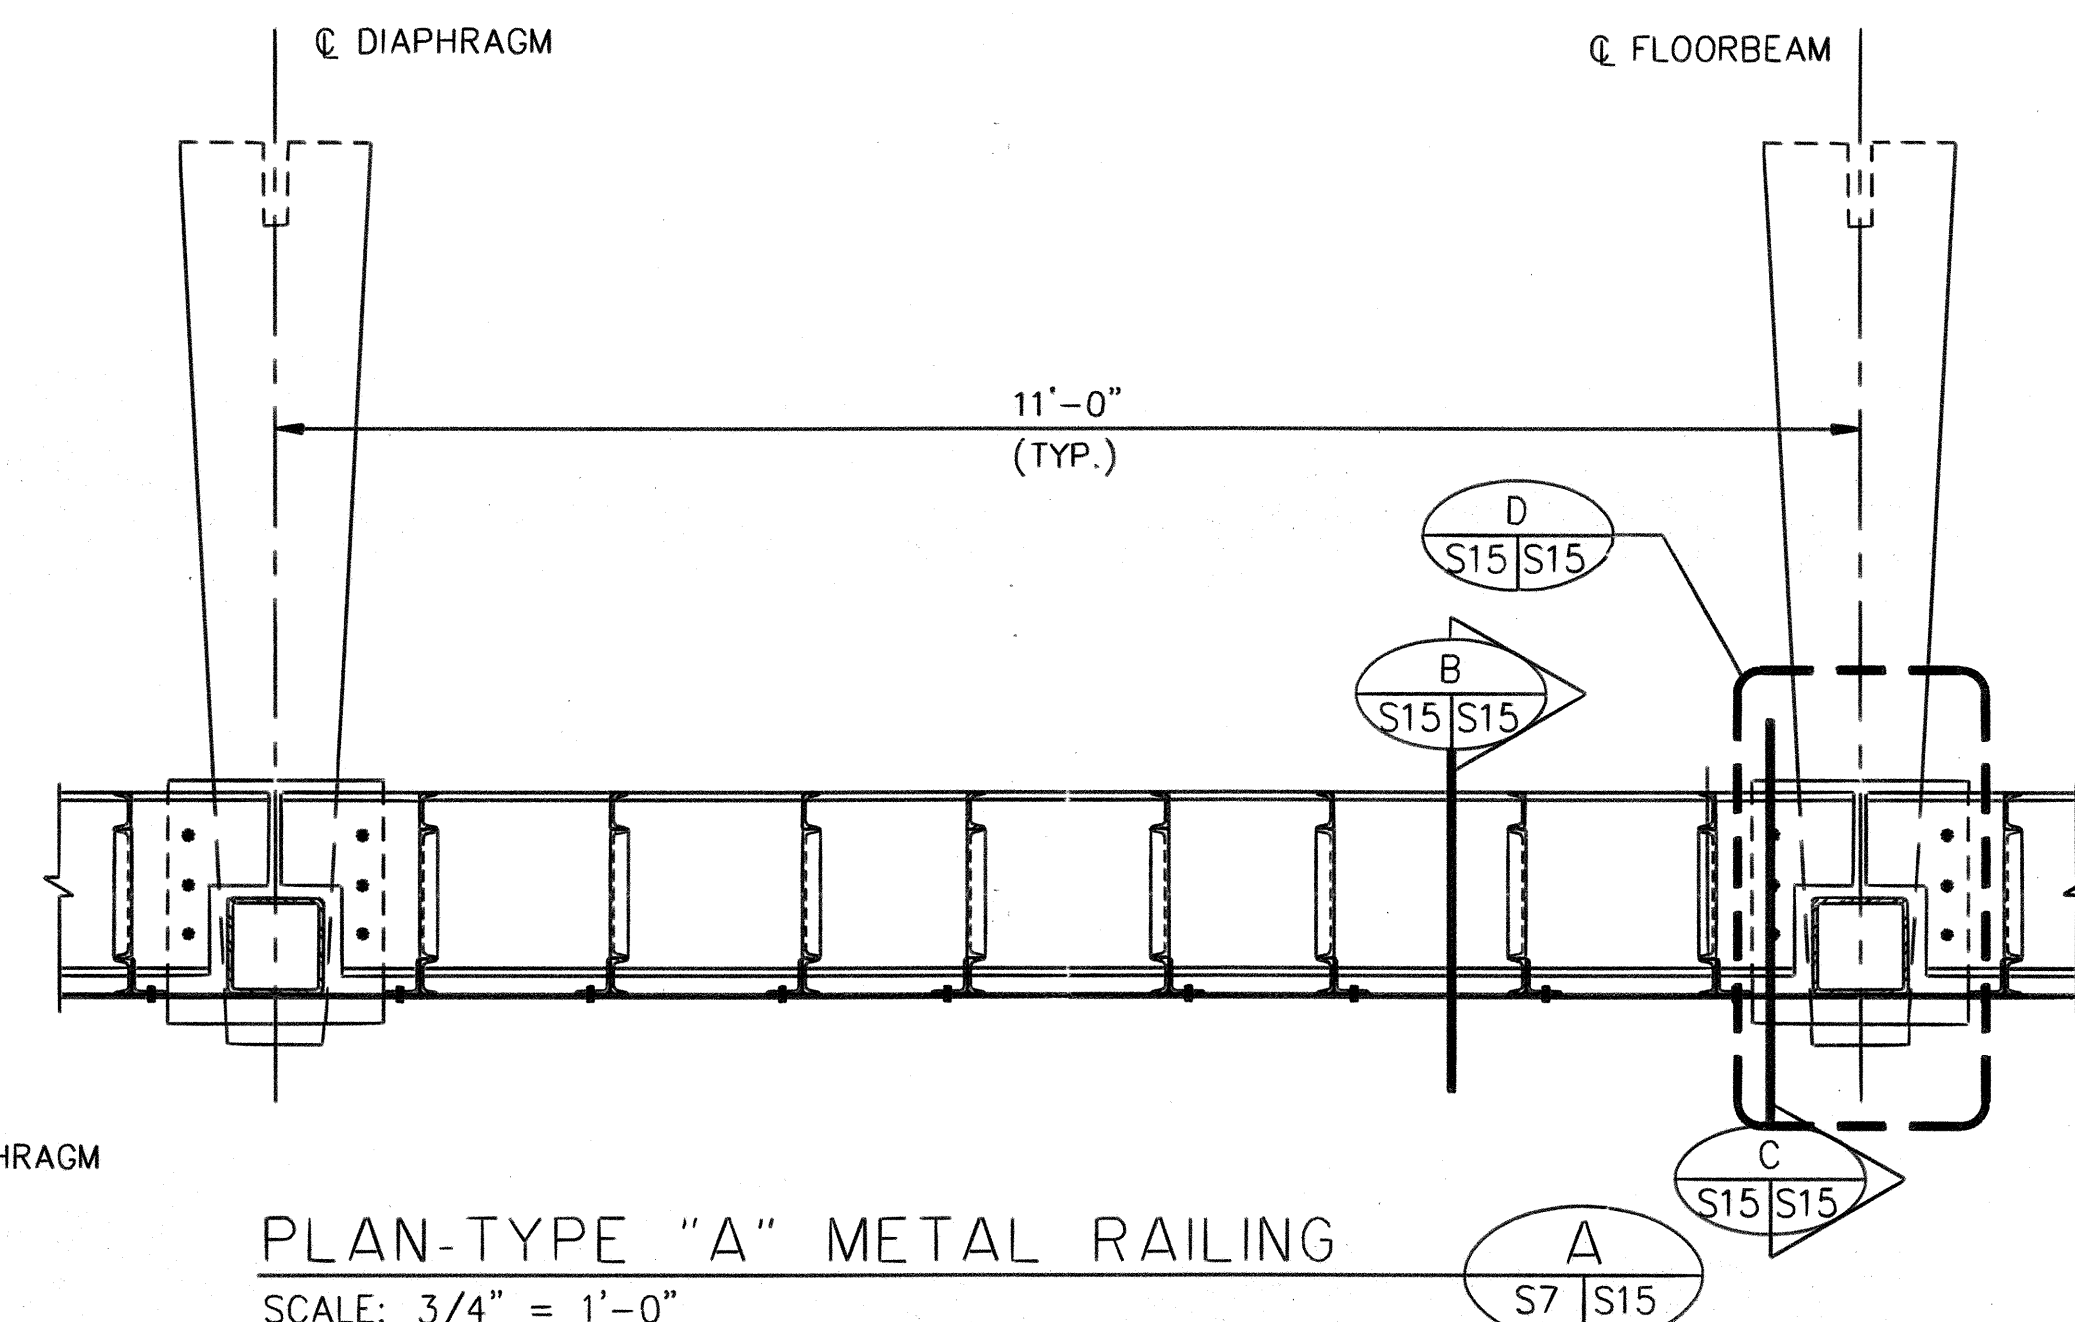

PLAN-TYPE "A" METAL RAILING

SCALE: 3/4" = 1'-0"

A


S7 | S15

SECTION AT POST-TYPE "A" METAL RAILING

SCALE: 1 1/2" = 1'-0"


S7

C
S15 | S15

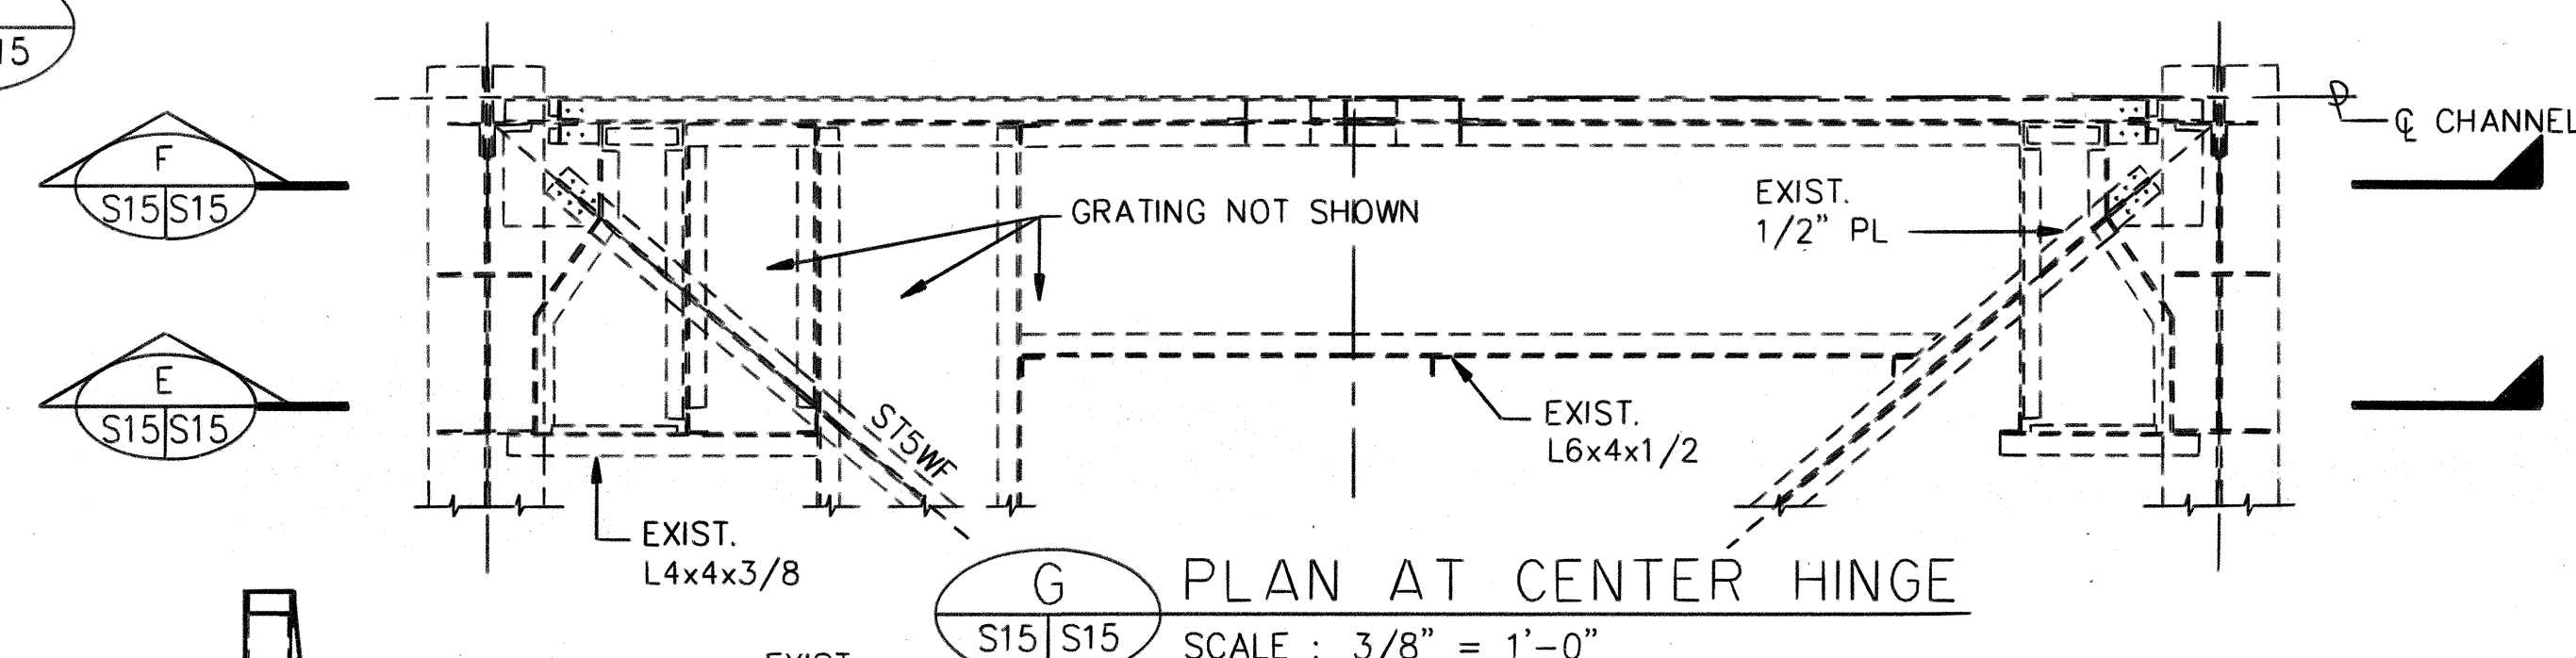

PLAN AT CENTER HINGE

SCALE : $3/8" = 1'-0"$

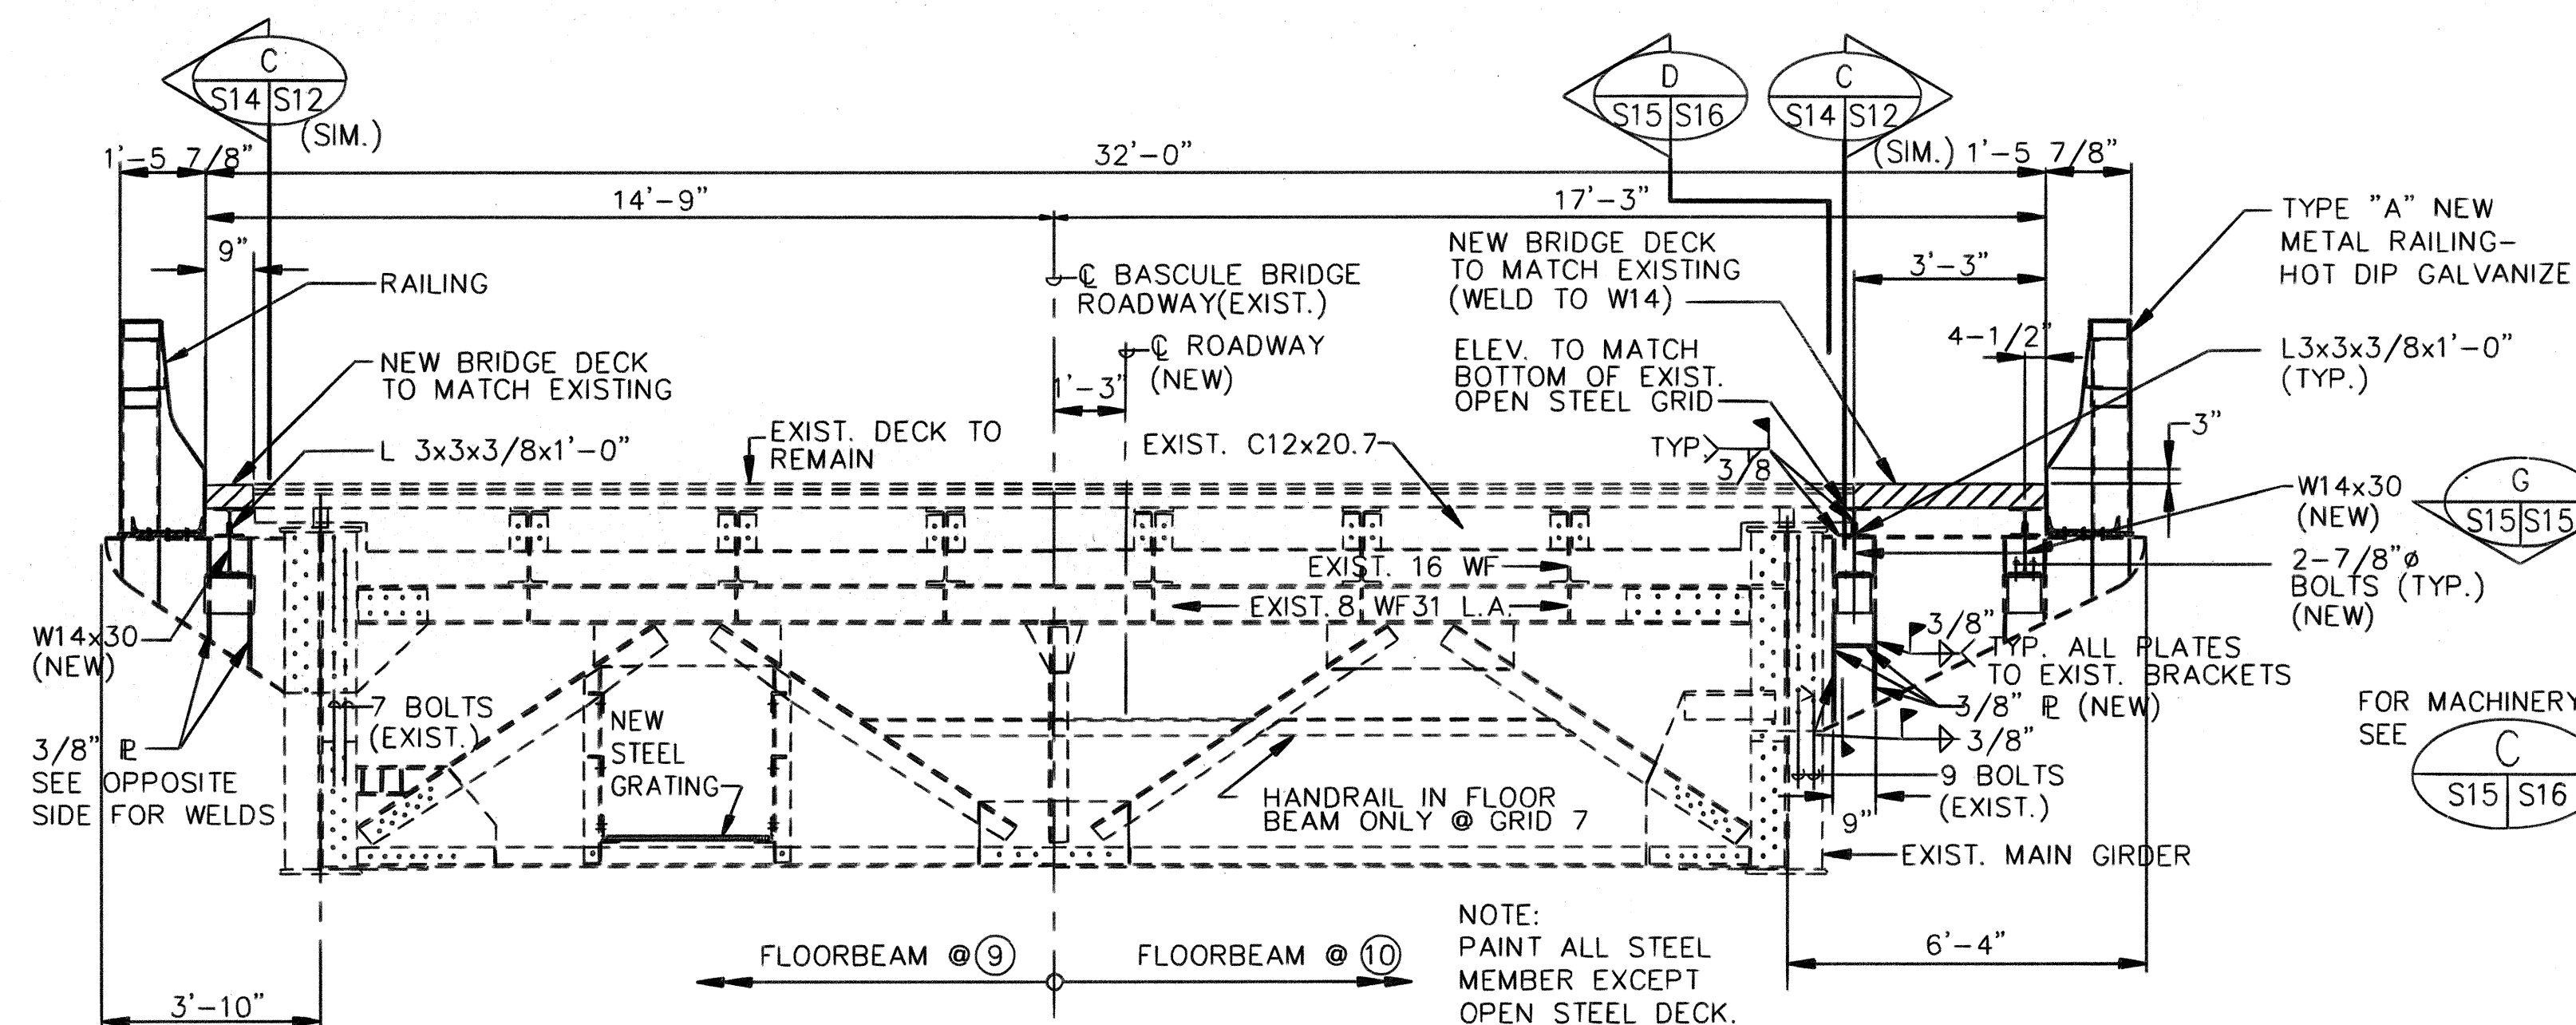


FINISHED CONDITION AT FLOOR BEAM

SCALE : $\frac{3}{8}'' = 1'-0''$

S2

F	
S15	S15

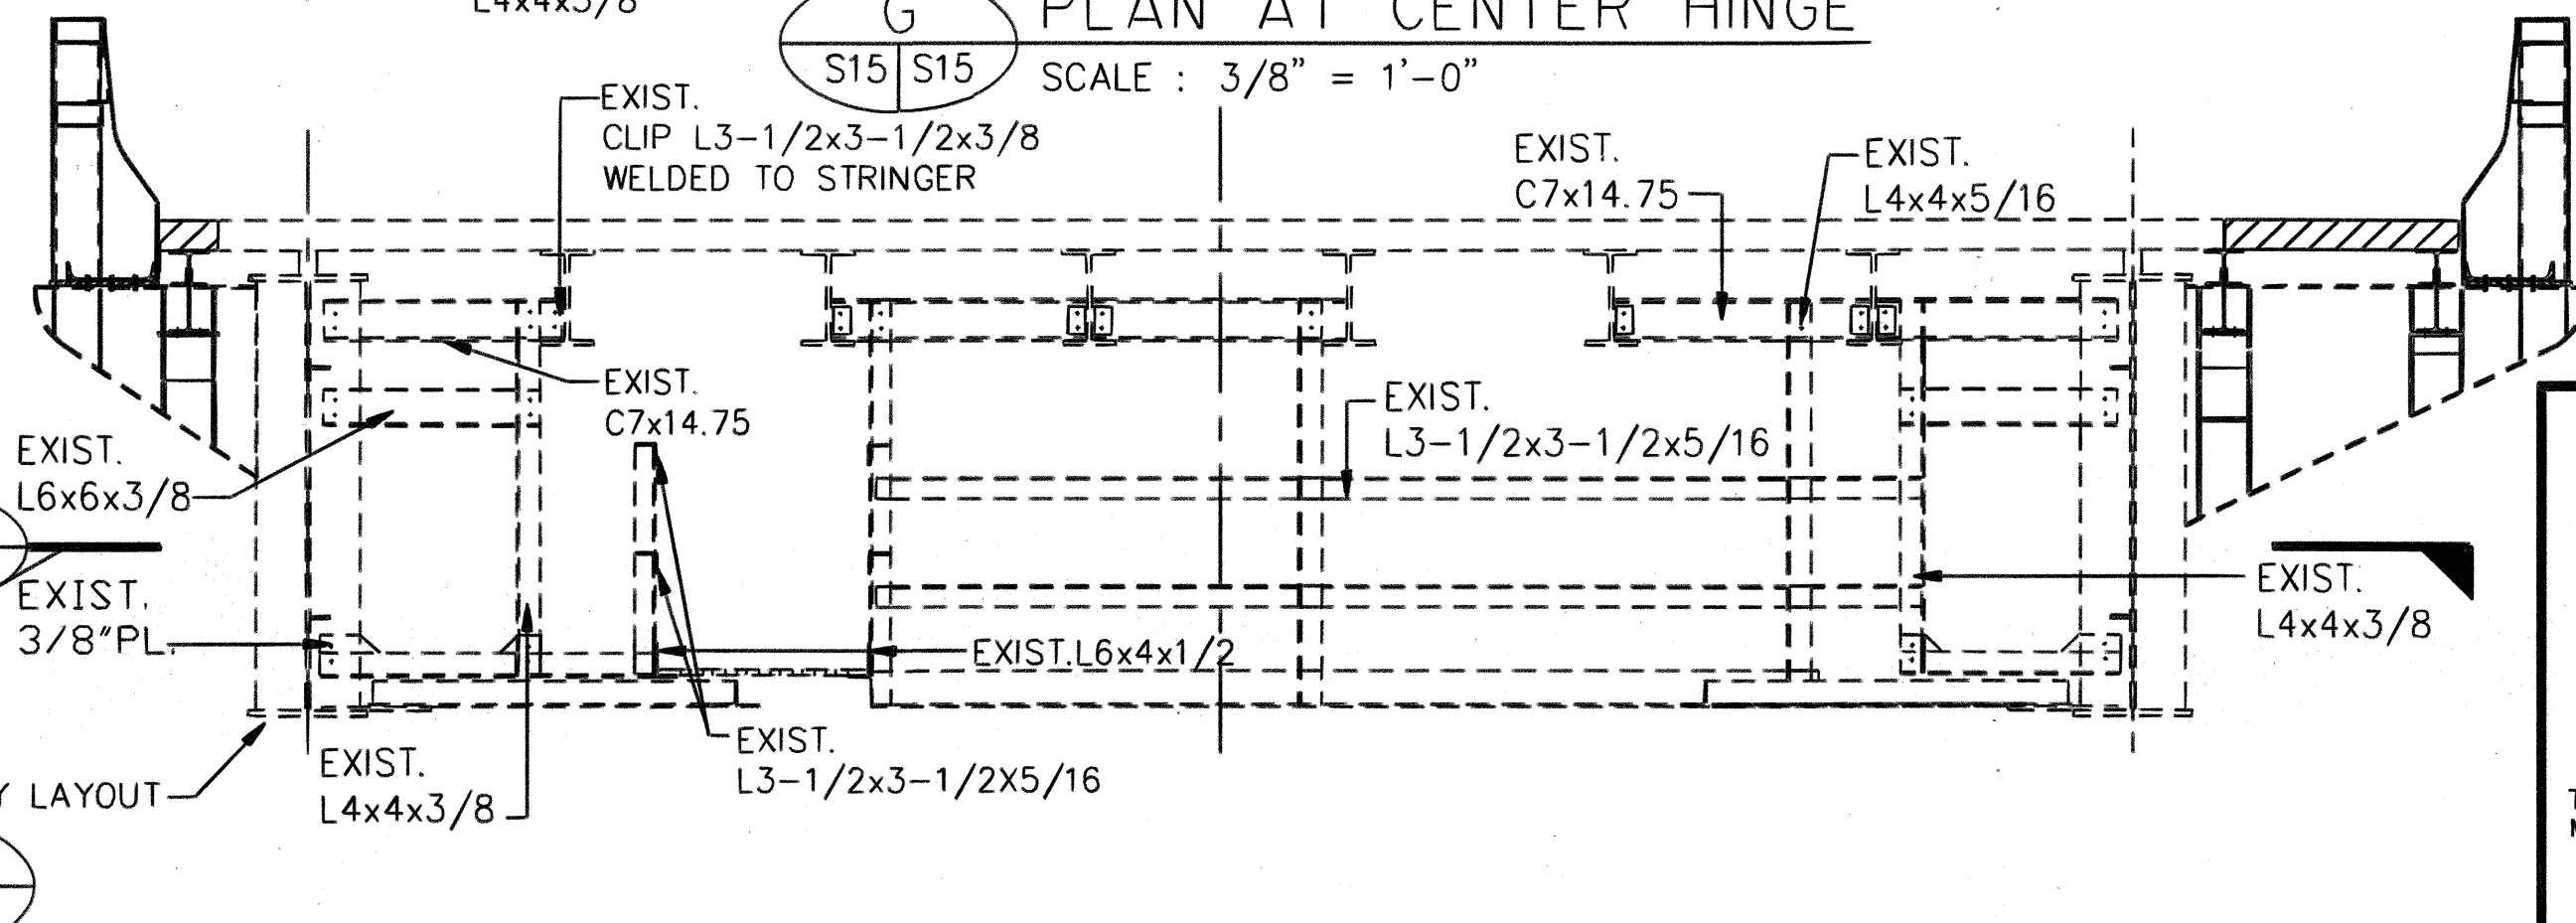

E SECTION
S15 | S15 SCALE : 3/8" = 1'-0"





THIS WORK WAS PREPARED BY
ME OR UNDER MY SUPERVISION

Roscoe O. Ford


STATE OF HAWAII
DEPARTMENT OF TRANSPORTATION
HIGHWAYS DIVISION
NEW METAL RAILING
AND CONNECTION DETAILS

SAND ISLAND BASCULE BRIDGE
REHABILITATION PHASE II
PROJECT NO. BR-064-[13]
SCALE: AS NOTED DATE: AUG. 15, 1991
SHEET No. S15 OF S21 SHEETS


FED. ROAD DIST. NO.	STATE	FED. AID PROJ. NO.	FISCAL YEAR	SHEET NO.	TOTAL SHEETS
HAWAII	HAW.	BR-064-1(3)	1991	23	38

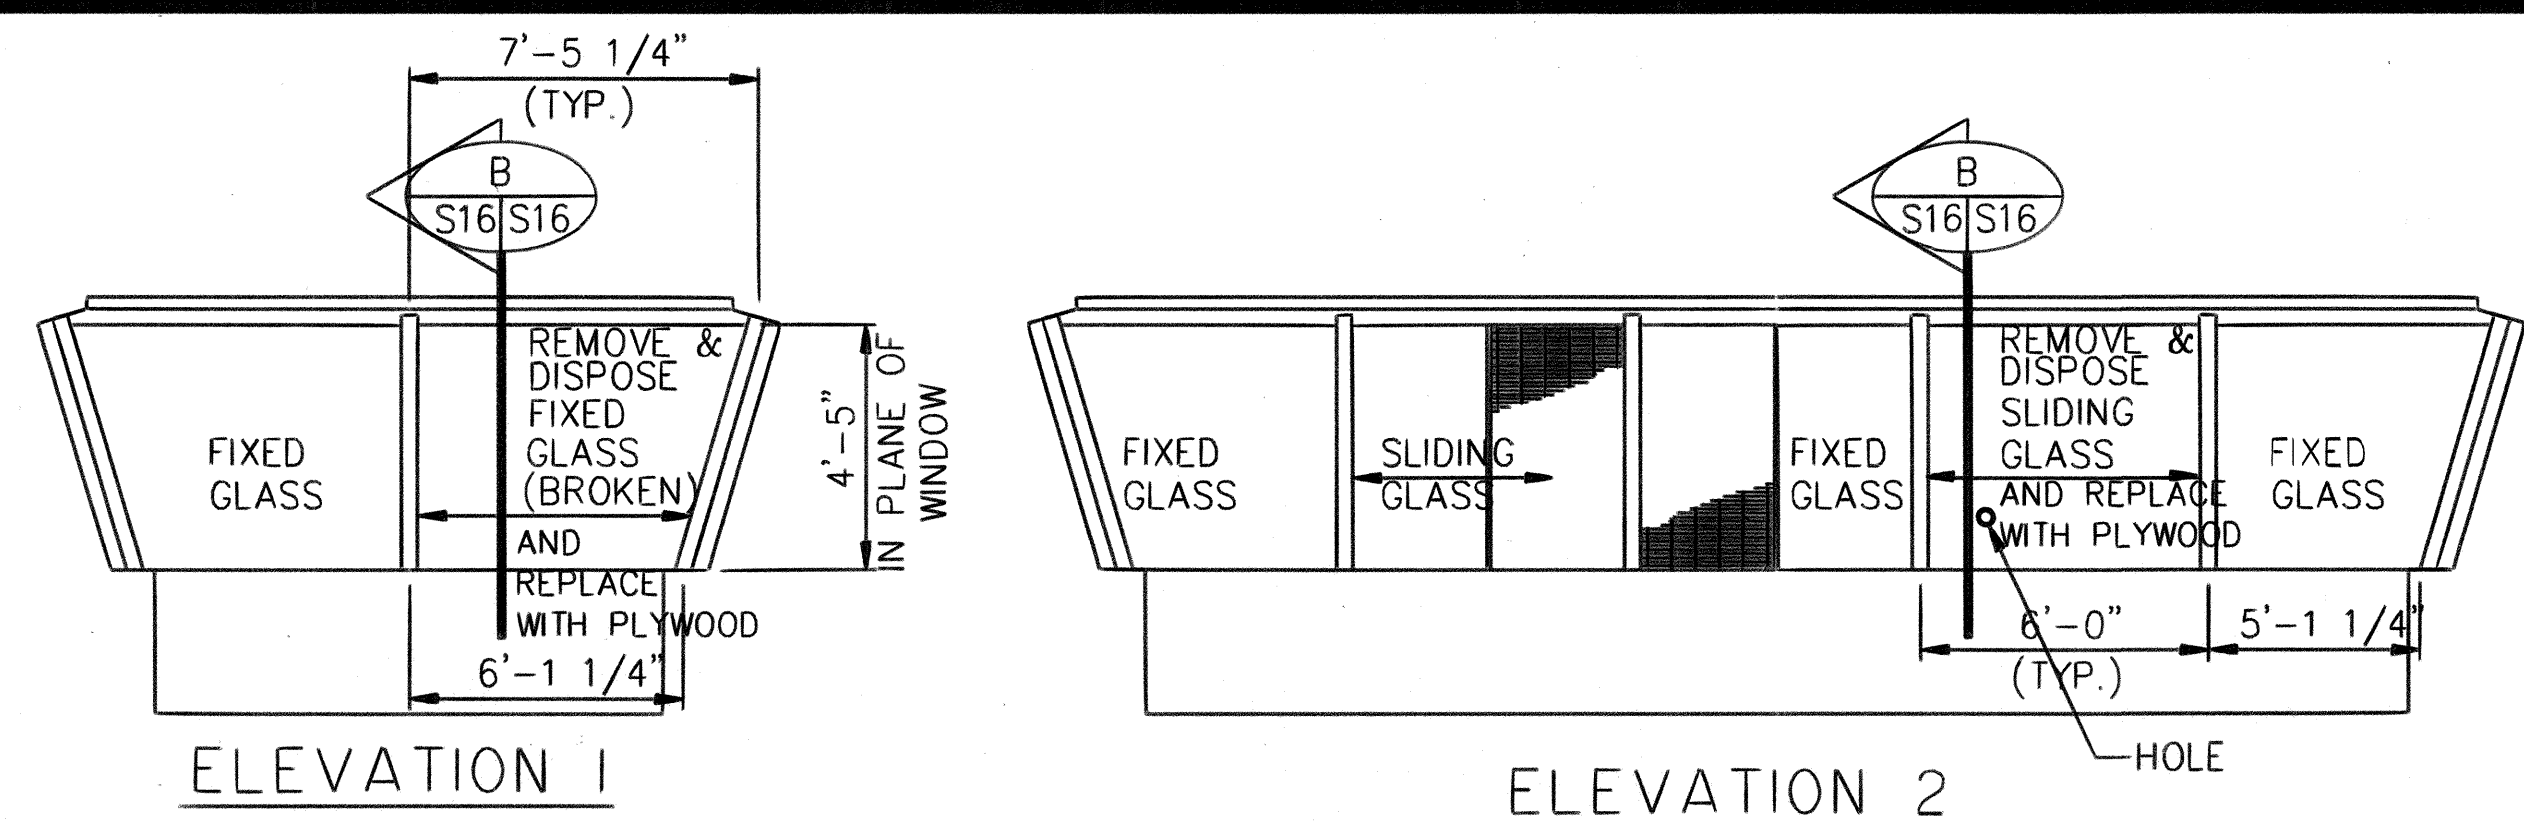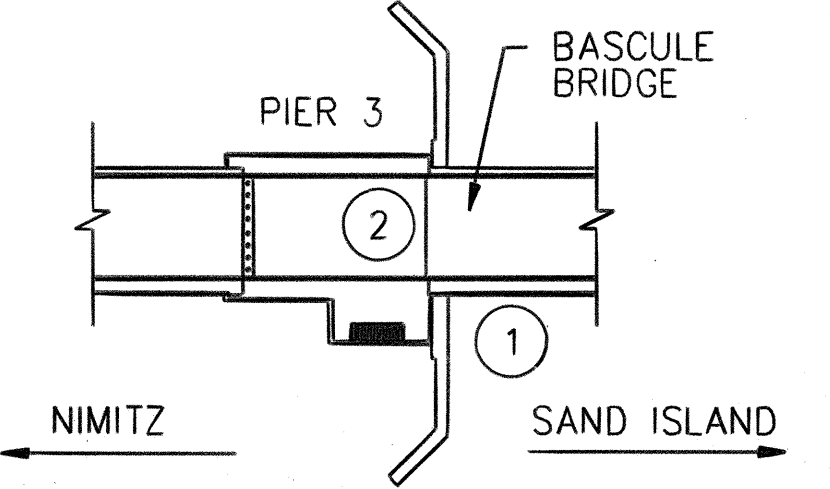


EXIST. CONTROL ROOM ELEVATIONS
A S16 S16

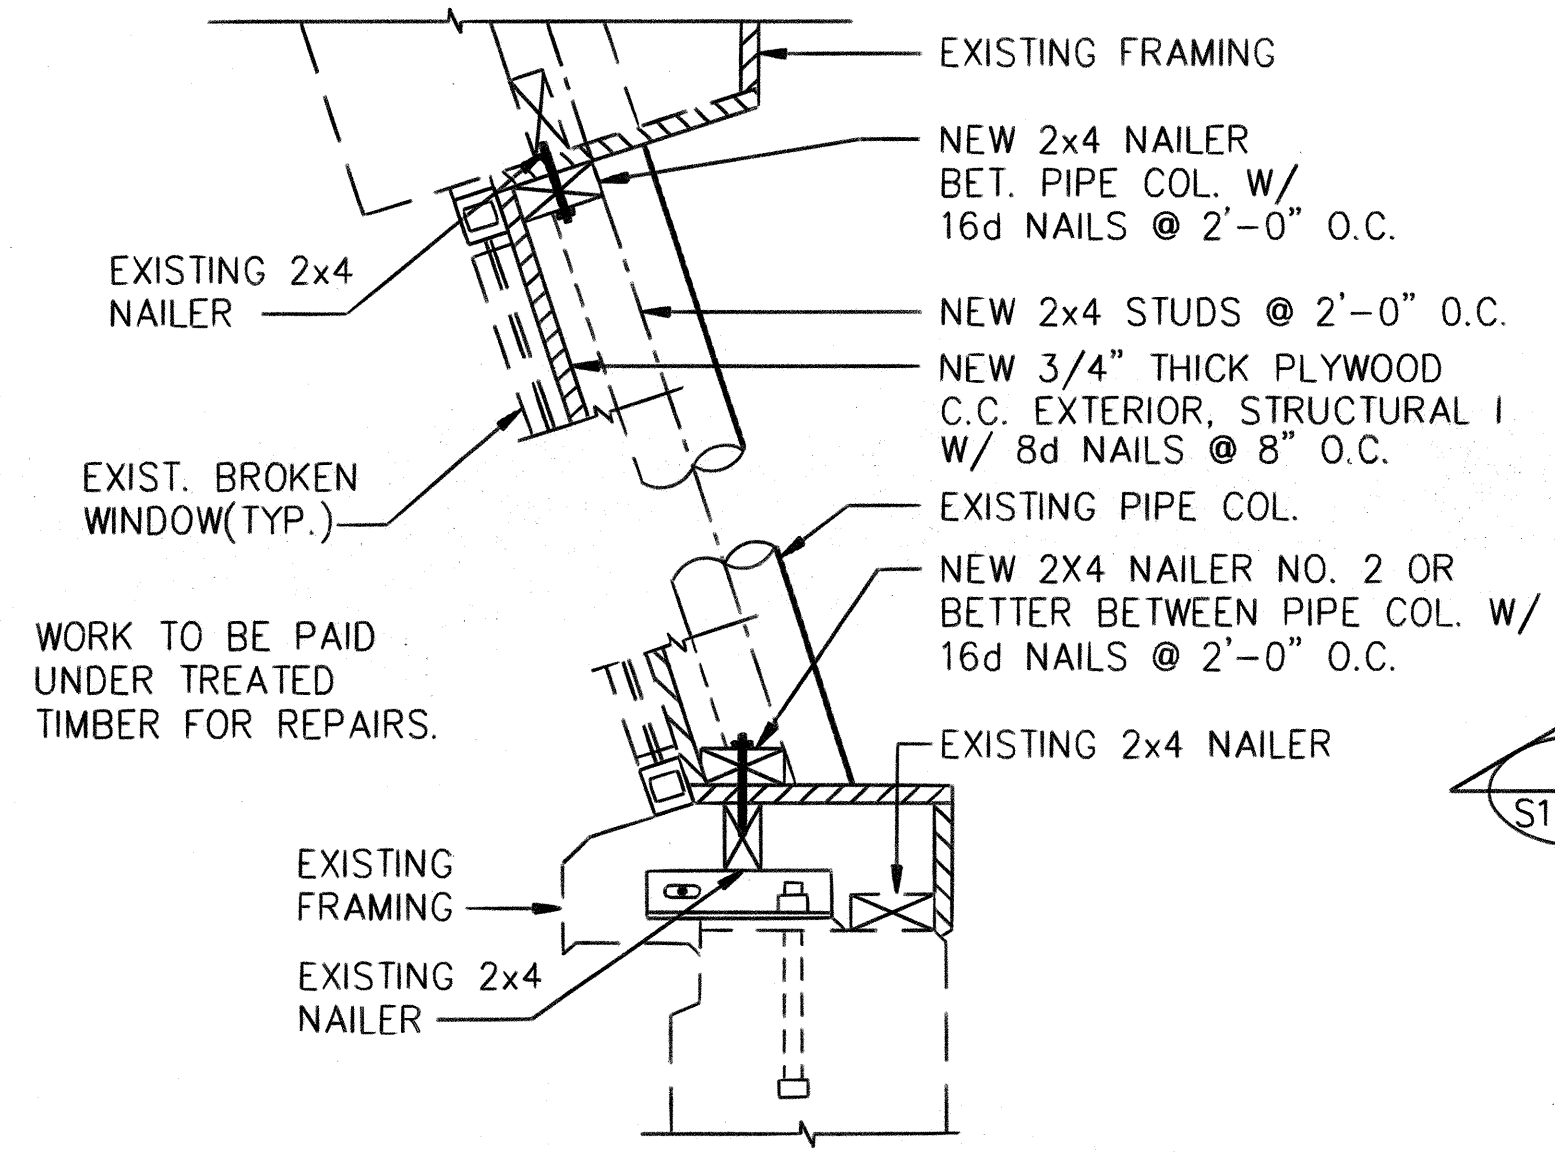


TYP. WINDOW REPAIR SECTION
B S16 S16
SCALE : 1 1/2" = 1'-0"

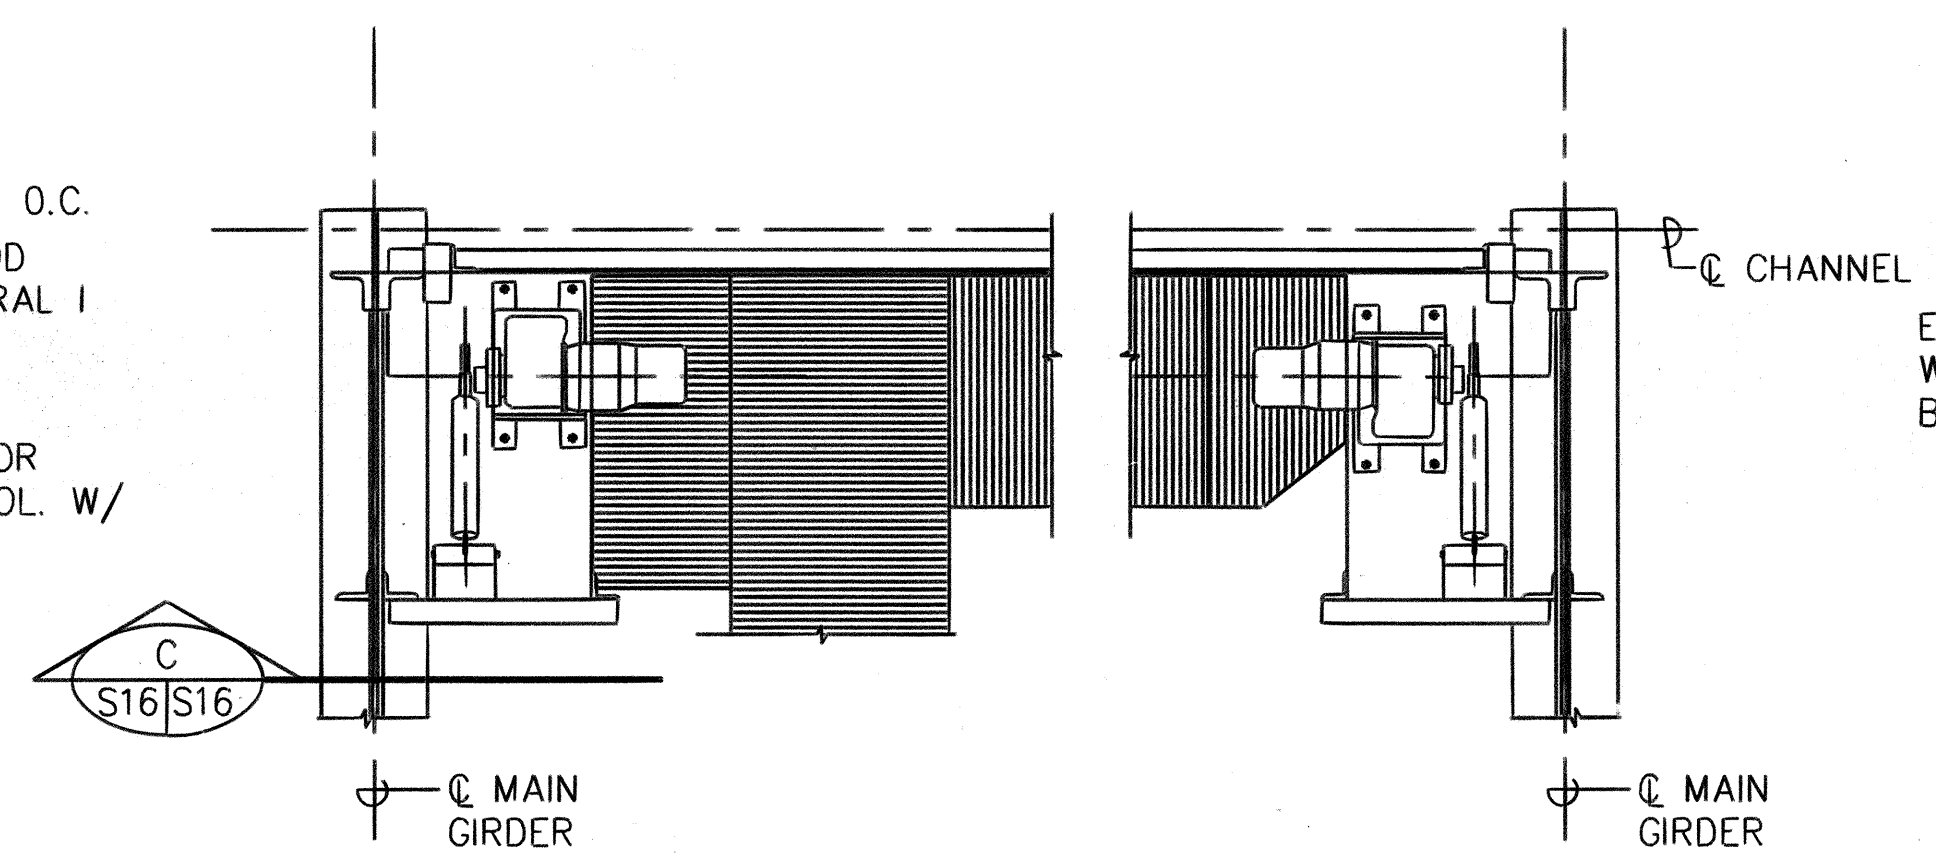


PLAN AT CENTER LOCK
EXIST. CONFIGURATION
SCALE: 3/8" = 1'-0"

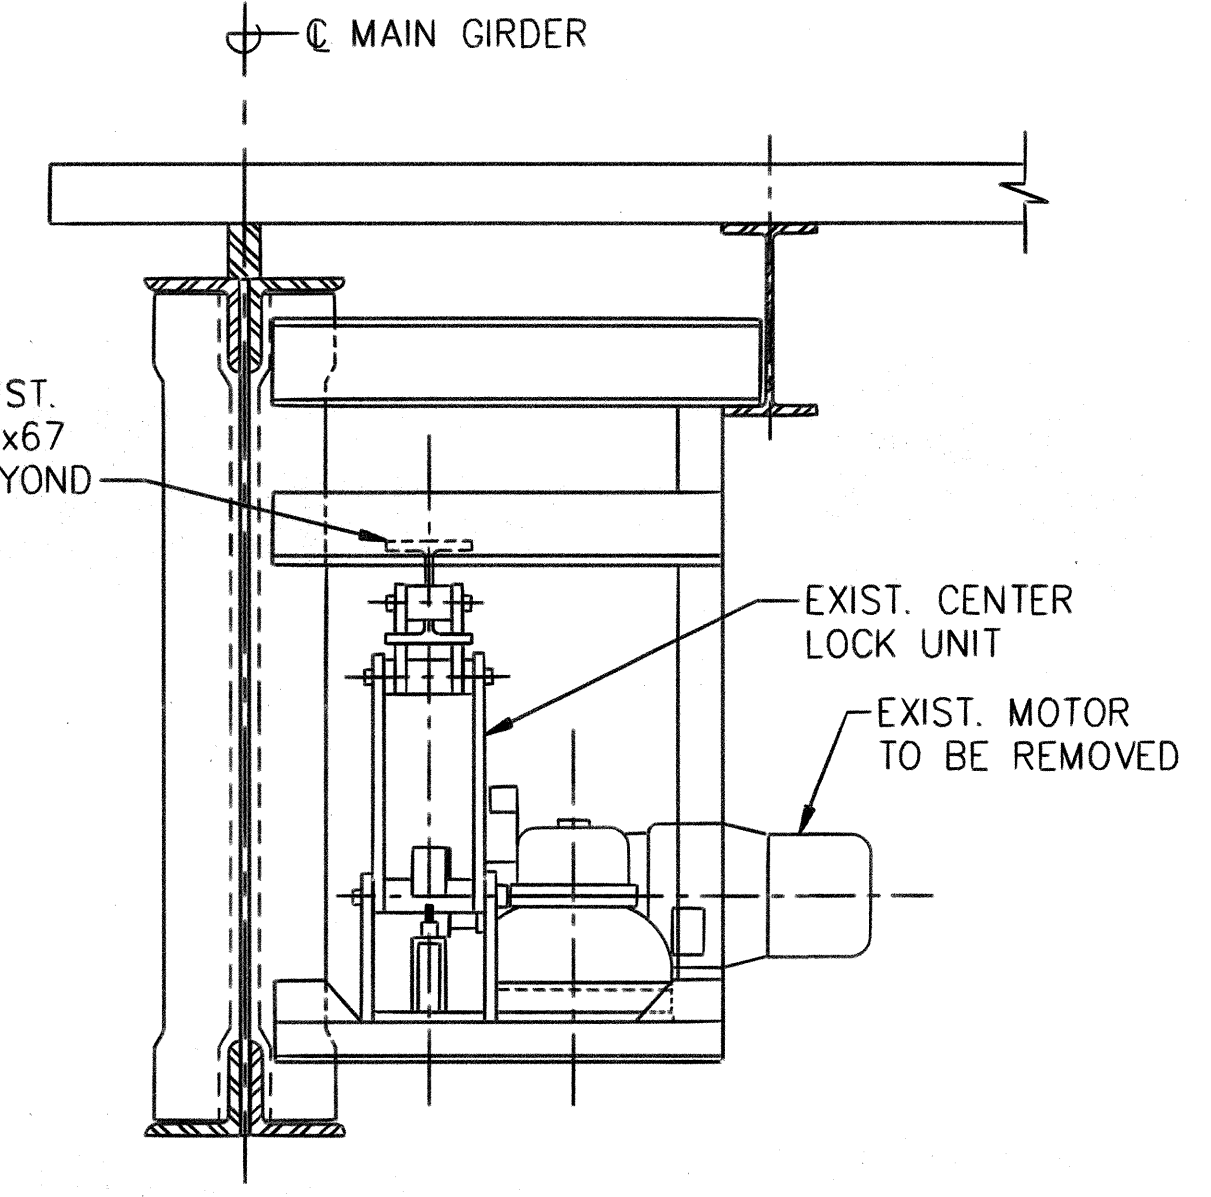


SECTION
C S16 S16
SCALE : 3/4" = 1'-0"

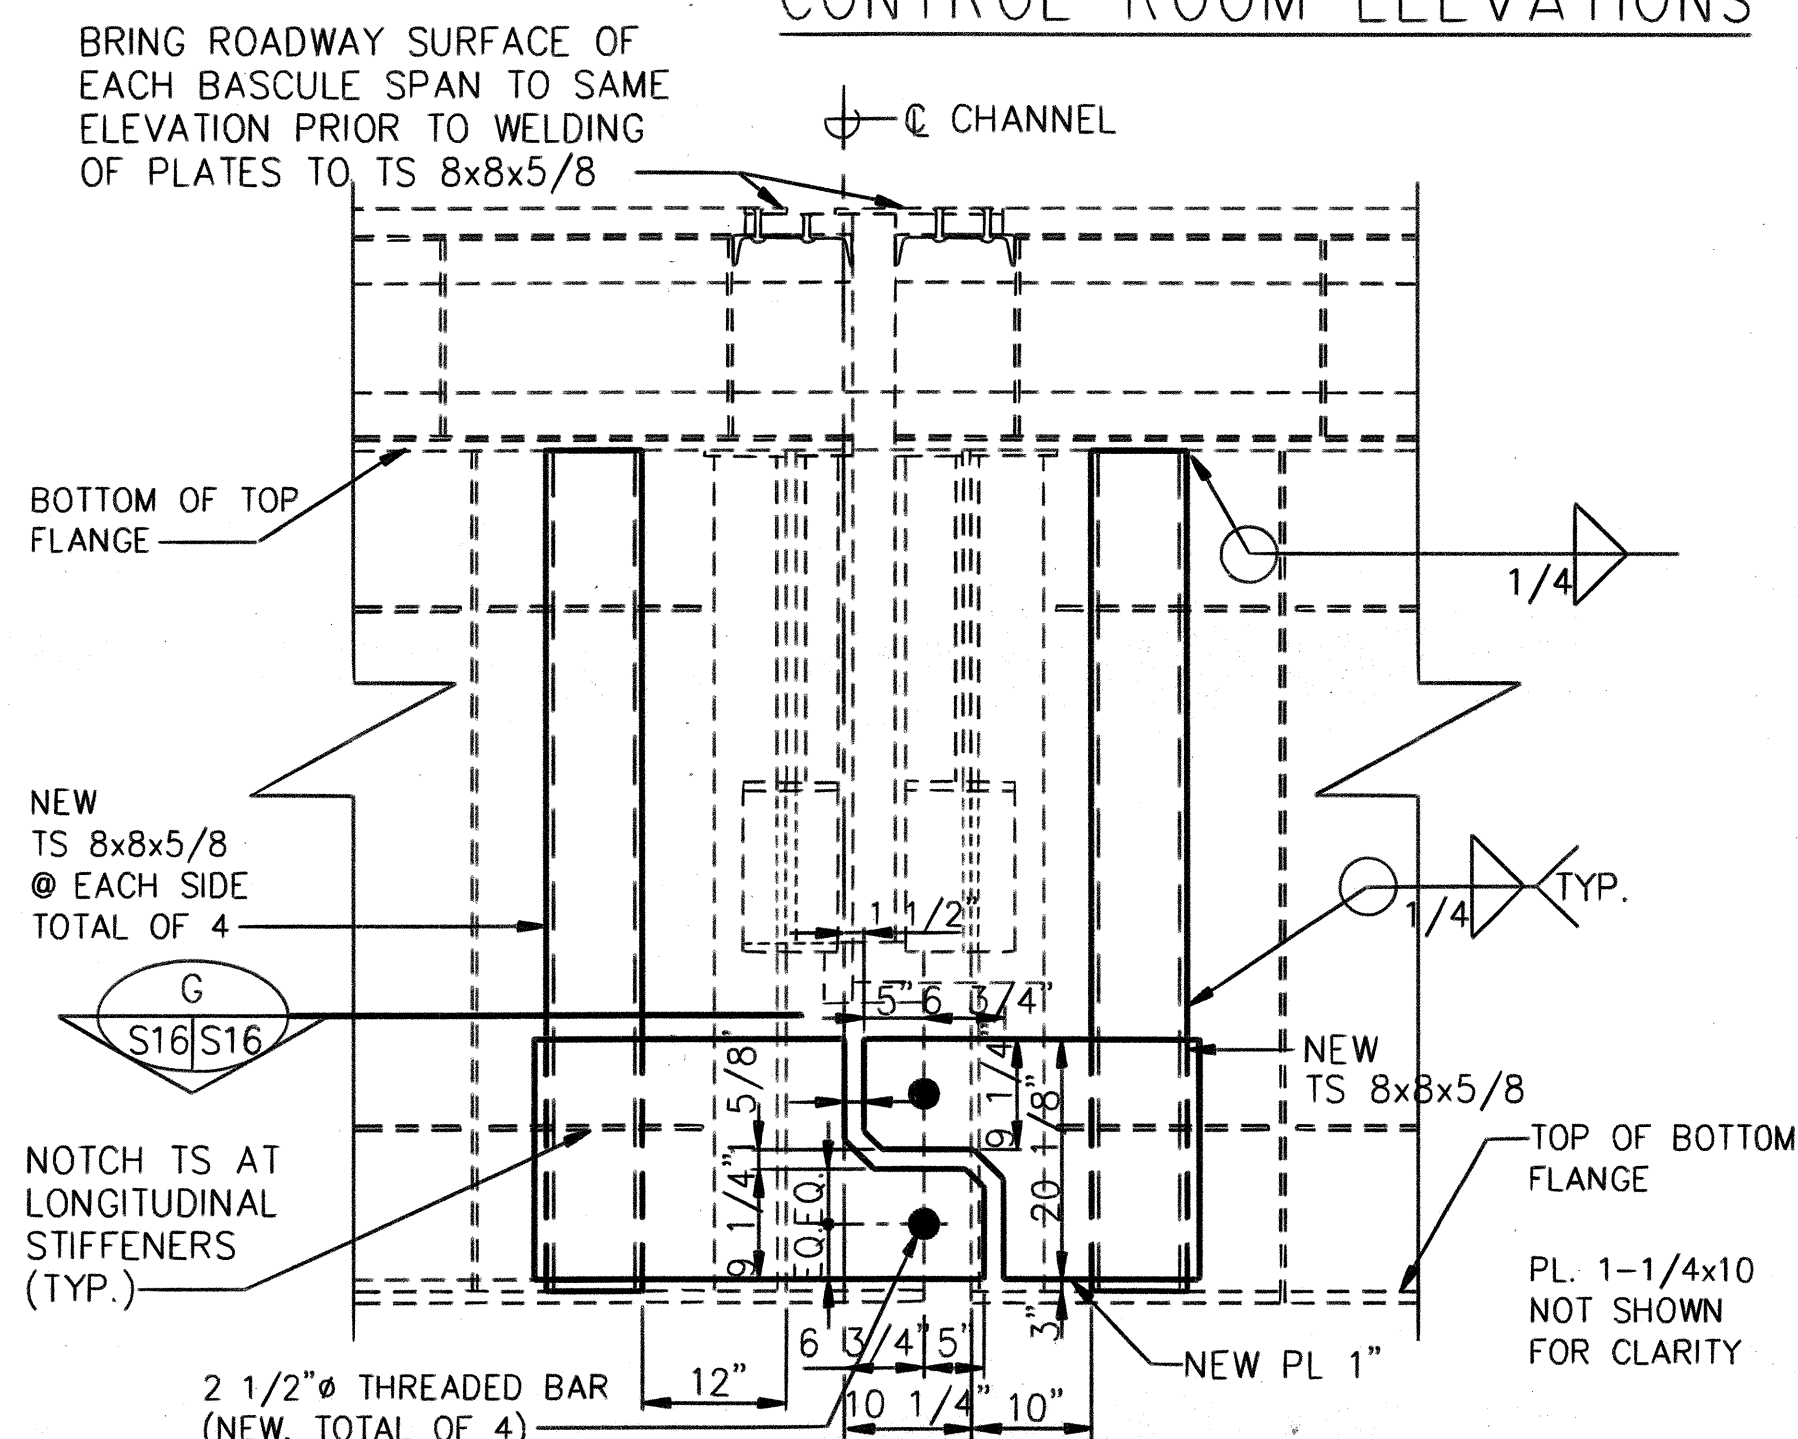


SECTION AT LOCK FOR CENTER HINGE
D S15 S16
SCALE : 3/4" = 1'-0"

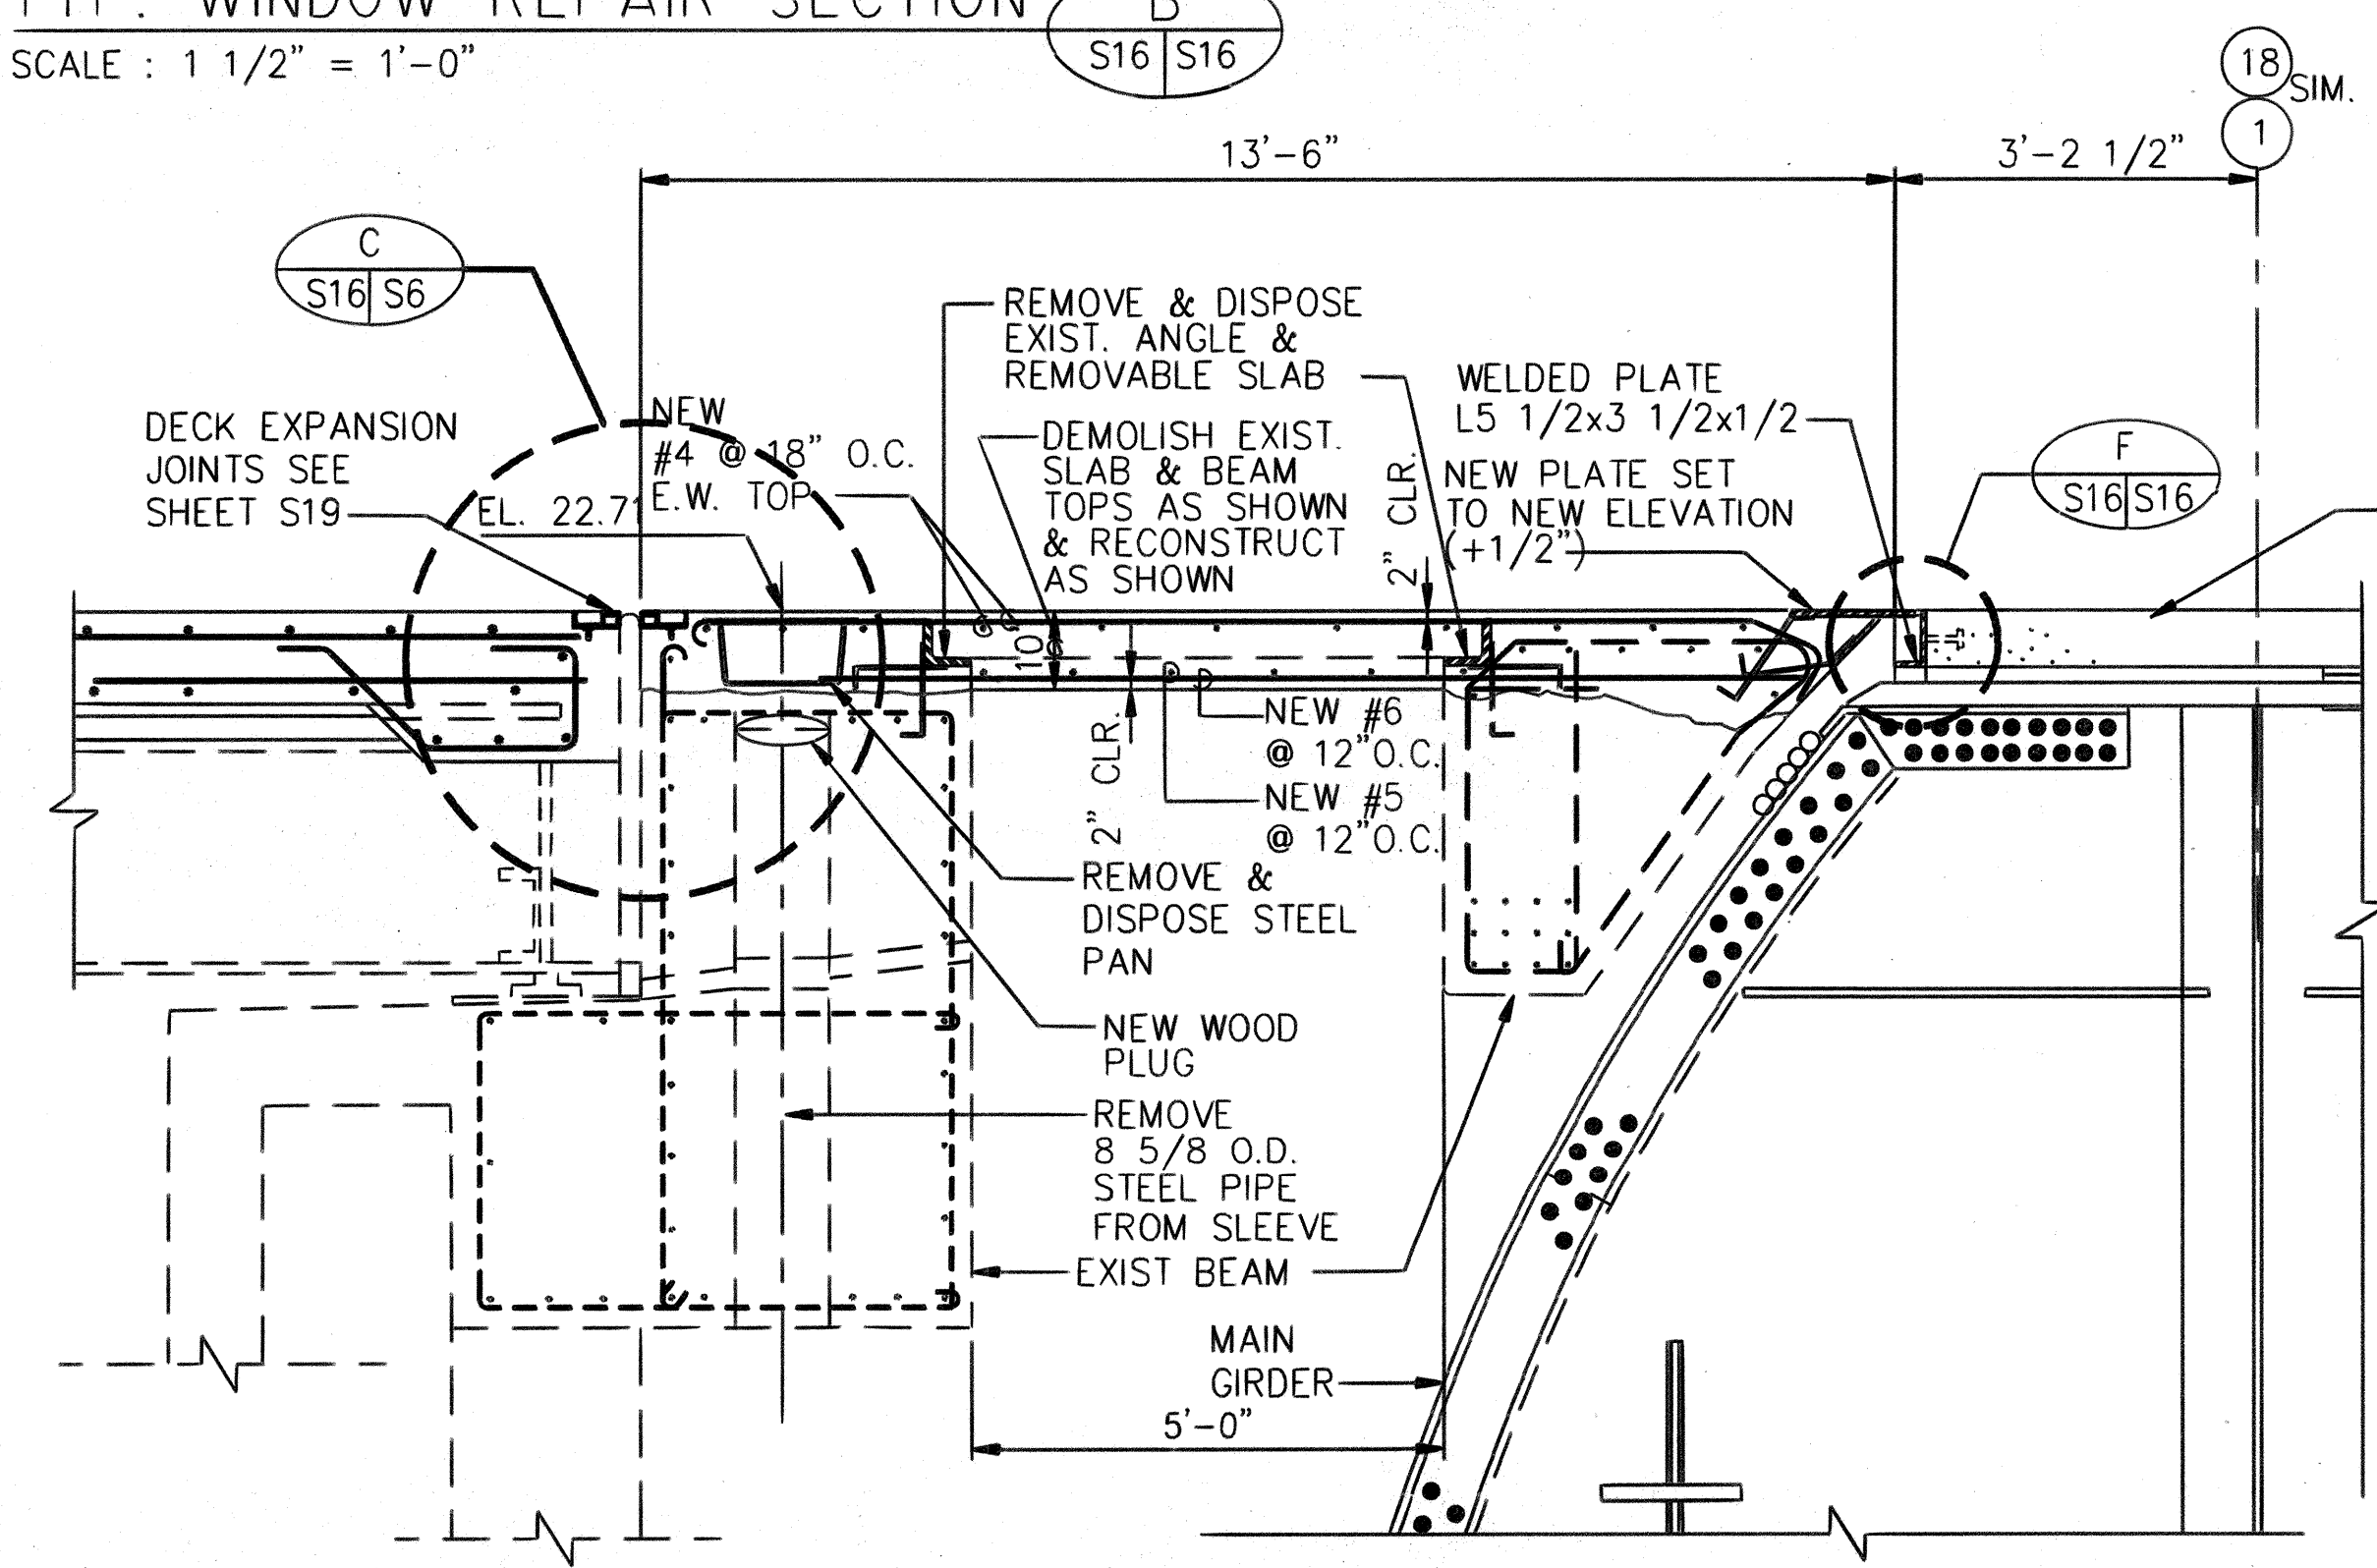


SECTION
E S9 S16
SCALE : 1/2" = 1'-0"

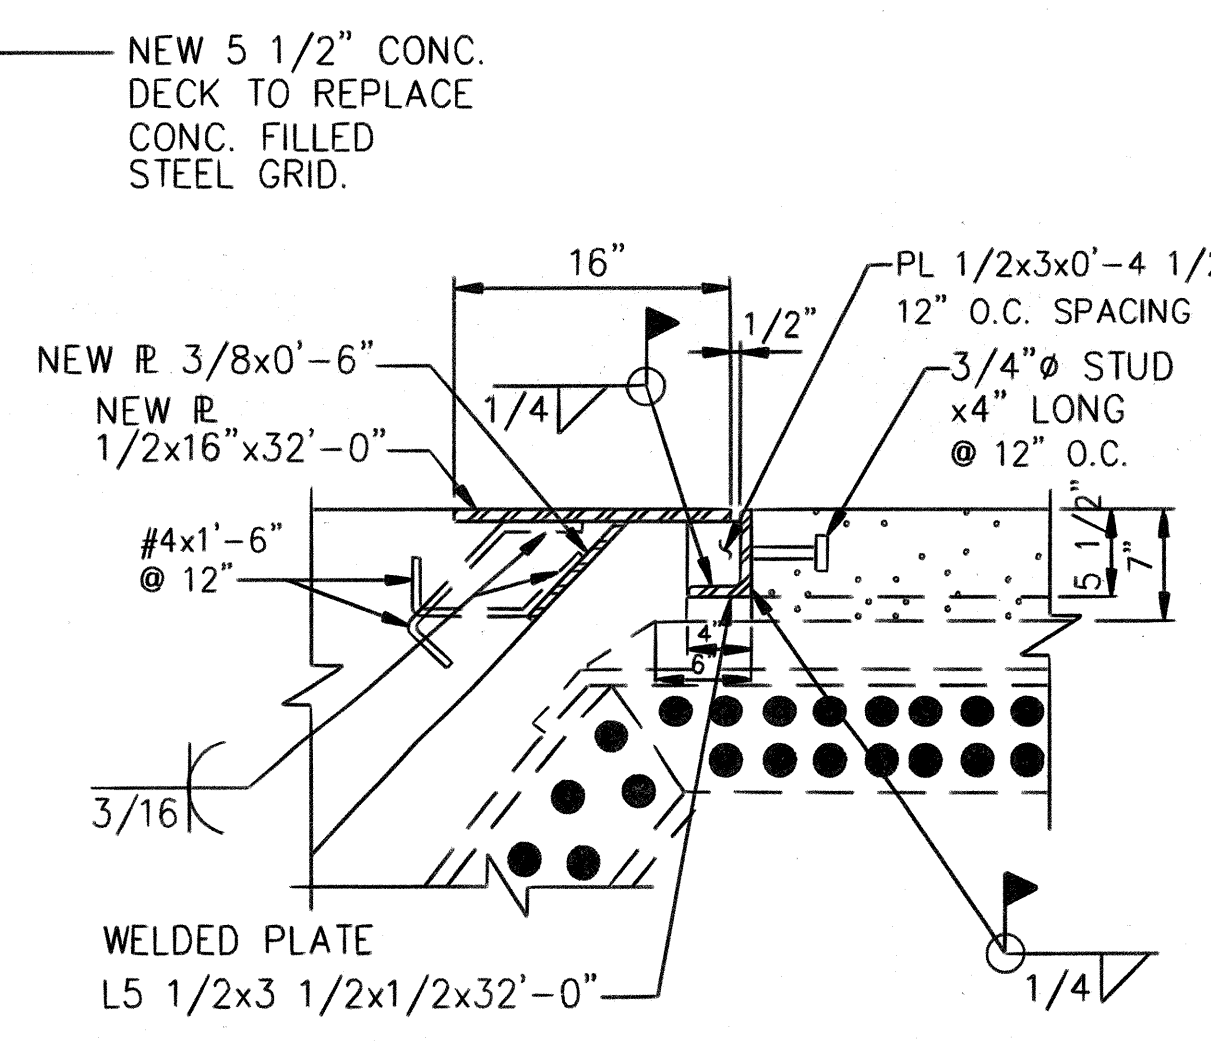

DETAIL
F S16 S16
SCALE : 1" = 1'-0"

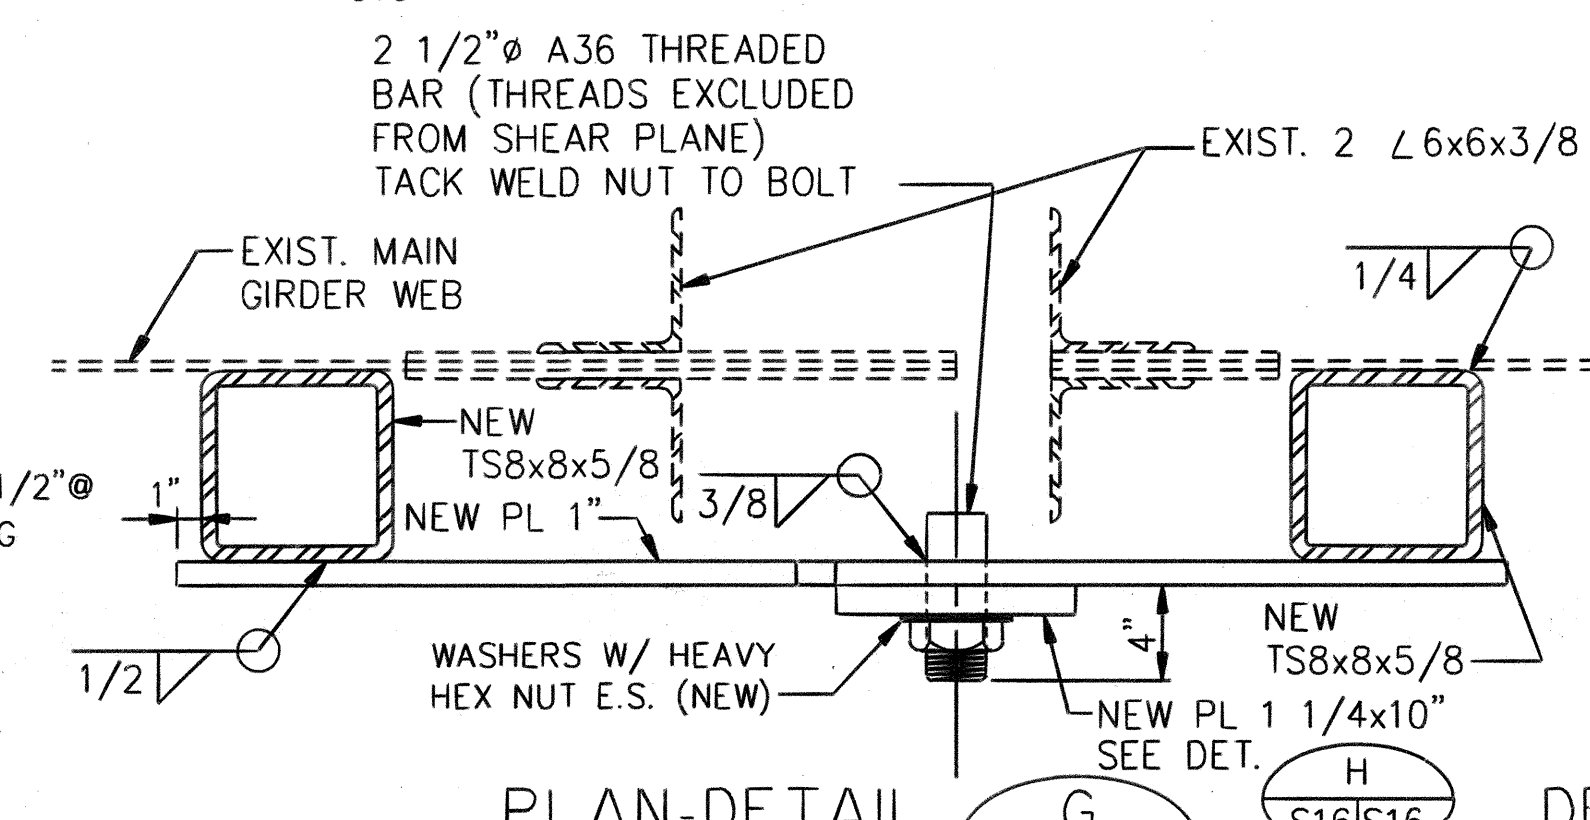

PLAN-DETAIL
G S16 S16
SCALE : 1 1/2" = 1'-0"

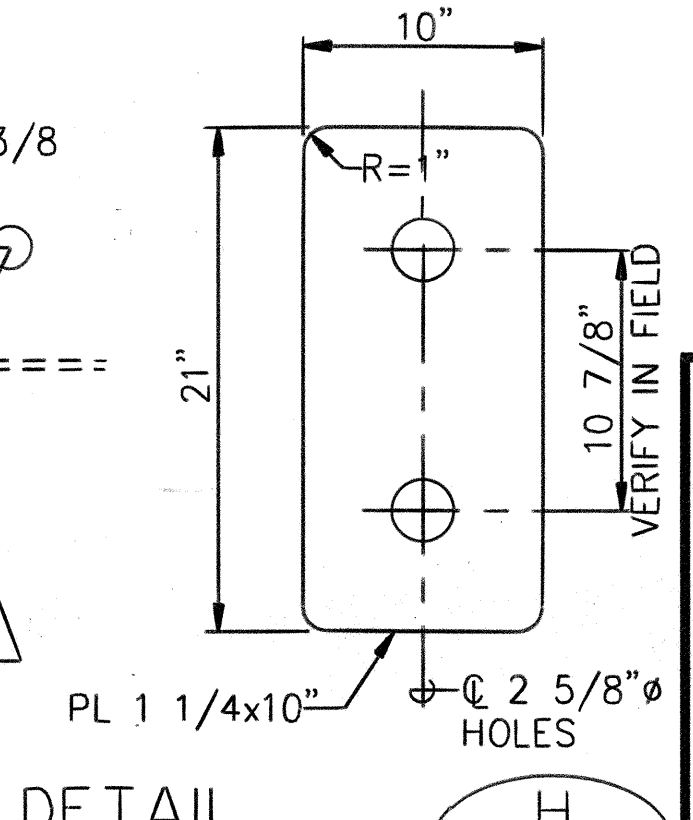

DETAIL
H S16 S16
SCALE : 1 1/2" = 1'-0"


ROSCOE O. FORD
REGISTERED PROFESSIONAL ENGINEER
No. 3751-S
HAWAII, U.S.A.
THIS WORK WAS PREPARED BY ME OR UNDER MY SUPERVISION
Roscoe O. Ford

STATE OF HAWAII
DEPARTMENT OF TRANSPORTATION
HIGHWAYS DIVISION
MISCELLANEOUS DETAILS


SAND ISLAND BASCULE BRIDGE
REHABILITATION PHASE II
PROJECT NO. BR-064-1(3)
SCALE: AS NOTED DATE: AUG. 15, 1991
SHEET No. S16 OF S21 SHEETS

DATE REVISION

FED. ROAD DIST. NO.	STATE	FED. AID PROJ. NO.	FISCAL YEAR	SHEET NO.	TOTAL SHEETS
HAWAII	HAW.	BR-064-1(3)	1991	24	38

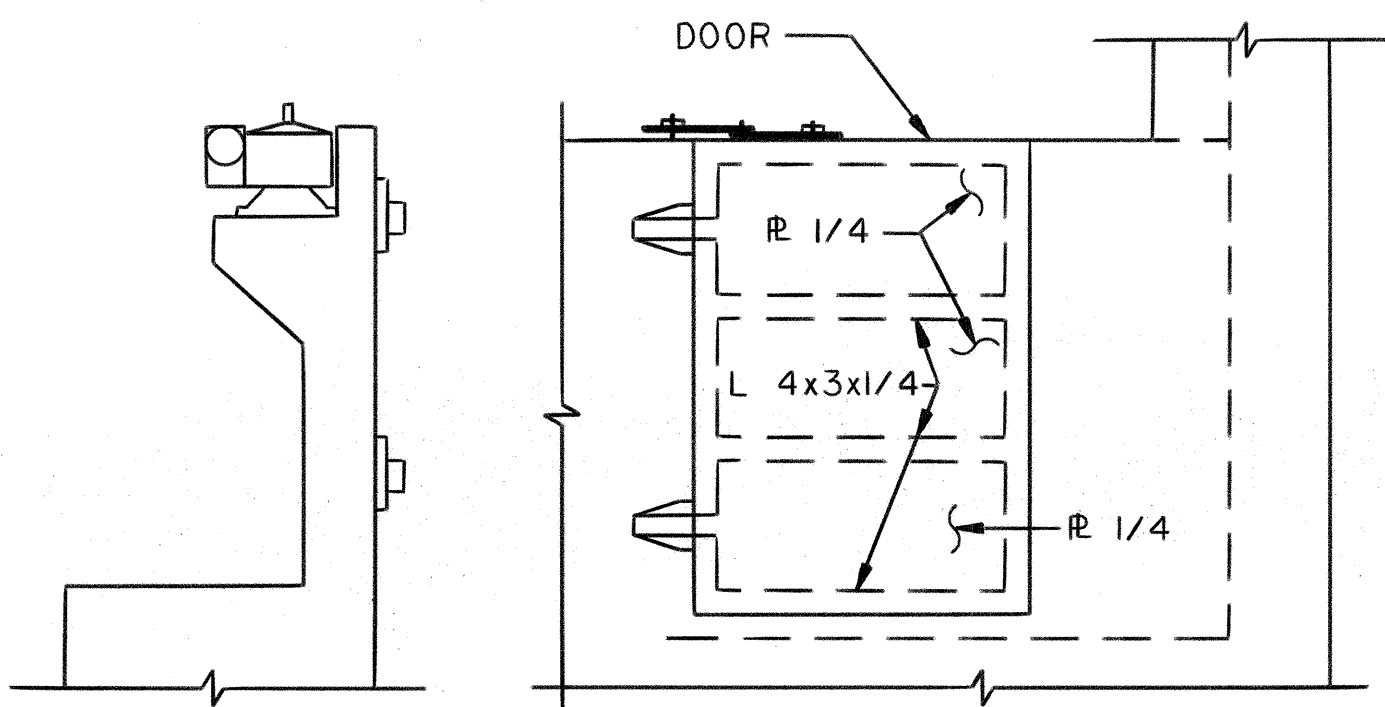


SECTION FRONT VIEW

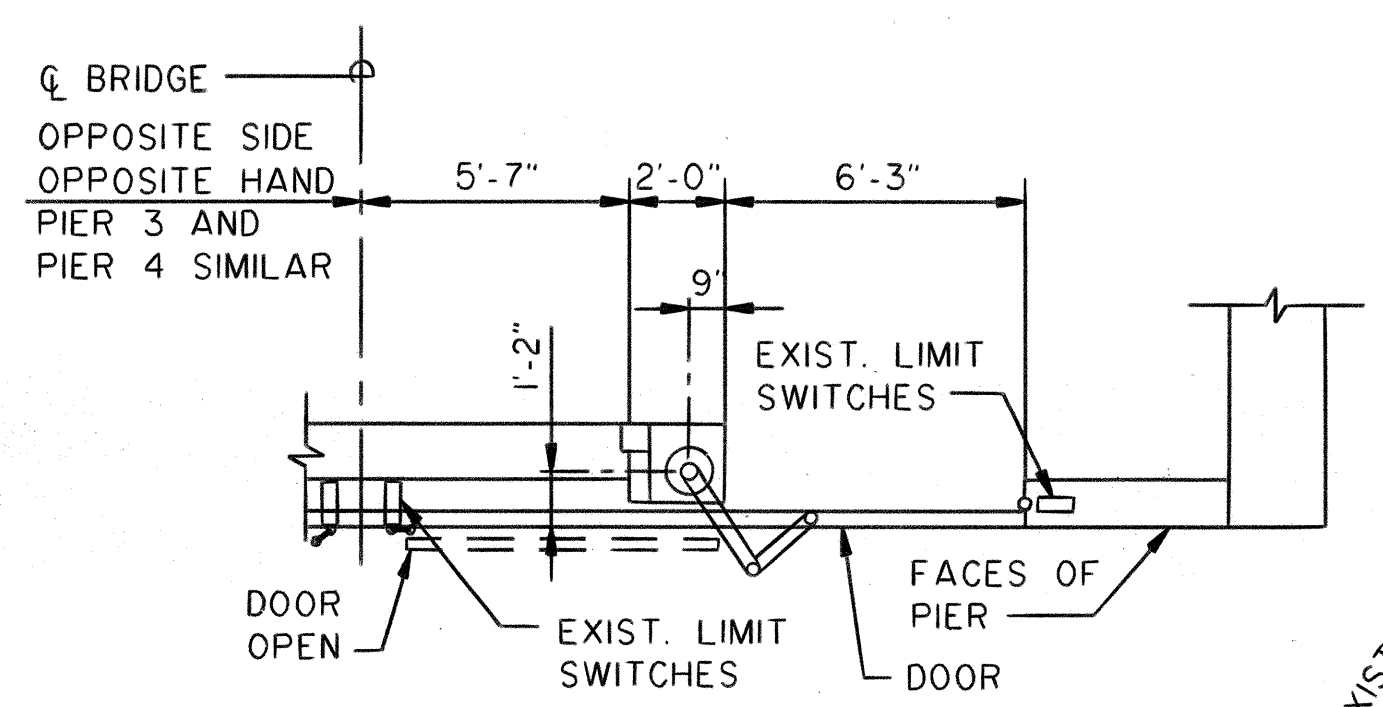


PLAN

EXIST. TSUNAMI GATE DETAIL E
SCALE: 1/4" = 1'-0"

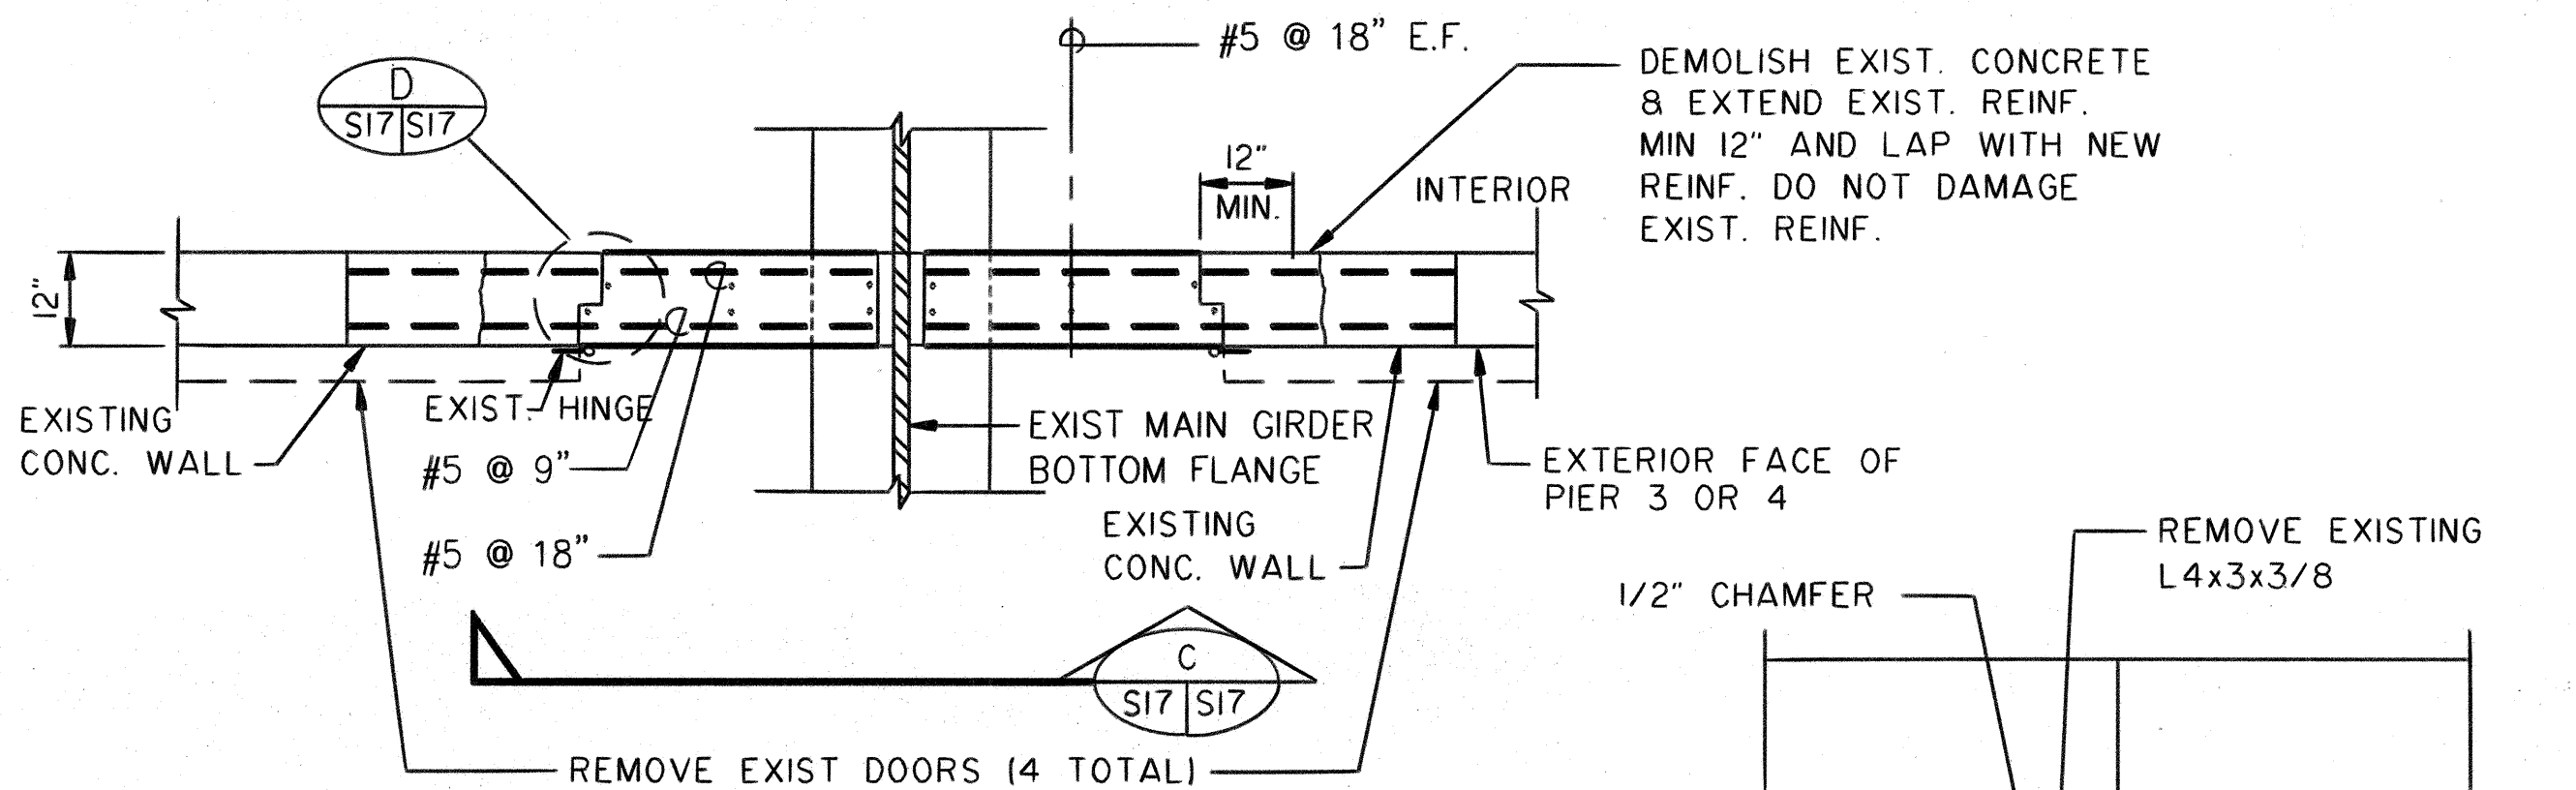


PLAN - GATE B
SCALE: 1/2" = 1'-0"

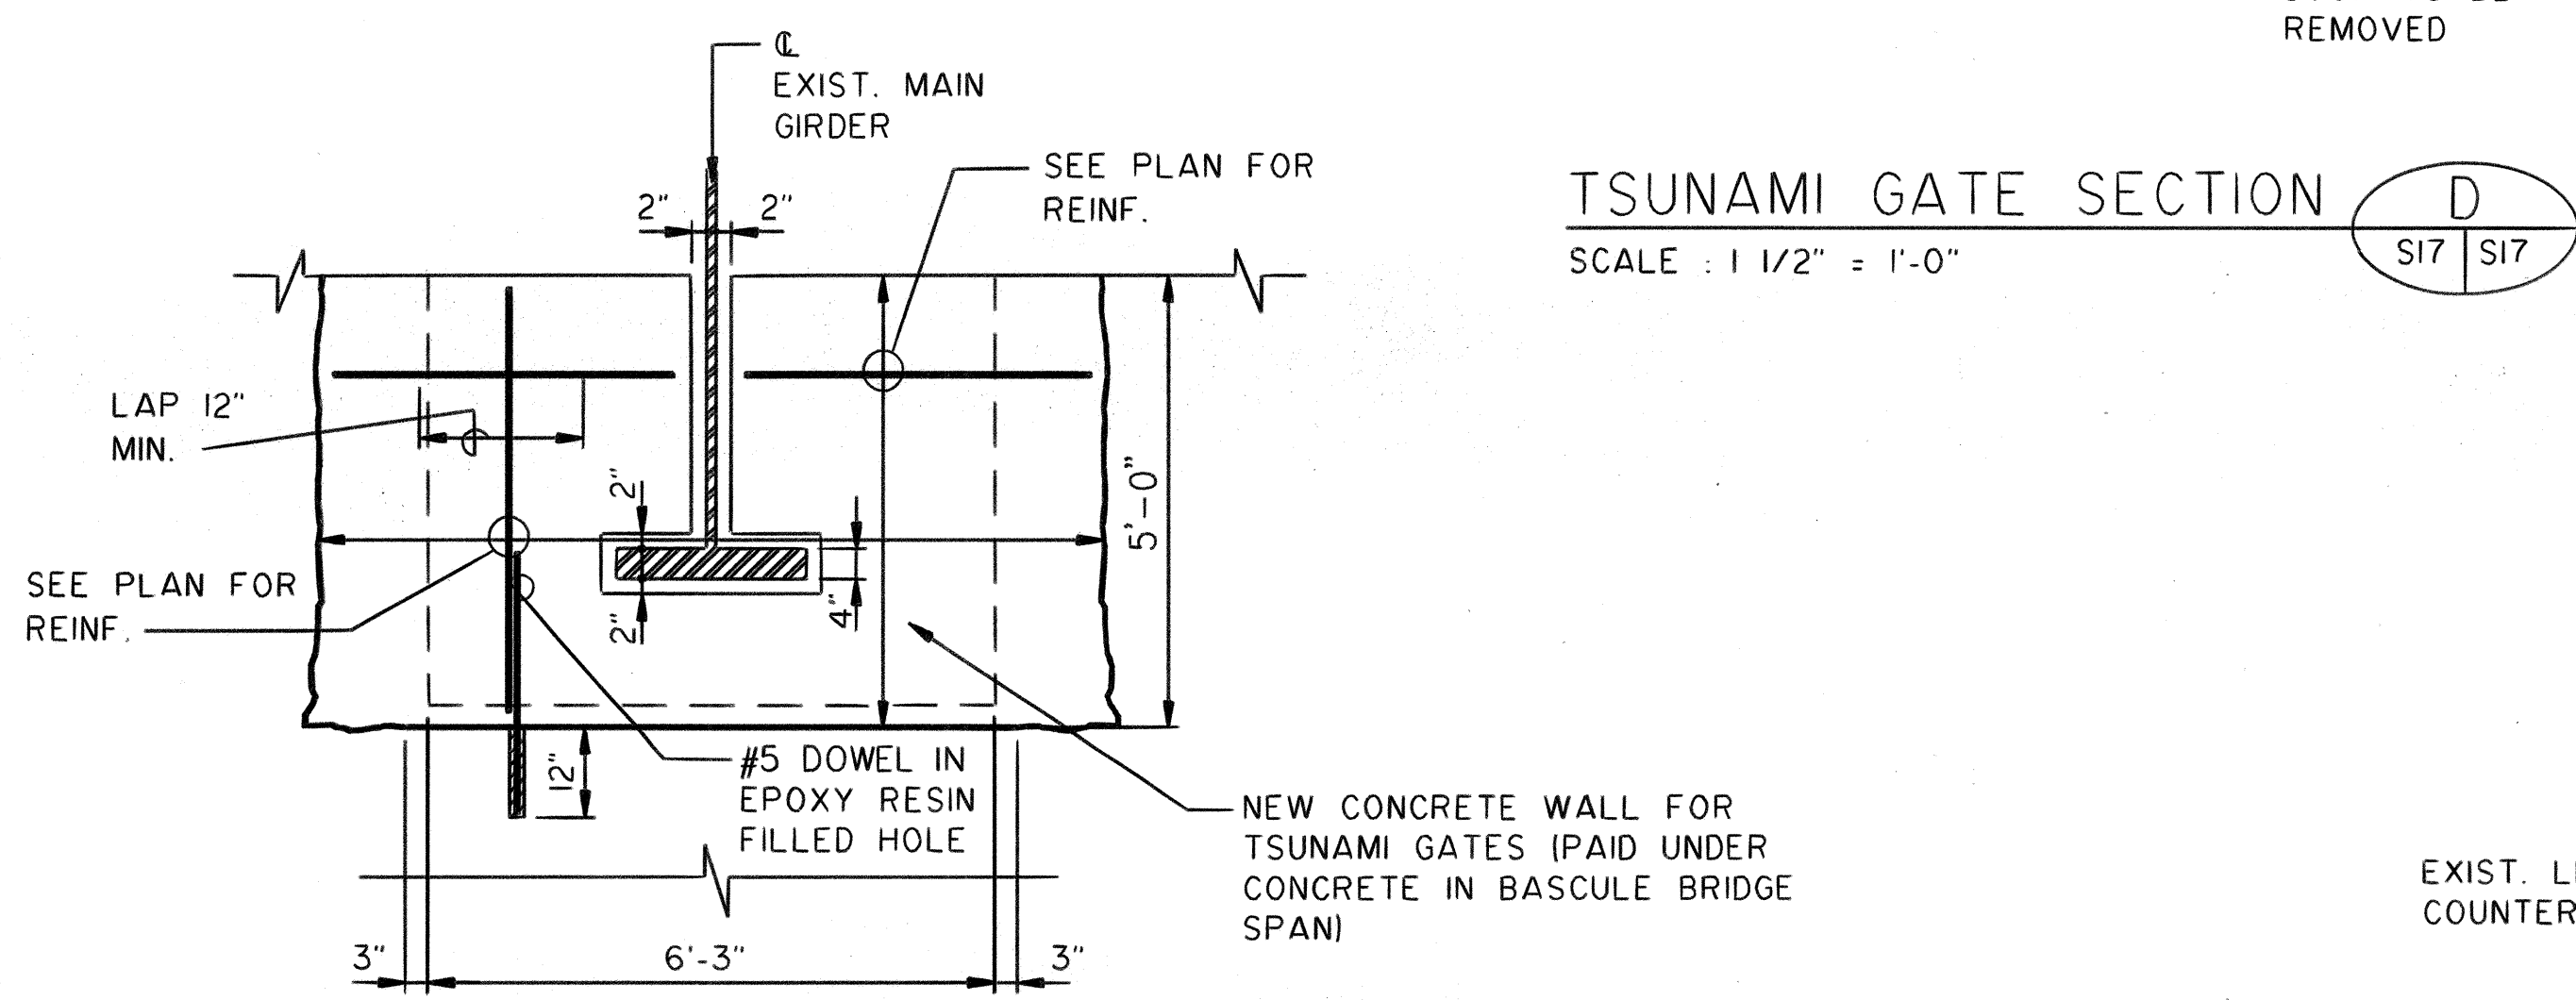

TSUNAMI GATE SECTION D
SCALE: 1 1/2" = 1'-0"

TSUNAMI GATE ELEVATION C
SCALE: 1/2" = 1'-0"

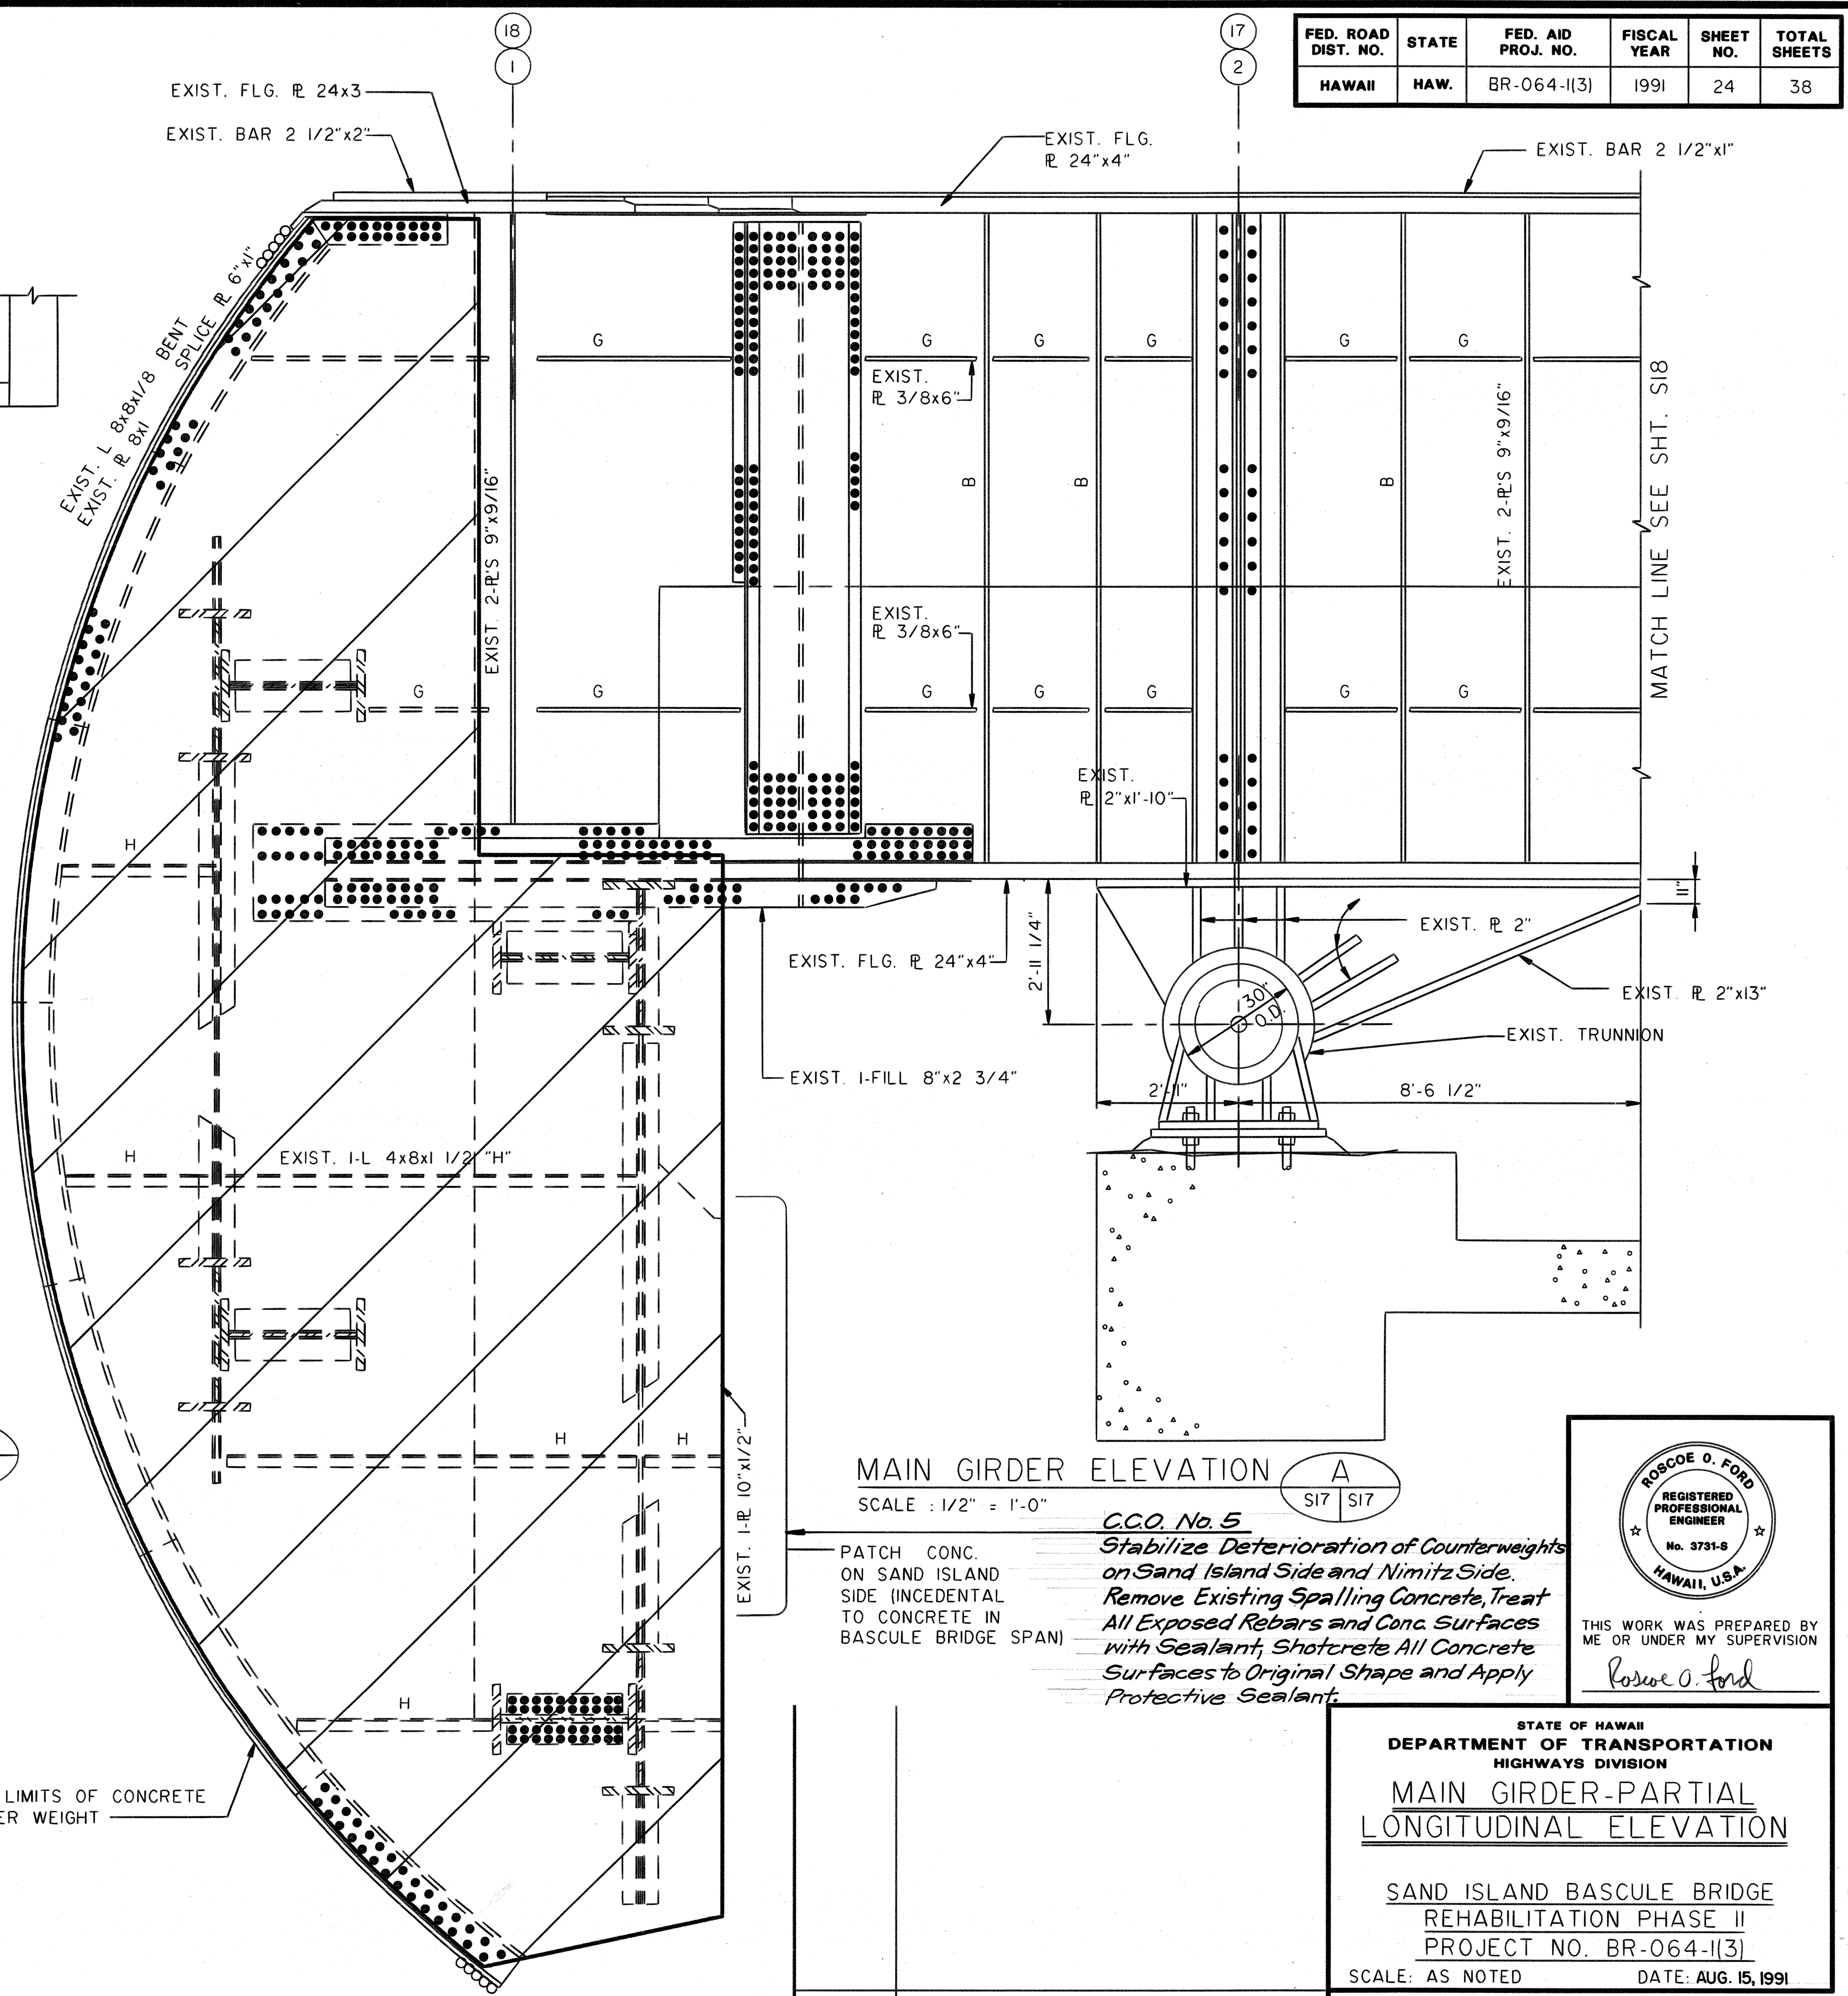

MAIN GIRDER ELEVATION A
SCALE: 1/2" = 1'-0"


C.C.O. No. 5
Stabilize Deterioration of Counterweights on Sand Island Side and Nimitz Side. Remove Existing Spalling Concrete, Treat All Exposed Rebars and Conc. Surfaces with Sealant, Shotcrete All Concrete Surfaces to Original Shape and Apply Protective Sealant.

ROSCOE O. FORD
REGISTERED PROFESSIONAL ENGINEER
No. 3731-S
HAWAII, U.S.A.
THIS WORK WAS PREPARED BY ME OR UNDER MY SUPERVISION
Roscoe O. Ford

STATE OF HAWAII
DEPARTMENT OF TRANSPORTATION
HIGHWAYS DIVISION
MAIN GIRDER-PARTIAL LONGITUDINAL ELEVATION
SAND ISLAND BASCULE BRIDGE
REHABILITATION PHASE II
PROJECT NO. BR-064-1(3)
SCALE: AS NOTED DATE: AUG. 15, 1991
SHEET No. S17 OF S21 SHEETS


DATE	
SURVEY PLOTTED BY	
DRAWN BY	
DESIGNED BY	
QUANTITIES BY	
CHECKED BY	
ORIGINAL PLAN	
NOTEBOOK	
No.	

FED. ROAD DIST. NO.	STATE	FED. AID PROJ. NO.	FISCAL YEAR	SHEET NO.	TOTAL SHEETS
HAWAII	HAW.	BR-064-1(3)	1991	25	38

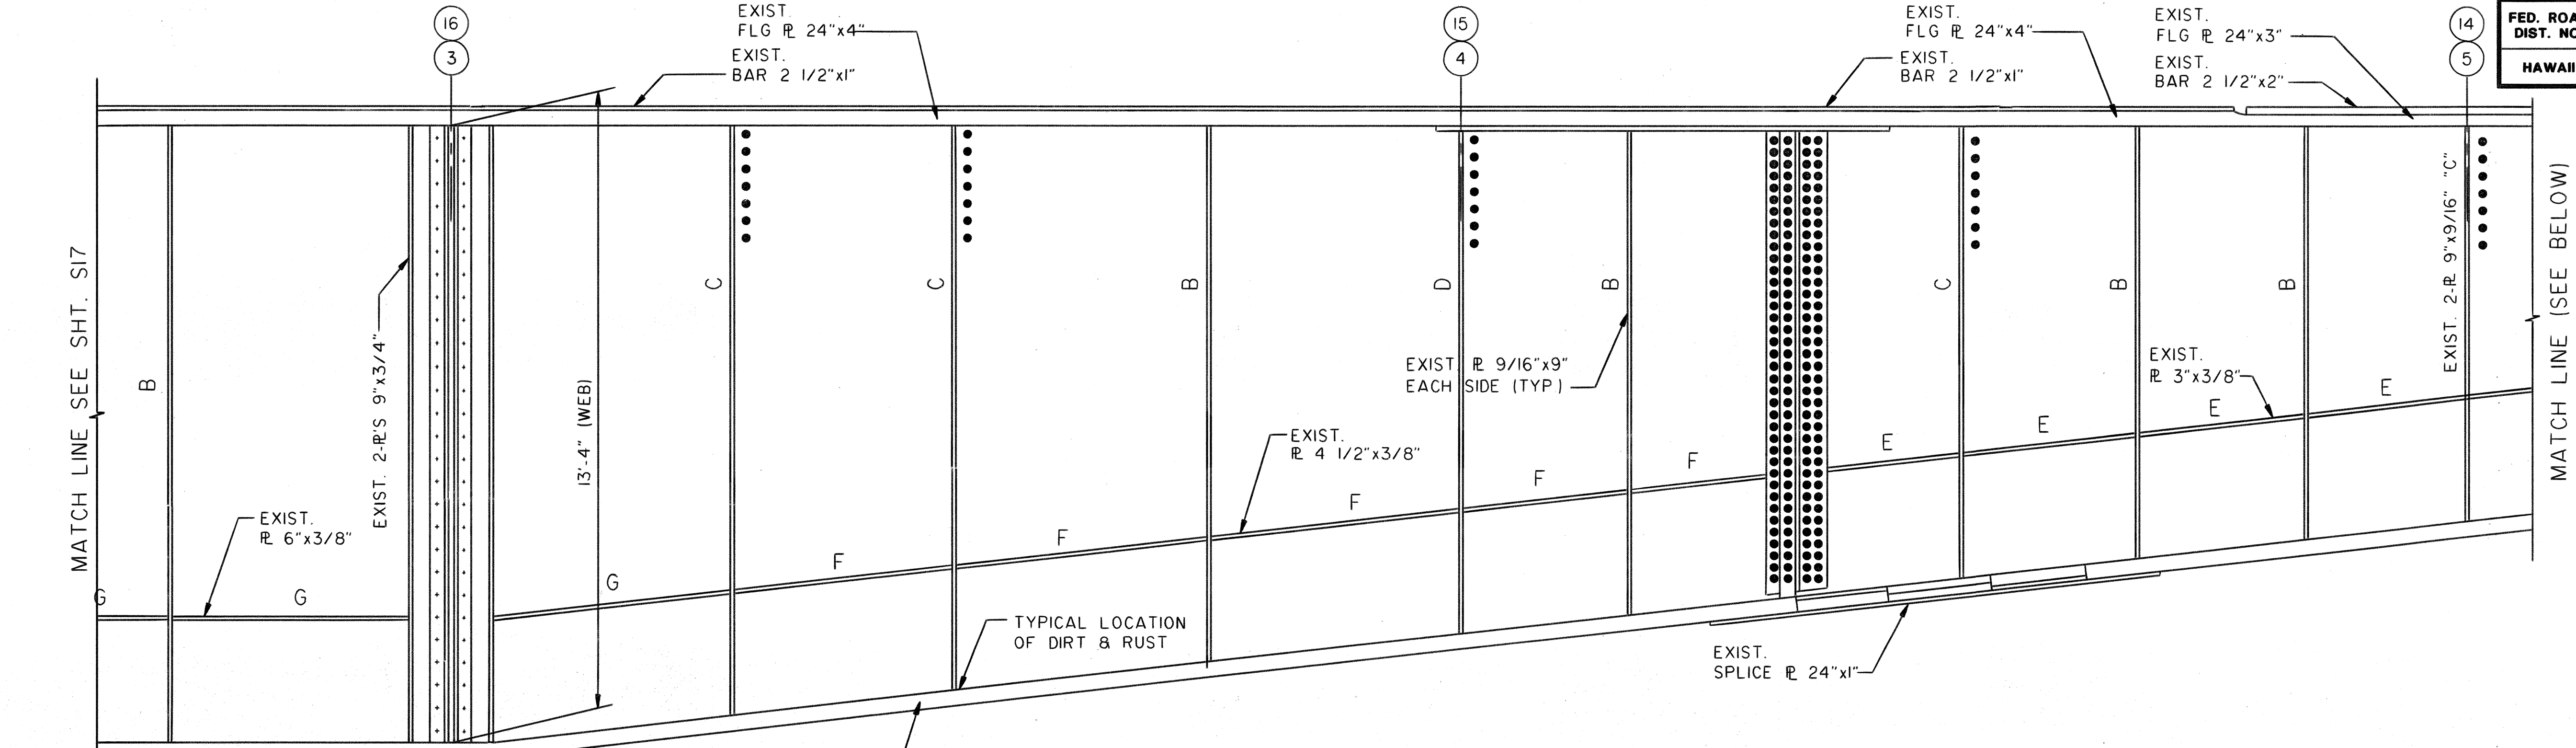


MAIN GIRDER ELEVATION

SCALE : 1/2" = 1'-0"

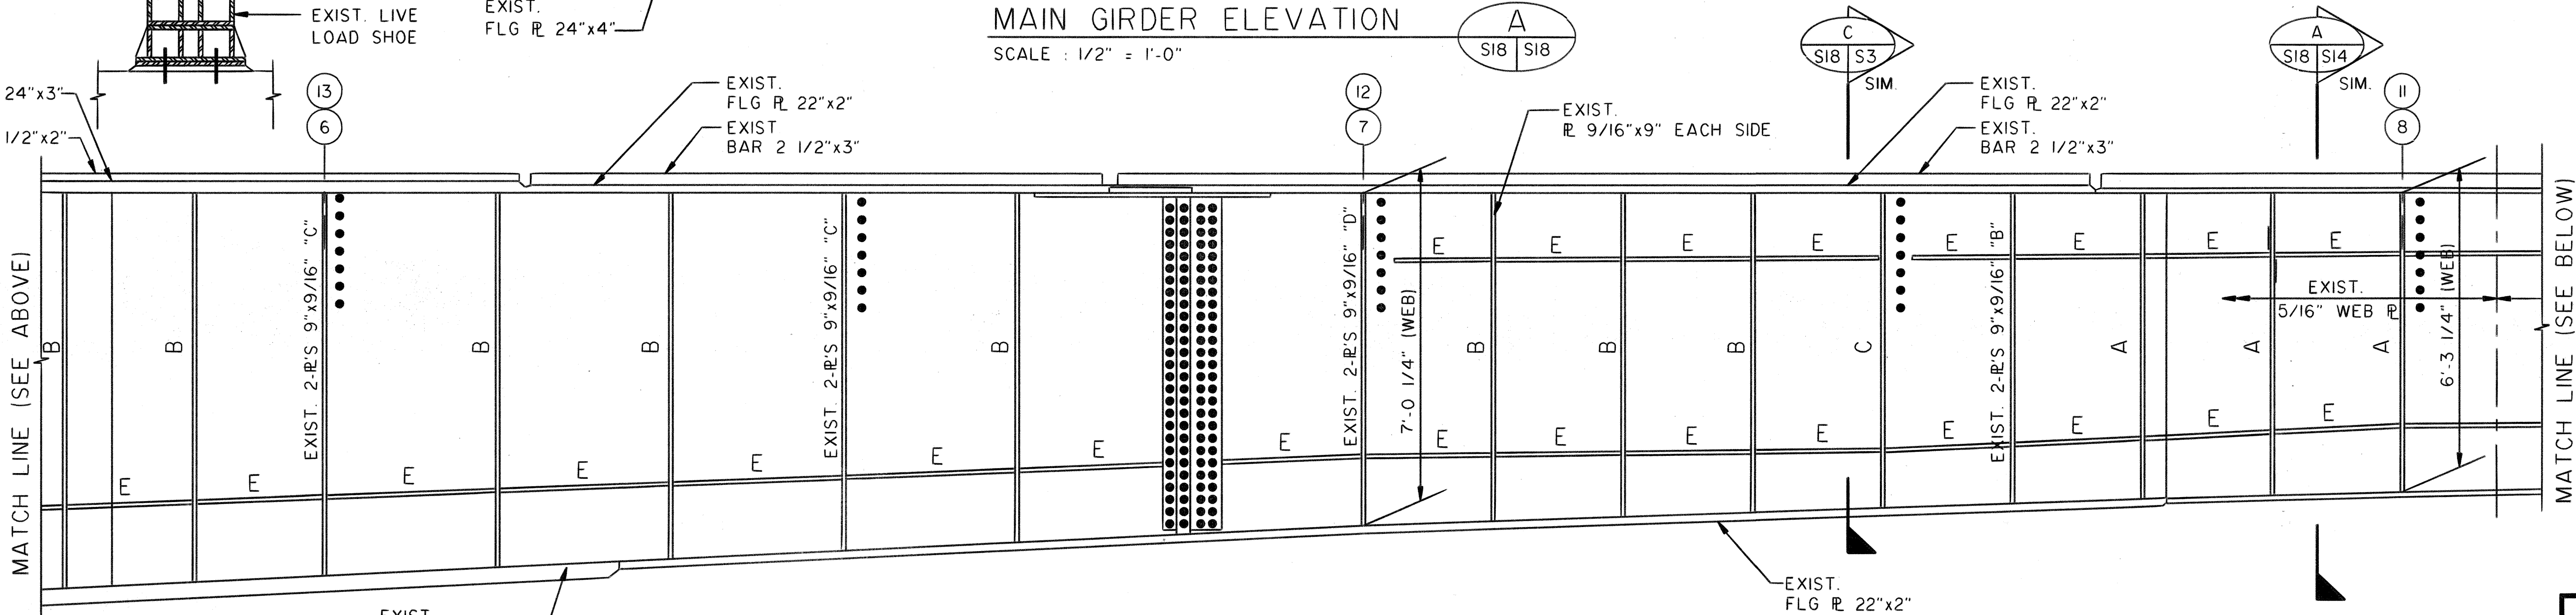

MAIN GIRDER ELEVATION

SCALE : 1/2" = 1'-0"

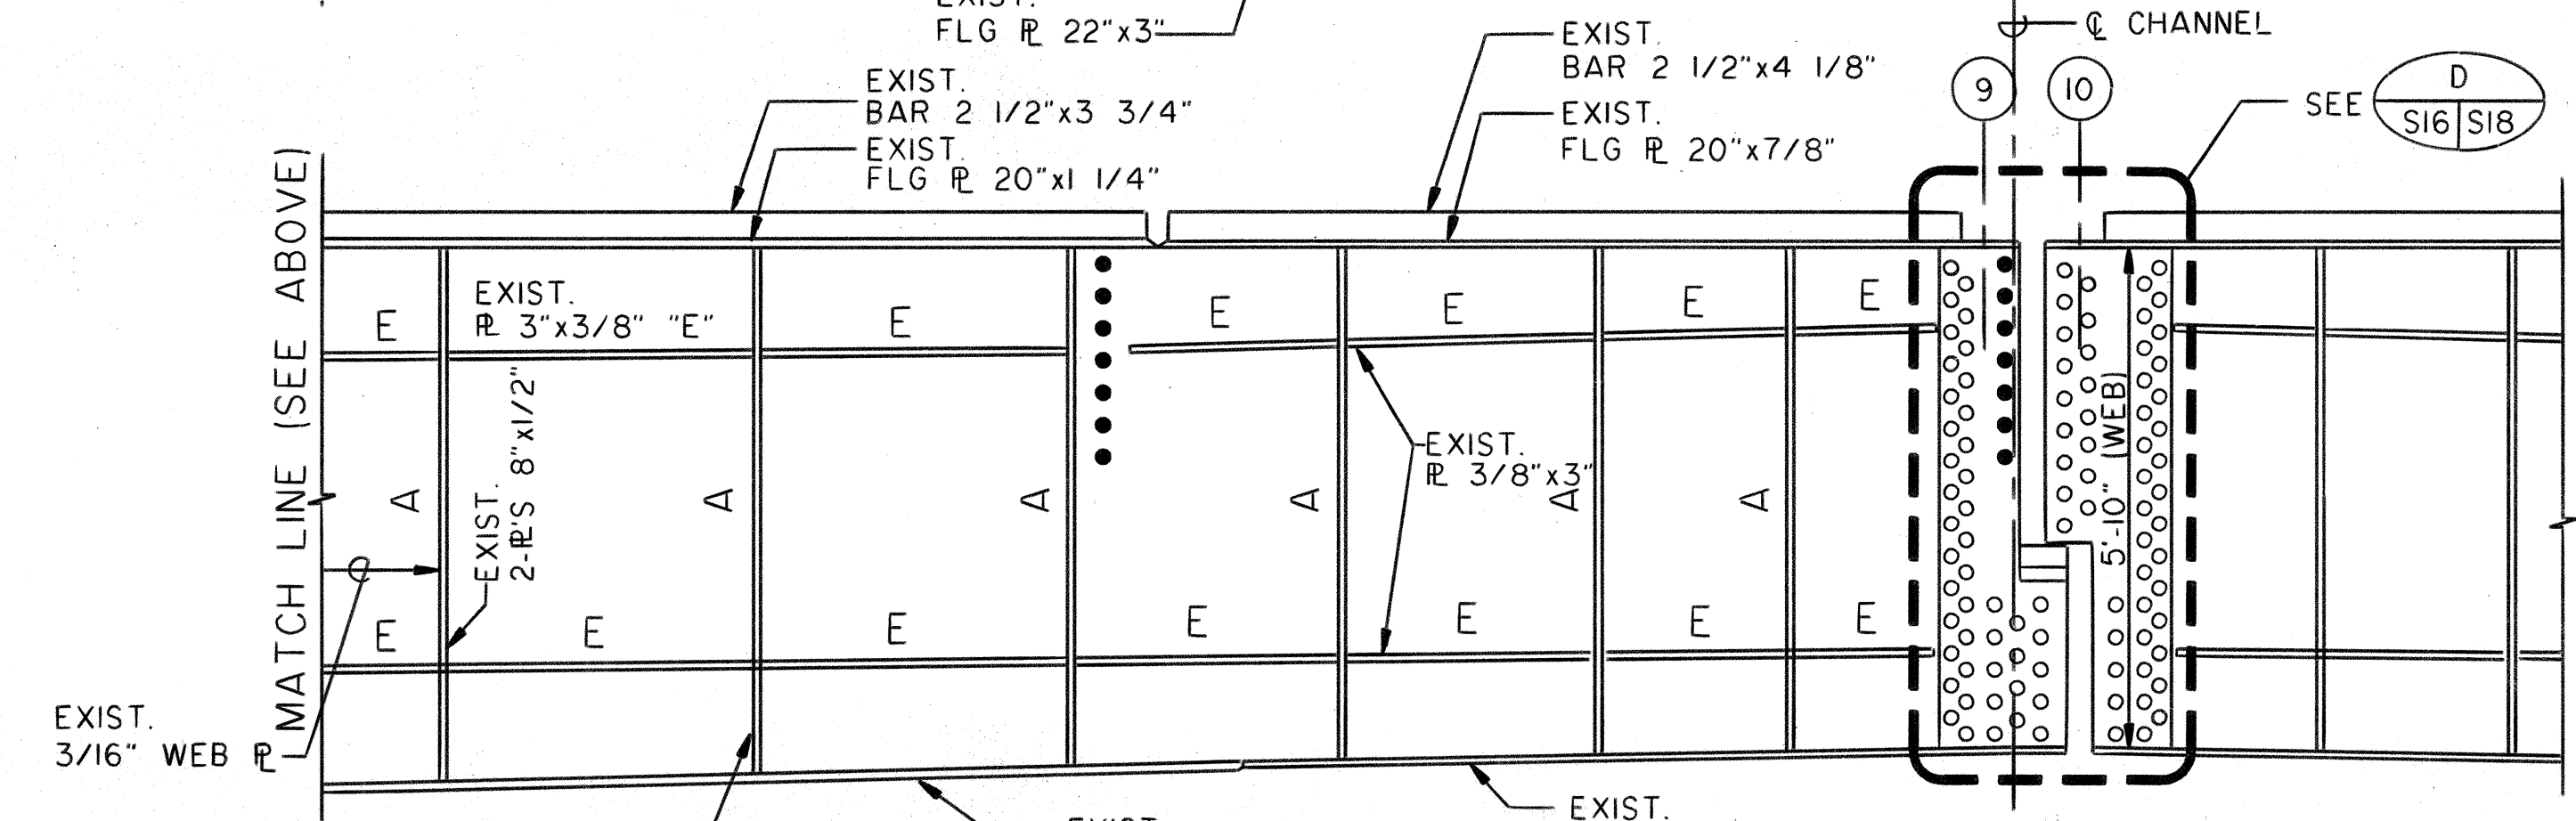


EXIST. MAIN GIRDER ELEVATION

SCALE : 1/2" = 1'-0"

NOTE:
EXISTING WEB PLATES, FLANGE PLATES
AND OTHER WELDED MATERIAL OVER 1"
THICK ARE CARBON STEEL ASTM A373. EXISTING
BOLTED AND OTHER WELDED MATERIAL 1"
OR LESS IN THICKNESS ARE ASTM A7 CARBON
STEEL.

EXISTING CONNECTIONS TYPICALLY USE
7/8"Ø HIGH STRENGTH BOLTS.

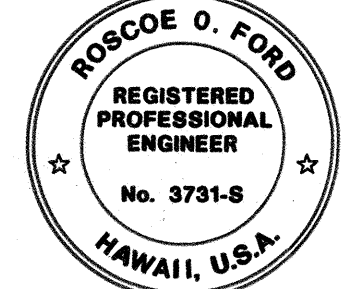

THIS WORK WAS PREPARED BY
ME OR UNDER MY SUPERVISION
Roscoe O. Ford

STATE OF HAWAII
DEPARTMENT OF TRANSPORTATION
HIGHWAYS DIVISION
MAIN GIRDER - PARTIAL
LONGITUDINAL ELEVATION


SAND ISLAND BASCULE BRIDGE
REHABILITATION PHASE II
PROJECT NO. BR-064-1(3)

SCALE: AS NOTED DATE: AUG. 15, 1991


SHEET No. S18 OF S21 SHEETS

DATE REVISION


FED. ROAD DIST. NO.	STATE	FED. AID PROJ. NO.	FISCAL YEAR	SHEET NO.	TOTAL SHEETS
HAWAII	HAW.	BR-064-1 (3)	1990	26	30

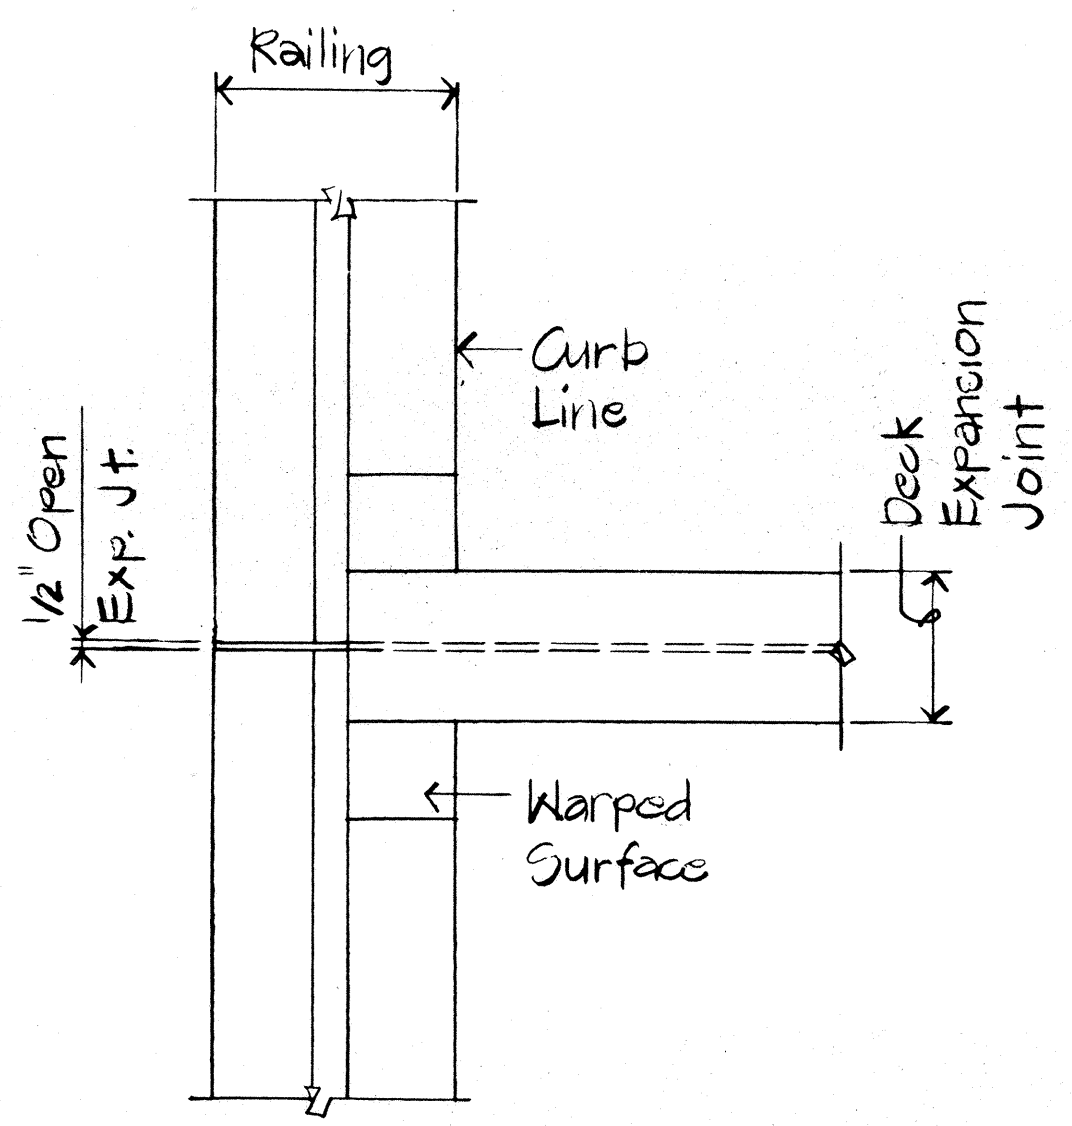


PLAN
Scale: 1" = 1'-0"
D
5/19/91

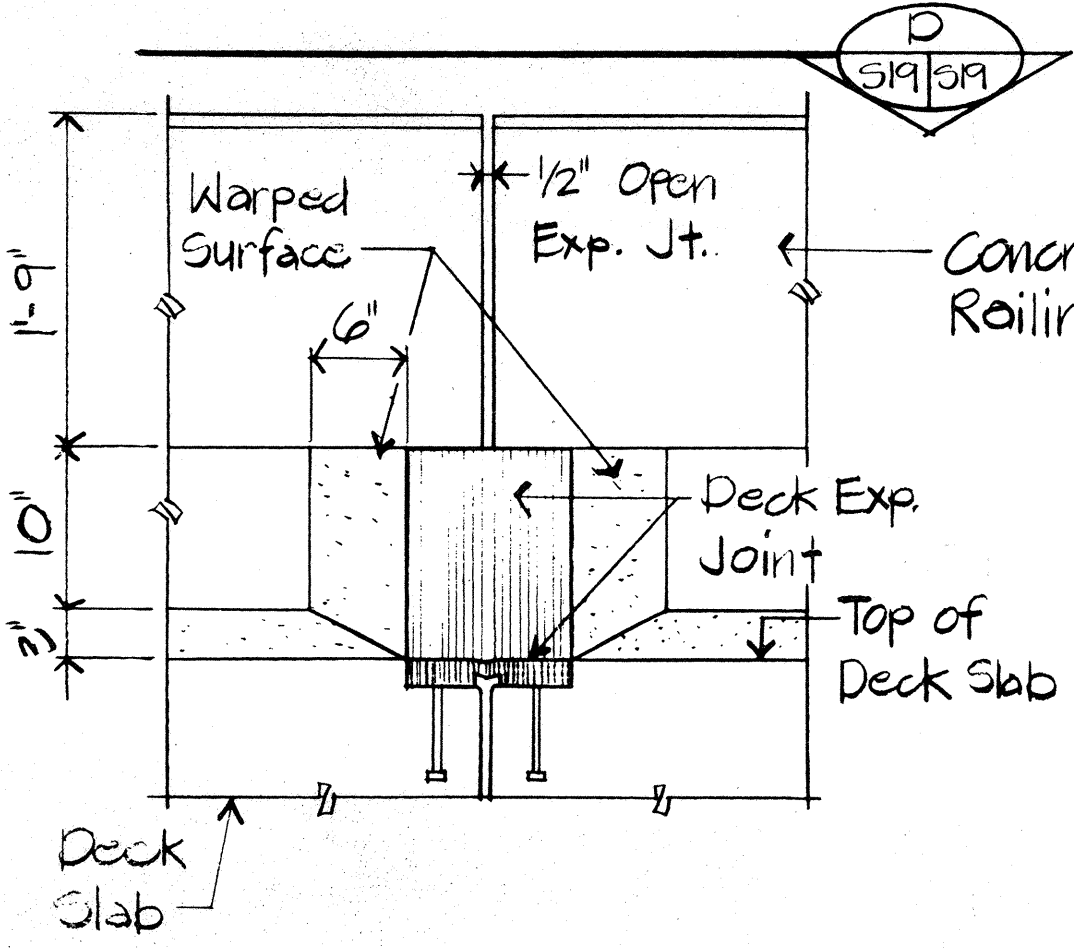


SECTION C
Scale: 1" = 1'-0"
C
5/19/91

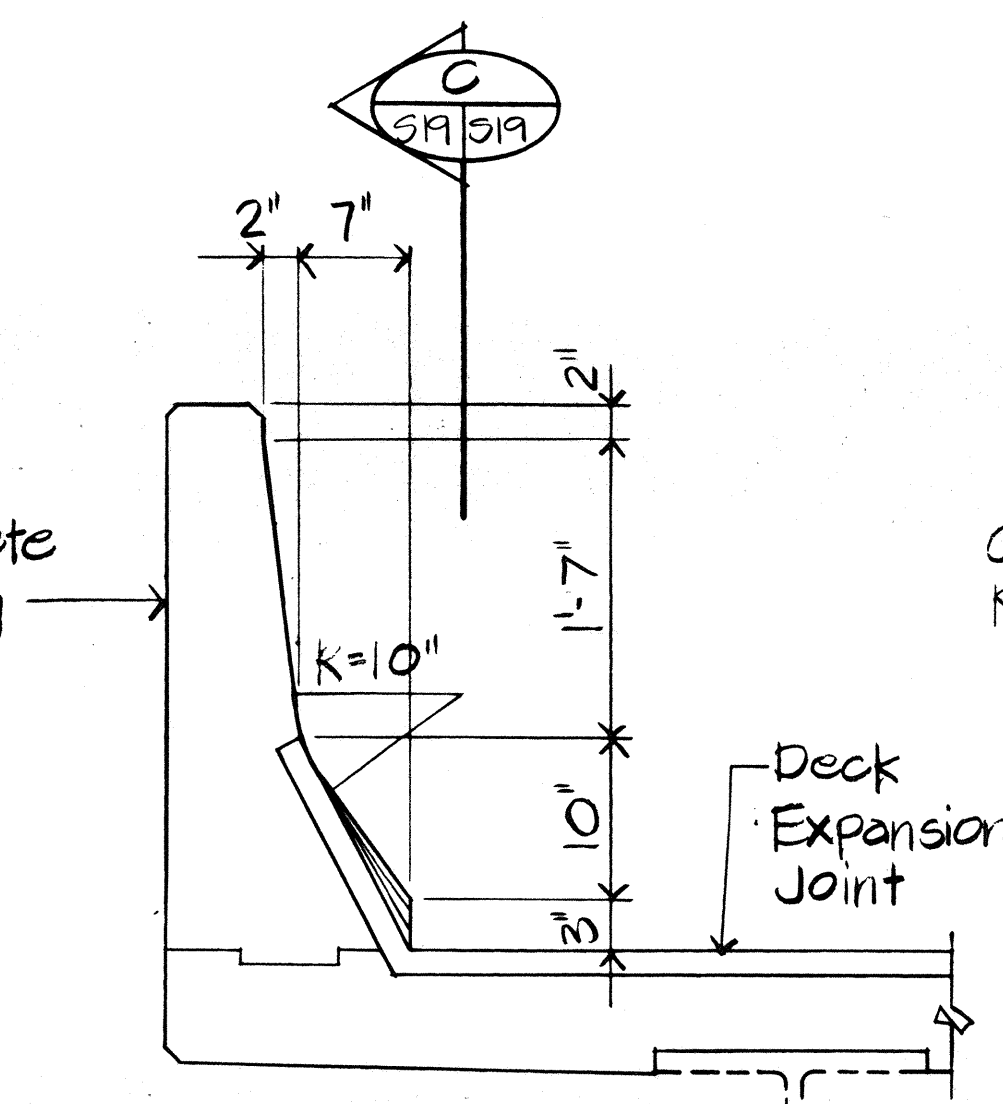

ALTERNATE DETAIL B
Scale: 1" = 1'-0"
B
5/19/91

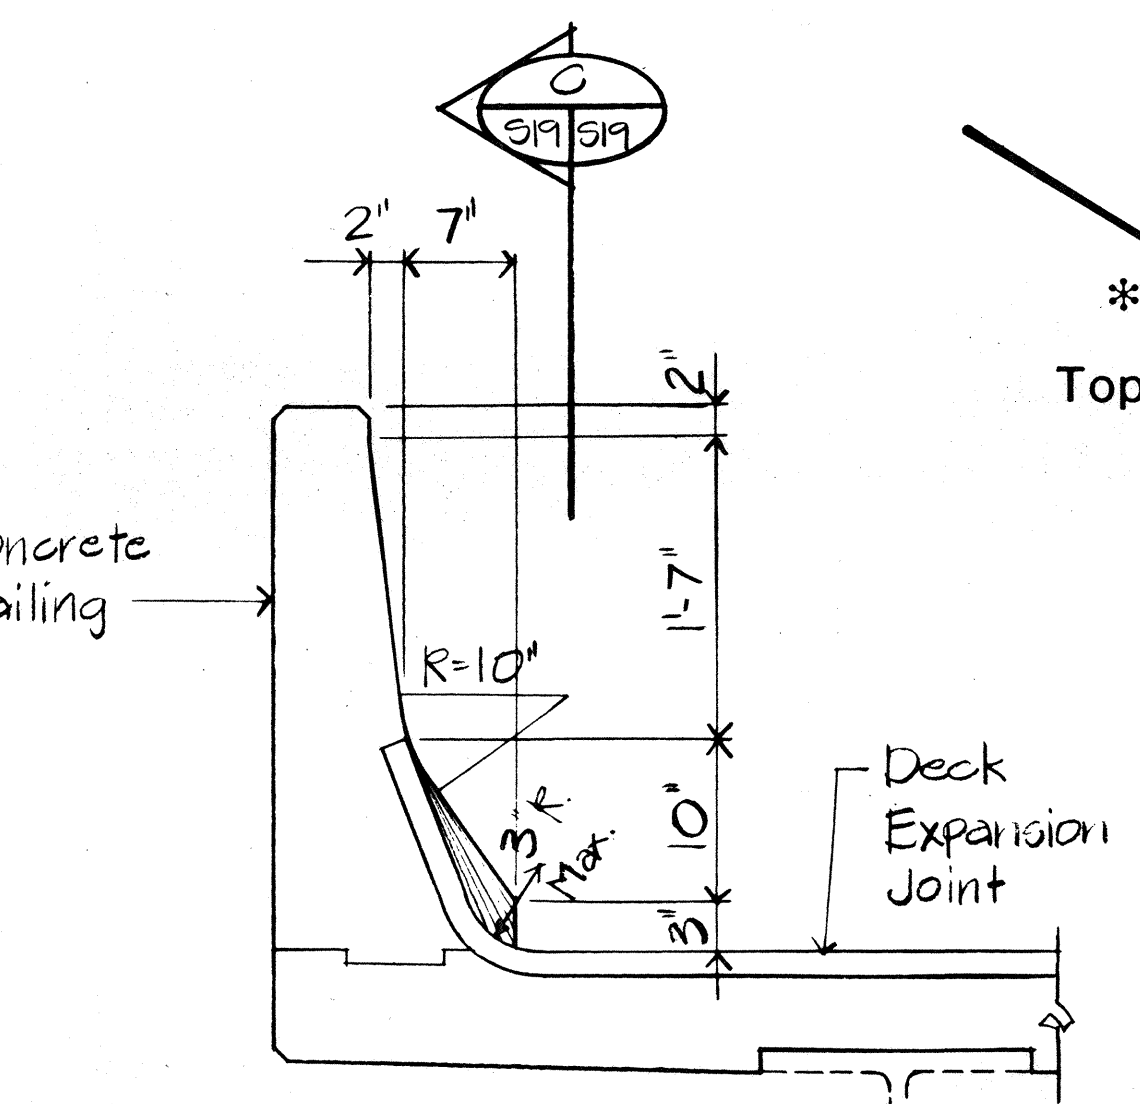


TYPICAL DETAIL A
Scale: 1" = 1'-0"
A
5/19/91

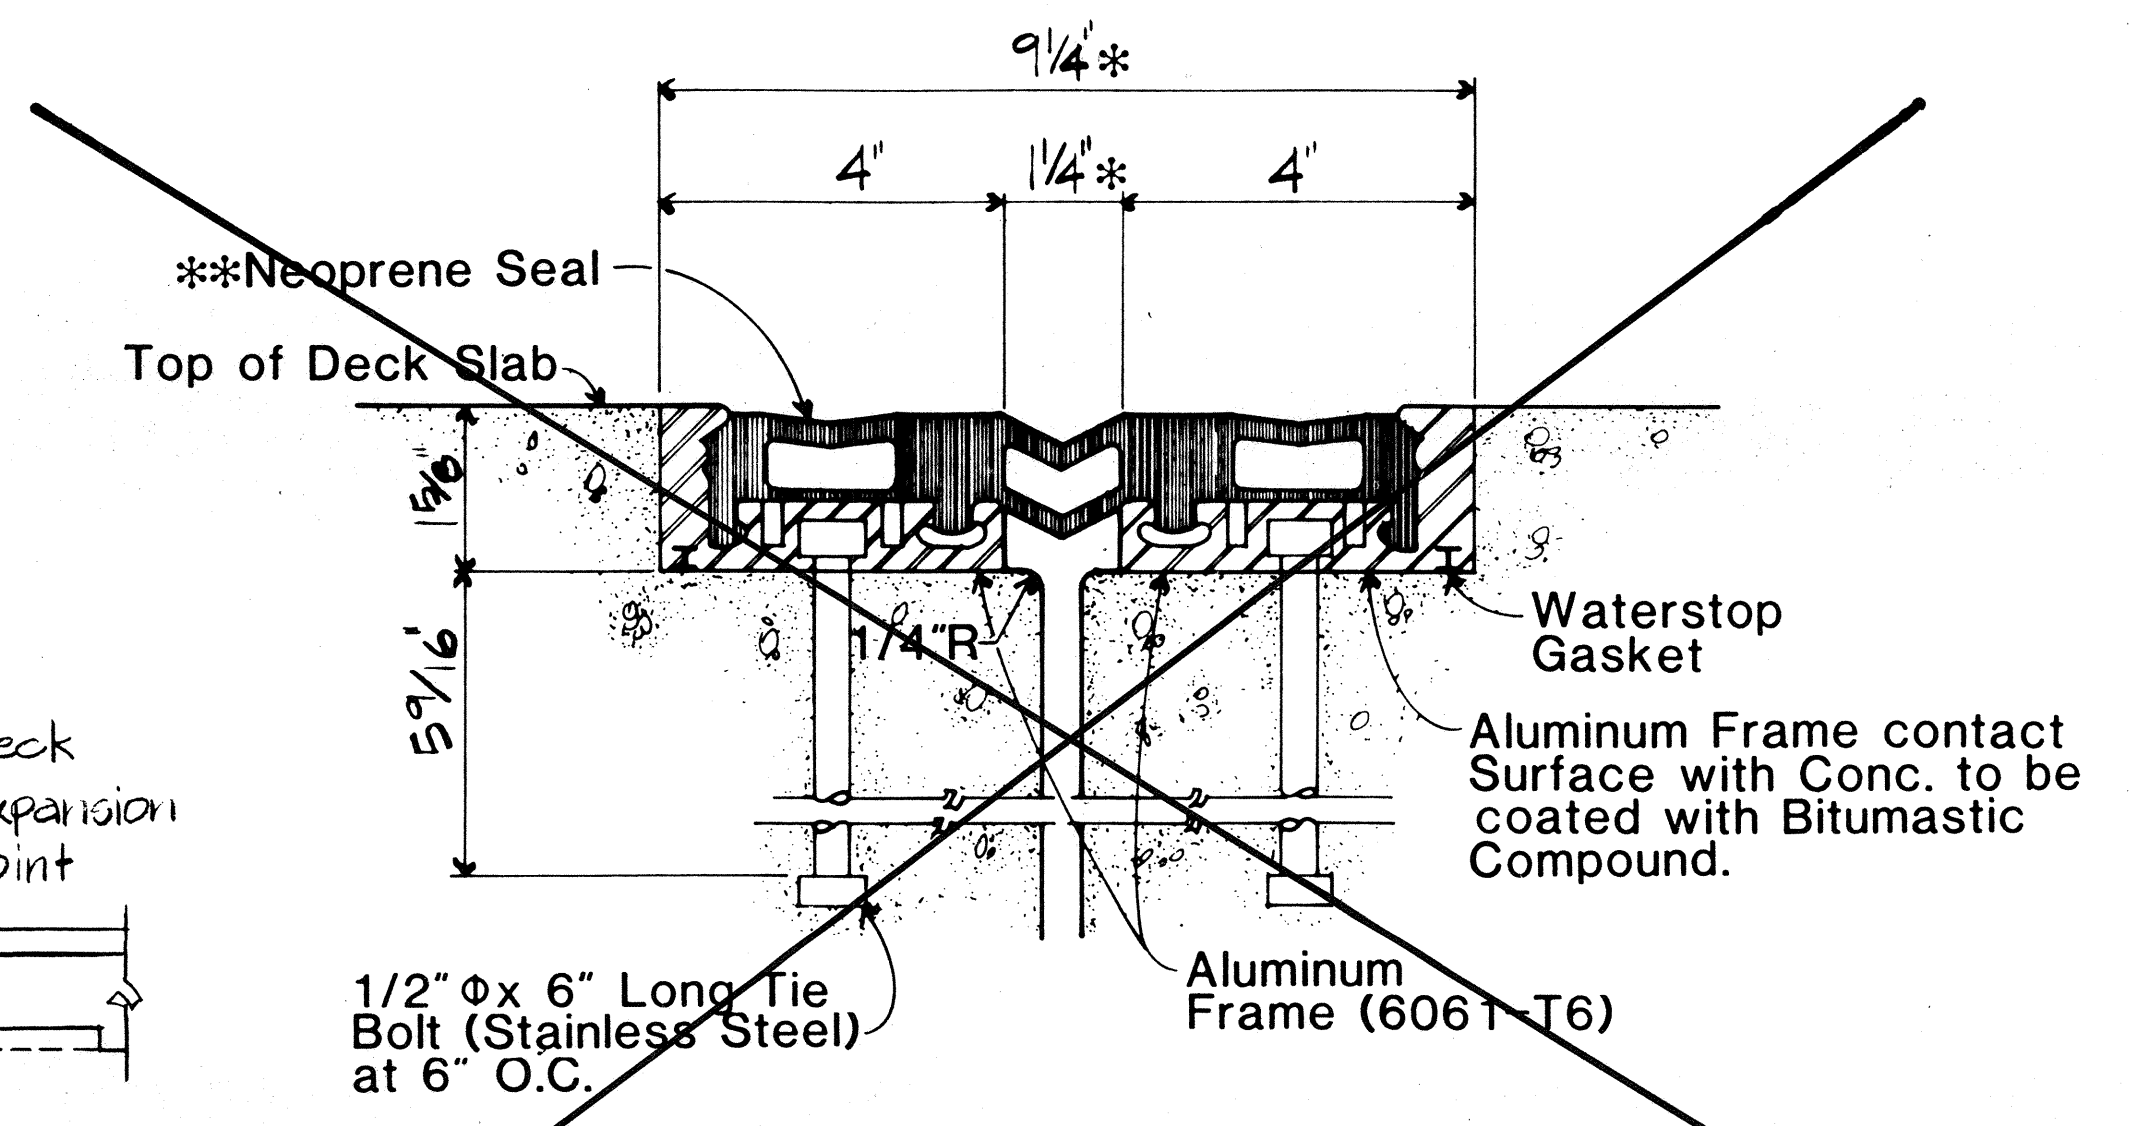


DELASTIFLEX TYPE SM200
Not to scale
(Manufacturer: D.S. Brown & Co.)


Prior to Pouring Hatched Areas, Coat all Surfaces in Contact w/ Fresh Concrete w/ an Epoxy Adhesive (Incidental to Concrete in Bascule Bridge Span)

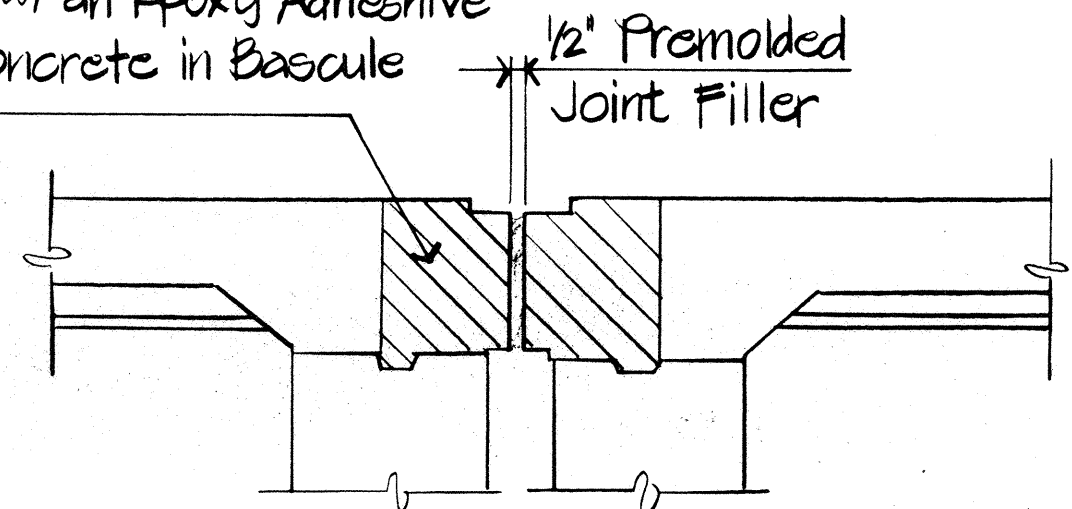

Hatched Areas shall be poured a Minimum of 28 Days after the Deck Slab has been poured. Expansion Joint Anchor Devices shall be located and secure on final positions per Manufacturer's Requirements.


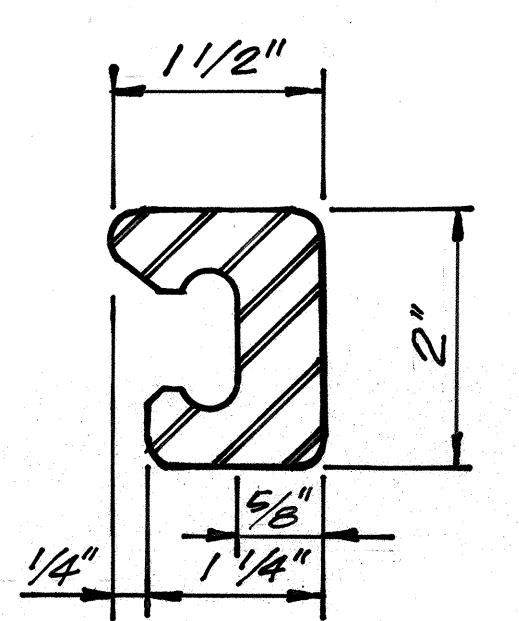


SSA STEEL RAIL

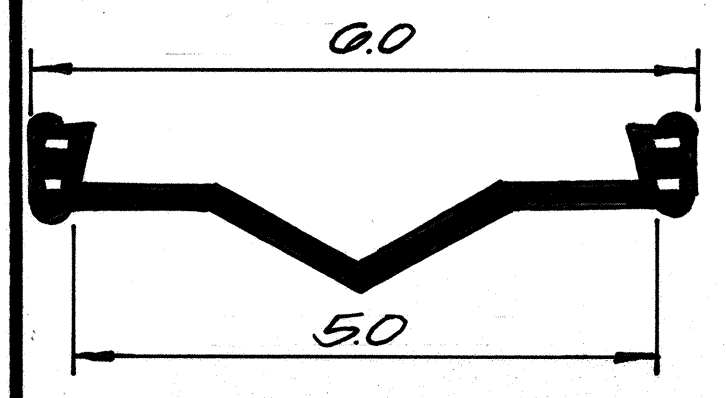


400L NEOPRENE EXTRUSION

STEELFLEX-STRIP SEAL EXPANSION JOINT SYSTEMS
Not to Scale (Manufacturer: The D.S. Brown Company)
Substitute - Field Change No. 2

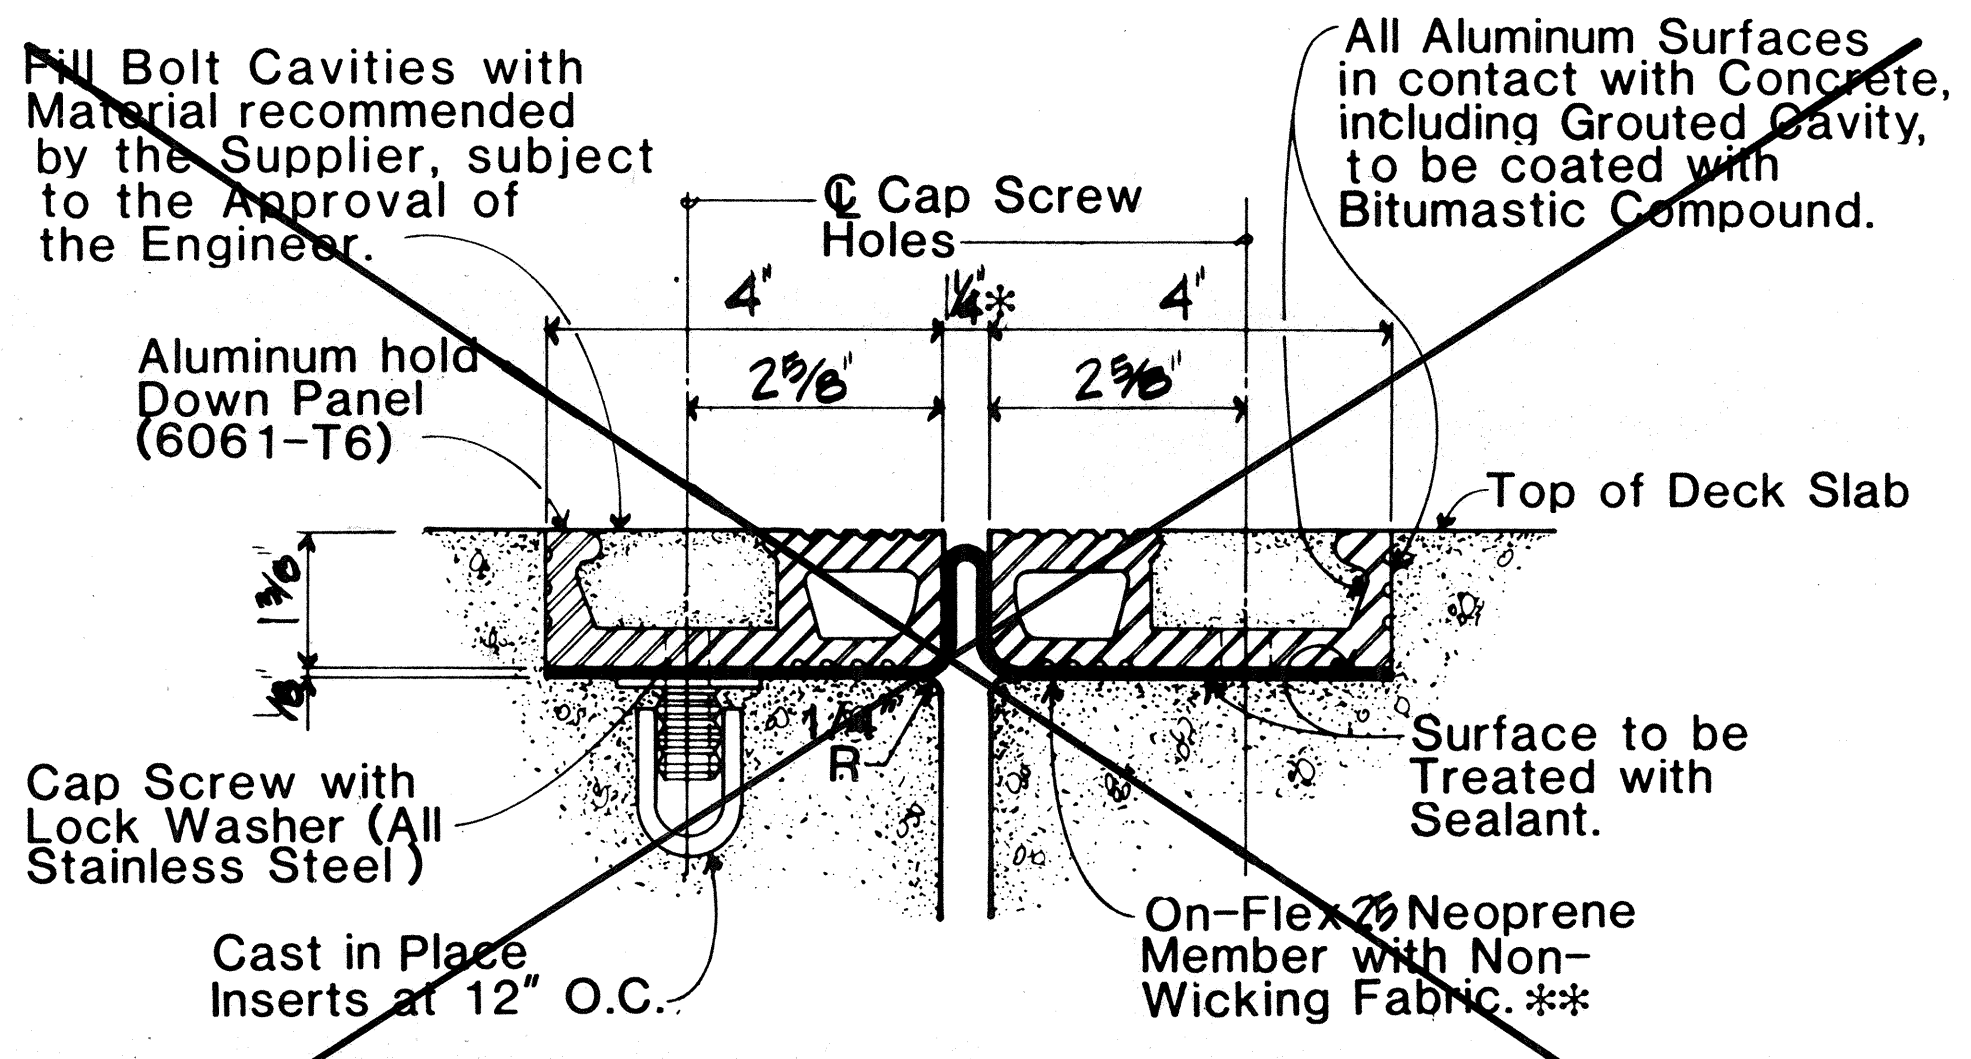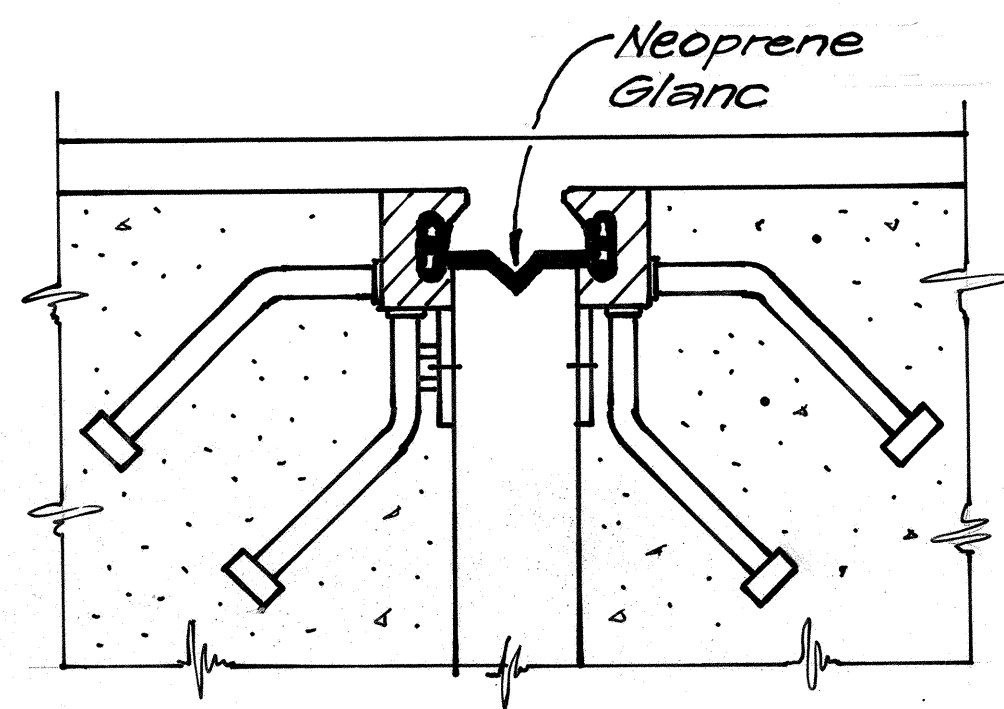

ON-FLEX 25
Not to scale
(Manufacturer: Structural Accessories Inc.)

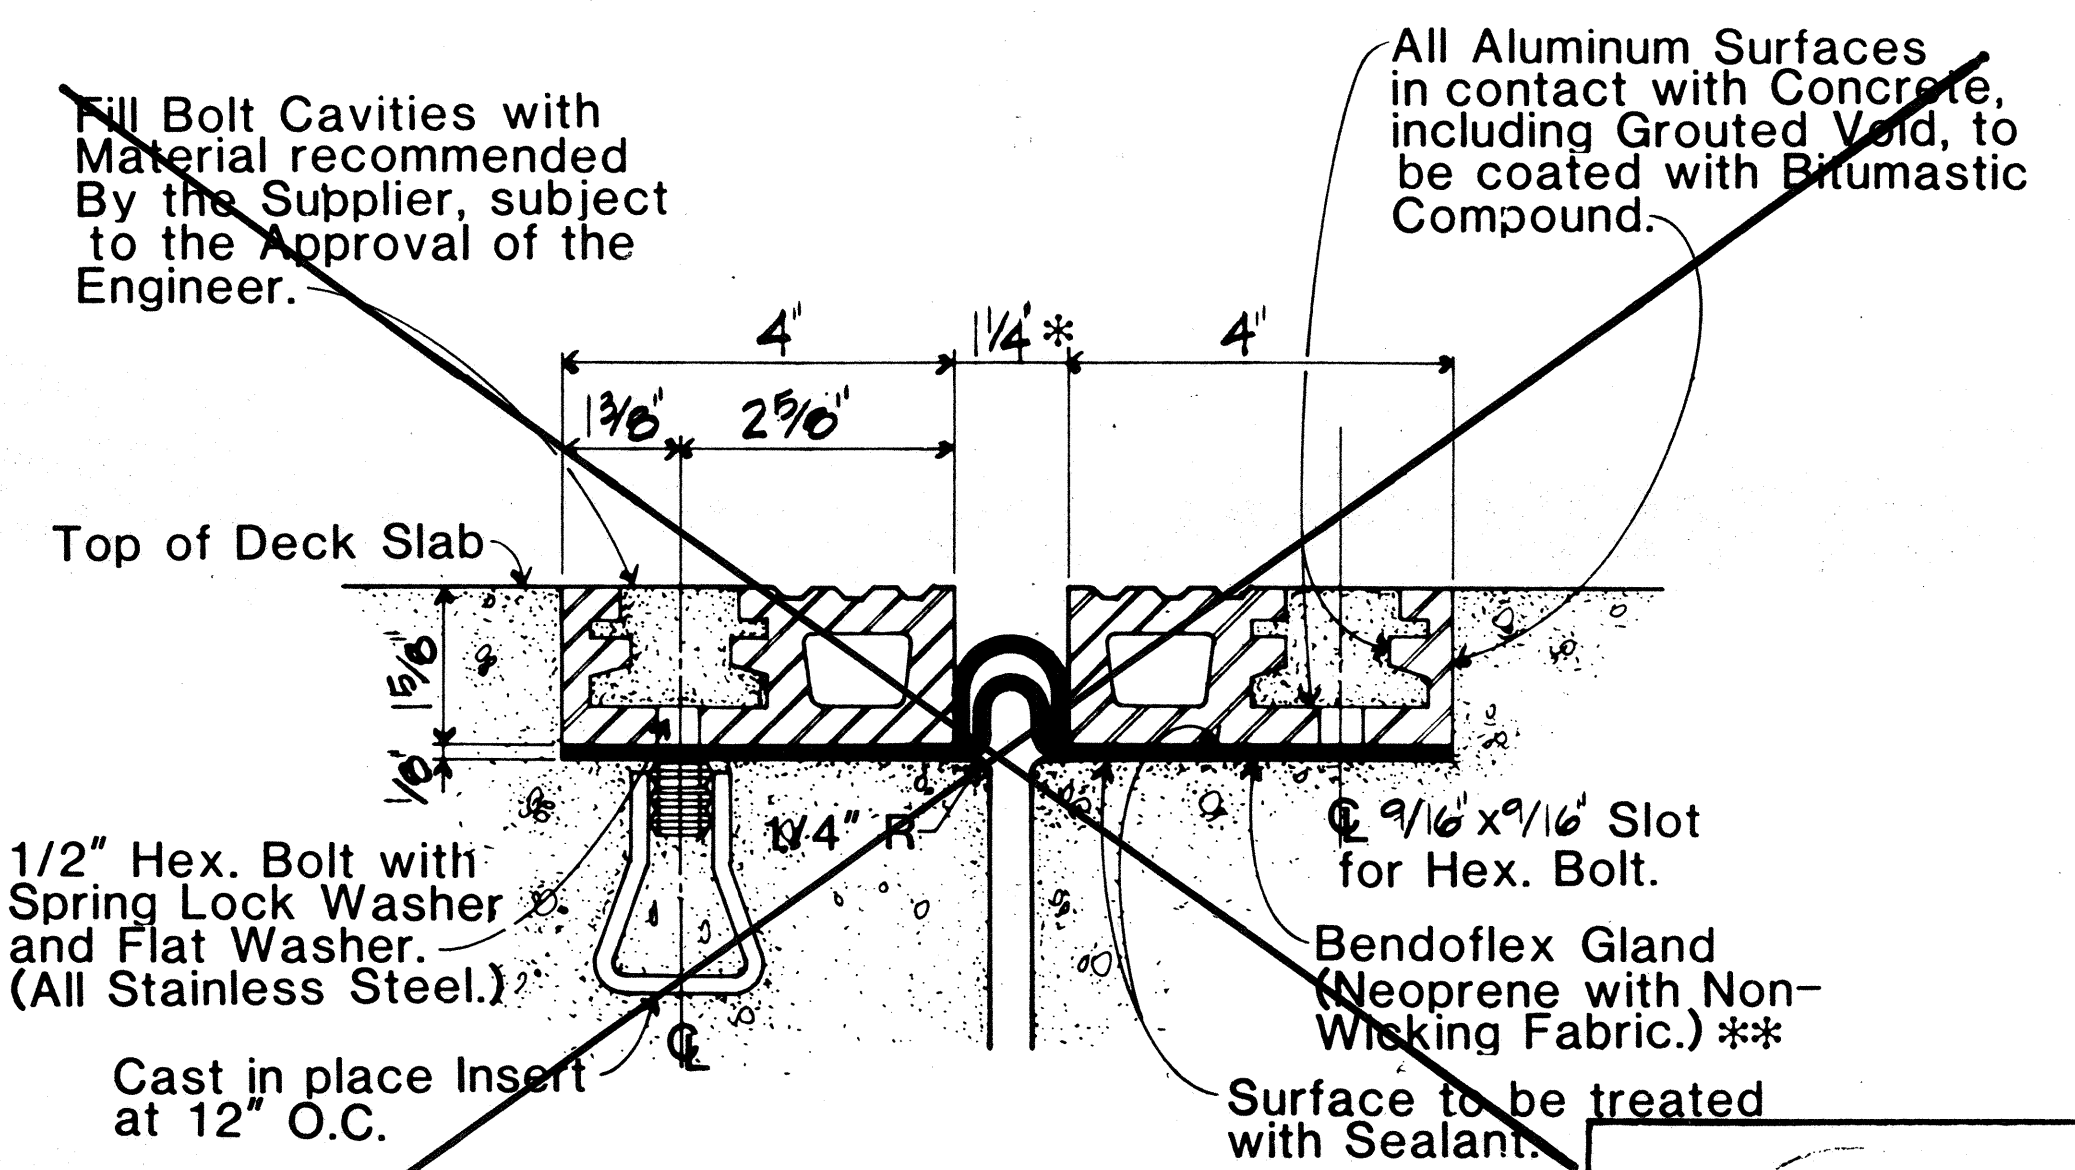

WABO BENDOFLEX 250
Not to scale
(Manufacturer: Watson Bowman Assoc. Inc.)

DECK EXPANSION JOINT NOTES






- Three Alternate Deck Expansion Joint Systems are shown. Contractor has the Option of selecting any One of the Systems. The Contractor shall submit Detailed Shop Drawings of the selected Joint to the Engineer for Approval.
 - The Contractor also has the Option of using an Alternate Expansion Joint System provided it complies with the Plans and Specifications.
- *Installation Width at 75° F.
**Seal Gland or Membrane shall be continuous across the Full Width of the Structure.

THIS WORK WAS PREPARED BY ME OR UNDER MY SUPERVISION
Signature
Date

STATE OF HAWAII
DEPARTMENT OF TRANSPORTATION
HIGHWAYS DIVISION
DECK EXPANSION JOINT DETAILS
SAND ISLAND BASCULE BRIDGE
REHABILITATION PHASE II
PROJECT NO. BR-064-1 (3)
SCALE: AS NOTED DATE: MARCH 1991
SHEET NO. S19 OF S21 SHEETS

DATE	REVISION

FED. ROAD DIST. NO.	STATE	FED. AID PROJ. NO.	FISCAL YEAR	SHEET NO.	TOTAL SHEETS
HAWAII	HAW.	BR-064-1(3)	1991	27	38

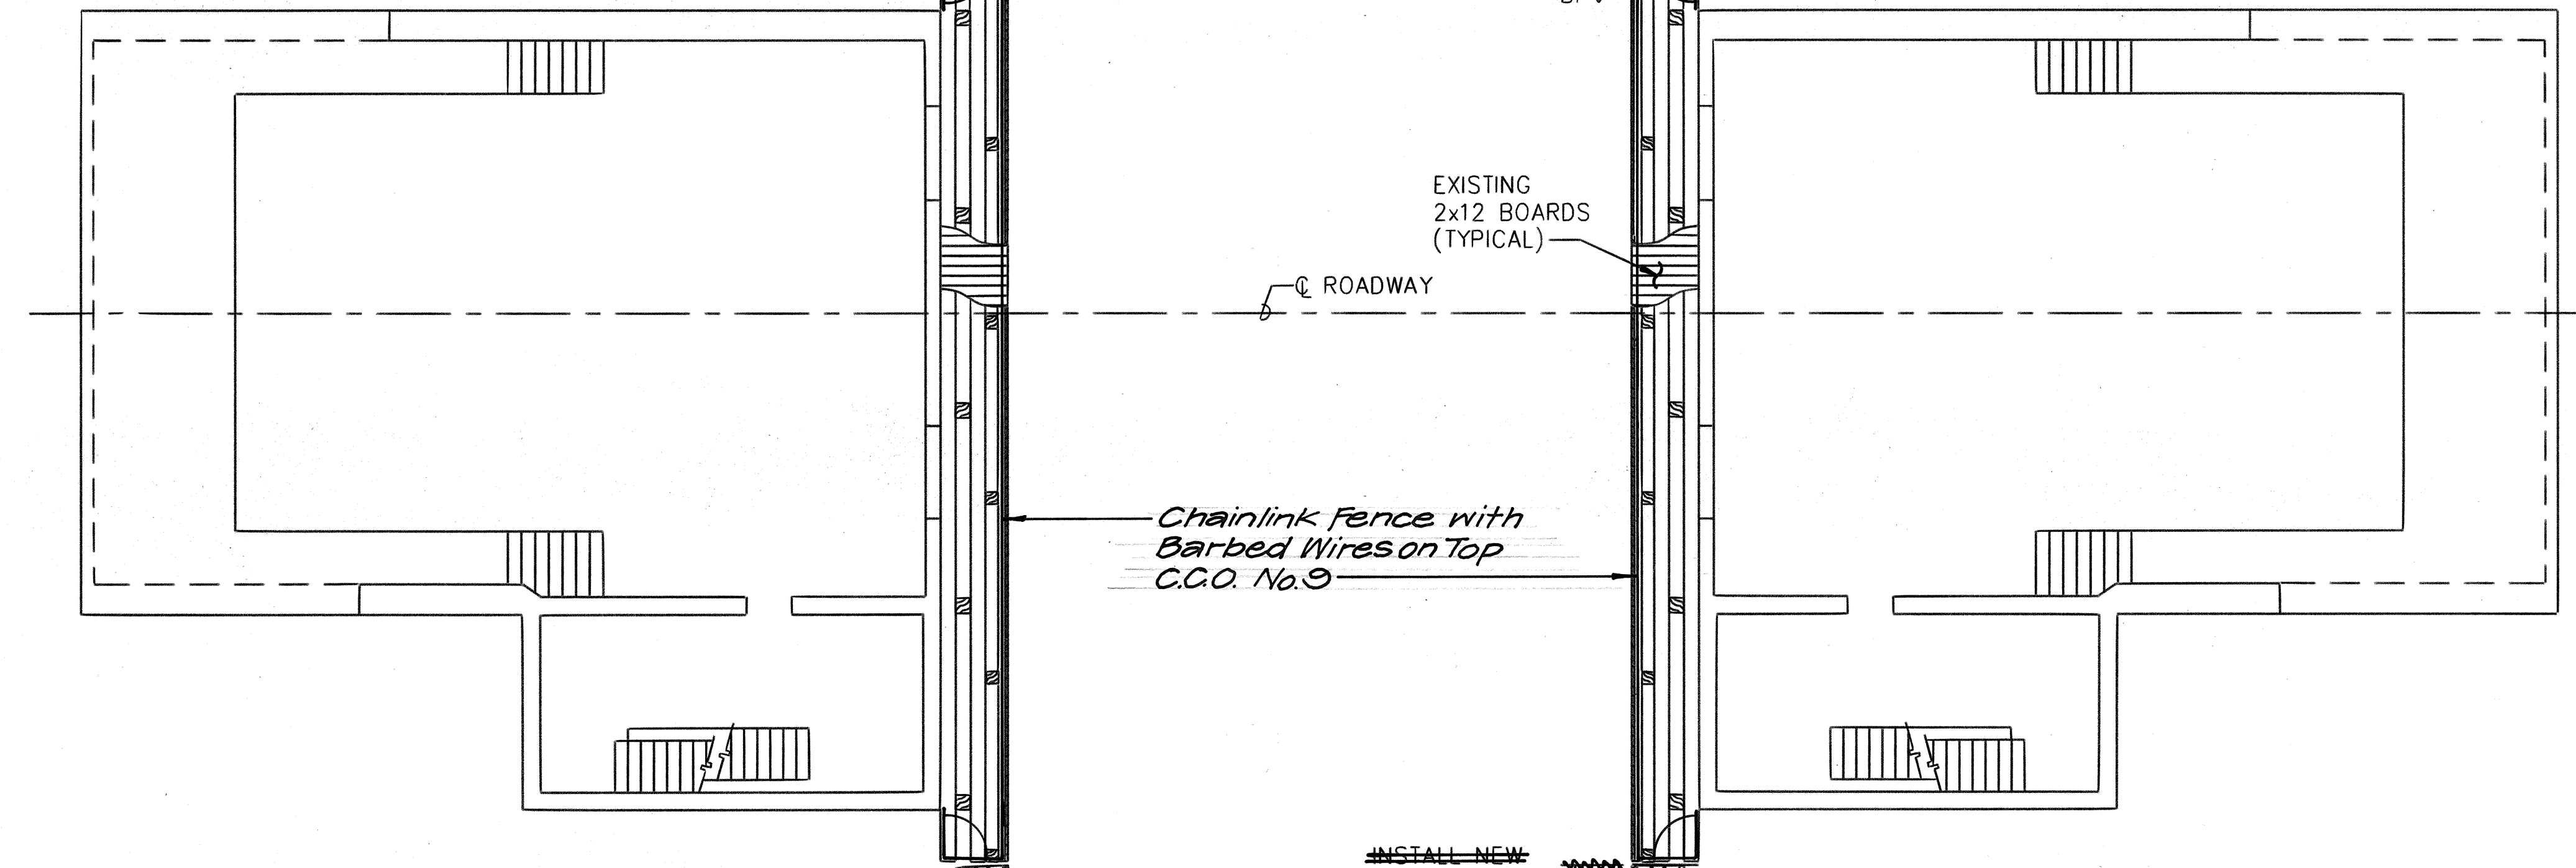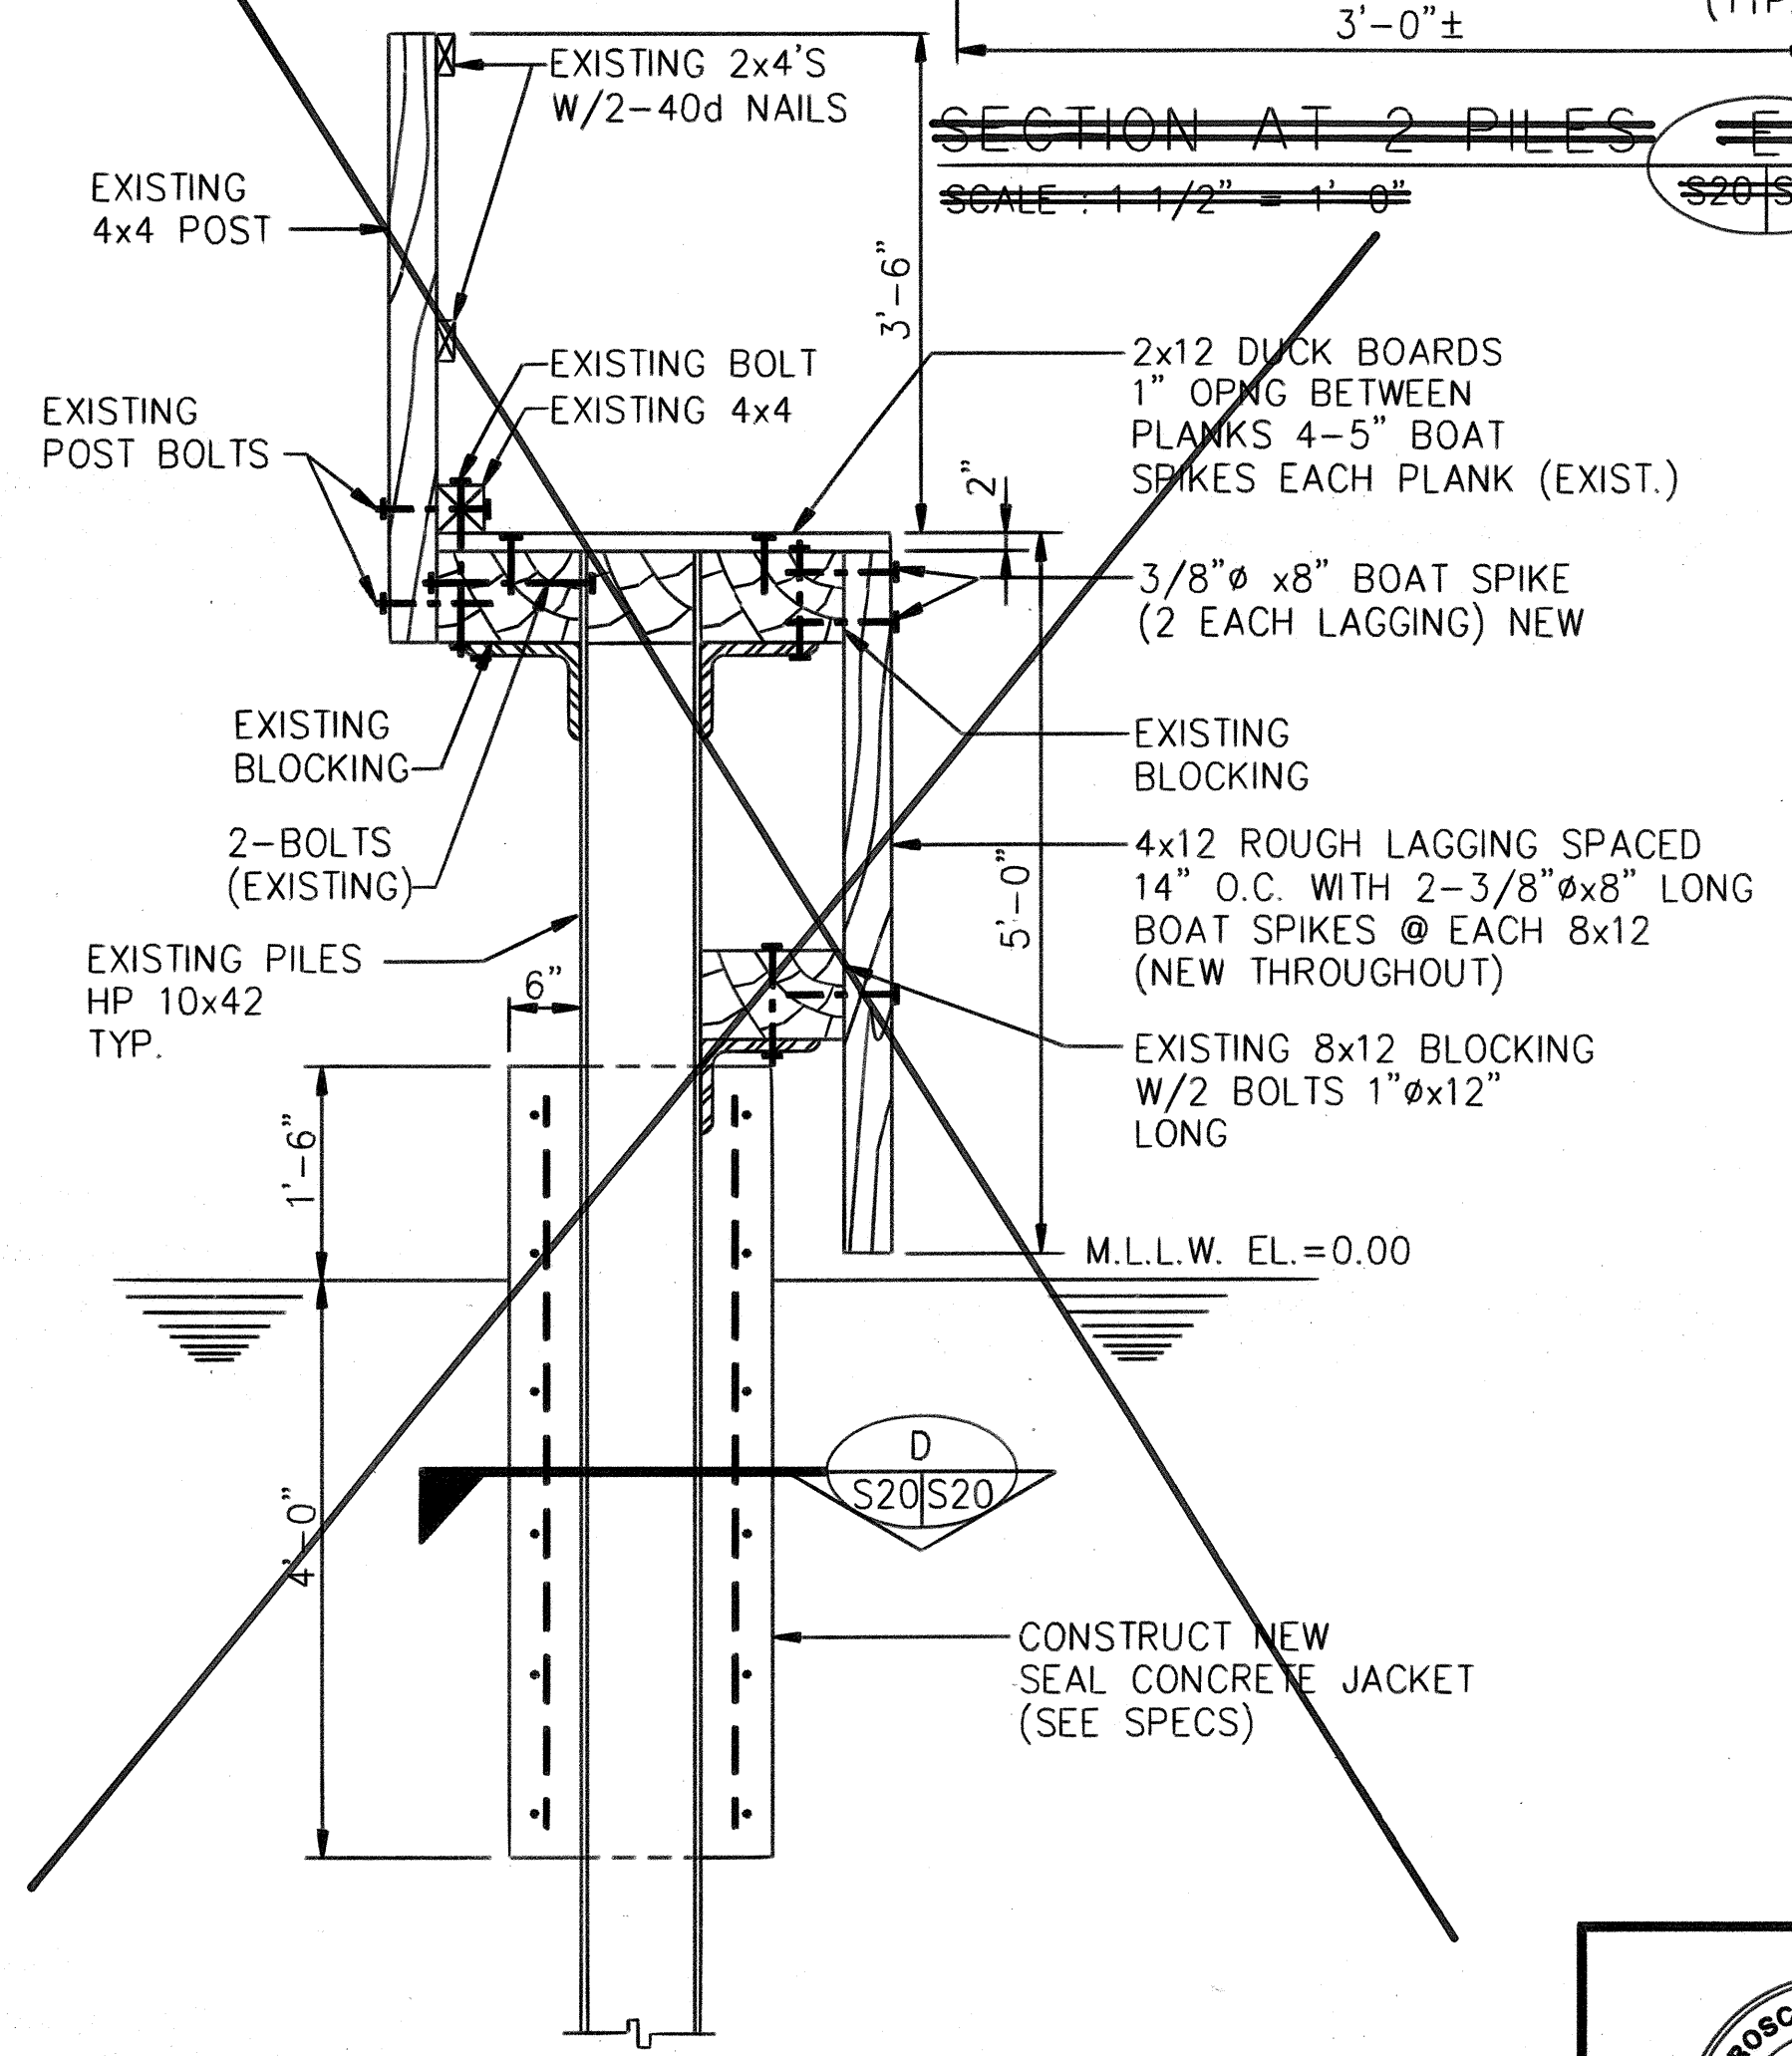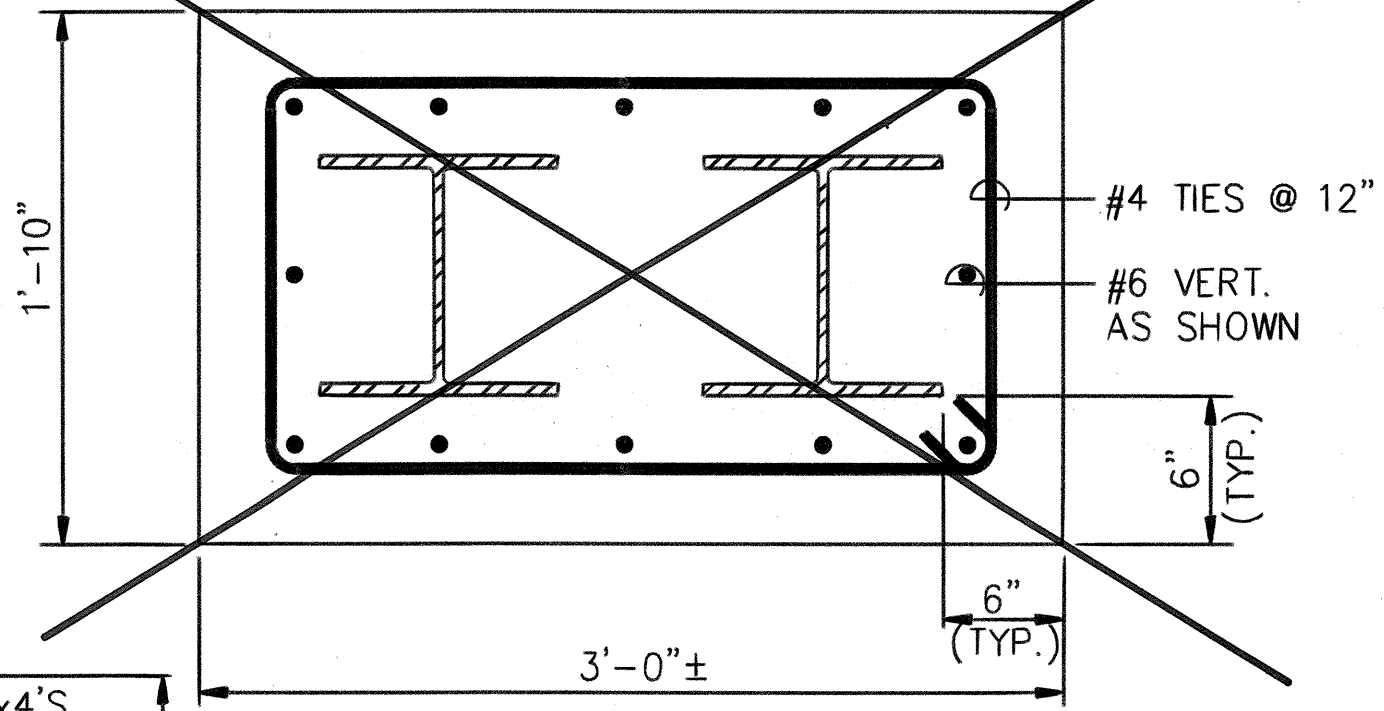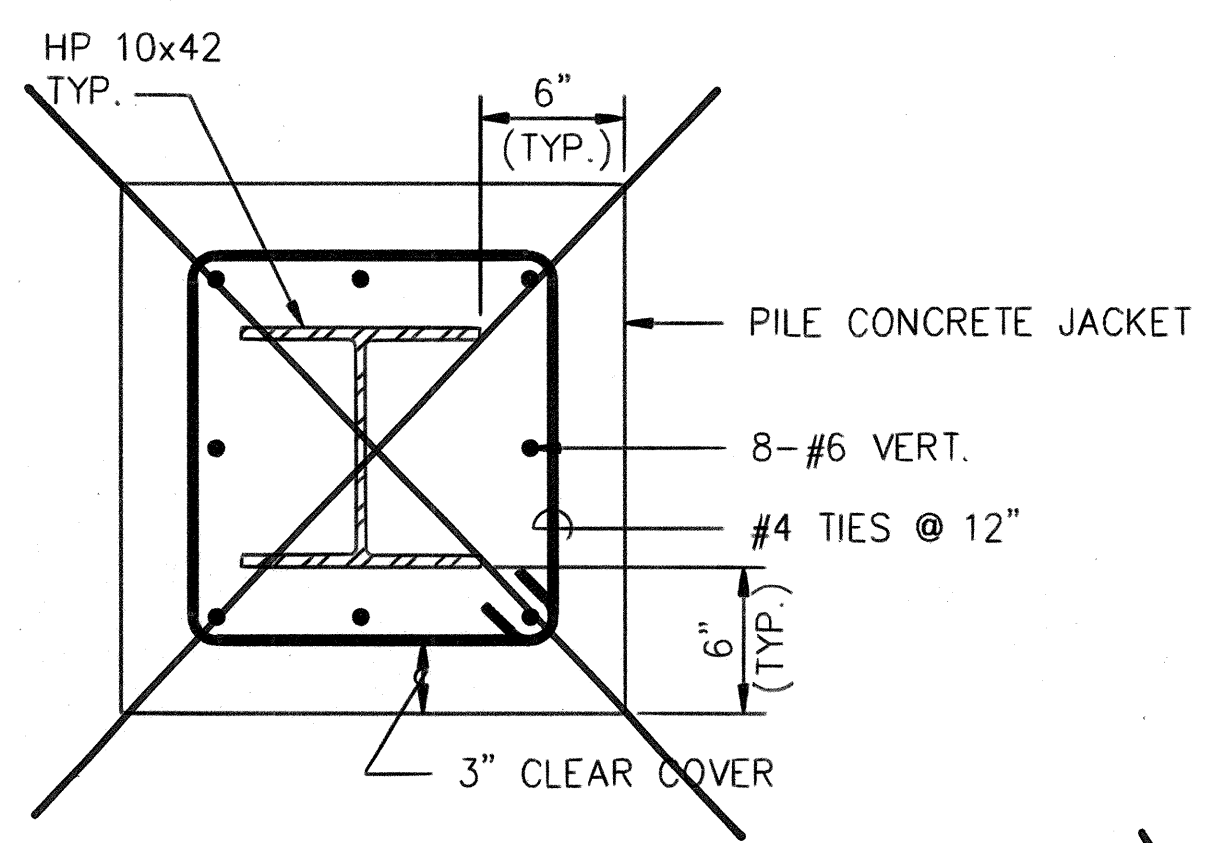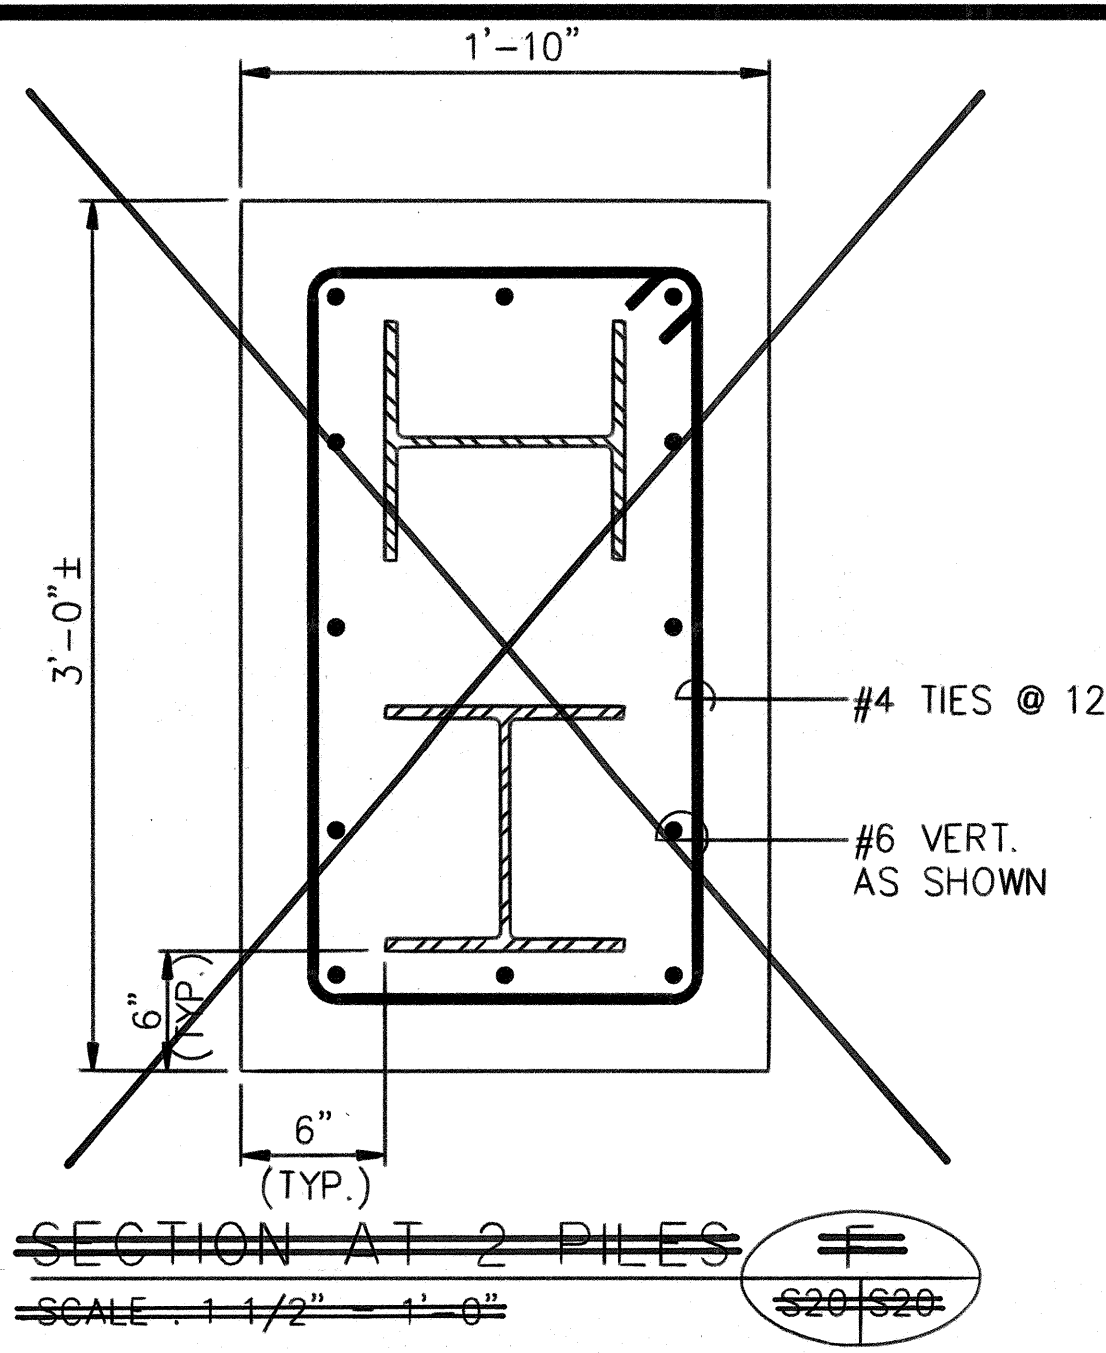

PLAN-SECTION
SCALE : 1/8" = 1'-0"

PLAN-SECTION
SCALE : 1/8" = 1'-0"

SECTION TYPICAL
SCALE : 3/4" = 1'-0"

- NOTES:
1. BP INDICATES BATTER PILE.
 2. ALL PILES TO HAVE NEW JACKETS.
 3. BATTER PILES TO HAVE INDIVIDUAL JACKETS.

THIS WORK WAS PREPARED BY ME OR UNDER MY SUPERVISION

Roscoe O. Ford

STATE OF HAWAII
DEPARTMENT OF TRANSPORTATION
HIGHWAYS DIVISION

FENDER SECTIONS
AND DETAILS

SAND ISLAND BASCULE BRIDGE
REHABILITATION PHASE II
PROJECT NO. BR-064-1(3)

SCALE: AS NOTED DATE: AUG. 15, 1991


SHEET No. S20 OF S21 SHEETS

SURVEY PLOTTED BY	DATE
DRAWN BY	
DESIGNED BY	
QUANTITIES BY	
CHECKED BY	
ORIGINAL PLAN	
NOTEBOOK	
No.	


DATE	REVISION

FED. ROAD DIST. NO.	STATE	FED. AID PROJ. NO.	FISCAL YEAR	SHEET NO.	TOTAL SHEETS
HAWAII	HAW.	BR-064-1(3)	1991	28	38


- NOTES:
- CAP PL TAPERED BOX SPACER BLOCK SHALL BE FABRICATED FROM ASTM A36 STEEL AND HOT-DIP GALVANIZED AFTER FABRICATIONS.
 - CAP PL(s), TAPERED BOX SPACER BLOCK, ANCHOR BOLTS INCLUDING NUTS AND WASHERS AND OTHER APPURTENANCES SHALL BE INCIDENTAL TO BEAM TYPE GUARDRAIL AND WILL NOT BE PAID FOR SEPARATELY.

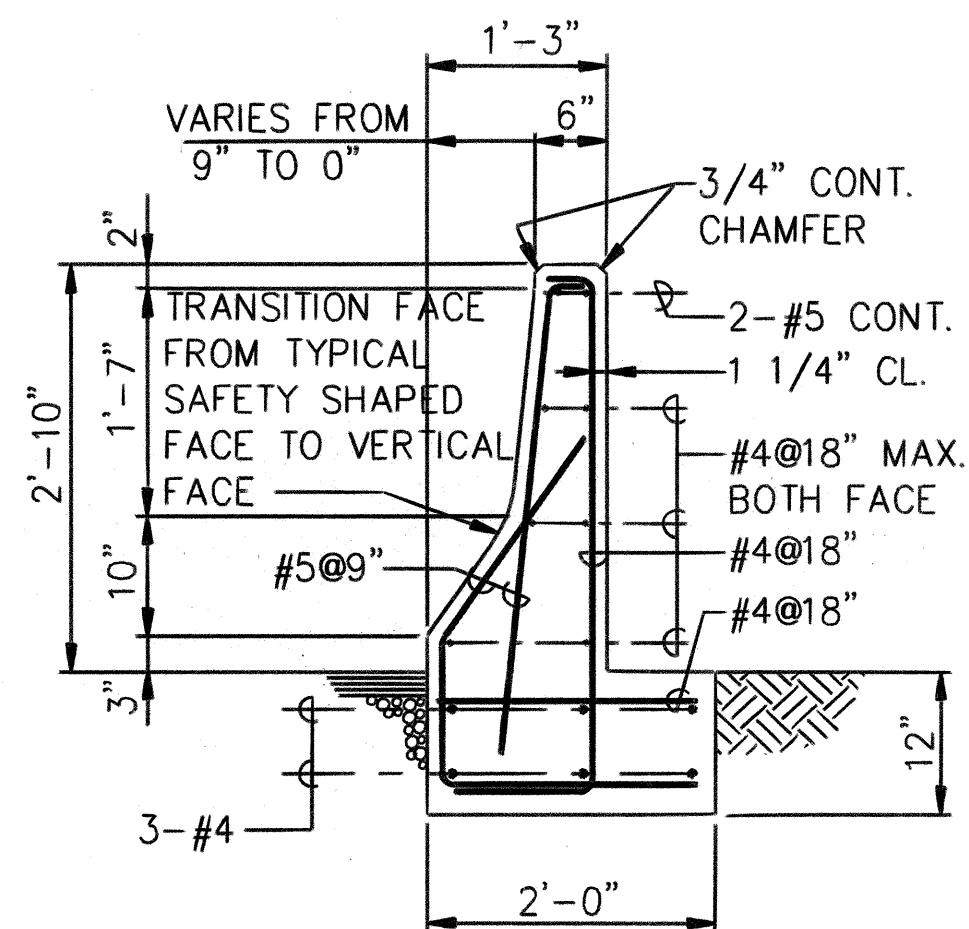


SECTION A
SCALE : 3/4" = 1'-0"

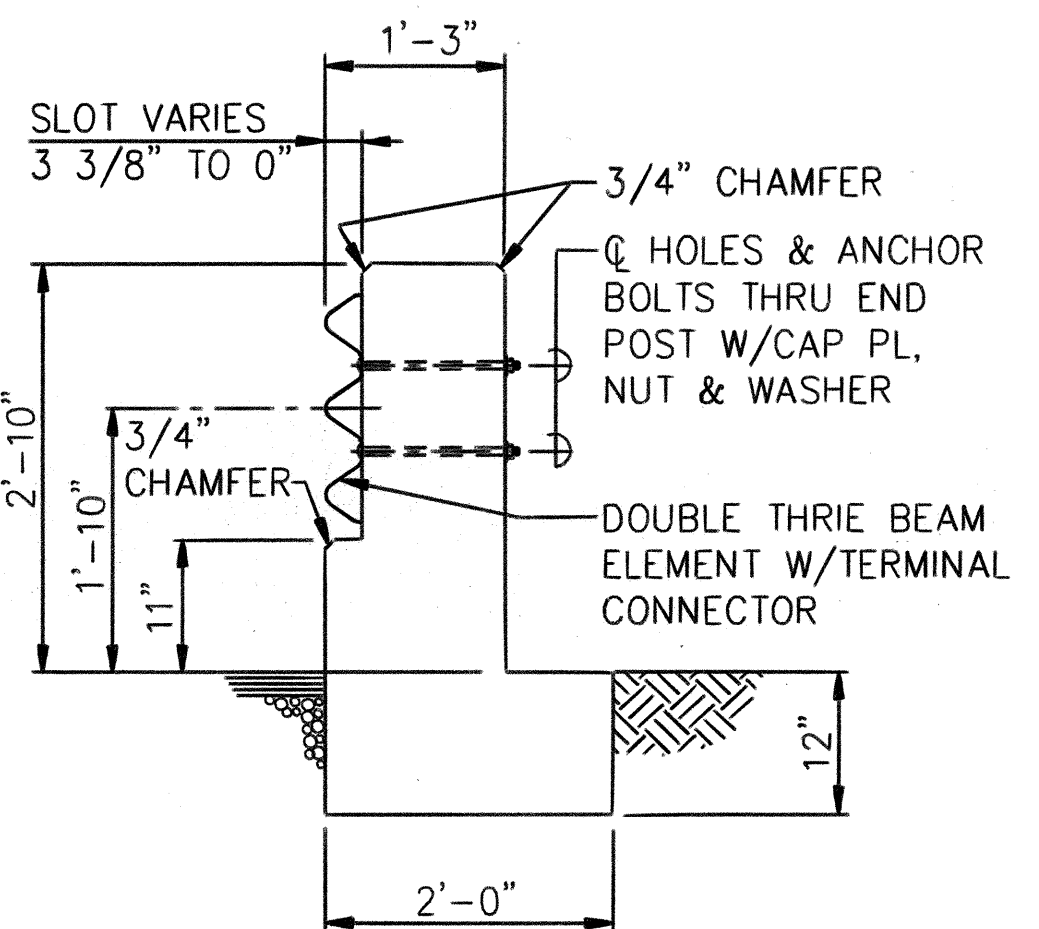


SECTION B
SCALE : 3/4" = 1'-0"

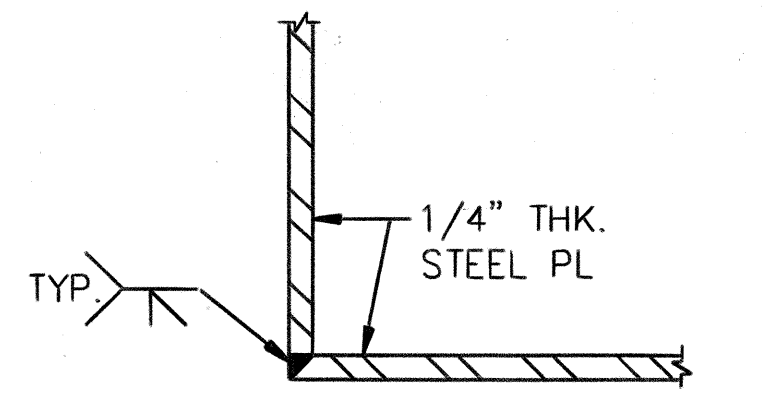

DETAIL S21/S21
NOT TO SCALE

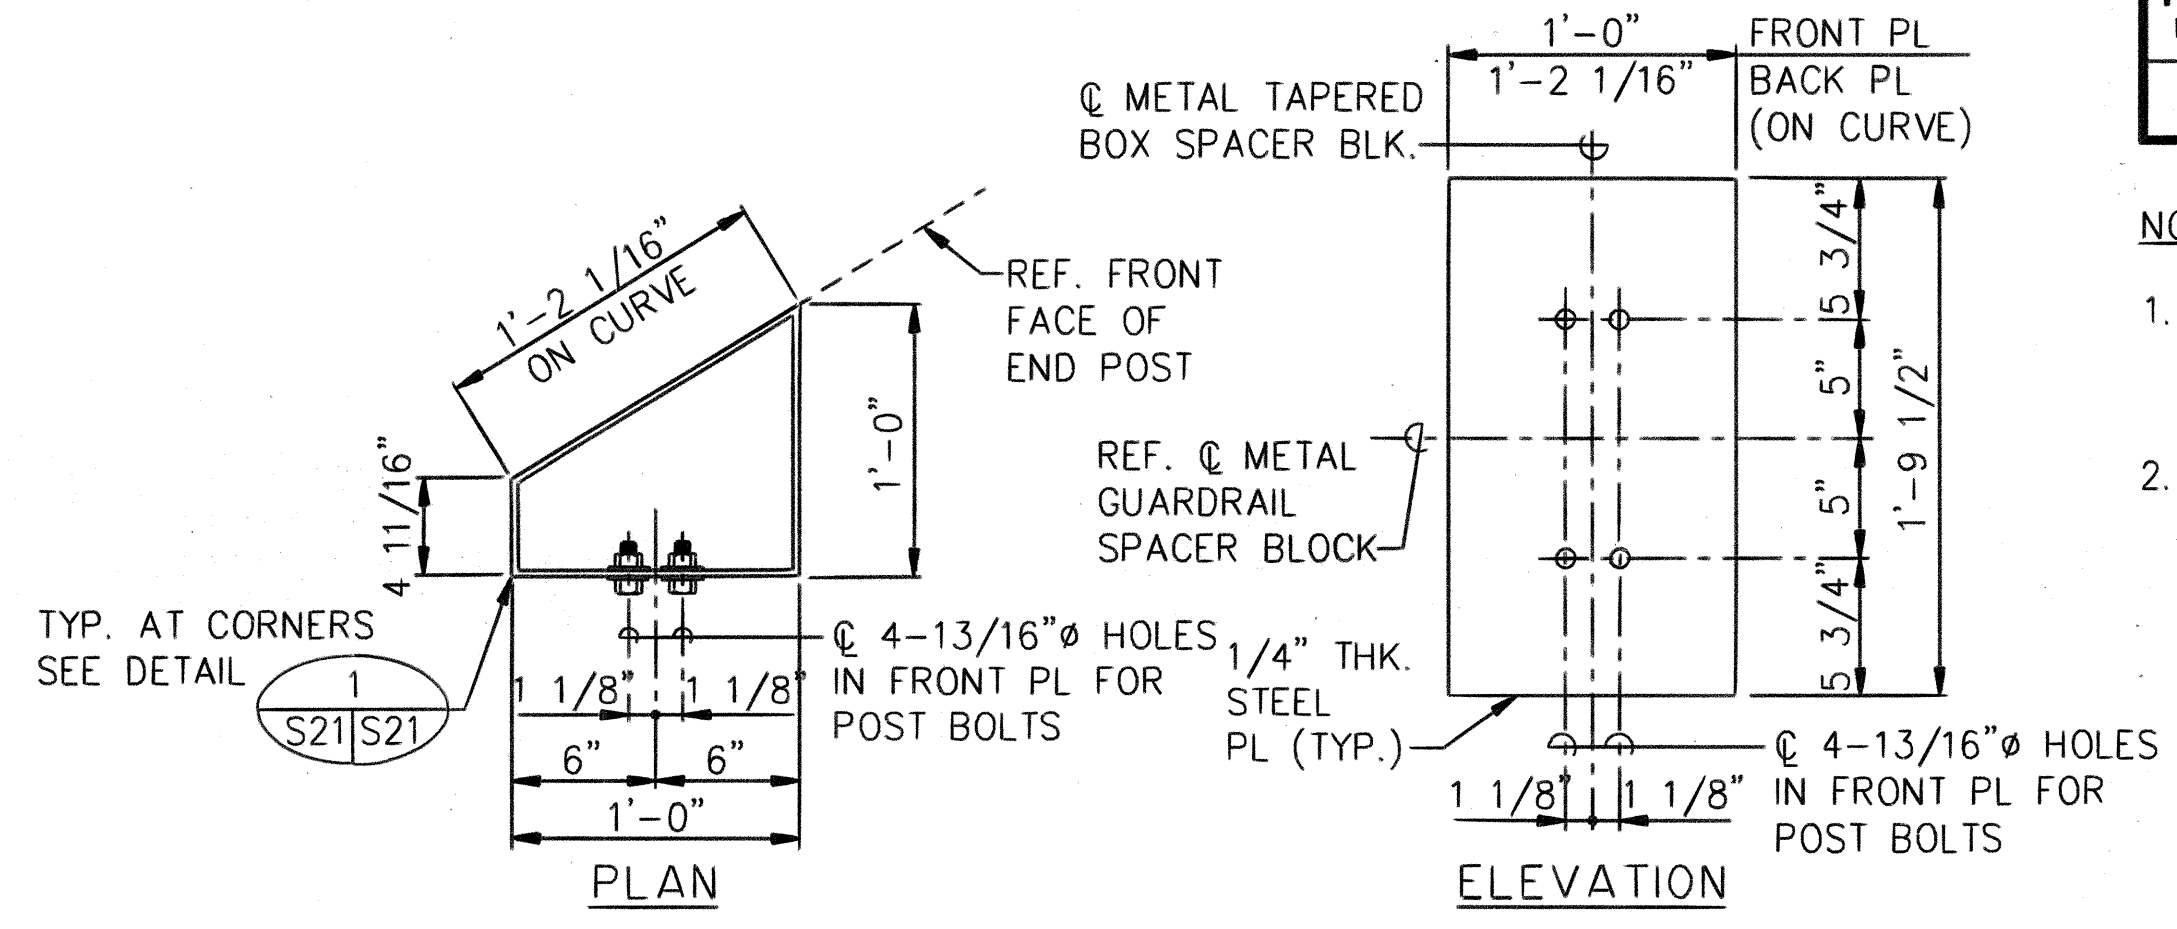


METAL TAPERED BOX SPACER BLOCK DETAIL
SCALE : 1 1/2" = 1'-0"

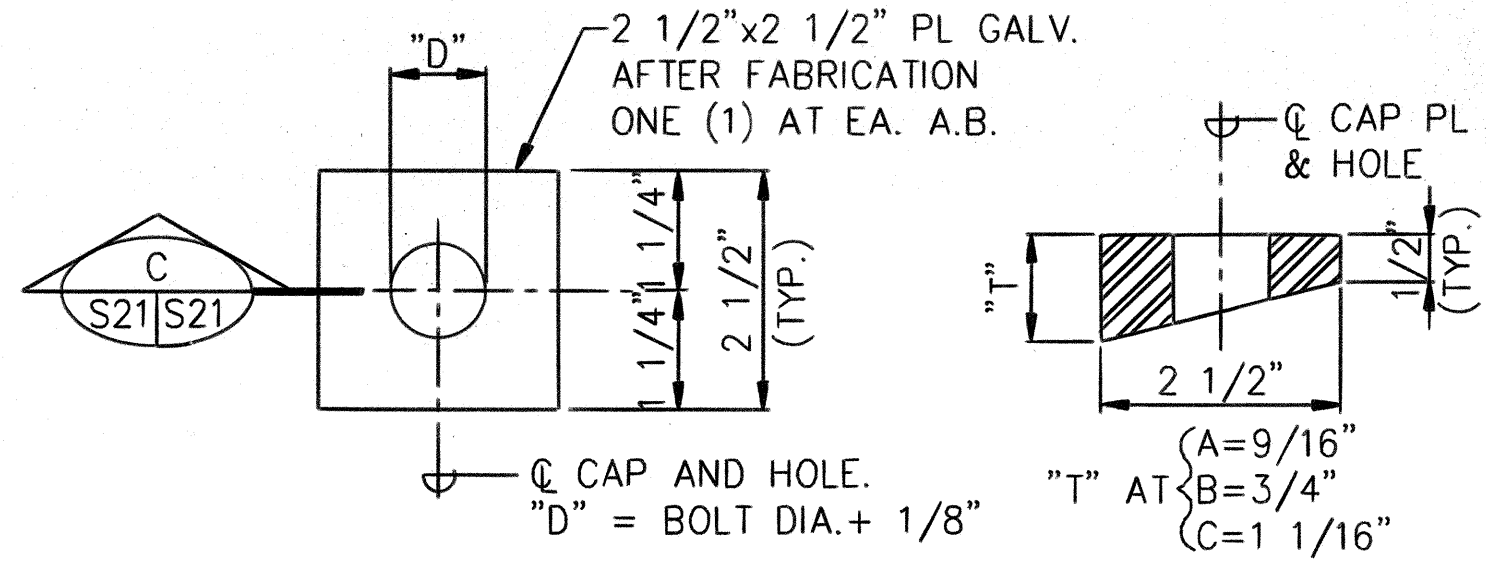


FRONT VIEW
SECTION C
CAP (BEARING) PLATE DETAIL
NOT TO SCALE

CURVE DATA (FRONT FACE)
 $\Delta = 40^{\circ}06'25''$
 $R = 10'-0''$
 $L_c = 7'-0''$


METAL GUARDRAIL CONNECTION REF. LINE & 2-3/4" HOLES FOR 5/8" H.S. ANCHOR BOLTS W/ BEVEL CAP PL. NUT & WASHER
5-1" HOLES FOR 7/8" H.S. ANCHOR BOLTS W/ BEVEL CAP PL. NUT & WASHER.

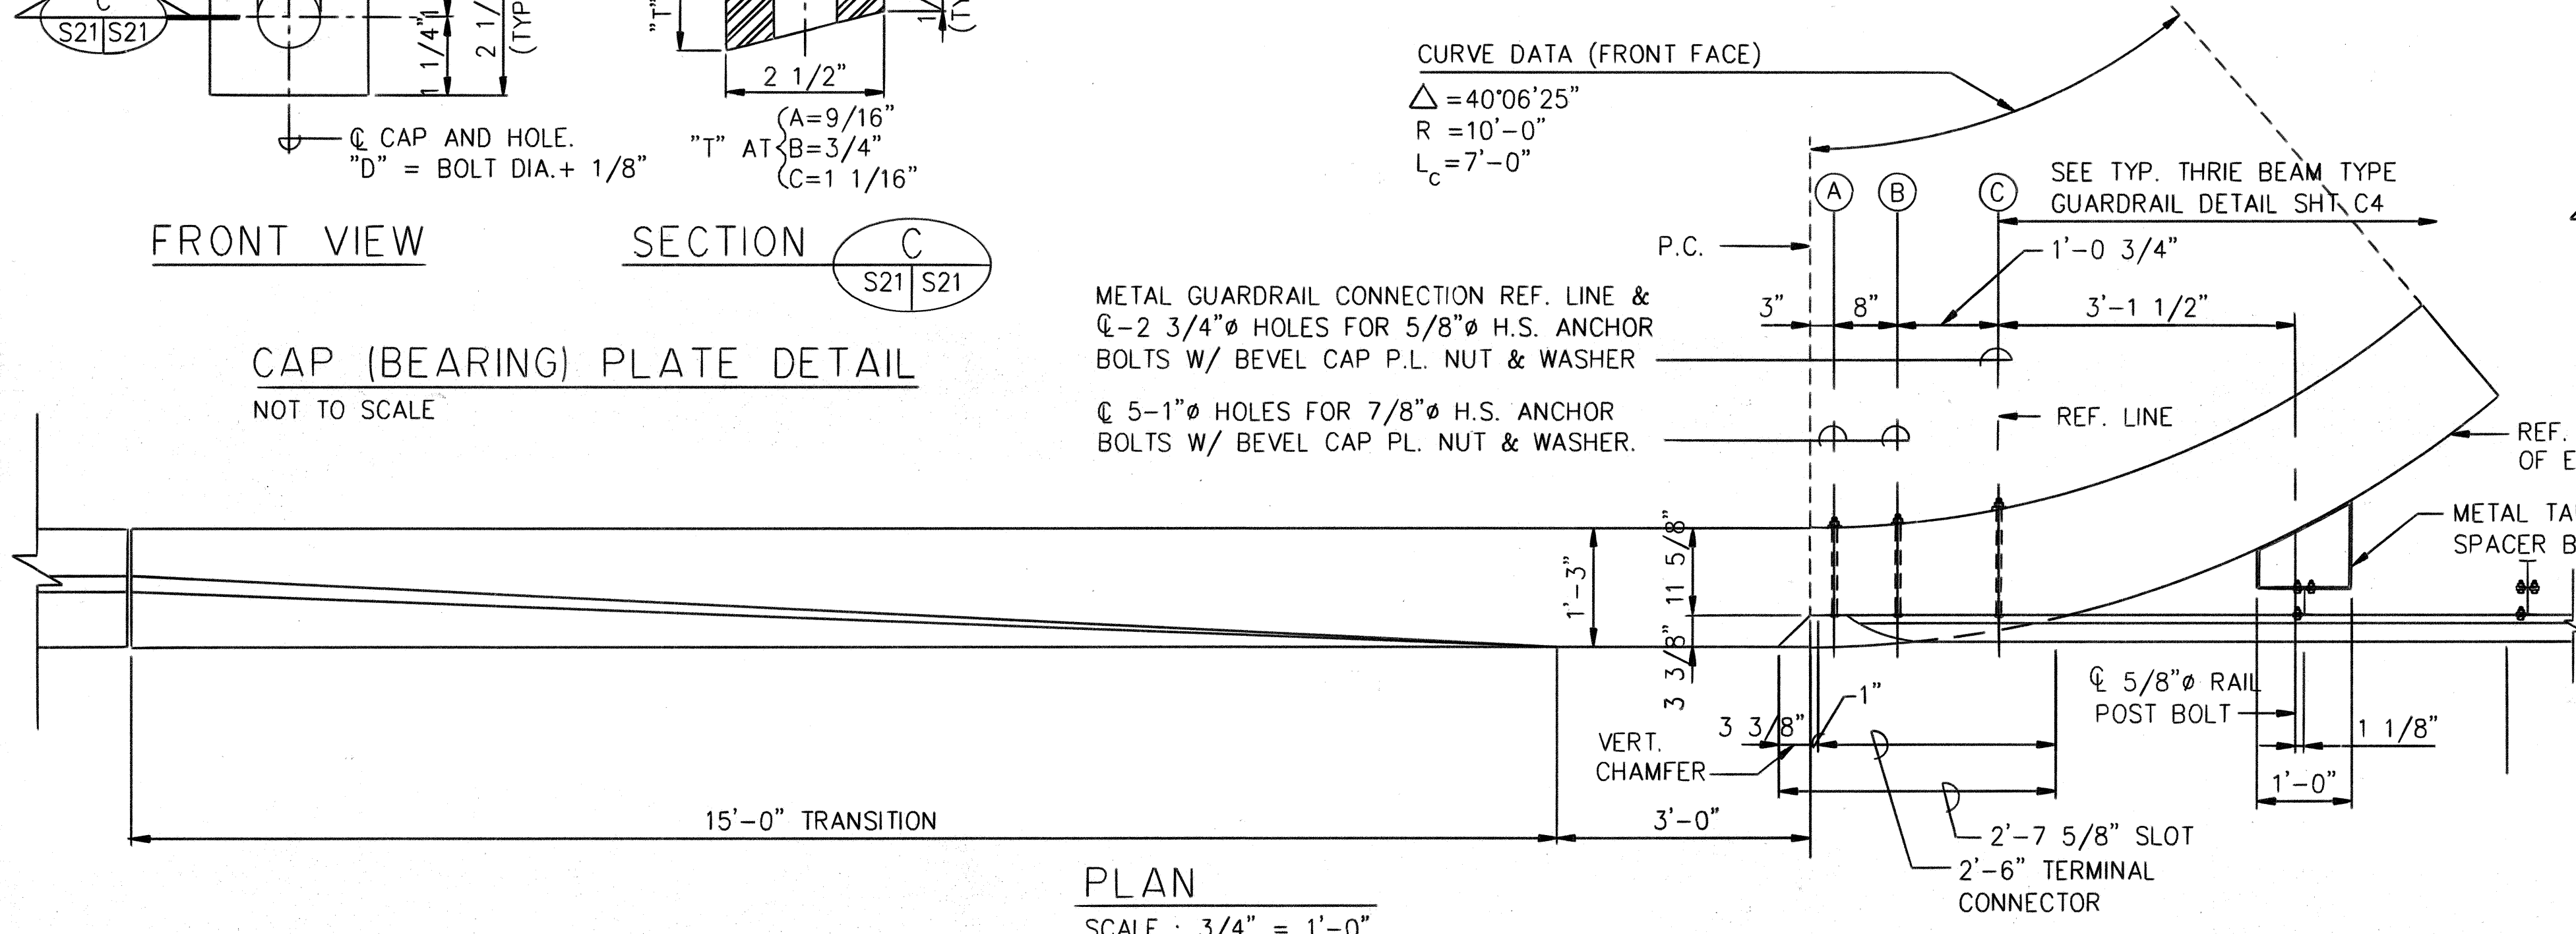


PLAN
SCALE : 3/4" = 1'-0"

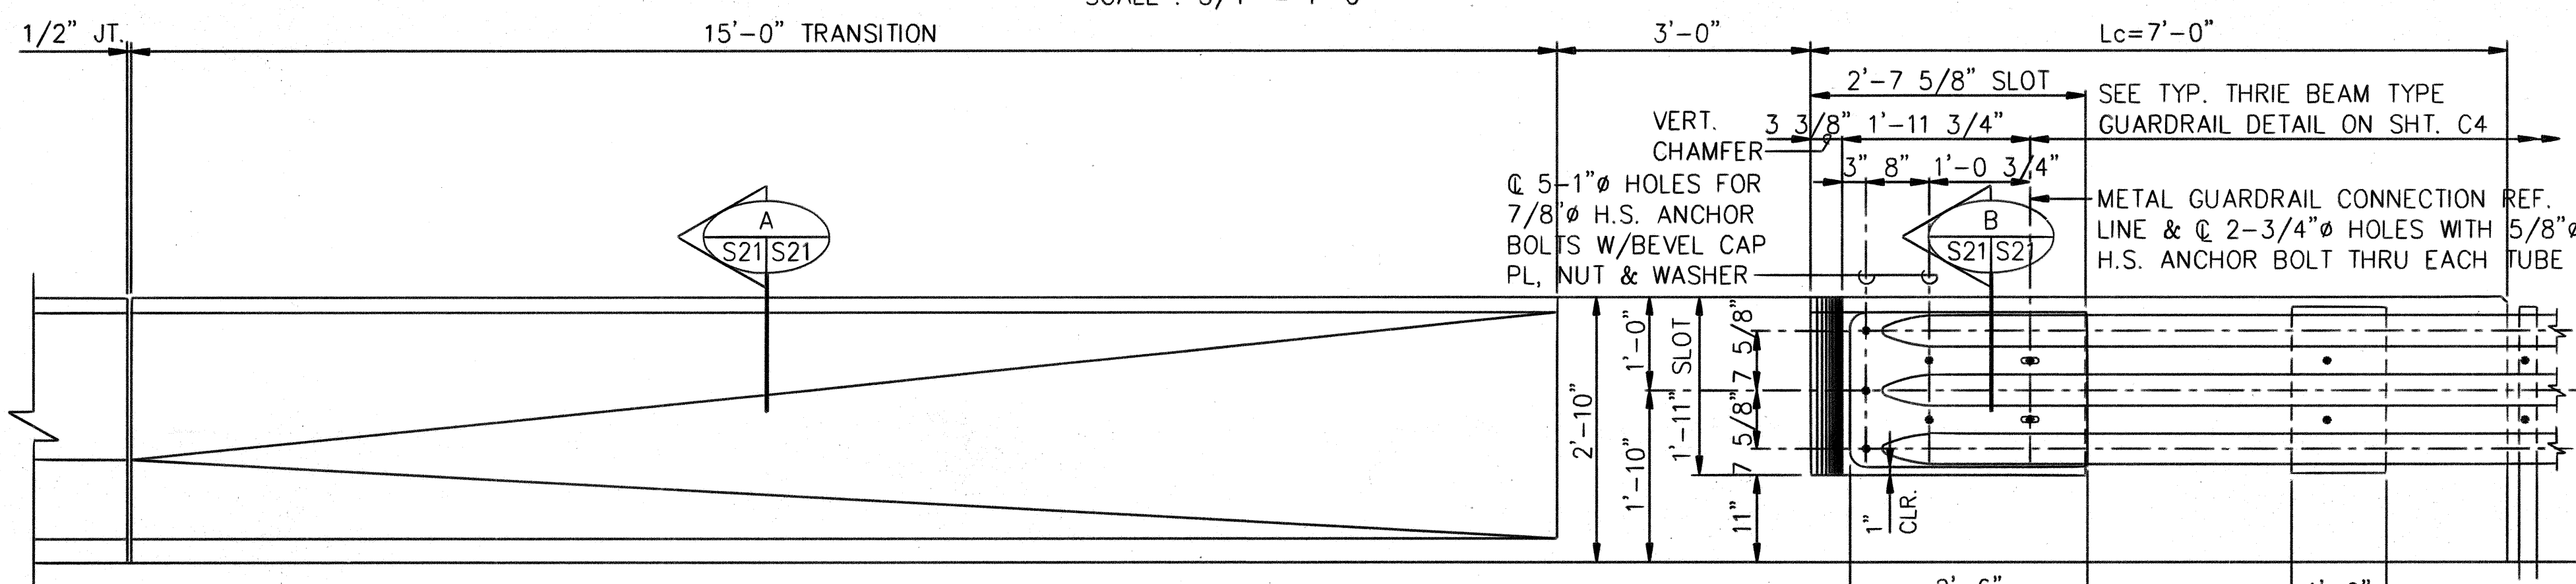

ELEVATION
SCALE : 3/4" = 1'-0"

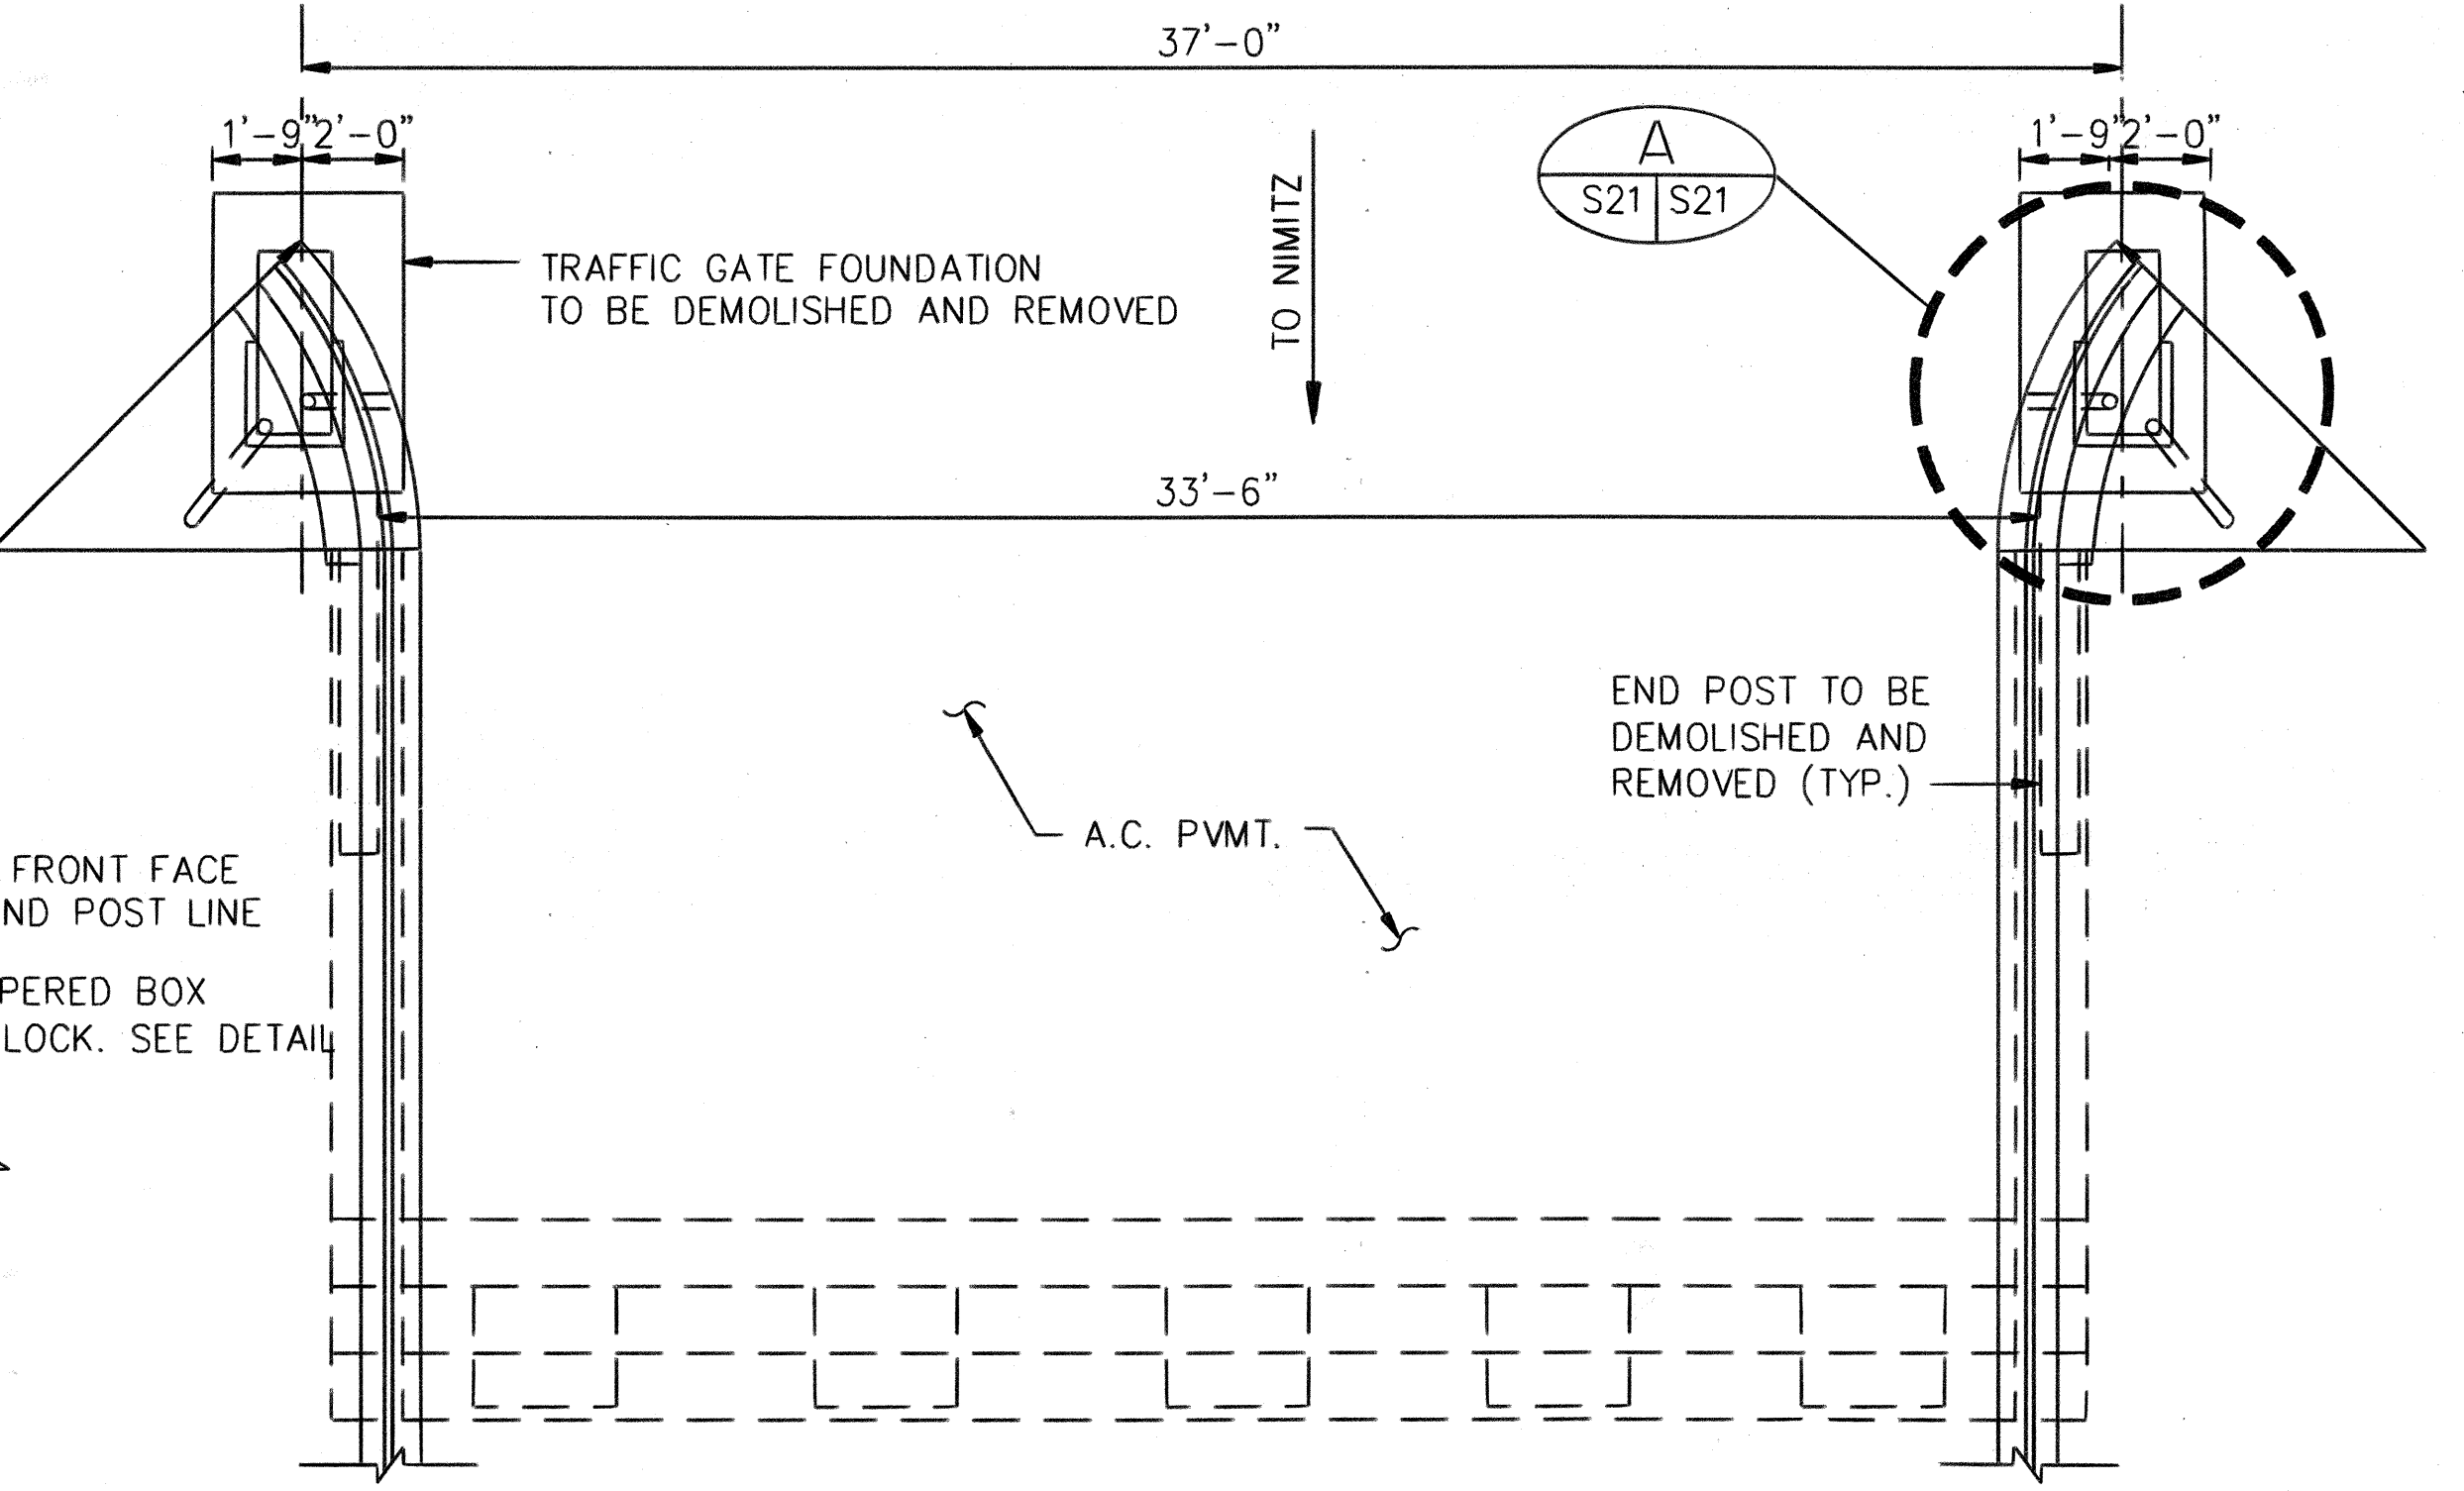

GUARDRAIL END POST-PLAN
SCALE : 1/4" = 1'-0"

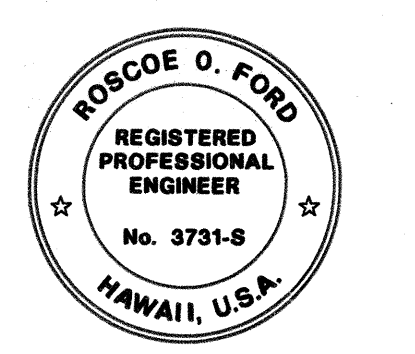

THIS WORK WAS PREPARED BY ME OR UNDER MY SUPERVISION
Roscoe O. Ford

STATE OF HAWAII
DEPARTMENT OF TRANSPORTATION
HIGHWAYS DIVISION
TYPICAL DETAILS
CONCRETE BRIDGE RAIL TRANSITION WITH
CURVED END AND GUARDRAIL CONNECTION
SAND ISLAND BASCULE BRIDGE
REHABILITATION PHASE II
PROJECT NO. BR-064-1(3)
SCALE: AS NOTED DATE: AUG. 15, 1991
SHEET No. S21 OF S21 SHEETS

SURVEY PLOTTED BY	DATE
DRAWN BY	
DESIGNED BY	
QUANTITIES BY	
CHECKED BY	
ORIGINAL PLAN	No.
NOTEBOOK	No.