


B STA. 13+30 TO STA. 14+00
O/S = +16' LT. & O/S = +48' LT
REMOVE EXIST CURB & GUTTER
INSTALL NEW CURB & GUTTER

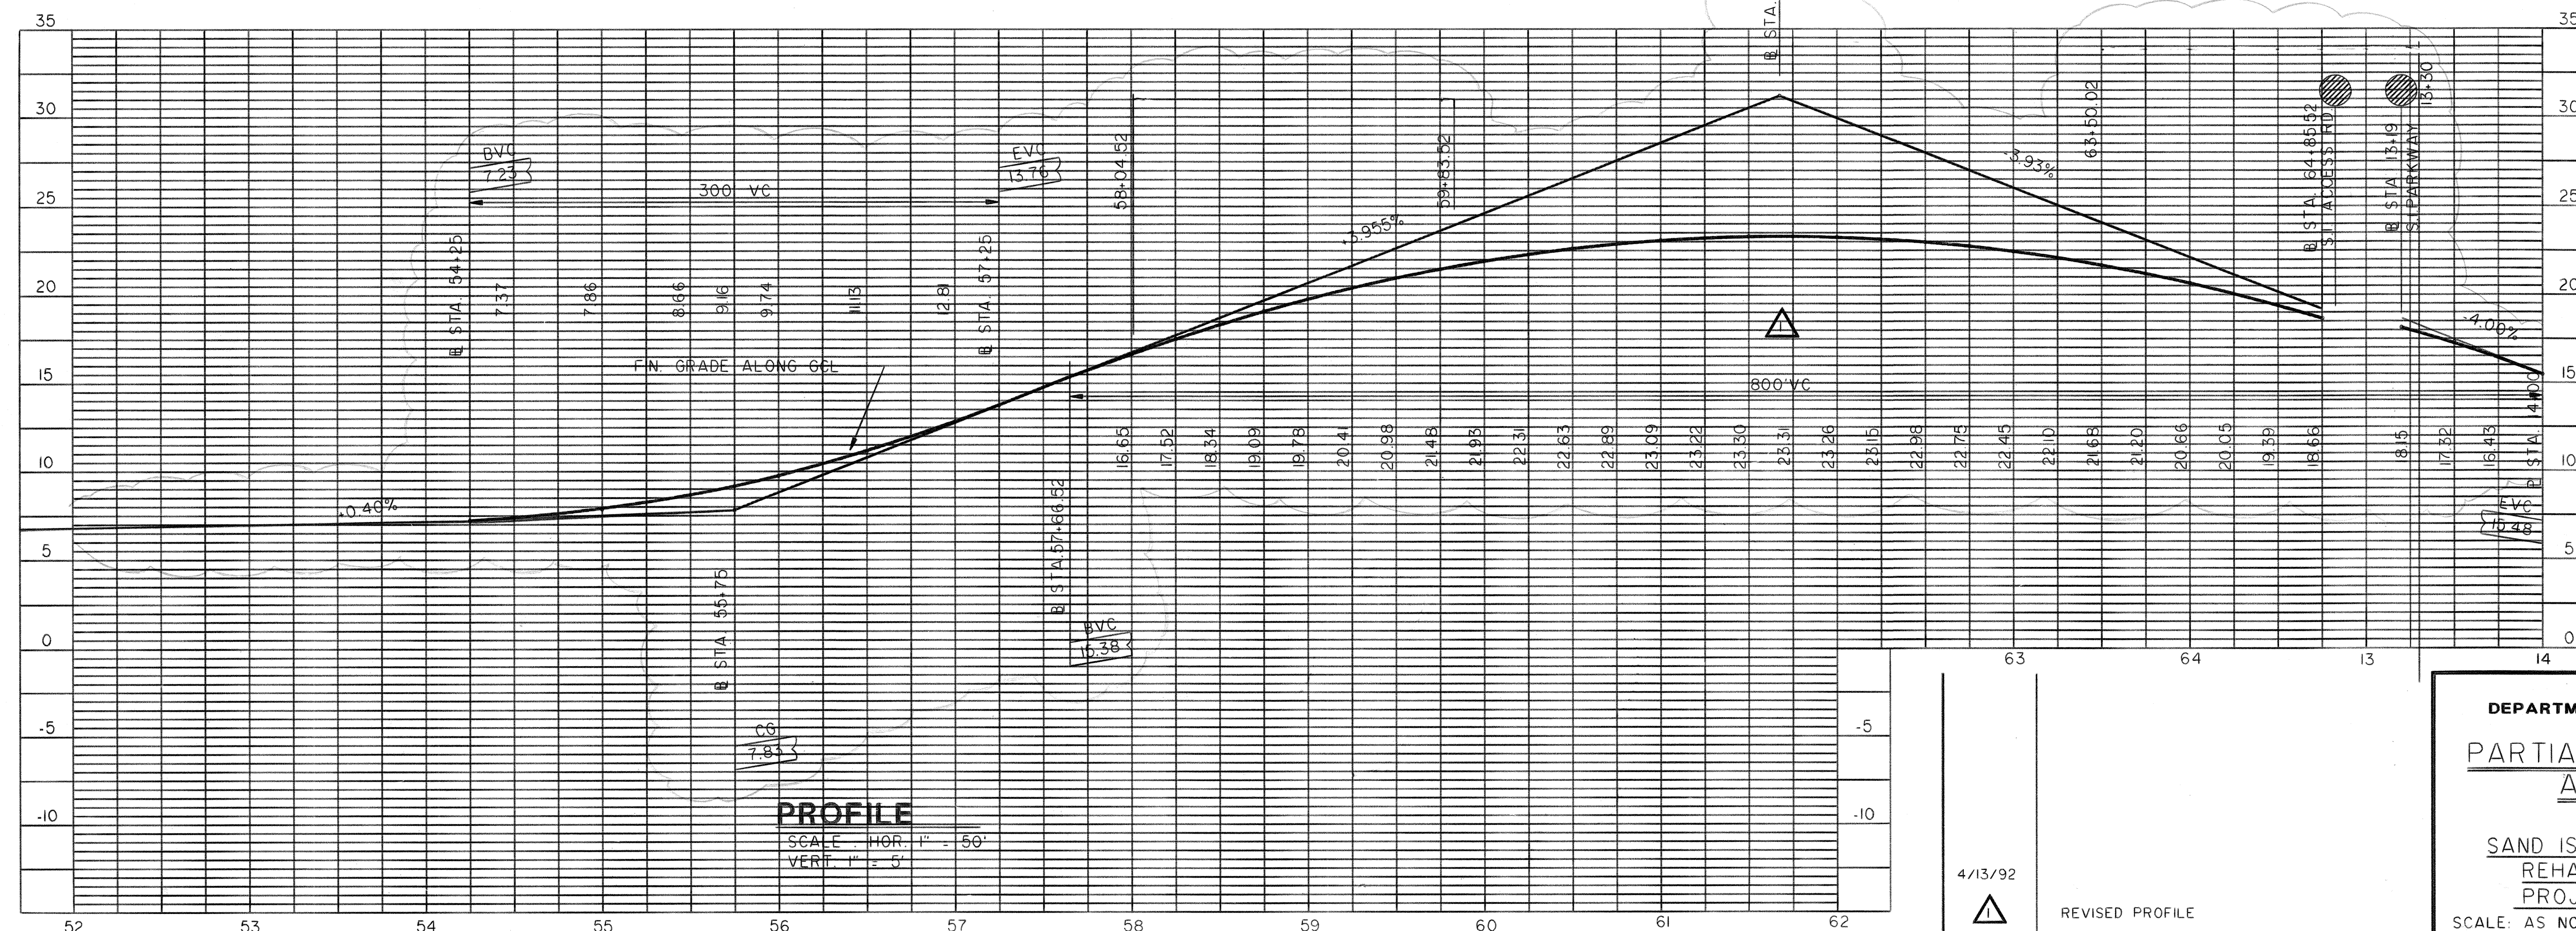

ROSCOE O. FORD
REGISTERED
PROFESSIONAL
ENGINEER
No. 3731-C
HAWAII, U.S.A.

THIS WORK WAS PREPARED BY
ME OR UNDER MY SUPERVISION

Roscoe O Ford

SAND ISLAND BASCULE BRIDGE
REHABILITATION PHASE II
PROJECT NO. BR-064-I(3)
SCALE: AS NOTED DATE: AUG. 15,
SHEET No. 11 OF 14 SHEETS

C.O.3