


FED. ROAD DIST. NO.	STATE	FED. AID PROJ. NO.	FISCAL YEAR	SHEET NO.	TOTAL SHEETS
HAWAII	HAW.	BR-064-1(3)	1991	1	38

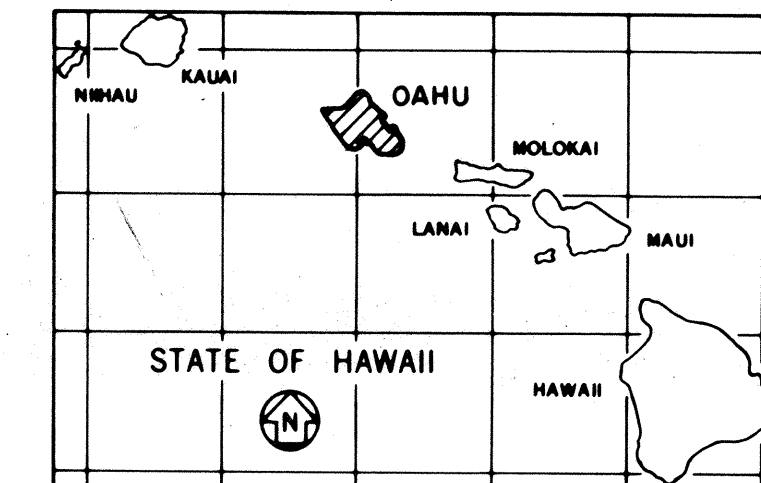

STATE OF HAWAII
DEPARTMENT OF TRANSPORTATION
HIGHWAYS DIVISION
HONOLULU, HAWAII
"AS-BUILT"
PLANS FOR

SAND ISLAND BASCULE BRIDGE REHABILITATION PHASE II



FEDERAL AID PROJECT NO. BR-064-1(3)

DISTRICT OF HONOLULU

ISLAND OF OAHU

[illegible]

Plan Sht. Nos. ① CO12S-I, 20S-I are supplementary
sheet to this project.
TOTAL SHEET COUNT after "AS BUILT" postings.
40 Sheets.

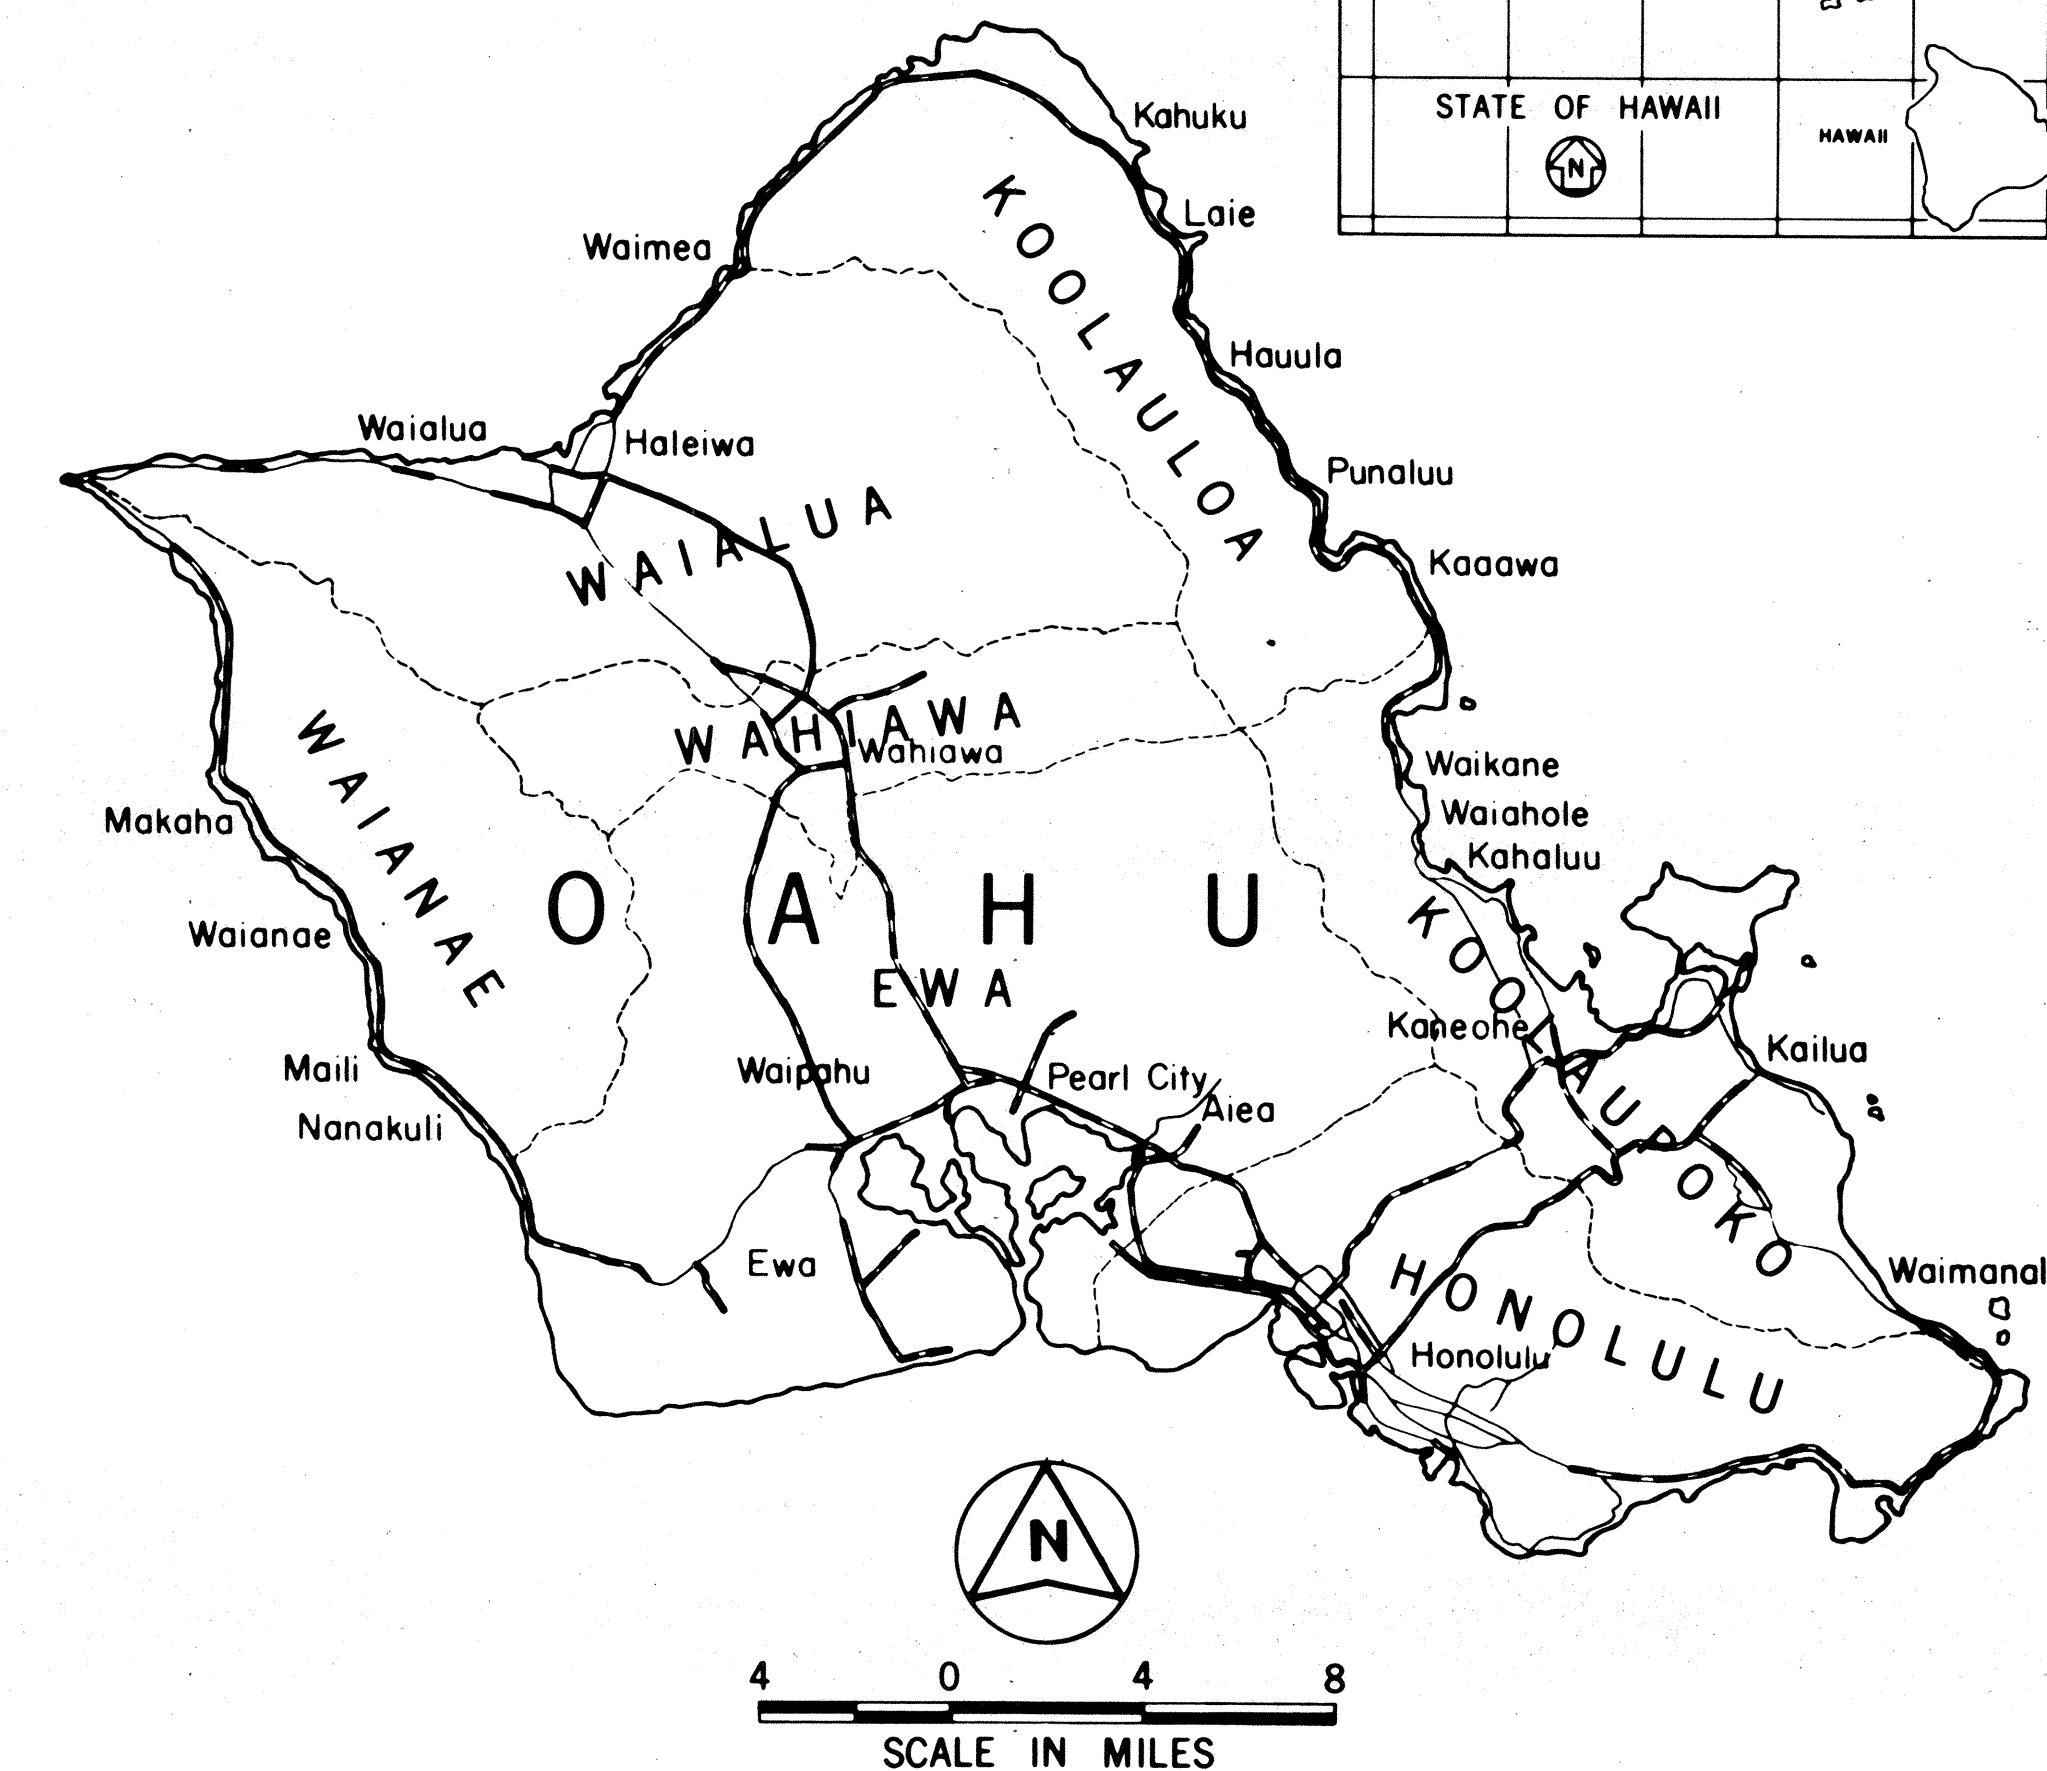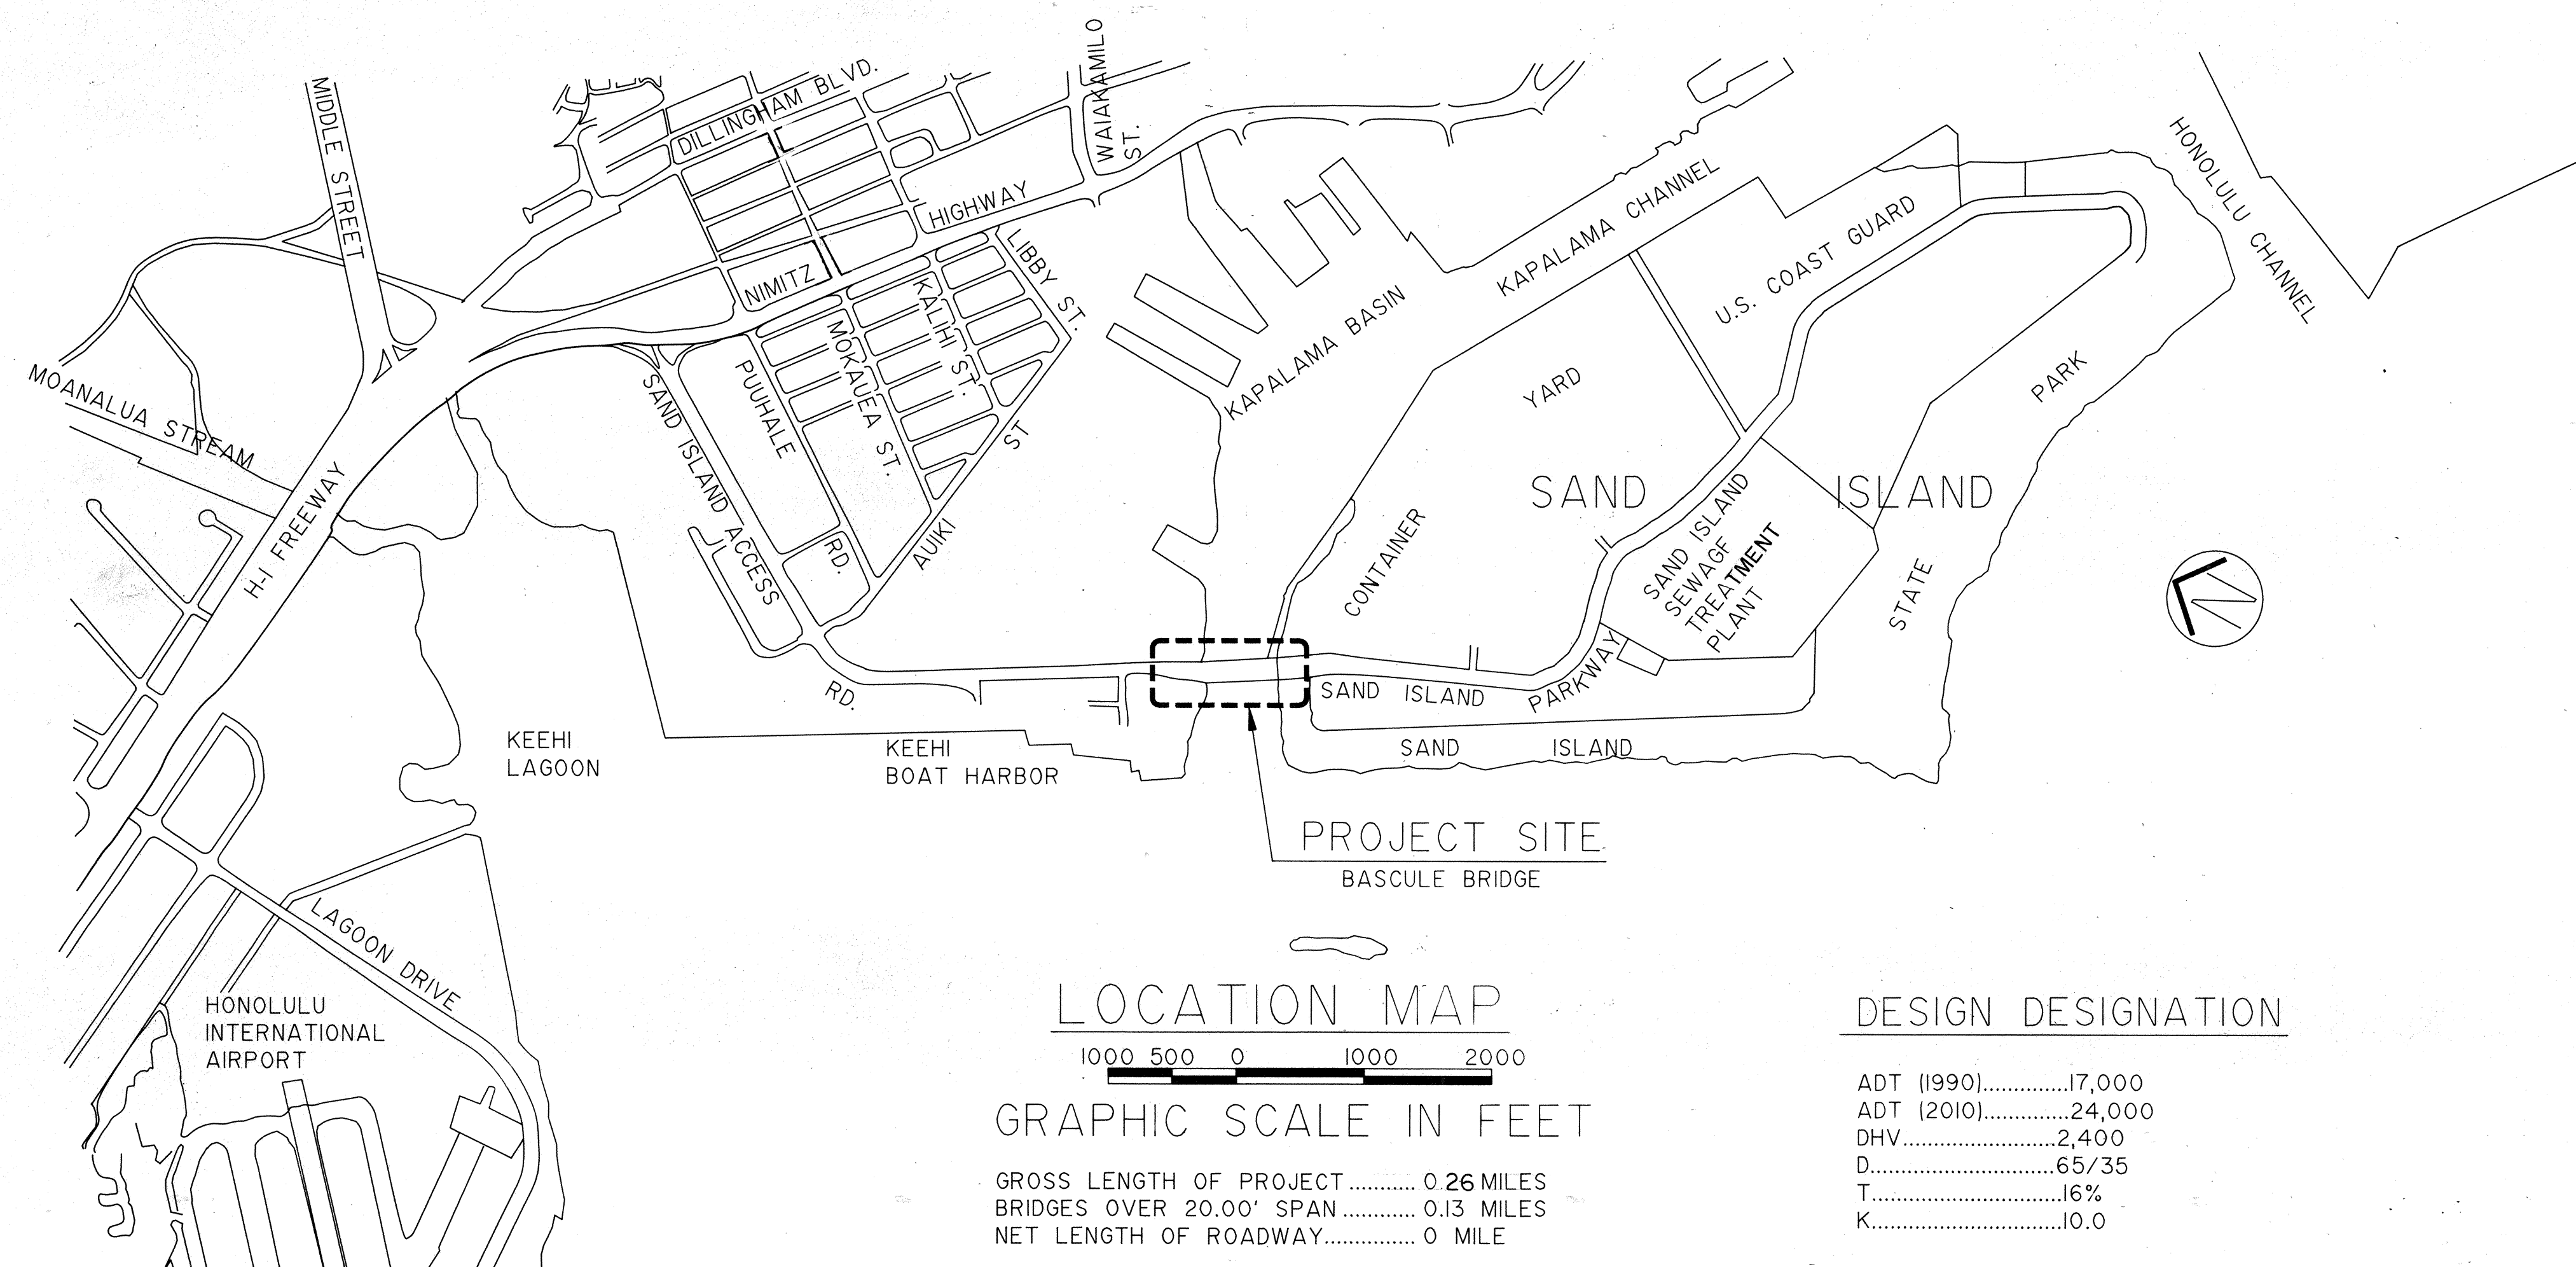

 FEDERAL AID PROJECTS PREVIOUSLY CONSTRUCTED
OR UNDER CONSTRUCTION

MILE POST 1.41 TO MILE POST 1.54

CHANGES MADE DURING CONSTRUCTION HAVE BEEN INCORPORATED ON THESE PLANS EXCEPT CHANGES IN THE ORIGINAL THEORETICAL QUANTITIES.

Sidney S. C. Lee
RESIDENT ENGINEER

12/11/93
DATE

DESIGN DESIGNATION

ADT (1990).....	17,000
ADT (2010).....	24,000
DHV.....	2,400
D.....	65/35
T.....	16%
K.....	10.0

DEPARTMENT OF TRANSPORTATION FEDERAL HIGHWAY ADMINISTRATION	
APPROVED:	
<i>W. L. ...</i>	<i>9/11/9</i>
DIVISION ADMINISTRATOR	DATE

DEPARTMENT OF TRANSPORTATION
STATE OF HAWAII

APPROVED: Edward J. Davis 8/30/91
DIR. OF TRANSPORTATION DATE