


FED. ROAD DIST. NO.	STATE	PROJ. NO.	FISCAL YEAR	SHEET NO.	TOTAL SHEETS
HAWAII	HAW.	64A-01-93M	1993	12	12

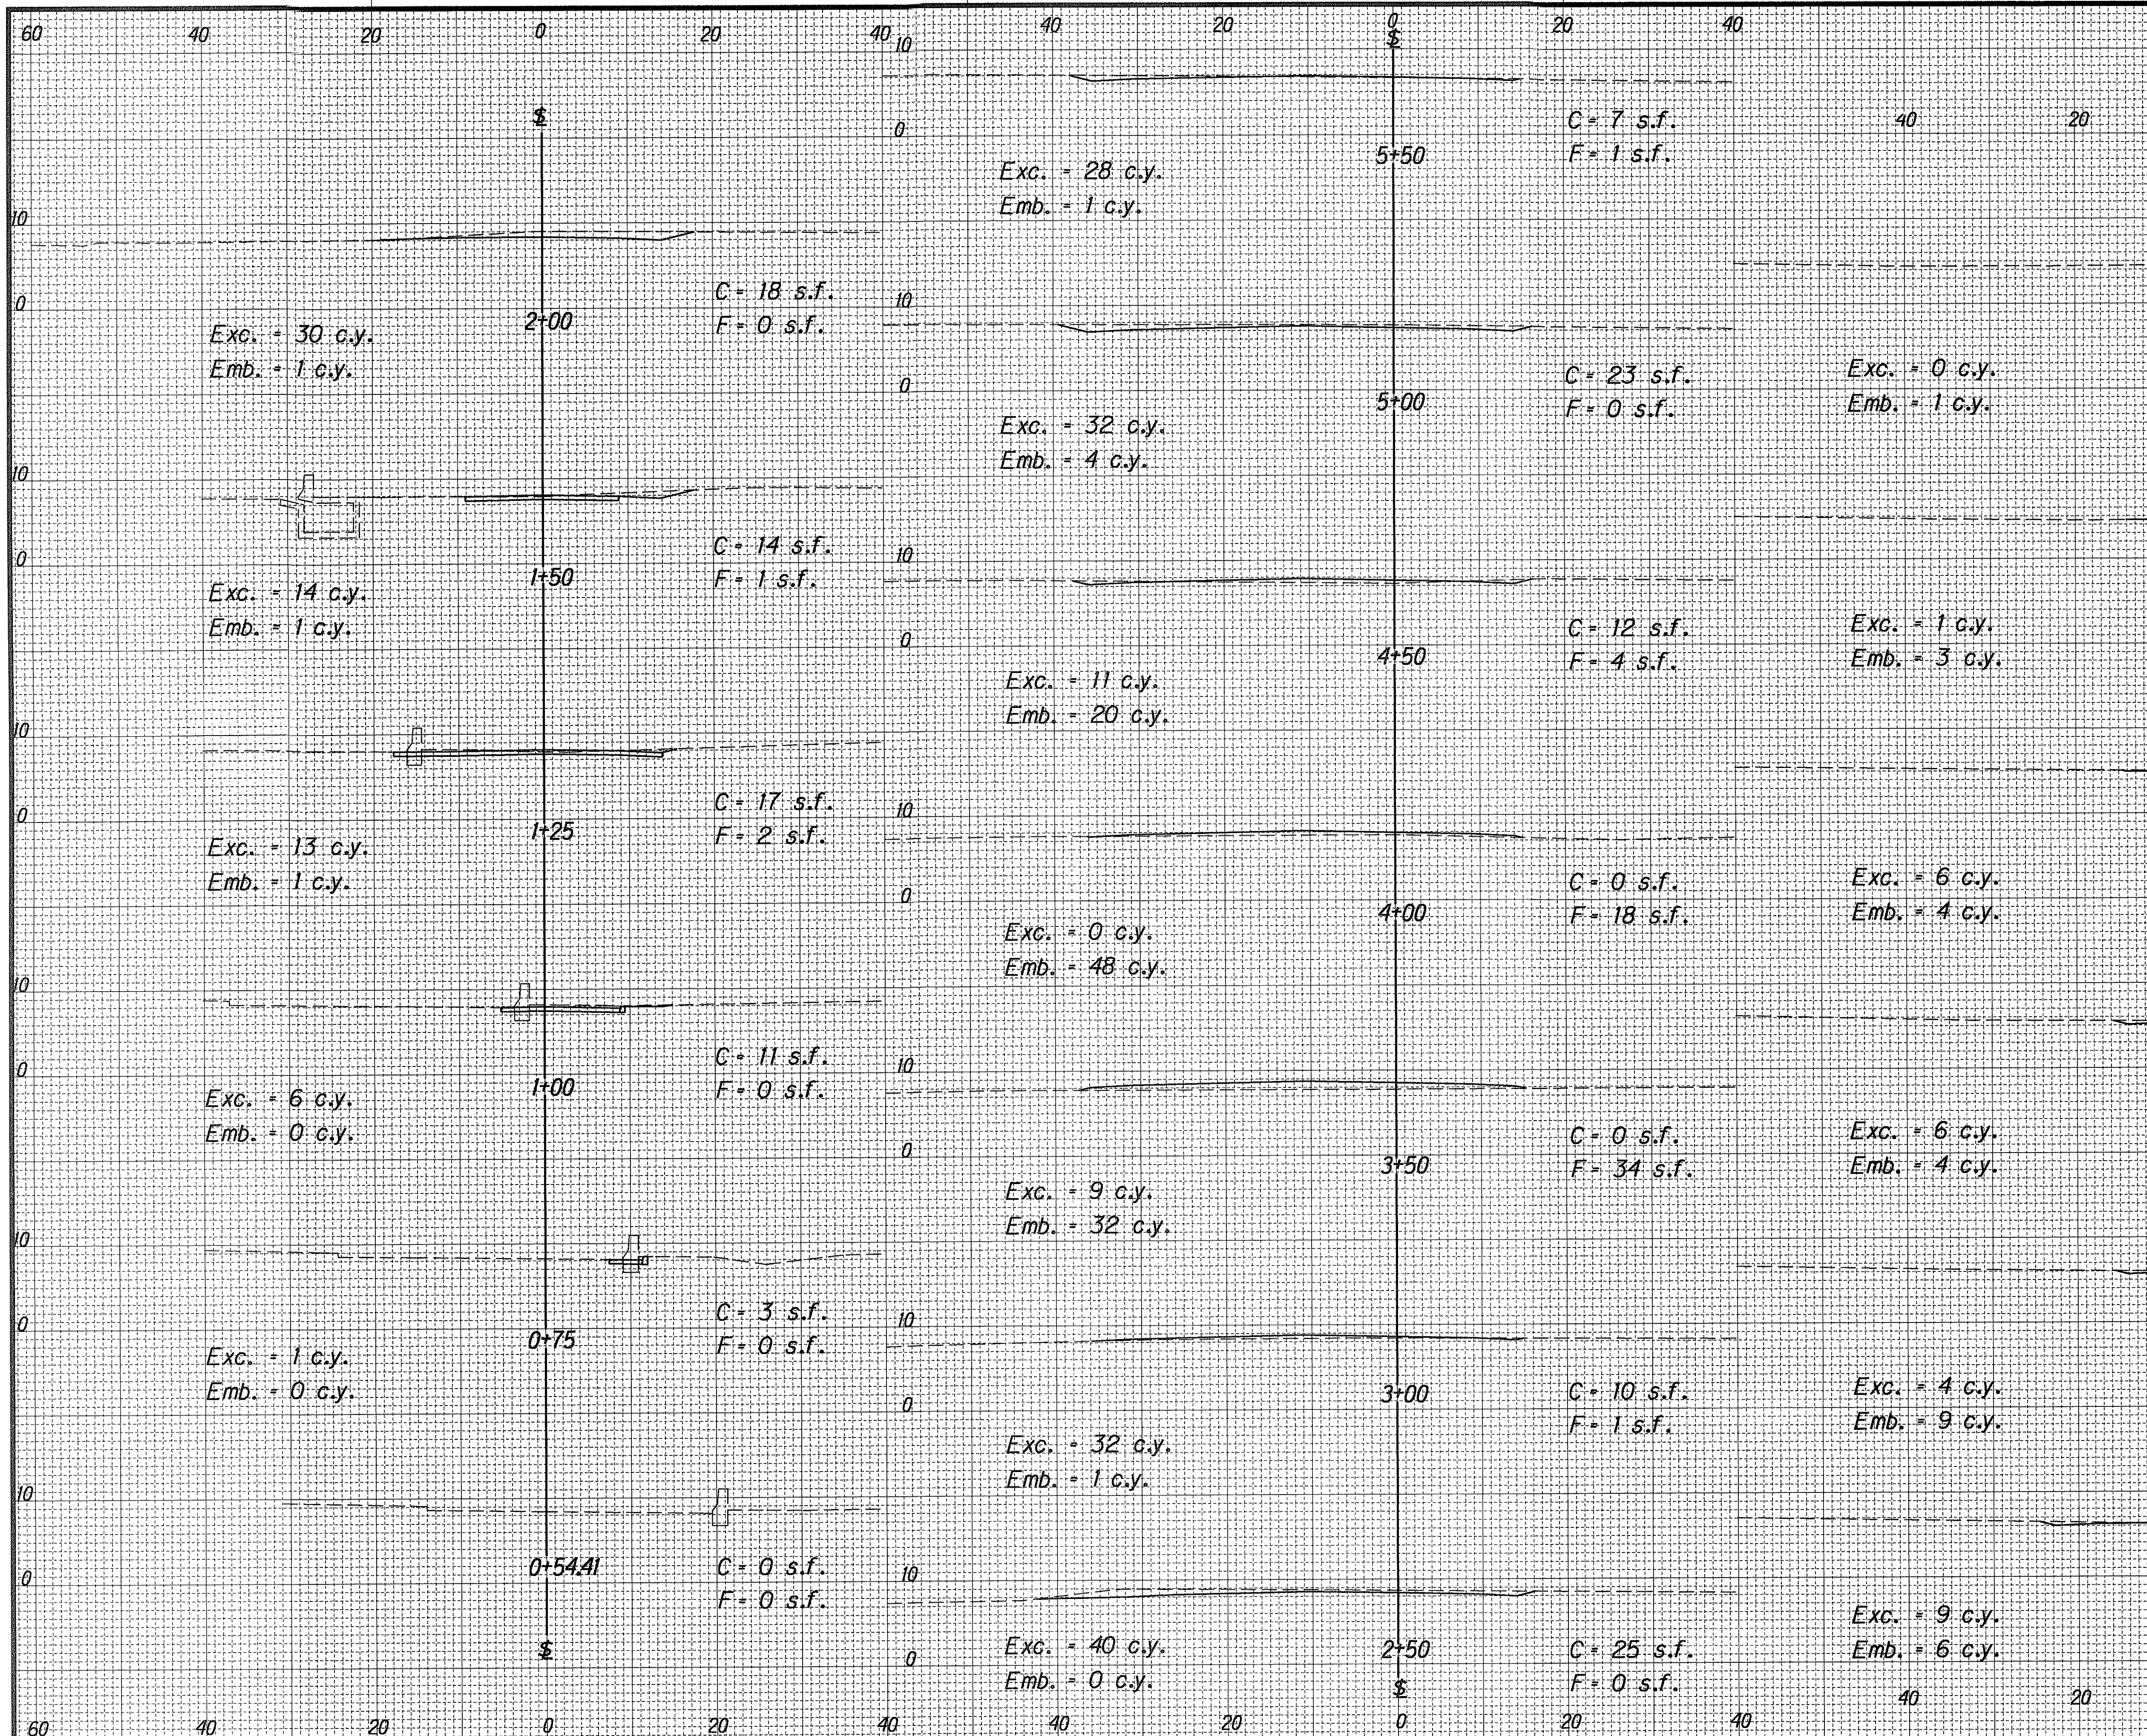

ORIGINAL PLAN
DESIGNED BY
CHECKED BY
DATE
6/2/93