


FED. ROAD DIST. NO.	STATE	PROJ. NO.	FISCAL YEAR	SHEET NO.	TOTAL SHEETS
HAWAII	HAW.	HWY-0-05-00	2002	10	30

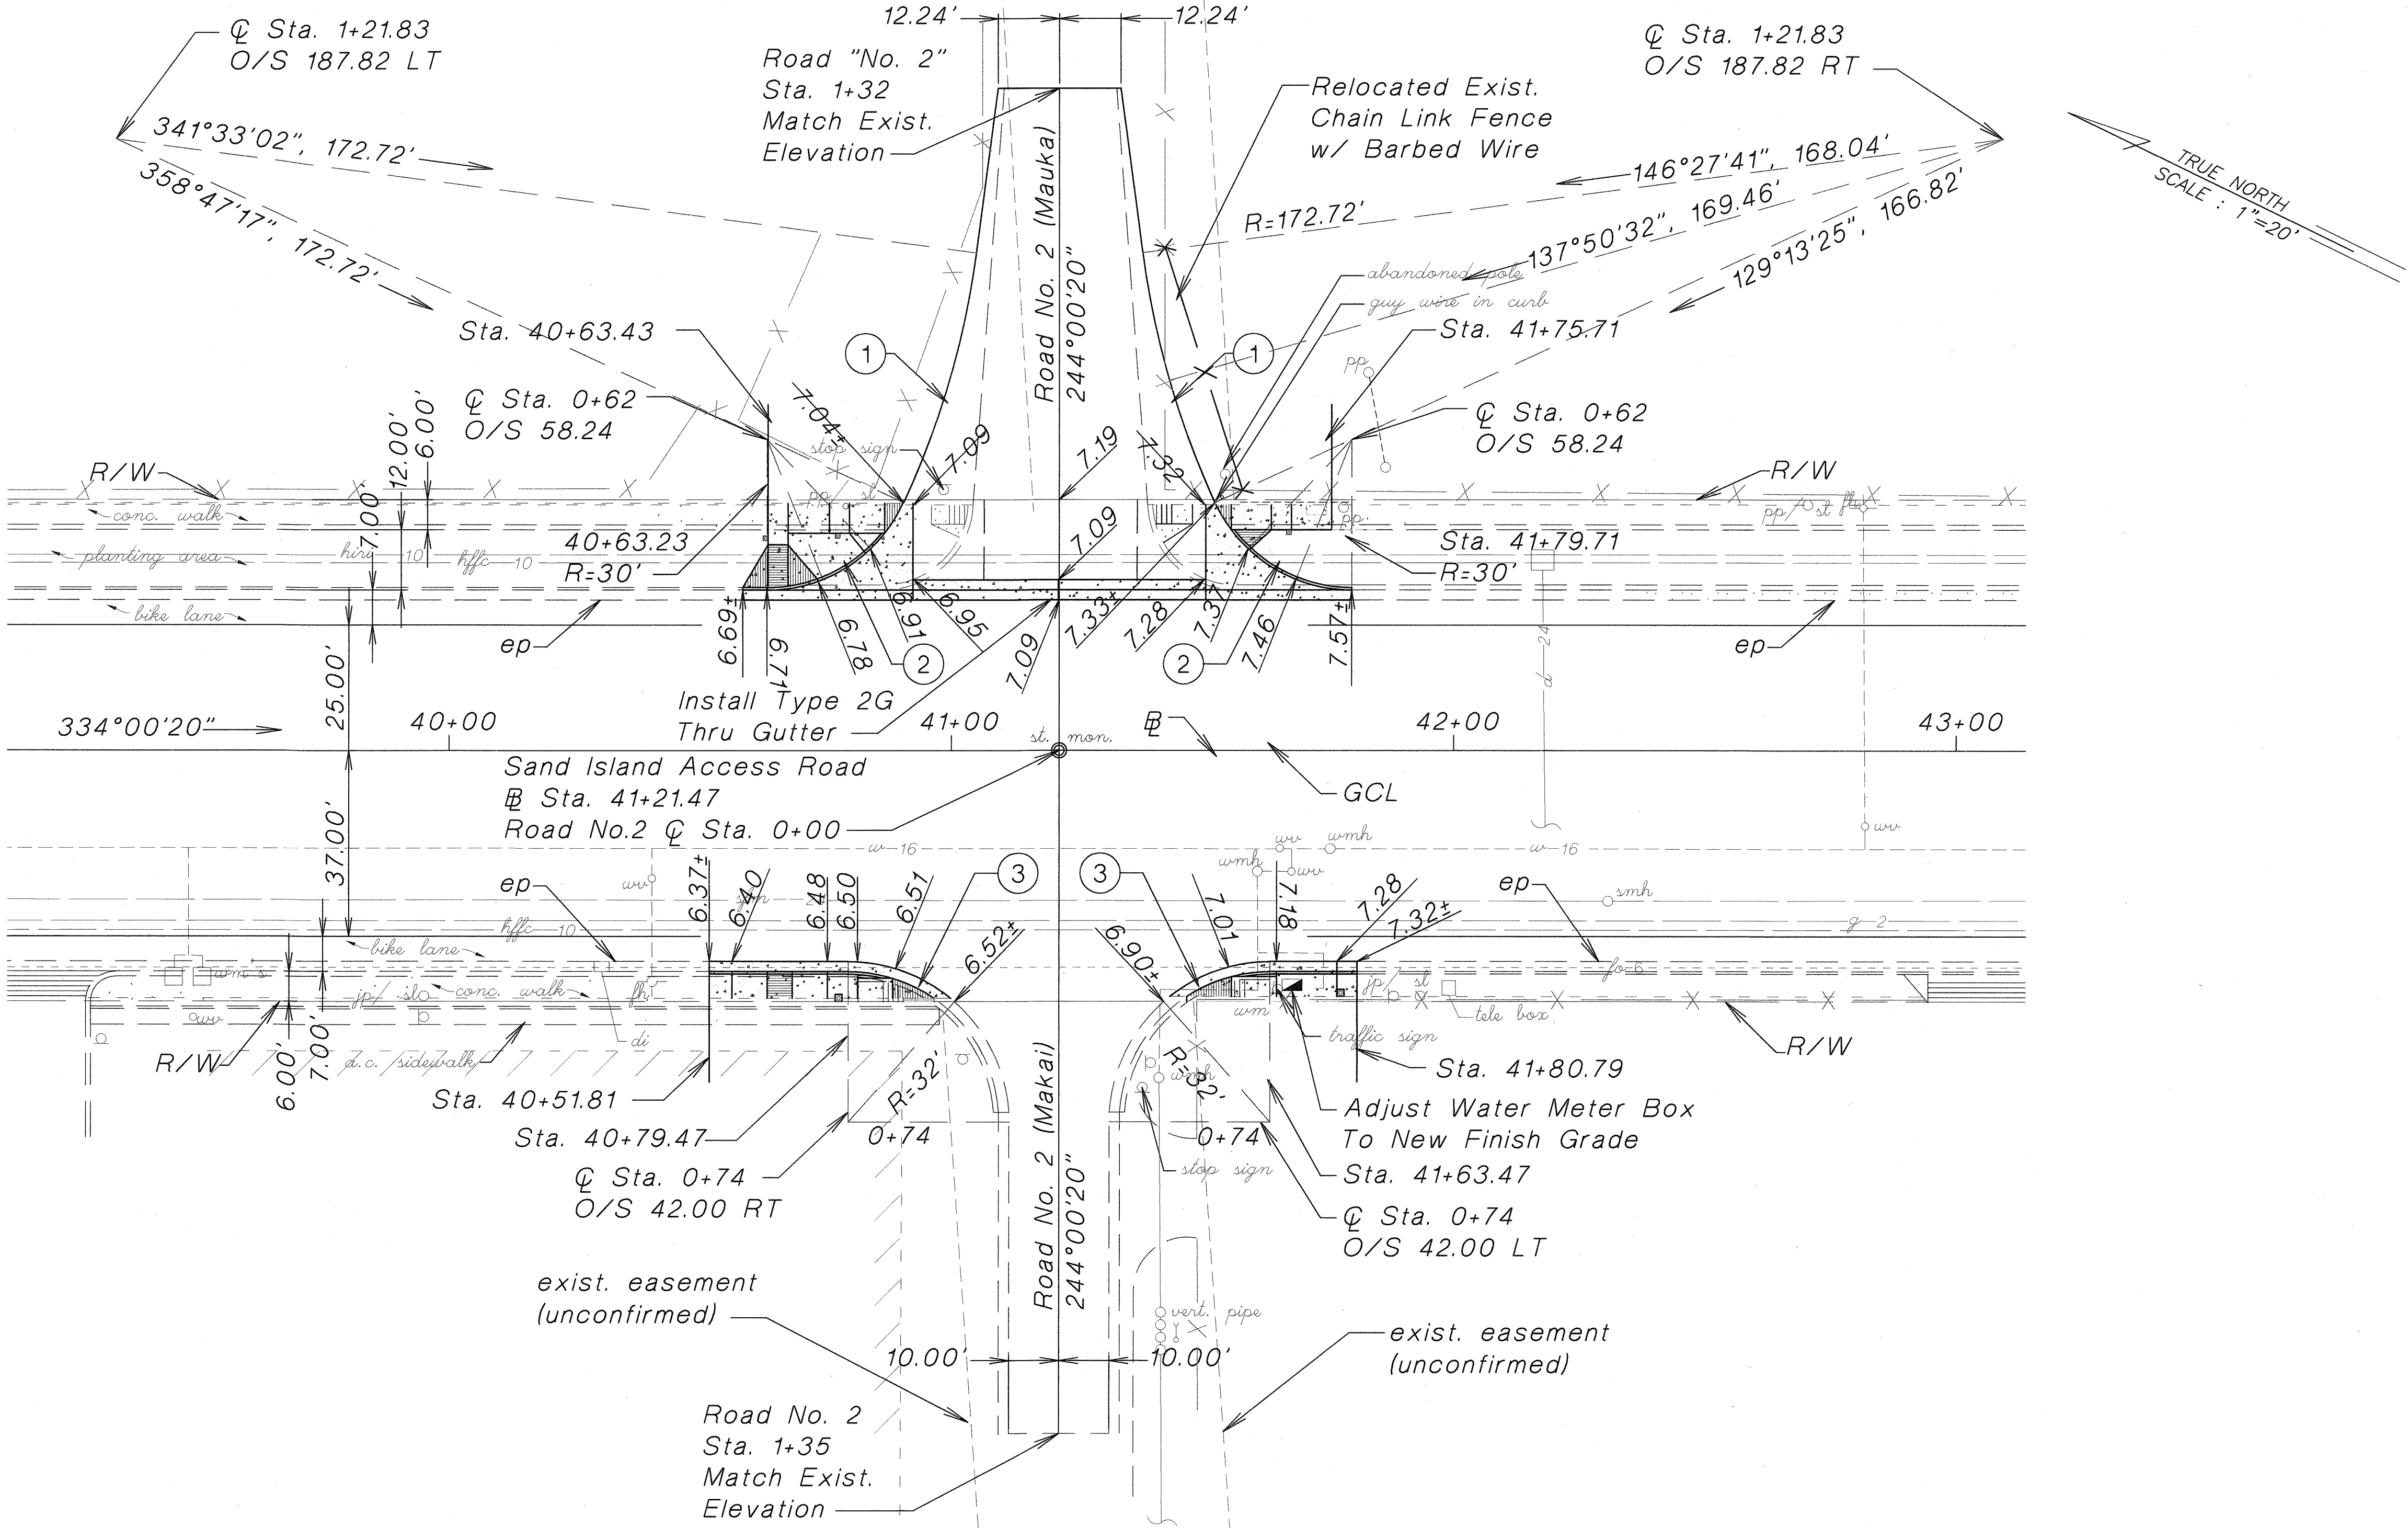

CURVE DATA			
No.	E.P.		GUTTER
	①	②	③
Δ	17°14'15"	64°19'15"	41°24'34"
R	172.72'	30.00'	32.00'
T	26.18'	18.86'	12.09'
C	51.77'	31.94'	22.63'
Lc	51.96'	33.68'	23.13'

SURVEY PLOTTED BY	DATE
DRAWN BY	
DESIGNED BY	
CHECKED BY	
ORIGINAL PLAN	No.

THIS WORK WAS PREPARED BY ME OR UNDER MY SUPERVISION

Mark S. Nelson

STATE OF HAWAII
DEPARTMENT OF TRANSPORTATION
HIGHWAYS DIVISION

INTERSECTION DETAIL

SAND ISLAND ACCESS ROAD

Intersection Improvements at Road No. 2

Project No. HWY-0-05-00

Scale: 1" = 20'
Date: Feb. 2002

SHEET No. 1 OF 1 SHEETS