


|                  |                         |            |
|------------------|-------------------------|------------|
| ORIGINAL<br>PLAN | SURVEY PLOTTED BY _____ | DATE _____ |
|                  | DRAWN BY _____          | " _____    |
|                  | TRACED BY _____         | " _____    |
| NOTE BOOK        | DESIGNED BY _____       | " _____    |
|                  | QUANTITIES BY _____     | " _____    |
| No. _____        | CHECKED BY _____        | " _____    |

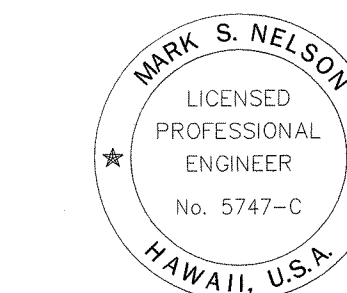

THIS WORK WAS PREPARED BY  
ME OR UNDER MY SUPERVISION

Michael A. Brown