



NOTE: See Plan and Profile Sheet #5 for E & Curve Data.

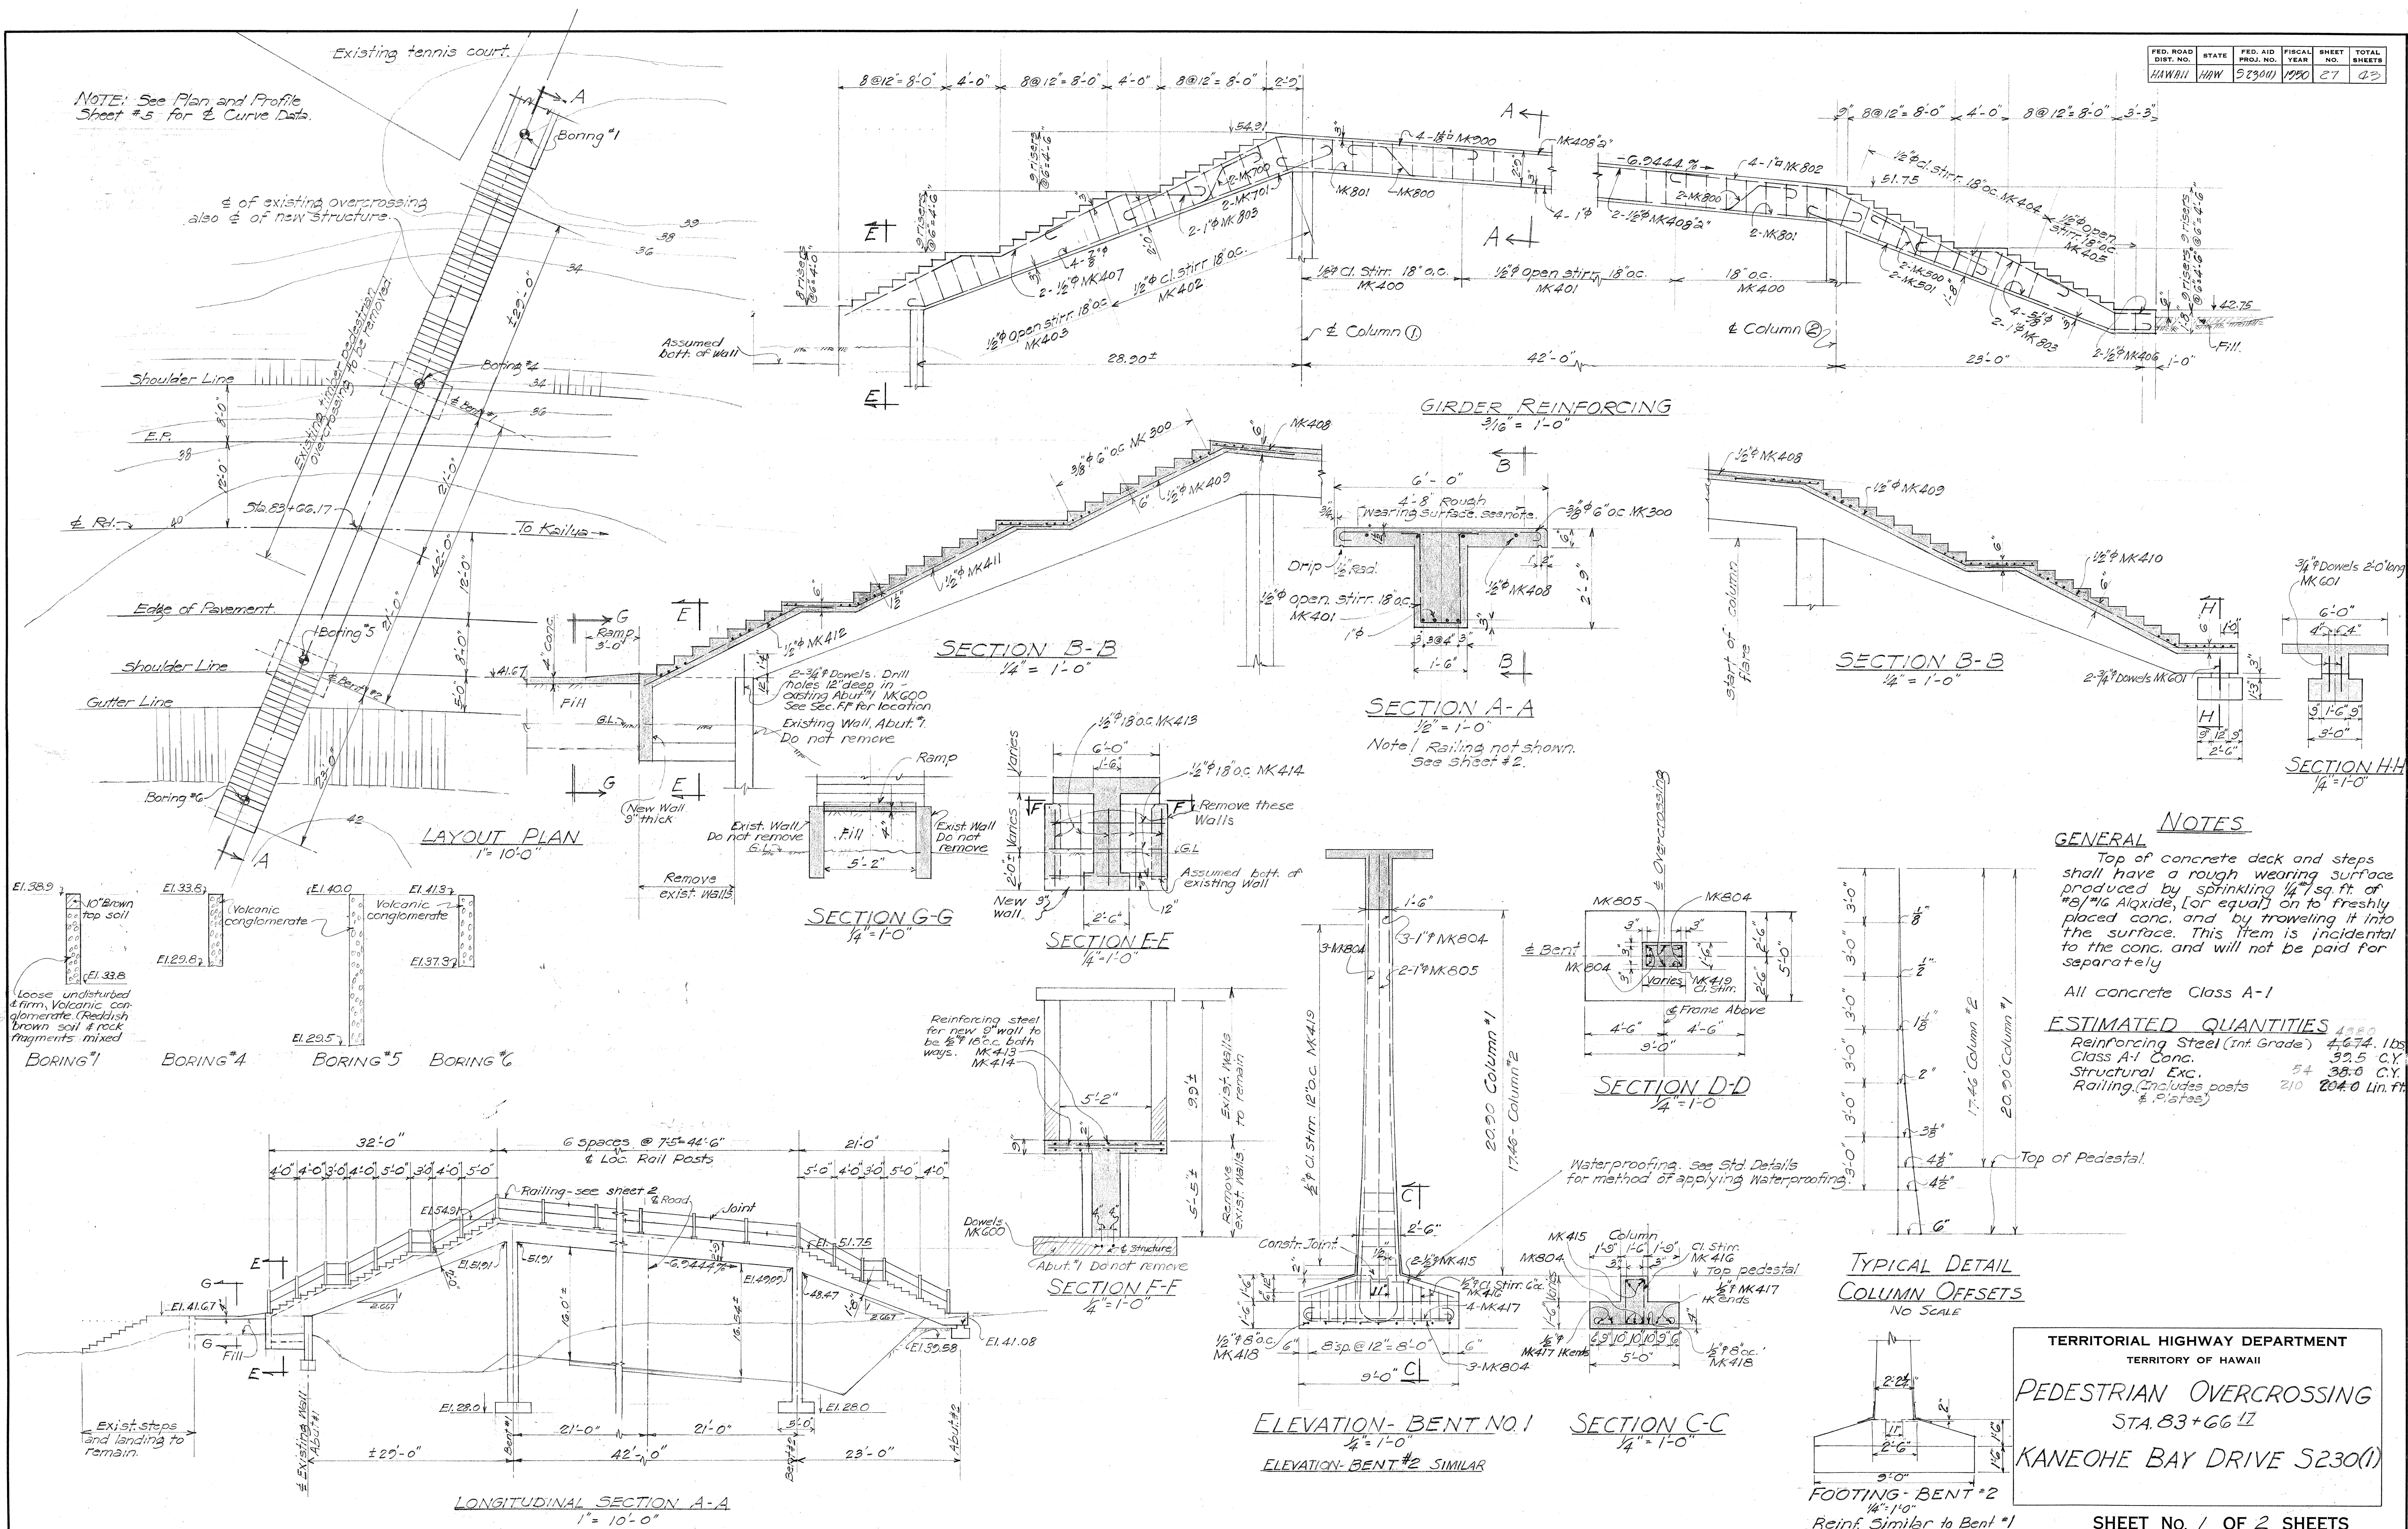


FED. ROAD DIST. NO.	STATE	FED. AID PROJ. NO.	FISCAL YEAR	SHEET NO.	TOTAL SHEETS
HAWAII	HAW	52300	1950	28	42


Revision: Galvanizing added to U bolts including nuts, washers and lock washers. 4-4-51.

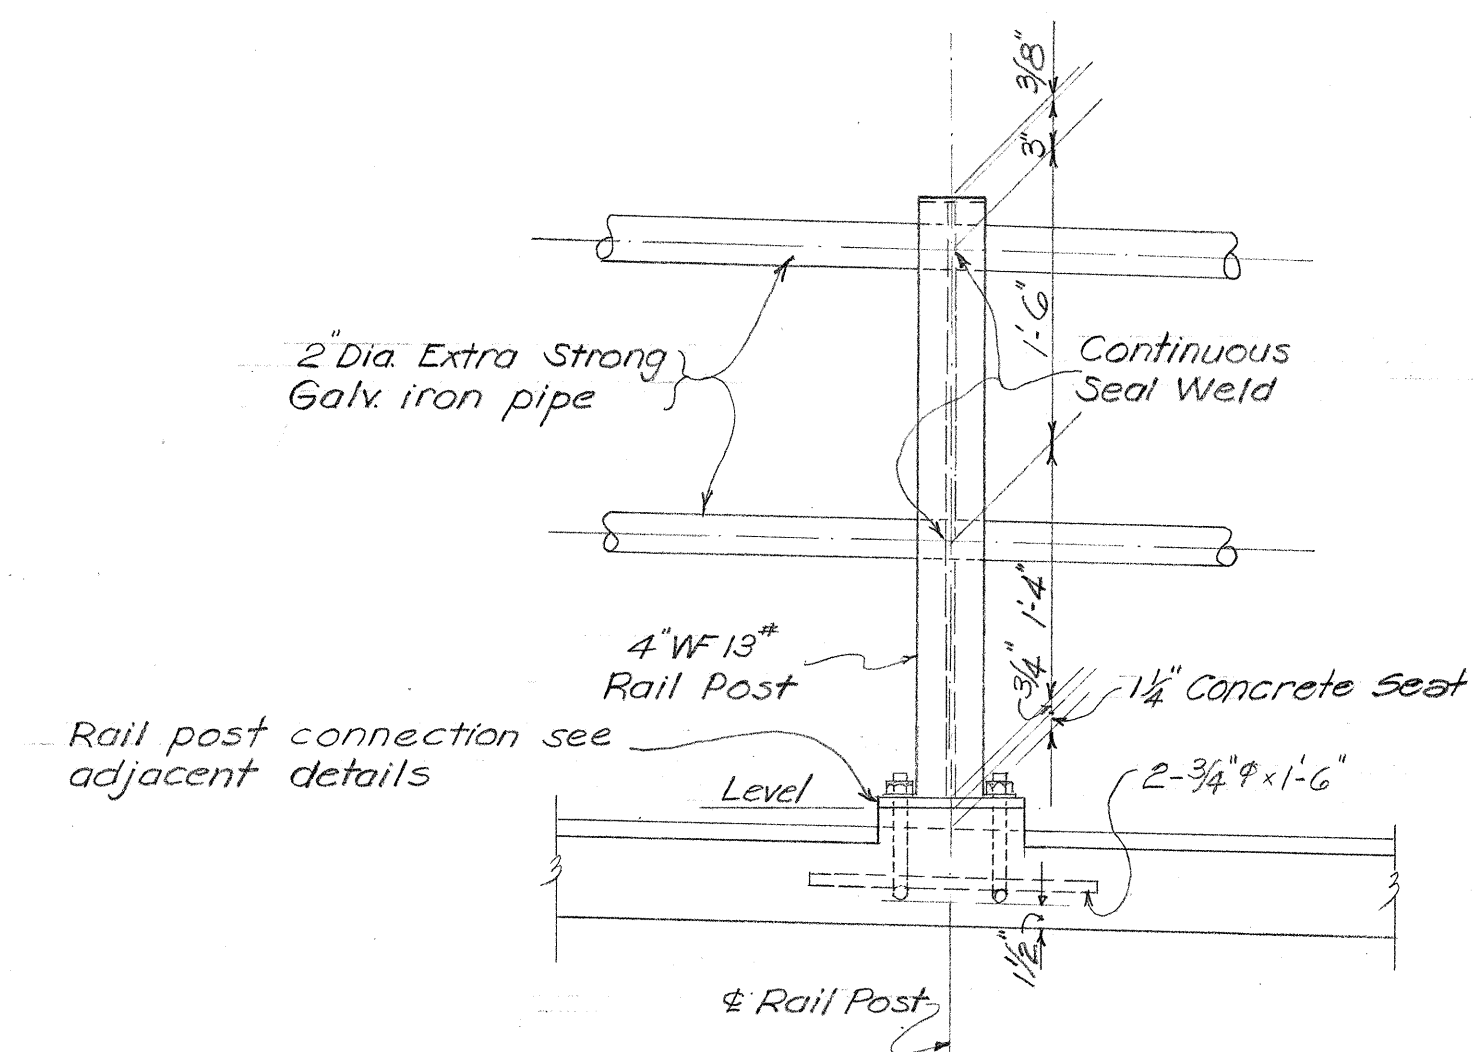


HANDRAIL DETAILS AT CENTER SPAN
1" = 1'-0"

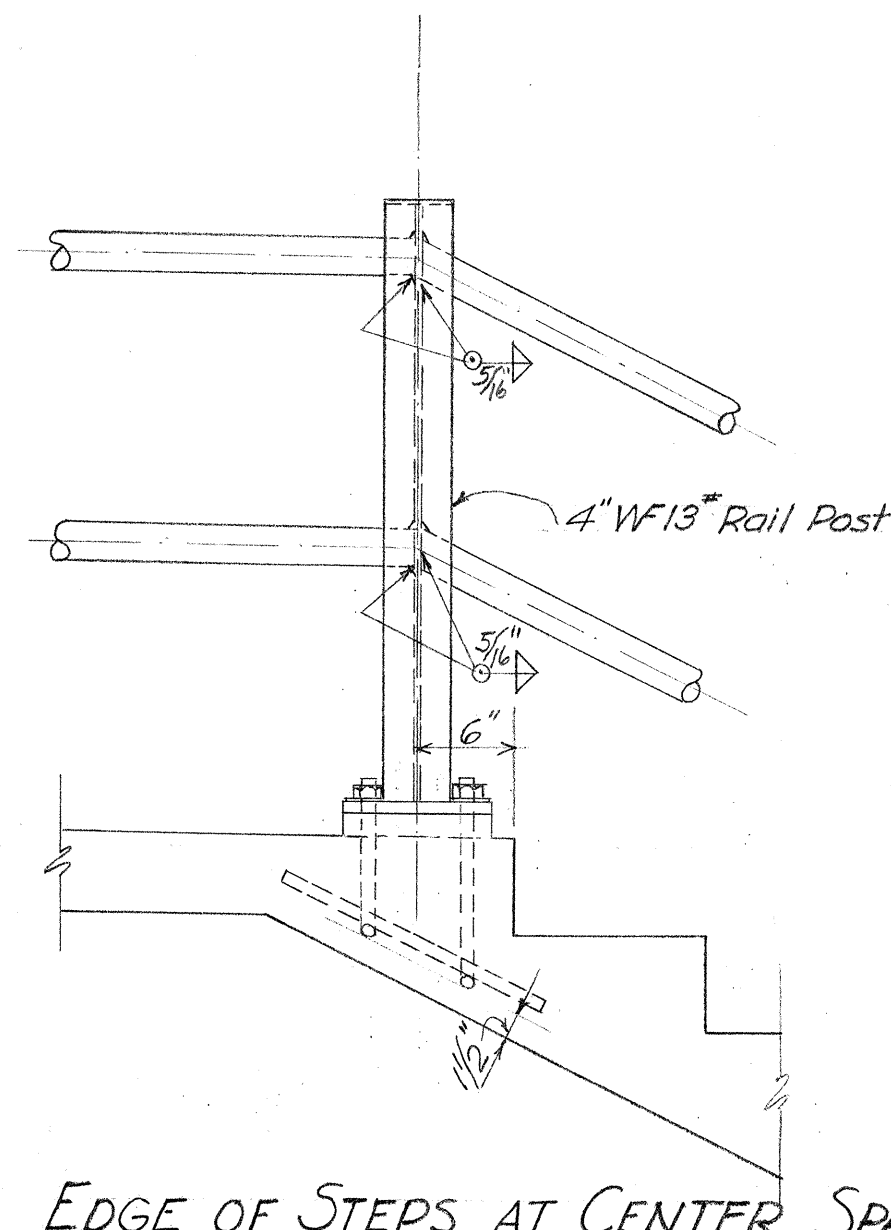

EDGE OF STEPS AT CENTER SPAN

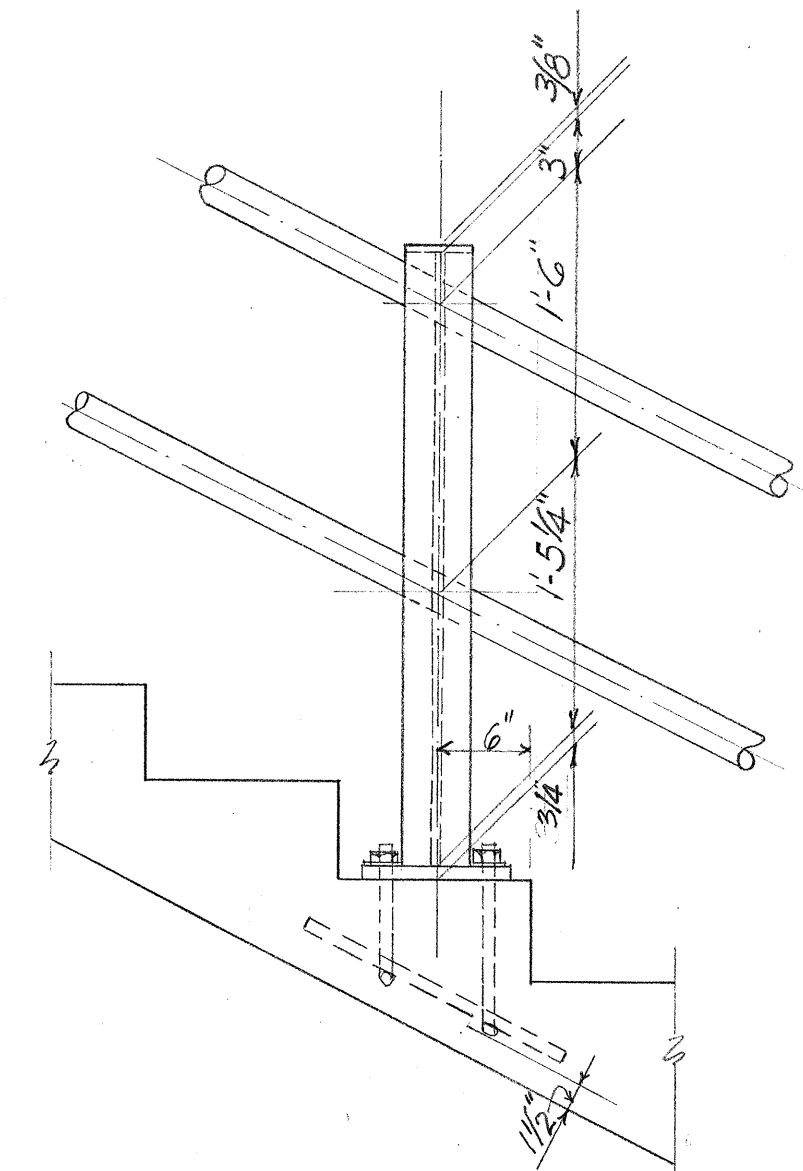


AT INTERMEDIATE POSTS

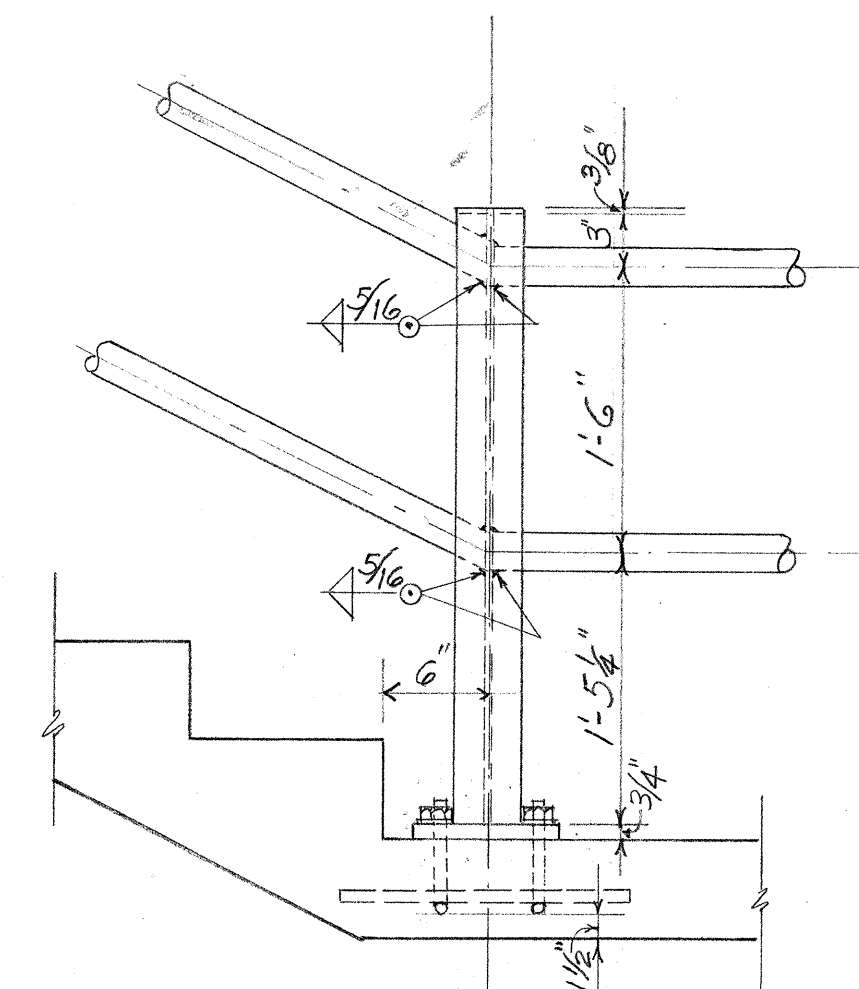


AT POSTS ON LANDINGS

HANDRAIL DETAILS AT STAIRS 1" = 1'-0"

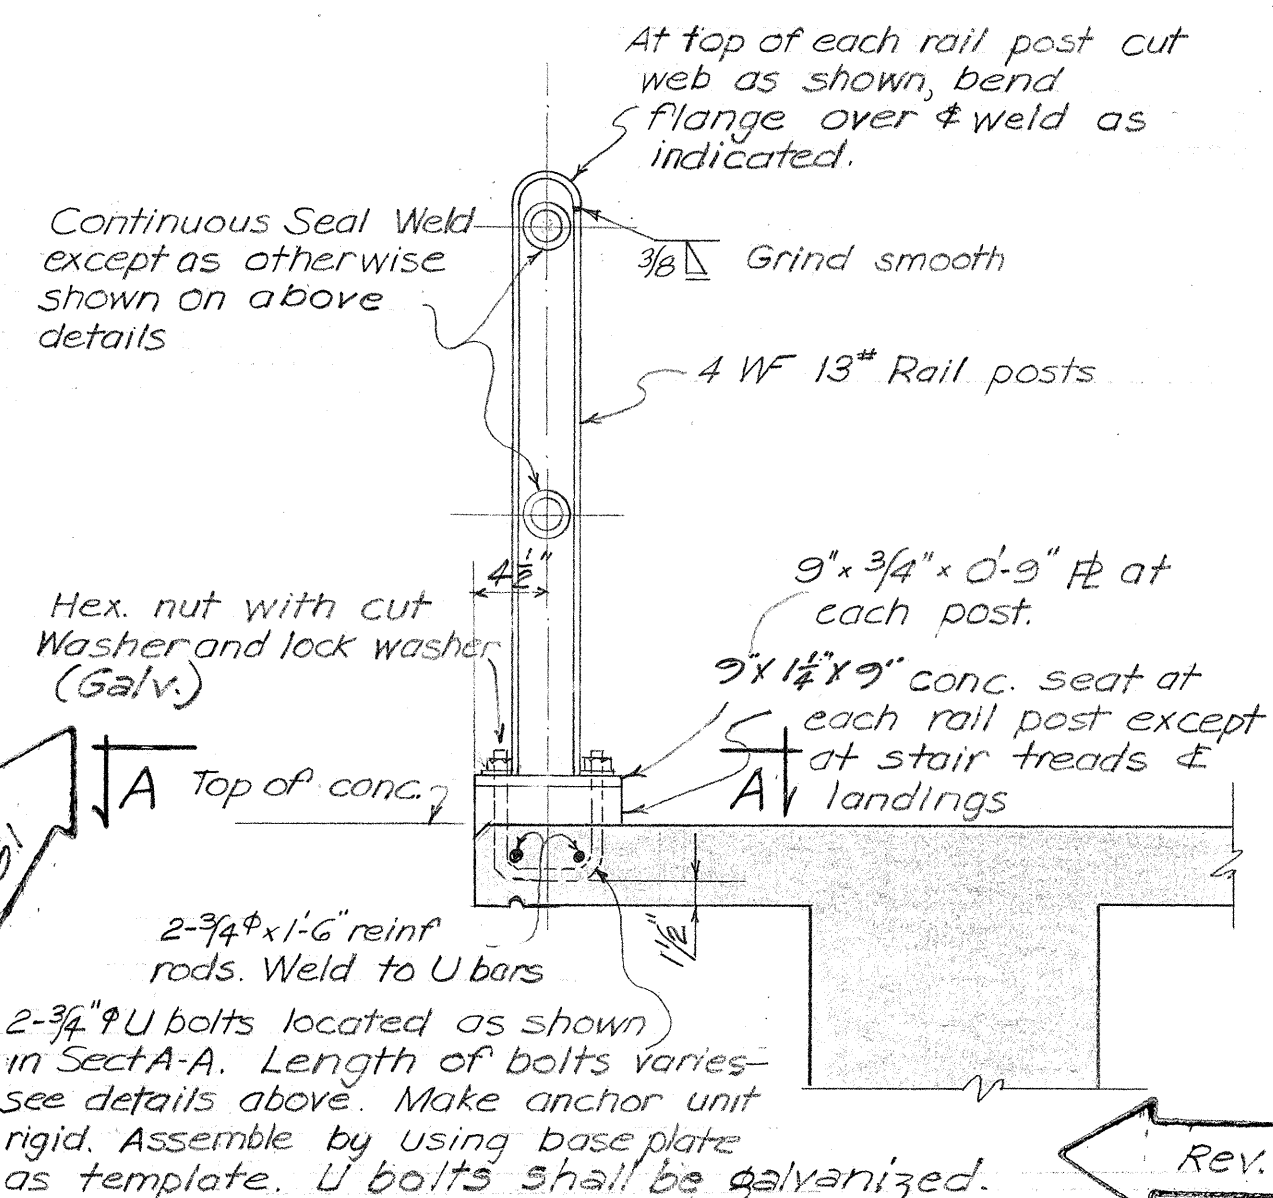


TYPICAL SECTION THRU HANDRAIL
AT CENTER SPAN
1" = 1'-0"










(SECTION THRU HANDRAIL AT STAIRS
SIMILAR EXCEPT AS OTHERWISE NOTED)

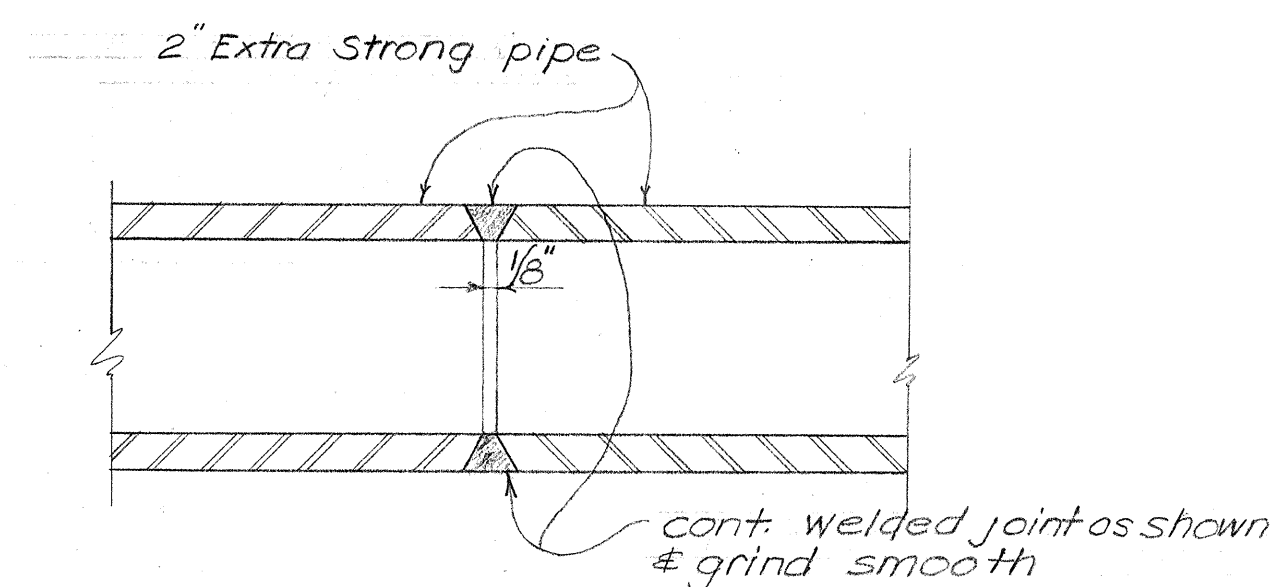

TYP. CONNECTION DETAIL
CONT. TOP & BOT. PIPE RAILING
HALF SIZE

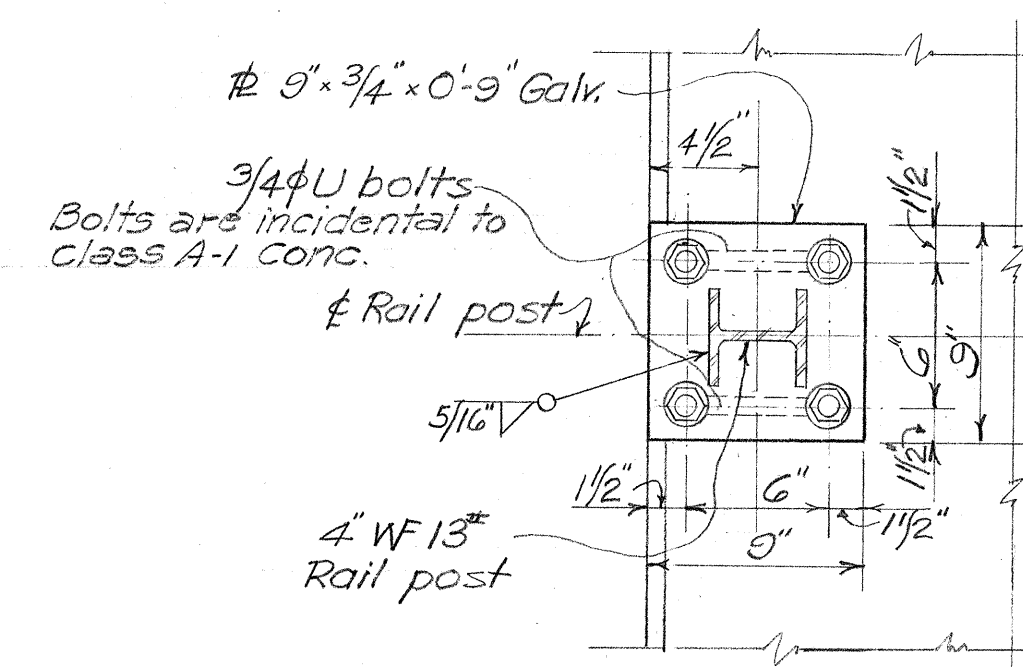

SECTION A-A
1 1/2" = 1'-0"

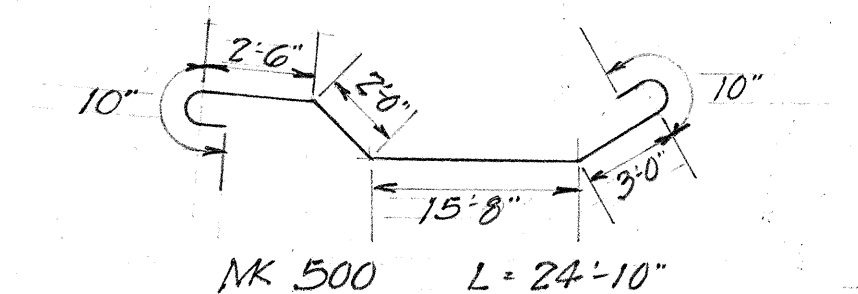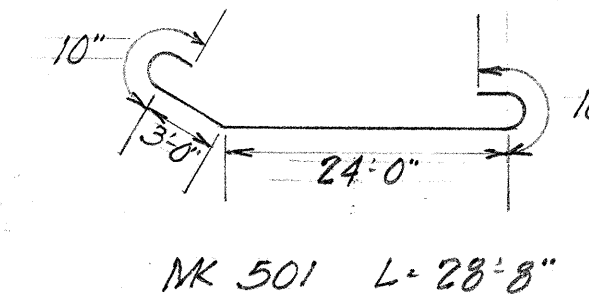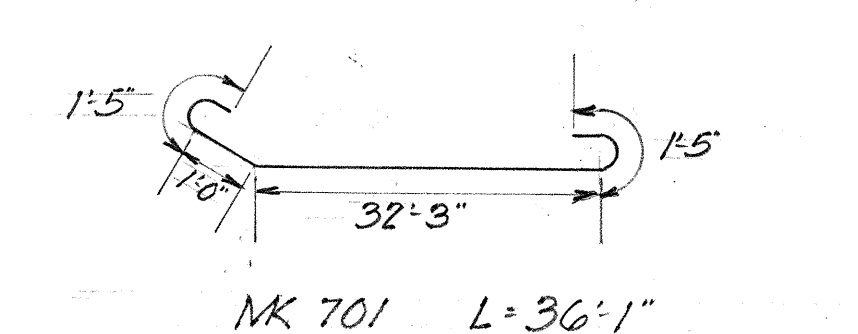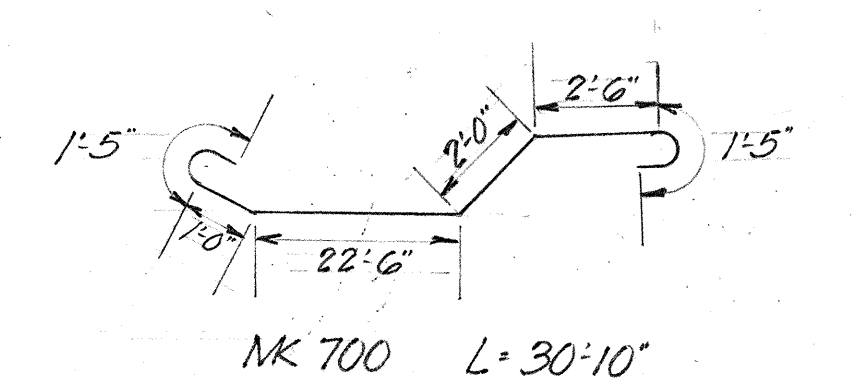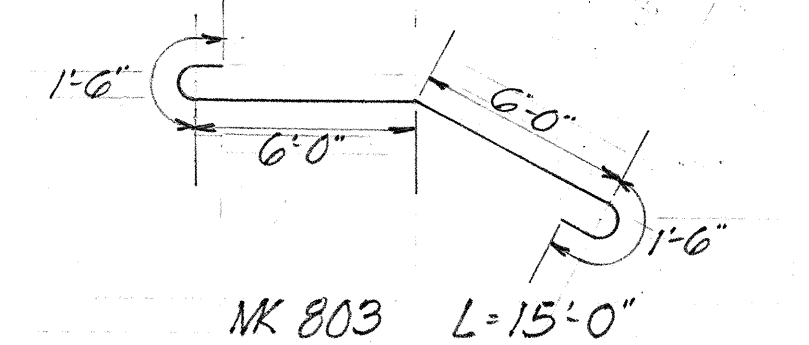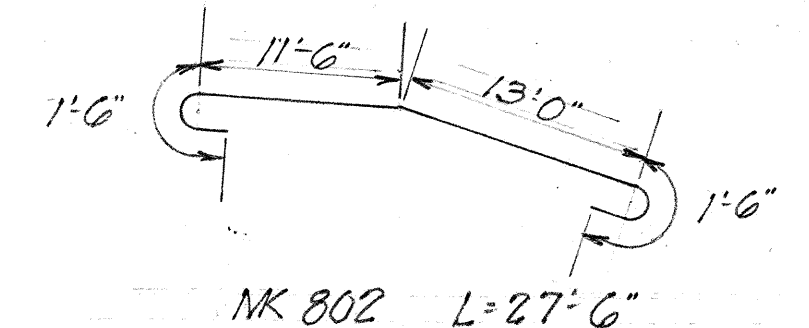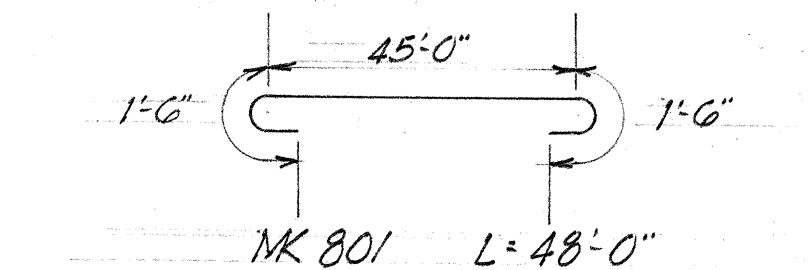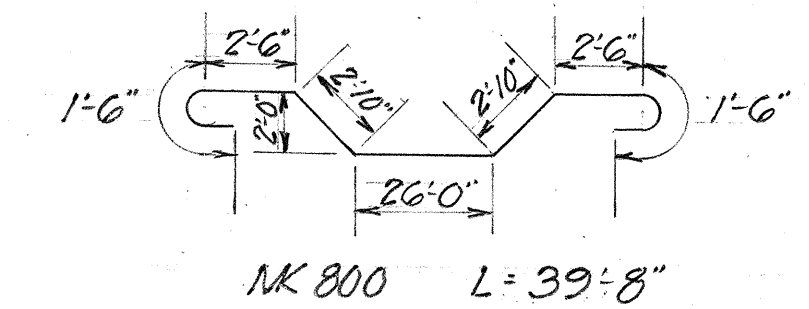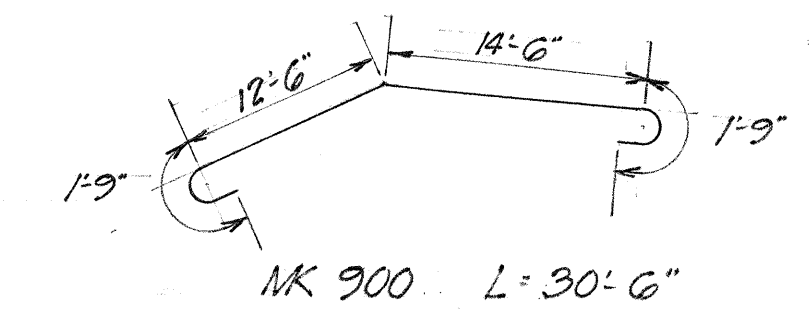

TERRITORIAL HIGHWAY DEPARTMENT
TERRITORY OF HAWAII

PEDESTRIAN OVERCROSSING
STA. 83+65.45
KANEHOE BAY DRIVE S230(1)

SHEET No. 2 OF 2 SHEETS

5473.28

DATE	3/50
SURVEY PLOTTED BY	W. S. BARTIS
DESIGNED BY	R. CHUCK
DRAWN BY	R. CHUCK
QUANTITIES CHECKED BY	
CHECKED BY	
ORIGINAL PLAN	No.
NOTEBOOK	No.