


INDEX TO DRAWINGS	
SHEET NO.	DESCRIPTION
1	TITLE SHEET
2	TYPICAL SECTION
3-6	PLAN & PROFILE
7-9	HIGHWAY LIGHTING SYSTEM
10-14	IMPROVEMENTS TO KANEHOE WATER SYSTEM
15-21	STANDARD DETAILS
22-23	INTERSECTION DETAILS
24-26	BOX CULVERT DETAILS
27-28	PEDESTRIAN OVERCROSSING
29-43	CROSS SECTIONS

CONVENTIONAL SIGNS	
Centerline	125
Boundary Lines	or
Fences (Named)	
Existing Roadways	
Circular Culvert	
Box Culvert	
Bridge	
Telephone Pole	
Electric Power Pole	
Water Main	W ₂ W ₂ (W ₄ , 8, 12, Etc.)
Storm Drain	SD ₁₂ SD ₁₂ (SD ₁₈ , 24, Etc.)
Concrete Drop Intake	C.D.I.
Standard Catch Basin	S.C.B.
Standard Manhole	S.M.H.
Sewer Manhole	S ₈ S ₈ S ₁₂
Telephone Manhole	T.M.H.
Fire Hydrant	F.H.
Tree (Large, named)	Mango, Cocoa
Railroad	

TERRITORY OF HAWAII
TERRITORIAL HIGHWAY DEPARTMENT
HONOLULU, OAHU, T. H.

PLANS OF
KANEHOE BAY DRIVE
FEDERAL AID SECONDARY PROJECT NO. S 230 (I)
DISTRICT OF KOOLAUPOKO
ISLAND OF OAHU

S C A L E S	
PLAN	1 inch = 100 feet
PROFILE	Hor. 1 inch = 100 feet
	Ver. 1 inch = 10 feet
CROSS SECTION	Hor. 1 inch = 10 feet
	Ver. 1 inch = 10 feet

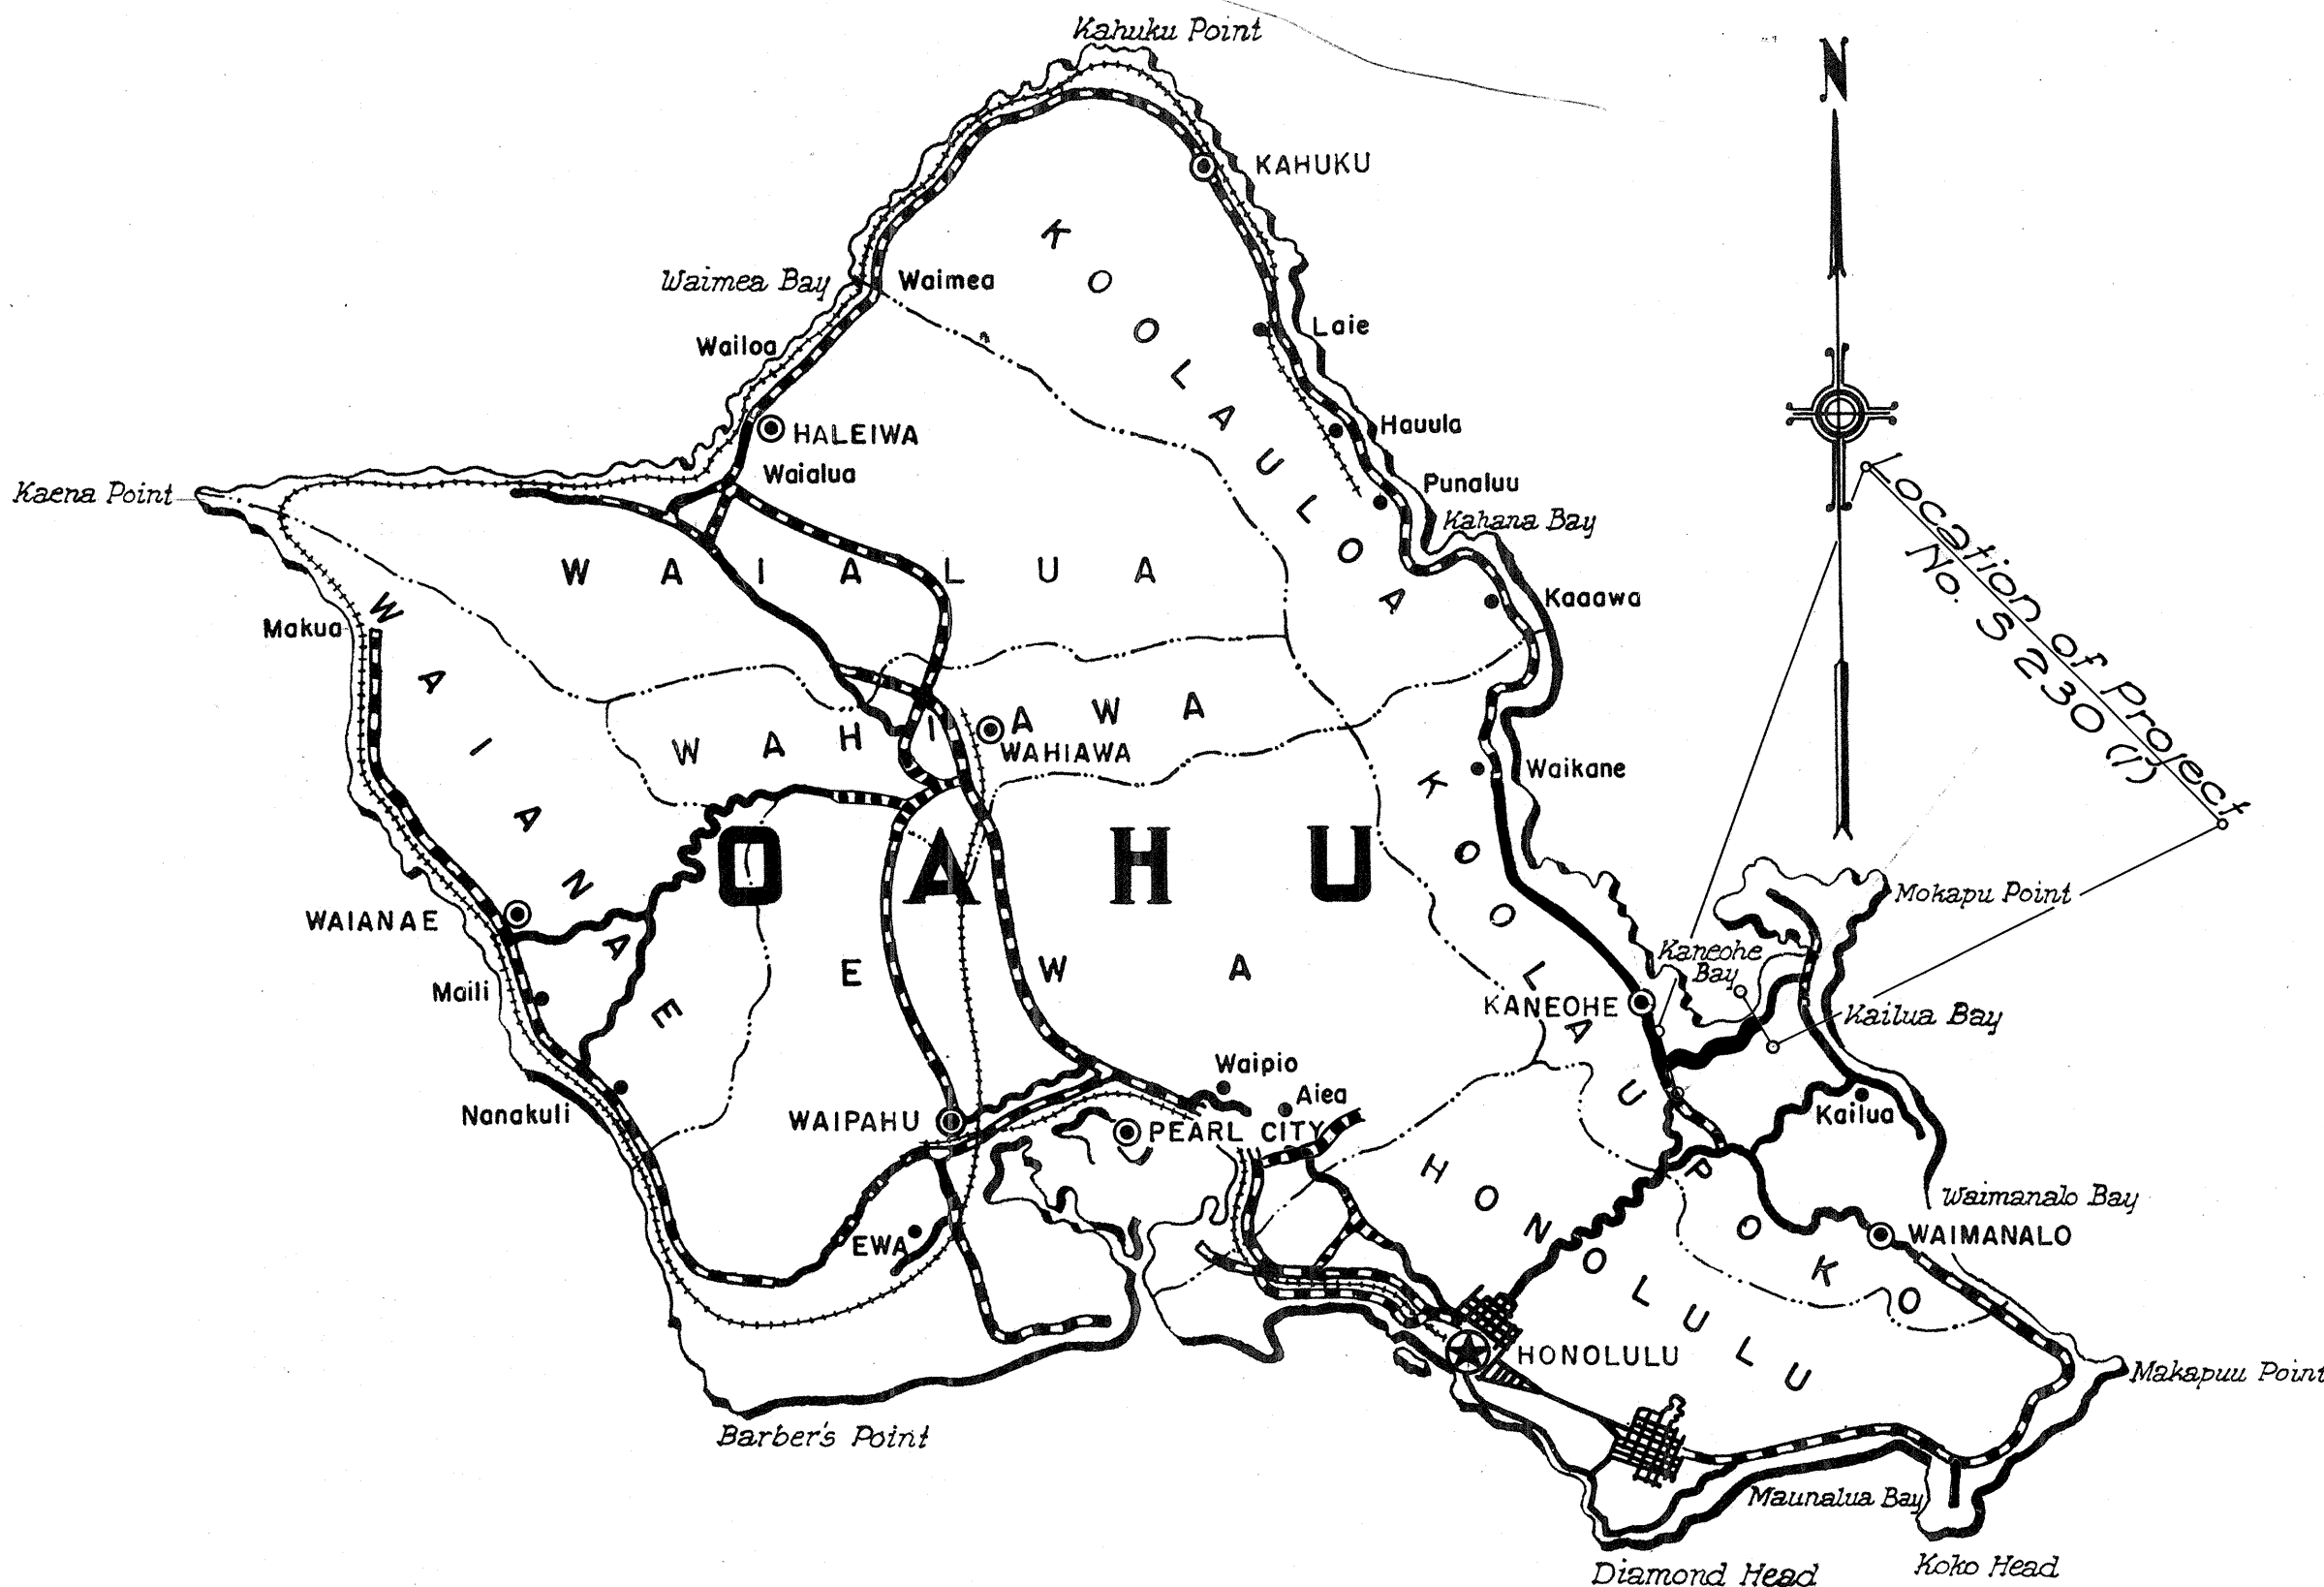


Federal Aid Projects Previously Constructed Or Under Construction

Note:
All changes made during construction have been noted in red on these tracings and checked.

By: Julian Judd
Project Engineer
Date: March 28, 1957

DATE	DESIGNED BY	DATE
PLANNED BY	DRAWN BY	CHECKED BY
NOTE BOOK	QUANTITIES BY	CHECKED BY
No.		

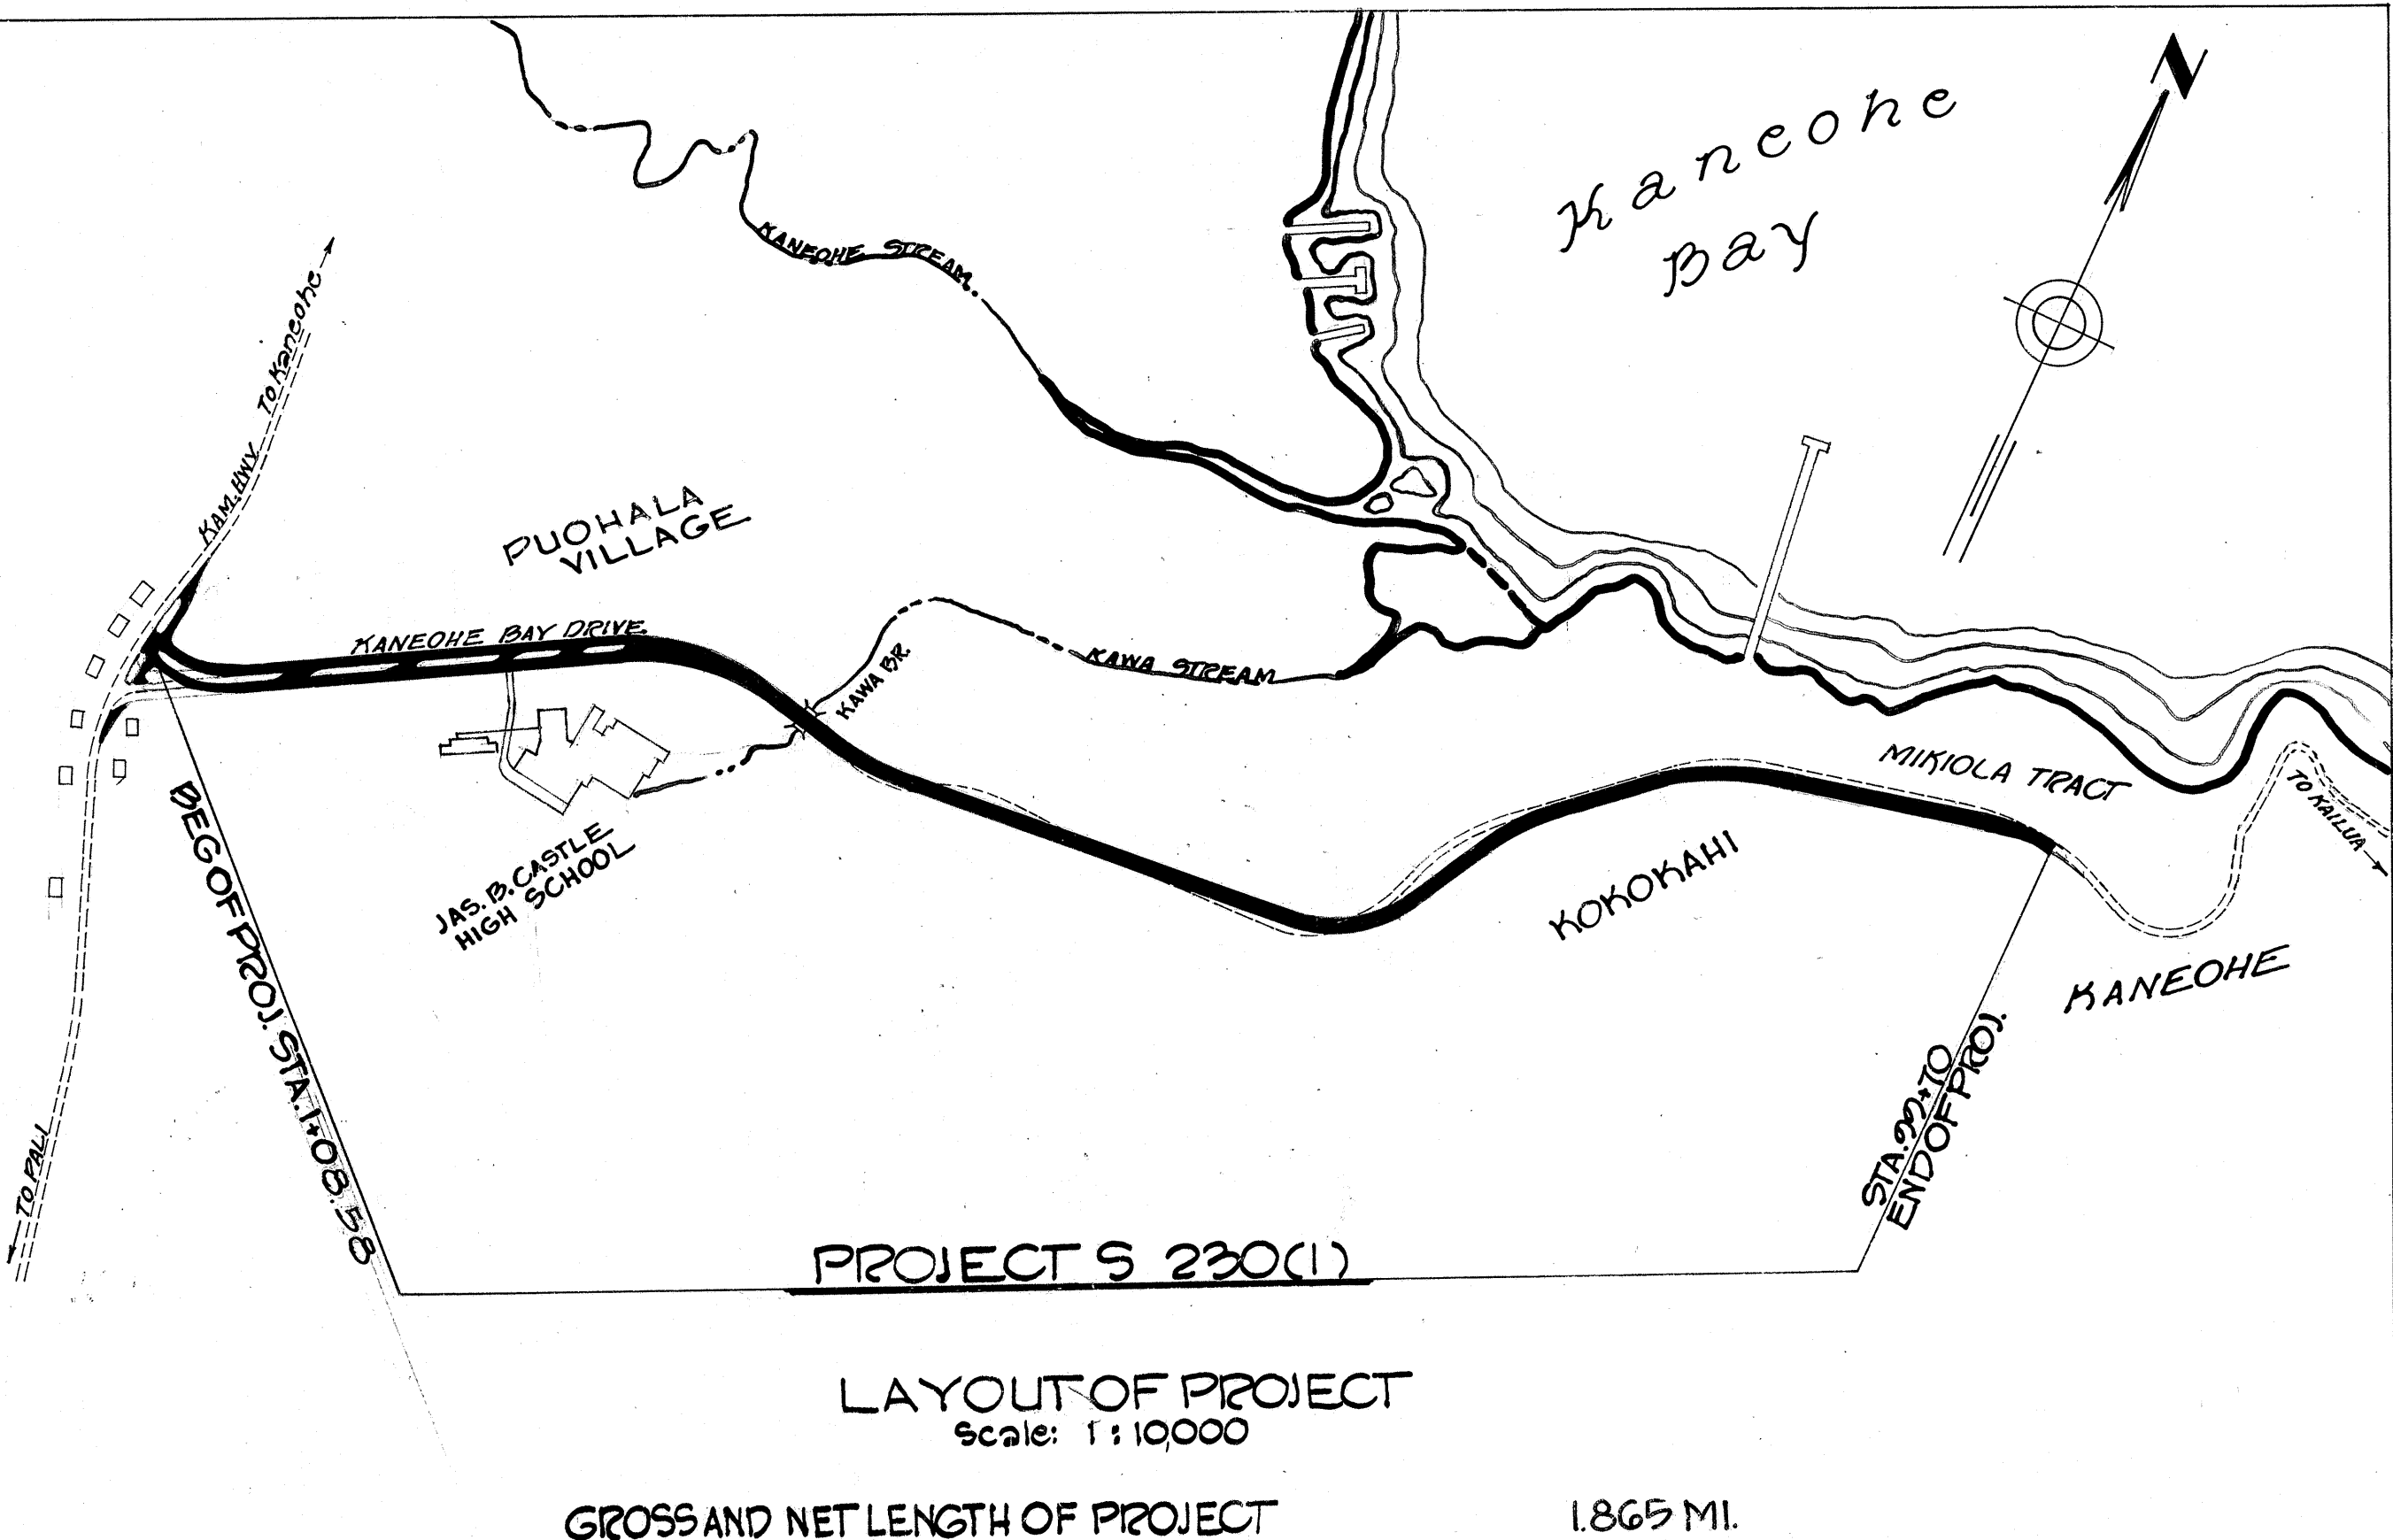

APPROVED DATE 7-7-50
Am Belt
TERRITORIAL HIGHWAY ENGINEER

DEPARTMENT OF COMMERCE BUREAU OF PUBLIC ROADS	
RECOMMENDED FOR APPROVAL:	
DISTRICT ENGINEER	DATE
APPROVED:	
DIVISION ENGINEER	DATE

5473.1