


FED. ROAD DIST. NO.	STATE	FED. AID PROJ. NO.	FISCAL YEAR	SHEET NO.	TOTAL SHEETS
HAWAII	HAWAII	W.D.R. 9(3)	1950	1	1

INDEX TO DRAWINGS	
SHEET NO.	DESCRIPTION
I	TITLE SHEET

TERRITORY OF HAWAII
TERRITORIAL HIGHWAY DEPARTMENT
HONOLULU, OAHU, T. H.

PLANS OF
REHABILITATION OF A PORTION OF
KANEOHE BAY DRIVE
WAR DAMAGE REHABILITATION PROJECT NO. W.D.R 9 (3)
DISTRICT OF KOOLAUPOKO
ISLAND OF OAHU

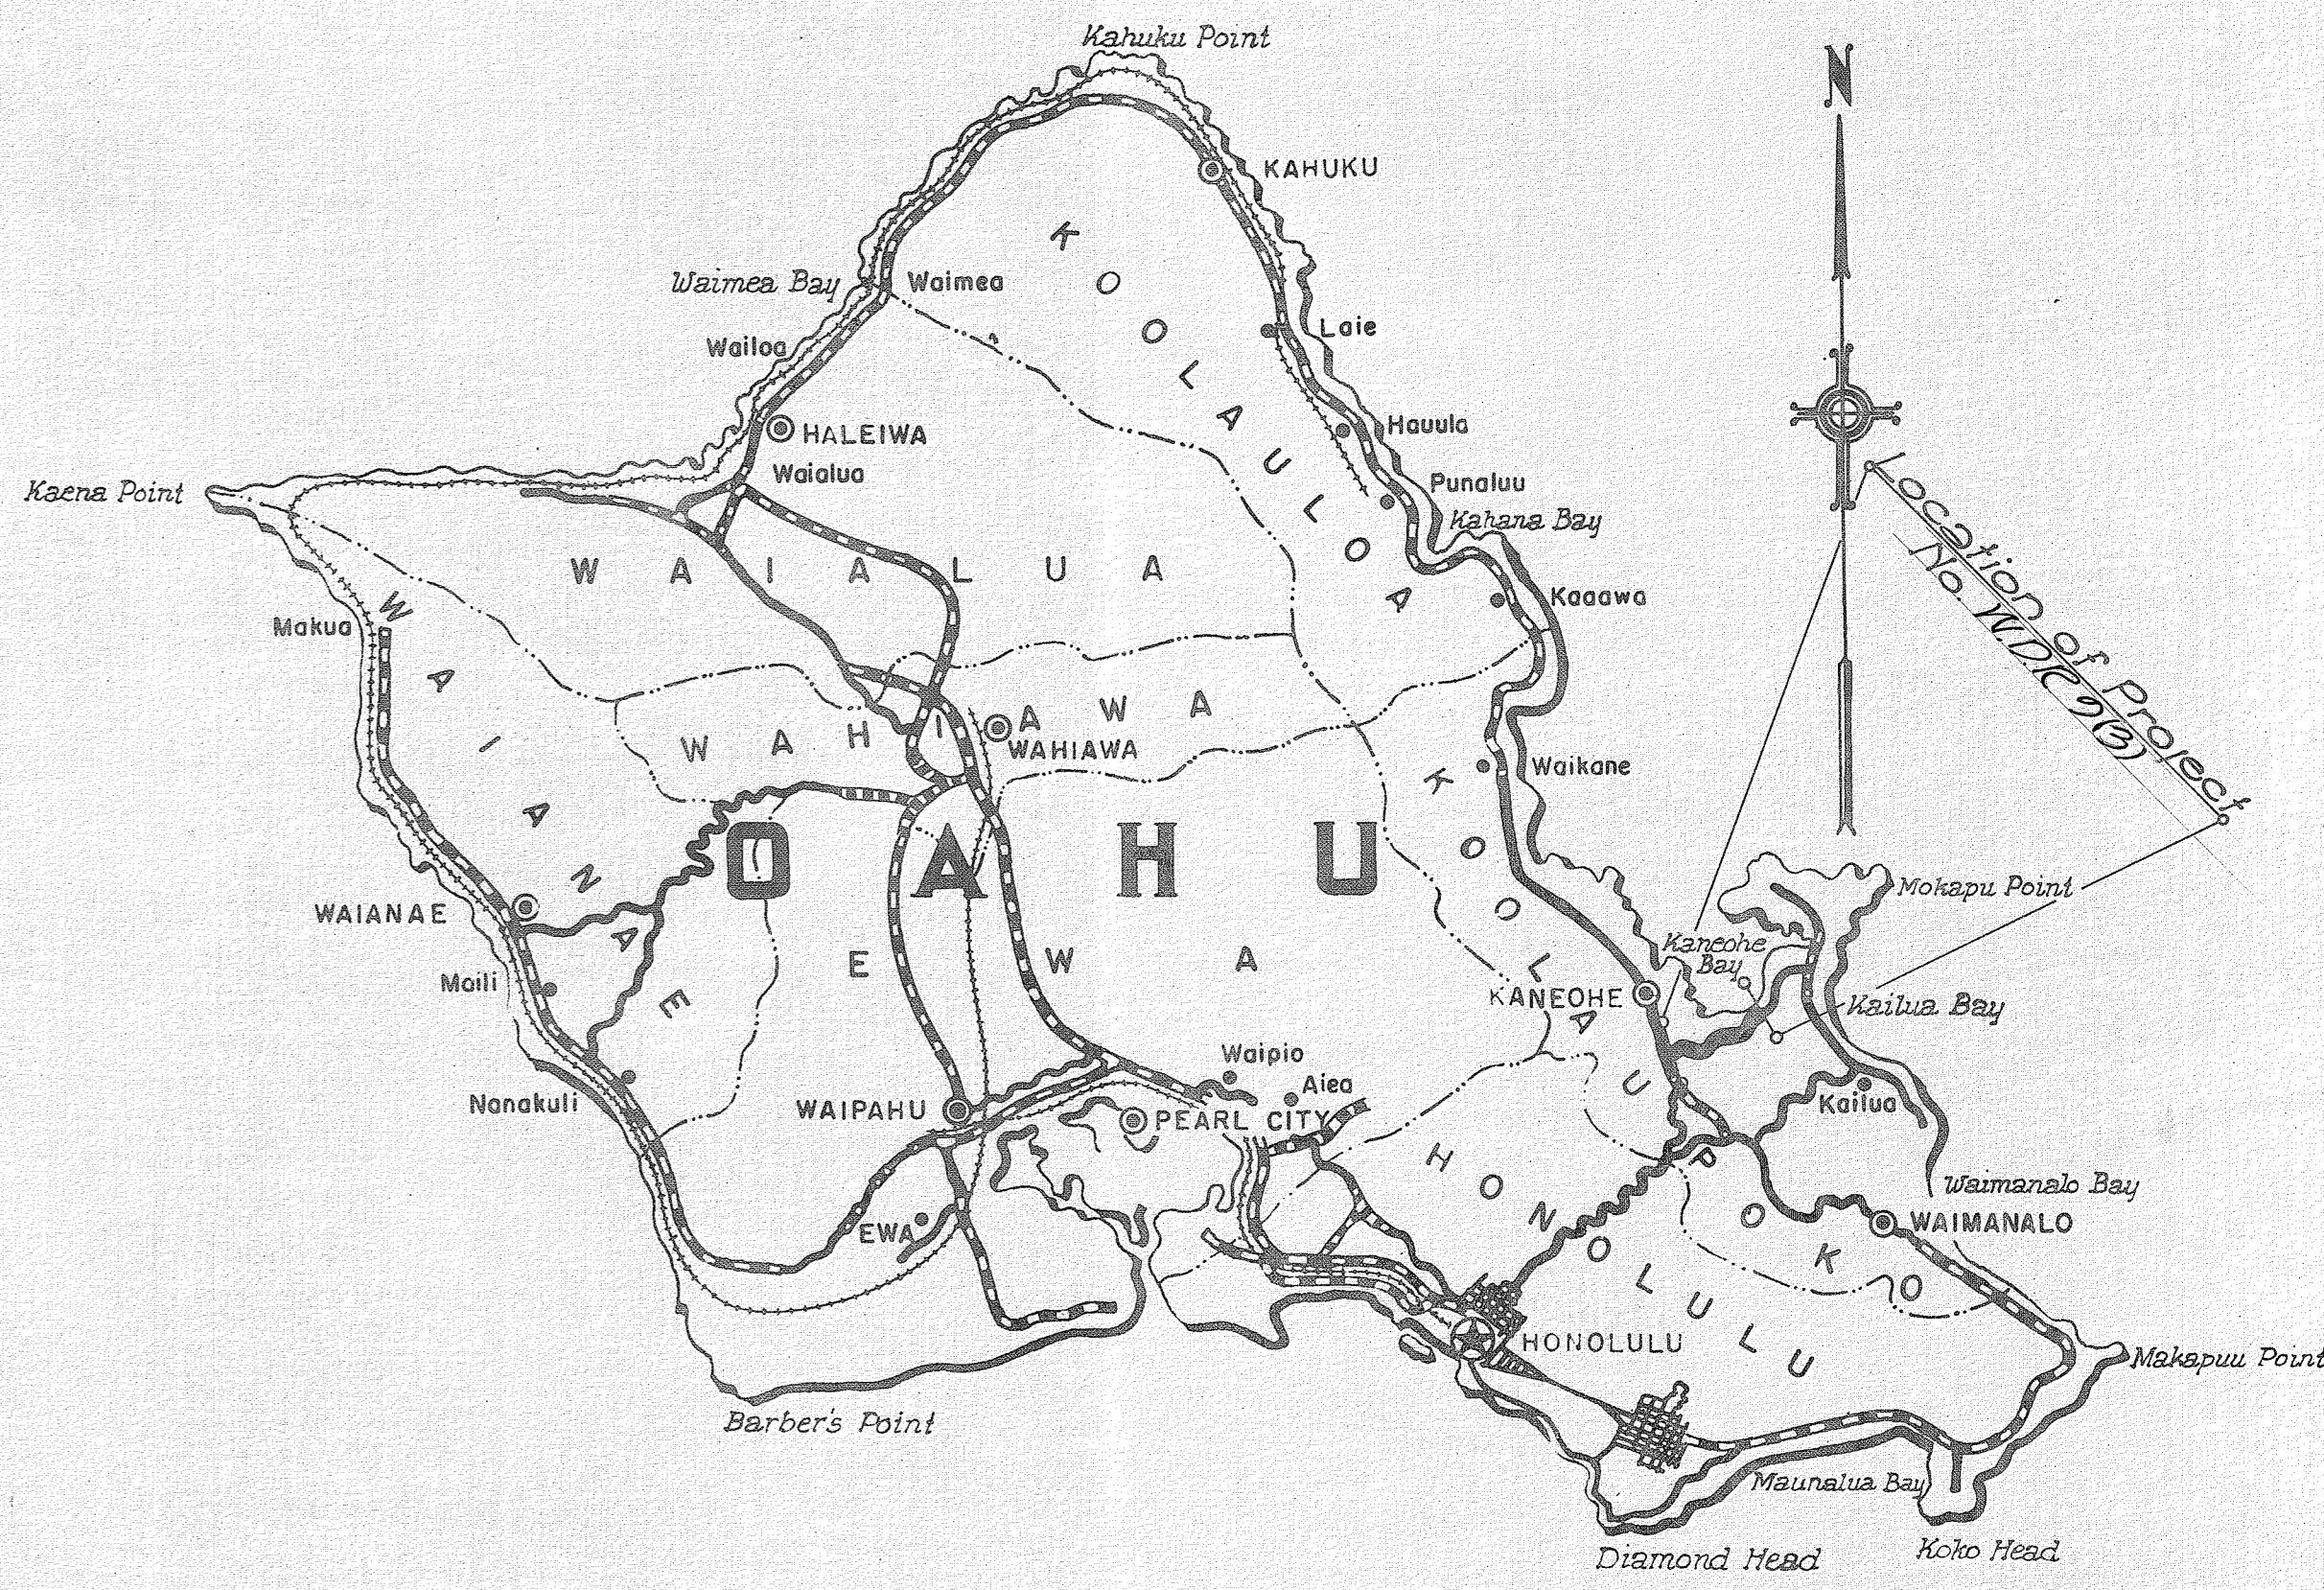

CONVENTIONAL SIGNS

Centerline 125

Boundary Lines , or

Fences (Named) - - - - -

Existing Roadways - - - - -

Circular Culvert

Box Culvert

Bridge

Telephone Pole T.P.

Electric Power Pole E.P.

Water Main W₂ - W₂ (W_{4, 8, 12, Etc.})

Storm Drain SD₁₂ - SD₁₂ (SD_{18, 24, Etc.})

Concrete Drop Intake C.D.I.

Standard Catch Basin S.C.B.

Standard Manhole S.M.S.

Sewer Manhole S₈ - S₈ - S₁₂

Telephone Manhole T.M.H.

Fire Hydrant F.H.

Tree (Large, named) Mango, Coco

Railroad

Federal Aid Projects Previously Constructed Or Under Construction

Note:
All changes made during construction have been noted in red on these tracings and checked.

By: *Lillian Judd*
Project Engineer

Date: *March 25, 1952*

DATE

SURVEY PLOTTED BY

DESIGNED BY


DRAWN BY

NOTE BOOK

QUANTITIES CHECKED BY

CHECKED BY

No.

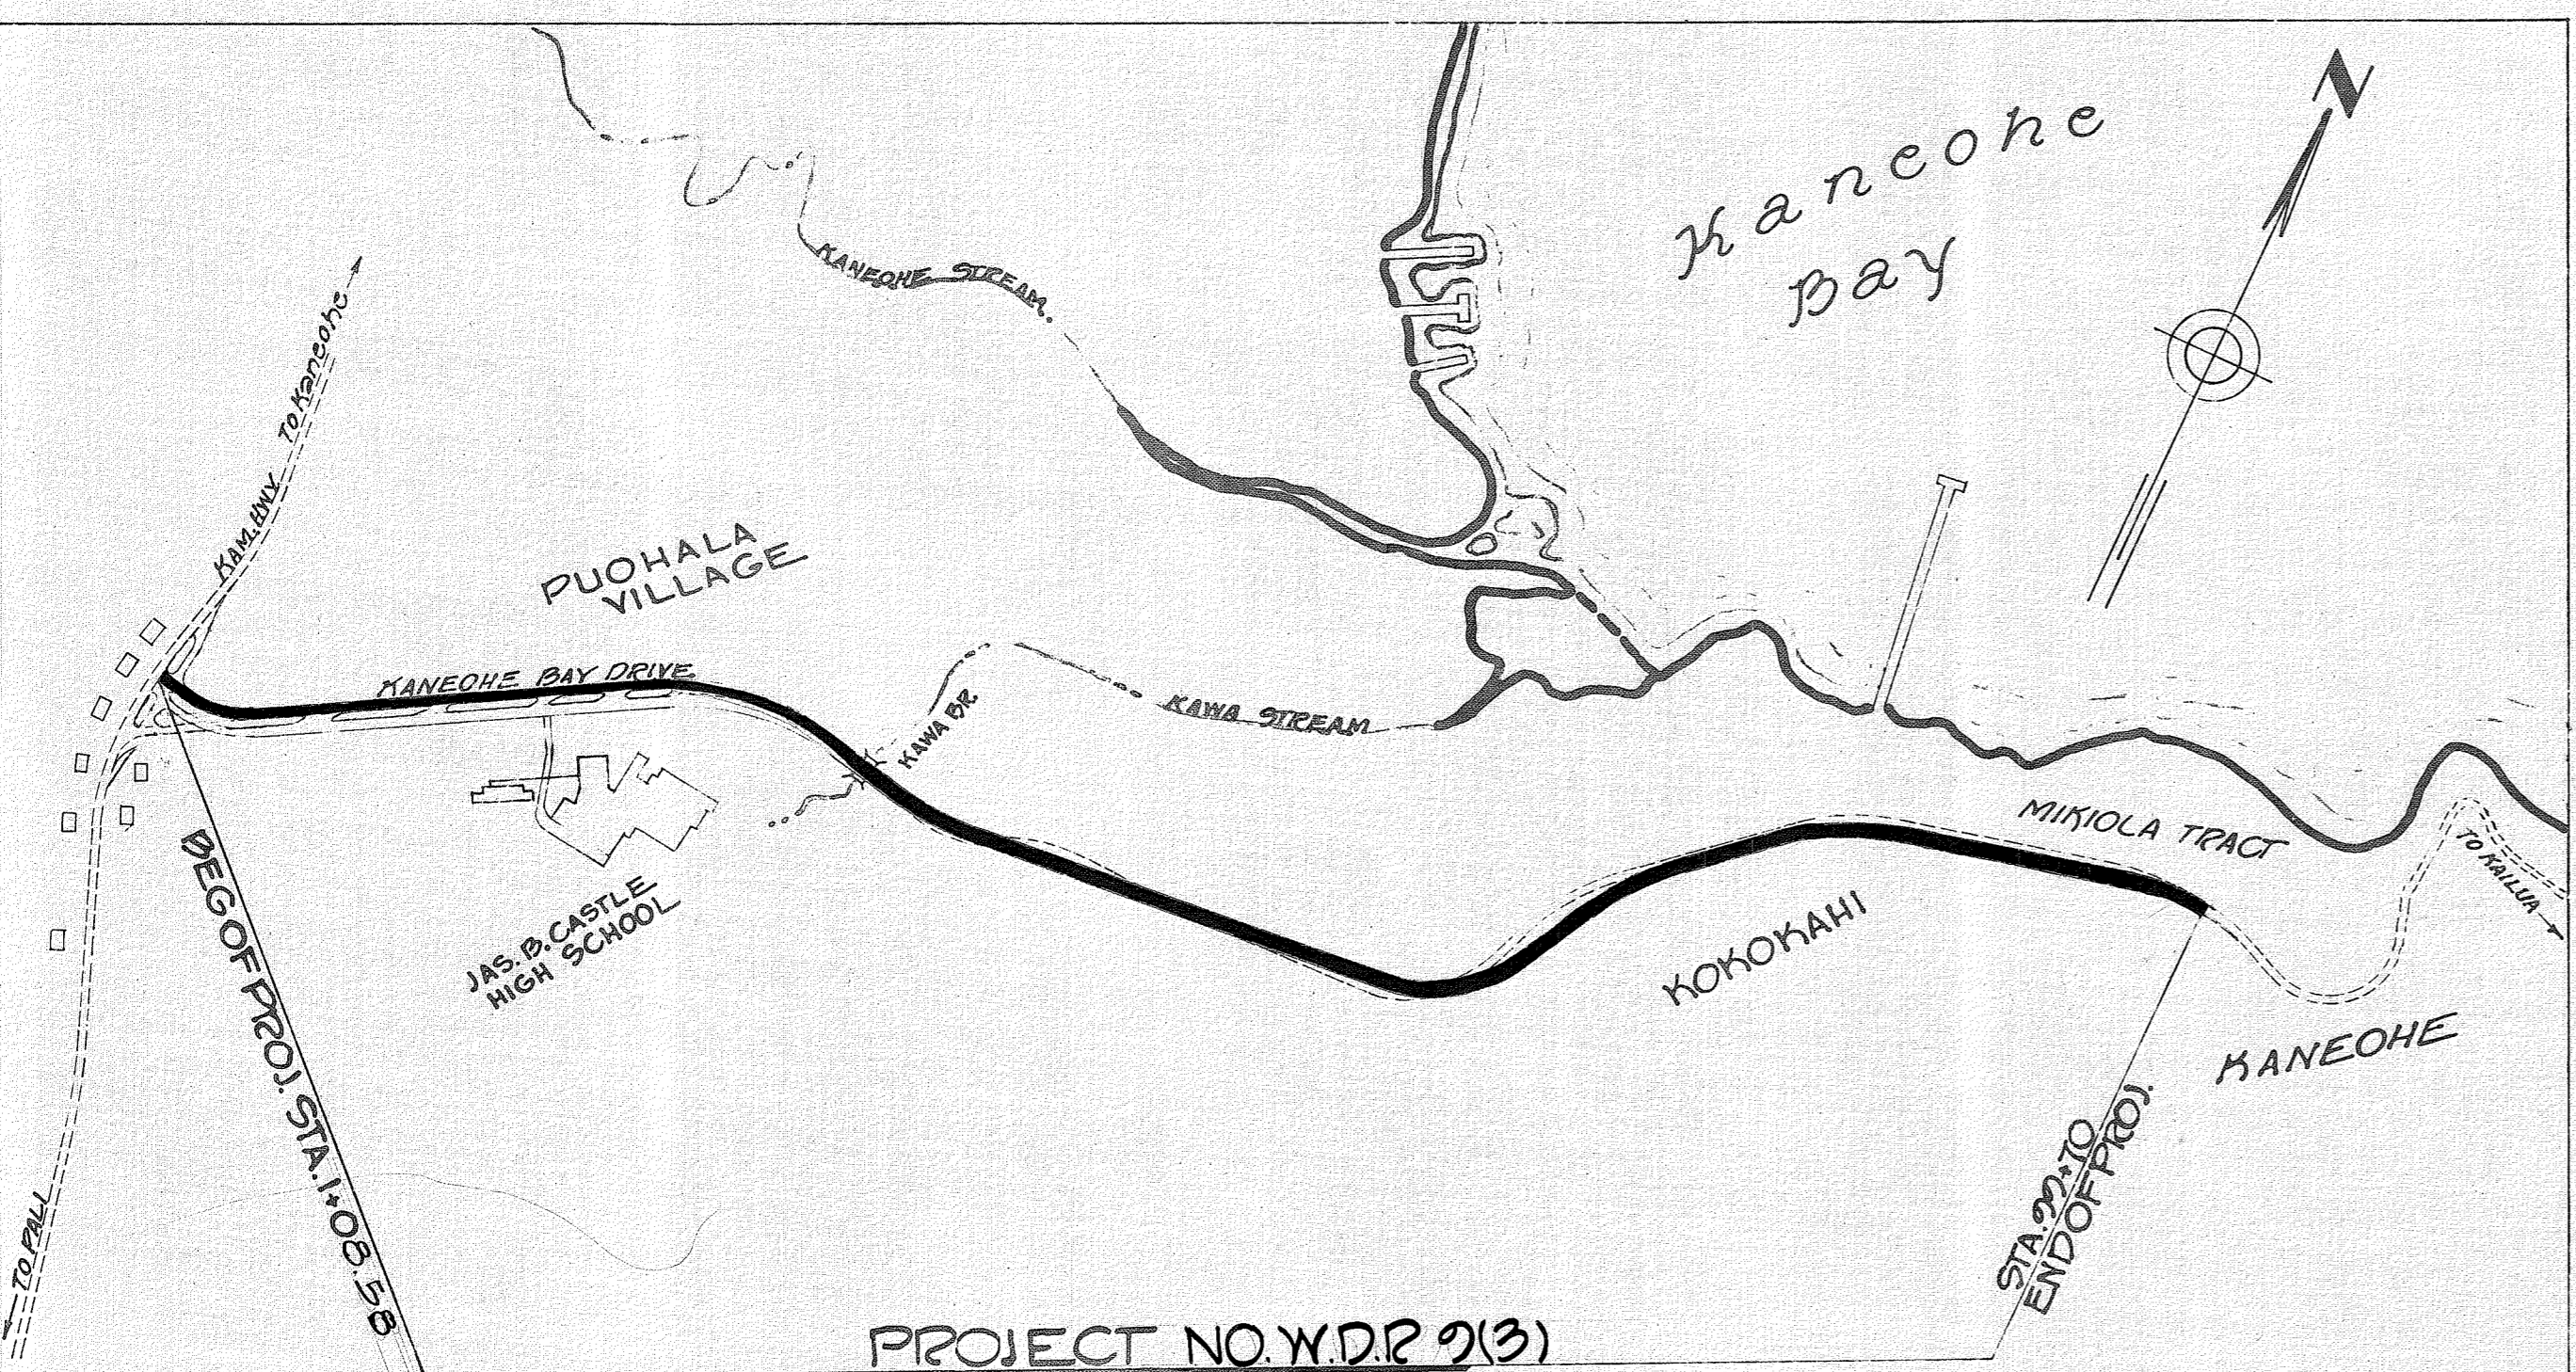

PROJECT NO. W.D.R 9(3)

LAYOUT OF PROJECT
Scale: 1:10,000

GROSS AND NET LENGTH OF PROJECT 1.865 MI.

APPROVED DATE 7-7-50

Lillian Judd
TERRITORIAL HIGHWAY ENGINEER

DEPARTMENT OF COMMERCE
BUREAU OF PUBLIC ROADS

RECOMMENDED FOR APPROVAL:

DISTRICT ENGINEER DATE

APPROVED:

DIVISION ENGINEER DATE

5485.1