



FED. ROAD DIST. NO.	STATE	FED. AID PROJ. NO.	FISCAL YEAR	SHEET NO.	TOTAL SHEETS
HAWAII	HAW.	5-0630(6)	1958	10	27

PLAN	DATE
BY: R. M. Tenwill	
PLOTTED: F. L. Lau	
CHECKED: O. Miyamoto	
NOTE BOOK: PLANNING CHECKED	
NO.:	
RT. OF WAY CHECKED:	

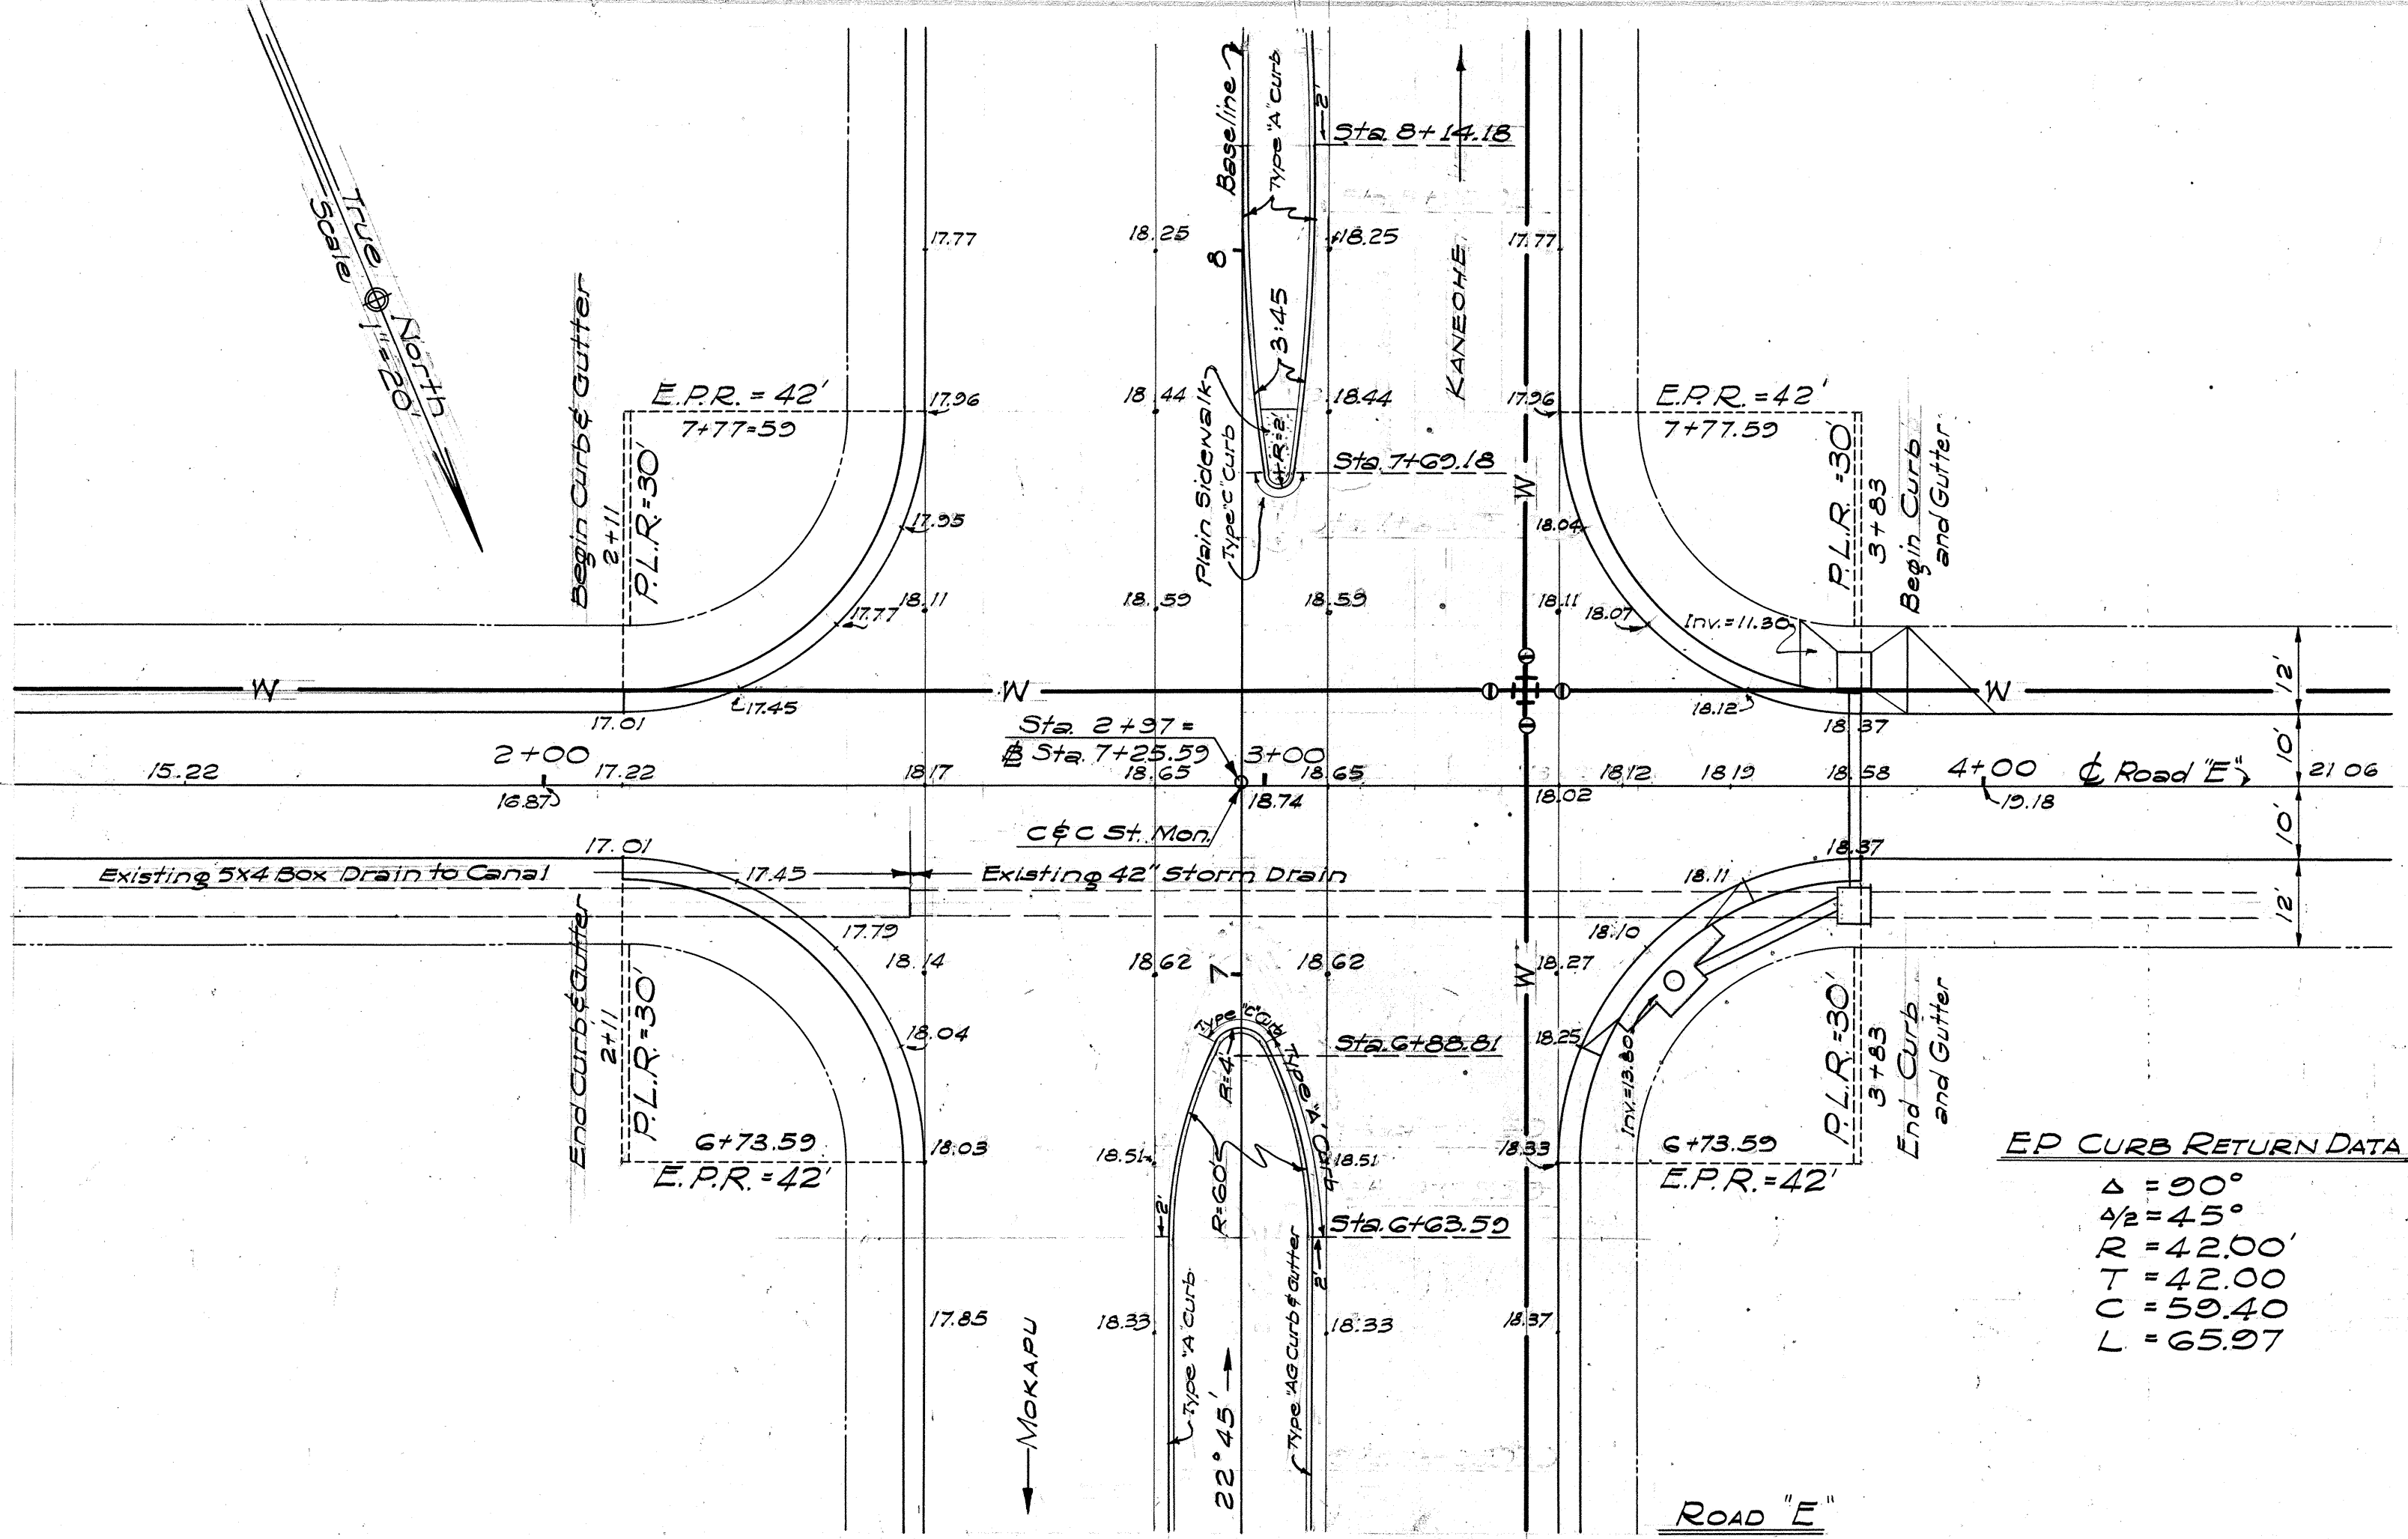


EP CURB RETURN DATA	
$\Delta = 90^\circ$	
$\Delta/2 = 45^\circ$	
$R = 42.00'$	
$T = 42.00'$	
$C = 59.40'$	
$L = 65.97'$	

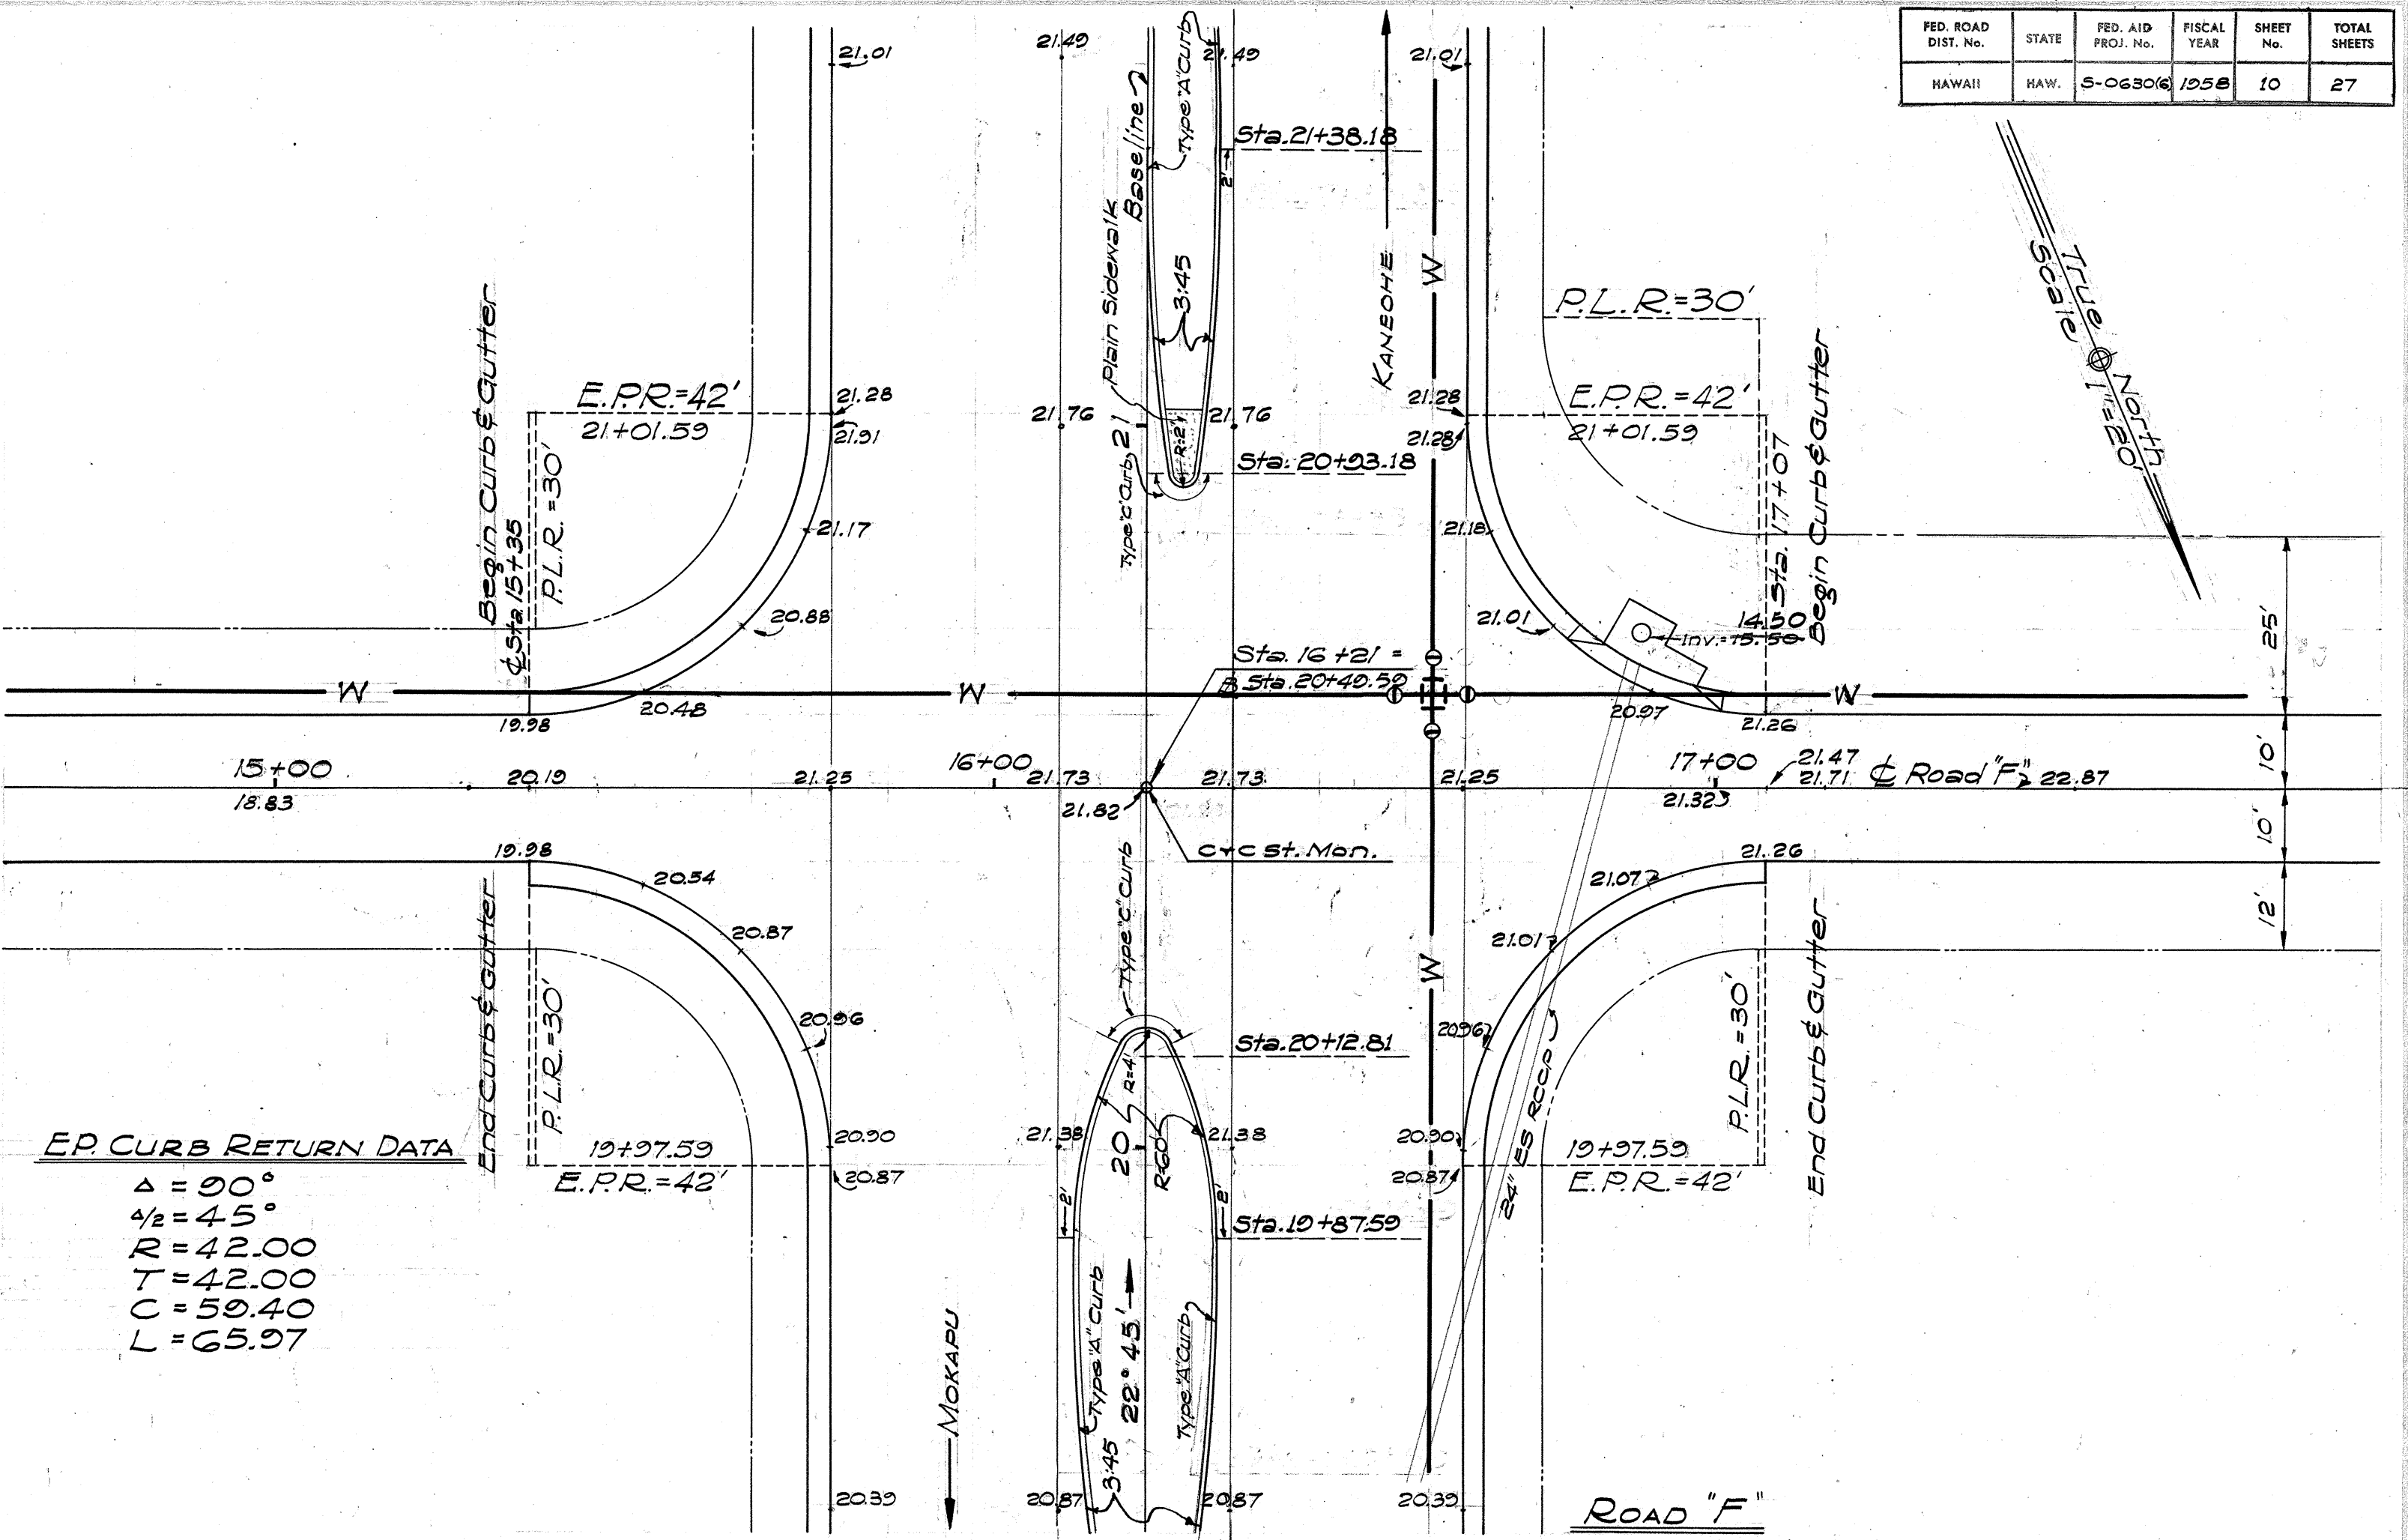

EP CURB RETURN DATA	
$\Delta = 90^\circ$	
$\Delta/2 = 45^\circ$	
$R = 42.00'$	
$T = 42.00'$	
$C = 59.40'$	
$L = 65.97'$	

PROFILE	DATE
BY: R. M. Tenwill	
PLOTTED: F. L. Lau	
CHECKED: O. Miyamoto	
NOTE BOOK: GRADES CHECKED	
NO.:	
STRUCTURE NOTATIONS CHKD:	

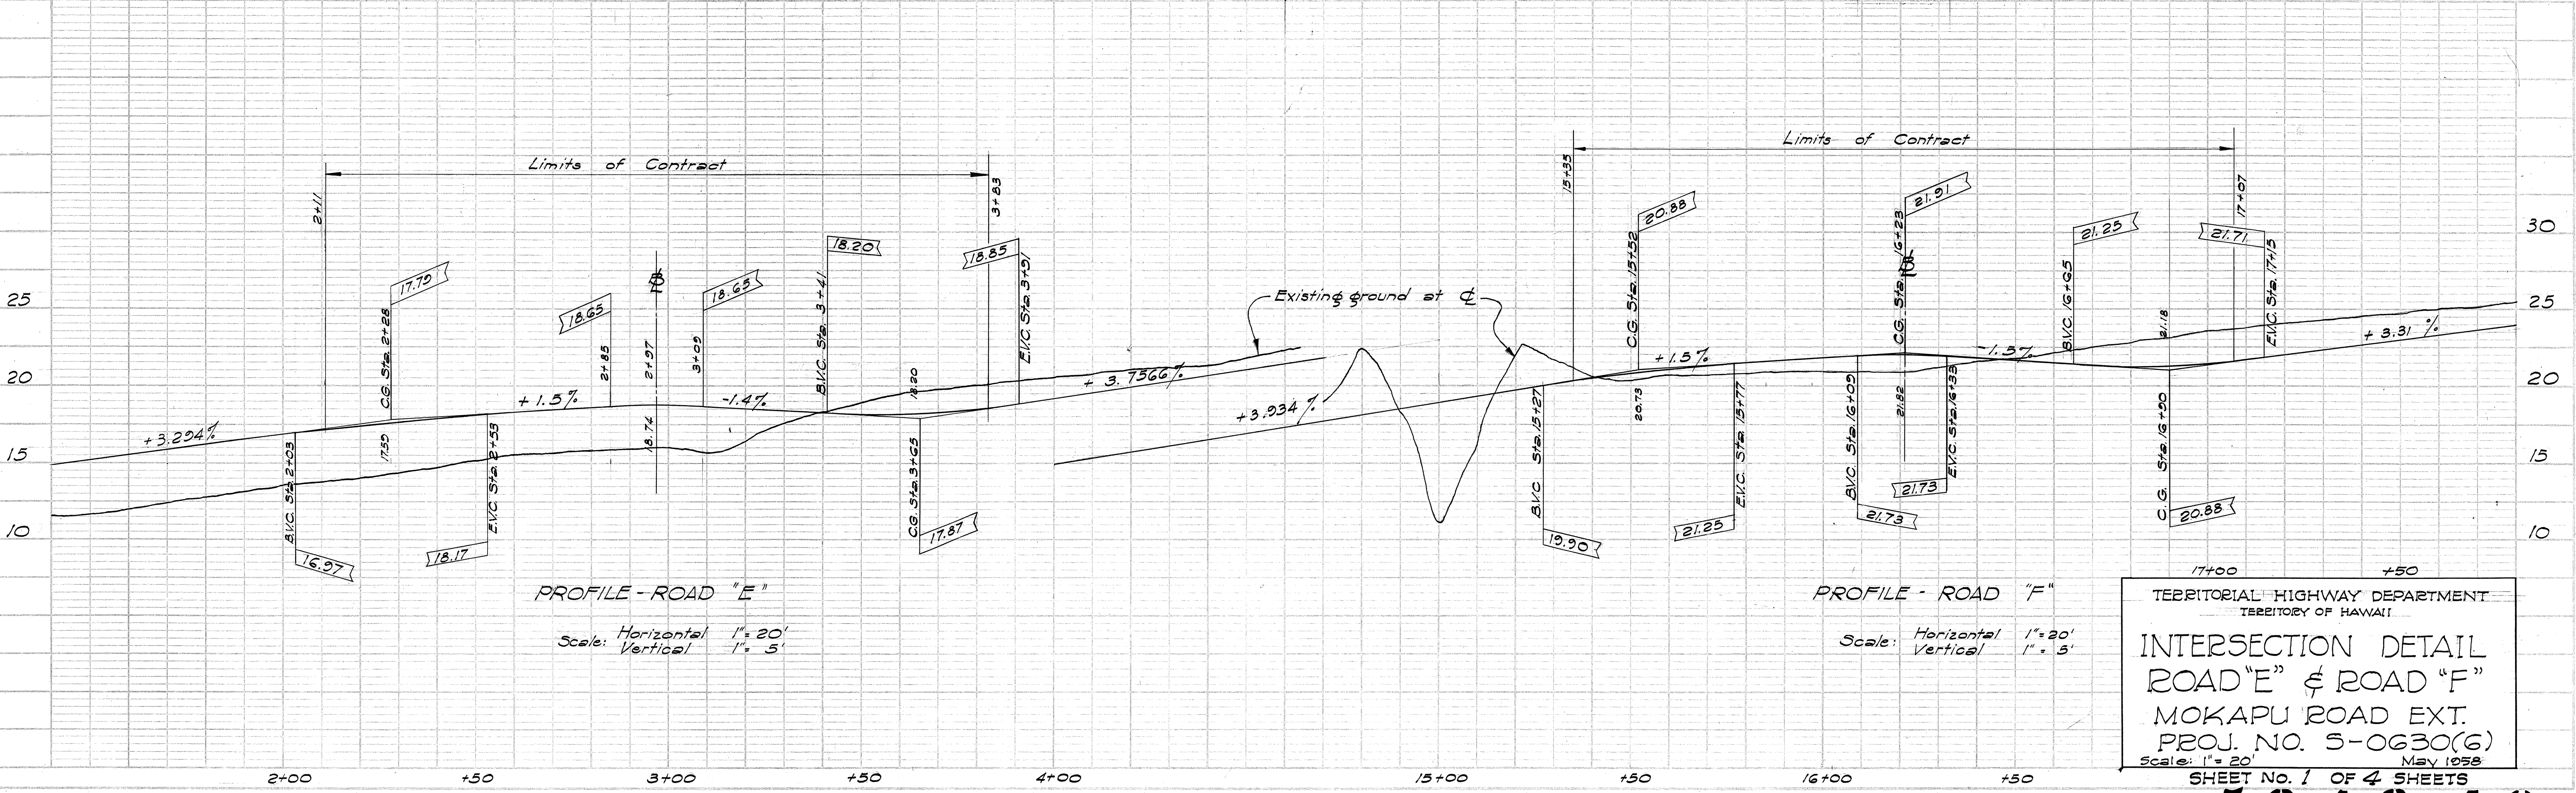

PROFILE - ROAD "E"
Scale: Horizontal 1" = 20'
Vertical 1" = 5'


PROFILE - ROAD "F"
Scale: Horizontal 1" = 20'
Vertical 1" = 5'

TERRESTRIAL HIGHWAY DEPARTMENT
TERRITORY OF HAWAII
INTERSECTION DETAIL
ROAD "E" & ROAD "F"
MOKAPU ROAD EXT.
PROJ. NO. 5-0630(6)
Scale: 1" = 20' May 1958
SHEET NO. 1 OF 4 SHEETS

5946.10

FED. ROAD DIST. No.	STATE	FED. AID PROJ. No.	FISCAL YEAR	SHEET No.	TOTAL SHEETS
HAWAII	HAW.	5-0630(6)	1958	11	27

PLAN	DATE
SUBMITTED	
NOTE BOOK	
ALIGNMENT CHECKED	
RT. OF WAY CHECKED	
NO.	

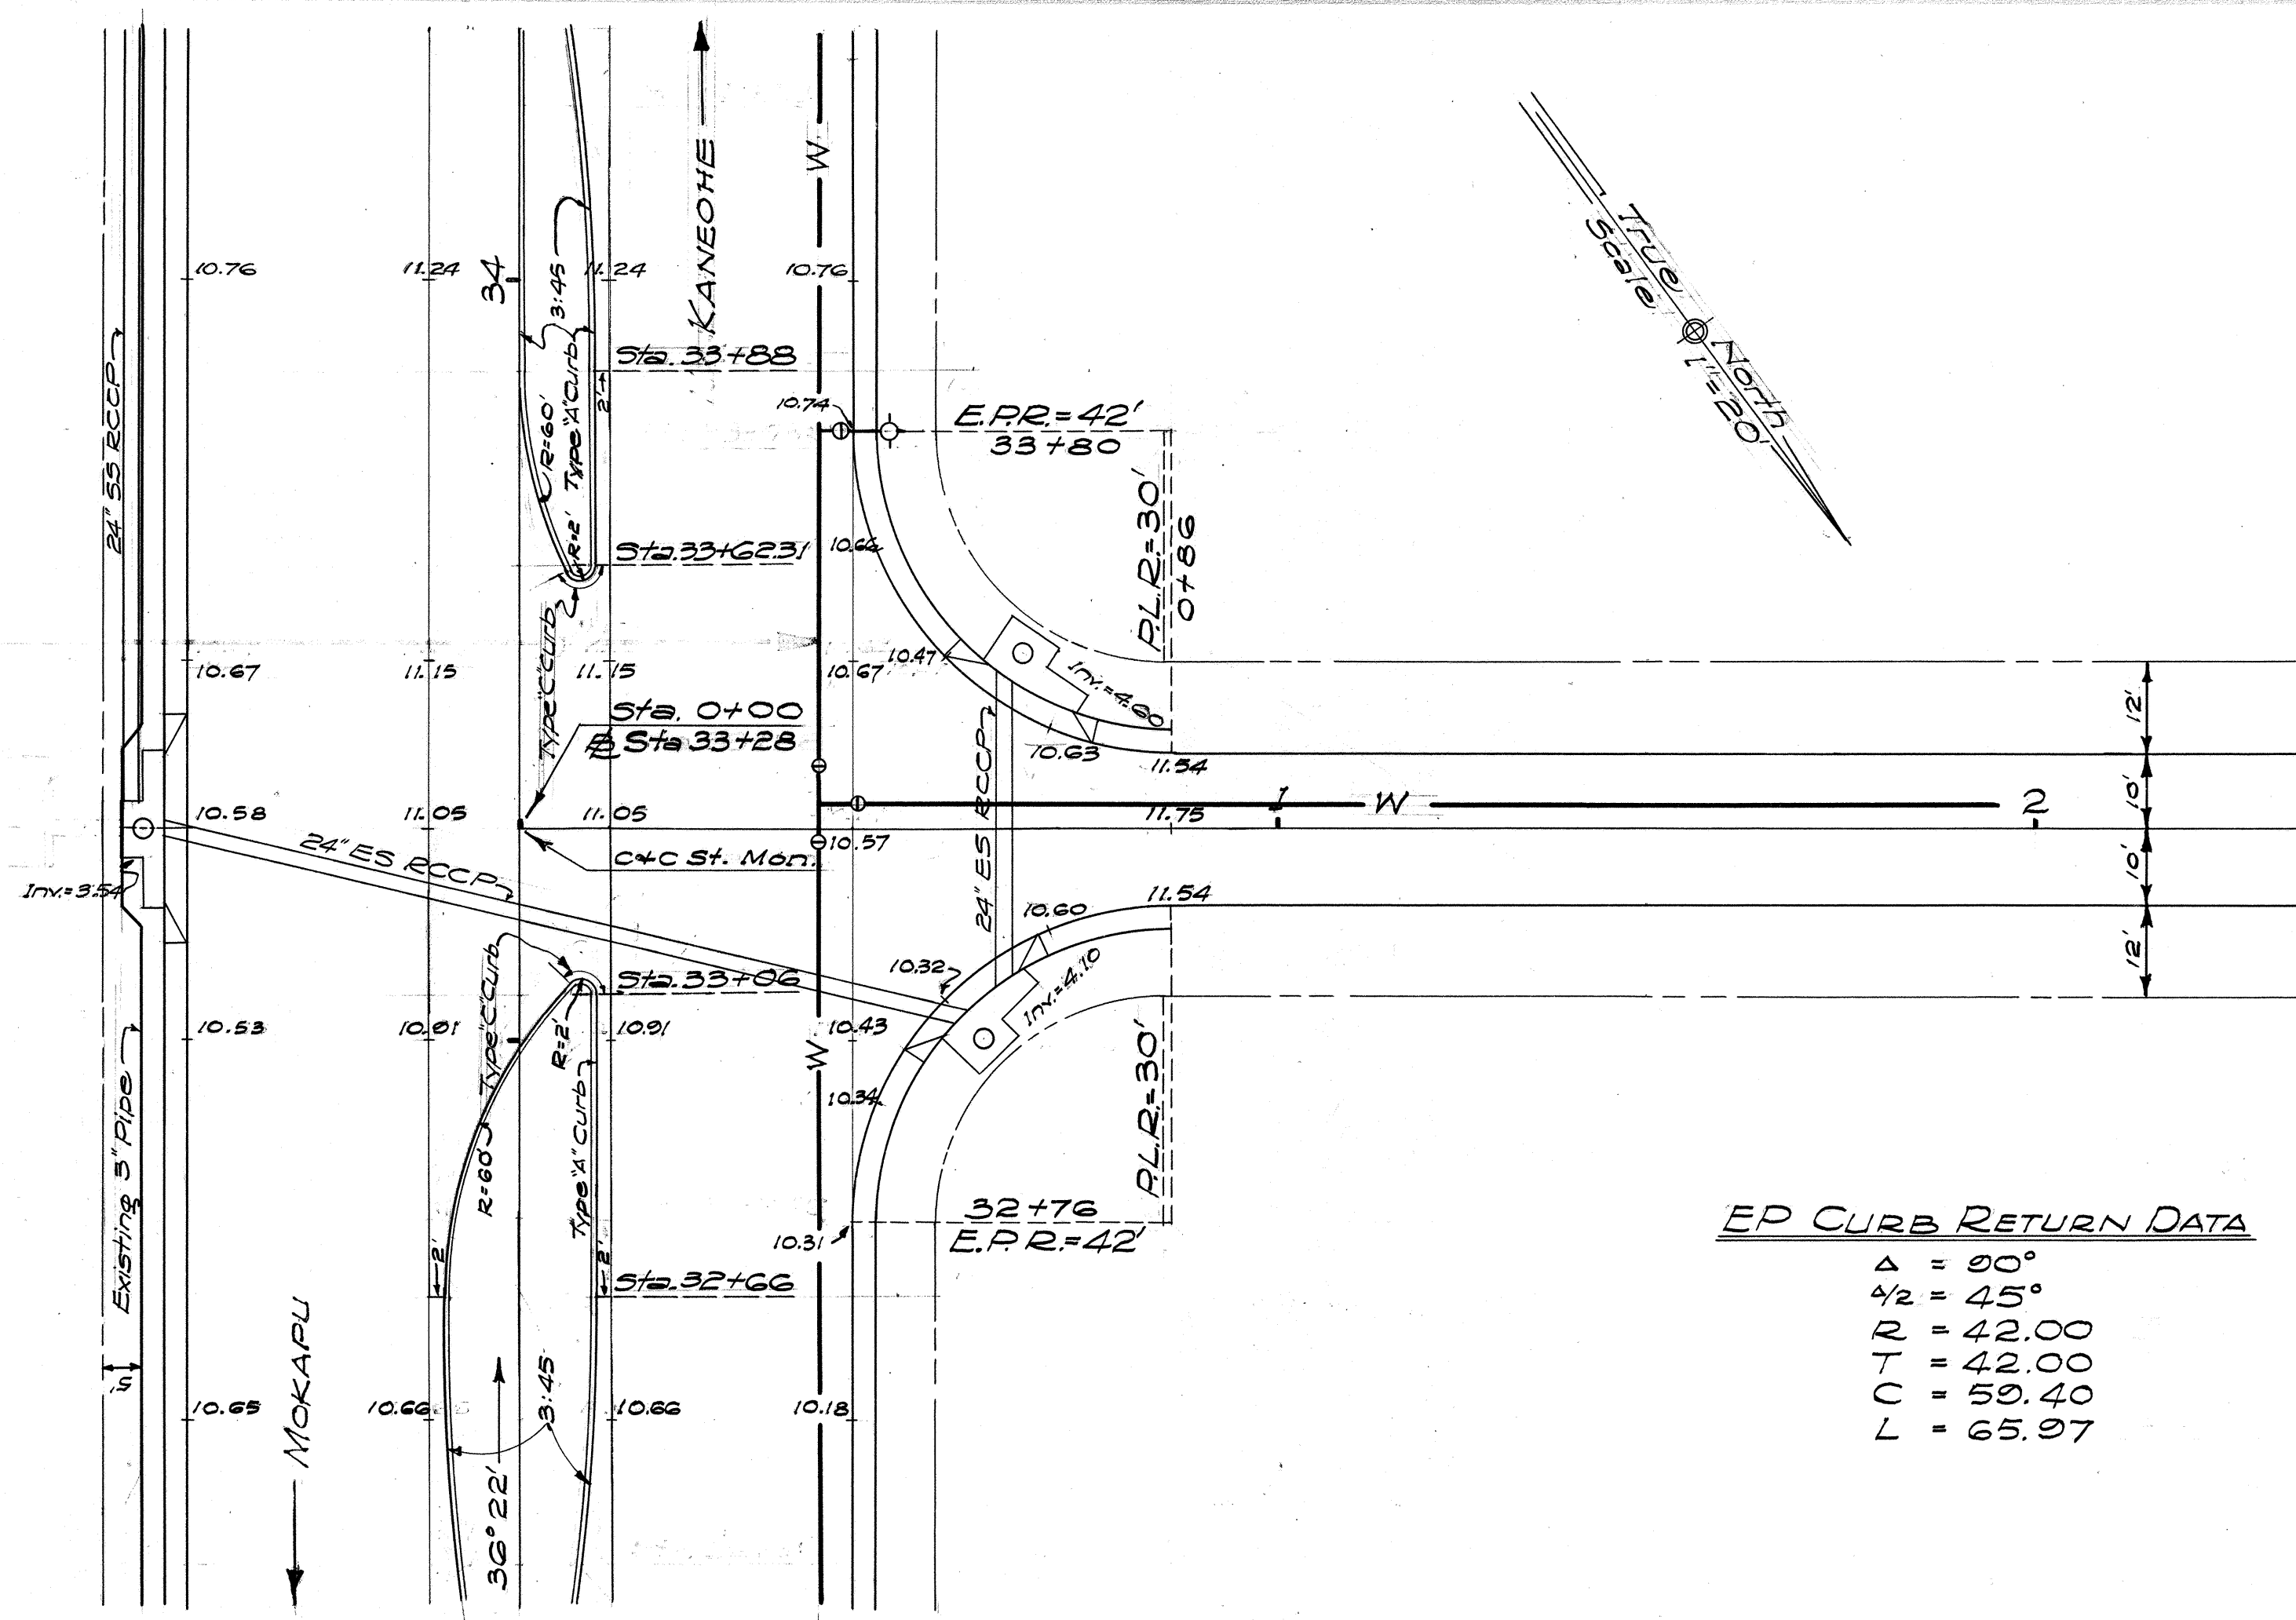

EP CURB RETURN DATA

$\Delta = 90^\circ$
 $\frac{\Delta}{2} = 45^\circ$
 $R = 42.00$
 $T = 42.00$
 $C = 59.40$
 $L = 65.97$


EP CURB RETURN DATA

$\Delta = 90^\circ$
 $\frac{\Delta}{2} = 45^\circ$
 $R = 40.00$
 $T = 40.00$
 $C = 56.57$
 $L = 62.83$

EP CURB RETURN DATA

$\Delta = 90^\circ$
 $\frac{\Delta}{2} = 45^\circ$
 $R = 42.00$
 $T = 42.00$
 $C = 59.40$
 $L = 65.97$

PROFILE	DATE
SUBMITTED	
NOTE BOOK	
GRADES CHECKED	
B. ME. NOTED	
STRUCTURE NOTED	
NO.	

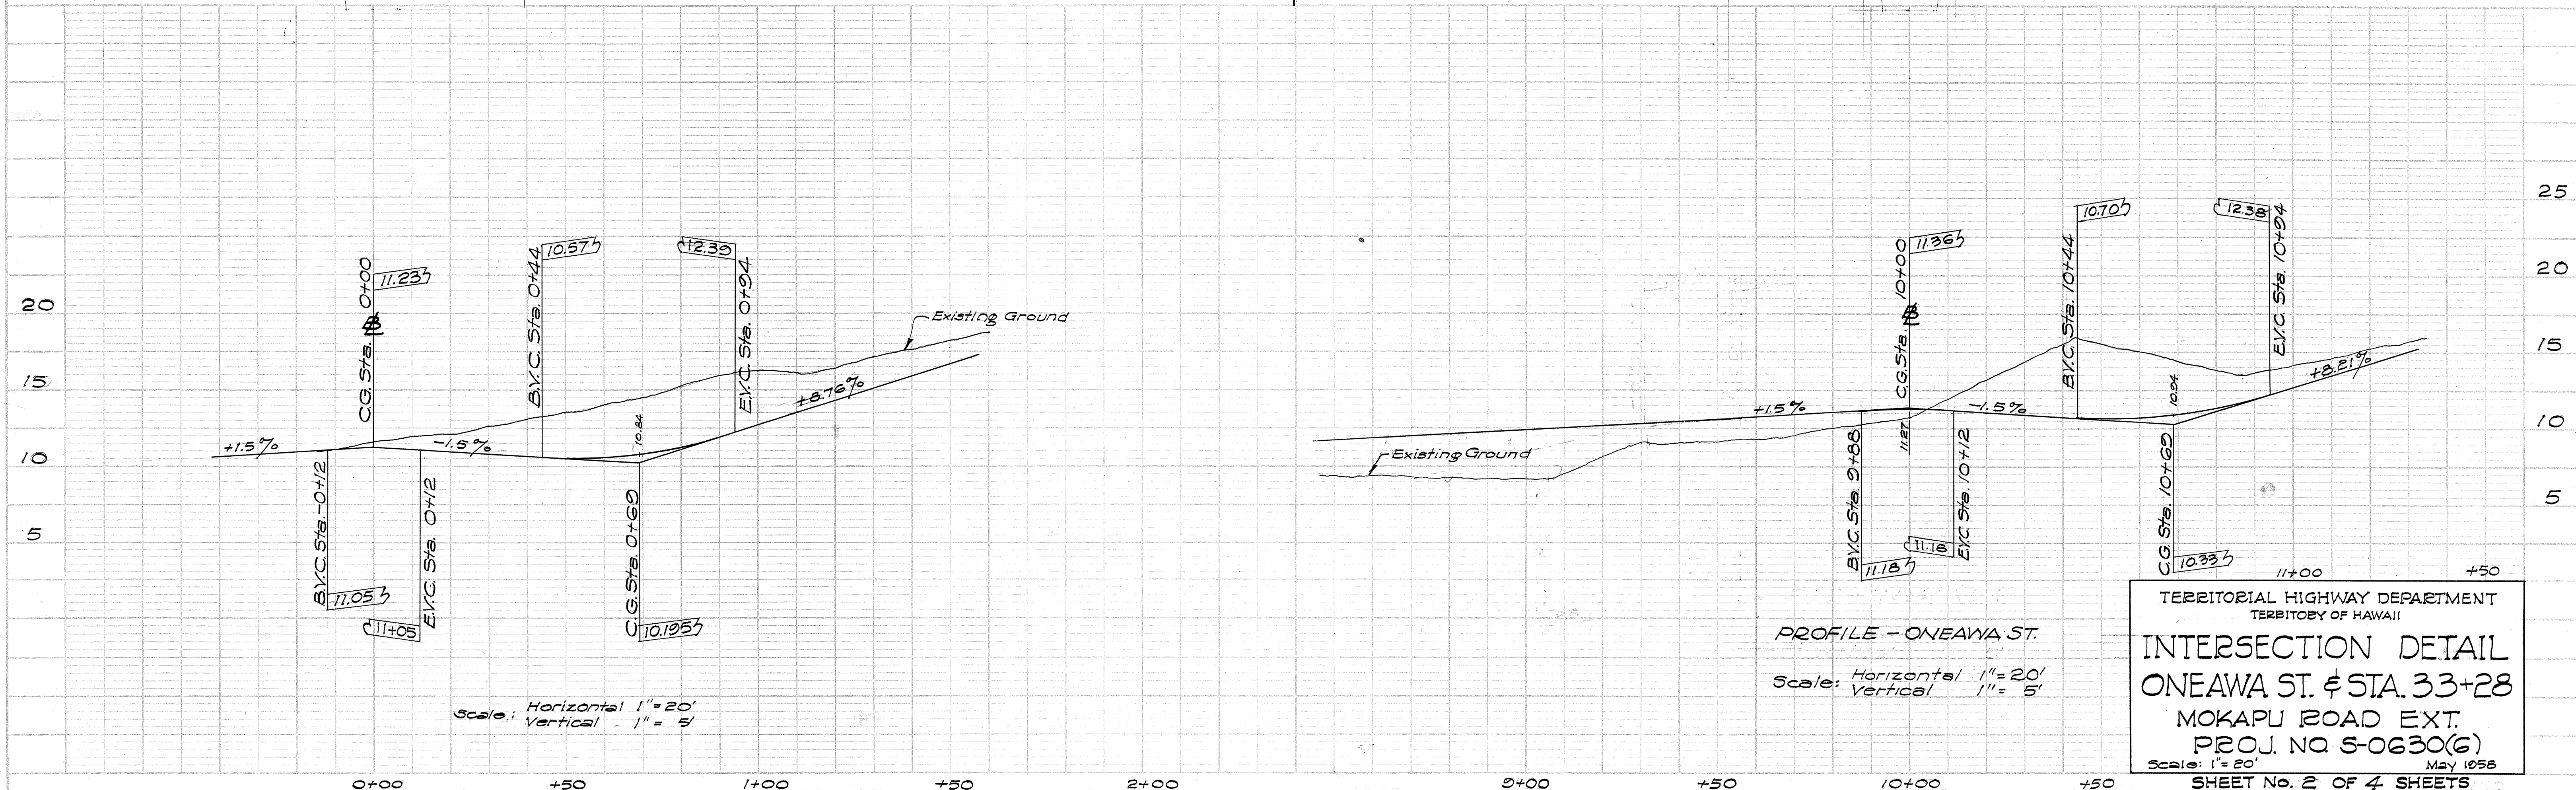

PROFILE - ONEAWA ST.

Scale: Horizontal 1" = 20'
 Vertical 1" = 5'



TERRITORIAL HIGHWAY DEPARTMENT
 TERRITORY OF HAWAII
INTERSECTION DETAIL
ONEAWA ST. & STA. 33+28
 MOKAPU ROAD EXT.
 PROJ. NO. 5-0630(6)
 Scale: 1" = 20' May 1958
 SHEET No. 2 OF 4 SHEETS

5946.11

FED. ROAD DIST. No.	STATE	FED. AID PROJ. No.	FISCAL YEAR	SHEET No.	TOTAL SHEETS
HAWAII	HAW.	5-0630(6)	1958	12	27

PLAN	SUBMITTED	DATE
NOTE BOOK	BY	
NO.	NO.	

PROFILE	SUBMITTED	DATE
NOTE BOOK	BY	
NO.	NO.	

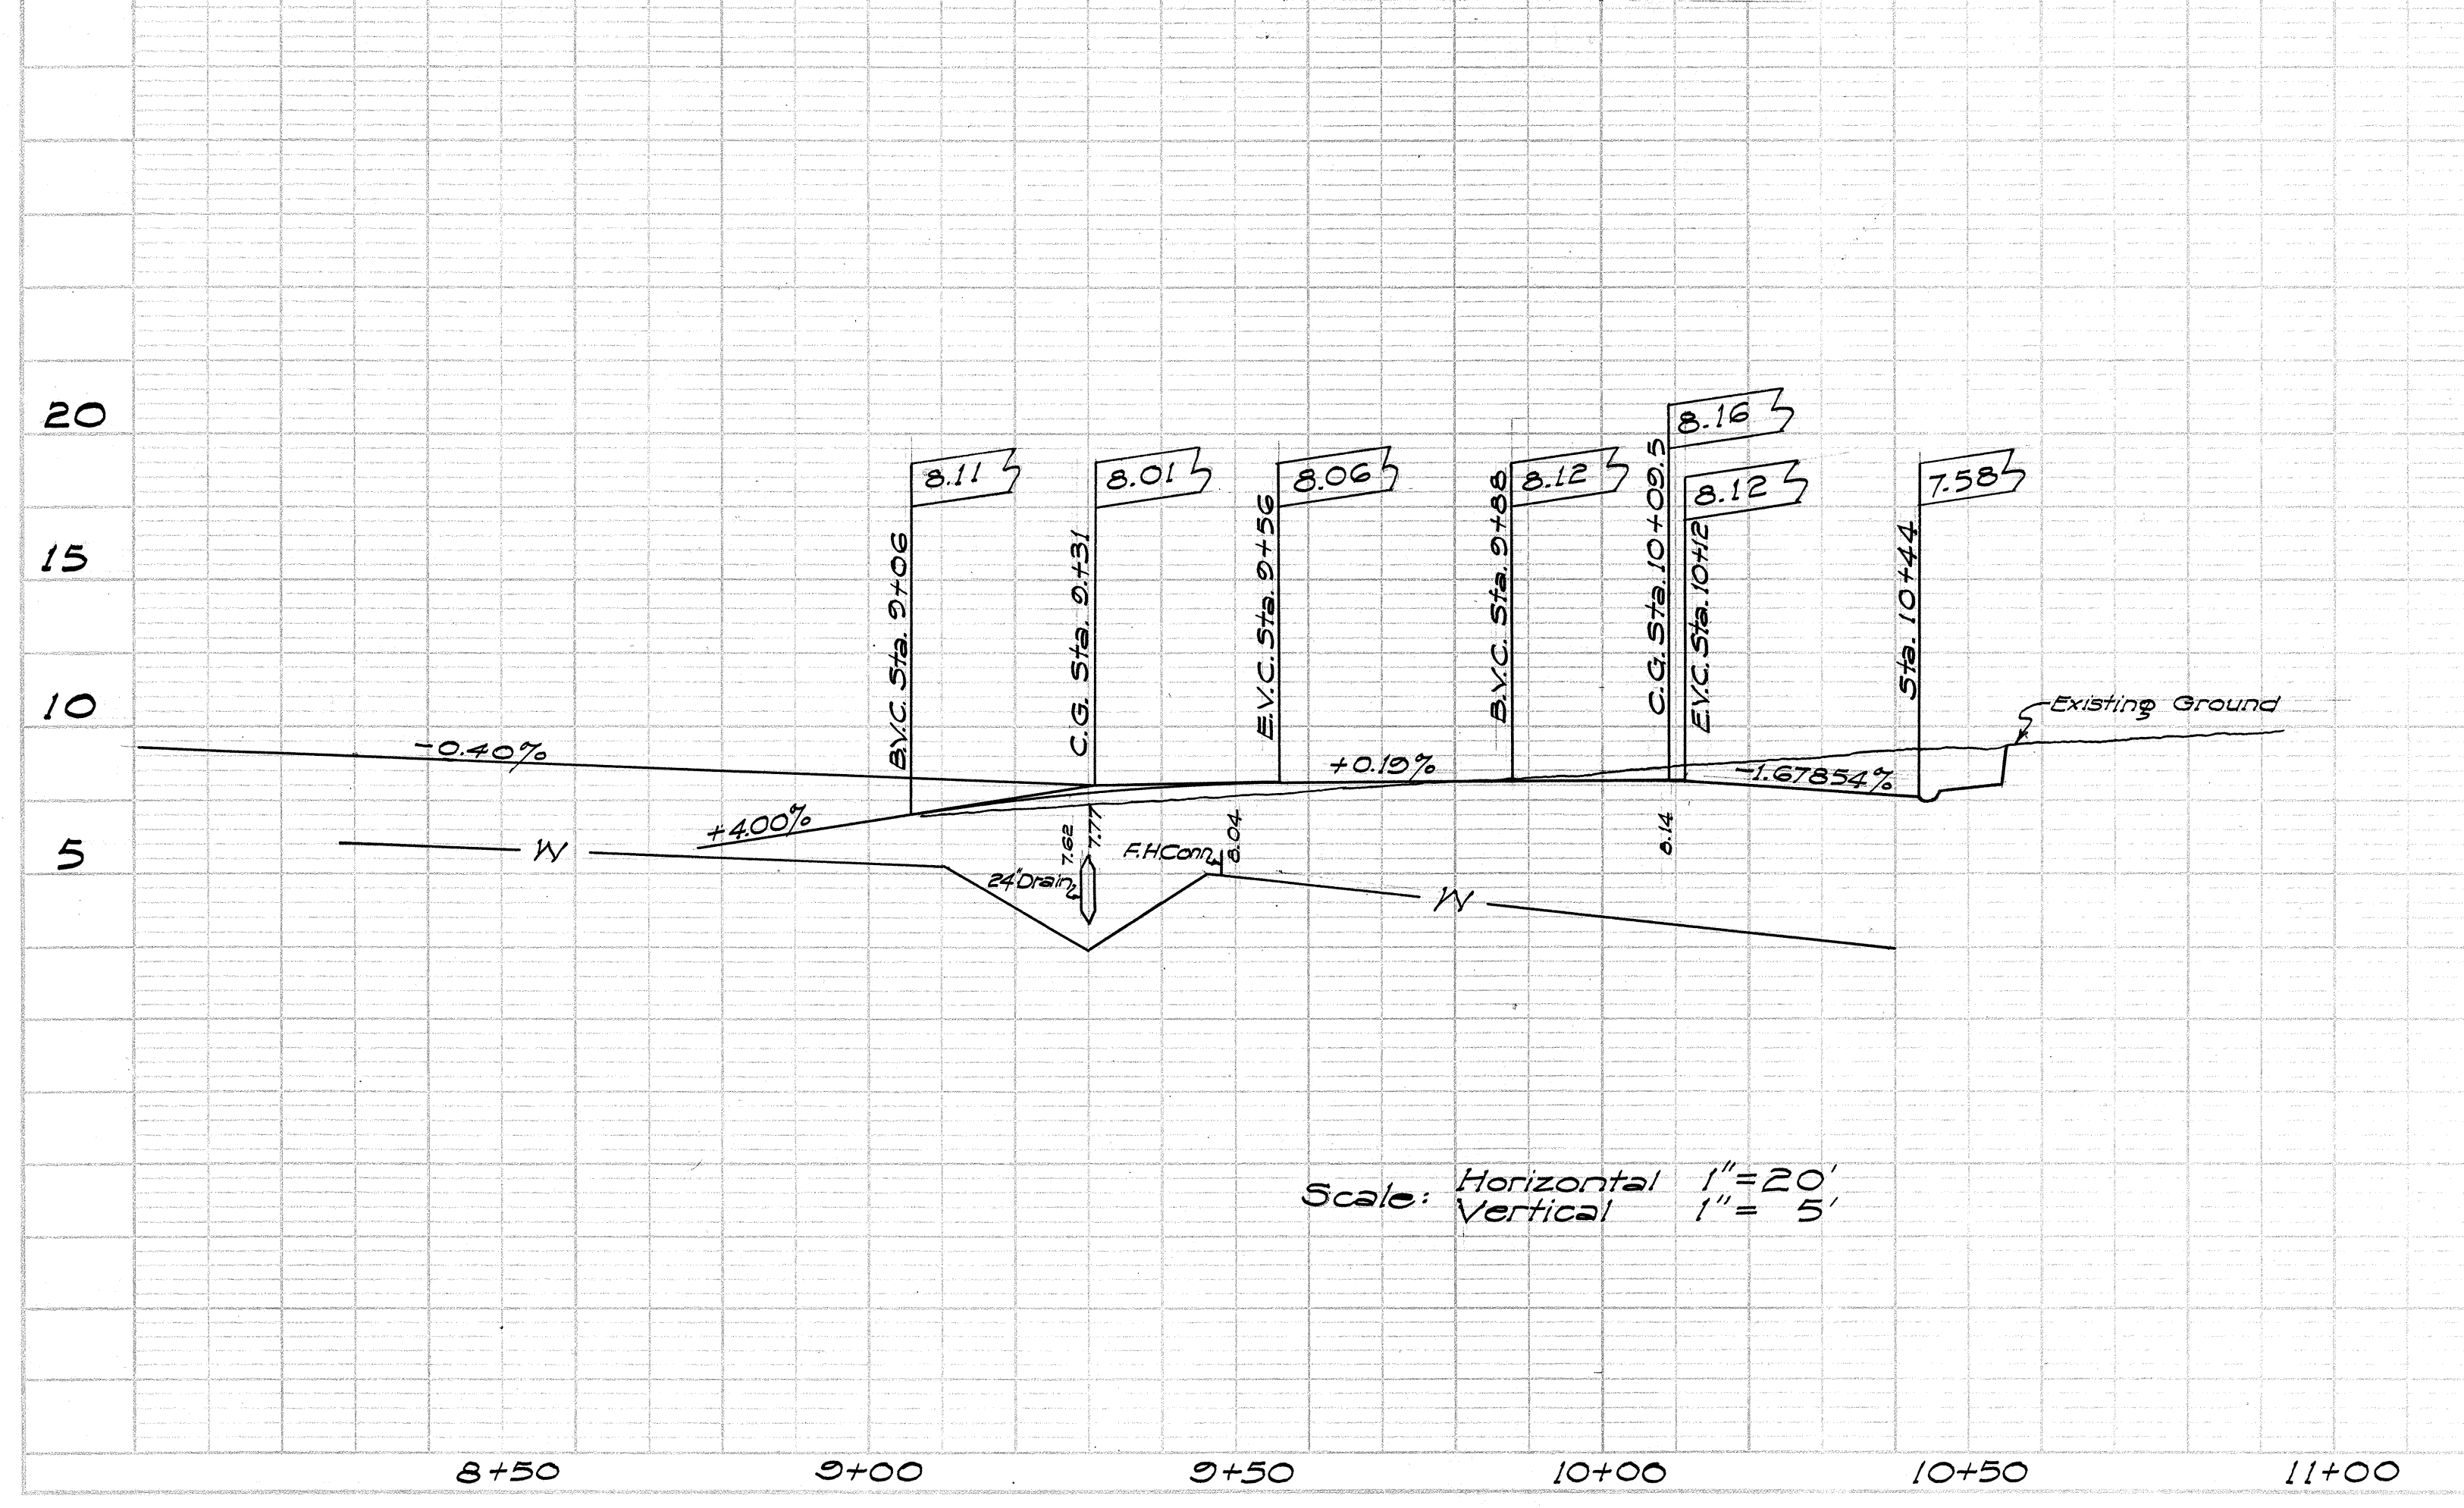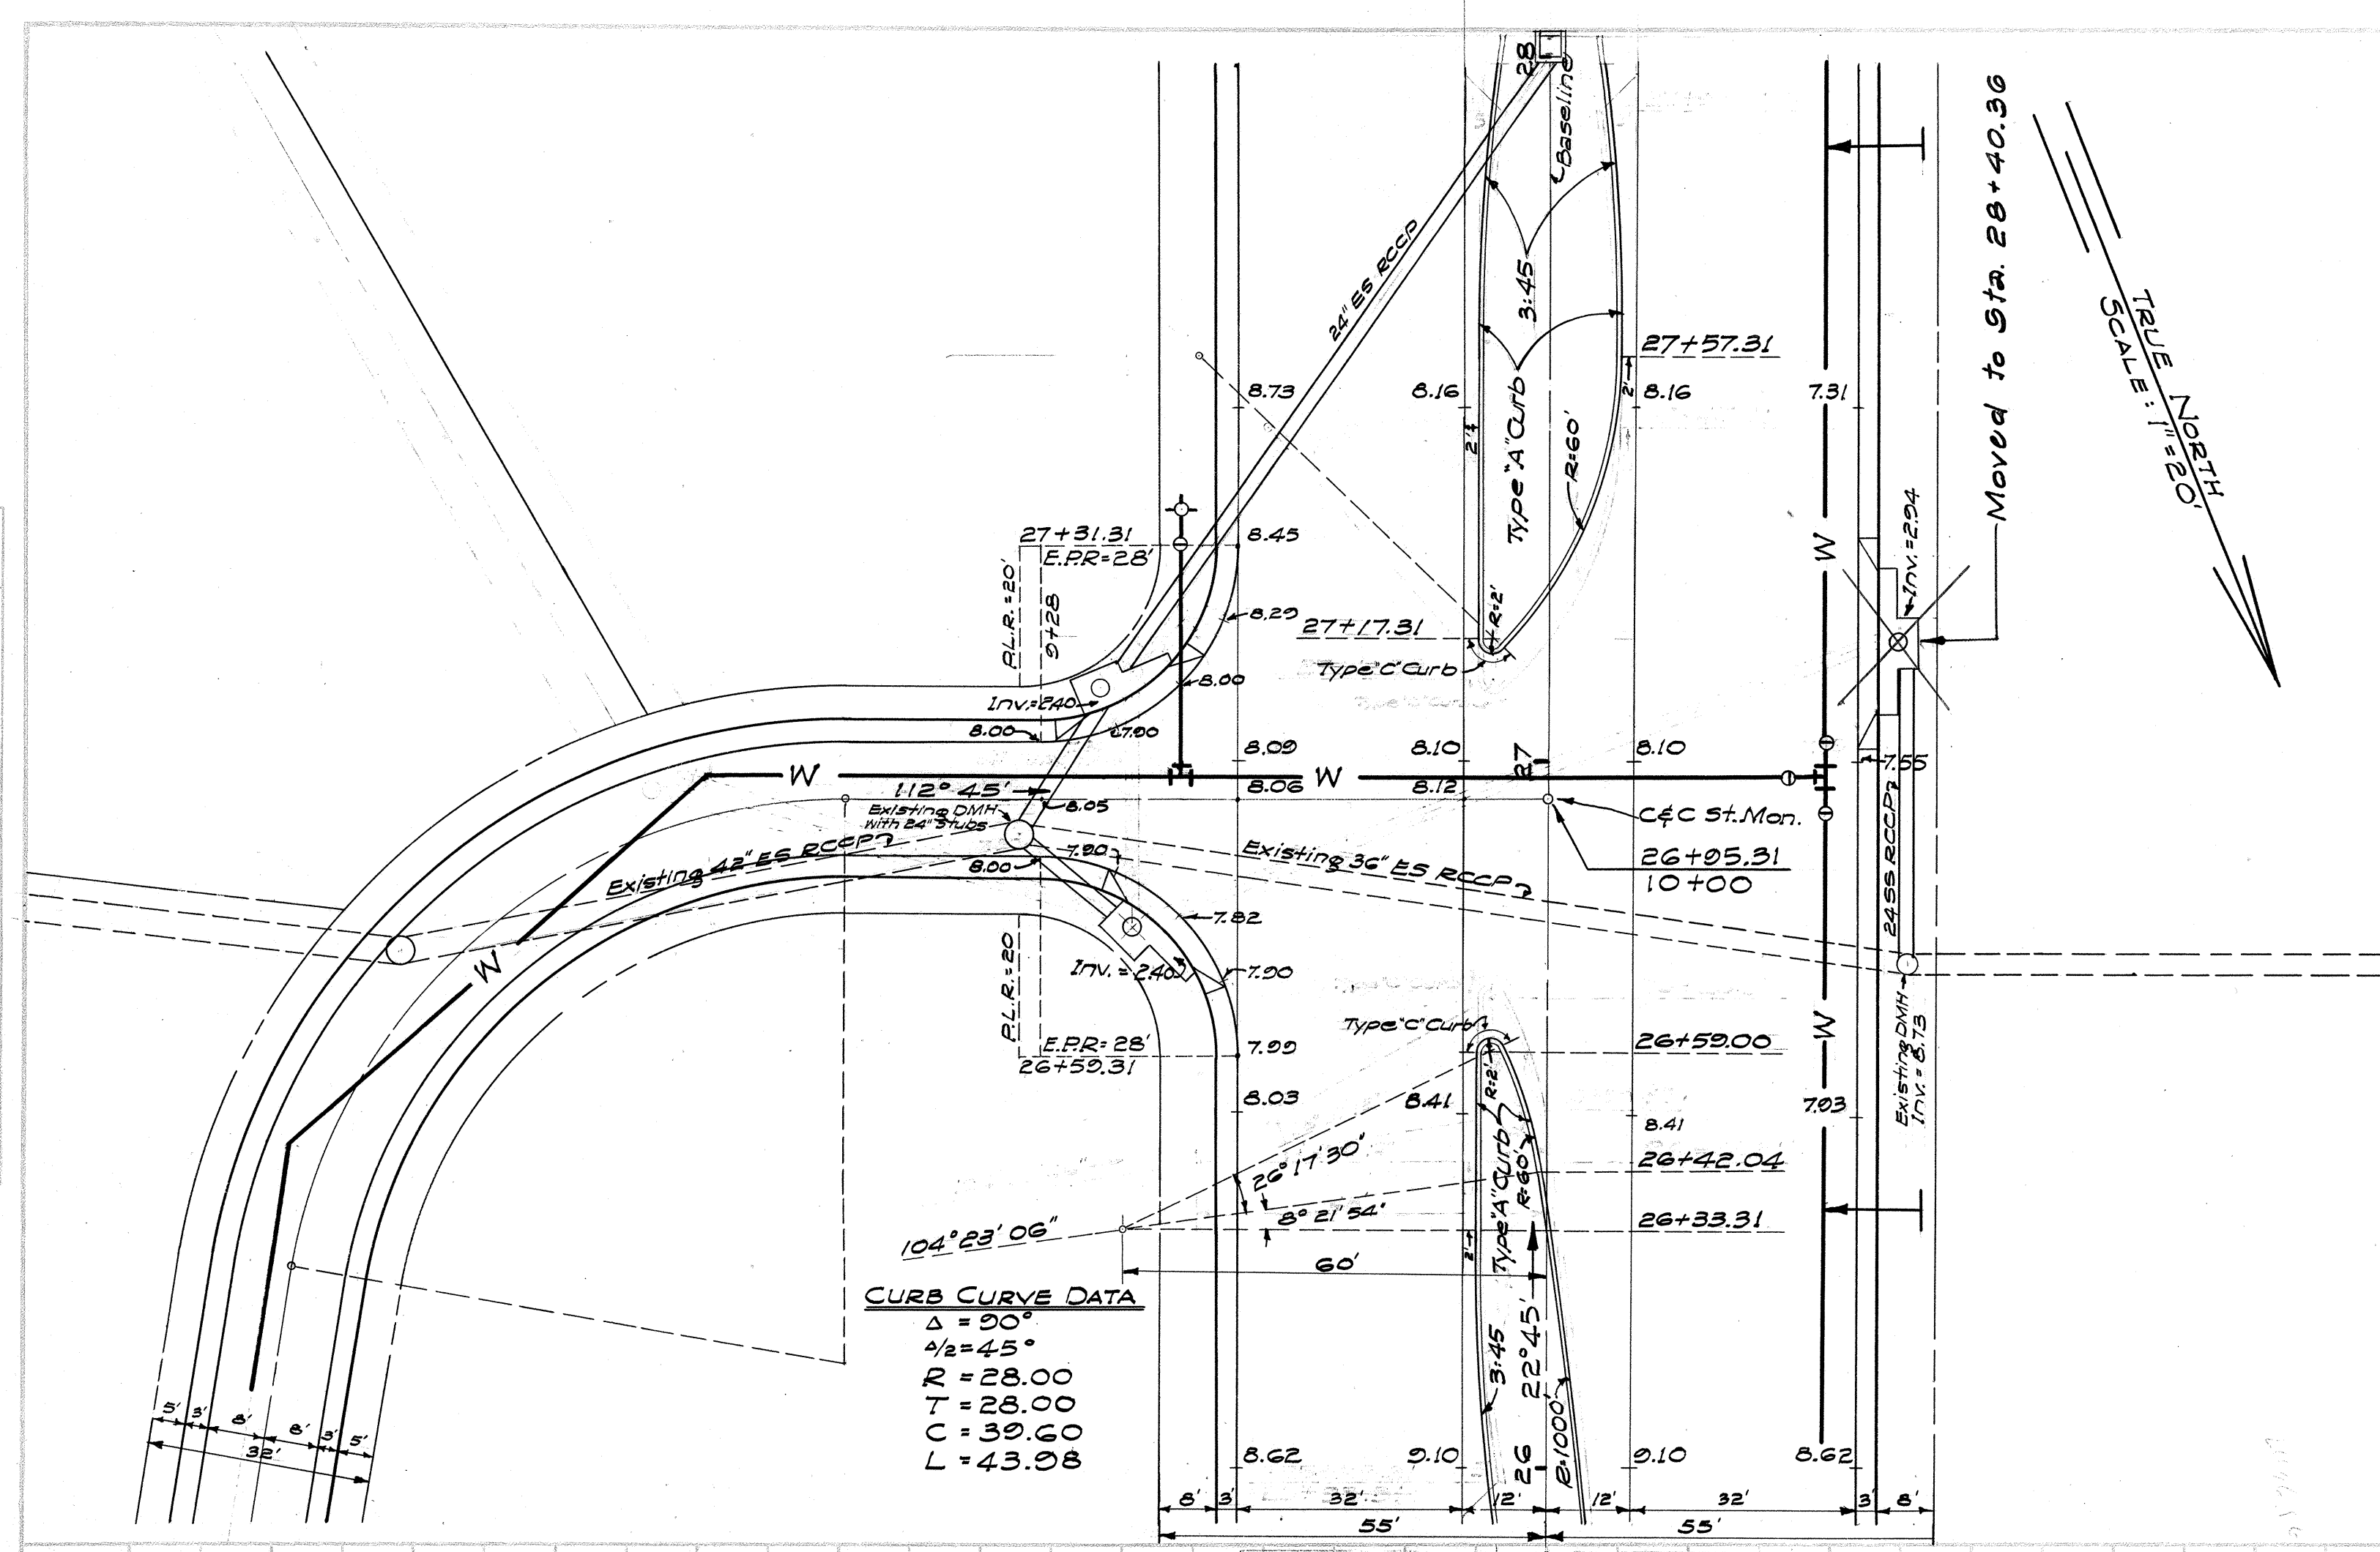


TERRITORIAL HIGHWAY DEPARTMENT
Territory of Hawaii
INTERSECTION DETAIL
STA. 26+95.31
MOKAPU ROAD EXT.
PROJ. NO. 5-0630(6)
Scale: 1" = 20' May 1958
SHEET No. 3 OF 4 SHEETS

5946.12

ORIGINAL PLAN	SURVEY PLOTTED BY _____ DESIGNED BY _____ CHECKED BY _____ TRACED BY _____ QUANTITIES BY _____ QUANTITIES CHECKED BY _____ CHECKED BY _____	DATE _____ " _____ " _____ " _____ " _____ " _____ " _____
NOTE BOOK No. _____		

PRINTED ON DIEPO 1000H CLEARPRINT

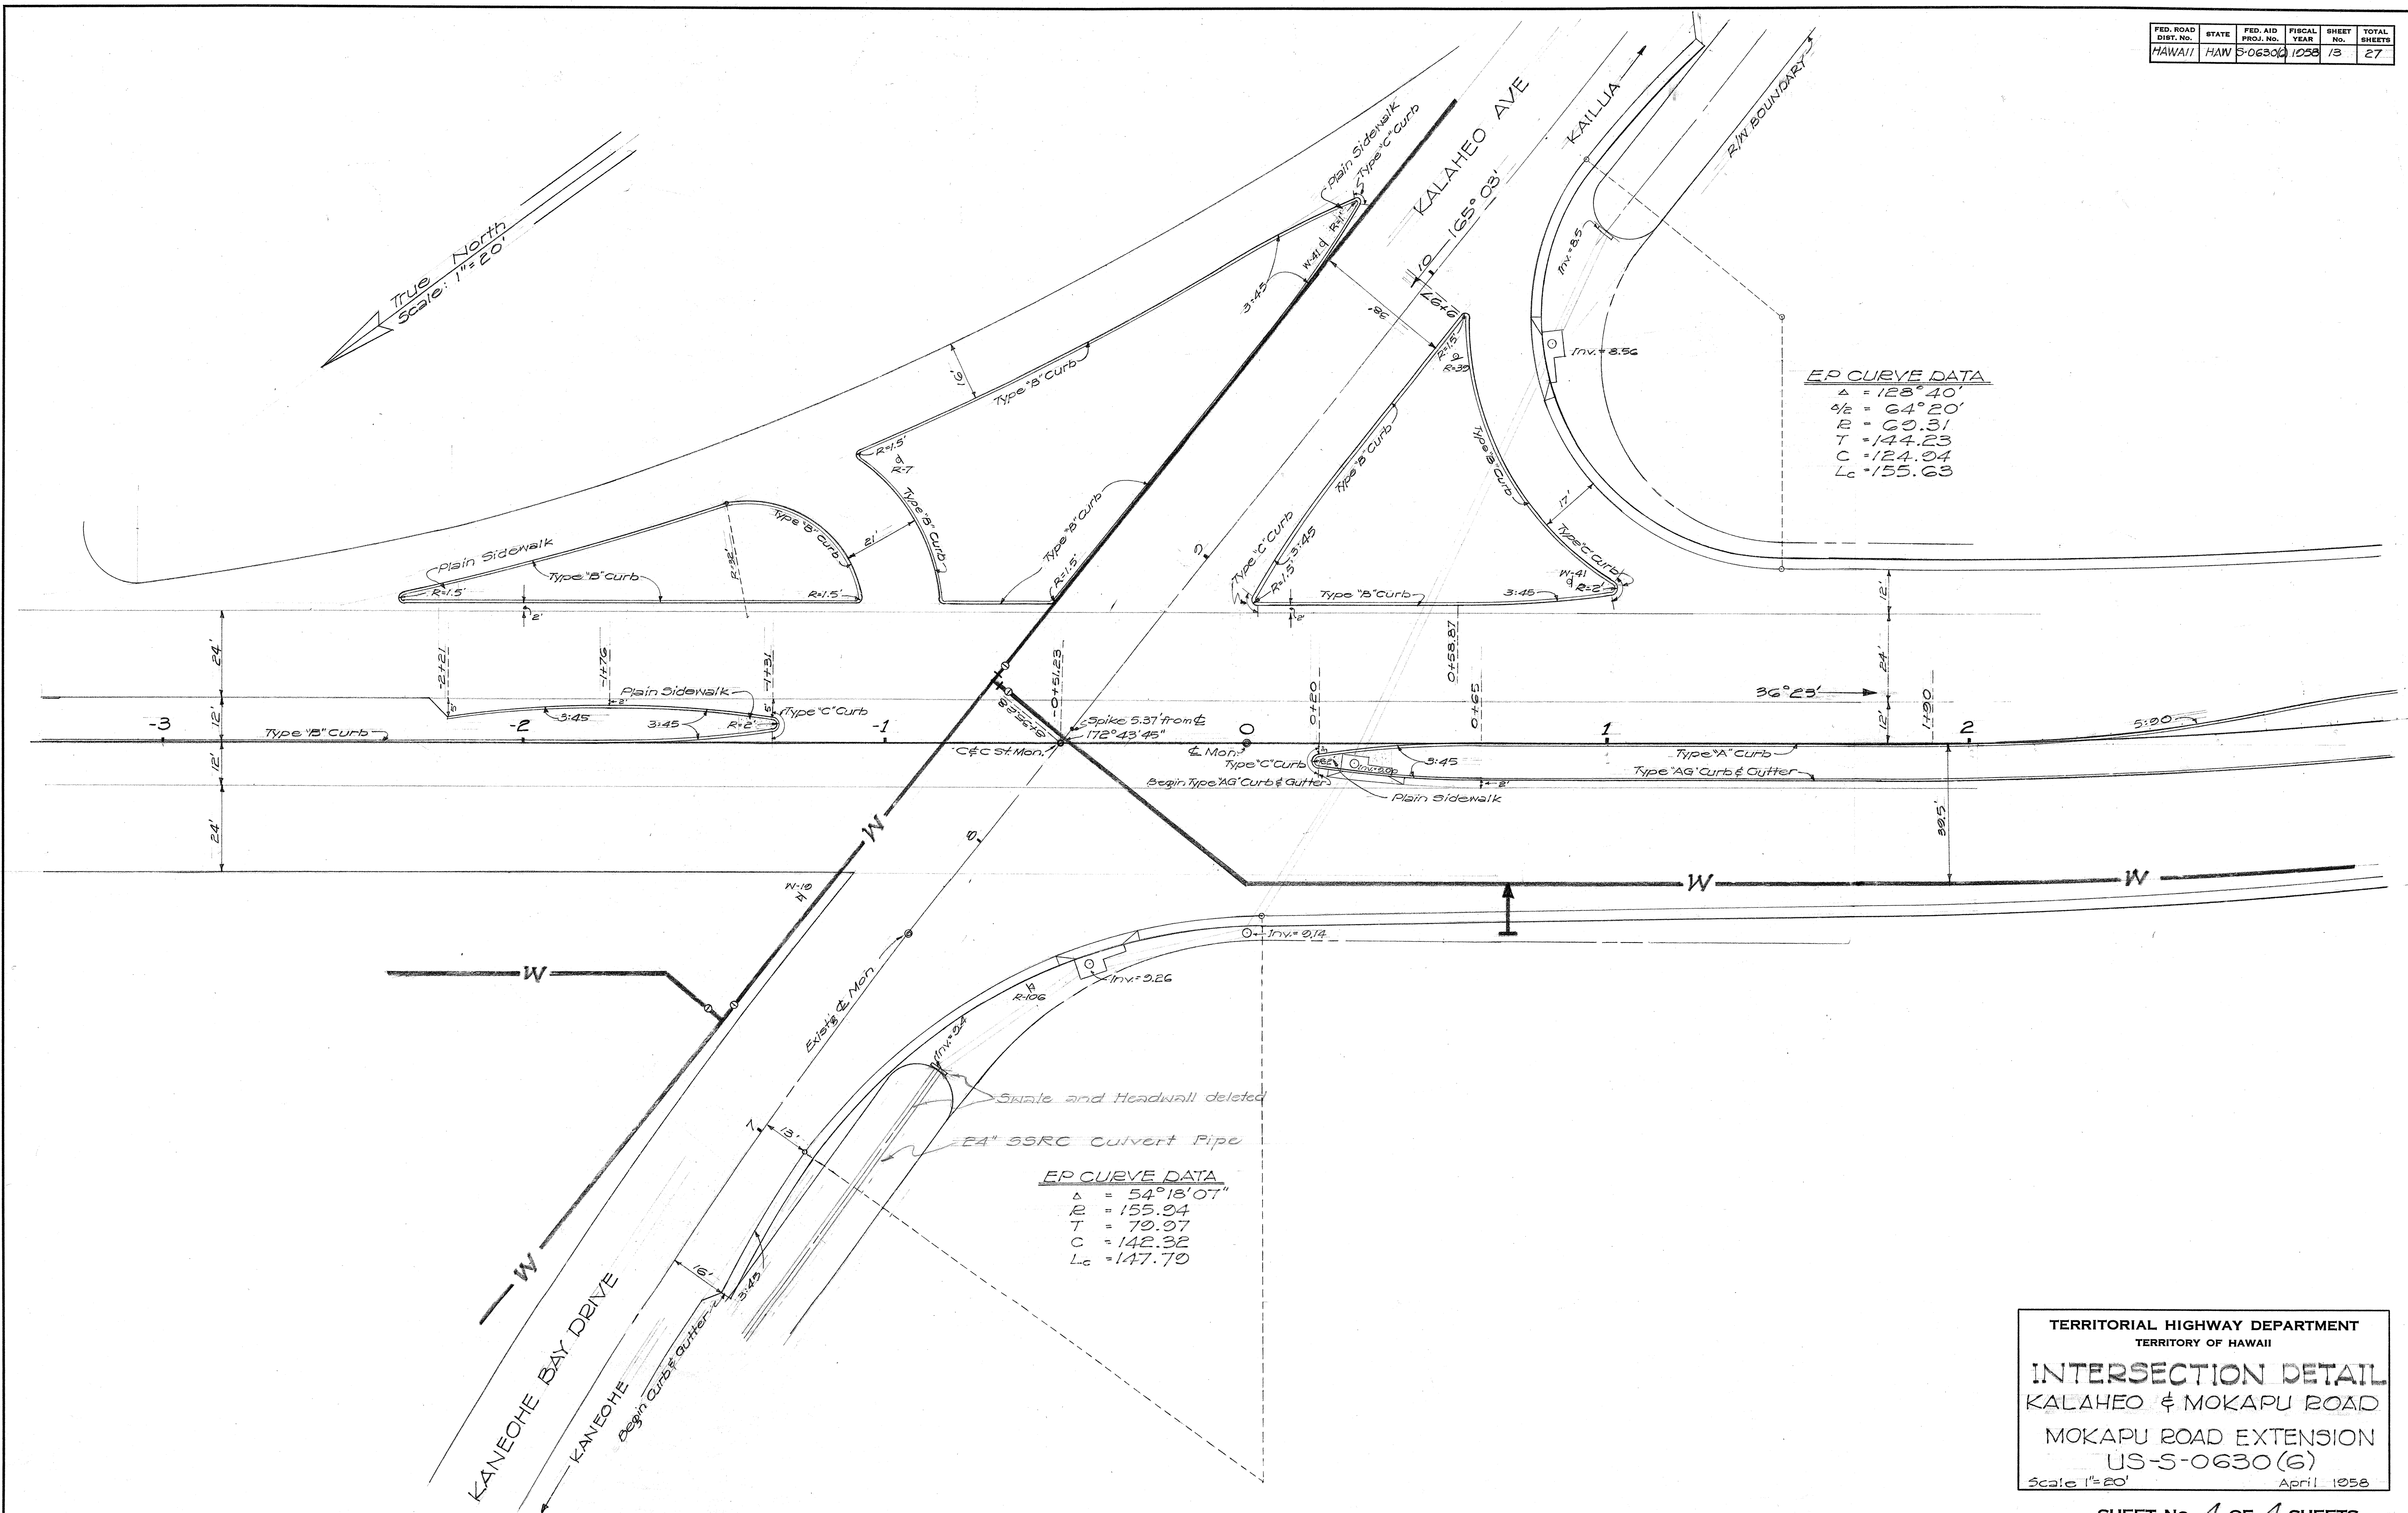

TERRITORIAL HIGHWAY DEPARTMENT
TERRITORY OF HAWAII

INTERSECTION DETAIL
KALAHEO & MOKAPU ROAD
MOKAPU ROAD EXTENSION
US-S-0630 (G)

Scale 1"=20'
April 1958

SHEET No. 4 OF 4 SHEETS

5946.13