


FED. ROAD DIST. No.	STATE	FED. AID PROJ. No.	FISCAL YEAR	SHEET No.	TOTAL SHEETS
HAWAII	HAW.	5-0630(6)	1958	27A	27

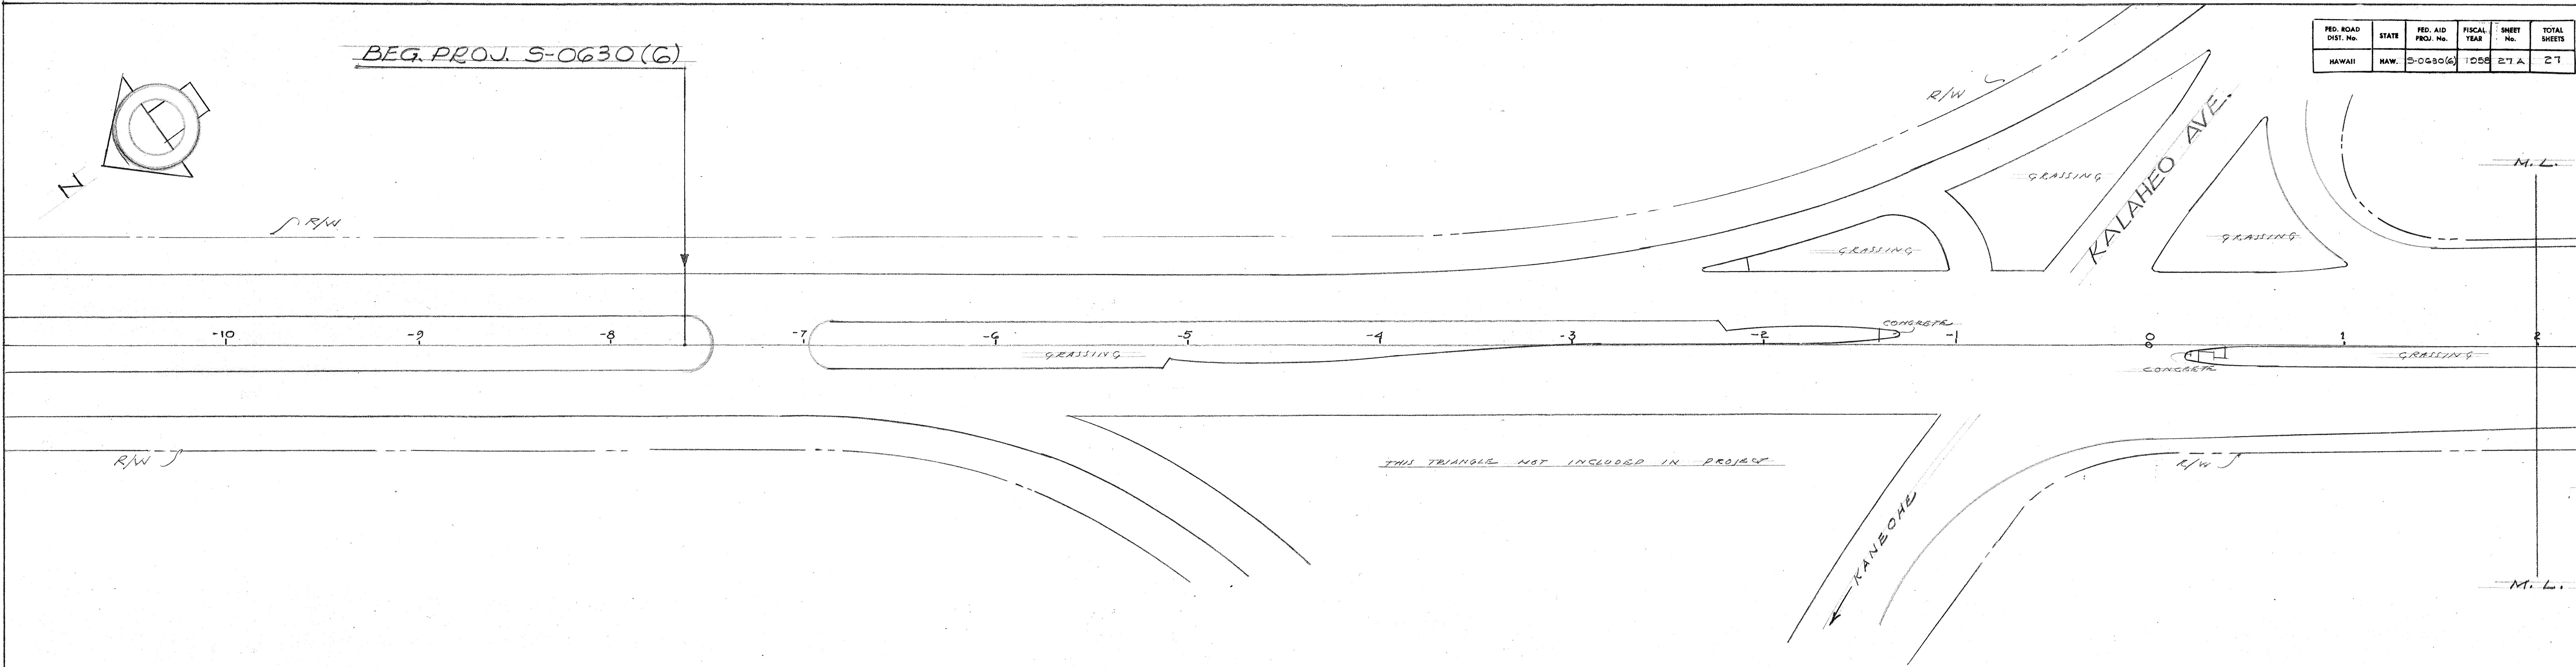


• TOTAL PLANT LIST •

KEY	BOTANICAL NAME	COMMON NAME	QUANT.	REMARKS
CD	CYNODON DACTYLON	BERMUDA GRASS	178	TO BE PLANTED IN MANNER ACCORDING TO TERRITORIAL HIGHWAY STANDARDS 5-GAL. CAN SIZE - 4'-5' TALL - ALL TREES TO BE STAKED SECURELY. 1-GAL. CAN - 8"-10" TALL - SEE "NOTE" FOR PLANTING DETAILS.
DR	DELONIX REGIA	ROYAL POINCIANA	248	
JK	SCAEVOLA FRUTESCENS	NAUPAKA	1034	
			1282	

GENERAL NOTES:

1. GRASS (CYNODON DACTYLON) SHALL BE PLANTED IN 3 TRIANGLES INDICATED ON THIS SHEET - ON ALL SHOULDERS TO THE RIGHT OF WAY LINE INDICATED - AND DOWN THE MEDIAL STRIP EXCEPT IN AREAS TO BE PLANTED TO NAUPAKA.
2. THE POINCIANA TREES ARE TO BE PLANTED TWO (2') FEET INSIDE OF THE RIGHT OF WAY LINES. THE LARGE DOTS ON PLAN INDICATE THE TREE LOCATIONS. THE TREES ARE SPACED THIRTY-FIVE (35') FEET APART EXCEPT IN A FEW INSTANCES WHERE UTILITIES CONFLICT - THESE ARE INDICATED ON PLAN. ALL TREES ARE TO BE STAKED SECURELY SO THEY DO NOT WHIP IN THE WIND.
3. WHERE INDICATED, THE NAUPAKA IS TO BE PLANTED THREE FEET (3') APART IN TWO (2) ROWS ON EACH SIDE OF THE CENTER LINE; EACH ROW TO BE TWO (2') FEET FROM THE CENTER LINE, THUS MAKING THE TWO ROWS OF NAUPAKA FOUR (4') FEET APART.

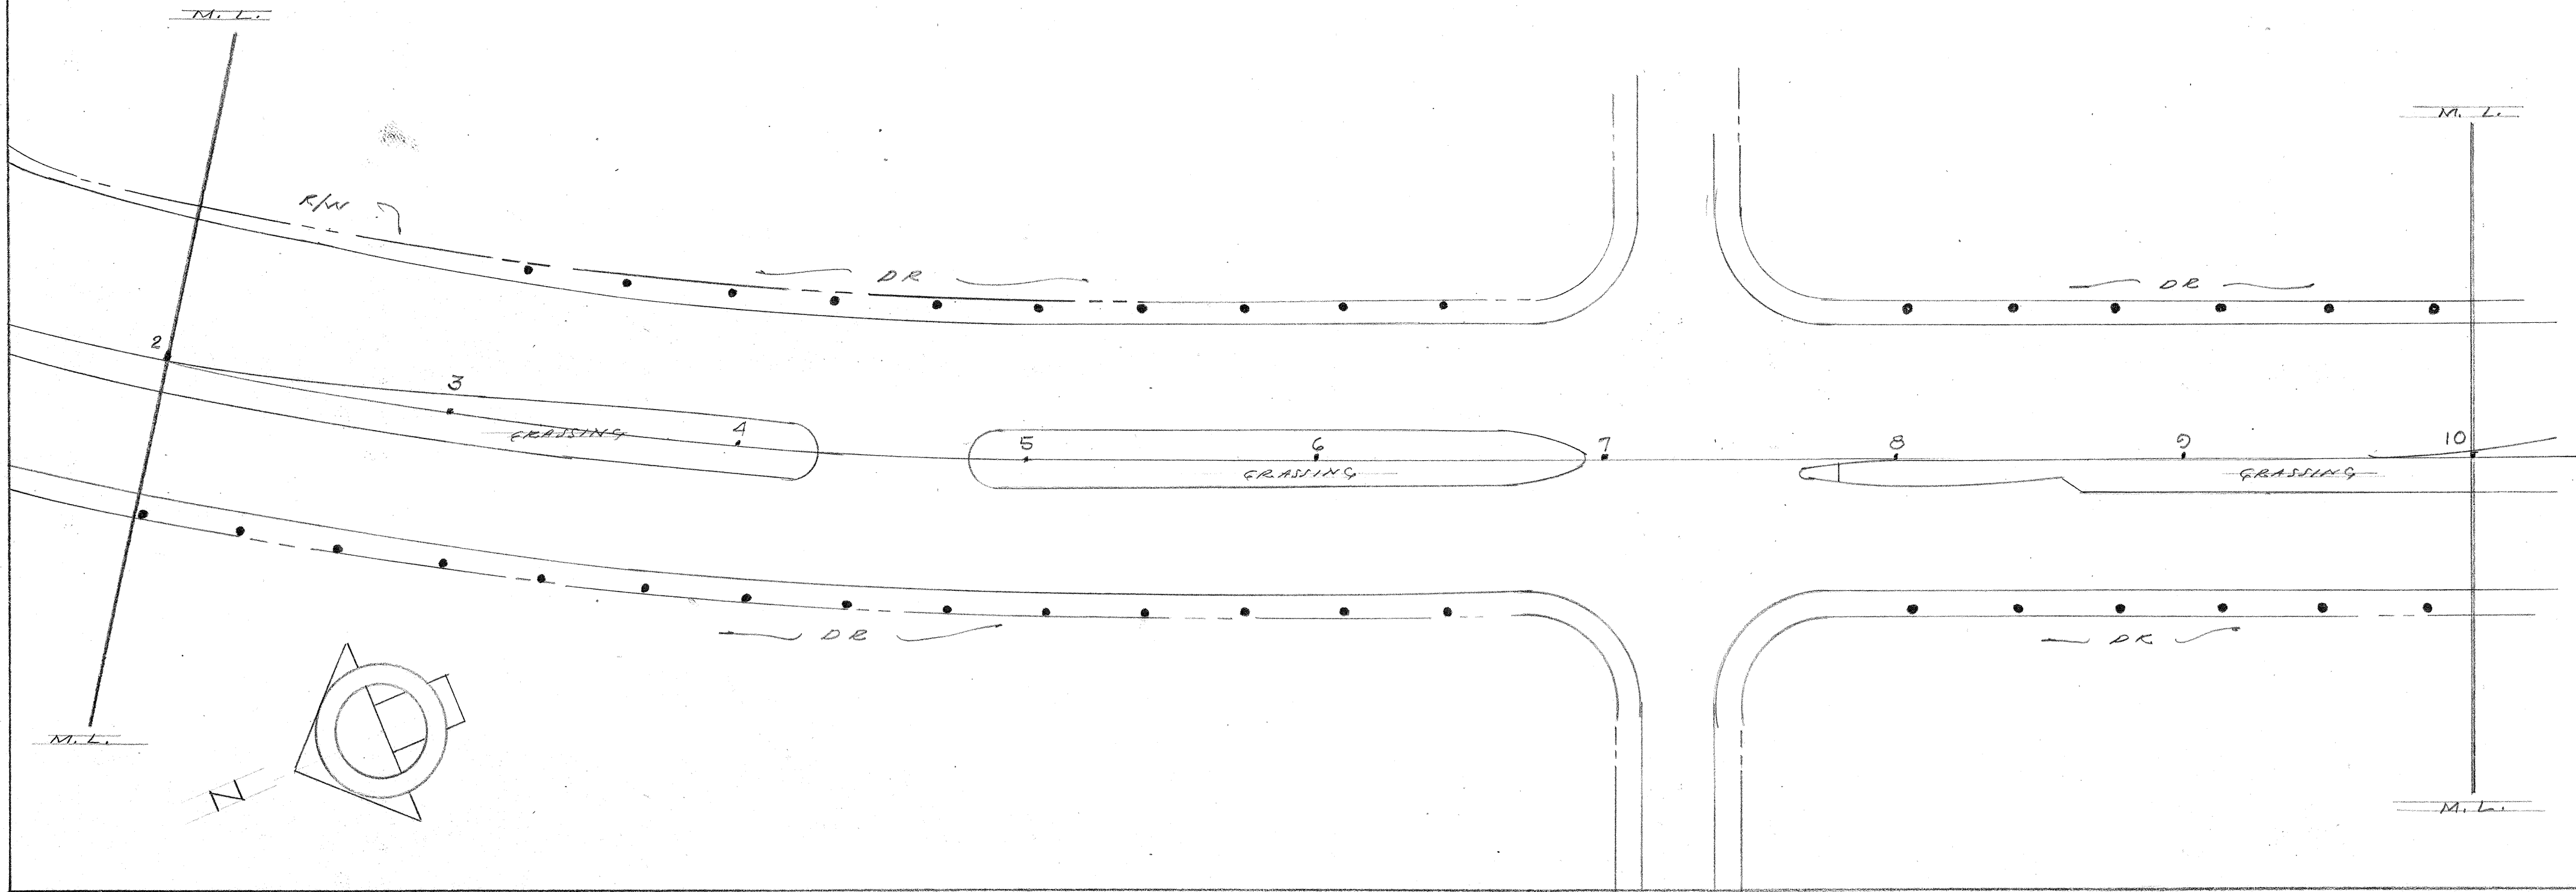


TERRITORIAL HIGHWAY DEPARTMENT
TERRITORY OF HAWAII
LANDSCAPE PLANTING
PLAN
FOR
MOKAPU ROAD EXTENSION
PROJ. NO. 5-0630(6)
Scale: 1"=40'

MANSFIELD P. CLAFLIN
LANDSCAPE ARCH. A.S.L.A.
HONOLULU

SEPT. 18, 1958
SHEET NO. 1 OF 3 SHEETS

5946.27 A

FED. ROAD DIST. No.	STATE	FED. AID PROJ. No.	FISCAL YEAR	SHEET No.	TOTAL SHEETS
HAWAII	HAW.	5-0630(6)	1958	27 B	27

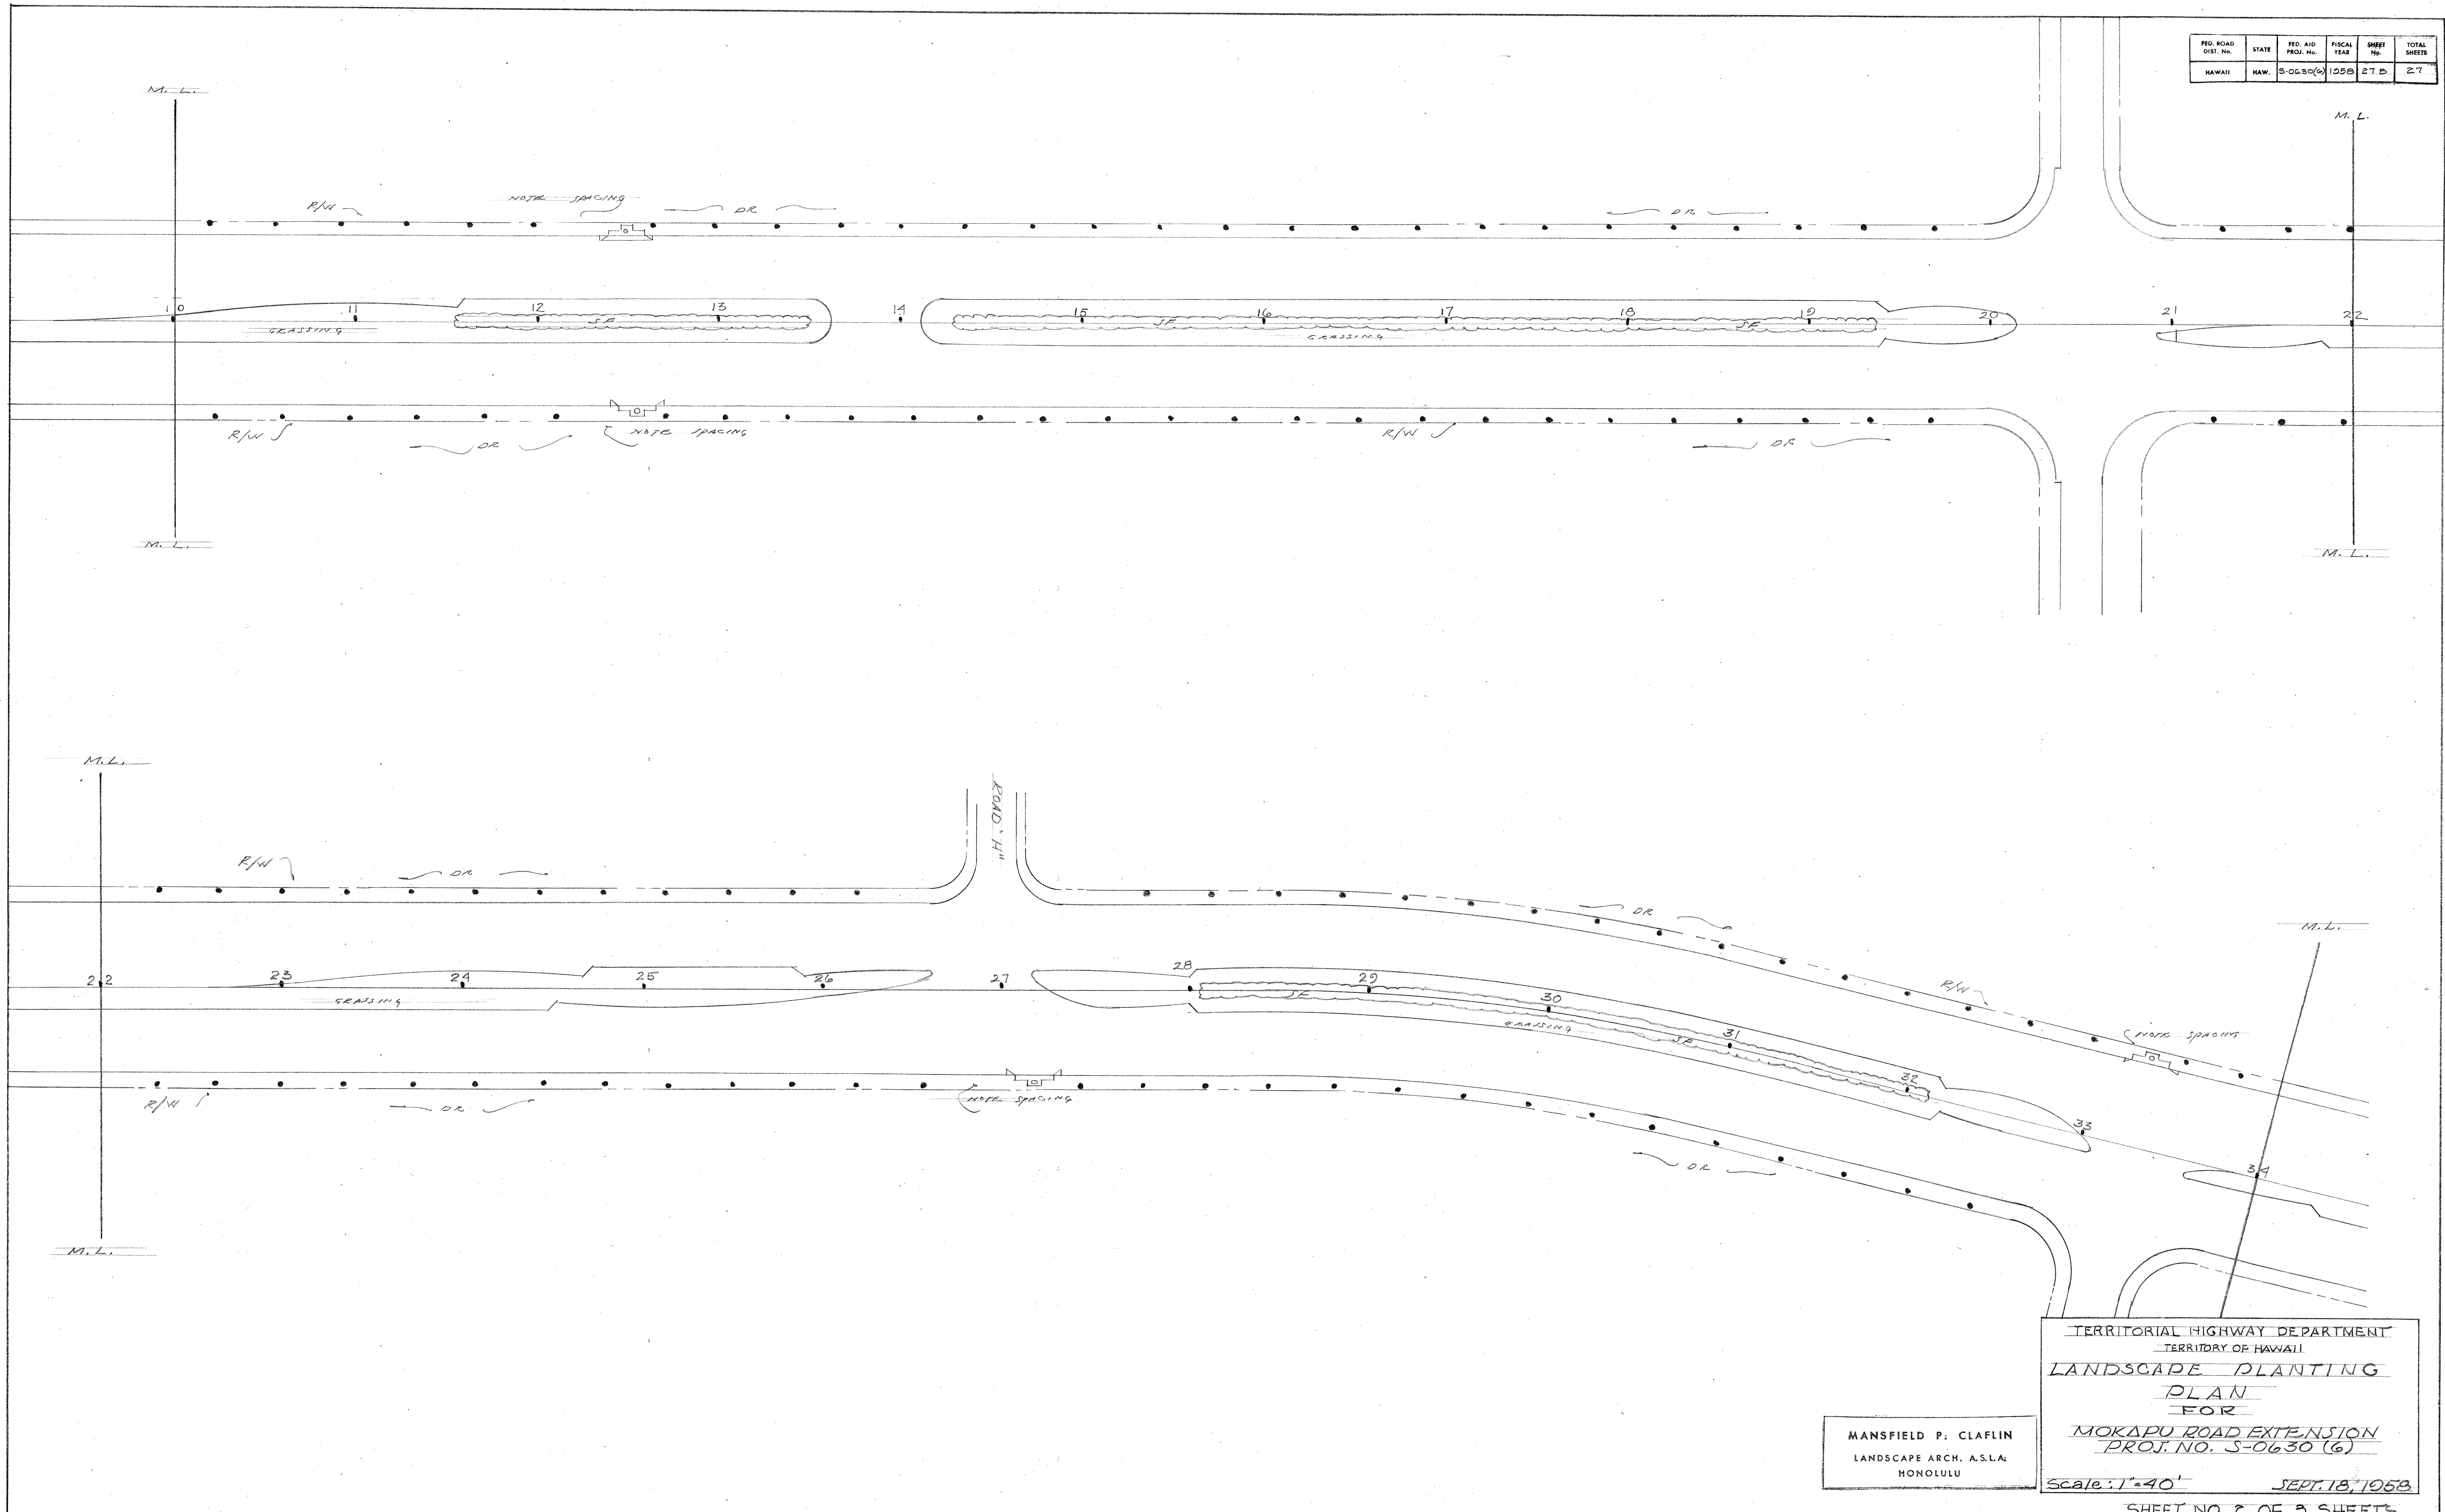

TERRITORIAL HIGHWAY DEPARTMENT
TERRITORY OF HAWAII
LANDSCAPE PLANTING
PLAN
FOR
MOKAPU ROAD EXTENSION
PROJ. NO. 5-0630 (6)


MANSFIELD P. CLAFLIN
LANDSCAPE ARCH. A.S.L.A.
HONOLULU

Scale: 1"=40' SEPT. 18, 1958

SHEET NO. 2 OF 3 SHEETS

5946.27 B

FED. ROAD DIST. No.	STATE	FED. AID PROJ. No.	FISCAL YEAR	SHEET No.	TOTAL SHEETS
HAWAII	HAW.	S-0630(6)	1958	27	27

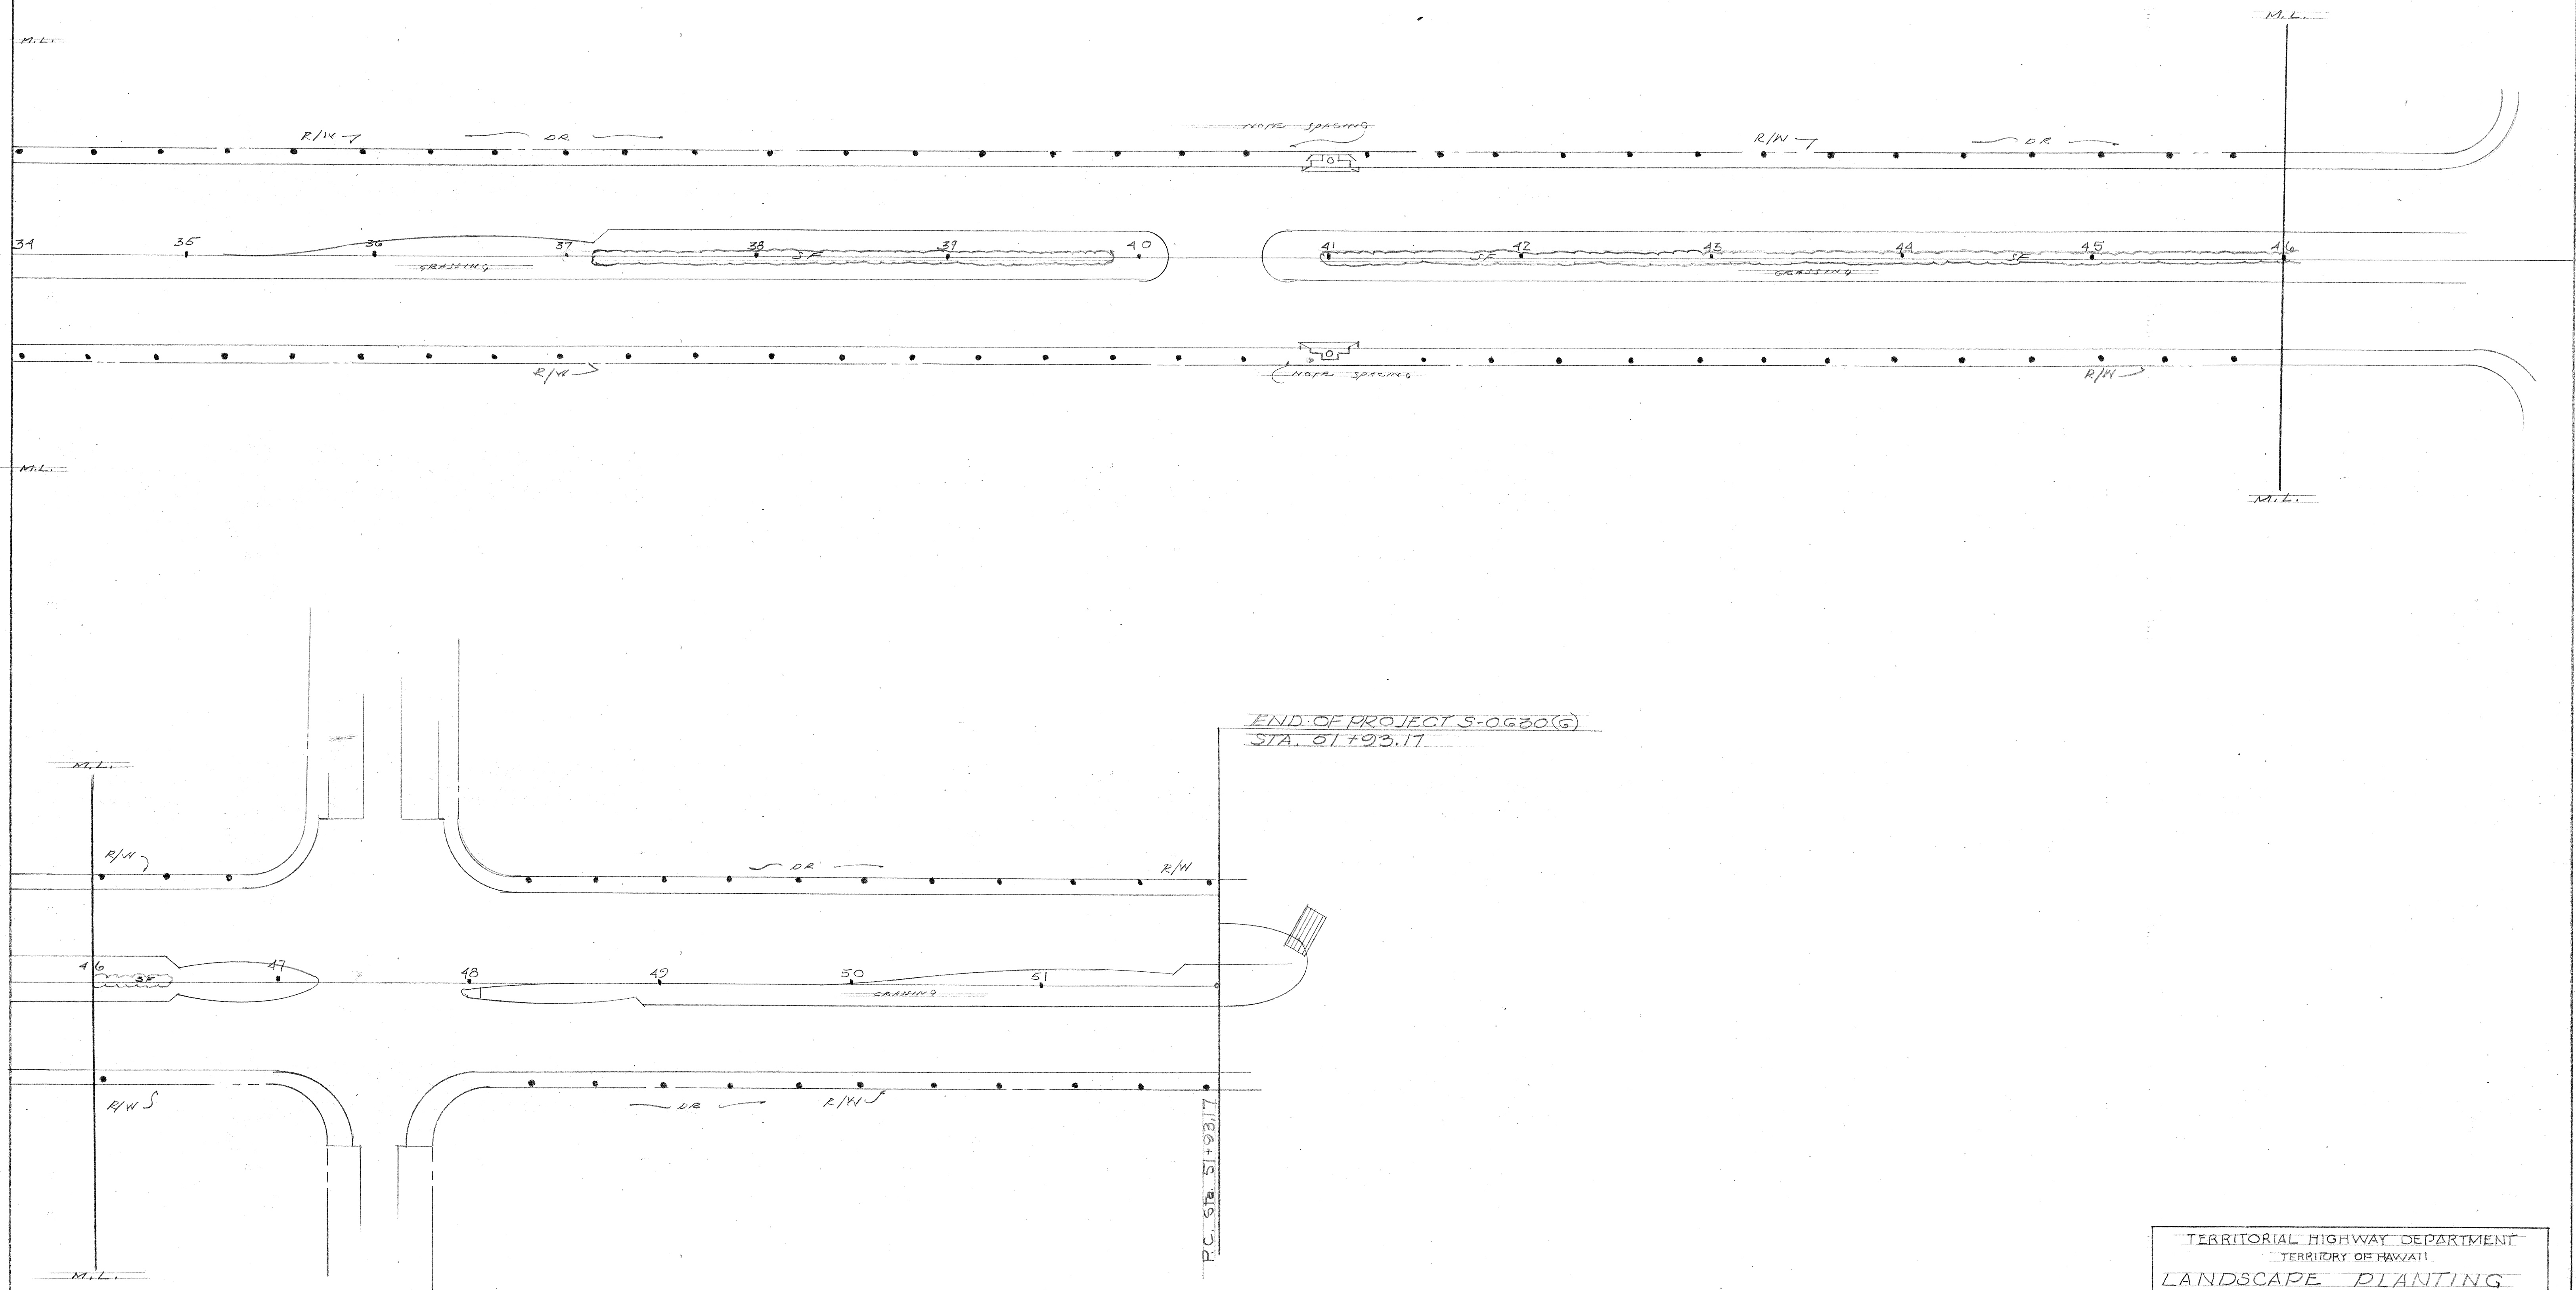


MANSFIELD P. CLAFLIN
LANDSCAPE ARCH. A.S.L.A.
HONOLULU

TERRITORIAL HIGHWAY DEPARTMENT
TERRITORY OF HAWAII
LANDSCAPE PLANTING
PLAN
FOR
MOKAPU ROAD EXTENSION
PROJ. NO. S-0630(6)
Scale: 1"=40' SEPT. 18, 1958

SHEET NO. 3 OF 3 SHEETS

5946.27 C

Revised: April 2, 1959
Adjusted landscaping in
island at Sta. 5+00 (±)

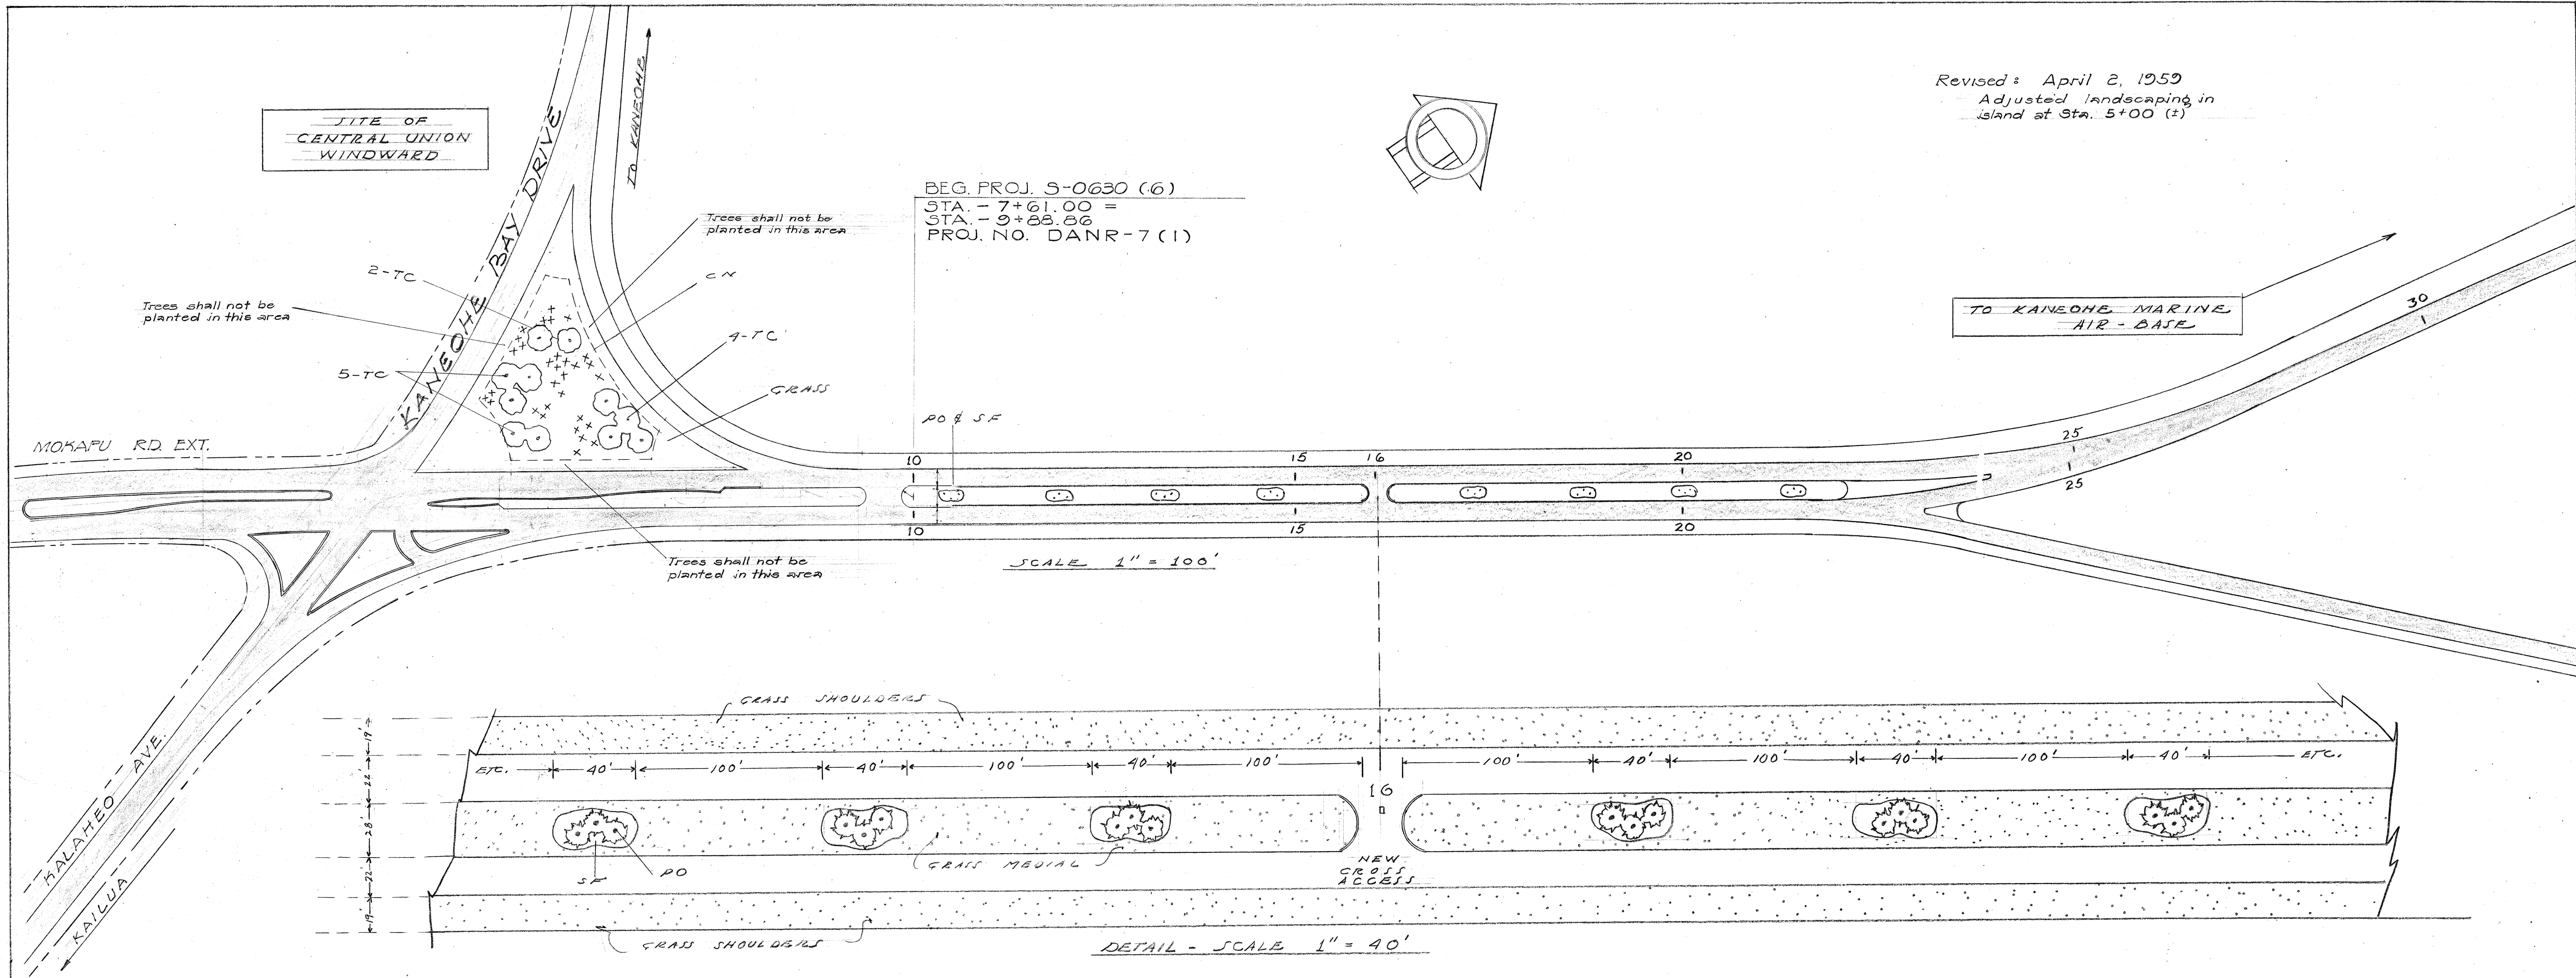

PLANT LIST

KEY	BOTANICAL NAME	COMMON NAME	QUANTITY	REMARKS
CN	COCOS NUCIFERA	COCONUT	31 56	5-GAL. CAN - 6 MATURE LEAVES - PLANT AS INDICATED IN TRIANGLES.
NA	NAUPAKA	NAUPAKA	24	5-GAL. CAN - 4-5 FT. TALL - PLANT IN 32 APPROX. 10 FT. APART.
TC	TERMINALIA CATAPPA	FALSE KAMANI	11 74	1-GAL. CAN - 8"-10" TALL - PLANT 3 FT. OC. IN AREAS IND.

NOTES

1. THE ISLANDS OF NAUPAKA ARE APPROX. 40'X18' WITH SOFTENED CONTOURS. THE HALAS RISE FROM THESE ISLANDS. AS INDICATED ABOUT 5' FT. OF GRASS IS INDICATED BETWEEN THE ISLANDS & ROADWAY TO ALLOW MOWERS ACCESS DOWN MEDIAL WITHOUT HAVING TO RUN ONTO ROAD.
2. GRASS IS INDICATED ON PLAN ON SHOULDERS, MEDIAL STRIP & IN BOTH LARGE "TRIANGLES". BERMUDA GRASS (CYNODON DACTYLON) IS RECOMMENDED.
3. THE FALSE KAMANI SHOULD BE STAKED SECURELY UNTIL TREES ARE WELL ESTABLISHED - 3 YRS.
4. TREES PLANTED WITHIN THE ISLAND AT STA. 5+00(±) SHALL HAVE A MINIMUM CLEARANCE OF 15' FROM THE EDGE OF PAVEMENT AND 125' FROM THE NOSE.

TERRITORIAL HIGHWAY DEPARTMENT
TERRITORY OF HAWAII
LANDSCAPE PLANTING PLAN
FOR
MOKAPU ROAD
KAILUA, OAHU
MANSFIELD CLARLIN
LANDSCAPE ARCH.
A.S.L.A.
HONOLULU
DATE - JULY 20, 1956 SCALE - ABOVE