


FED. ROAD DIST. NO.	STATE	FED. AID PROJ. NO.	FISCAL YEAR	SHEET NO.	TOTAL SHEETS
HAWAII	HA	5-0630(6)	1958	4	27

TRAFFIC SIGN SYMBOLS

- Sign on New 3" Galv. Posts
- Sign on Traffic Signal Poles
- Salvage and Remove existing traffic signs as directed by the Engineer.
- Est. Quant. = 5 each

Grade and Repave Existing Driveways with 2 1/2" A.C. Pavement. (No Basecourse) to match new Shoulder Slope.

BEG. PROJ. S-0630(6)
STA. -7+61.00 =
STA. 0+88.86
PROJ. NO. DA-NR-7(1)


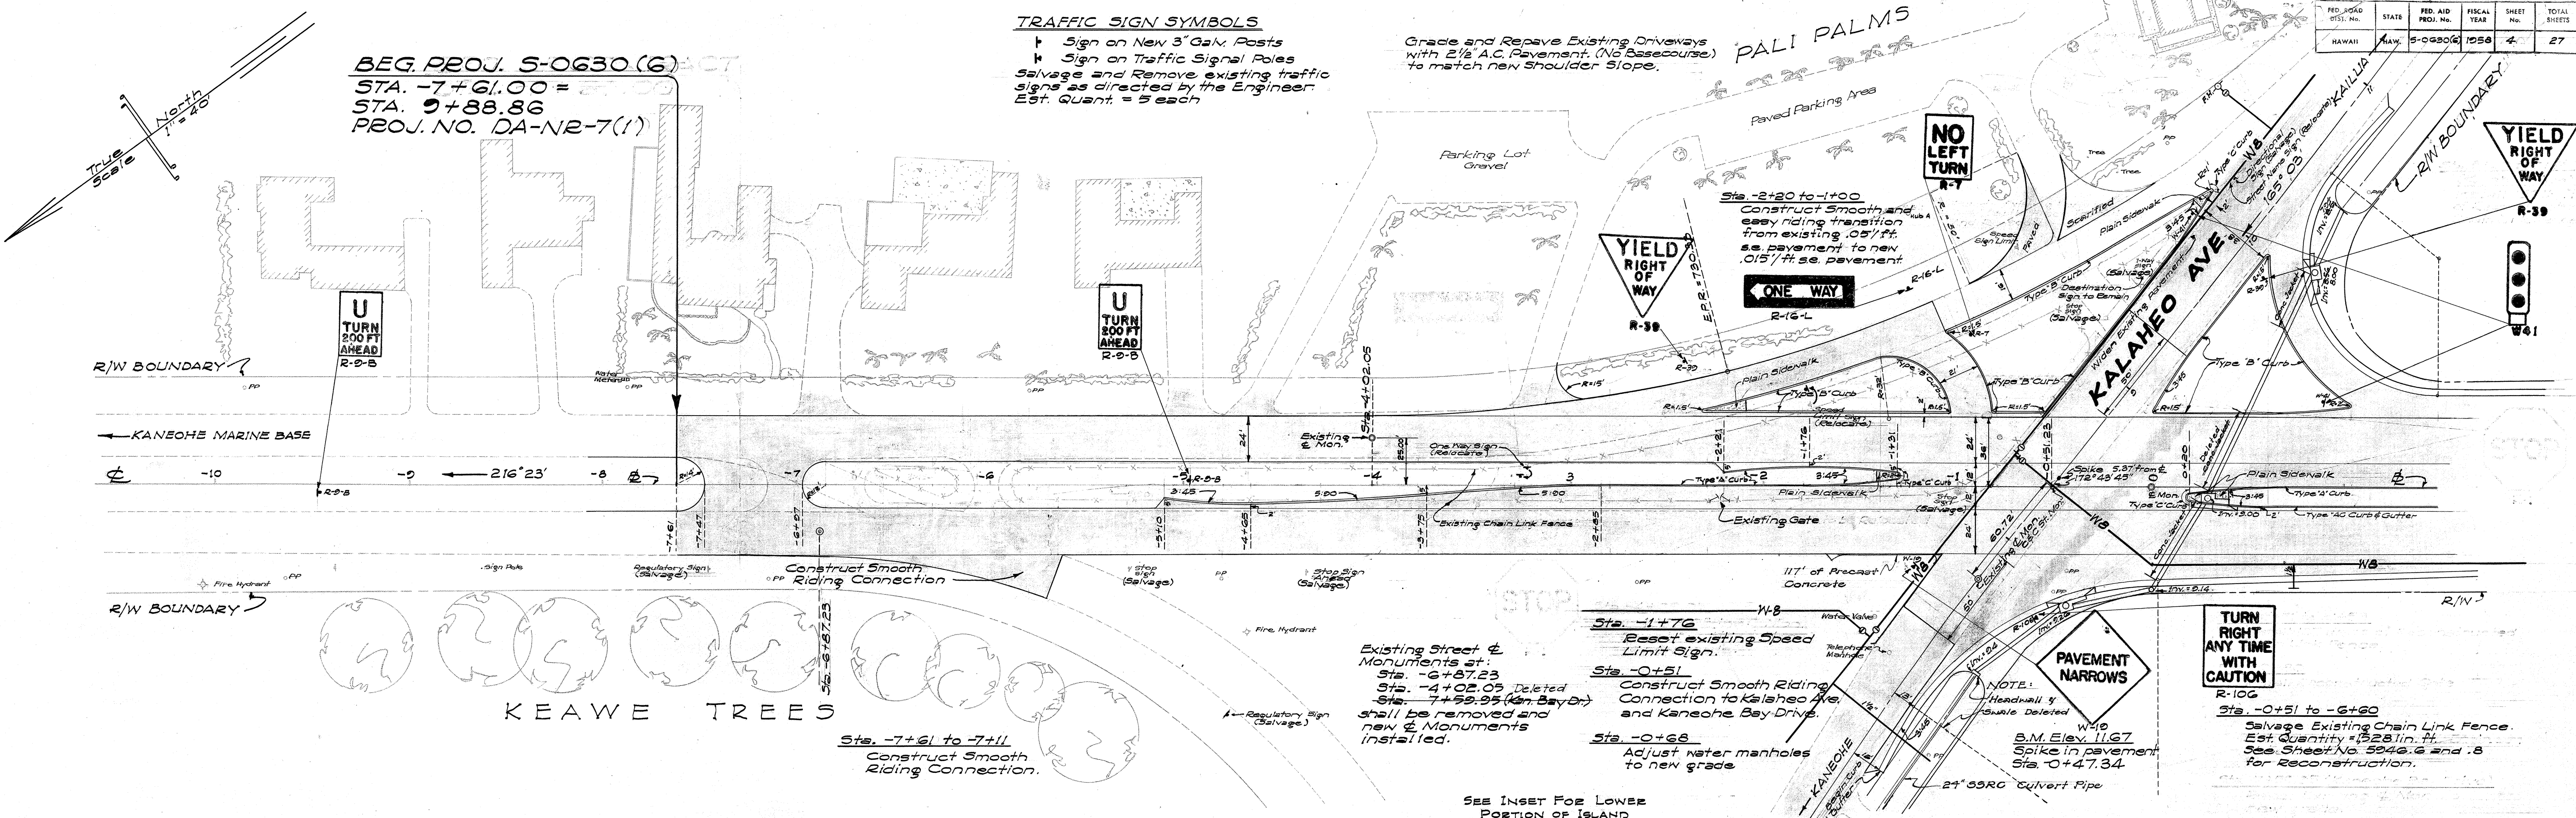


Existing Street & Monuments at:
Sta. -6+87.23
Sta. -4+02.05 Deleted
Sta. -7+59.25 (Kan. Bay Dr.) shall be removed and new & Monuments installed.

- Sta. -1+76 Reset existing Speed Limit Sign.
- Sta. -0+51 Construct Smooth Riding Connection to Kalaehe Ave. and Kaneohe Bay Drive.
- Sta. -0+68 Adjust water manholes to new grade.

TURN RIGHT ANY TIME WITH CAUTION
R-106
Sta. -0+51 to -6+80
Salvage Existing Chain Link Fence. Est. Quantity 1528 lin. ft. See Sheet No. 5046.6 and .8 for Reconstruction.

NOTE:
ALL WATER MAINS IN PROJECT ARE EXISTING

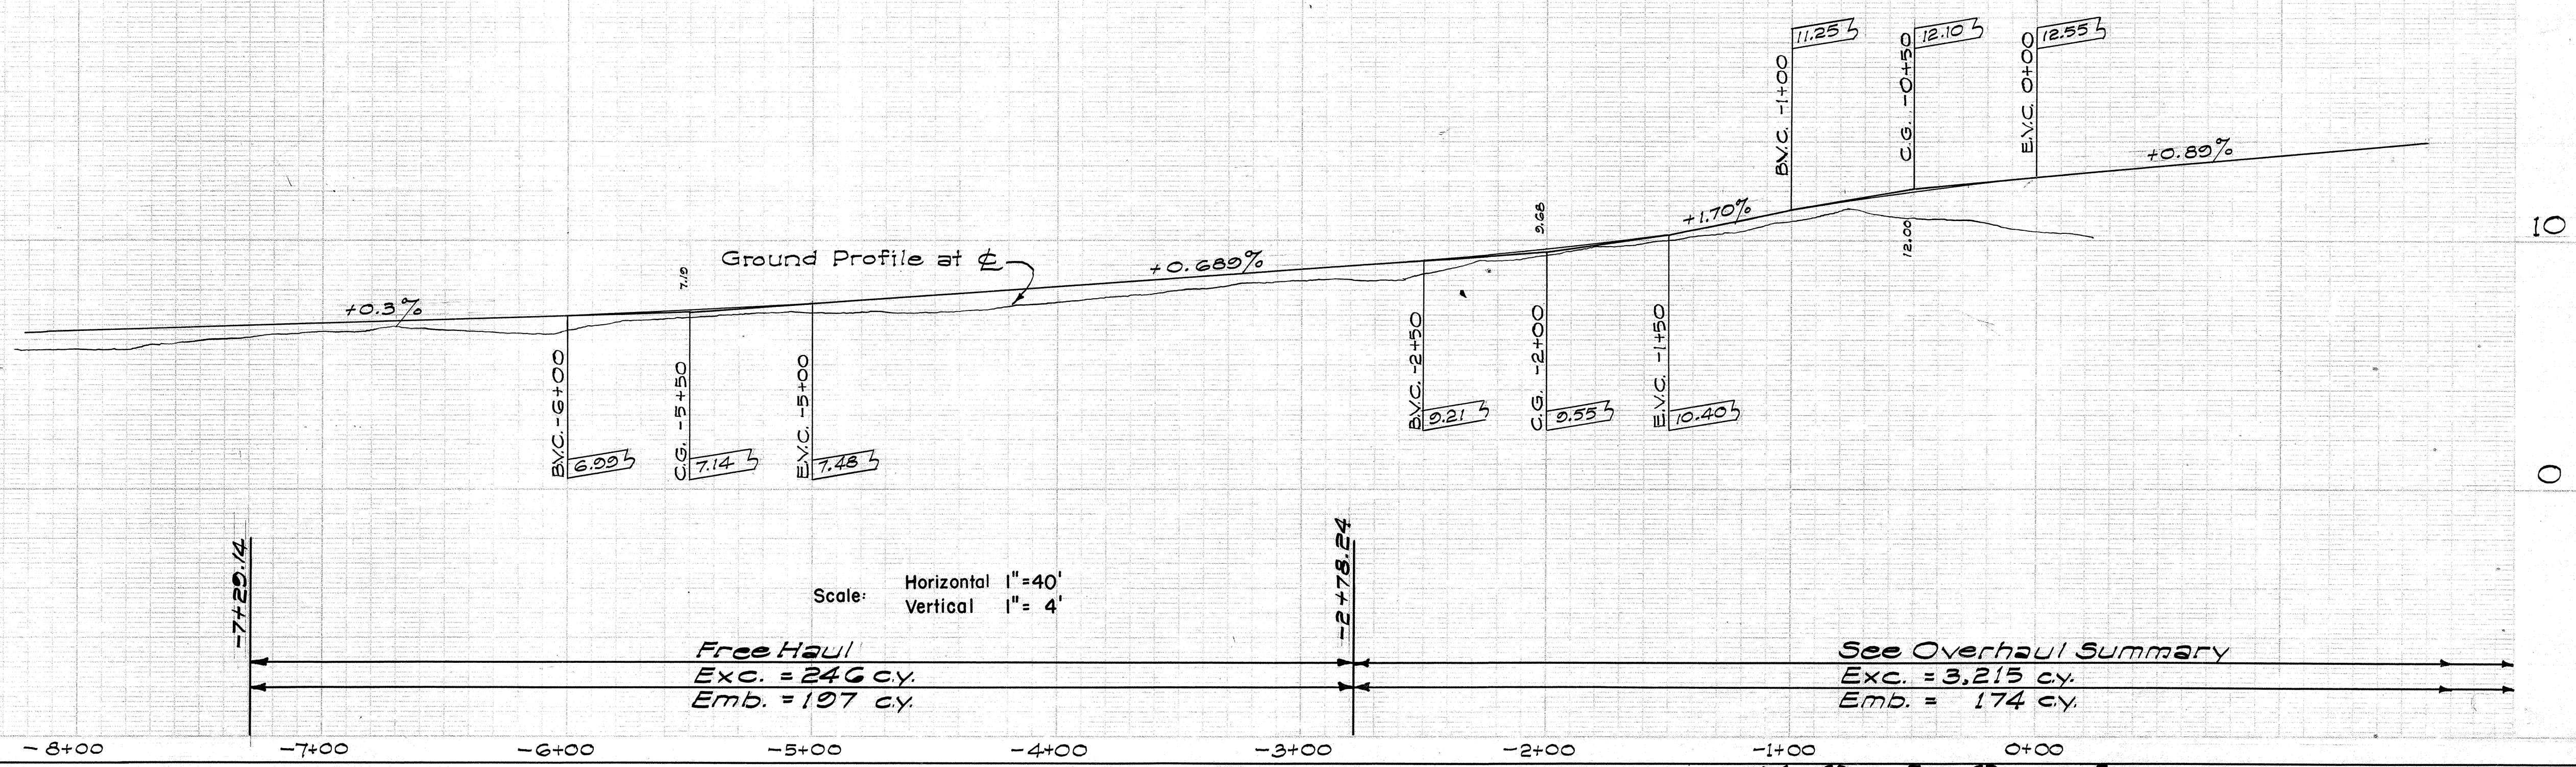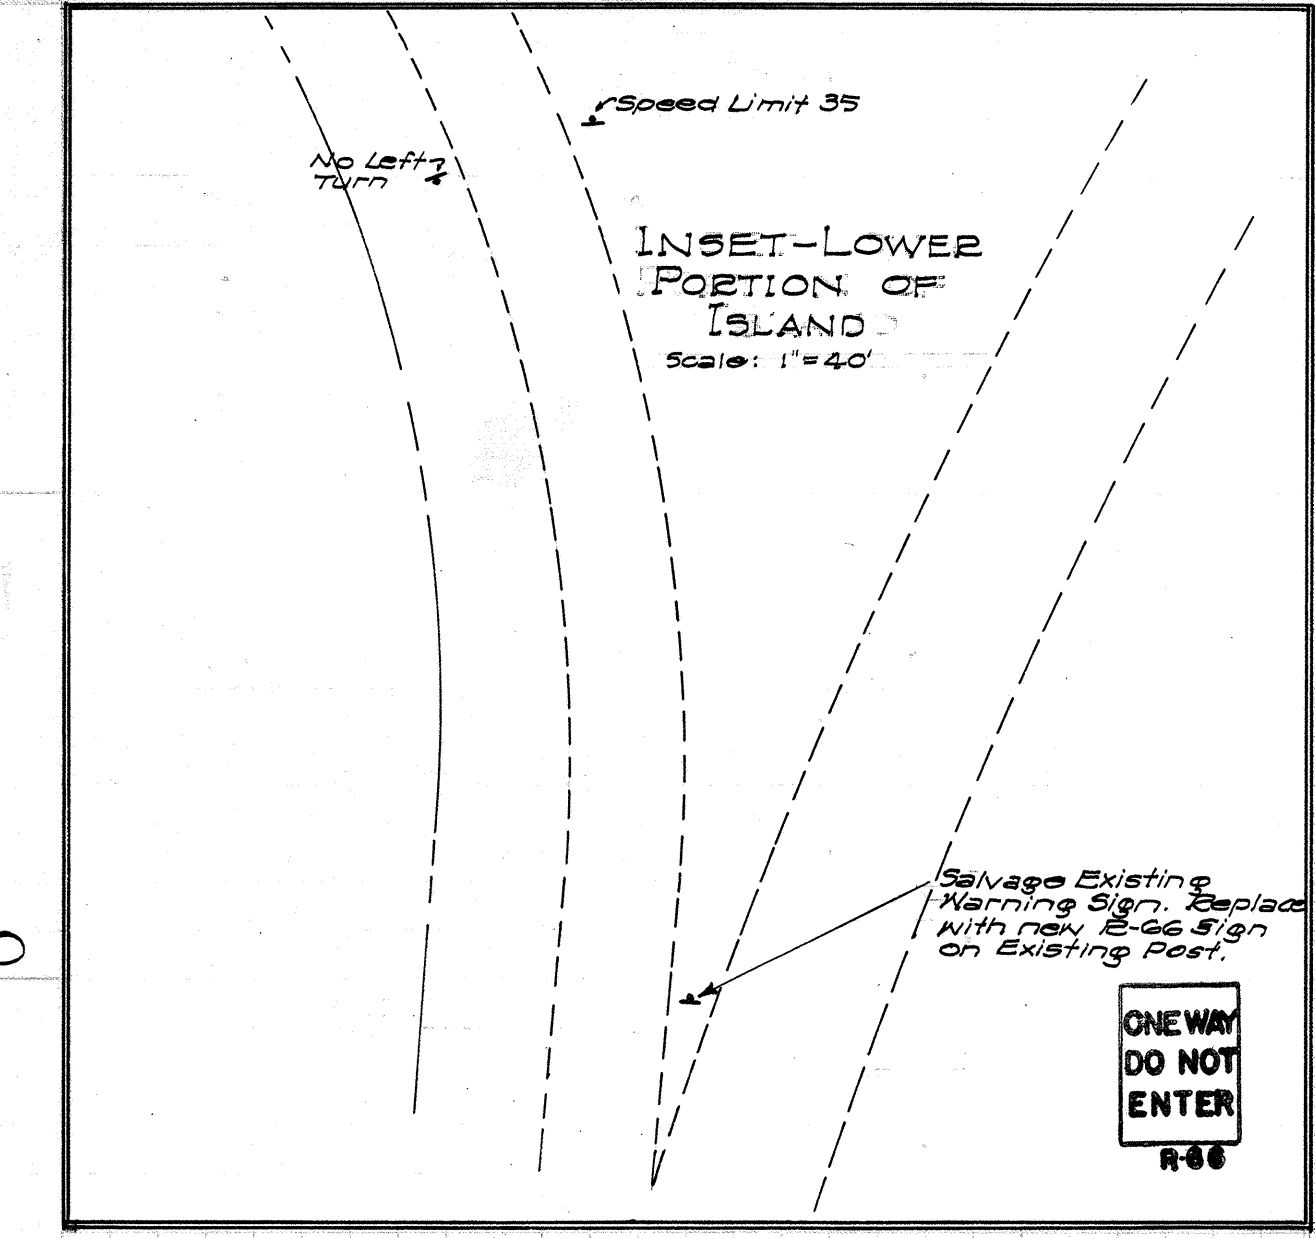

Free Haul
Exc. = 246 cy.
Emb. = 197 cy.

See Overhaul Summary
Exc. = 3,215 cy.
Emb. = 174 cy.

5946.4

FED. ROAD DIST. No.	STATE	FED. AID PROJ. No.	FISCAL YEAR	SHEET No.	TOTAL SHEETS
HAWAII	HAW.	50630(0)	1958	6	27

B.M. Elev. 2351
Top of Fire Hydrant (existing)
Sta. 20+69.51 left of C

For Intersection Detail
See Sheet No. 5946.10

TRUE NORTH
SCALE: 1"=40'

Sta. 12+50
1 - Type "A" C.B.
24 lin. ft. 24" 55 RCCP
52 cu. yd. Struct. Exc.
7.0 cu. yd. Class A-1 Conc.
120 lbs. Reinf. Steel
1 ea. Type "B" C.I. Frame and Cover

Existing D.M.H.
Inv. of 24" stub = 7.80
24" 55 RCCP
Inv. = 8.10



Existing D.M.H.
Inv. of 24" stub = 6.45

Sta. 12+55
1 - Type "A" C.B.
31.25 cu. yd. Struct. Exc.
8.75 cu. yd. Class A-1 Conc.
120 lbs. Reinf. Steel
1 ea. Type "B" C.I. Frame & Cover
4 lin. ft. 24" 55 RCCP

~~Sta. 14+24 to 19+54
Install 36" Reconstructed
Chain Link Fence
Est. Qty. = 530 lin. ft. Deleted~~

~~Sta. 11+55 to 13+50
Install new 36" Reconstructed
Chain Link Fence
Est. Quant. = 125 lin. ft.~~

Sta. 20+70 R.I.
1 - Type "C" C.B.
166.150 lin. ft. 24" 55 RCCP
172 cu. yd. Struct. Exc.
17.2 cu. yd. Class A-1 Conc.
810 lbs. Reinf. Steel
1 ea. Type "B" C.I. Frame & Cover

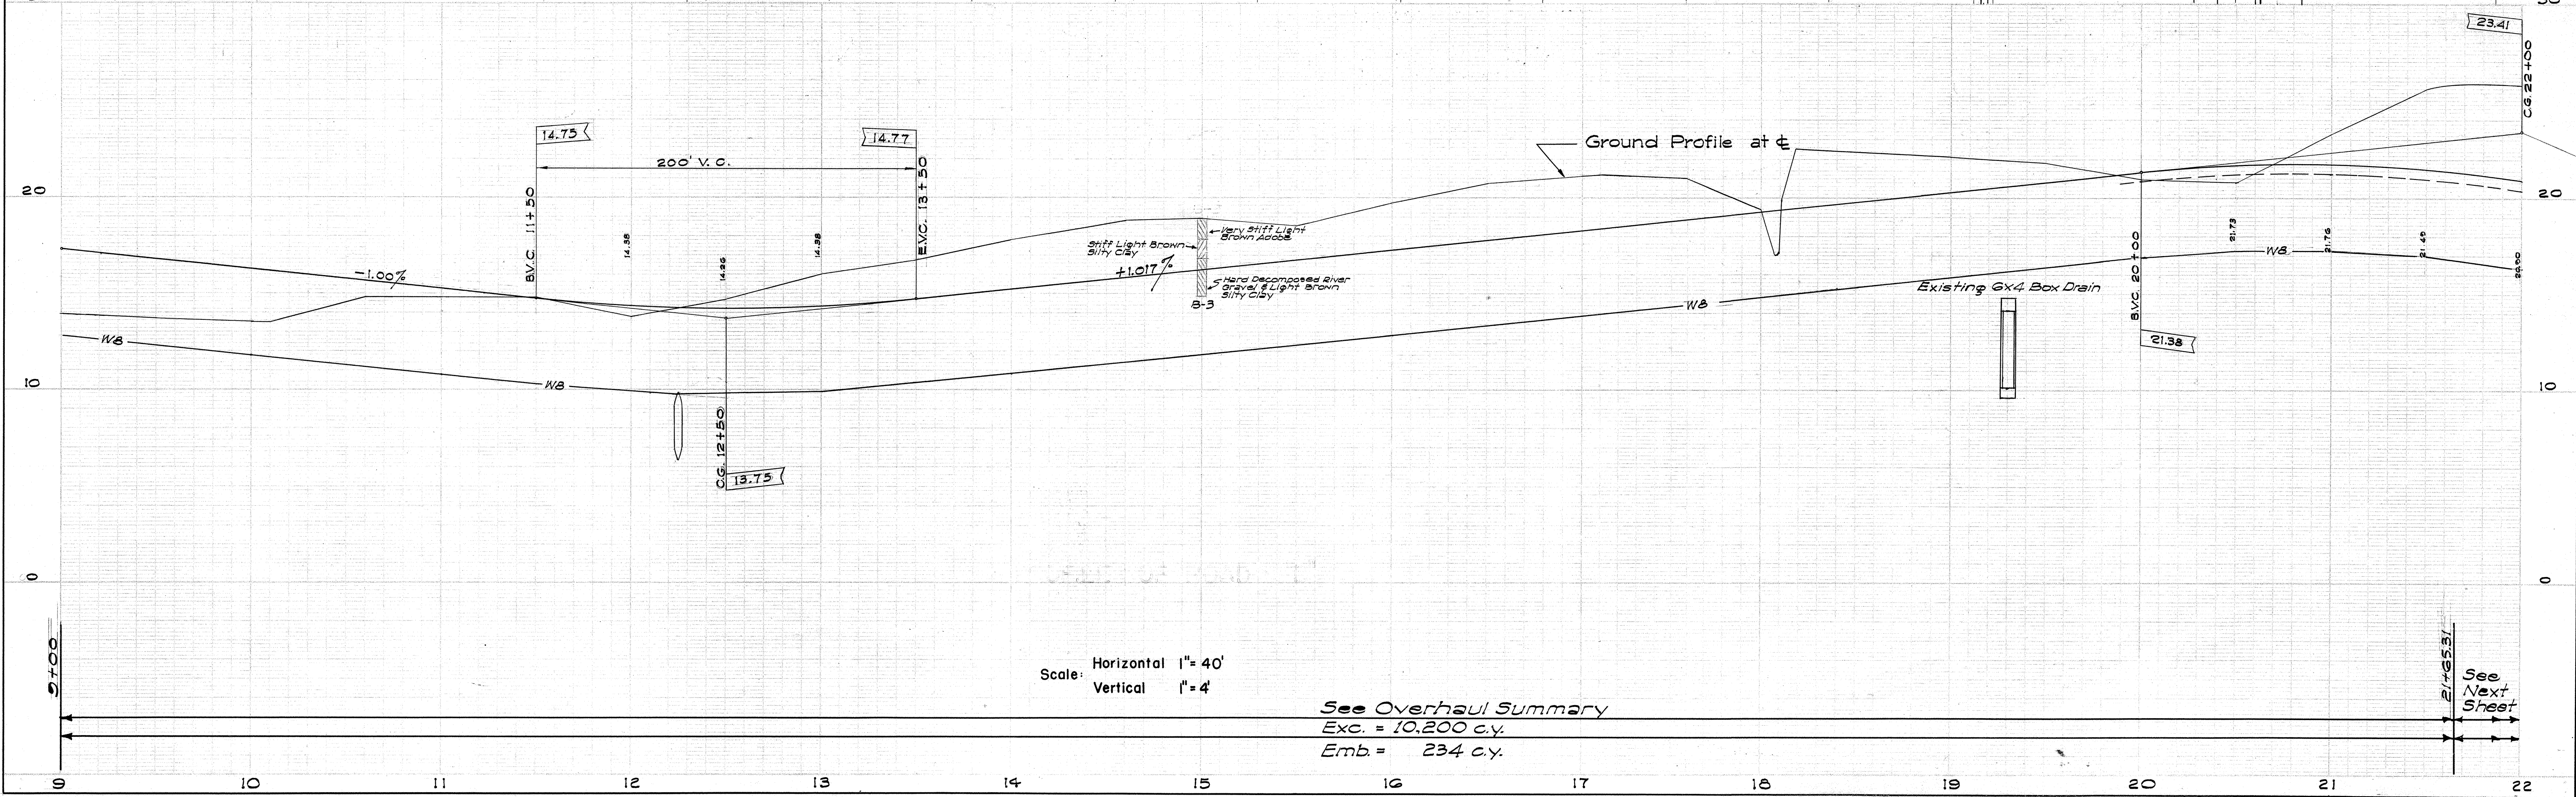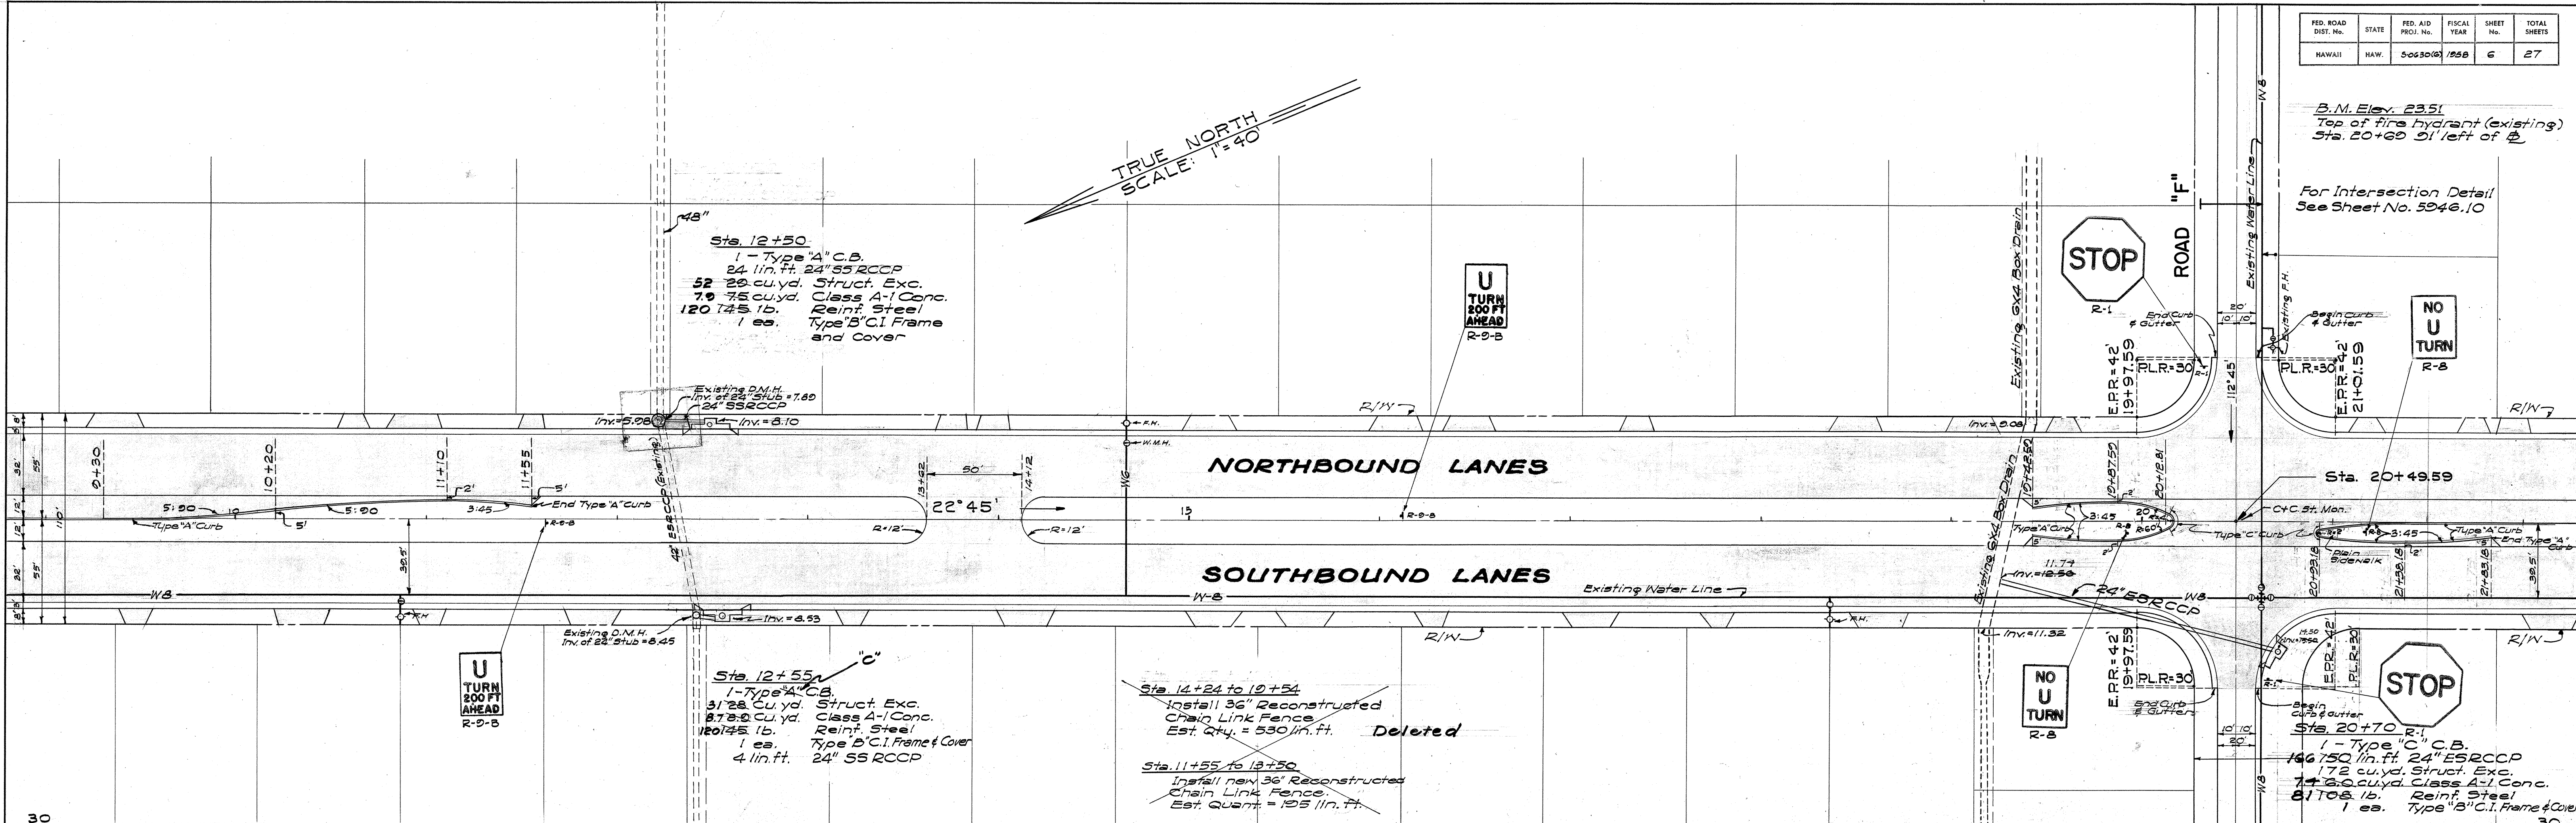


Scale: Horizontal 1"=40'
Vertical 1"=4'

See Overhaul Summary
Exc. = 10,200 c.y.
Emb. = 234 c.y.

See Next Sheet

5946.6

PROFILE	SURVEYED	BY	DATE
	PLOTTED	<i>E.M. Towill</i>	
NOTE BOOK	GRADES CHECKED	<i>J.Y.</i>	
NO. _____	B. MS. NOTED	<i>O.M.</i>	
	STRUCTURE NOTAT'NS. CH'KD		

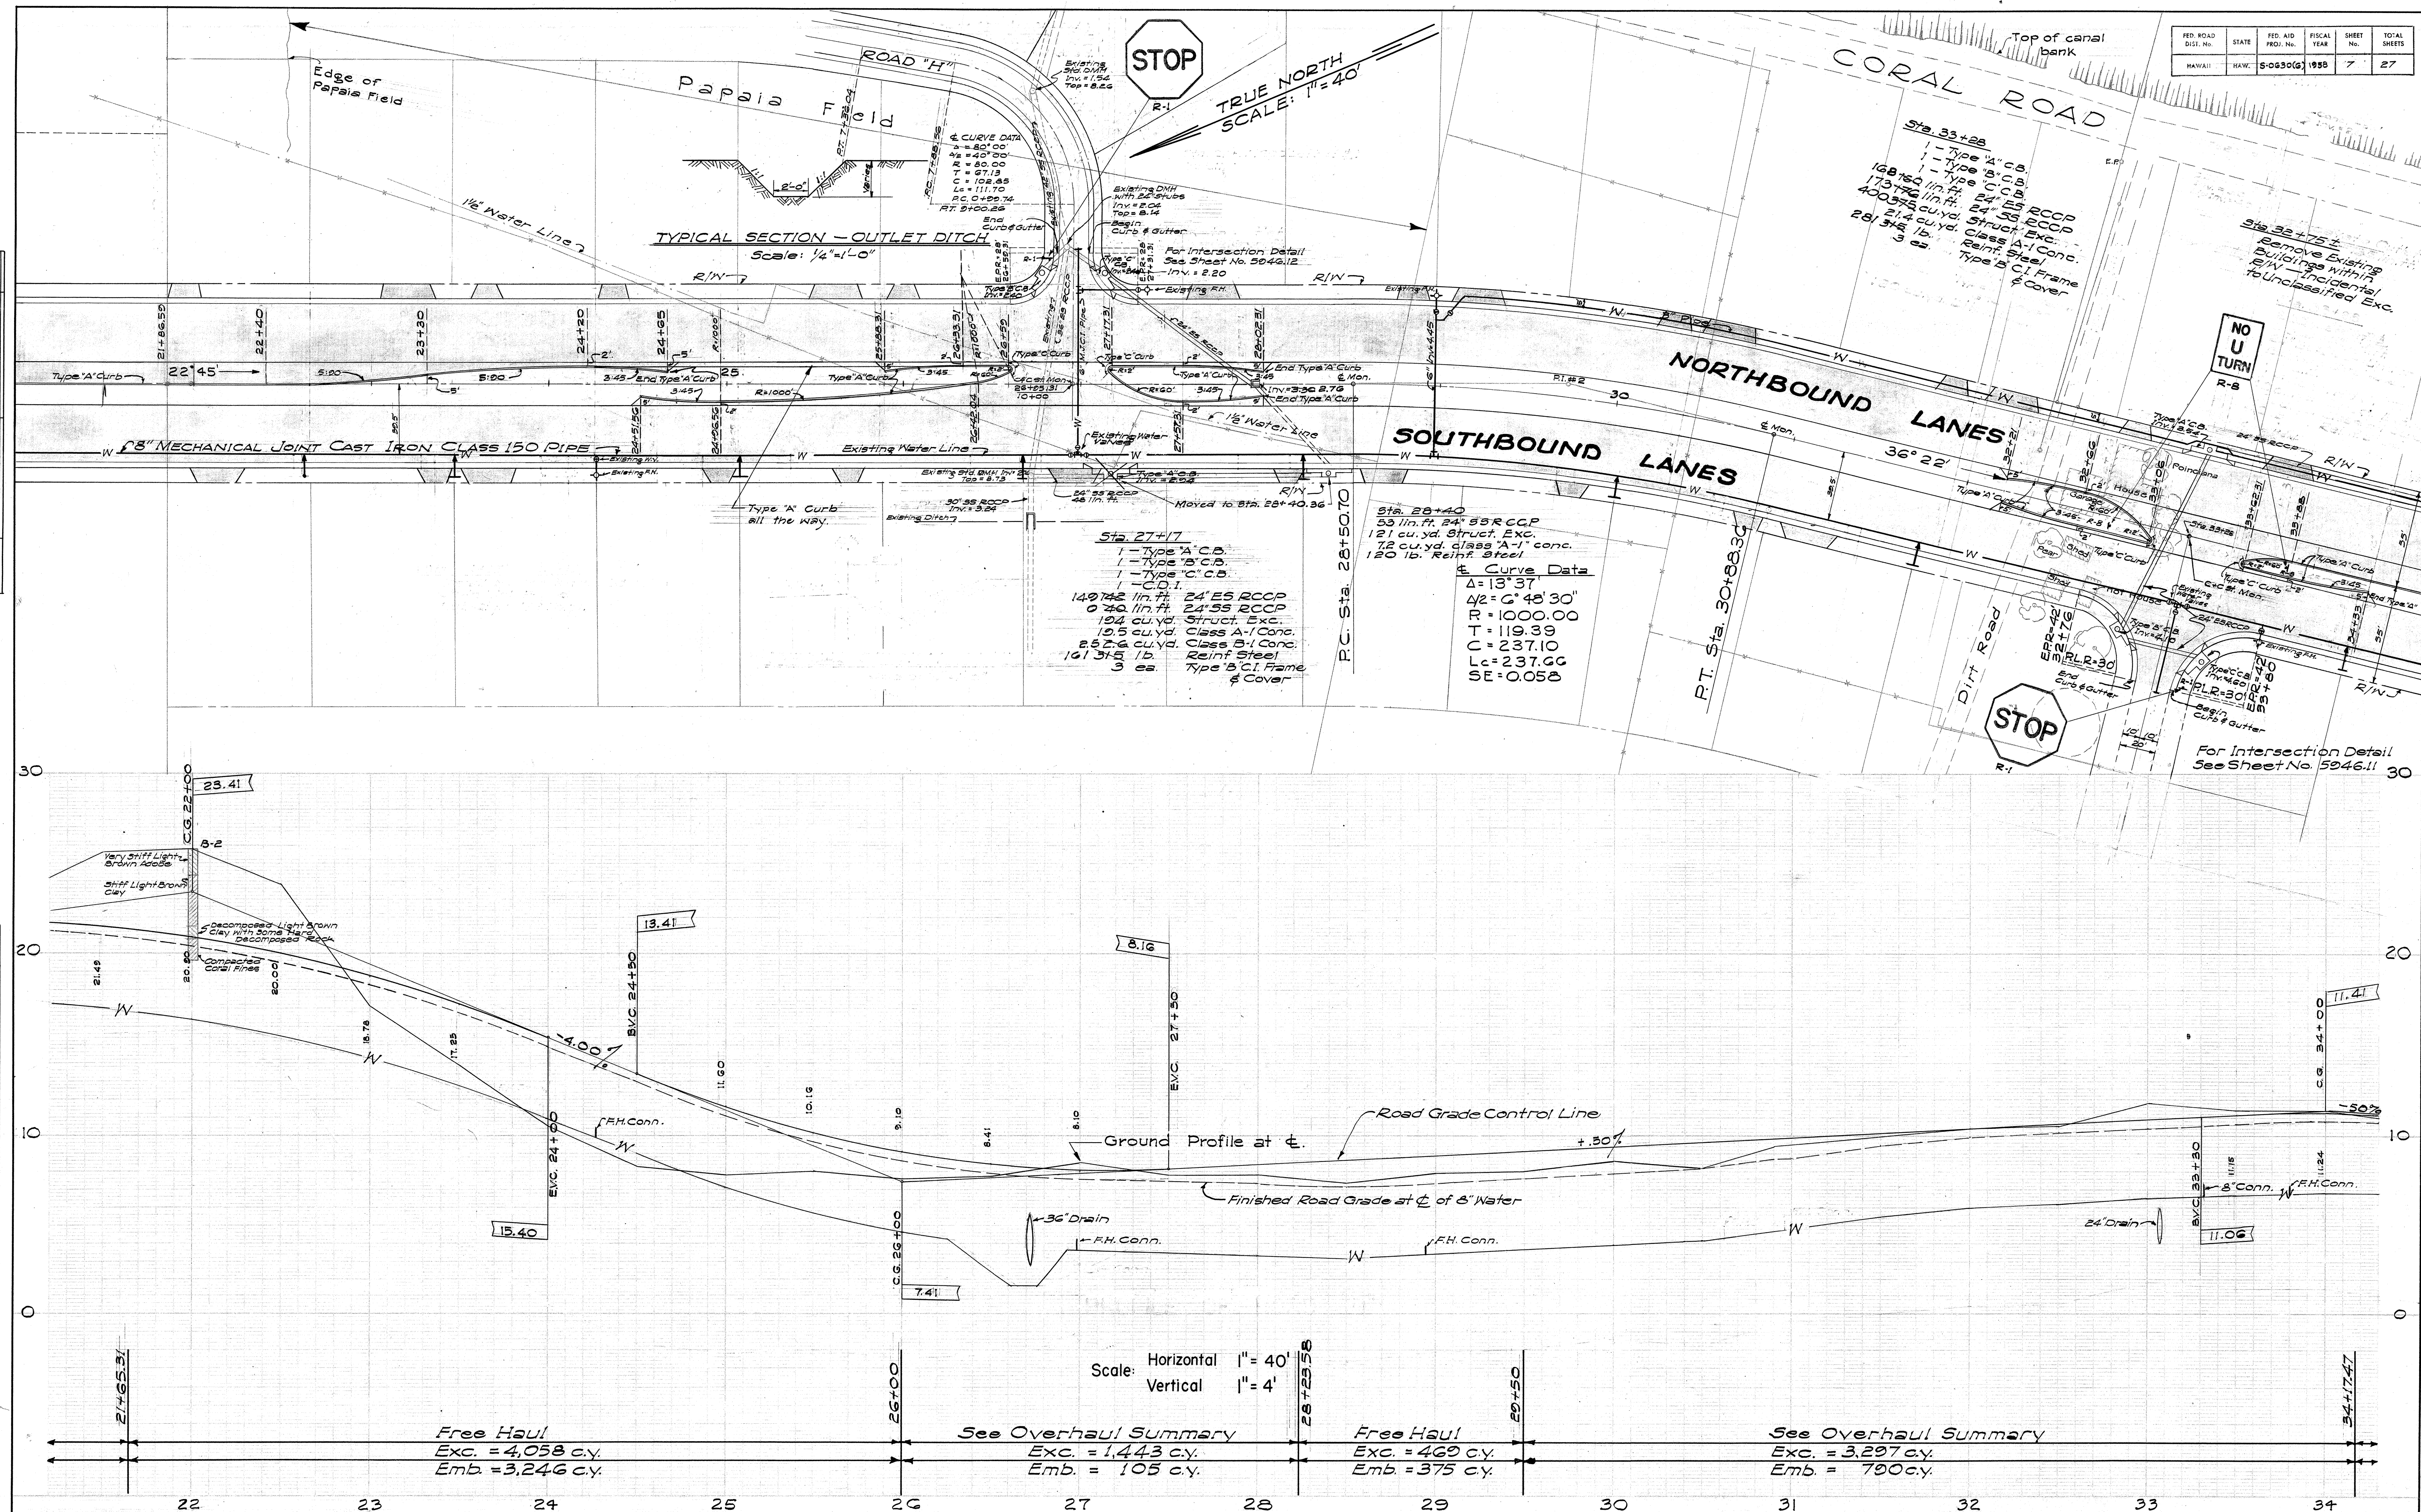


5946.7

FED. ROAD DIST. No.	STATE	FED. AID PROJ. No.	FISCAL YEAR	SHEET No.	TOTAL SHEETS
HAWAII	HAW.	S-0230(1)	1958	8	27

PLAN	DATE	BY
SURVEYED		
PLOTTED		
NOTE BOOK		
RT. OF WAY CHECKED		
NO.		

PROFILE	DATE	BY
SURVEYED		
PLOTTED		
NOTE BOOK		
STRUCTURE NOTATIONS CHECKED		
NO.		

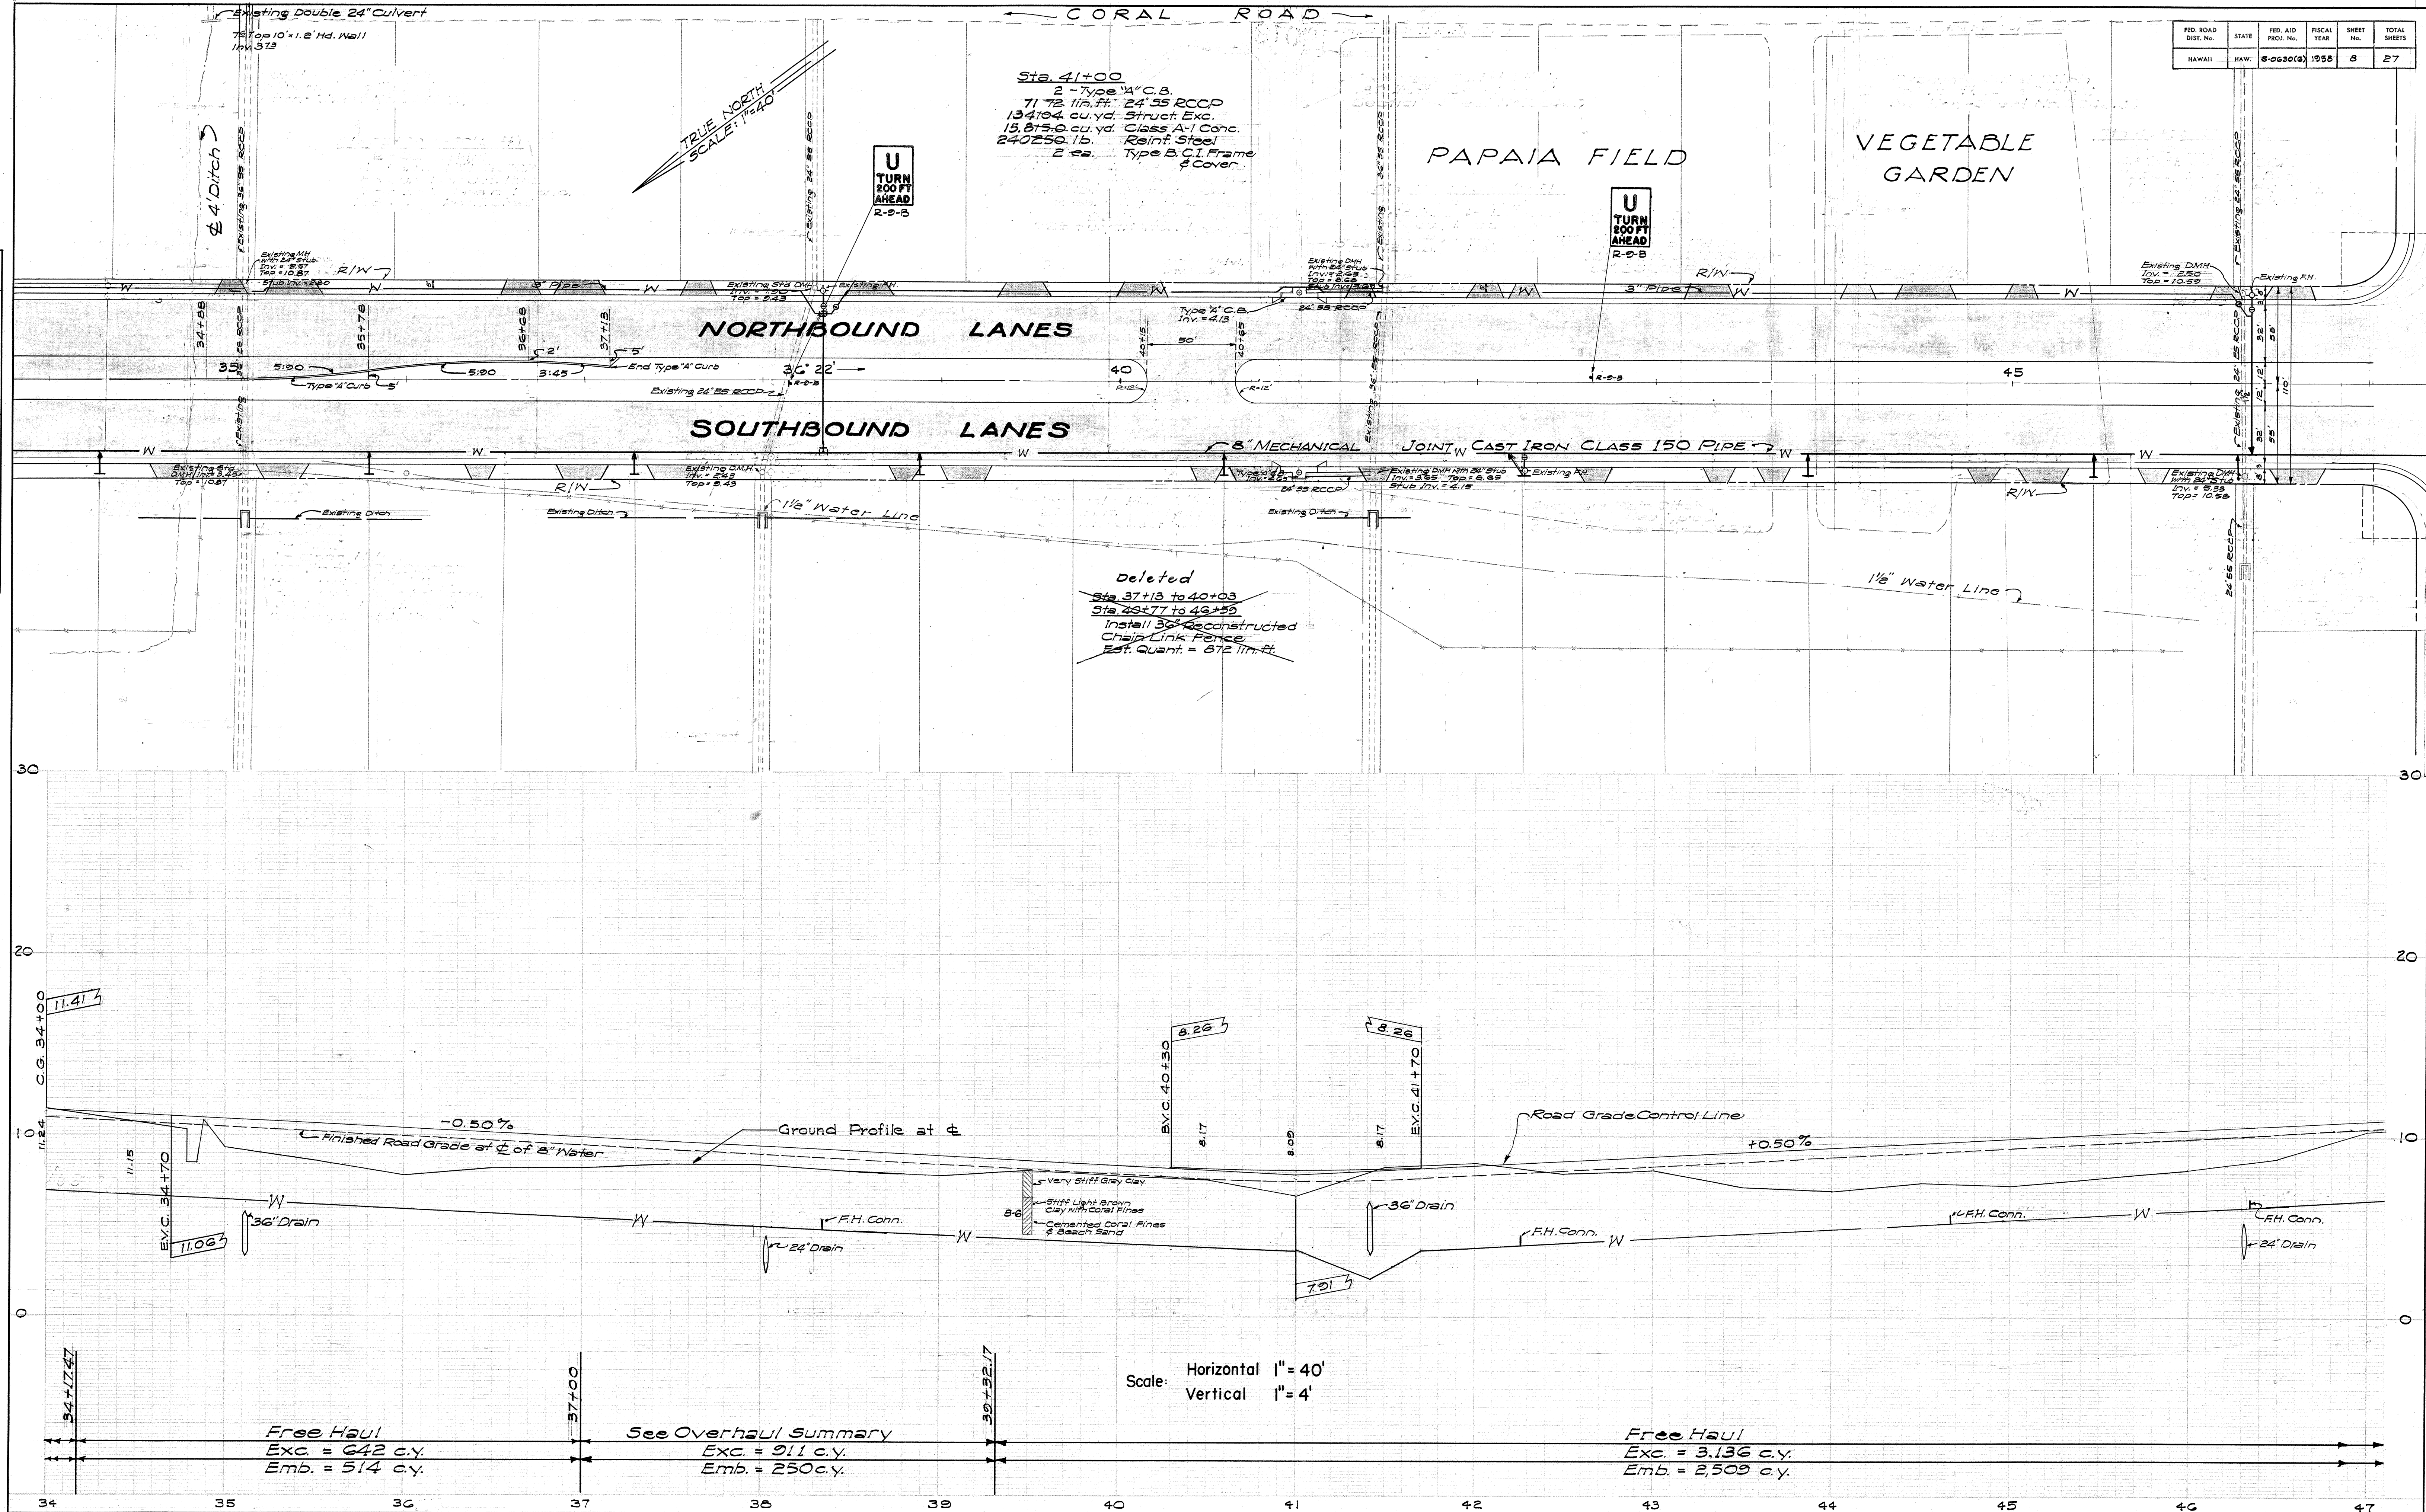

5946.8

