


| FED. ROAD DIST. NO. | STATE | FED. AID PROJ. NO. | FISCAL YEAR | SHEET NO. | TOTAL SHEETS |
|---------------------|-------|--------------------|-------------|-----------|--------------|
| HAWAII              | HAW   | 506306             | 1958        | 15        | 27           |

Revised: 7/19/58  
Walk-Wait Pedestrian Signals and Signal Standard 14 added.

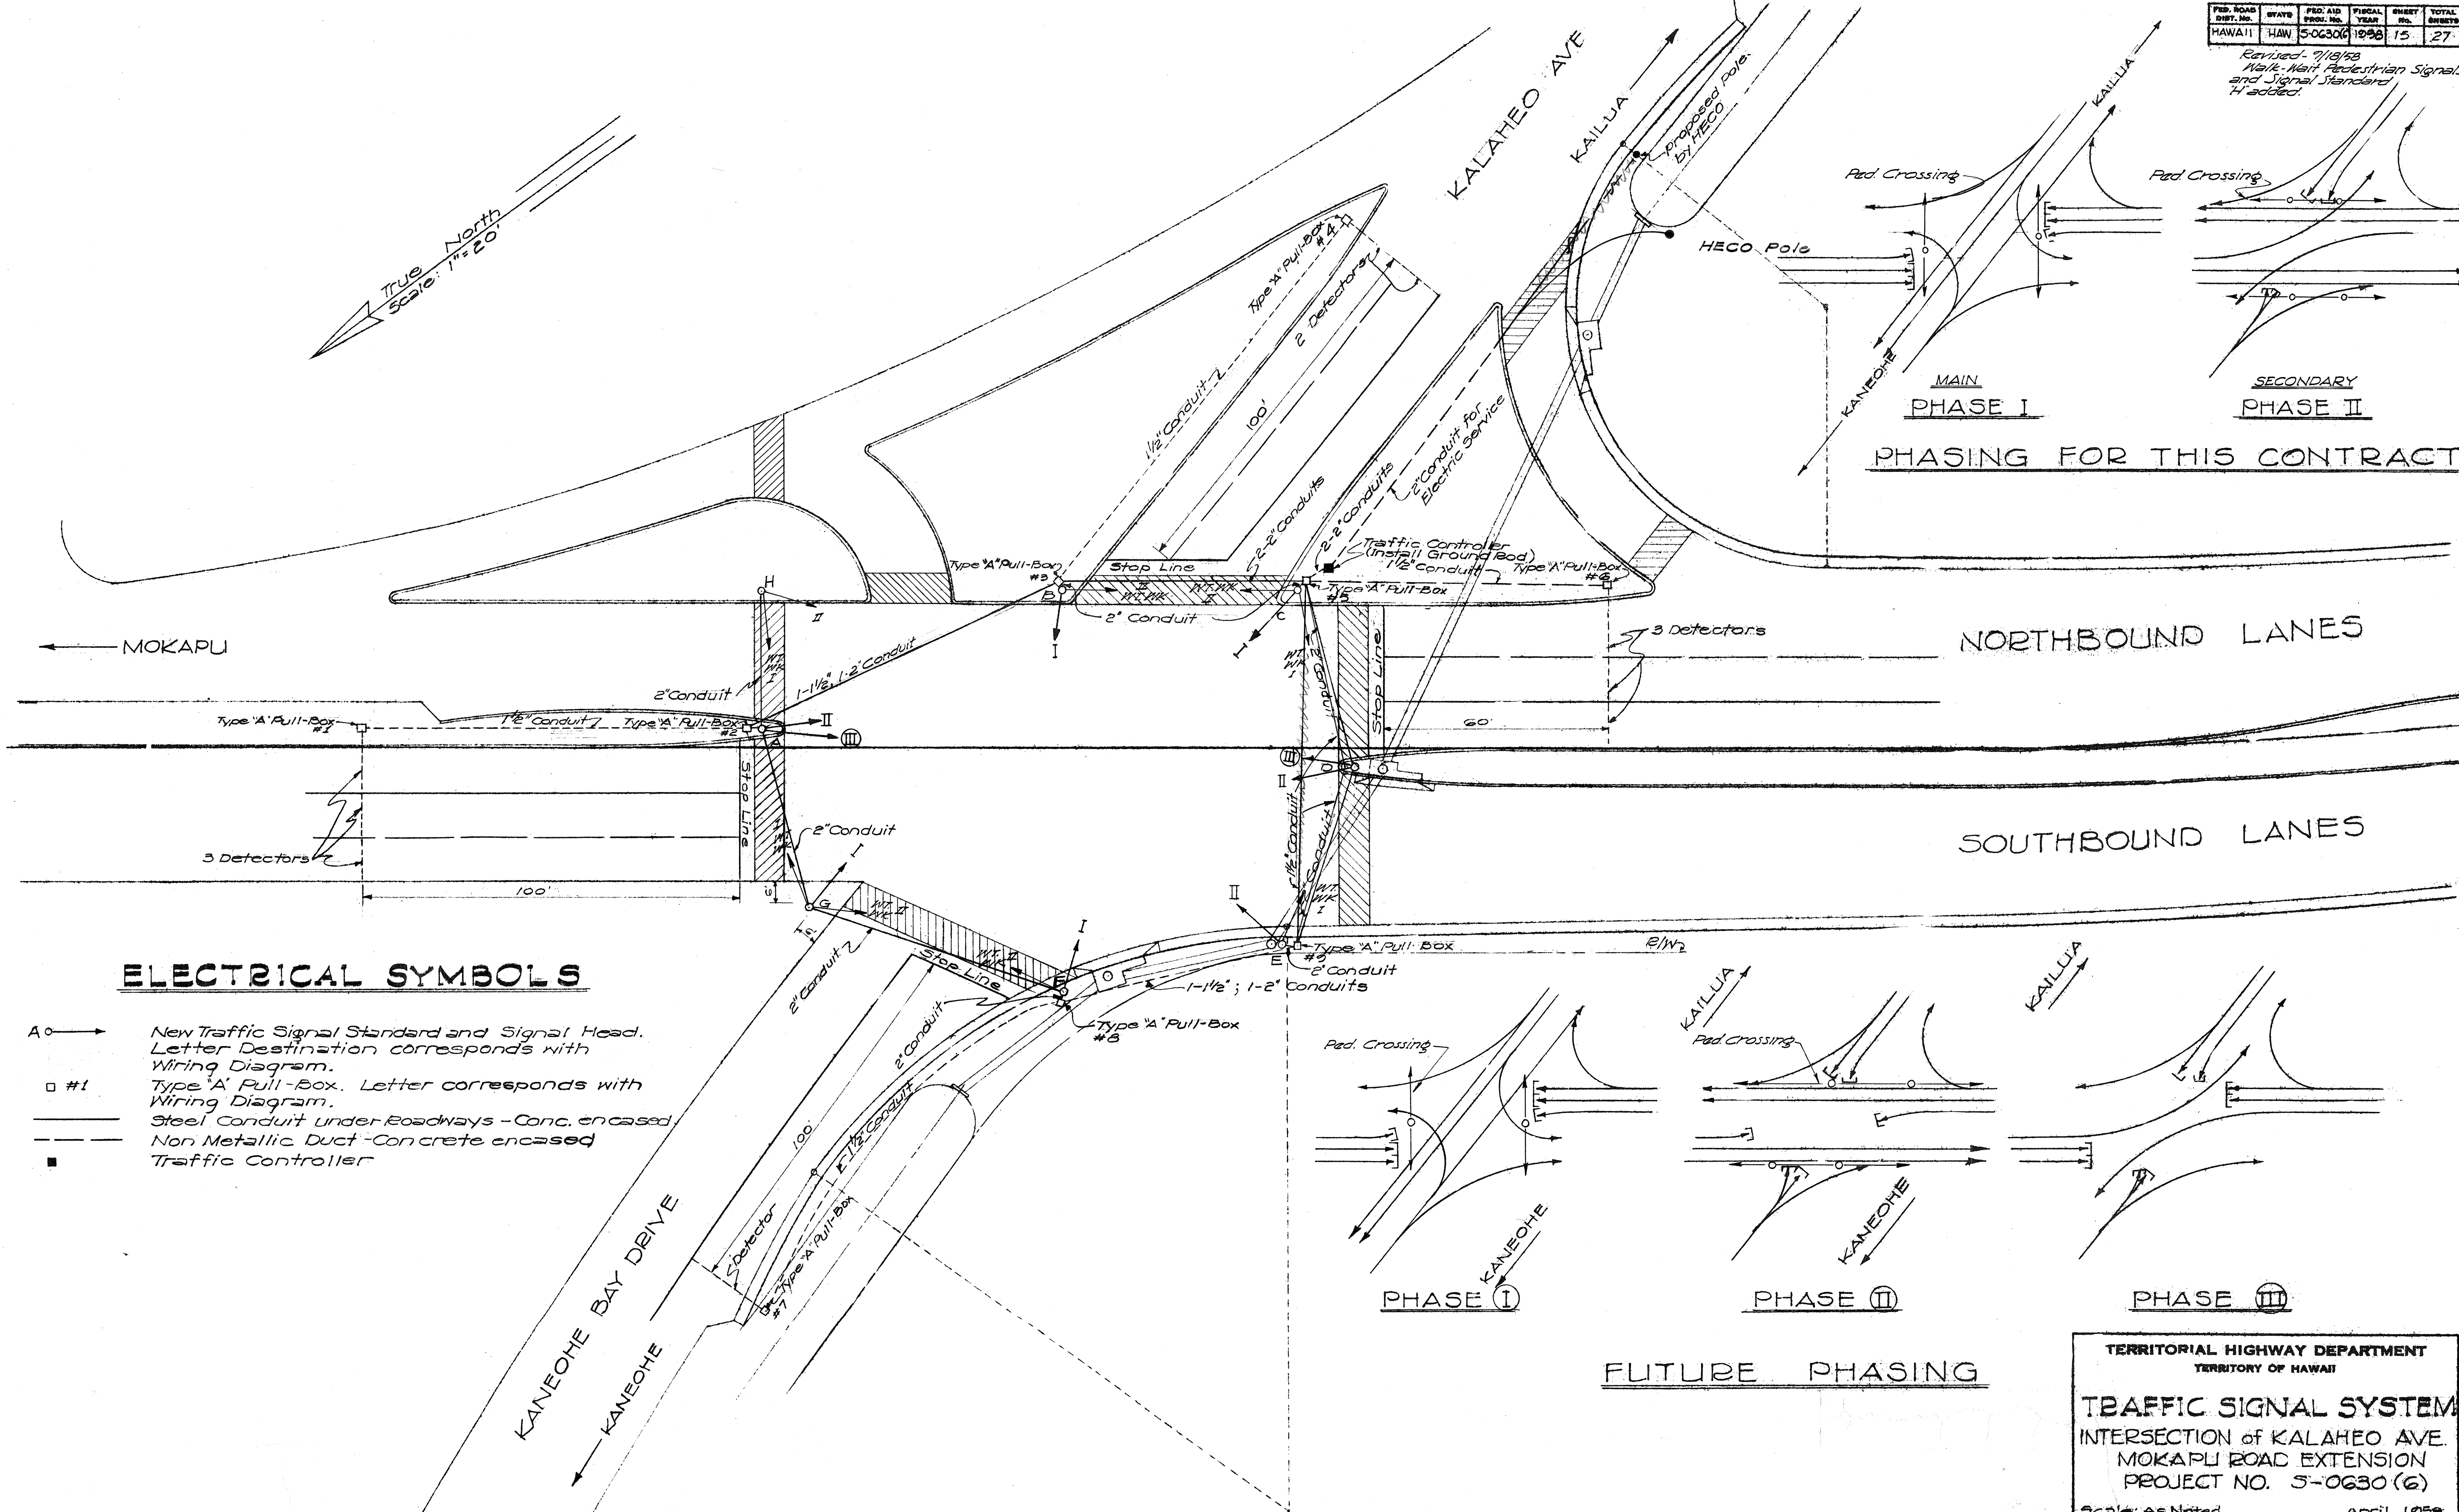

TERRITORIAL HIGHWAY DEPARTMENT  
TERRITORY OF HAWAII  
**TRAFFIC SIGNAL SYSTEM**  
INTERSECTION OF KALAHEO AVE.  
MOKAPU ROAD EXTENSION  
PROJECT NO. 5-0630 (6)  
Scale: As Noted April 1958

SHEET No. 1 OF 2 SHEETS


5946.15A

Revised: 7/19/58

|                       |              |
|-----------------------|--------------|
| DATE                  | 7/19/58      |
| DESIGNED BY           | W. J. HARRIS |
| DRAWN BY              | W. J. HARRIS |
| CHECKED BY            | W. J. HARRIS |
| QUANTITIES CHECKED BY | W. J. HARRIS |
| ORIGINAL PLAN         | NO.          |
| NOTE BOOK             | NO.          |

| FED. ROAD DIST. NO. | STATE | FED. AID PROJ. NO. | FISCAL YEAR | SHEET NO. | TOTAL SHEETS |
|---------------------|-------|--------------------|-------------|-----------|--------------|
| HAWAII              | HAW   | 5-0630(6)          | 1958        | 16        | 27           |

Revised 9/18/58  
Walk-Wait Circuit and Signal Standard "H" added

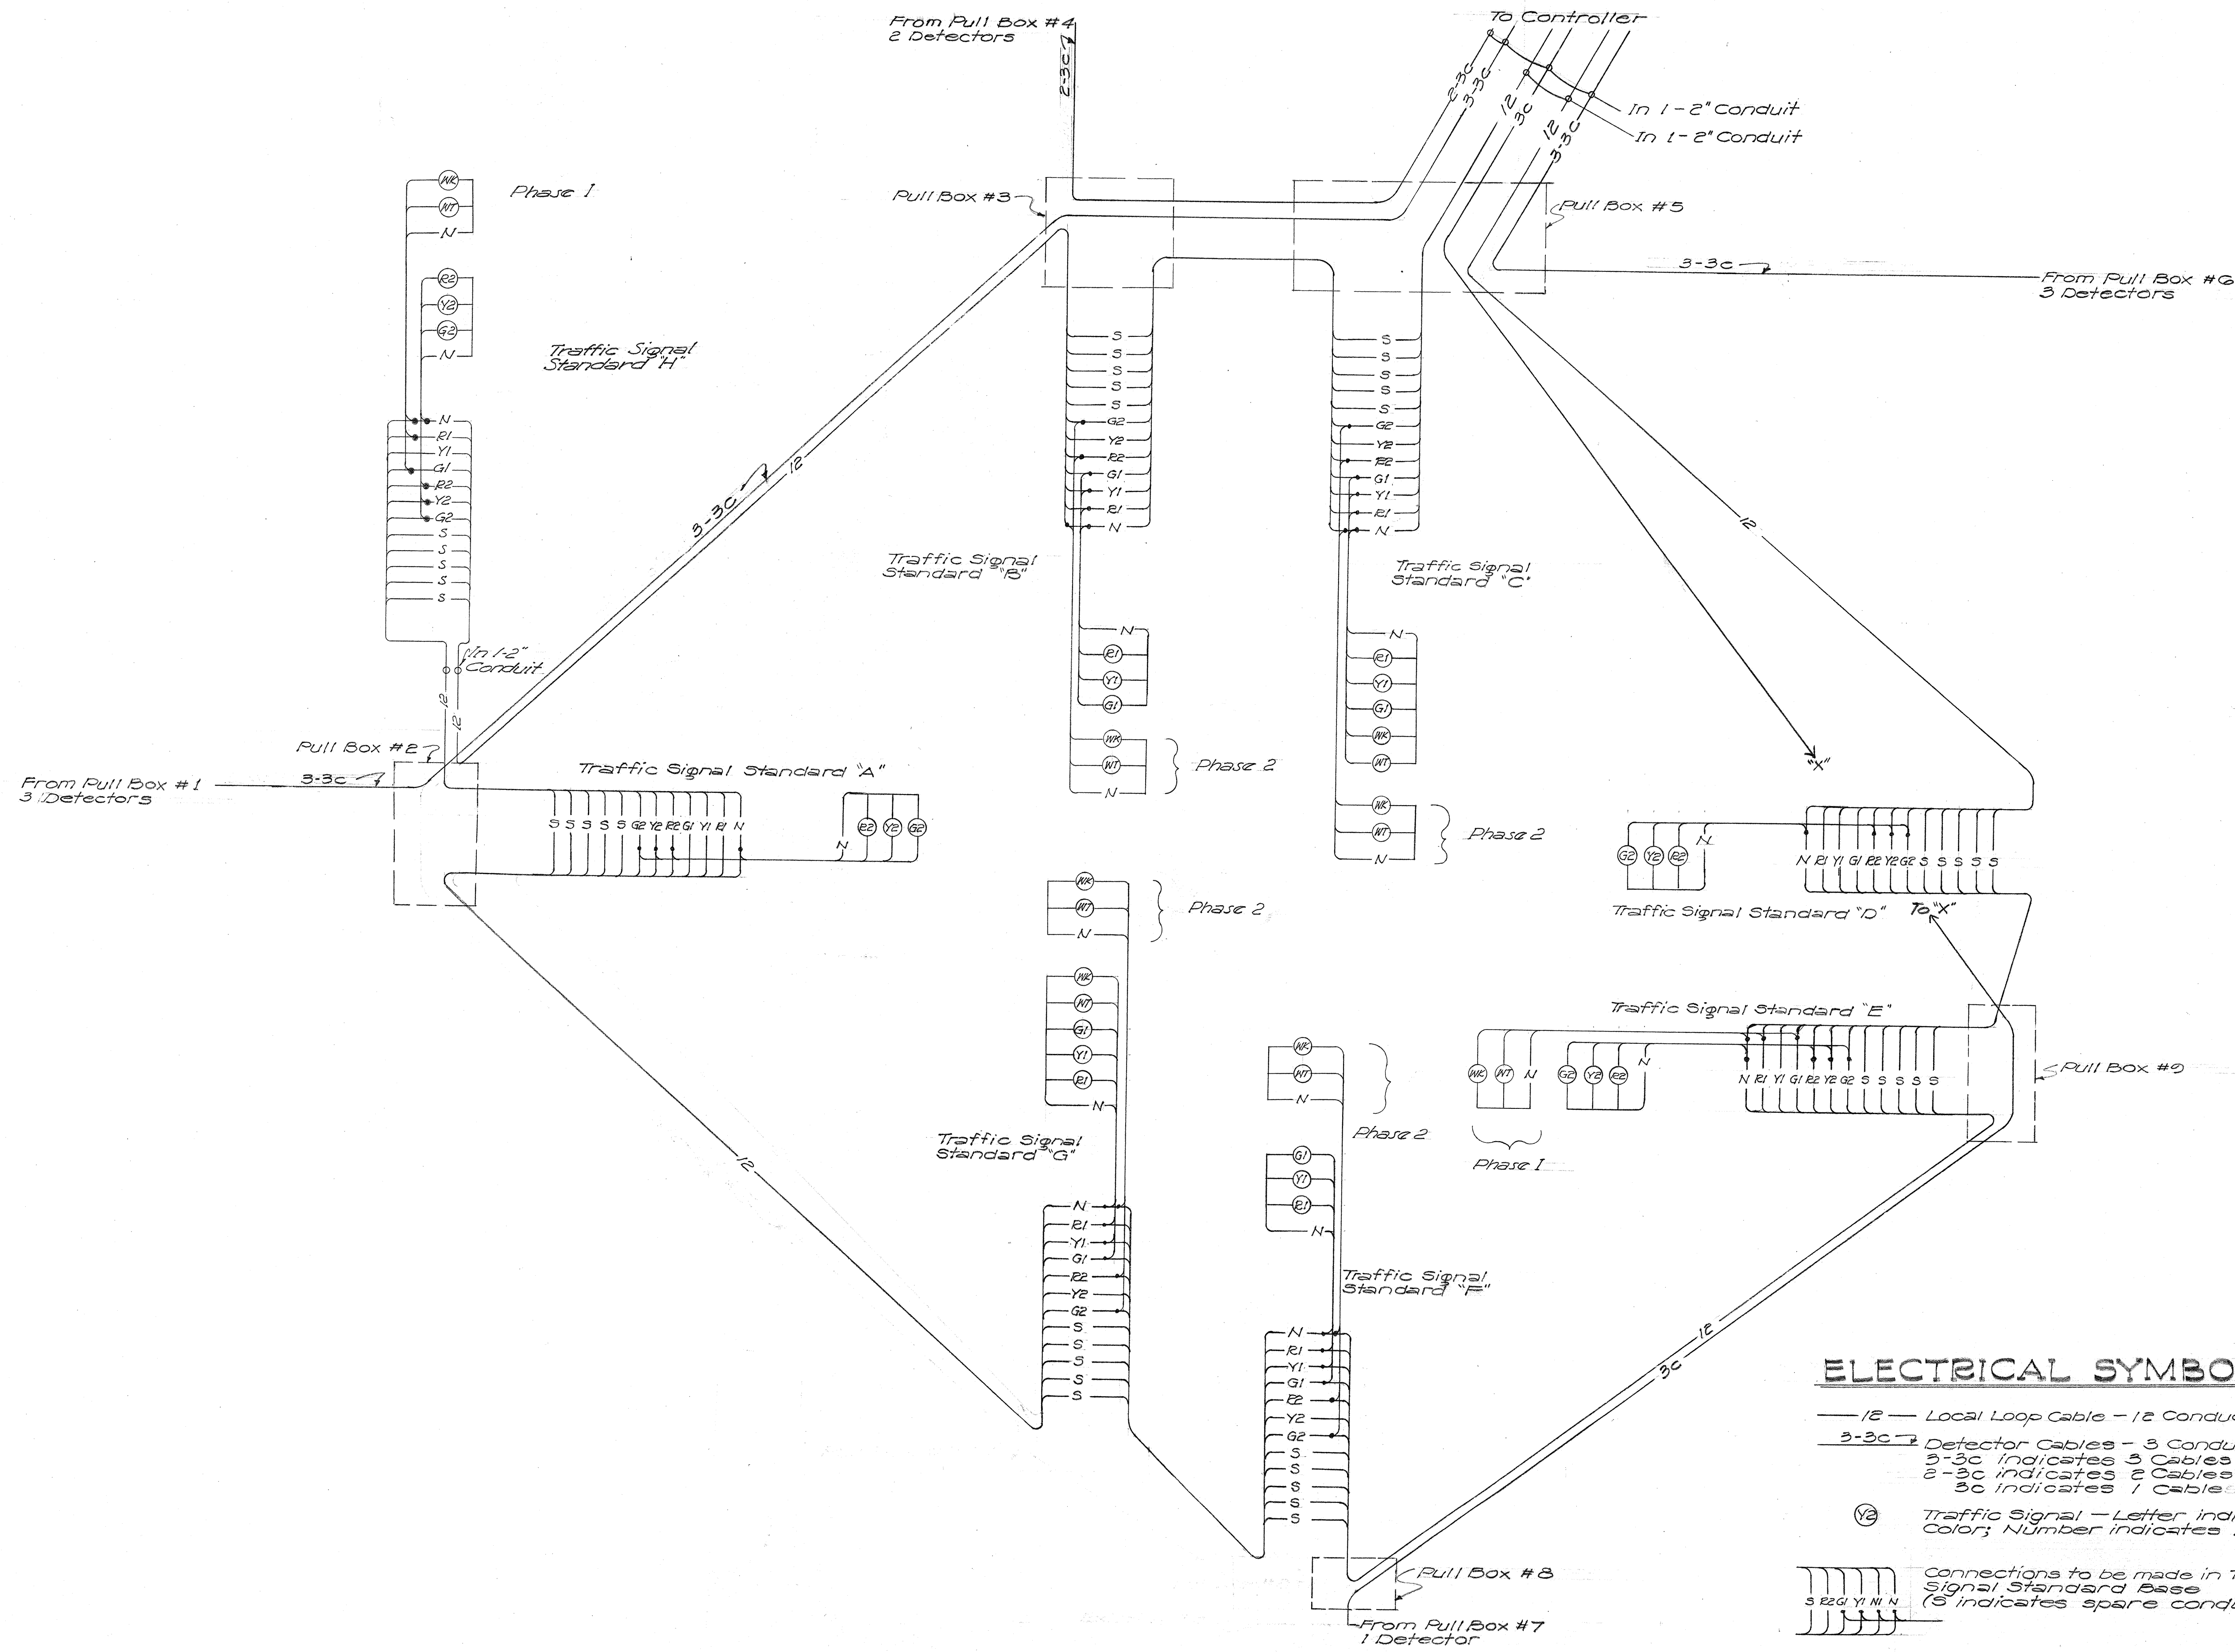

**NOTE**  
In addition to cables shown, a #8 AWG ground conductor shall be run from the Controller around the loop to each Traffic Signal Standard

### ELECTRICAL SYMBOLS

- 12 — Local Loop Cable — 12 Conductor
- 3-3c — Detector Cables — 3 Conductor  
3-3c indicates 3 Cables  
2-3c indicates 2 Cables  
3c indicates 1 Cable
- Y2 — Traffic Signal — Letter indicates Color; Number indicates Phase.
- Connections to be made in Traffic Signal Standard Base (S indicates spare conductor)

## TRAFFIC SIGNAL WIRING DIAGRAM PHASING FOR THIS CONTRACT

No Scale

TERRITORIAL HIGHWAY DEPARTMENT  
TERRITORY OF HAWAII

**TRAFFIC SIGNAL SYSTEM**  
INTERSECTION of KALAHEO AVE.  
MOKAPU ROAD EXTENSION  
PROJECT NO. S-0630(6)  
Scale: As Noted

May 1958

SHEET No. 2 OF 2 SHEETS

5946.16

|                       |      |
|-----------------------|------|
| SURVEY PLOTTED BY     | DATE |
| DRAWN BY              |      |
| TRACED BY             |      |
| QUANTITIES CHECKED BY |      |
| NOTE BOOK             |      |
| No.                   |      |