

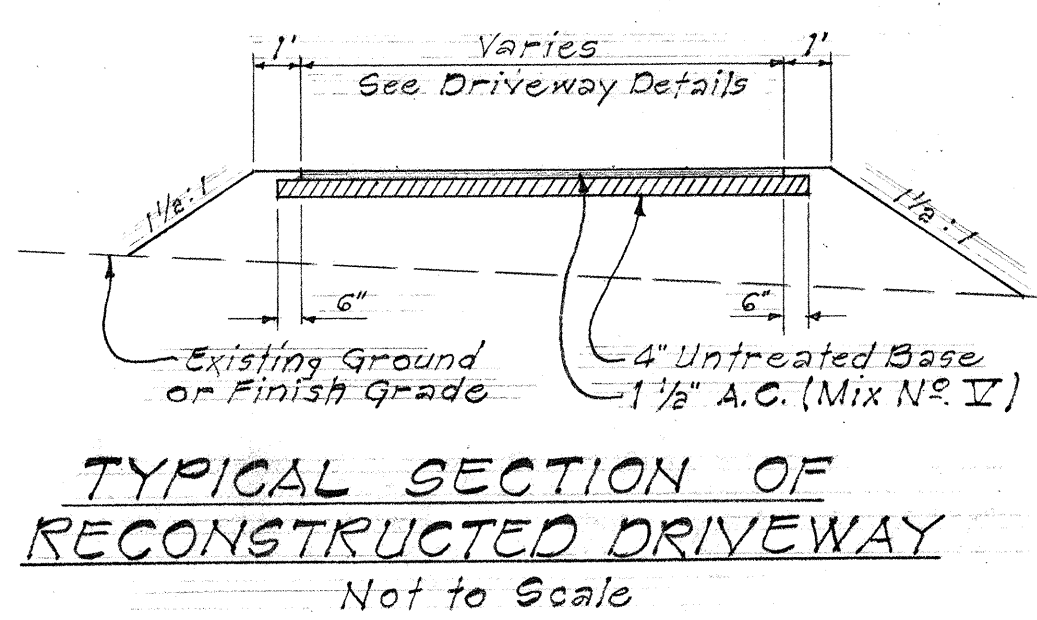
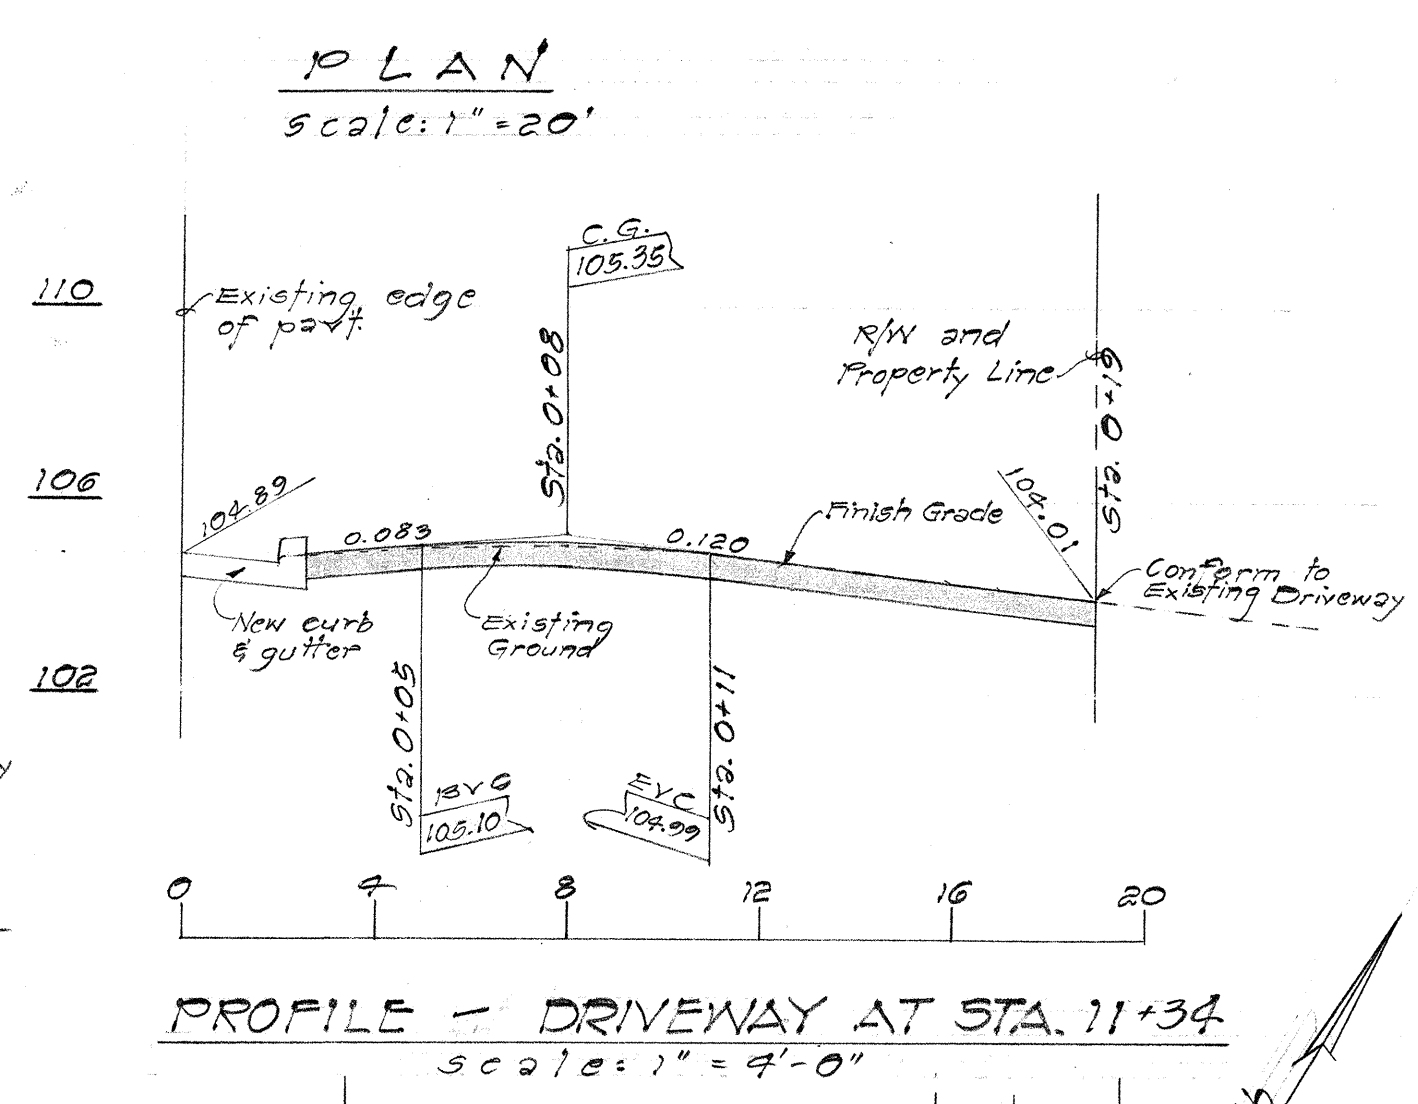
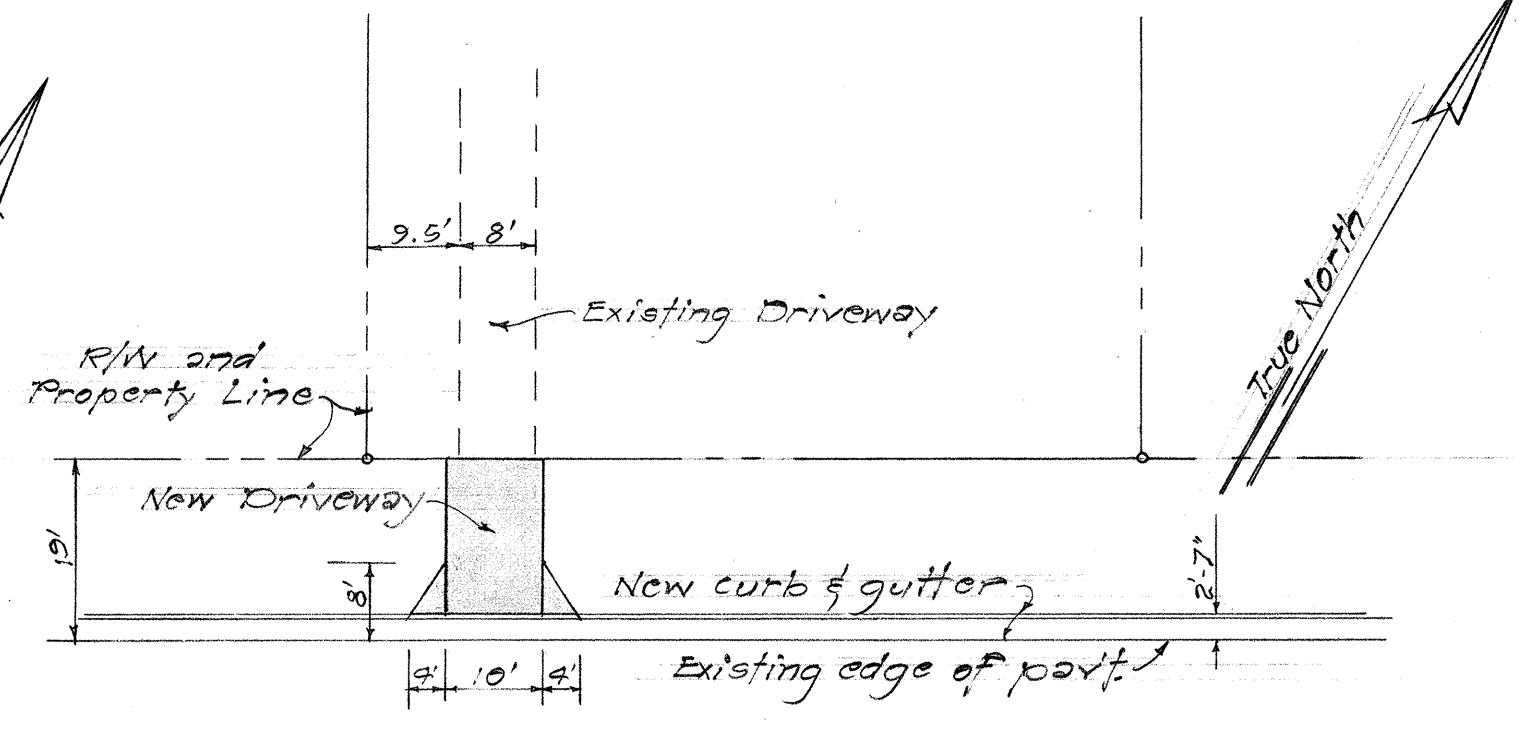
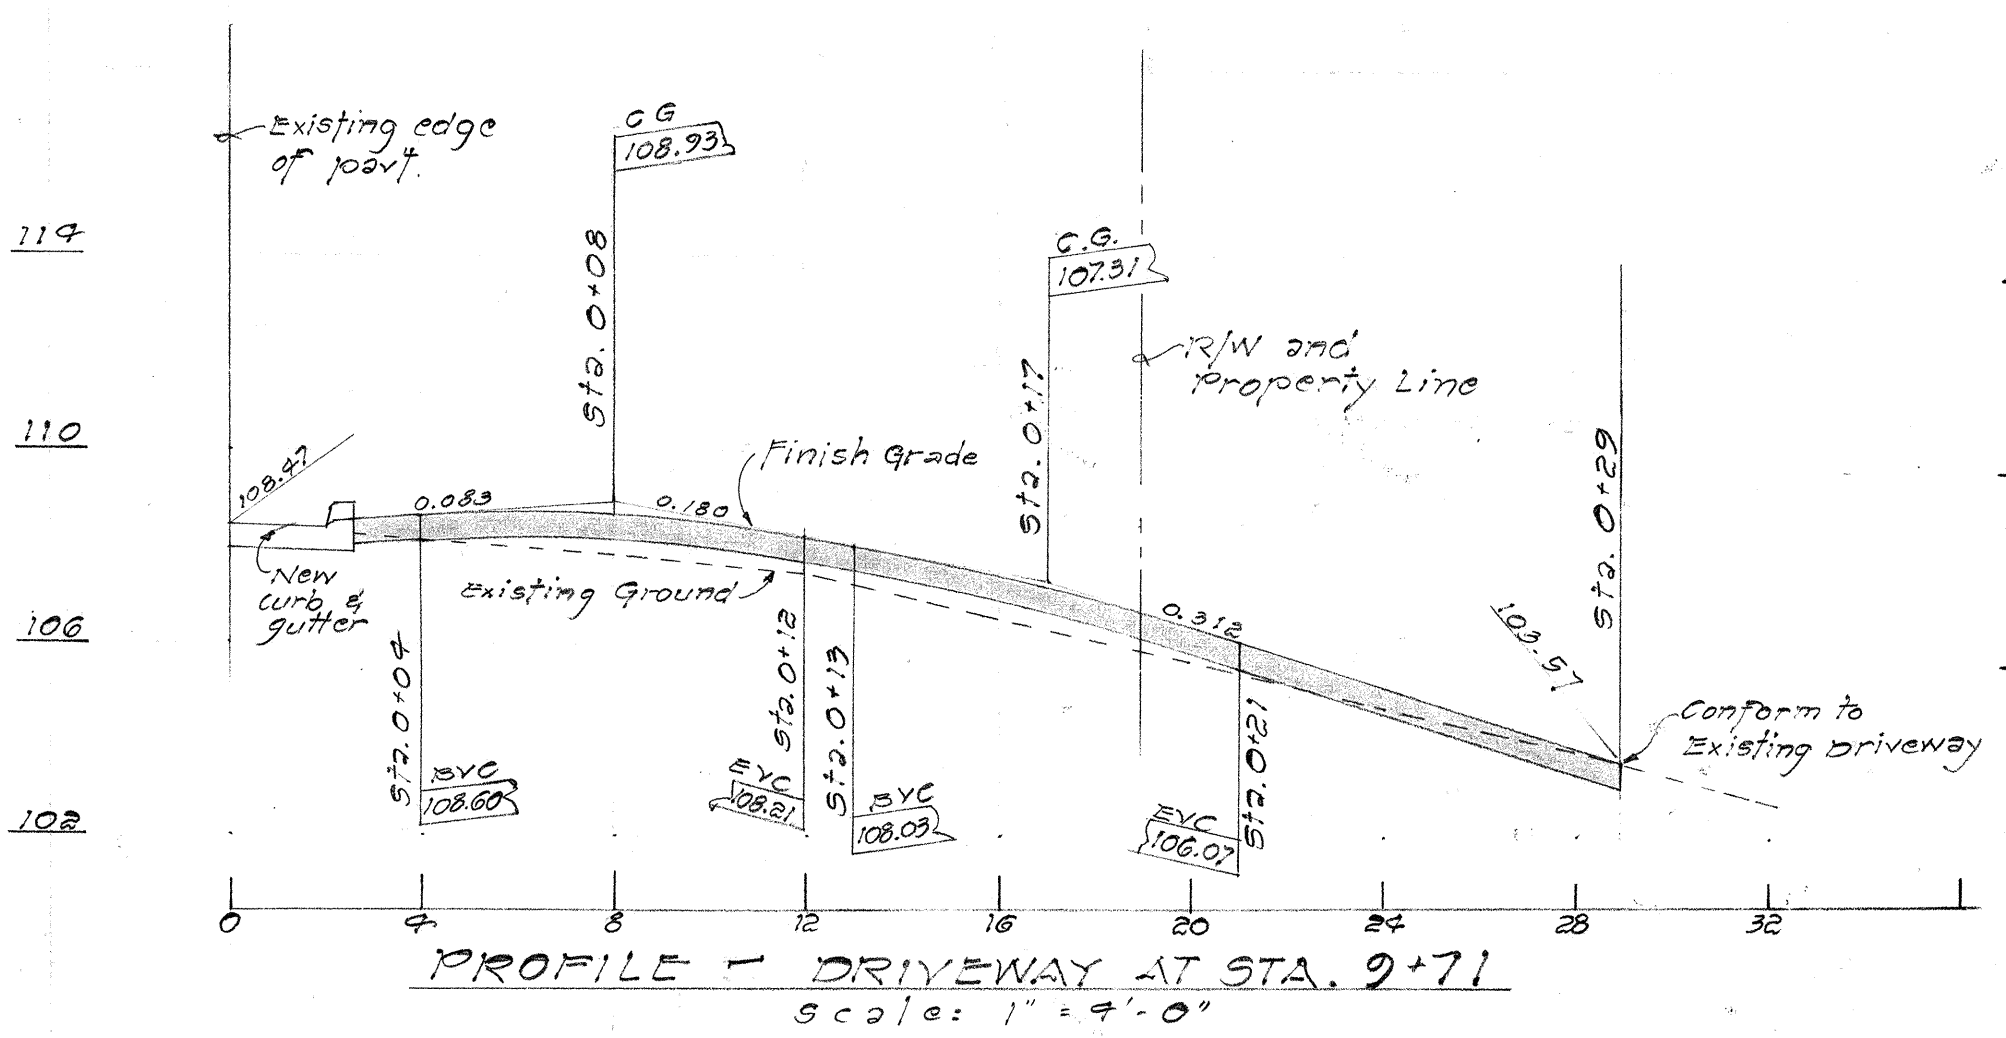
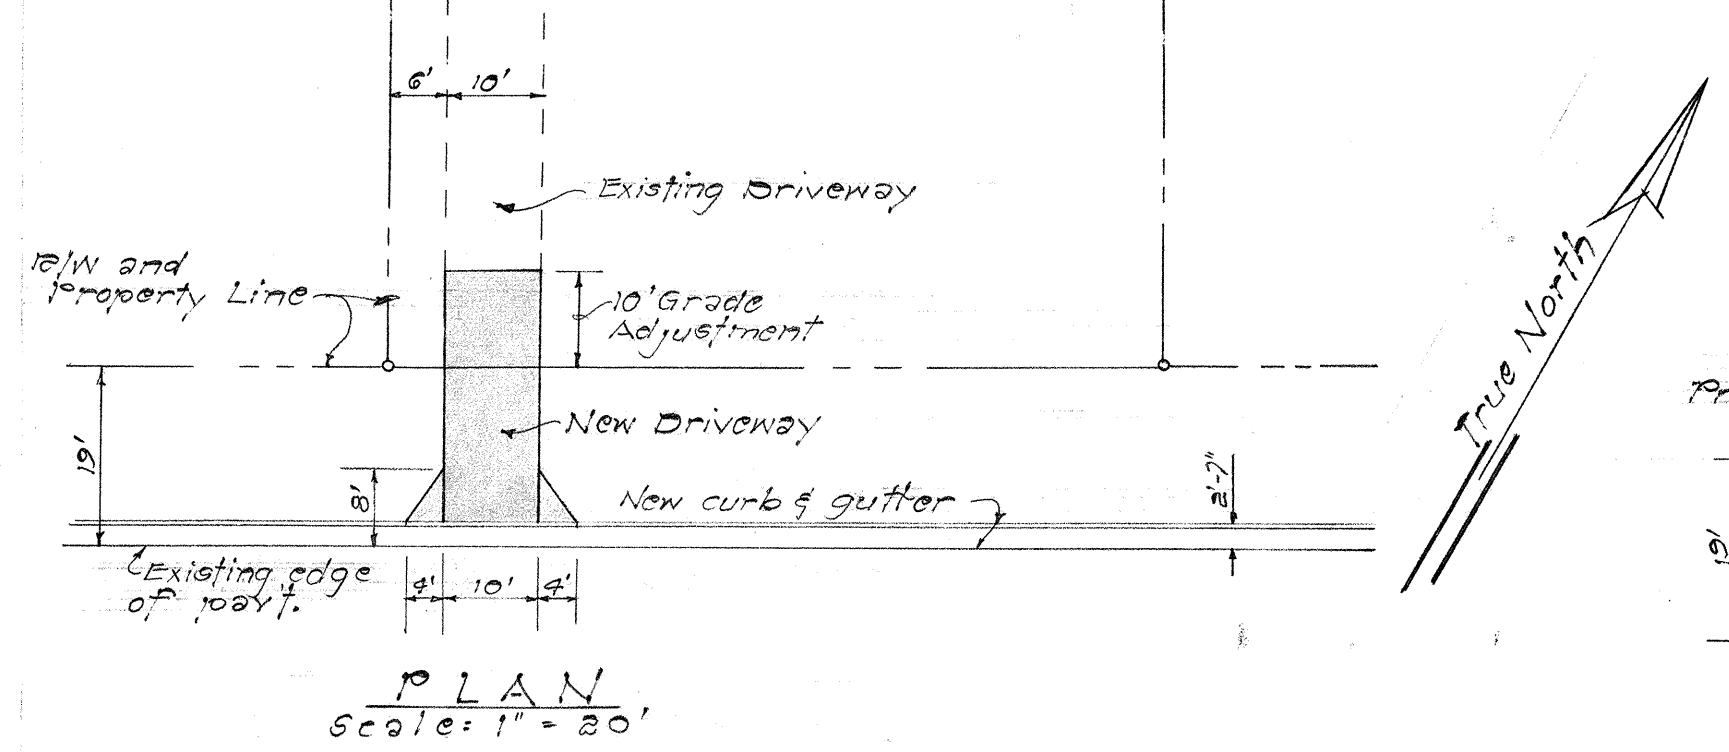
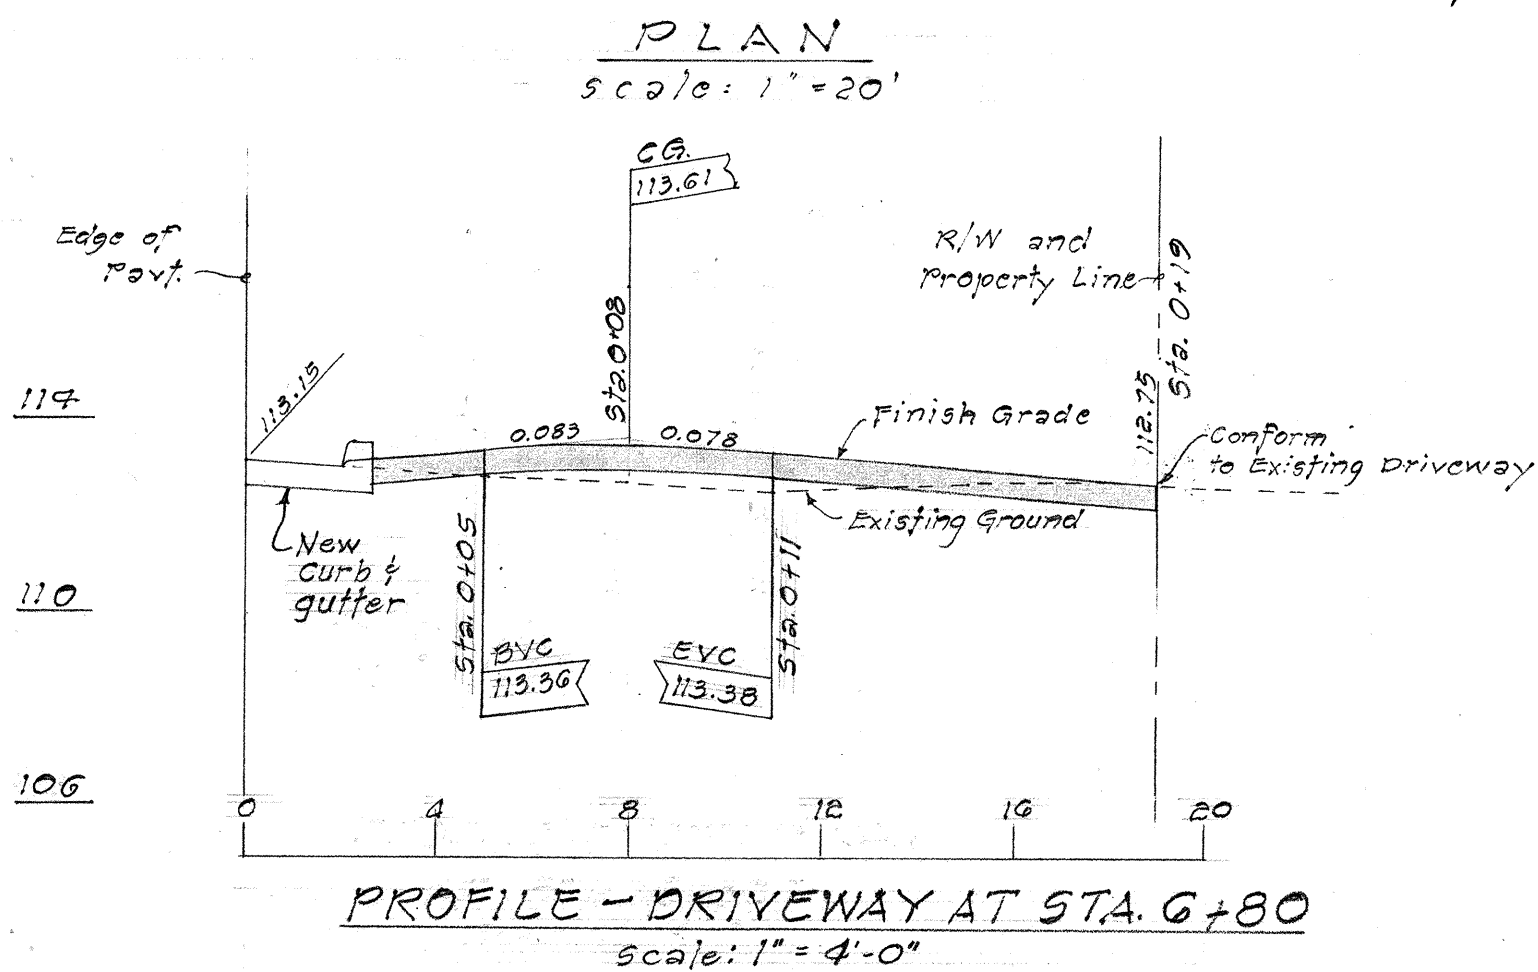
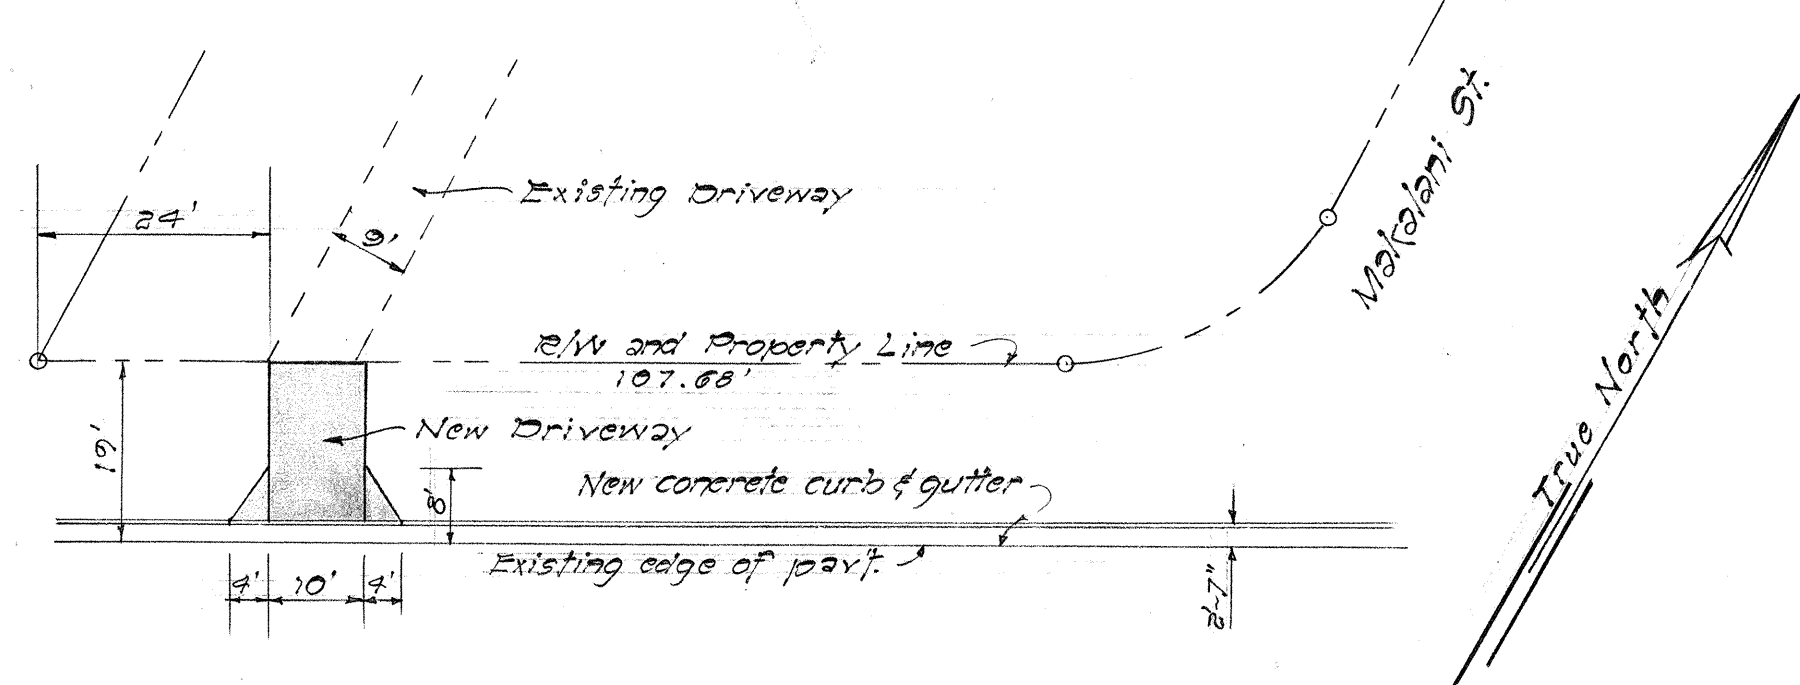
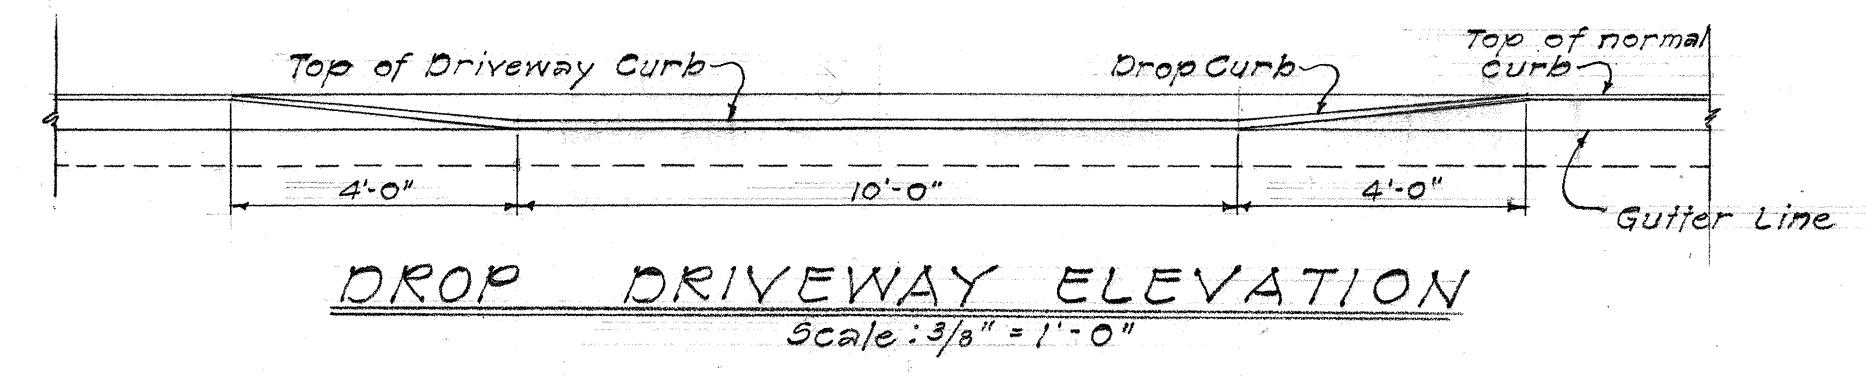
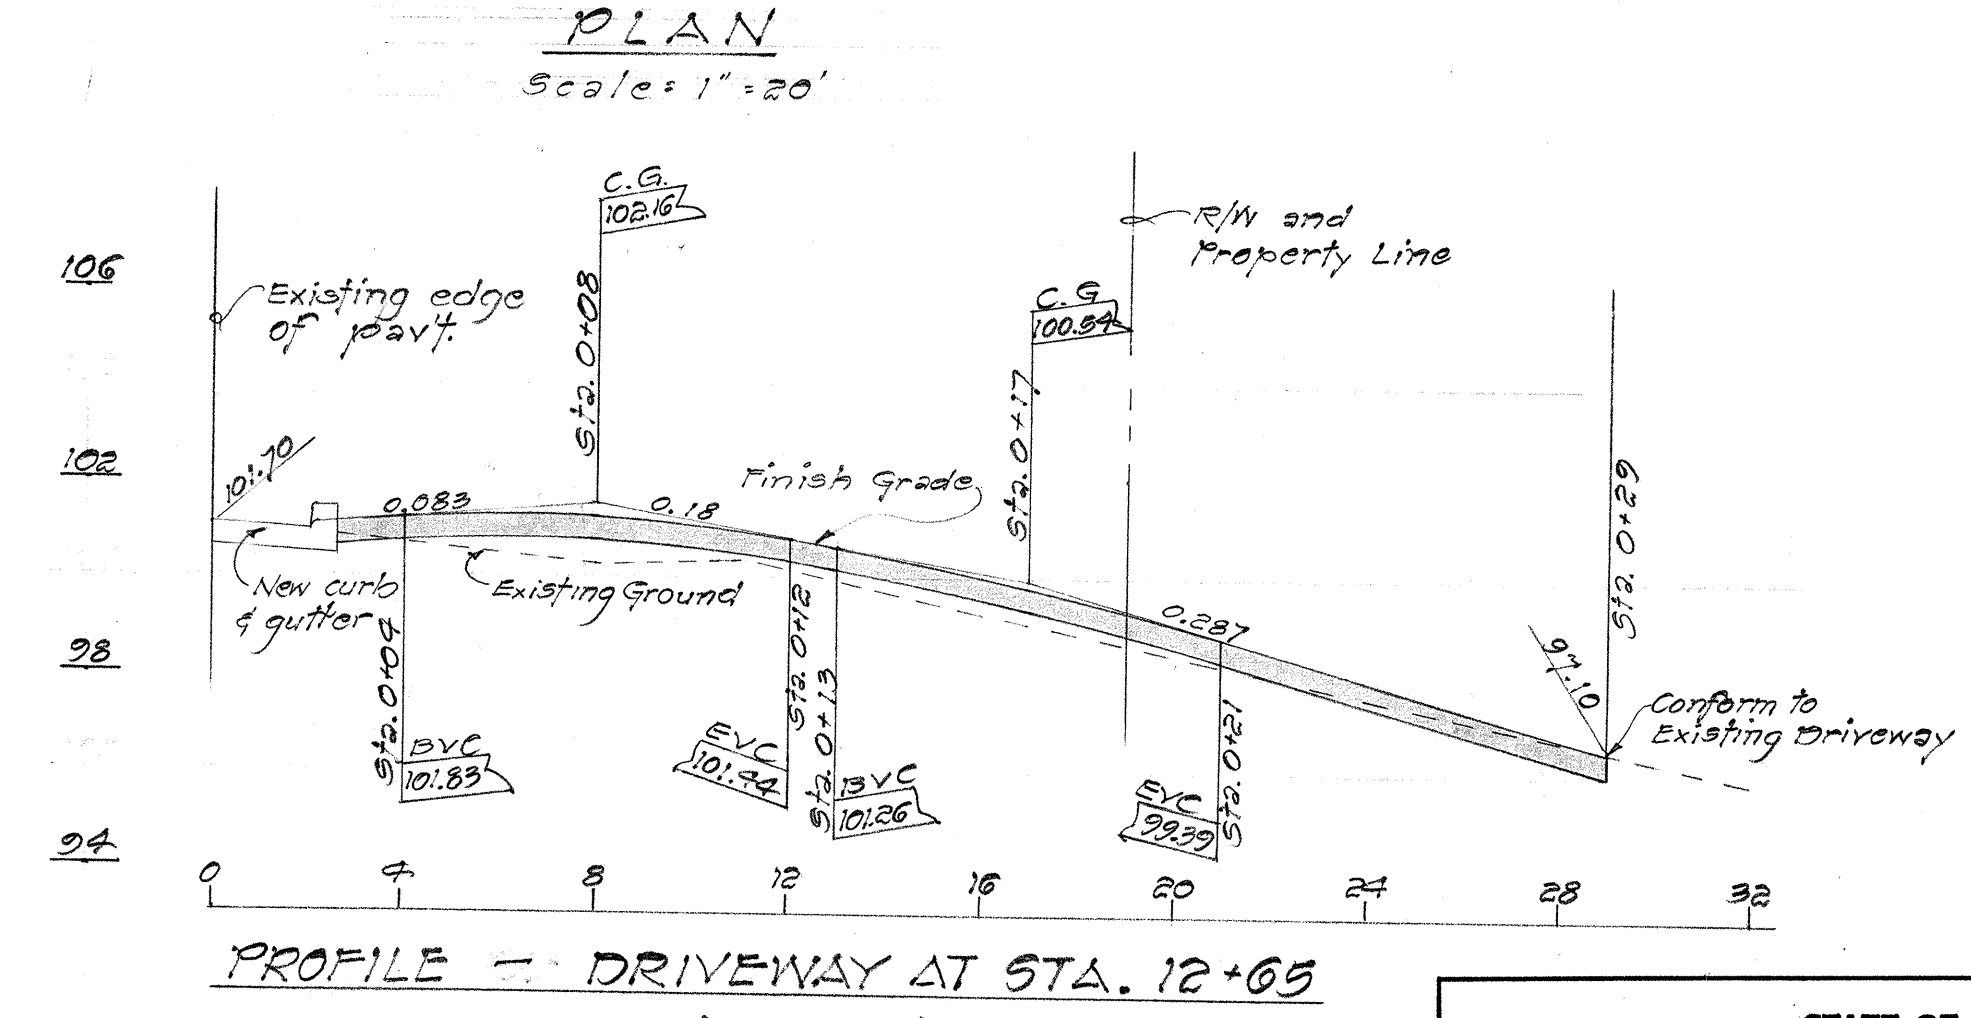
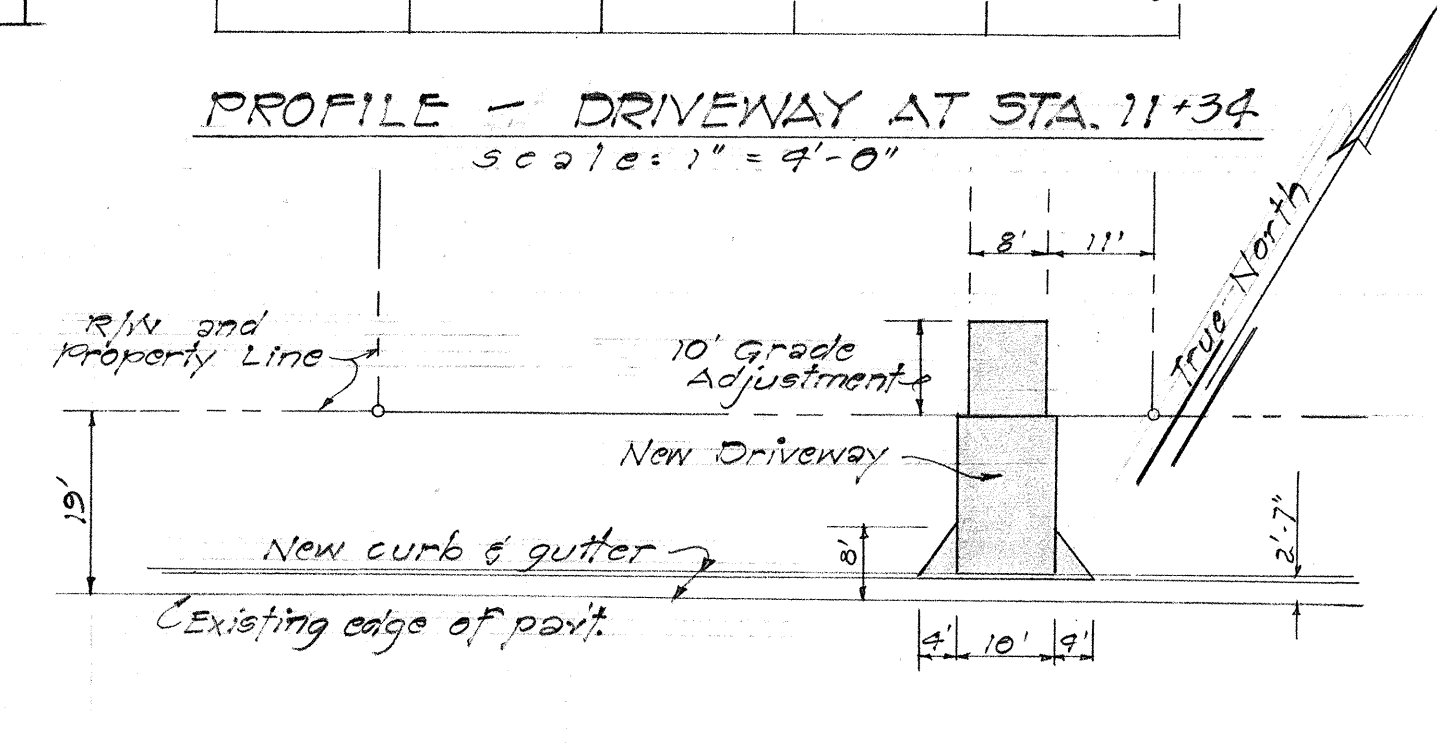
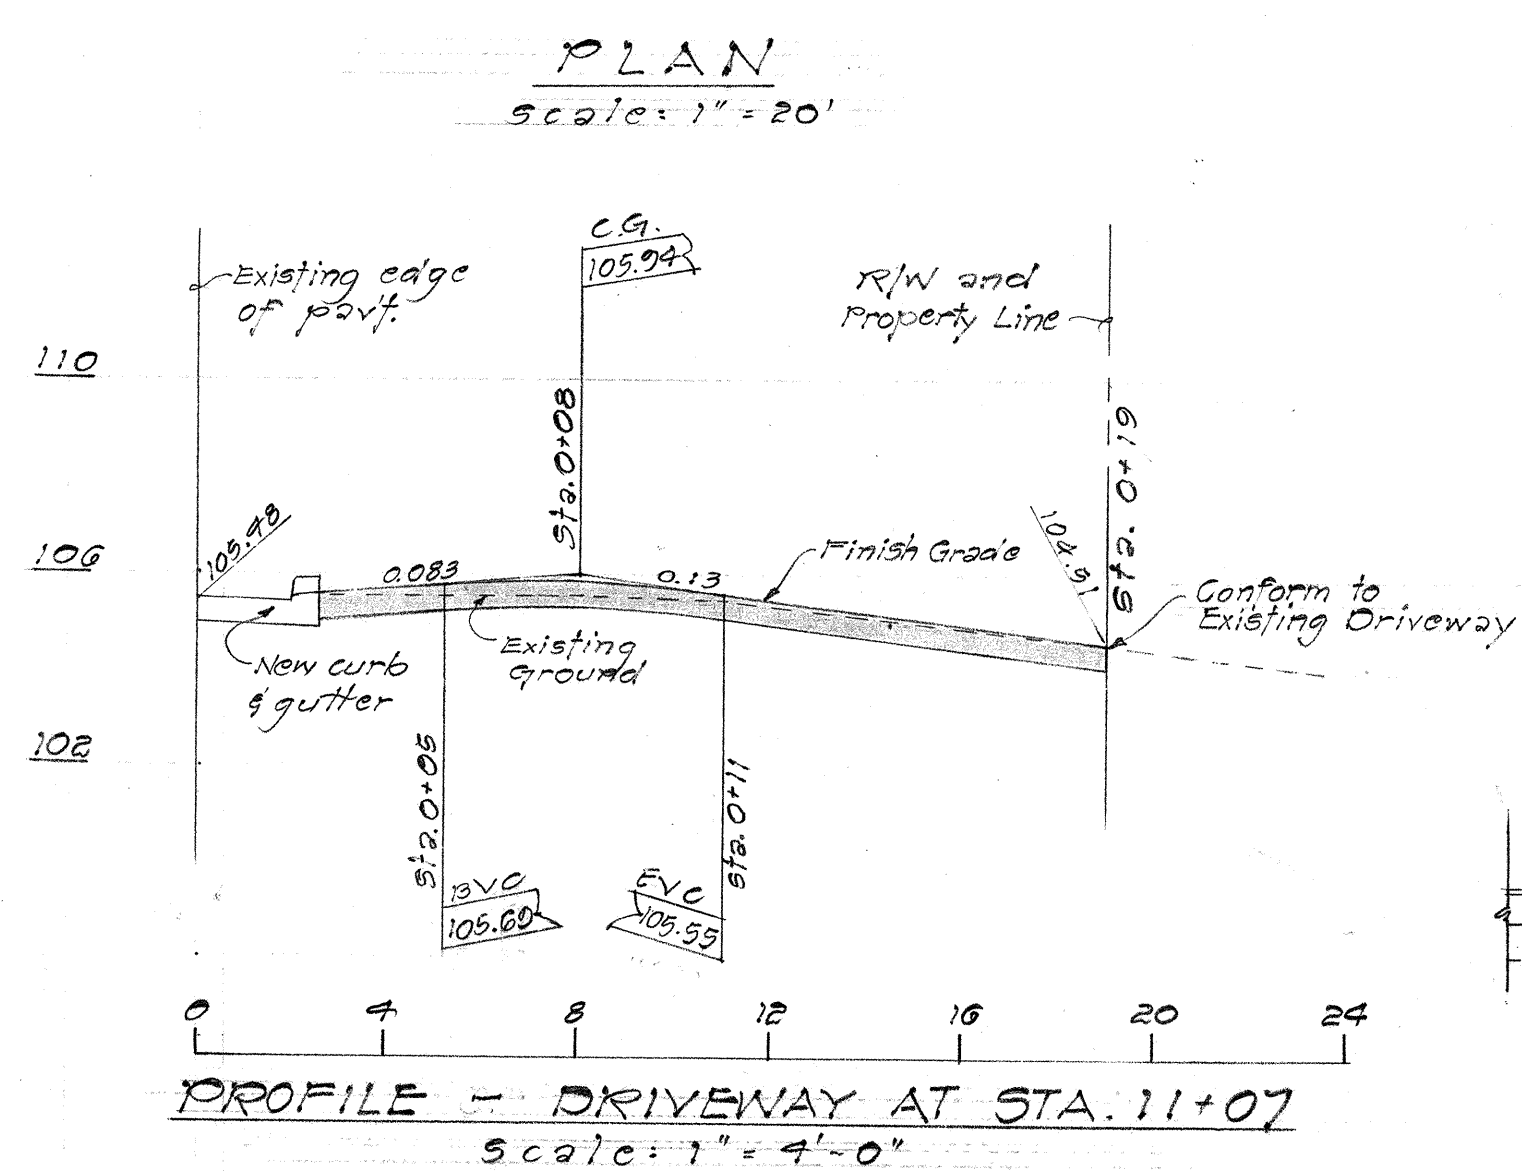
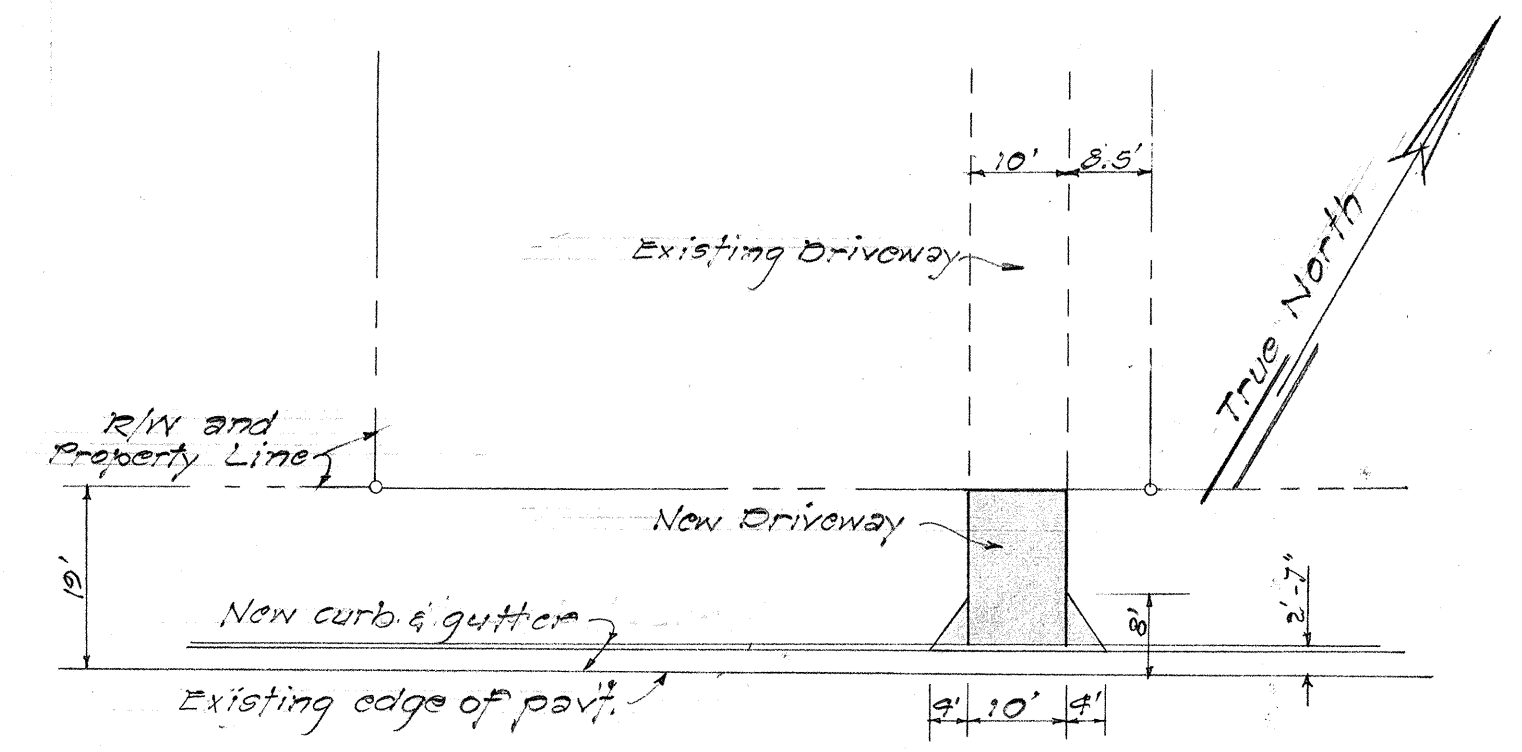


FED. ROAD DIST. NO.	STATE	FED. AID PROJ. NO.	FISCAL YEAR	SHEET NO.	TOTAL SHEETS
HAWAII	HAW.				

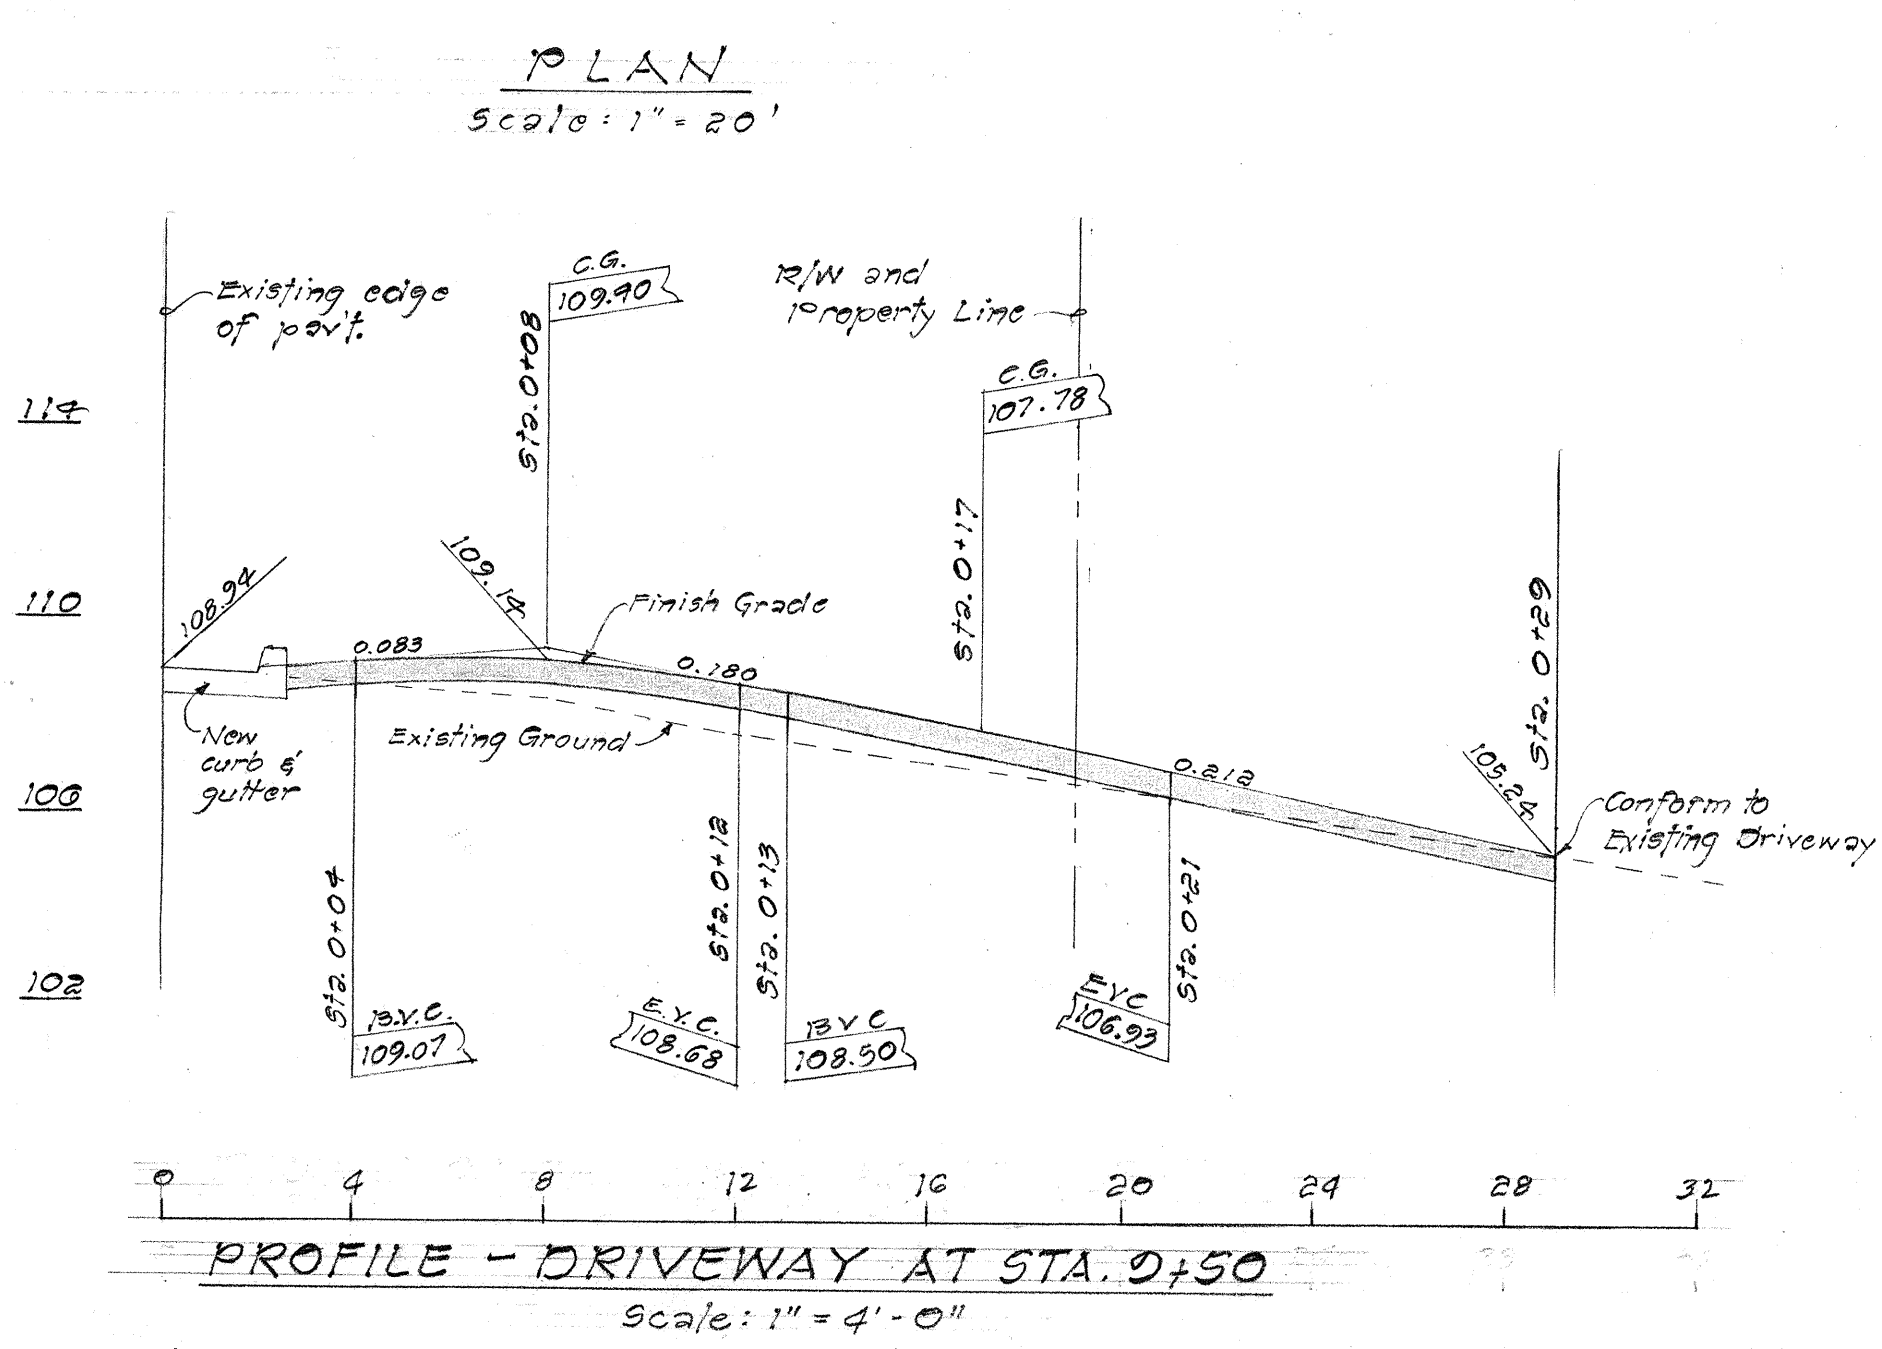

NOTE:
Driveway slopes are in feet / feet.

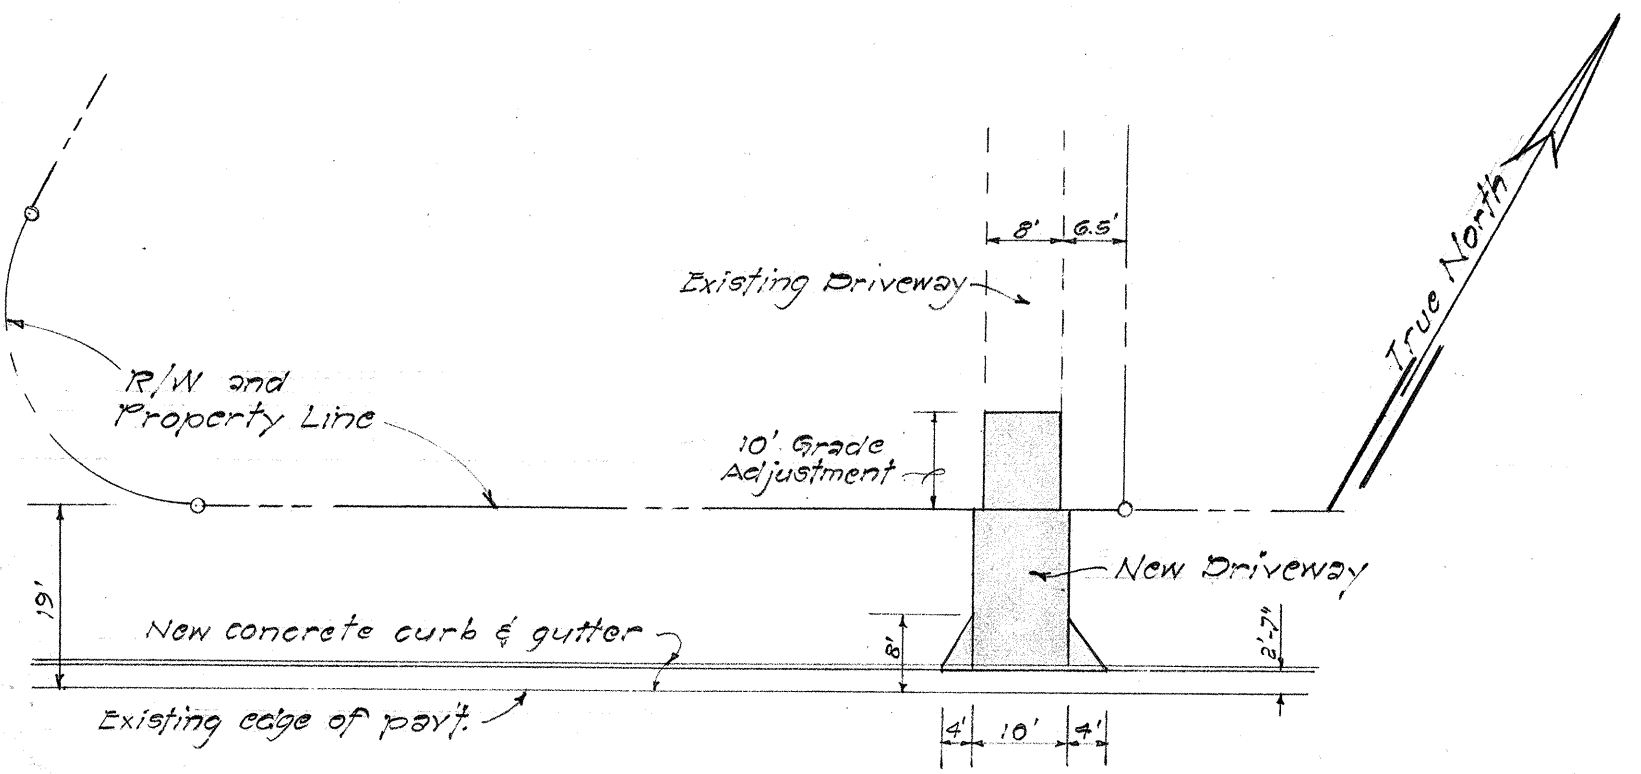

STATE OF HAWAII
DEPARTMENT OF TRANSPORTATION
HIGHWAYS DIVISION

MISCELLANEOUS DRAINAGE
IMPROVEMENTS ON OAHU - UNIT III

KANELOE BAY DRIVE
Proj. No. A-620-01-66

DRIVEWAY DETAILS

Scale: As Noted Date: Aug. 1966

SHEET No. 3 OF 5 SHEETS

DRIVEWAY DETAILS

DATE	DESIGNED BY	CHECKED BY
PLAN	TRACED BY	QUANTITIES BY
NOTE BOOK		