
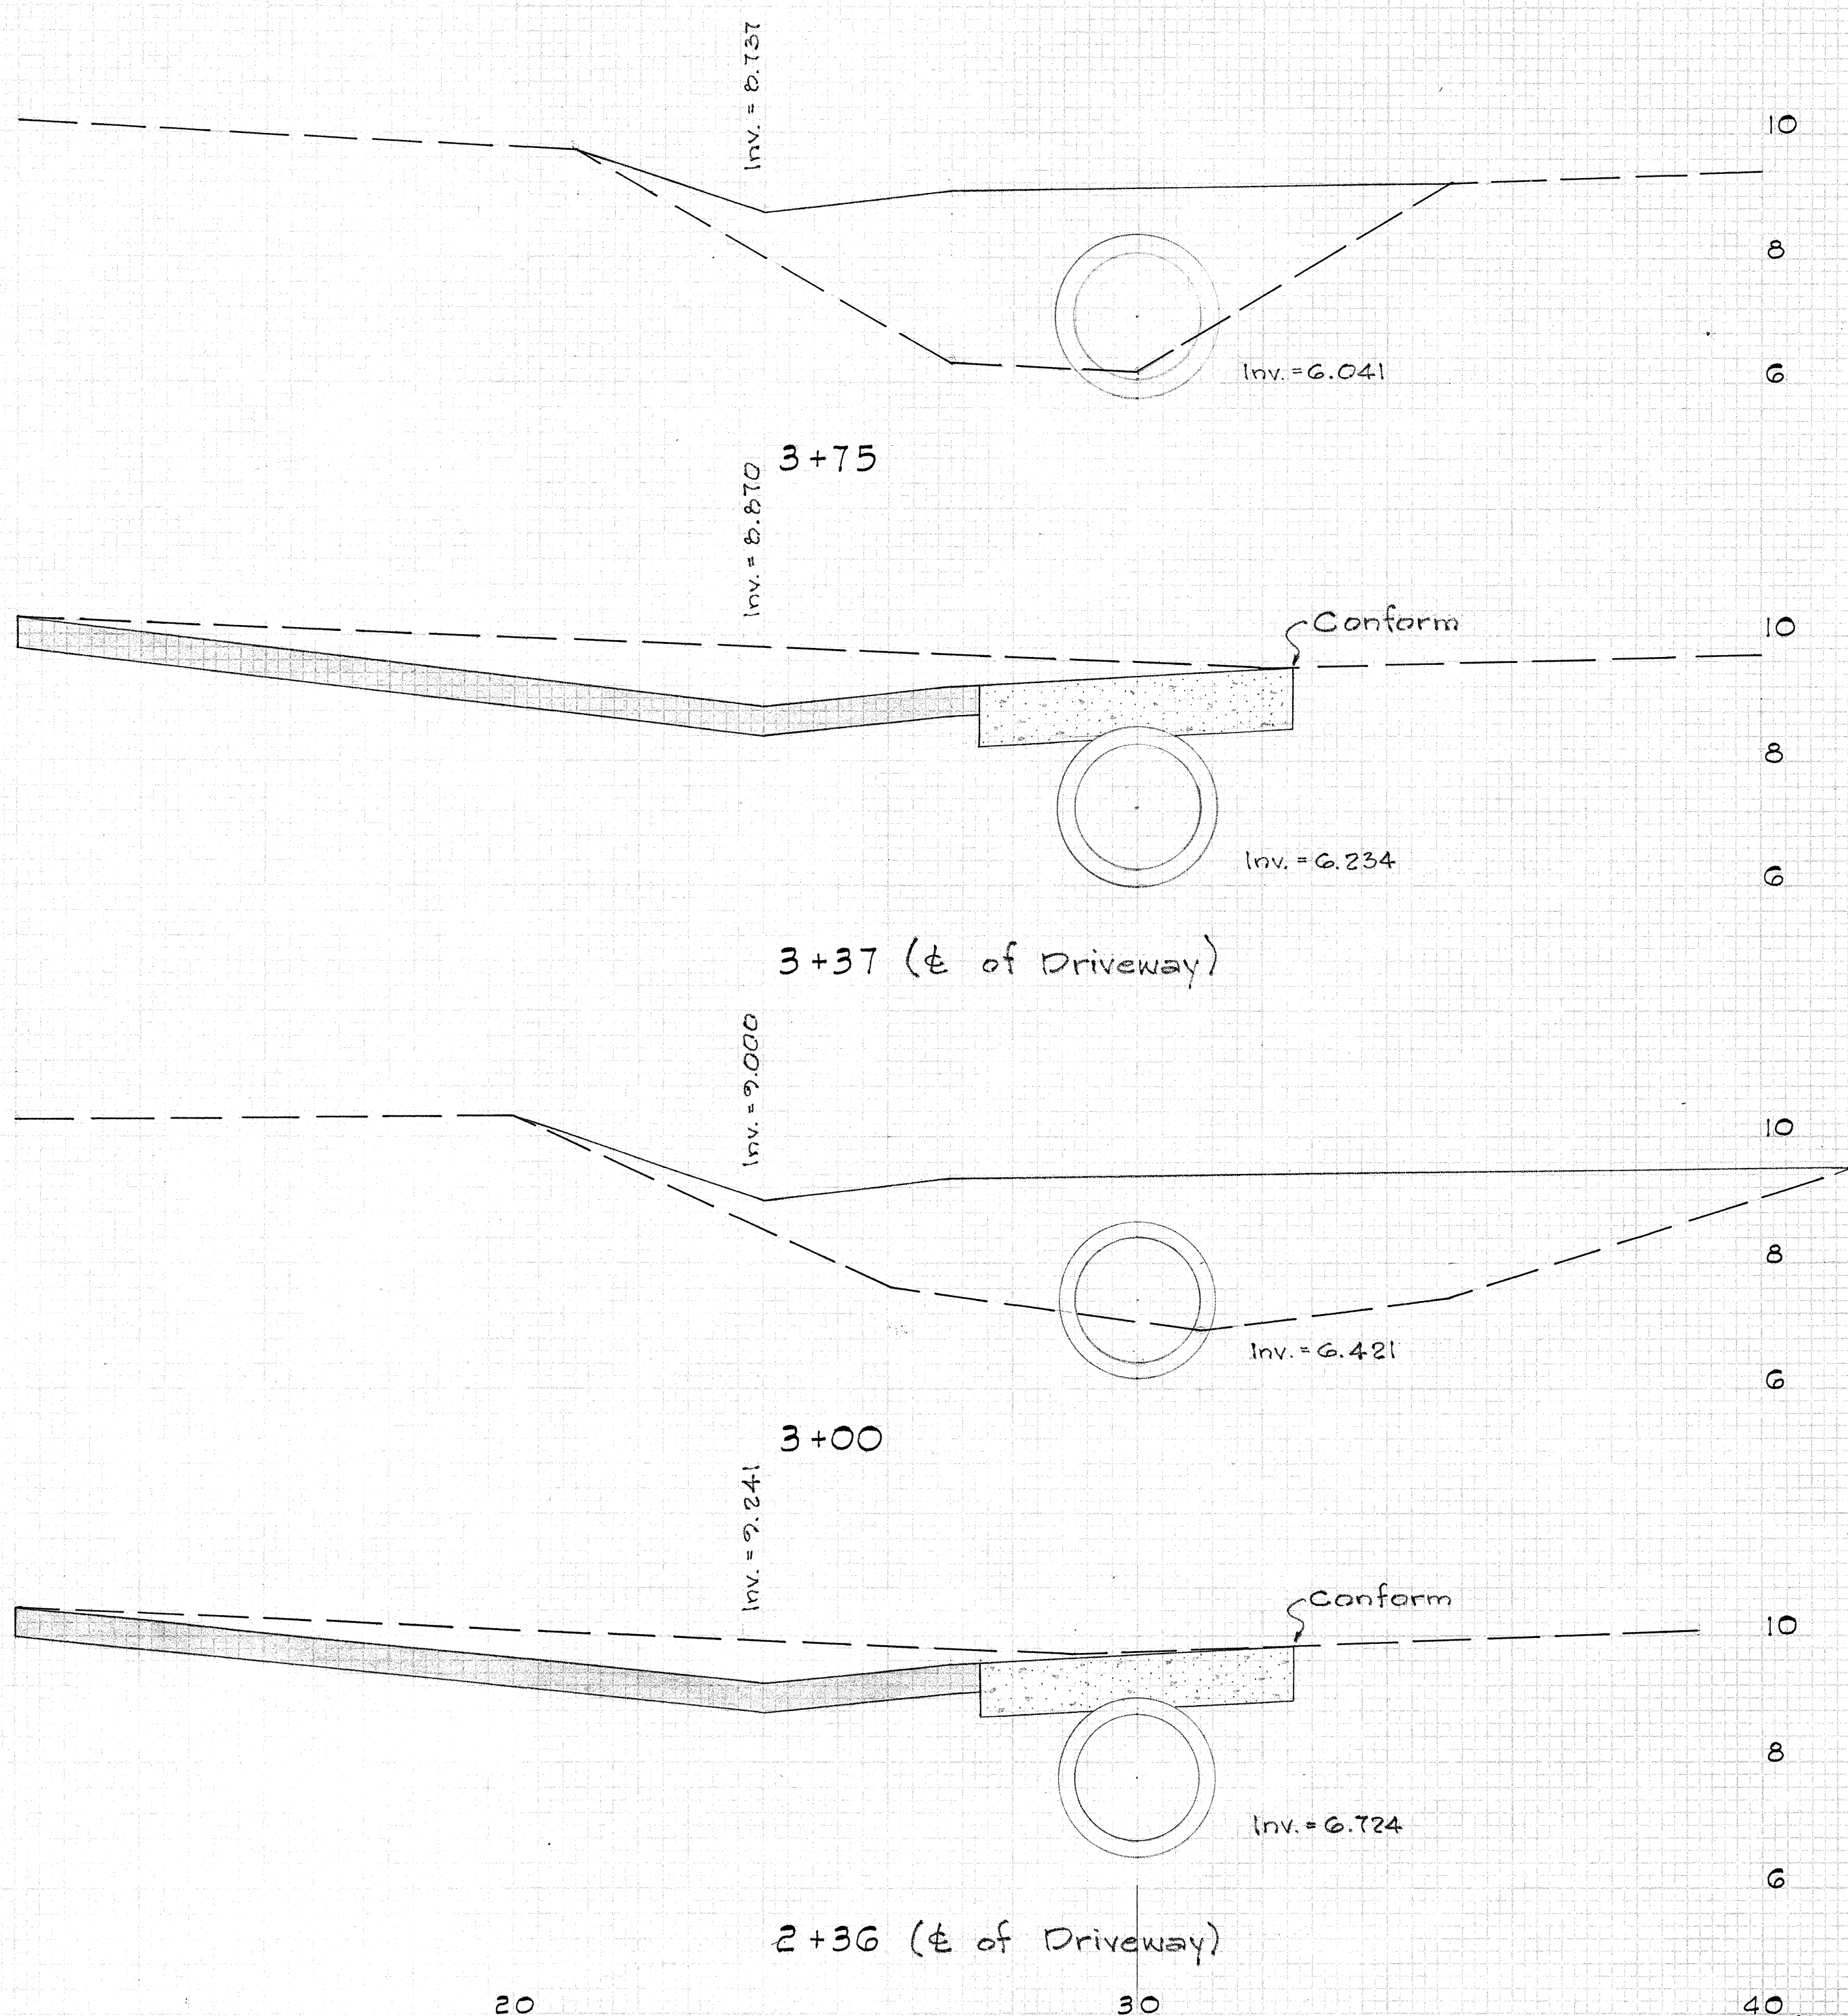


FED. ROAD DIST. NO.	STATE	FED. AID PROJ. NO.	FISCAL YEAR	SHEET NO.	TOTAL SHEETS
HAWAII	HAW.				

MISCELLANEOUS DRAINAGE
IMPROVEMENTS ON OAHU - UNIT IV
KALAHEO AVENUE
Proj. No. B-630-01-66
Sheet No. 3 of 3

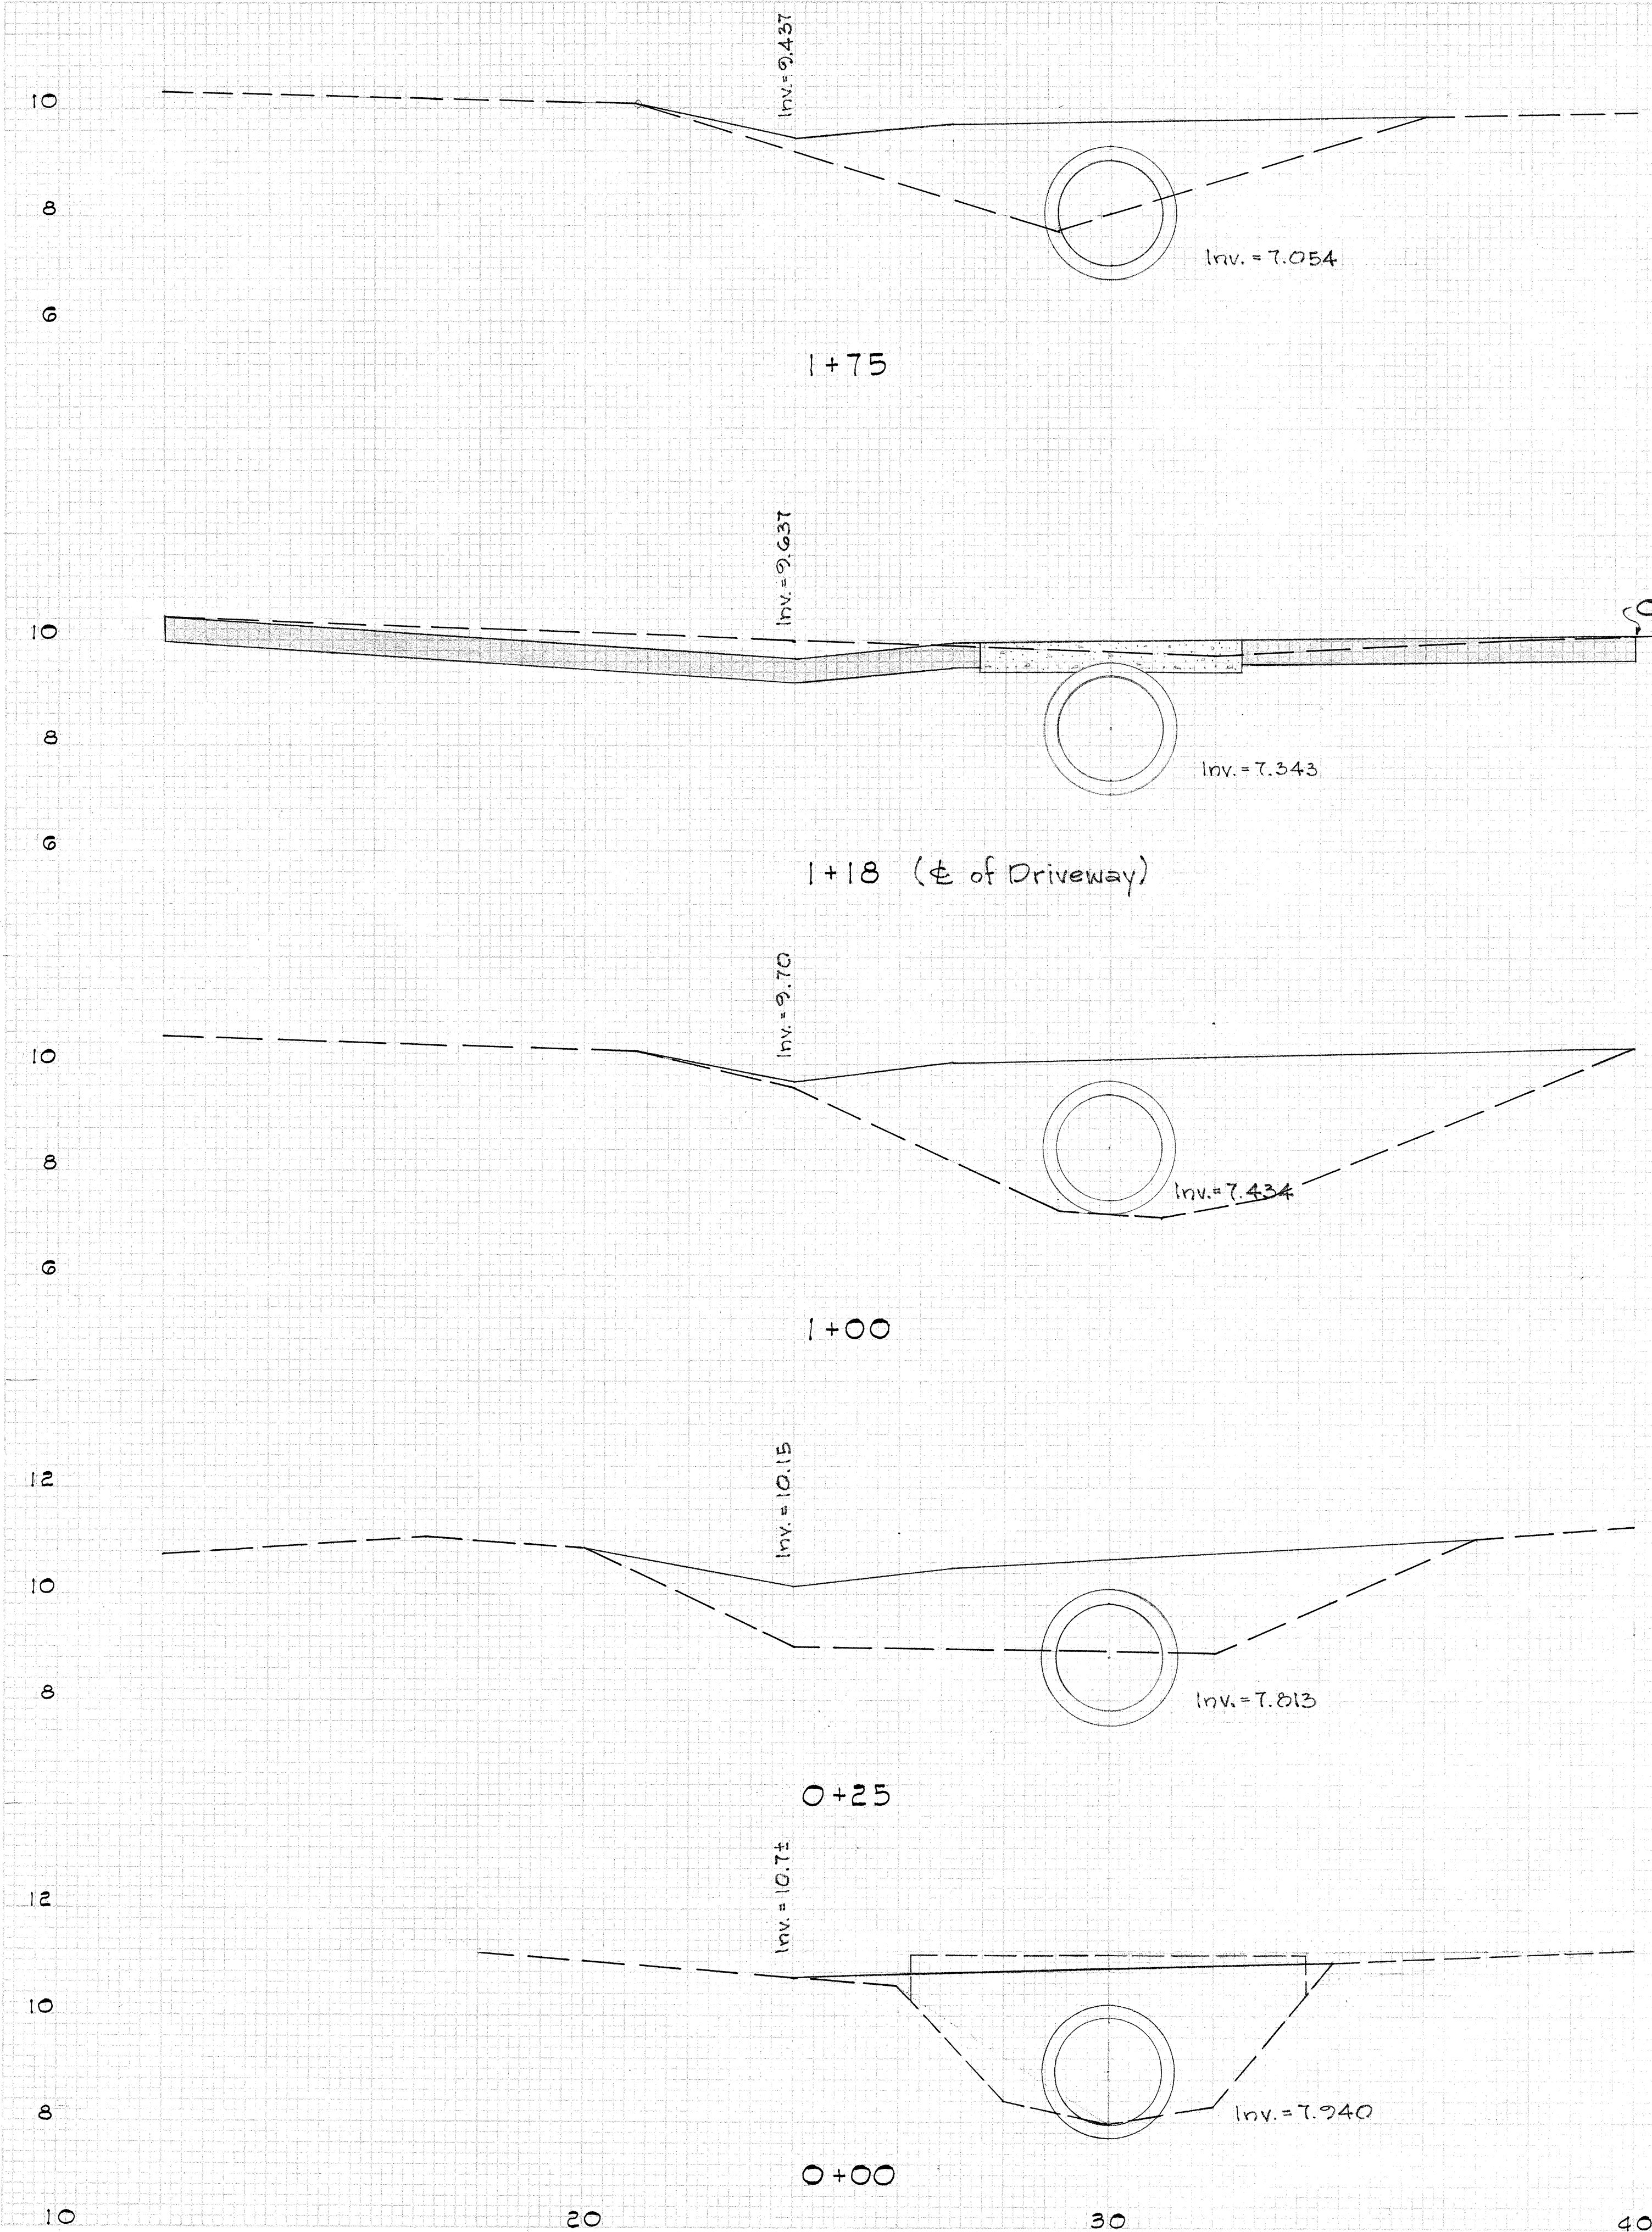

REVISIONS
DATE
BY
CHECKED
DATE
BY
NOTED
DATE
BY

REVISIONS
DATE
BY
CHECKED
DATE
BY
NOTED
DATE
BY