
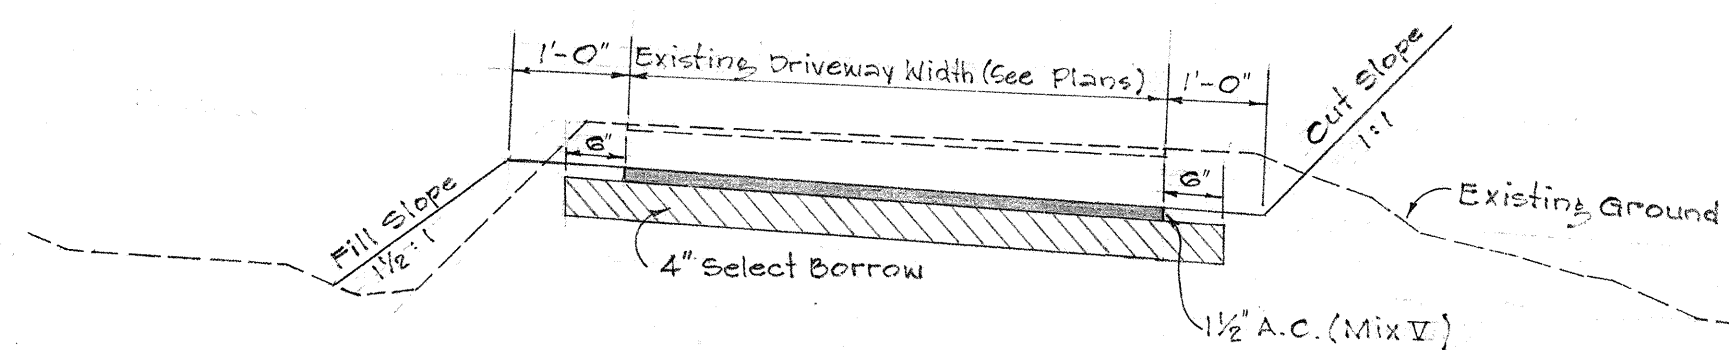
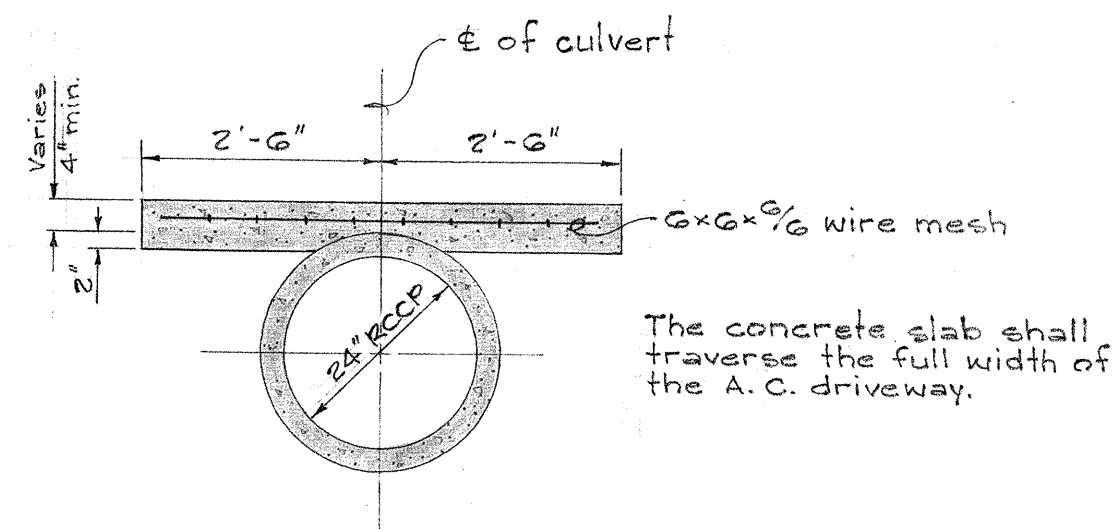
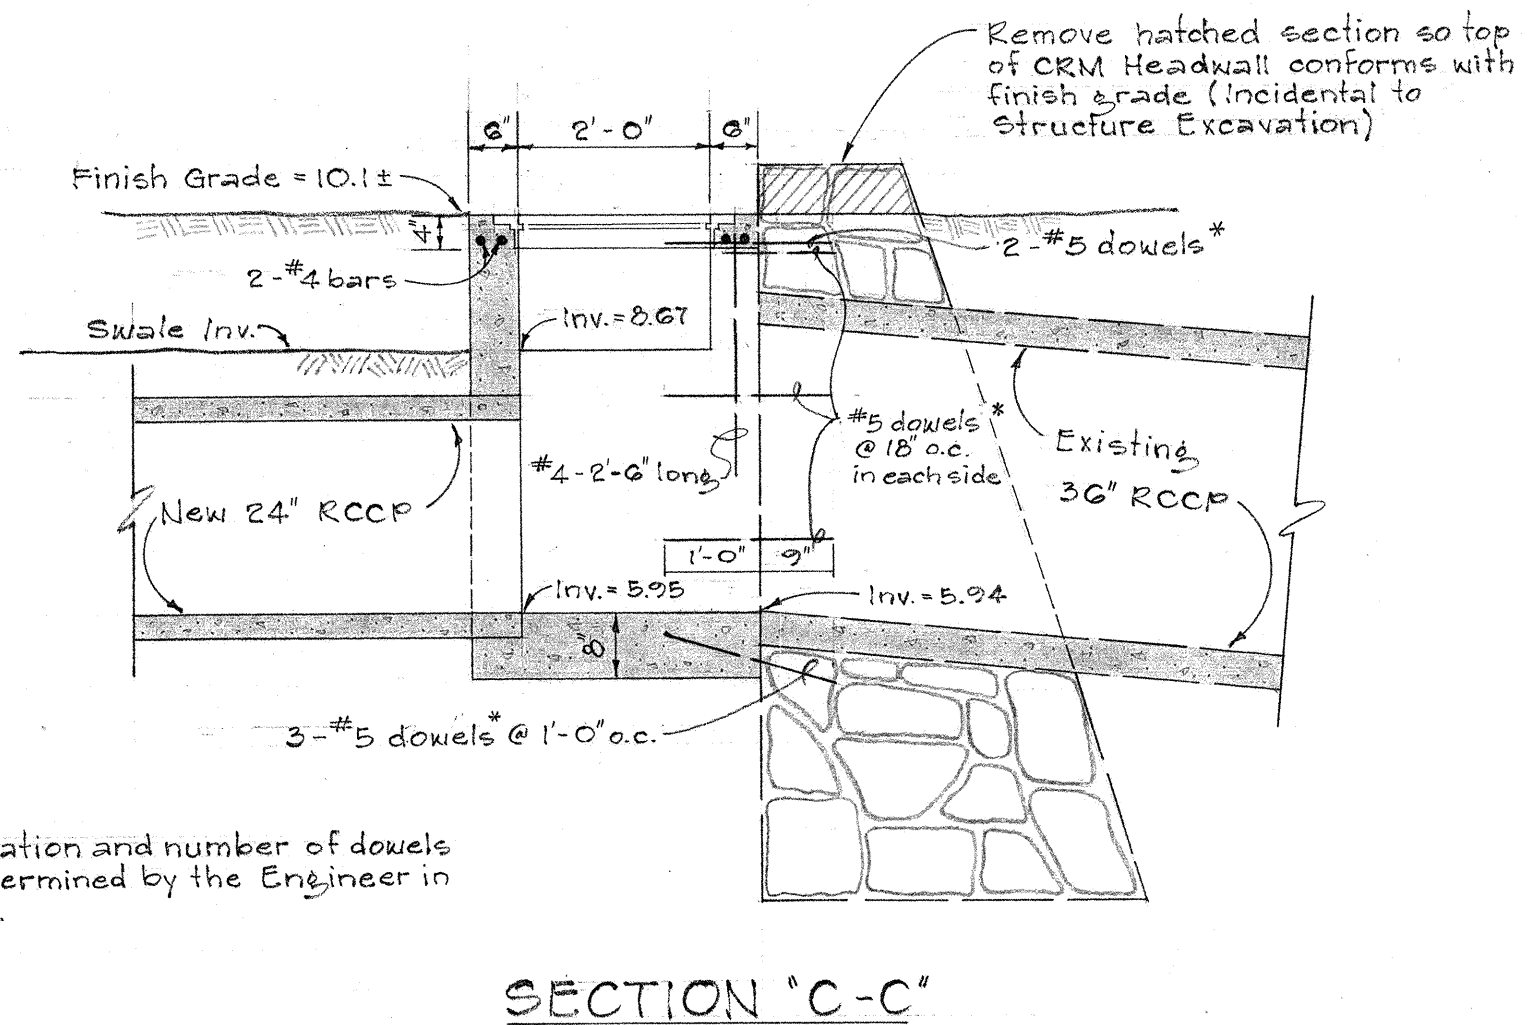
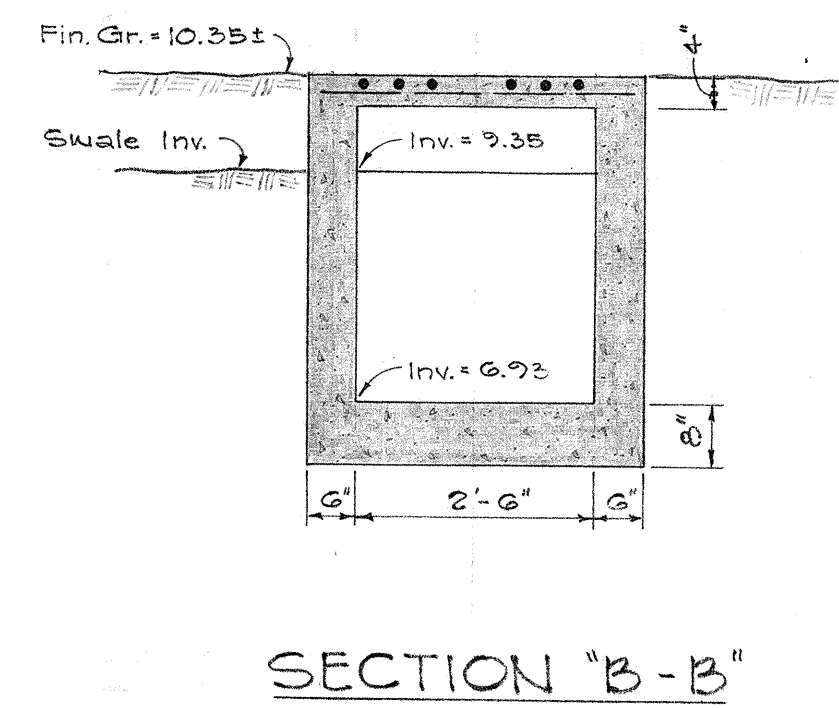
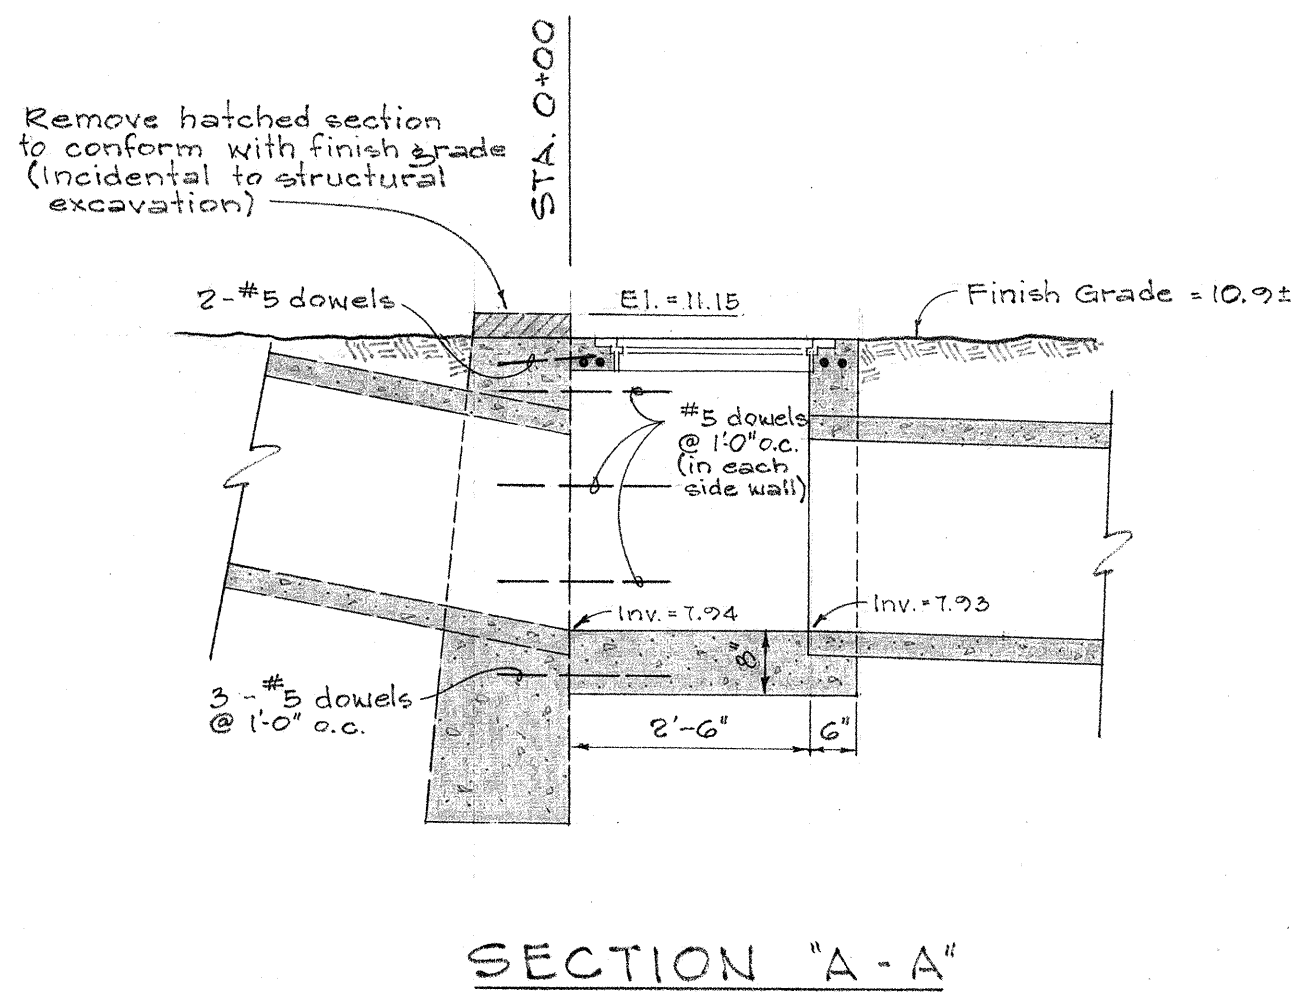
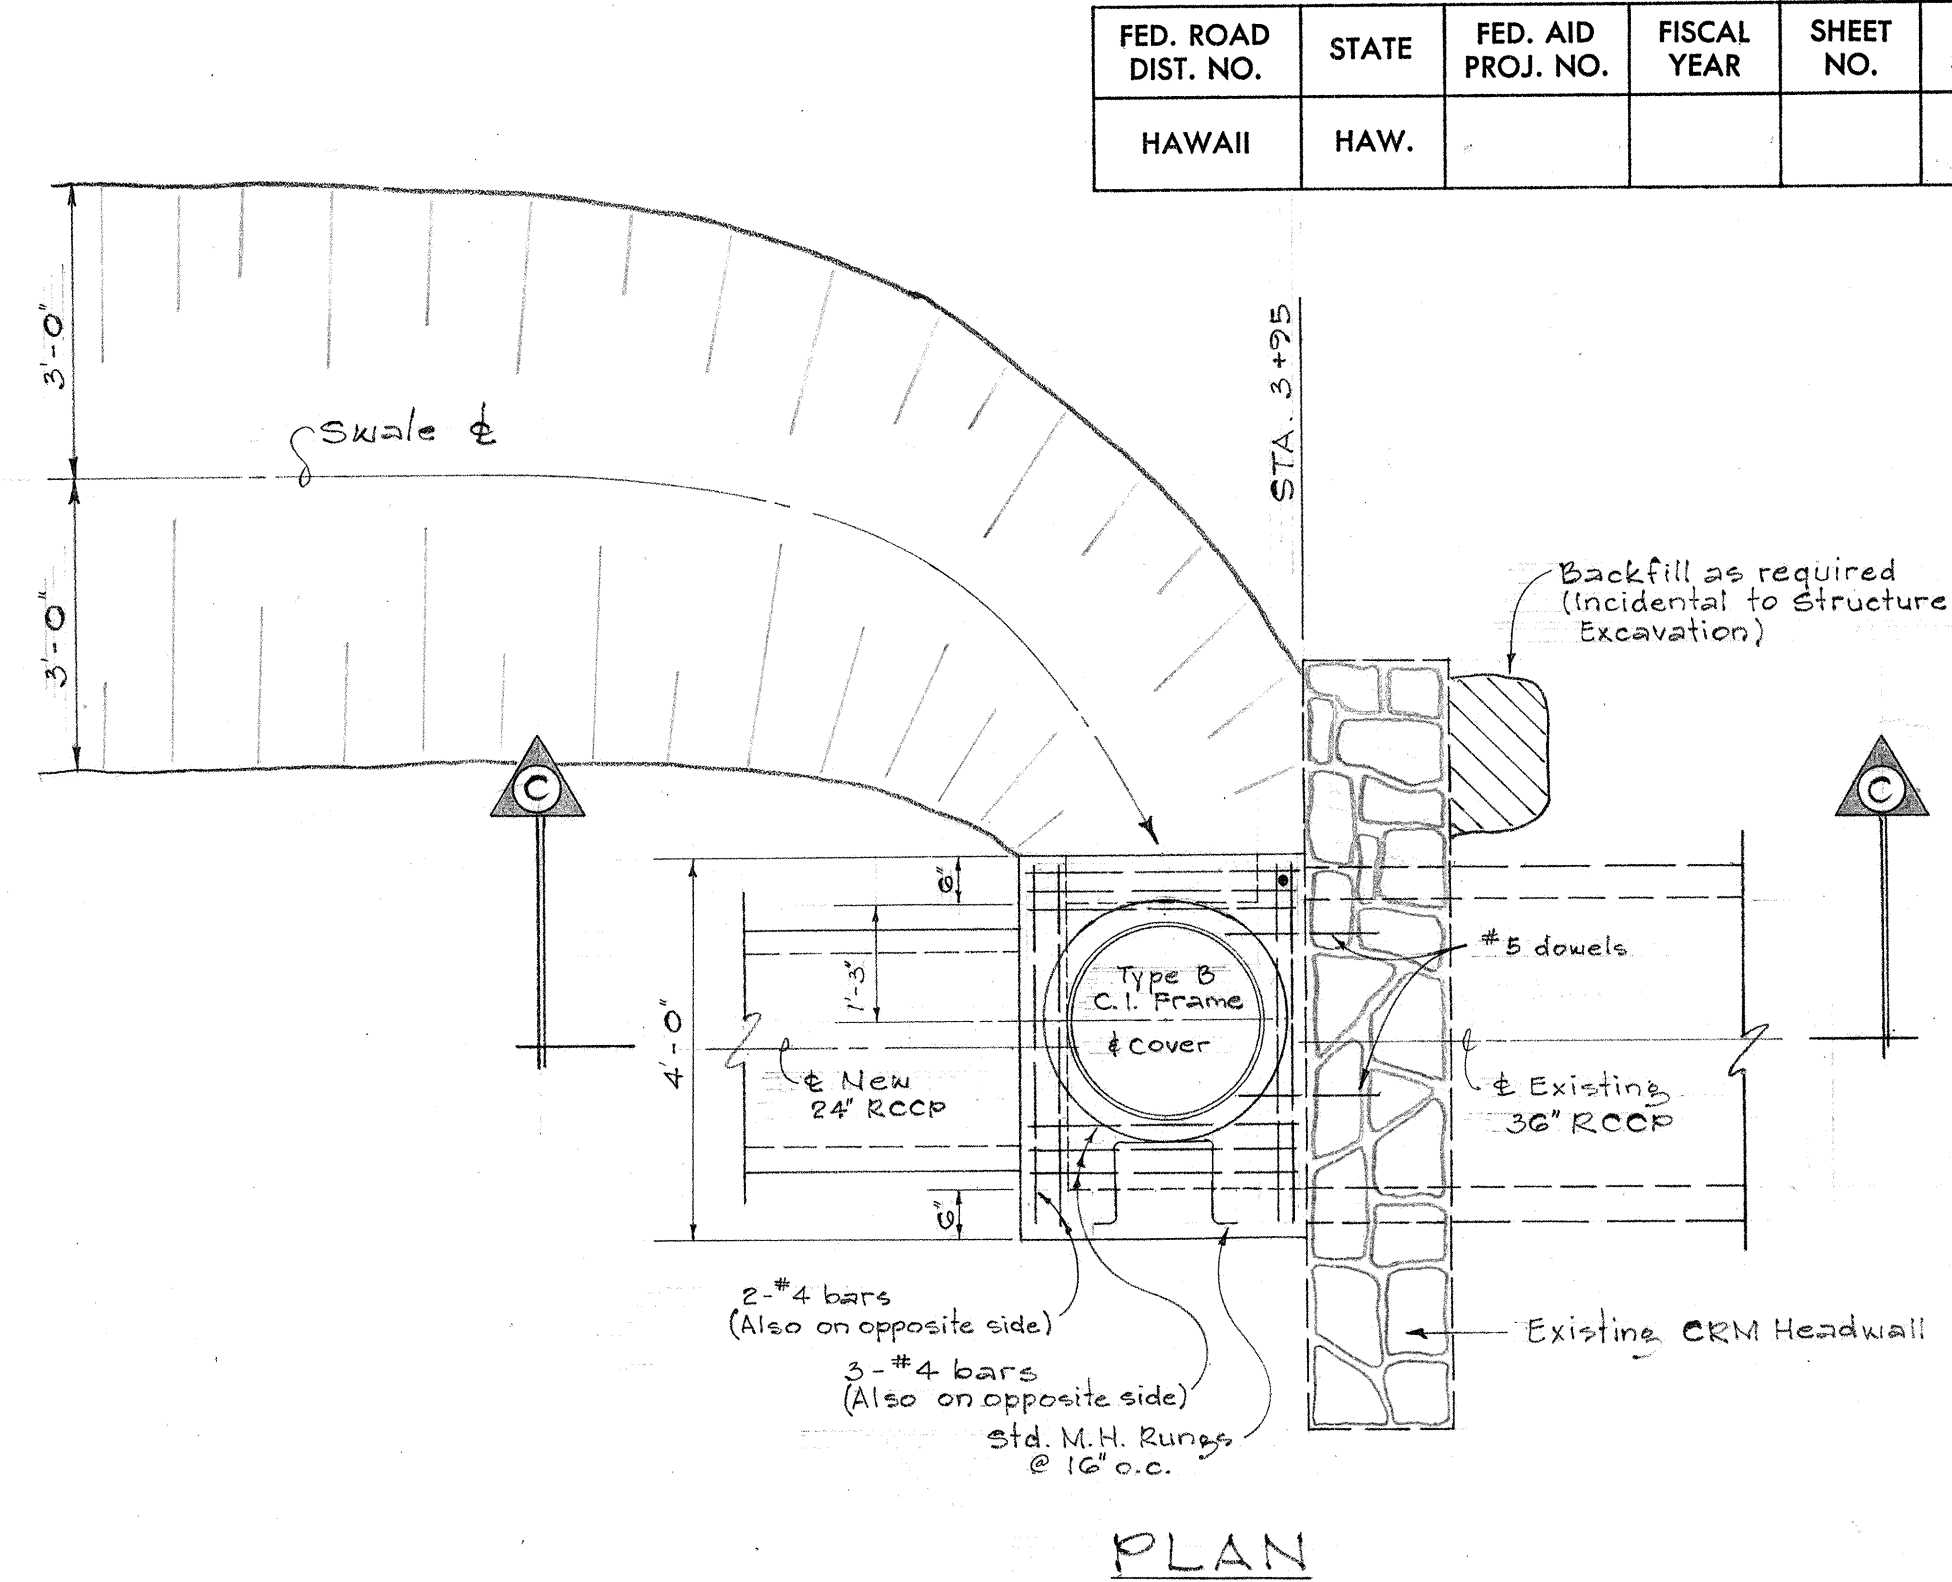
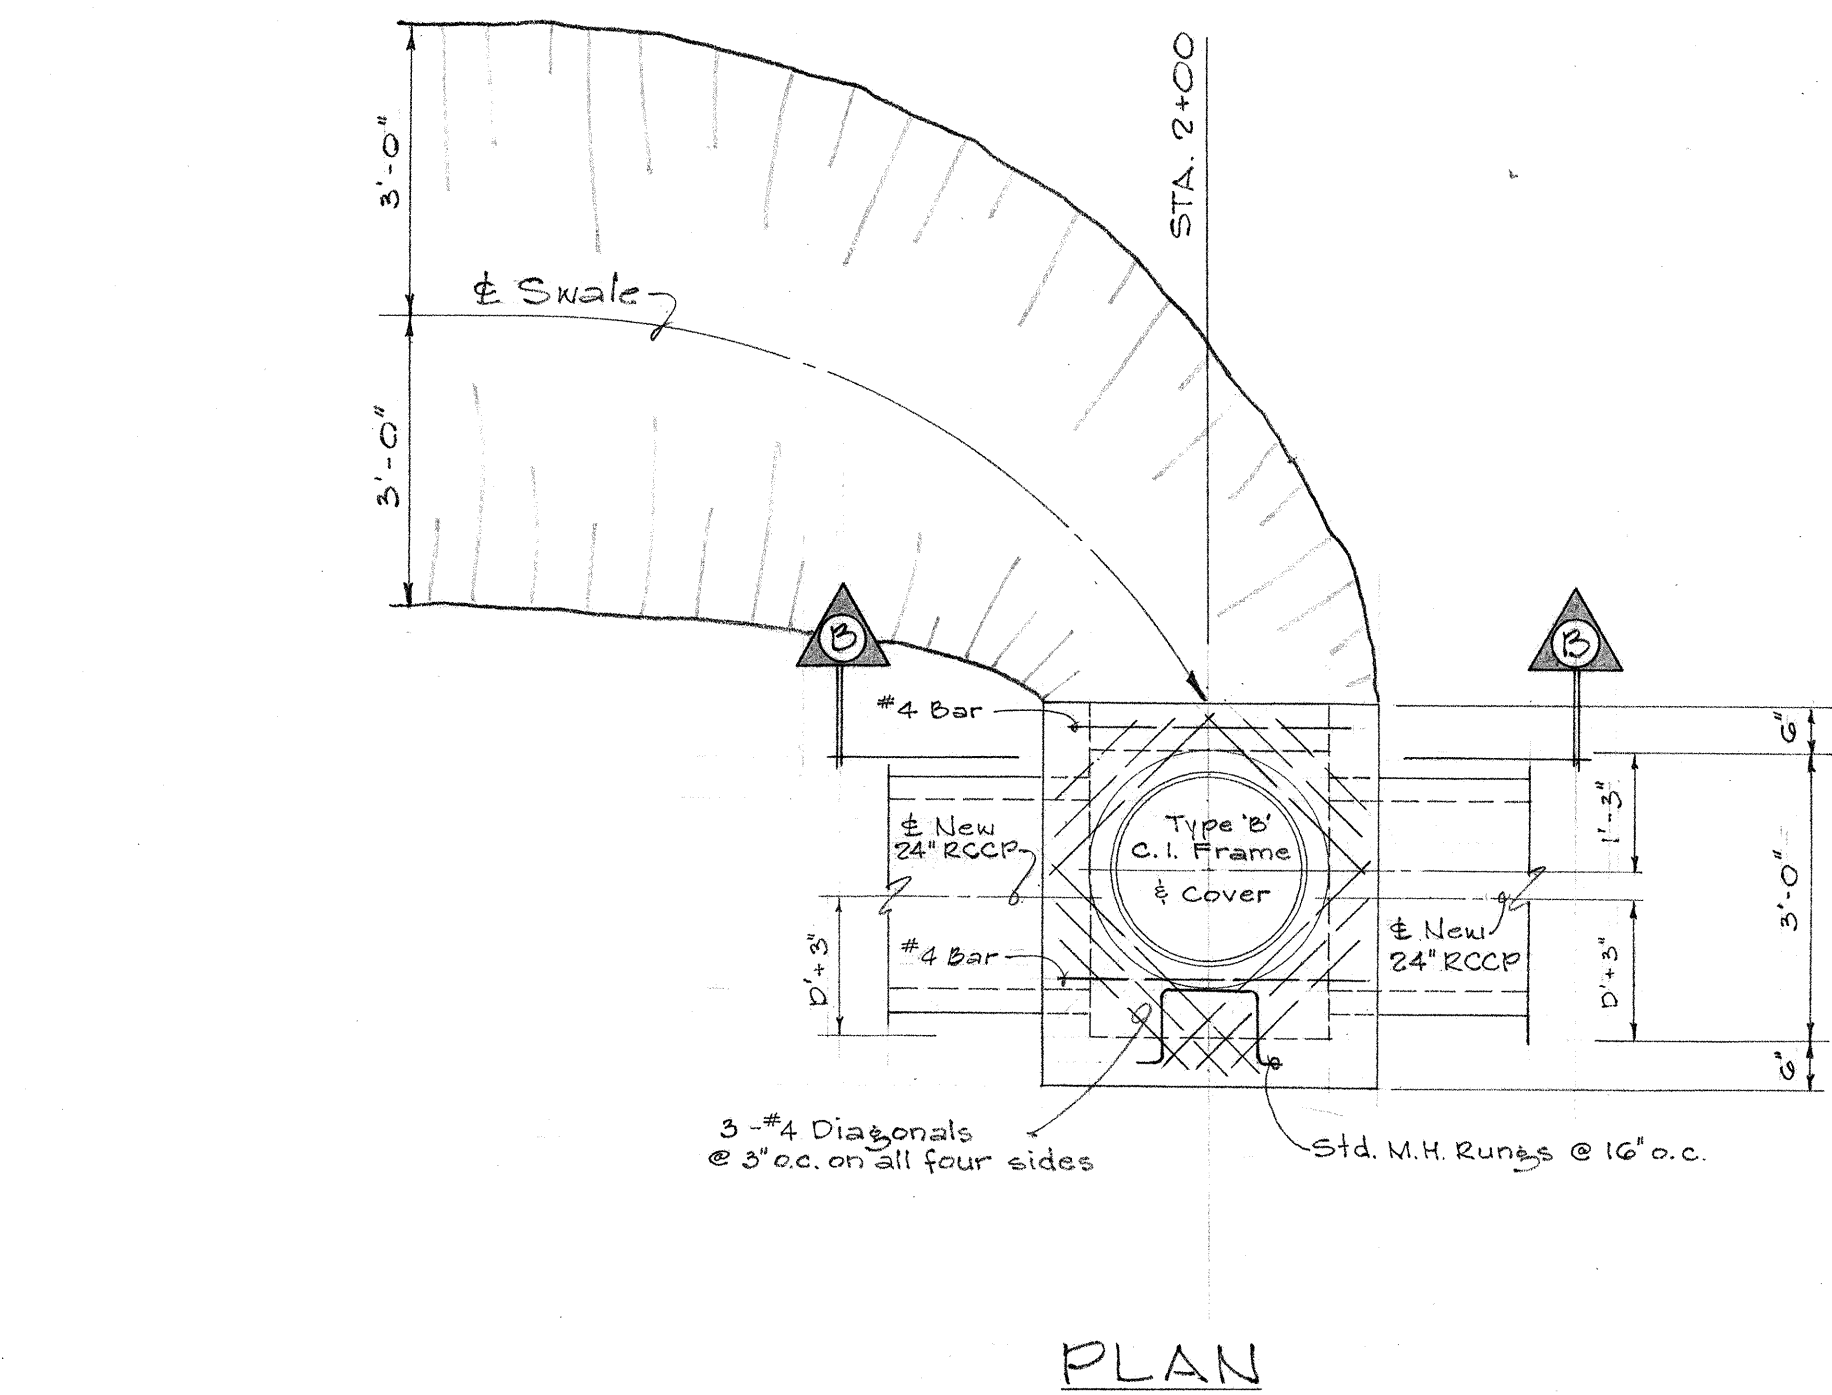


FED. ROAD DIST. NO.	STATE	FED. AID PROJ. NO.	FISCAL YEAR	SHEET NO.	TOTAL SHEETS
HAWAII	HAW.				

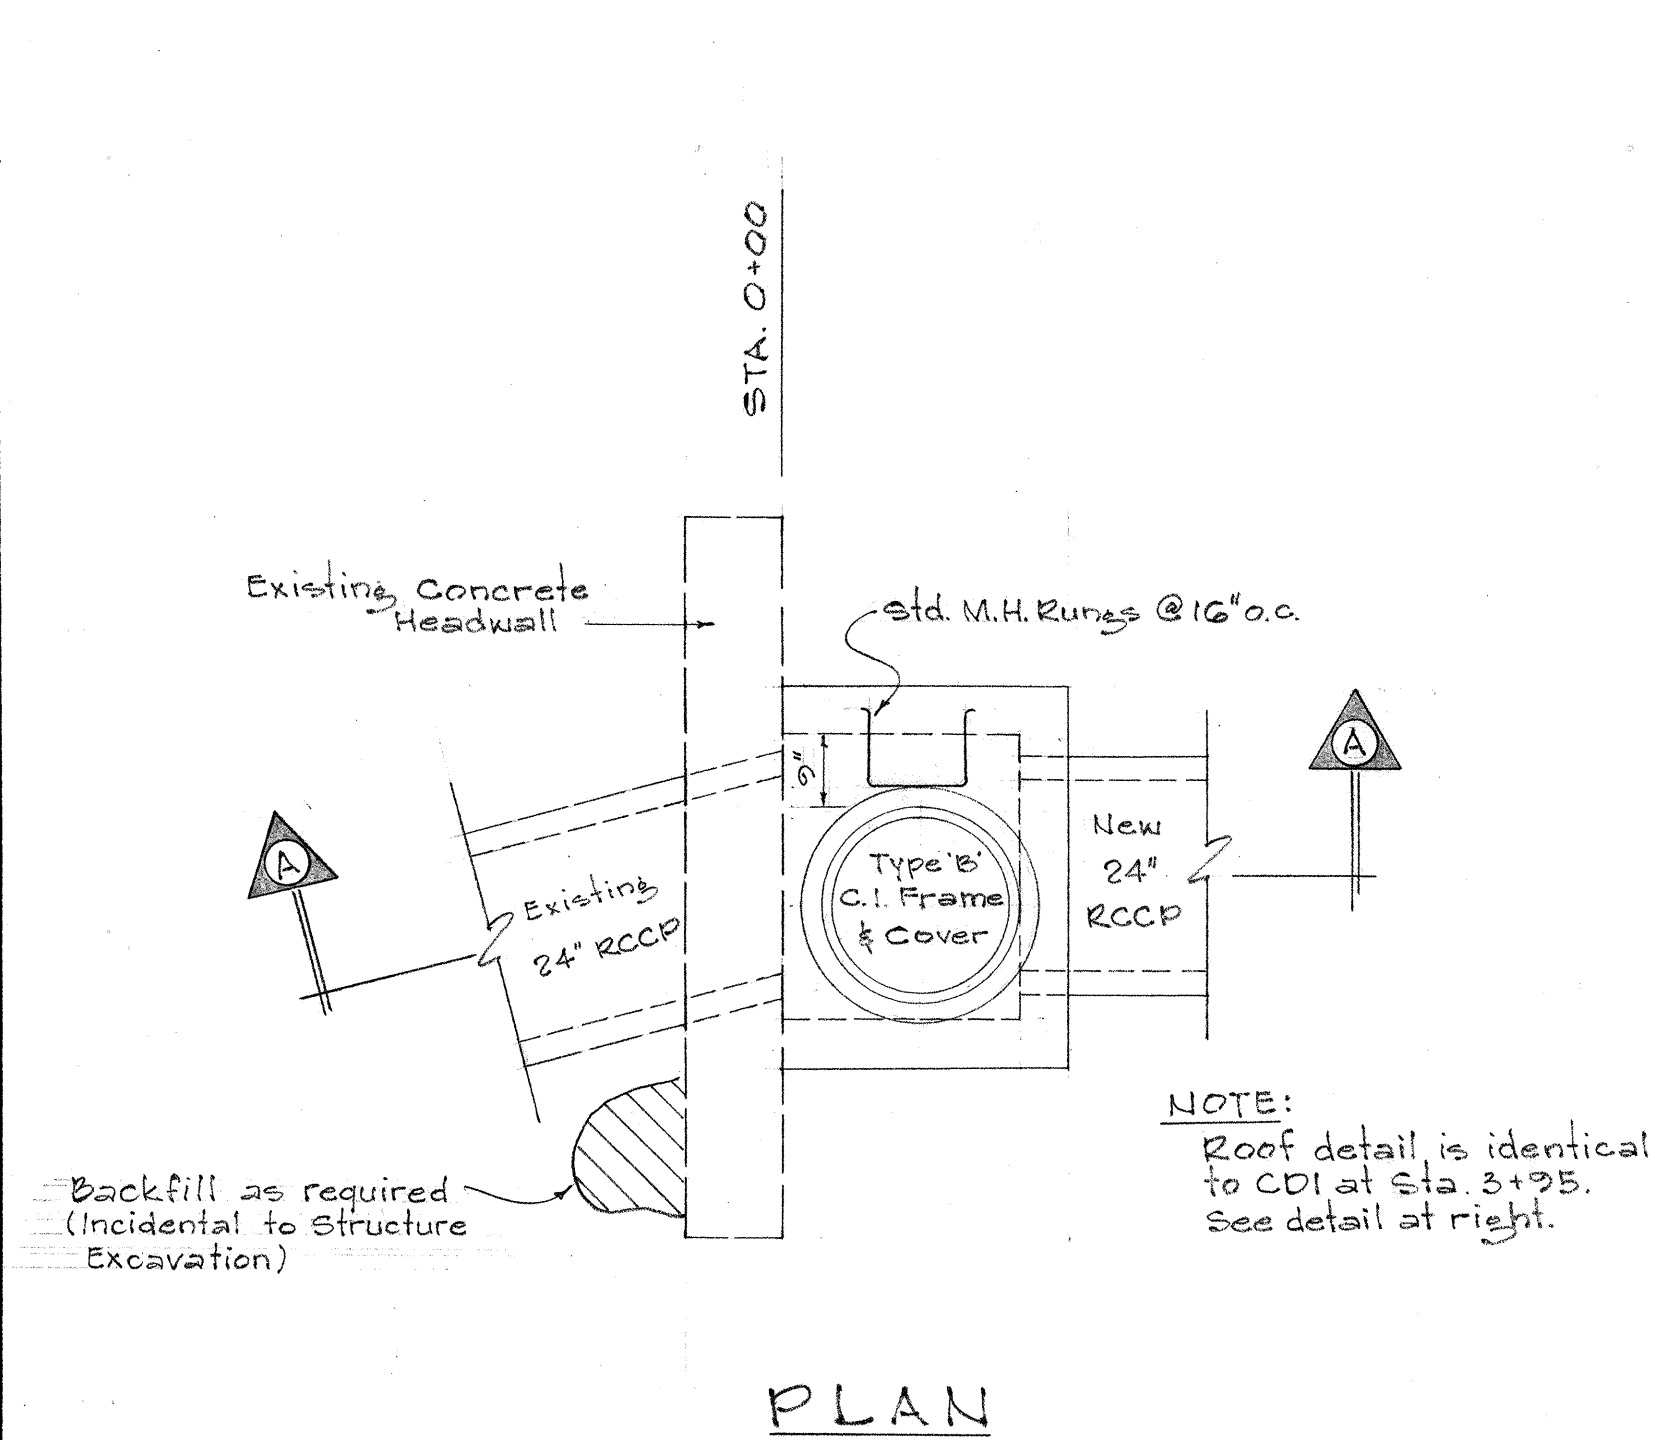

- NOTE:
1. All concrete shall be class B-1 Concrete unless otherwise noted.
 2. Standard manhole rungs shall be incidental to Type "B" C.I. Frame and Cover.
 3. Holes shall be drilled into existing headwalls at Sta. 0+00 and 3+25 and dowels to be grouted. Drilling and grout to be incidental to Class B-1 Concrete.

STATE OF HAWAII

DEPARTMENT OF TRANSPORTATION

HIGHWAYS DIVISION

MISCELLANEOUS DRAINAGE

IMPROVEMENTS ON OAHU - UNIT IV

KALAEHO AVENUE

Proj. No. B-030-01-00

DRIVEWAY DETAILS

CONC. DRAINAGE BOX DETAILS

Scale: As Shown

Date: August, 1966

SHEET No. 2 OF 3 SHEETS