


FED. ROAD DIST. NO.	STATE	PROJ. NO.	FISCAL YEAR	SHEET NO.	TOTAL SHEETS
HAWAII	HAW.	Q30001-74	1974	2	5


E CURVE DATA
 $\Delta = 13^{\circ} 30'$
 $R = 1408.17'$
 $T = 170.30'$
 $C = 356.50'$
 $L_c = 356.02'$
 $S.E. = 0.05'/ft.$

True North
 Scale: 1"=40'

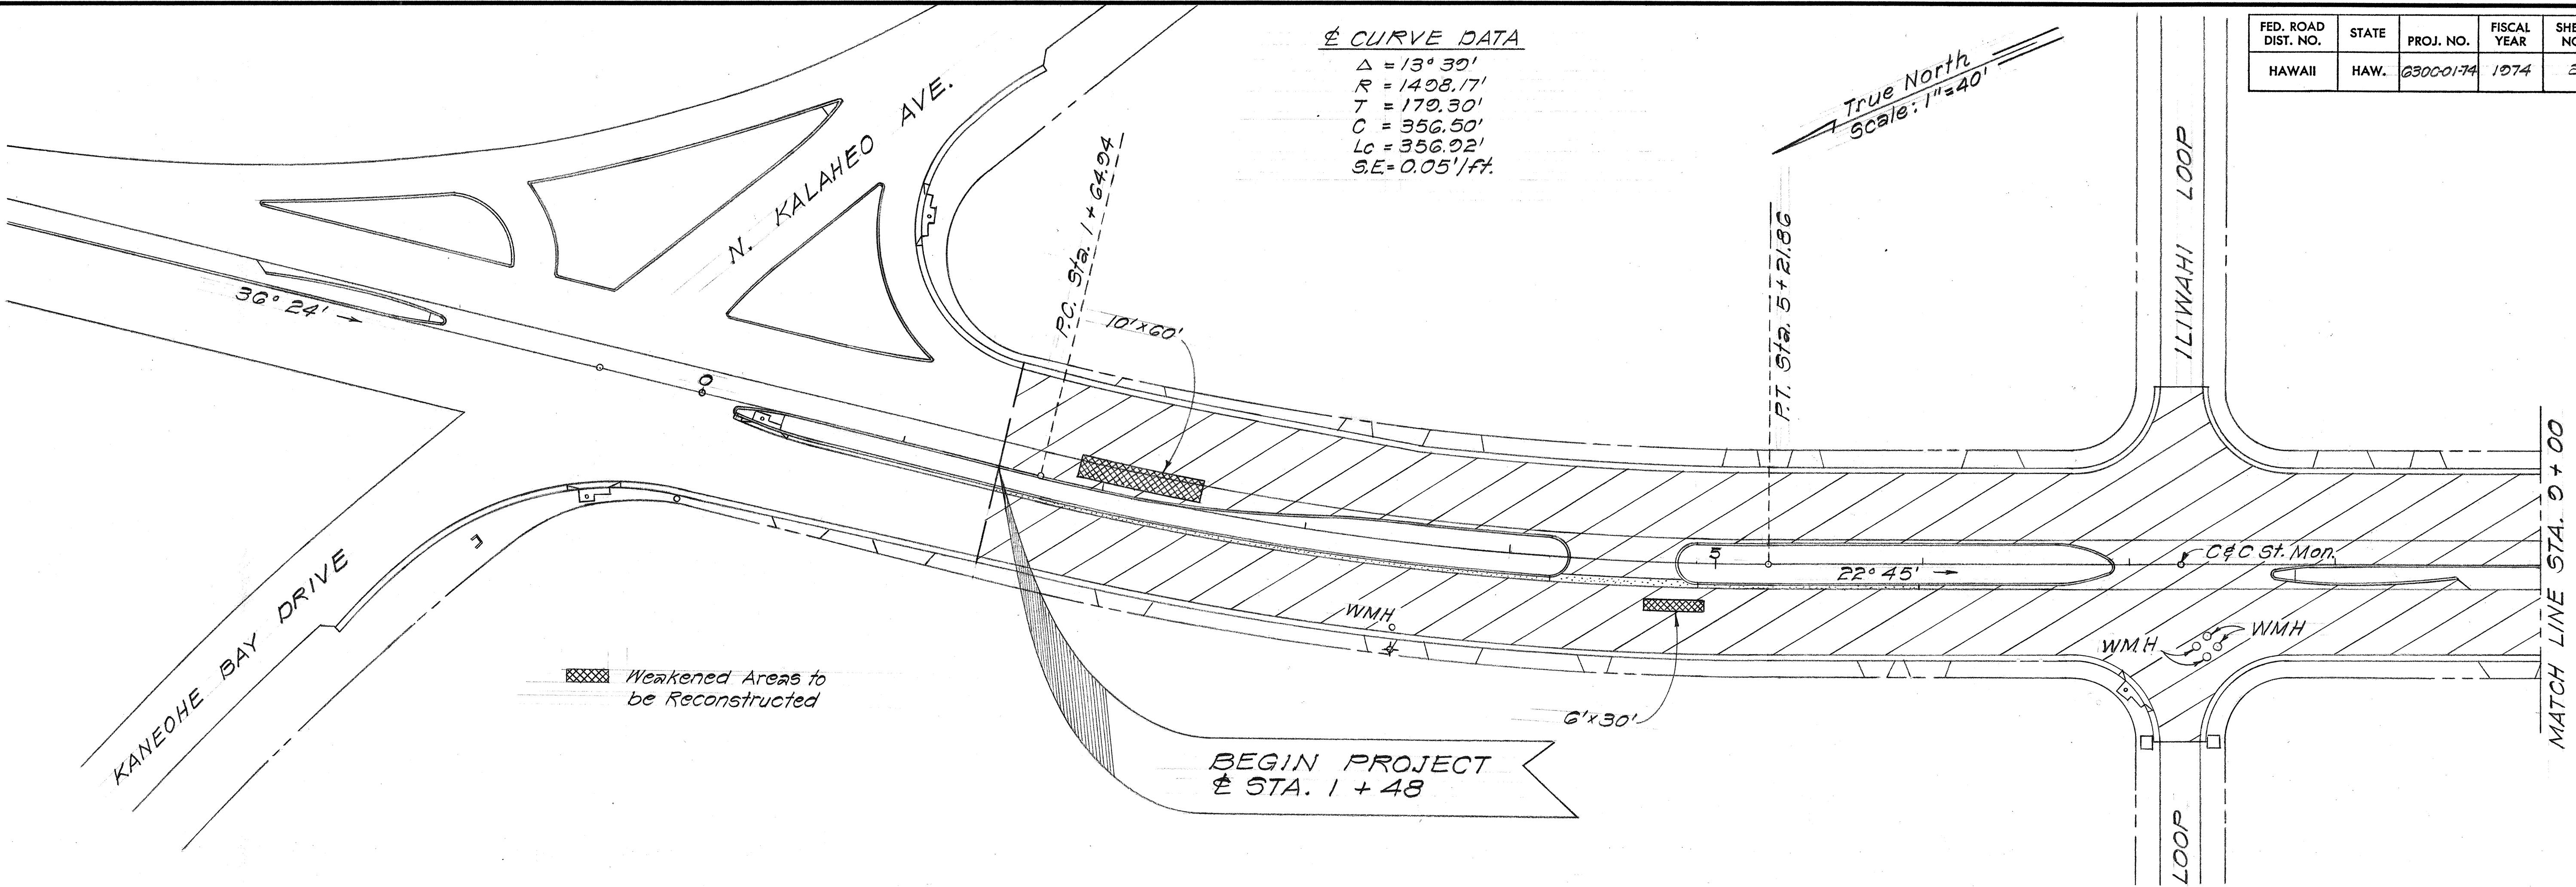


GENERAL NOTES

- All Stations are referenced to F.A.P. No. S-0630 (G).
- All holes, cracks and depressions encountered in the existing pavement shall be cleaned of loose material and filled and compacted with A.C. Pavement Mix V prior to resurfacing. Payment incidental to A.C. Pav't.
- The weakened areas as specified on the plans shall be reconstructed in accordance with the Special Provisions and plans. The exact location of areas designated for reconstruction shall be determined in the field by the Engineer.
- Smooth riding transitions shall be provided at the Beginning and Ending of project and at all street connections.
- Where the pavement adjoins existing concrete gutters, the resurfacing pavement shall be feathered down to meet the existing grade as required by the Engineer.
- Resurfacing shall be continuous over all existing manholes and street survey monuments that lie within the area of resurfacing. (See Special Provisions).

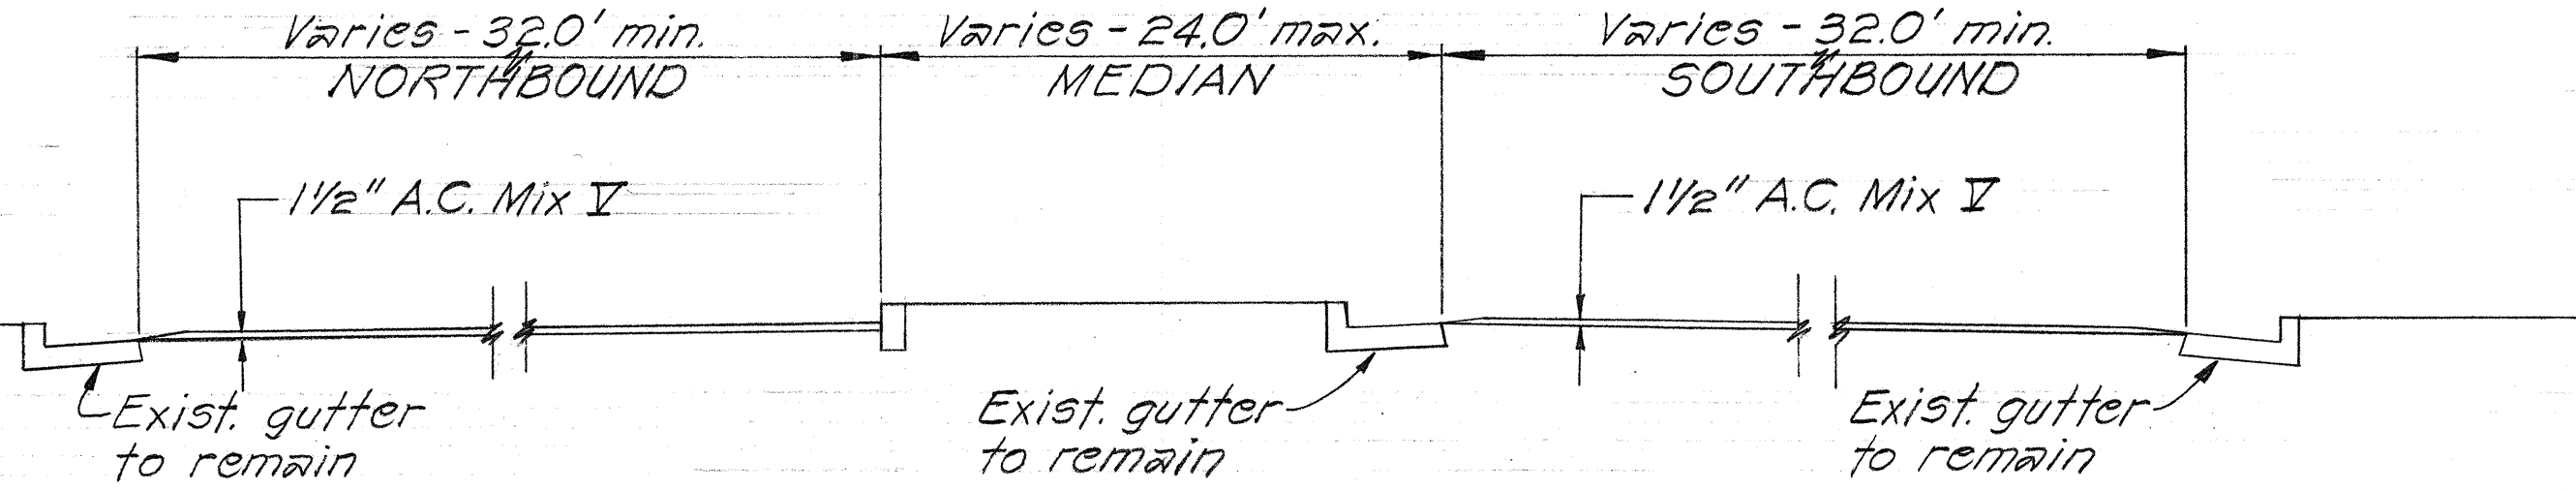

TYPICAL SECTION
 Scale: 1/4"=1'-0"

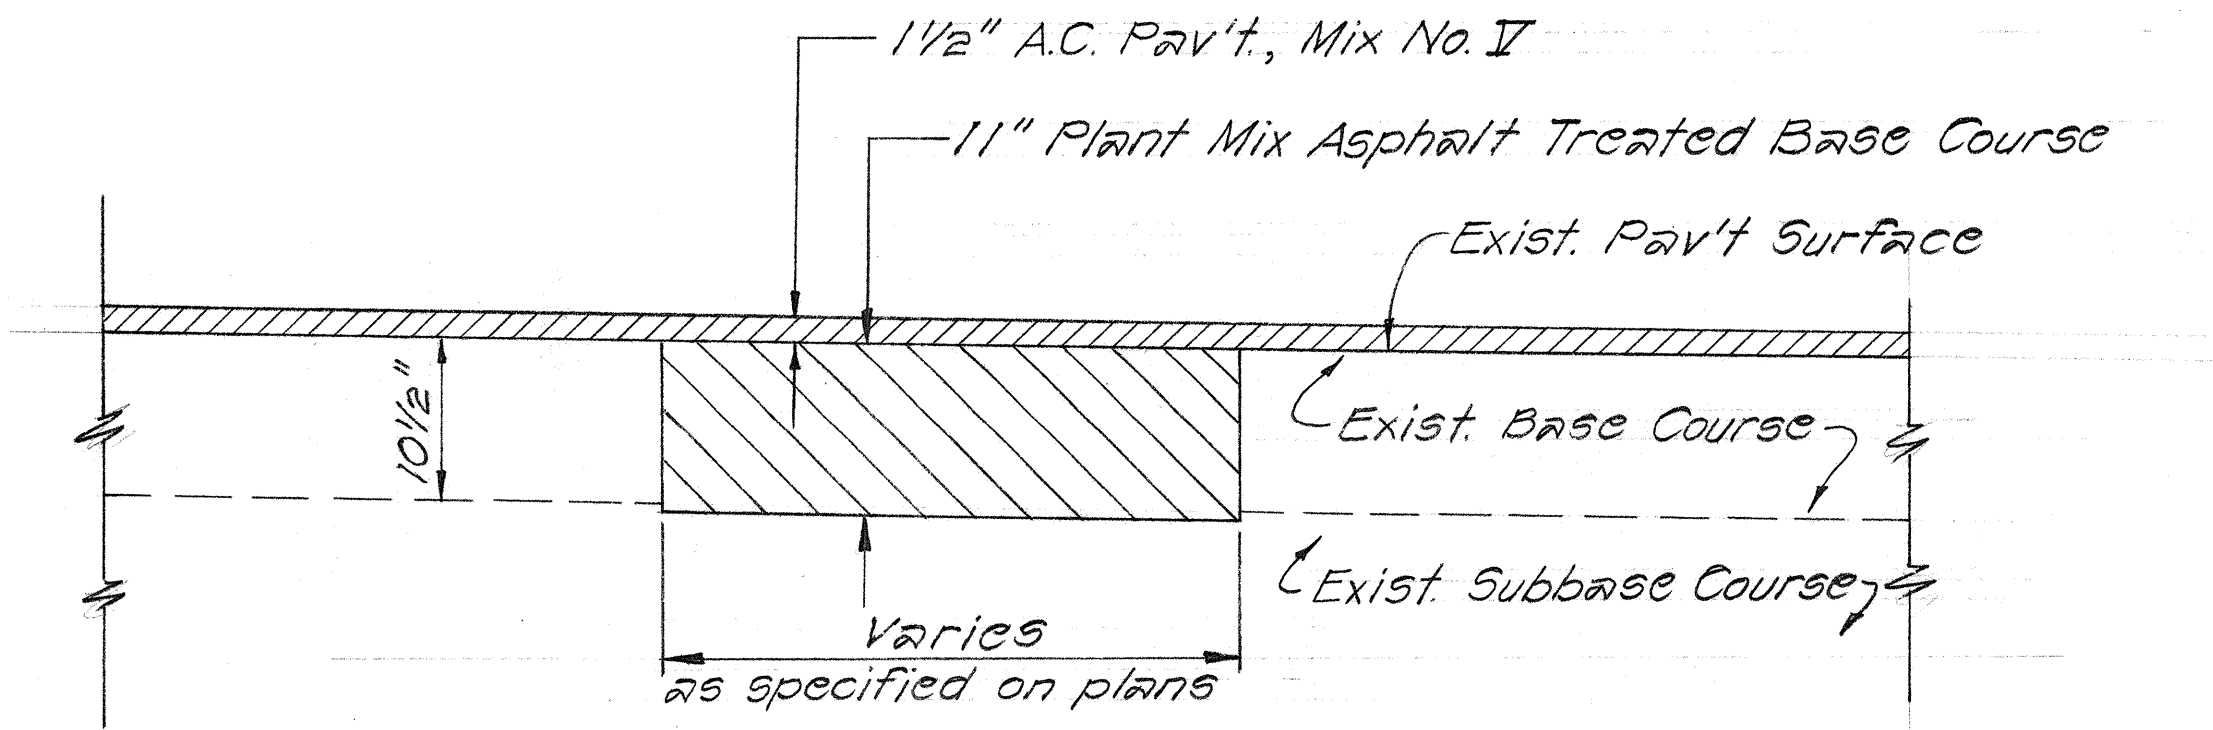

TYPICAL SECTION ~ RECONSTRUCTION OF WEAKENED AREA
 Scale: 1"=1'-0"



STATE OF HAWAII
 DEPARTMENT OF TRANSPORTATION
 HIGHWAYS DIVISION

TYPICAL SECTIONS-GENERAL NOTES
 & ROADWAY PLANS
 FOR
 MOKAPU BOULEVARD RESURFACING
 Proj. No. Q300-01-74
 Scale: As Shown Date: Sept. 1973
 SHEET No. 1 OF 3 SHEETS

SURVEY PLOTTED BY	DATE
DRAWN BY	
CHECKED BY	
NOTED BY	
ORIGINAL PLAN	
NOTE BOOK	
No.	

FED. ROAD DIST. NO.	STATE	PROJ. NO.	FISCAL YEAR	SHEET NO.	TOTAL SHEETS
HAWAII	HAW.	630001-74	1974	3	3

True North
Scale: 1"=40'

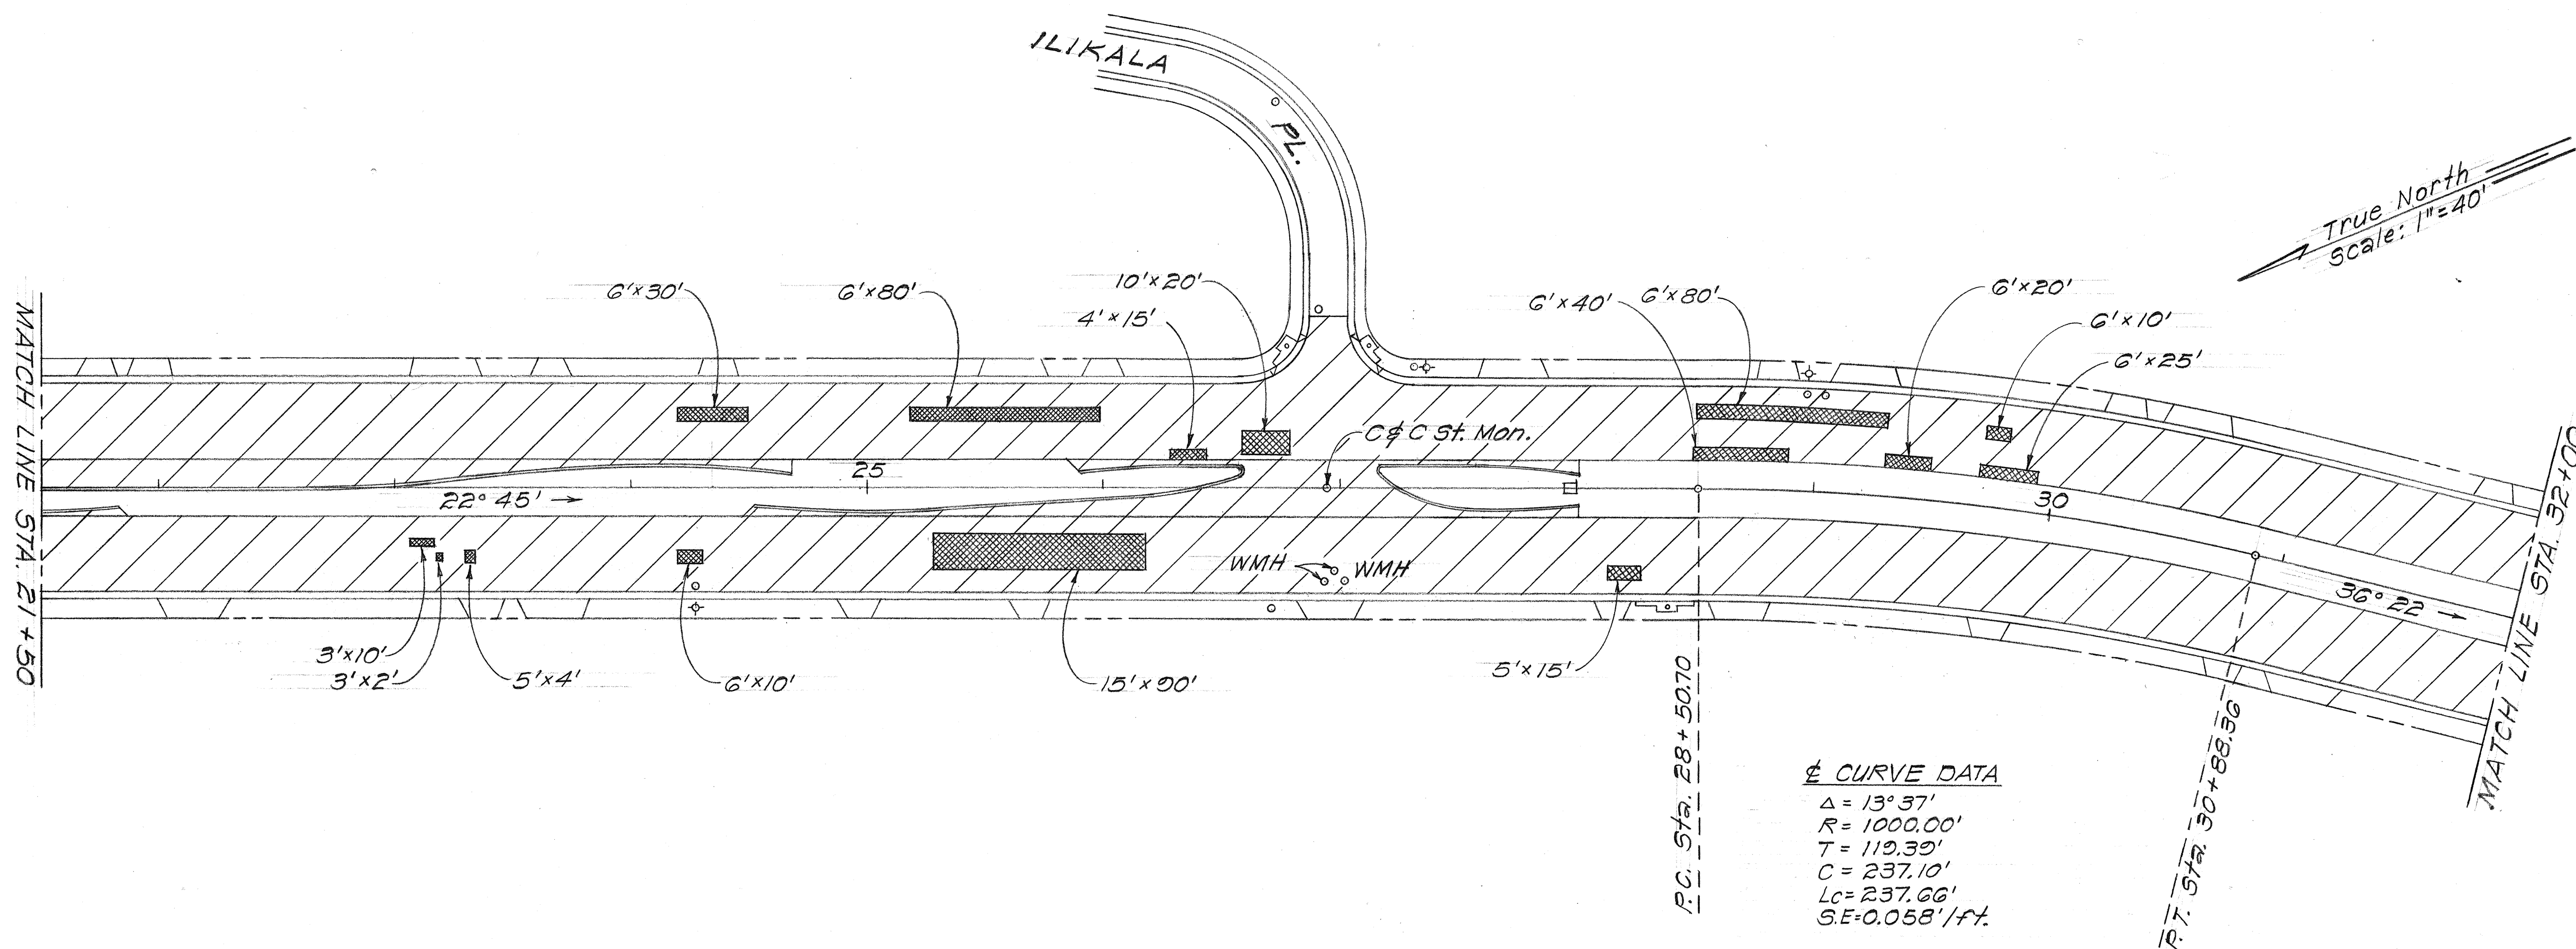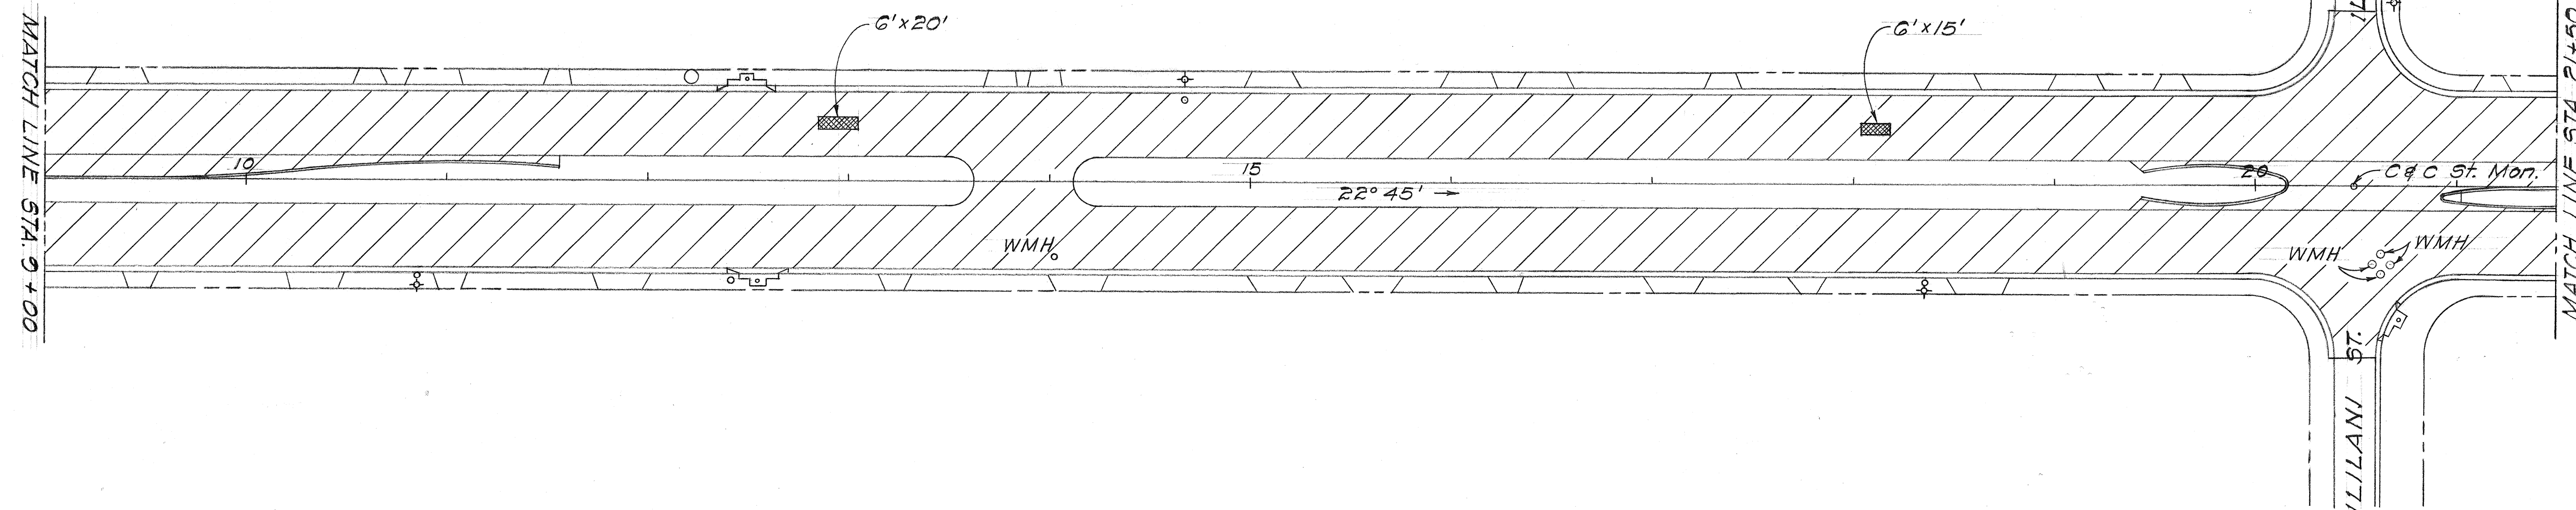

DATE	_____
SURVEY PLOTTED BY	_____
DRAWN BY	_____
TRACED BY	_____
QUANTITIES BY	_____
CHECKED BY	_____
ORIGINAL PLAN	_____
NOTE BOOK	_____
No.	_____

STATE OF HAWAII DEPARTMENT OF TRANSPORTATION HIGHWAYS DIVISION
ROADWAY PLANS
MOKAPU BOULEVARD RESURFACING
Proj. No. 6300-01-74
Scale: 1"=40' Date: Sept. 1973
SHEET No. 2 OF 3 SHEETS

