



STATE OF HAWAII

DEPARTMENT OF TRANSPORTATION HIGHWAYS DIVISION

HONOLULU, HAWAII


"AS BUILT"

PLANS FOR INSTALLATION OF

TRAFFIC SIGNALS ON KANEOHE BAY DRIVE AT MOKULELE DRIVE


F.A. PROJ. NO. U-0630(12)

DISTRICT OF KOOLAUPOKO
ISLAND OF OAHU

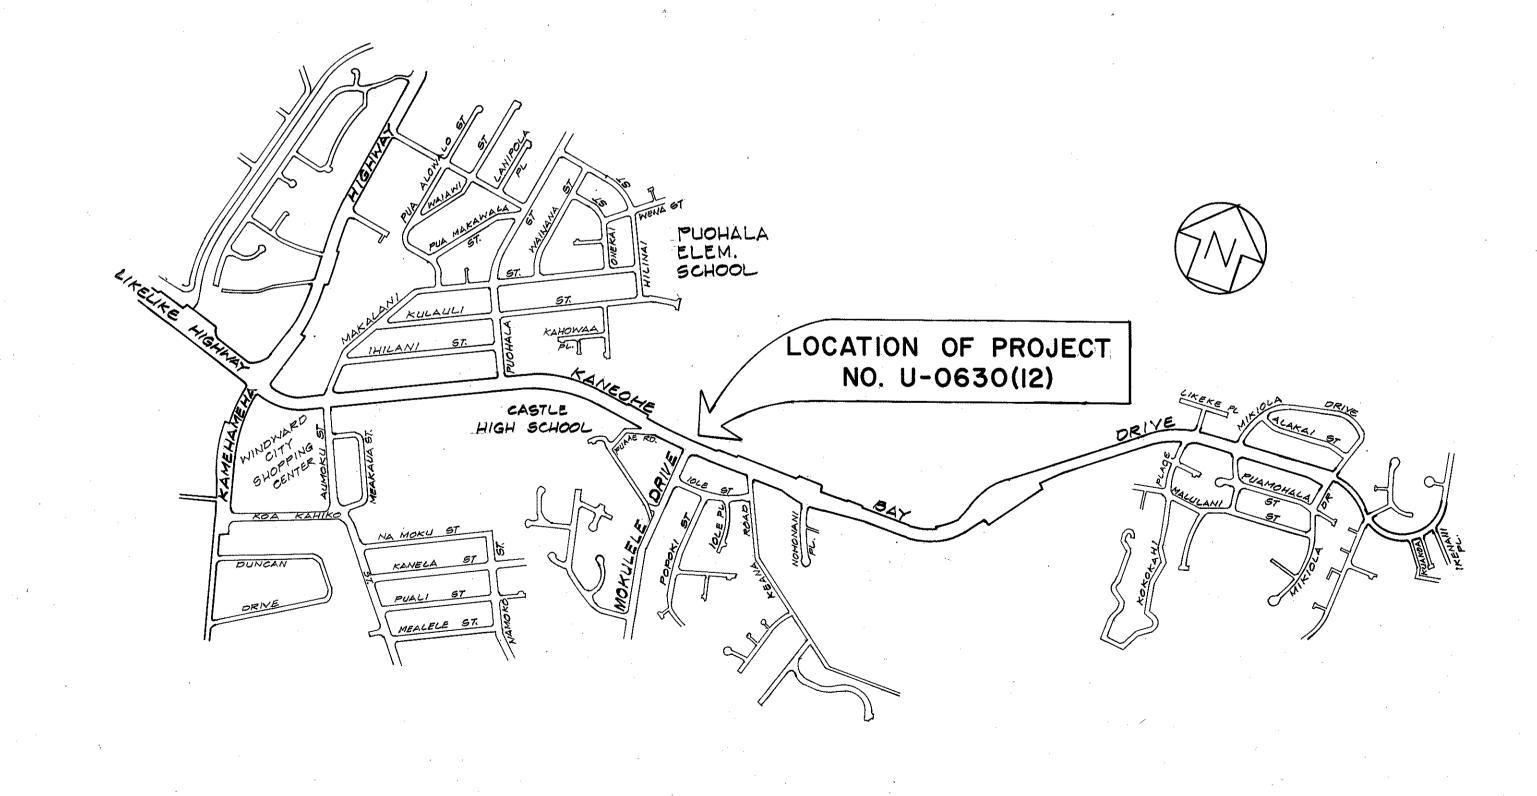

GENERAL LAYOUT PLAN

SCALE: I" = 800'

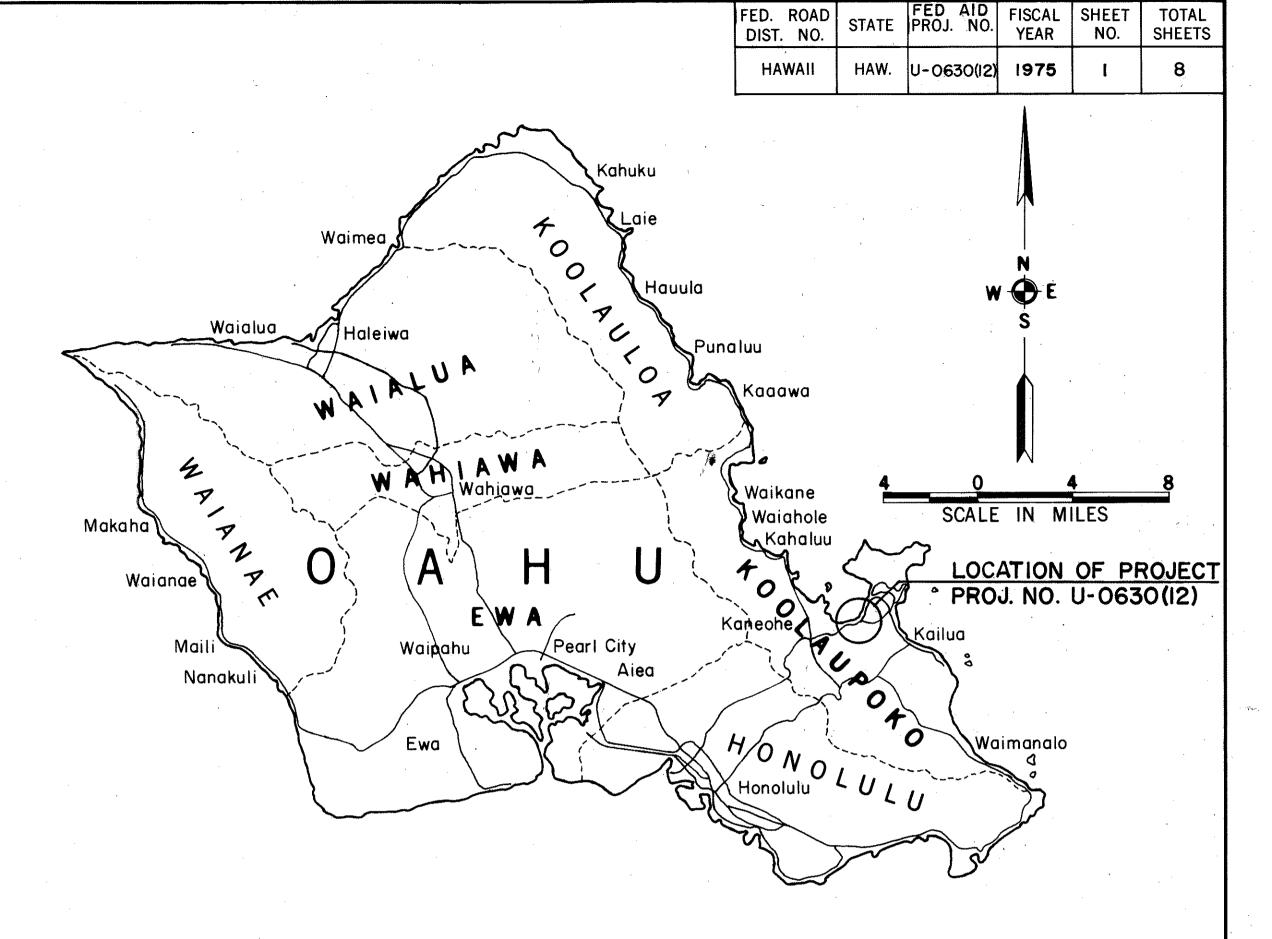

NOTE:

ALL CHANGES MADE DURING CONSTRUCTION HAVE BEEN INCORPORATED ON THESE PLANS IN RED EXCEPT CHANGES IN THE ORIGINAL THEORETICAL QUANTITIES.

PROJECT ENGINEER DATE

DESIGN CLASSIFICATION

CURRENT ADT (1975)	23,200
FUTURE ADT (1995)	25,000
DHV	11%
D	
T ₂₄	3 %
V	40 MPH

DEPARTMENT OF TRANSPORTATION
FEDERAL HIGHWAY ADMINISTRATION
APPROVED:

6.23.75 DATE

DEPARTMENT OF TRANSPORTATION STATE OF HAWAII	
APPROVED: E. alvey D. might	6/19/25
DIR. OF TRANSPORTATION	DATE