
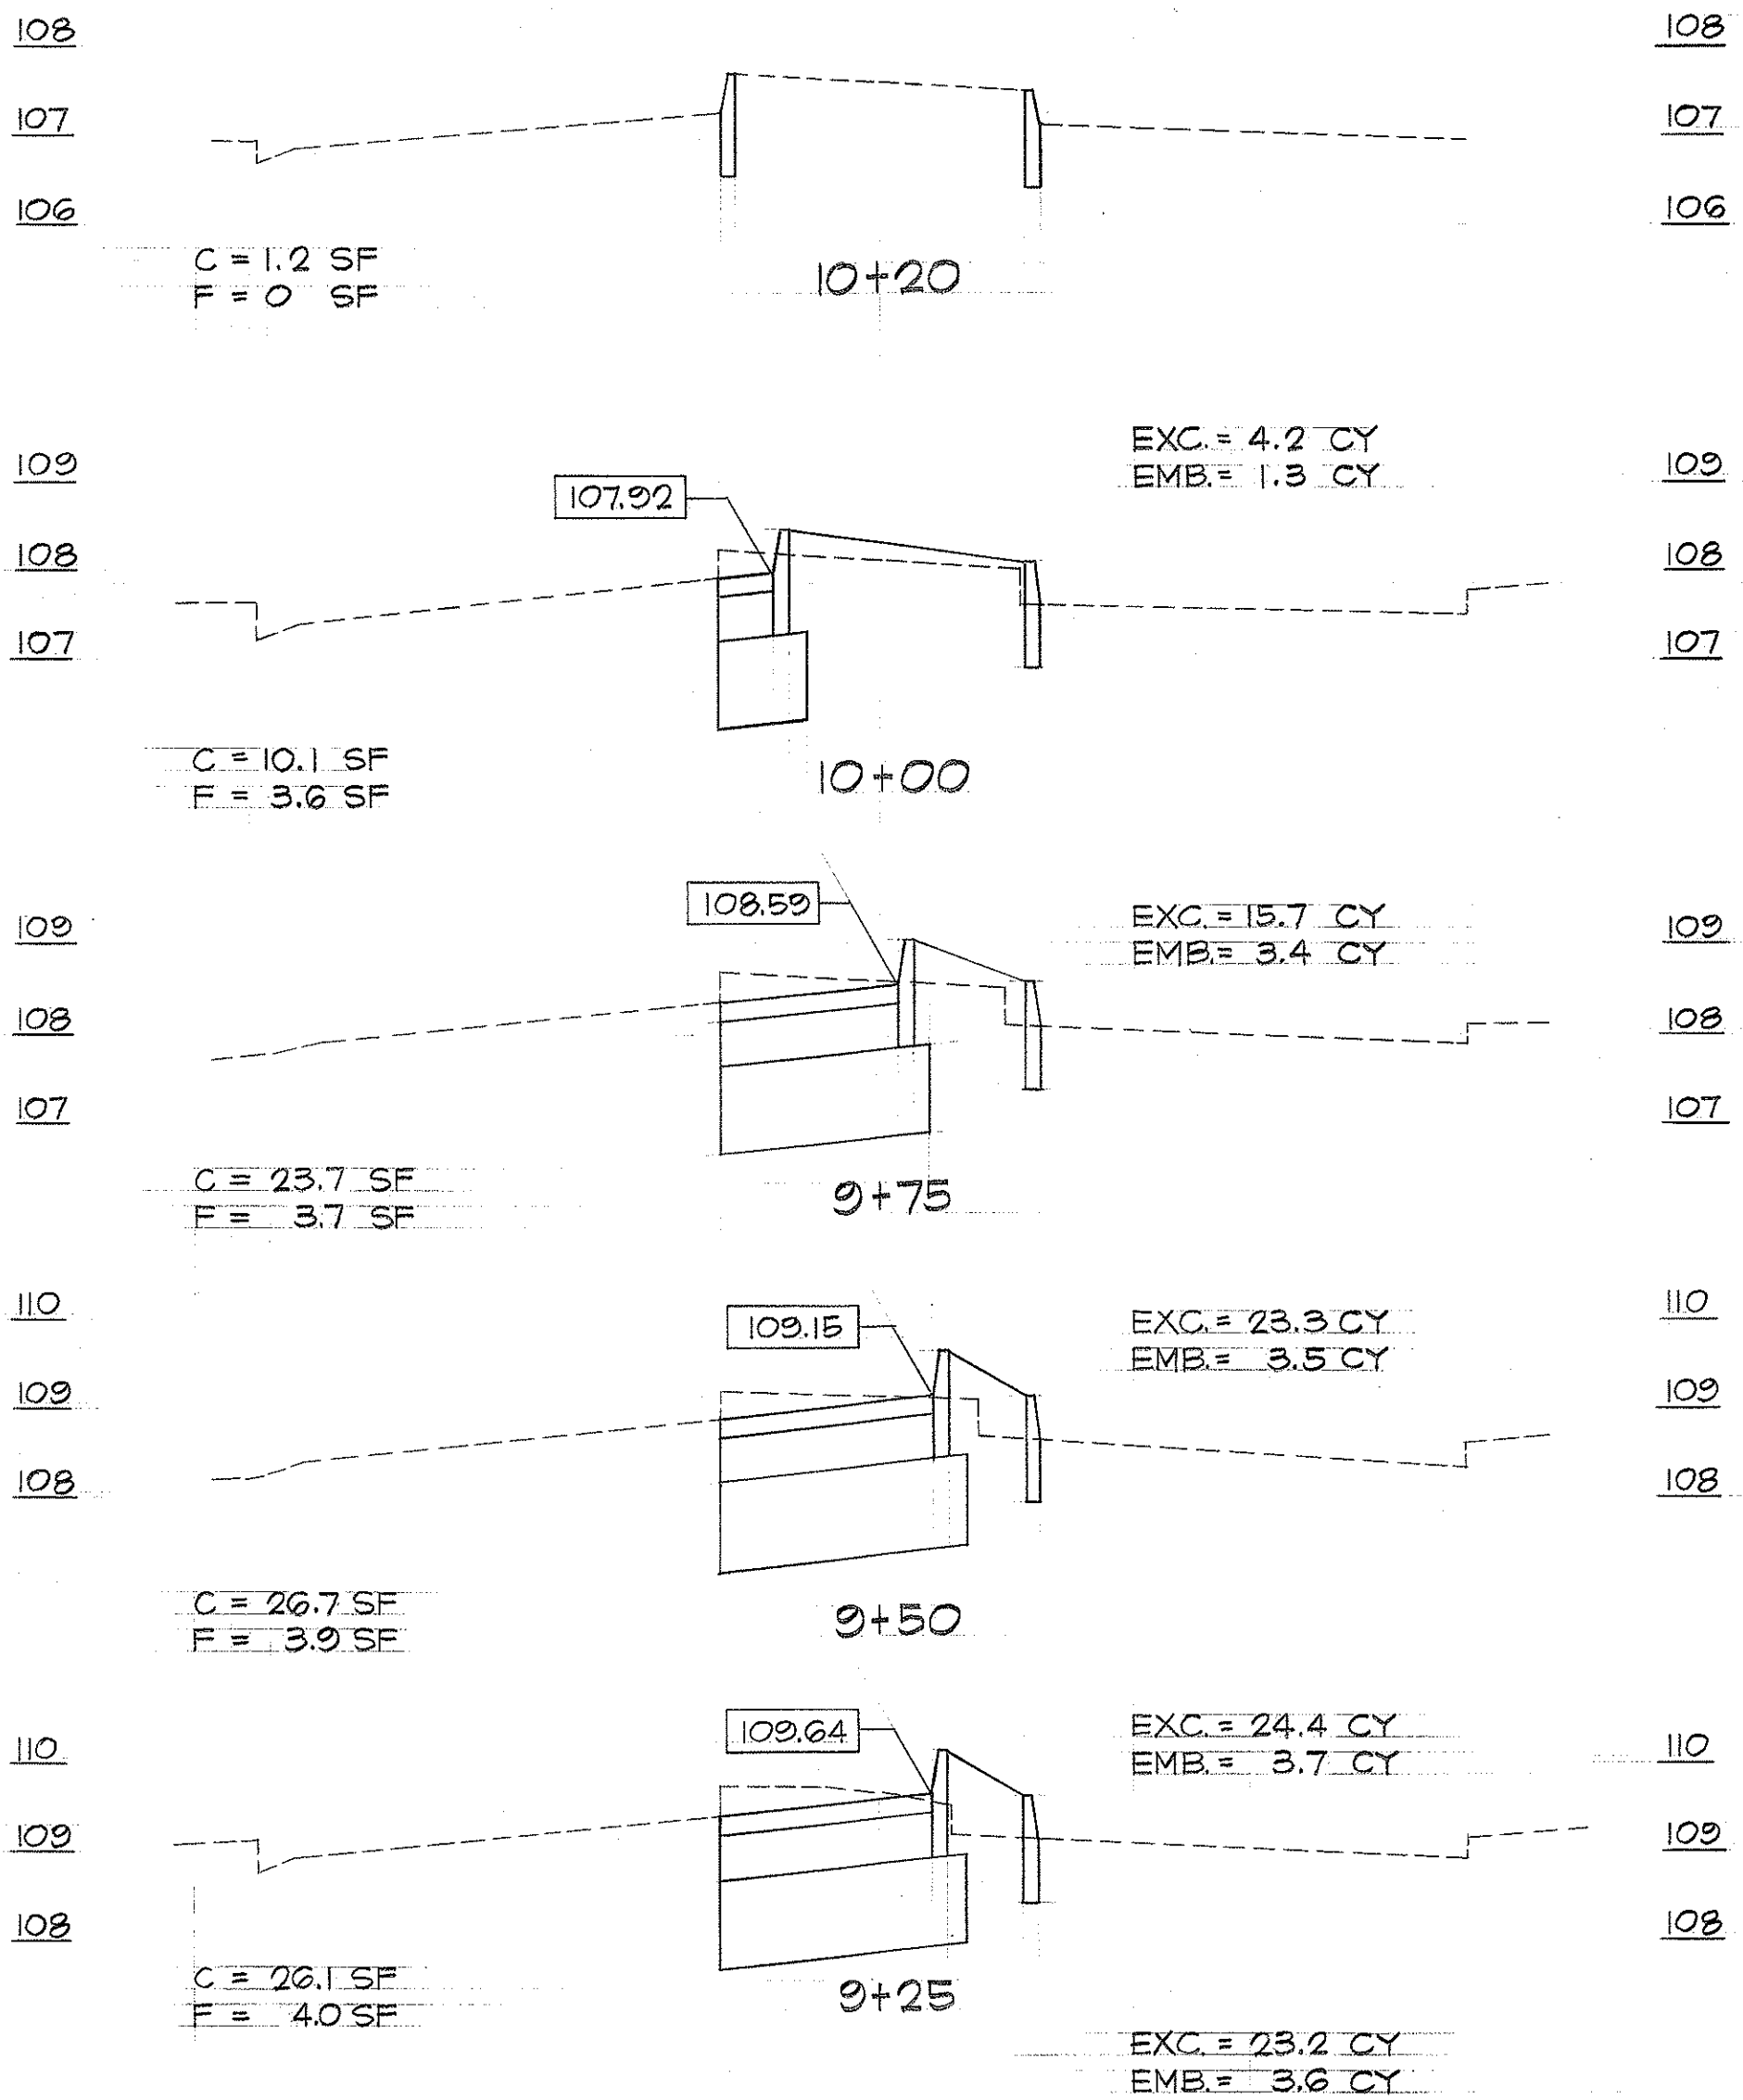
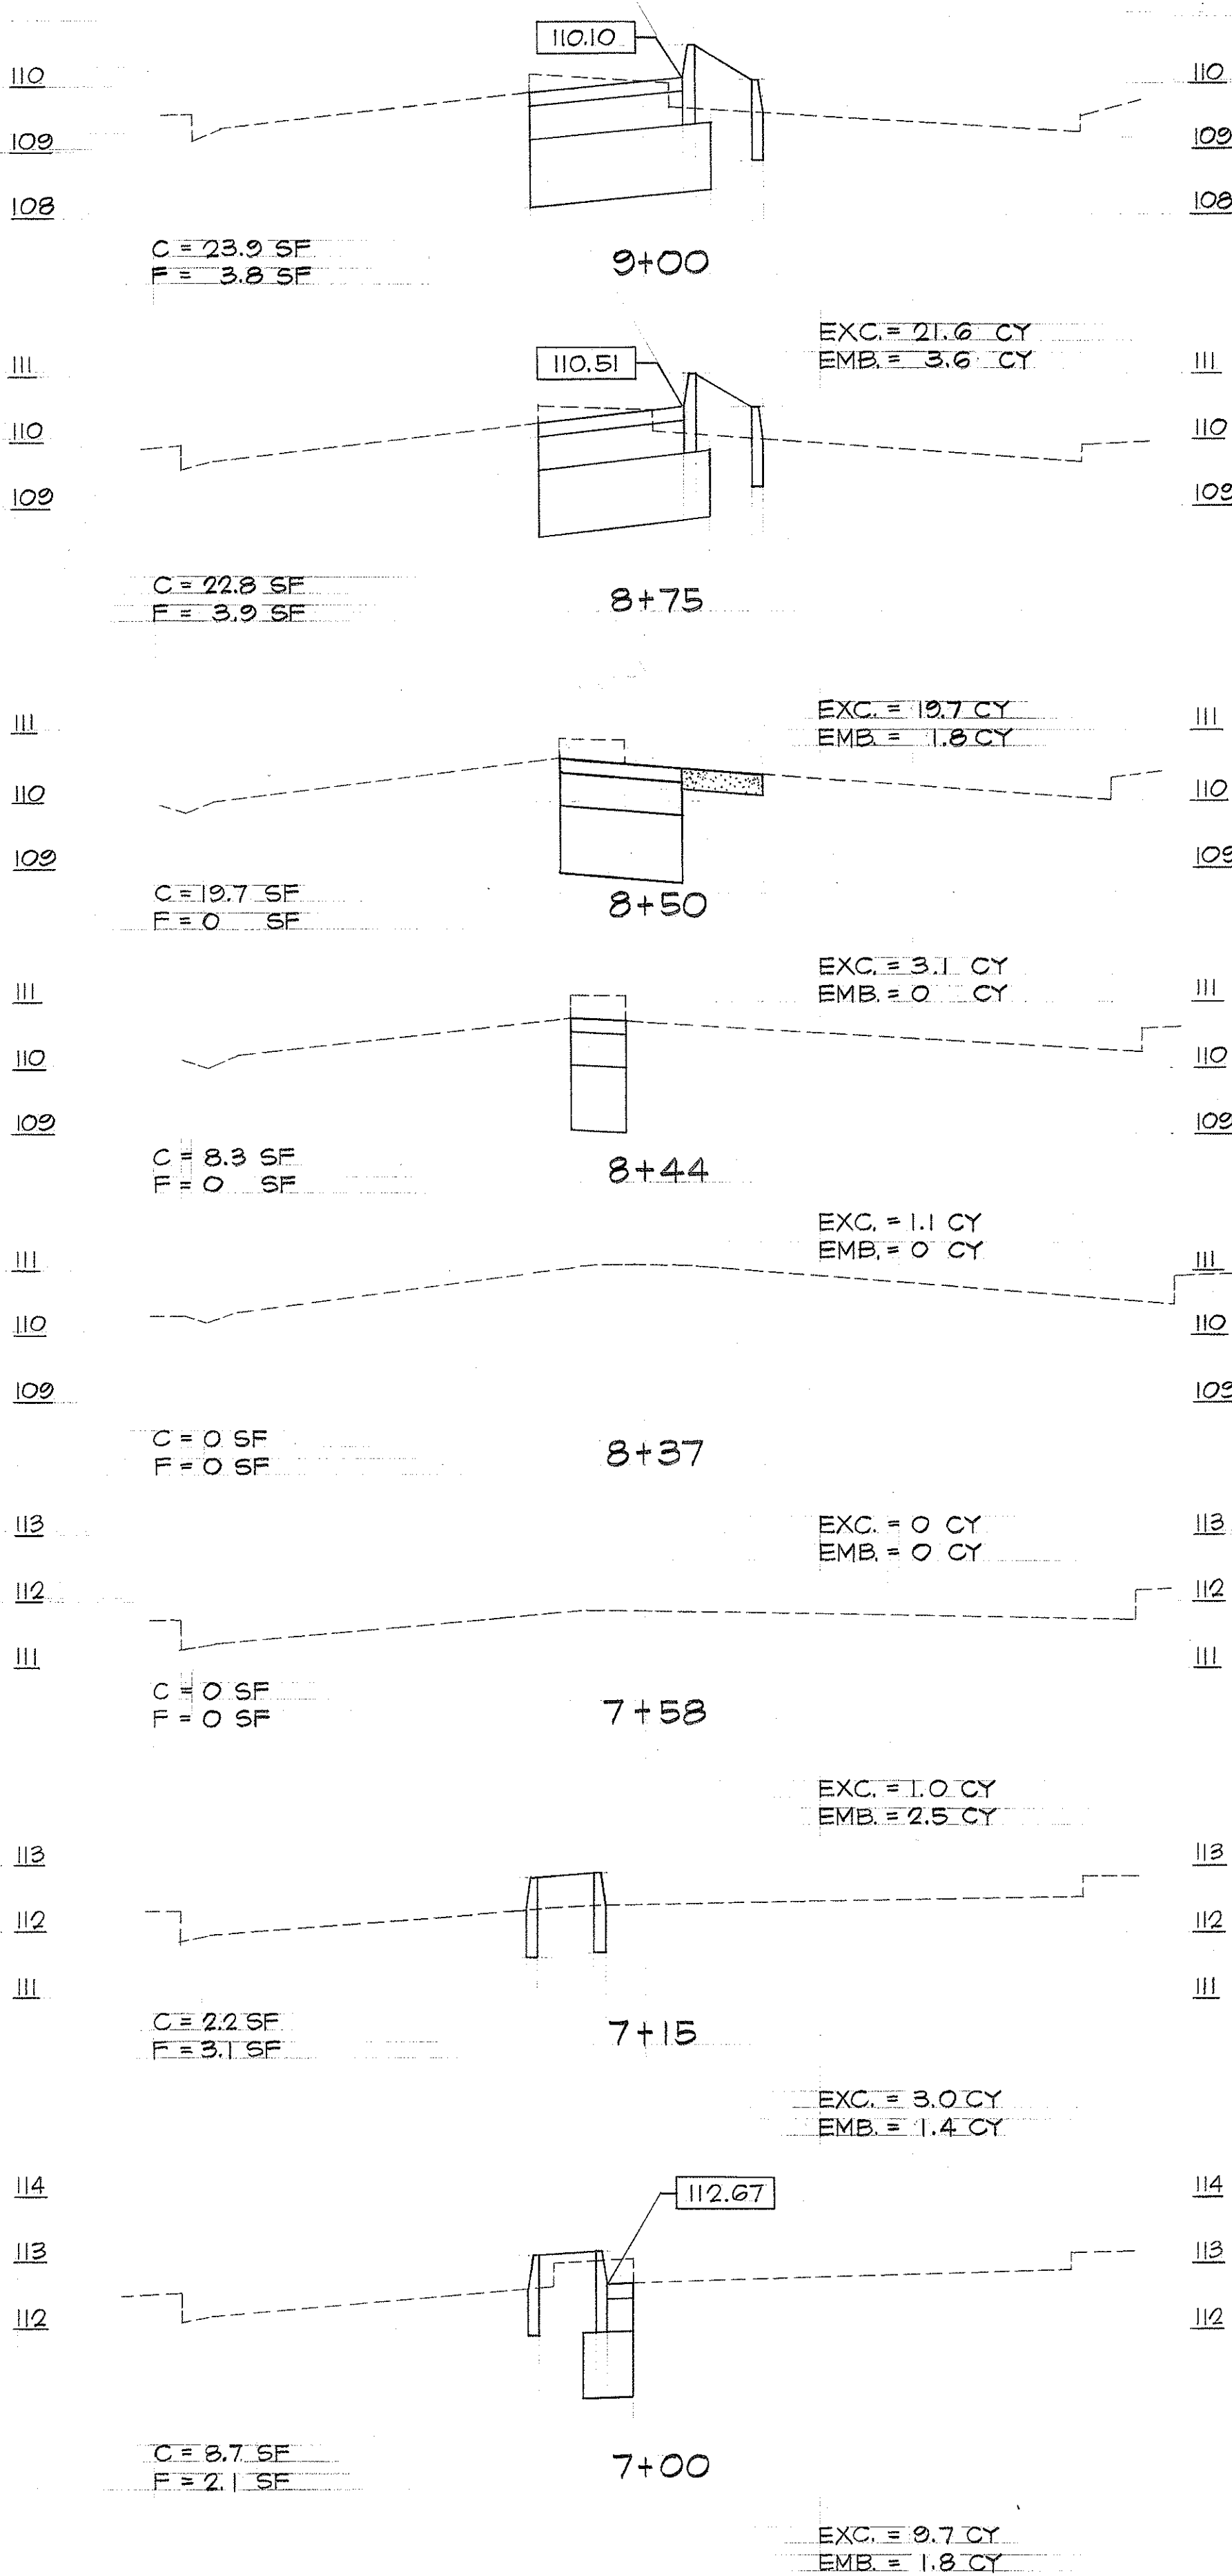


FED. ROAD DIST. NO.	STATE	PROJ. NO.	FISCAL YEAR	SHEET NO.	TOTAL SHEETS
HAWAII	HAW.	6300A-01-79	1980	5	20

SUMMARY

EXCAVATION	185 CY
EMBANKMENT	34 CY
A.C. PAVING	222 SF
6" BASE COURSE	37 CY
12" AGGREGATE SUBBASE	93 CY

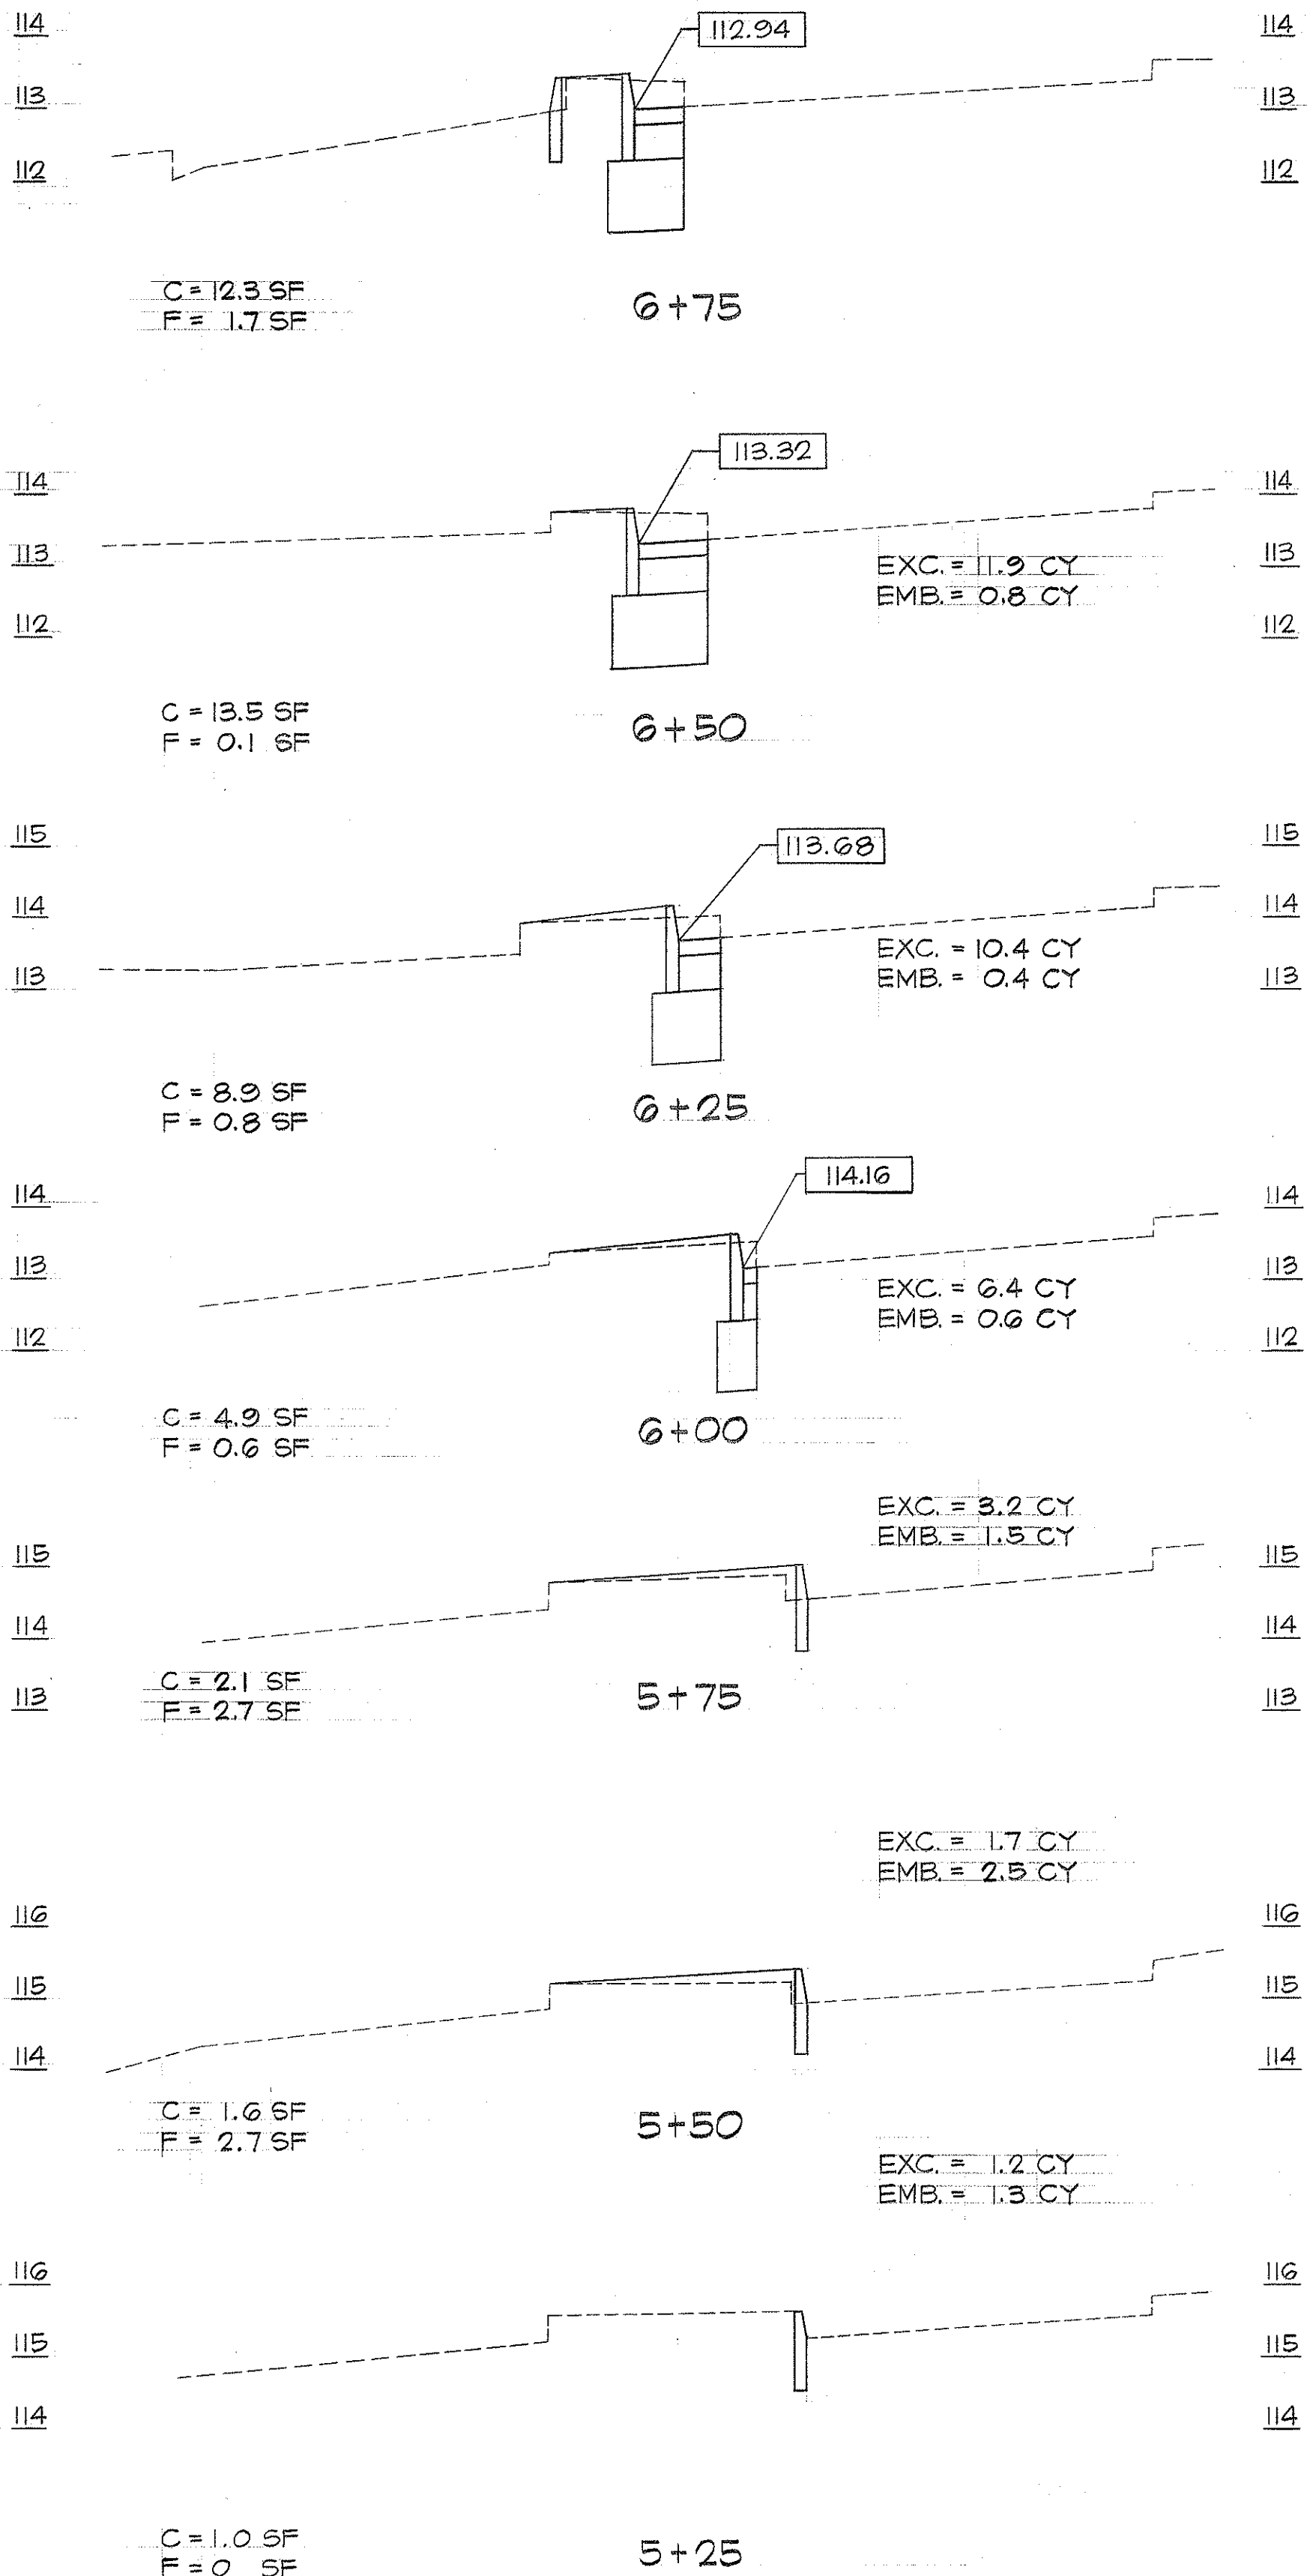

SCALES: HORIZ. 1"=10'
VERT. 1"=2'



THIS WORK WAS PREPARED BY ME
OR UNDER MY SUPERVISION
Theodore S. Kawahara
Signature

STATE OF HAWAII
DEPARTMENT OF TRANSPORTATION
HIGHWAYS DIVISION
KANE OHE BAY DRIVE
TRAFFIC SIGNALS AT
MAKALANI STREET
PROJECT NO. 6300A-01-79

CROSS SECTIONS

SCALE: AS SHOWN DATE: 6/21/79
SHEET NO. 1 OF 1 SHEETS

DATE	_____
SURVEY PLOTTED BY	_____
DRAWN BY	_____
DESIGNED BY	_____
CHECKED BY	_____
NOTE BOOK	_____
NO.	_____