	INDEX TO DRAWINGS
SHEET NO.	DESCRIPTION
1	TITLE SHEET
2	LEGEND AND NOTES
3	PLAN-NEW LEFT TURN LANES, STRIPING AND SIGNING
4	TRAFFIC SIGNAL PLAN
5	CROSS SECTIONS
6	MISCELLANEOUS DETAILS
7-8	TYPICAL DETAILS OF WHEEL CHAIR RAMPS
9-20	STANDARD DETAILS
.4'	
A CONTRACTOR OF THE CONTRACTOR	



STATE OF HAWAII



DEPARTMENT OF TRANSPORTATION HIGHWAYS DIVISION DIVISION


HONOLULU, HAWAII


"AS BUILT PLANS"

PLANS FOR

KANEOHE BAY DRIVE TRAFFIC SIGNALS AT MAKALANI STREET PROJECT NO. 6300A-01-79

> DISTRICT OF KOOLAUPOKO ISLAND OF OAHU

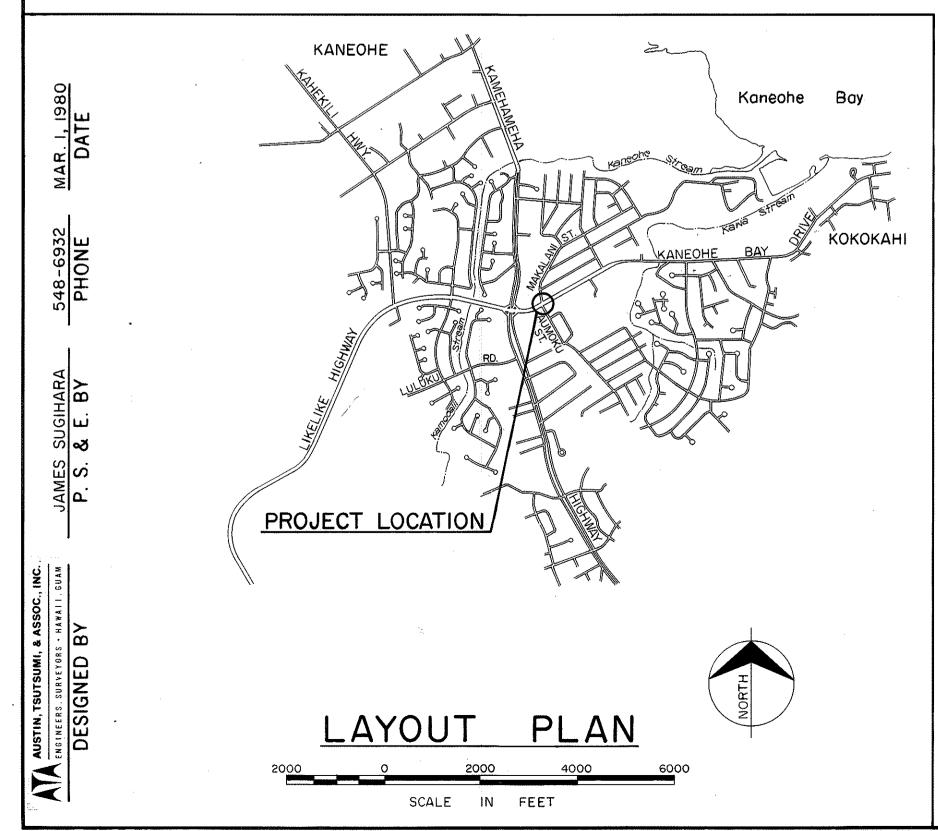

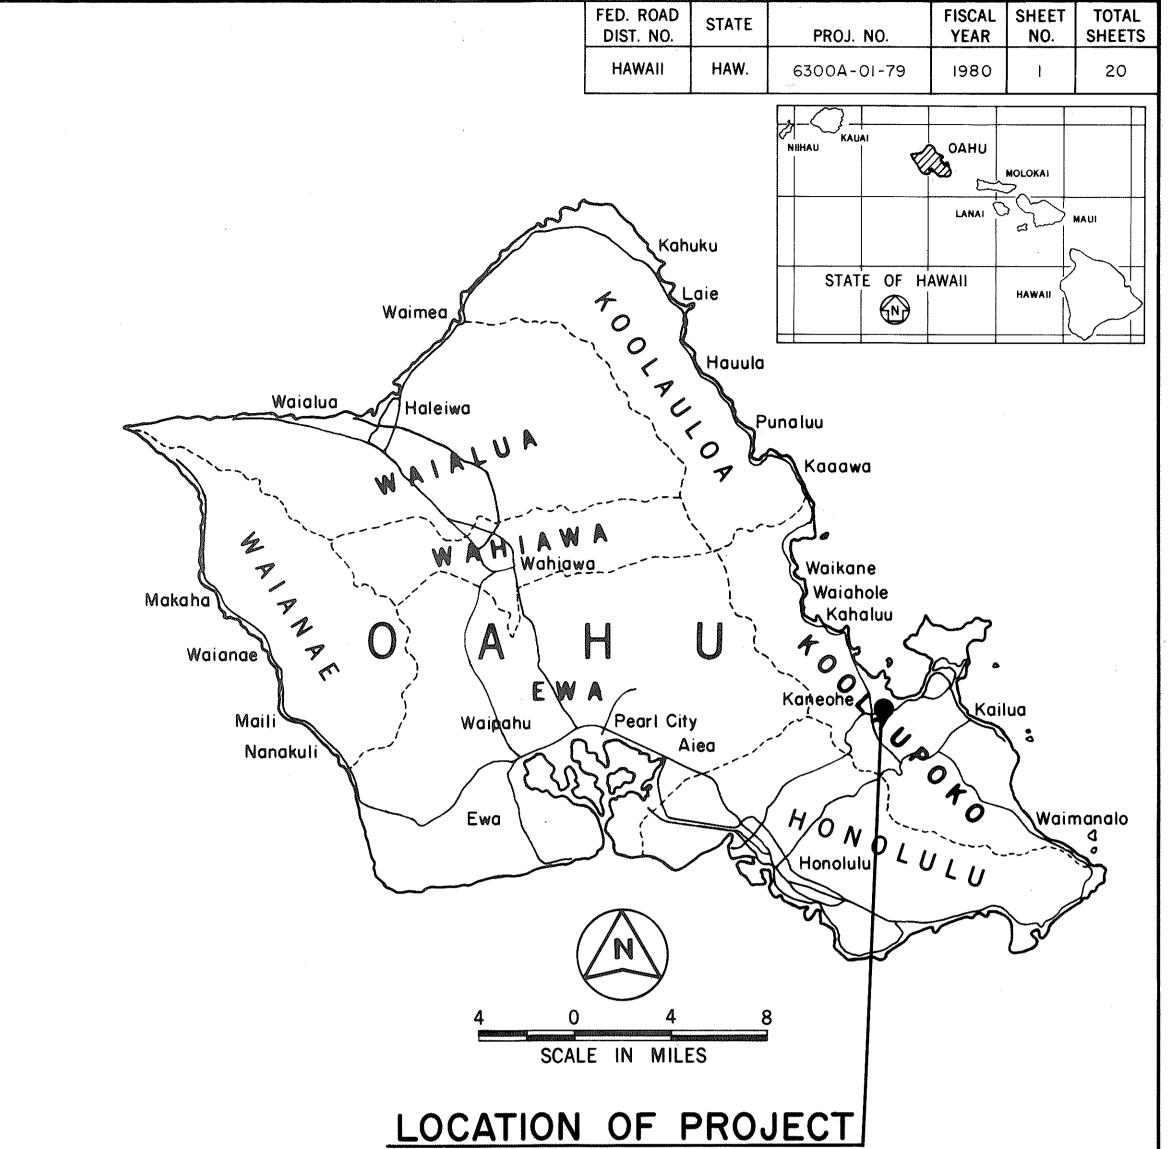

STATE

"ALL CHANGES MADE DURING CONSTRUCTION HAVE BEEN INCORPORATED ON THESE PLANS EXCEPT CHANGES IN THE ORIGINAL THEORETICAL QUANTITIES."

ROBERT ENGINEER

DEPARTMENT OF TRANSPO STATE OF HAWAII	RTATION
APPROVED:	
James Z. Carras	3/1/50
ADIR. OF TRANSPORTATION	DATE

JOB NO. 2401.IE