


FED. ROAD DIST. NO.	STATE	FED. AID PROJ. NO.	FISCAL YEAR	SHEET NO.	TOTAL SHEETS
HAWAII	HAW.	HES-6300(1)	1984	7	23

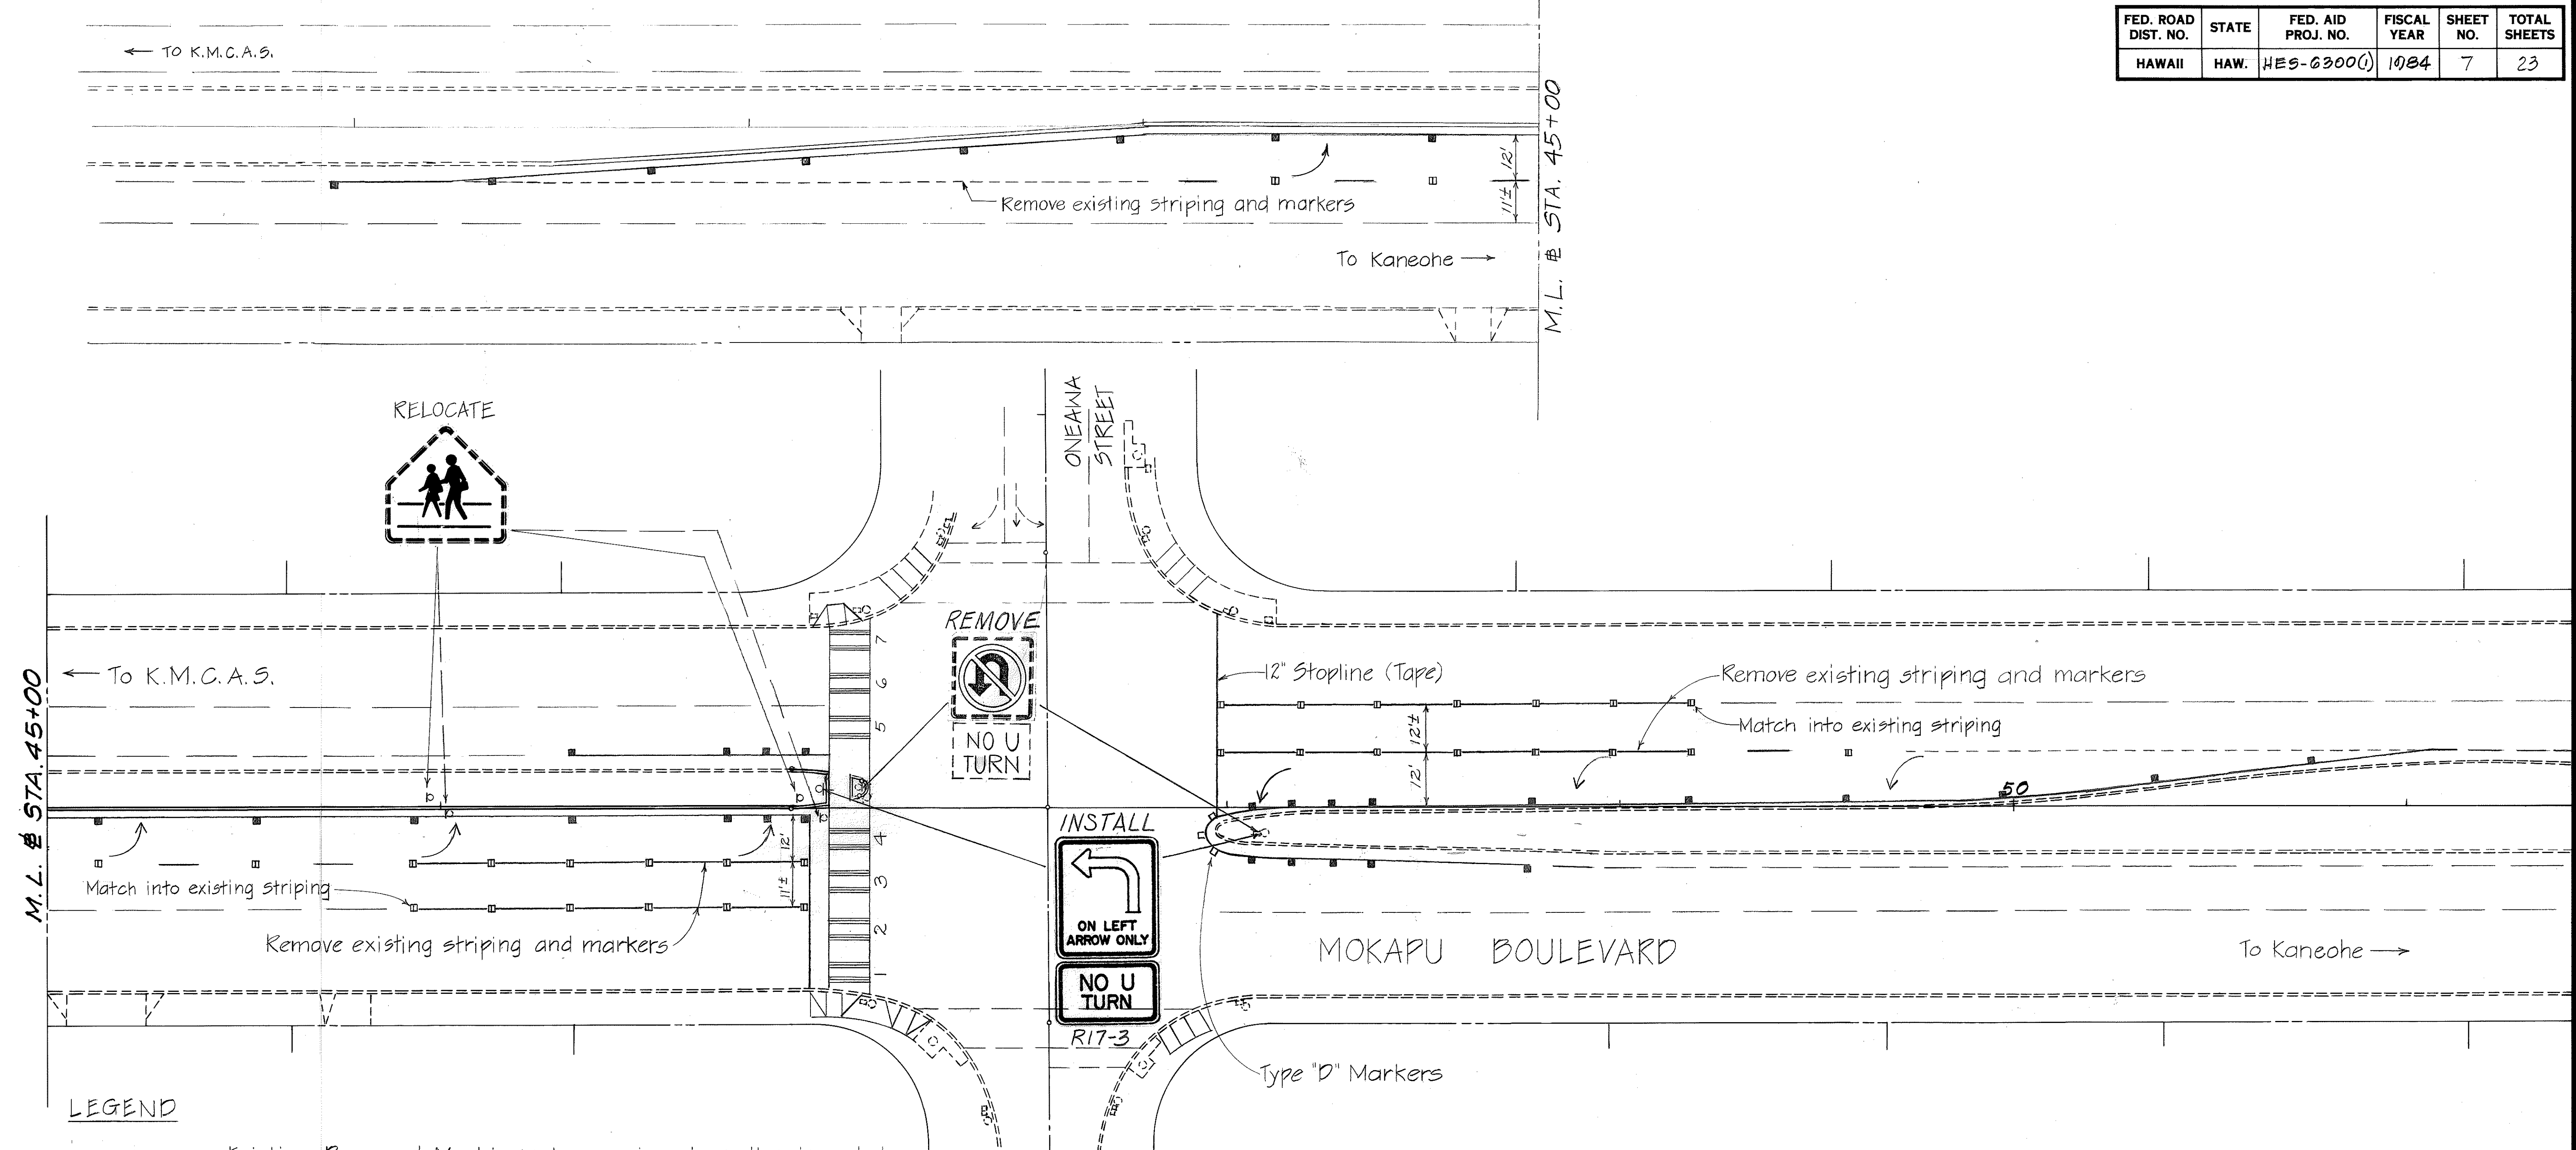

LEGEND

- — — Existing Pavement Markings to remain unless otherwise noted.
- — □ — 4 each Type "A" Raised Pavement Markers
- — □ — Type "C" Raised Pavement Markers @ 40'-0" o.c.
- — □ — 8" White Stripe (Tape) with Type "C" Raised Pavement Markers @ 20'-0" o.c.
- — □ — 4" Yellow Stripe (Paint) with Type "H" Raised Pavement Markers placed on traffic-side of stripe. Spacings as shown on plans.
- 1 2 Crosswalk (Tape) and 12" Stopline (Tape). Numbers indicate the number of lanes for payment of crosswalk.
- ↗ Pavement Arrow (Tape)
- - - 4" White Guide Lines (Paint)

NOTES:

1. Existing signs not shown on these plans shall remain as posted unless otherwise directed by the Engineer.
2. Final locations of all signs shall be approved by the Engineer.
3. The Contractor shall install raised pavement markers to replace existing markers that are missing within the limits between Sta. 42+00± and Sta. 51+00±, as directed by the Engineer. Payment will be made by force account.

DATE	_____
SURVEY PLOTTED BY	_____
DRAWN BY	_____
TRACED BY	_____
QUANTITIES BY	_____
CHECKED BY	_____
ORIGINAL PLAN	_____
NOTE BOOK	_____
No.	_____

STATE OF HAWAII
DEPARTMENT OF TRANSPORTATION
HIGHWAYS DIVISION

**SIGNING AND
PAVEMENT MARKING PLAN**

MOKAPU BOULEVARD
MODERNIZATION OF TRAFFIC SIGNALS
AT ONEAWA STREET

F.A. Project No. HES-6300(1)

SCALE: 1"=20' DATE: Nov., 1983

SHEET No. 1 OF 1 SHEETS