


FED. ROAD DIST. NO.	STATE	FED. AID PROJ. NO.	FISCAL YEAR	SHEET NO.	TOTAL SHEETS
HAWAII	HAW.	HE5-6300(1)	1984	8	23

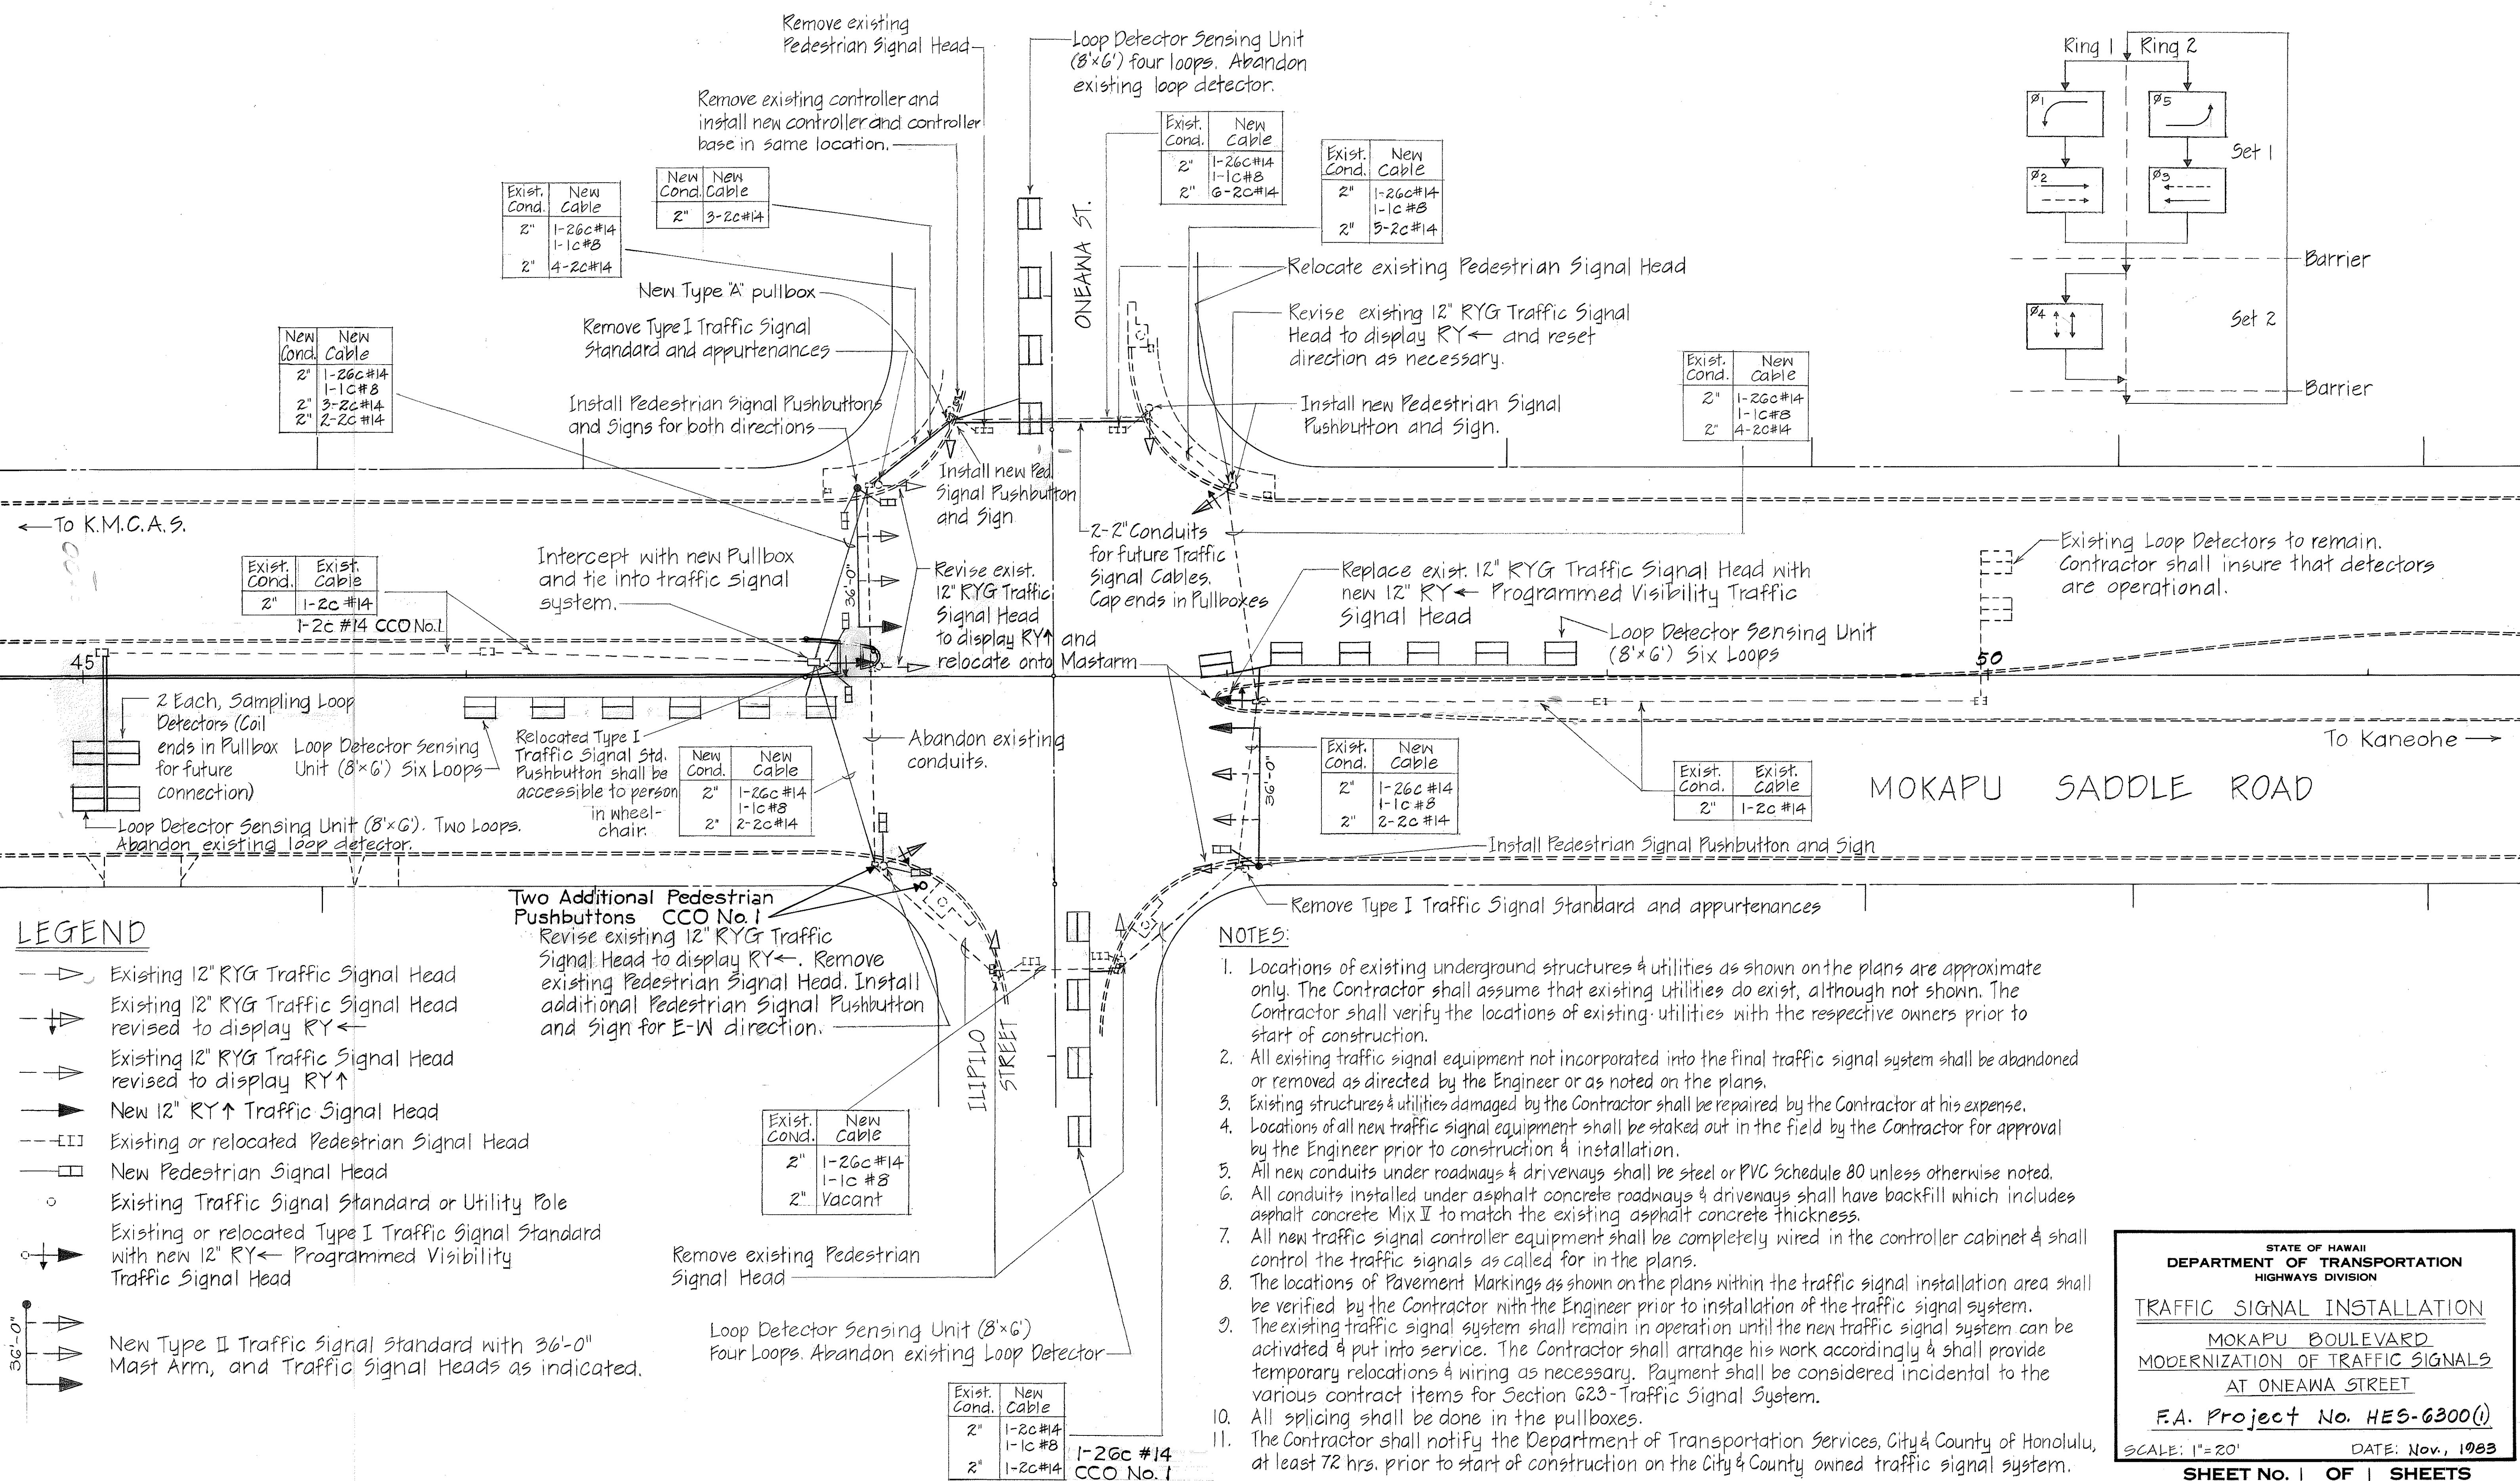

ORIGINAL PLAN	SURVEY PLOTTED BY _____	DATE _____
NOTE BOOK	DRAWN BY _____	_____
	TRACED BY _____	_____
	DESIGNED BY _____	_____
	QUANTITIES BY _____	_____
	CHECKED BY _____	_____
No. _____		

STATE OF HAWAII
DEPARTMENT OF TRANSPORTATION
HIGHWAYS DIVISION

TRAFFIC SIGNAL INSTALLATION
MOKAPU BOULEVARD
MODERNIZATION OF TRAFFIC SIGNALS
AT ONEAWA STREET
F.A. Project No. HES-6300(1)

SCALE: 1"=20' DATE: Nov., 1963

SHEET No. | OF | SHEETS