
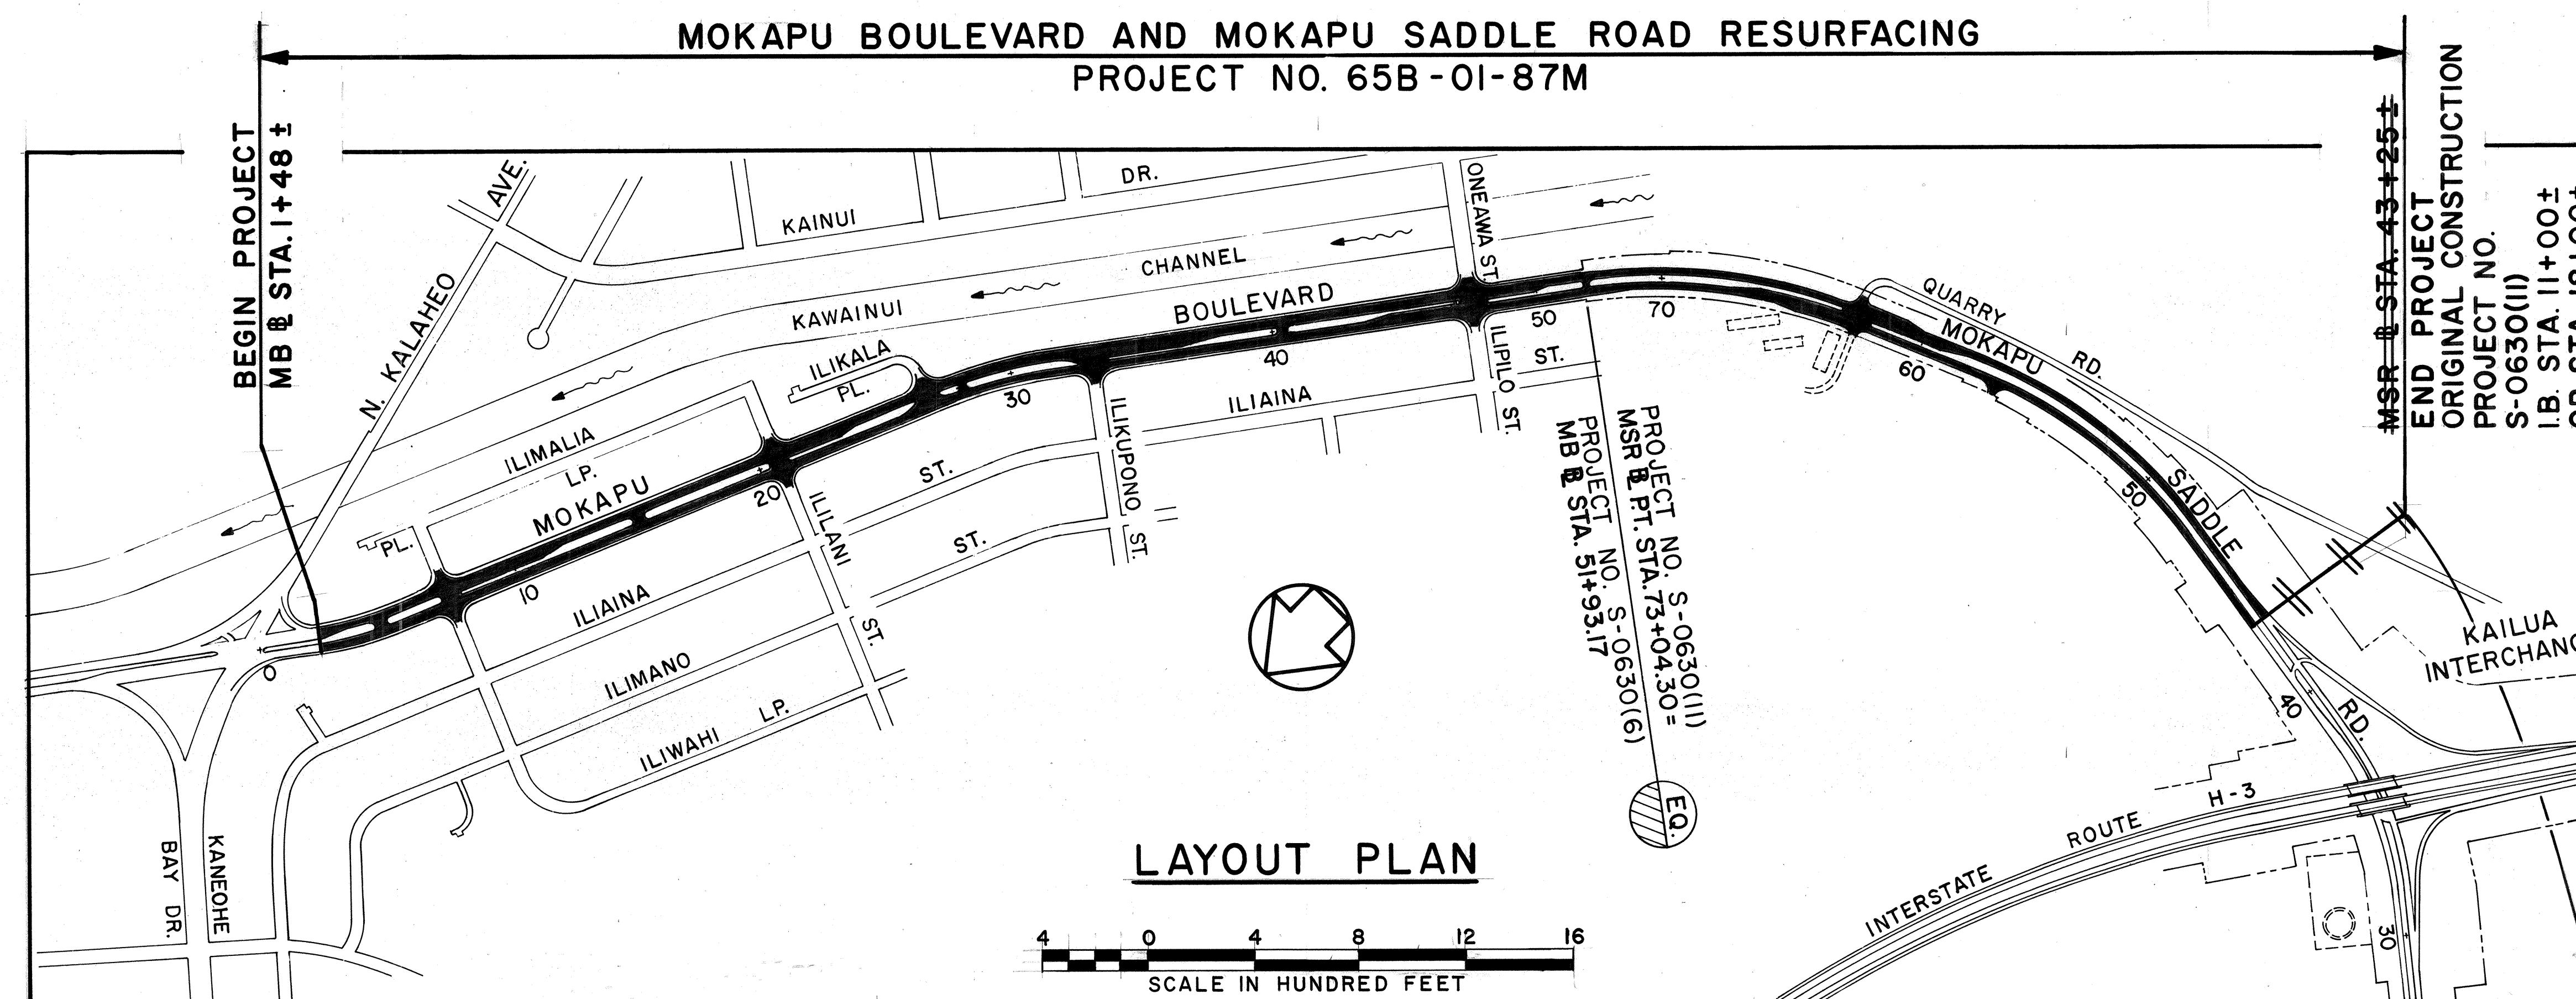


[illegible]

STATE OF HAWAII
DEPARTMENT OF TRANSPORTATION
HIGHWAYS DIVISION
HONOLULU, HAWAII
"AS-BUILT"
PLANS FOR
MOKAPU BOULEVARD
AND
MOKAPU SADDLE ROAD RESURFACING
KALAHEO AVENUE TO KAILUA INTERCHANGE
PROJECT NO. 65B - 01 - 87M

FED. ROAD DIST. NO.	STATE	PROJ. NO.	FISCAL YEAR	SHEET NO.	TOTAL SHEET
HAWAII	HAW.	65B-01-87M	1987	1	15

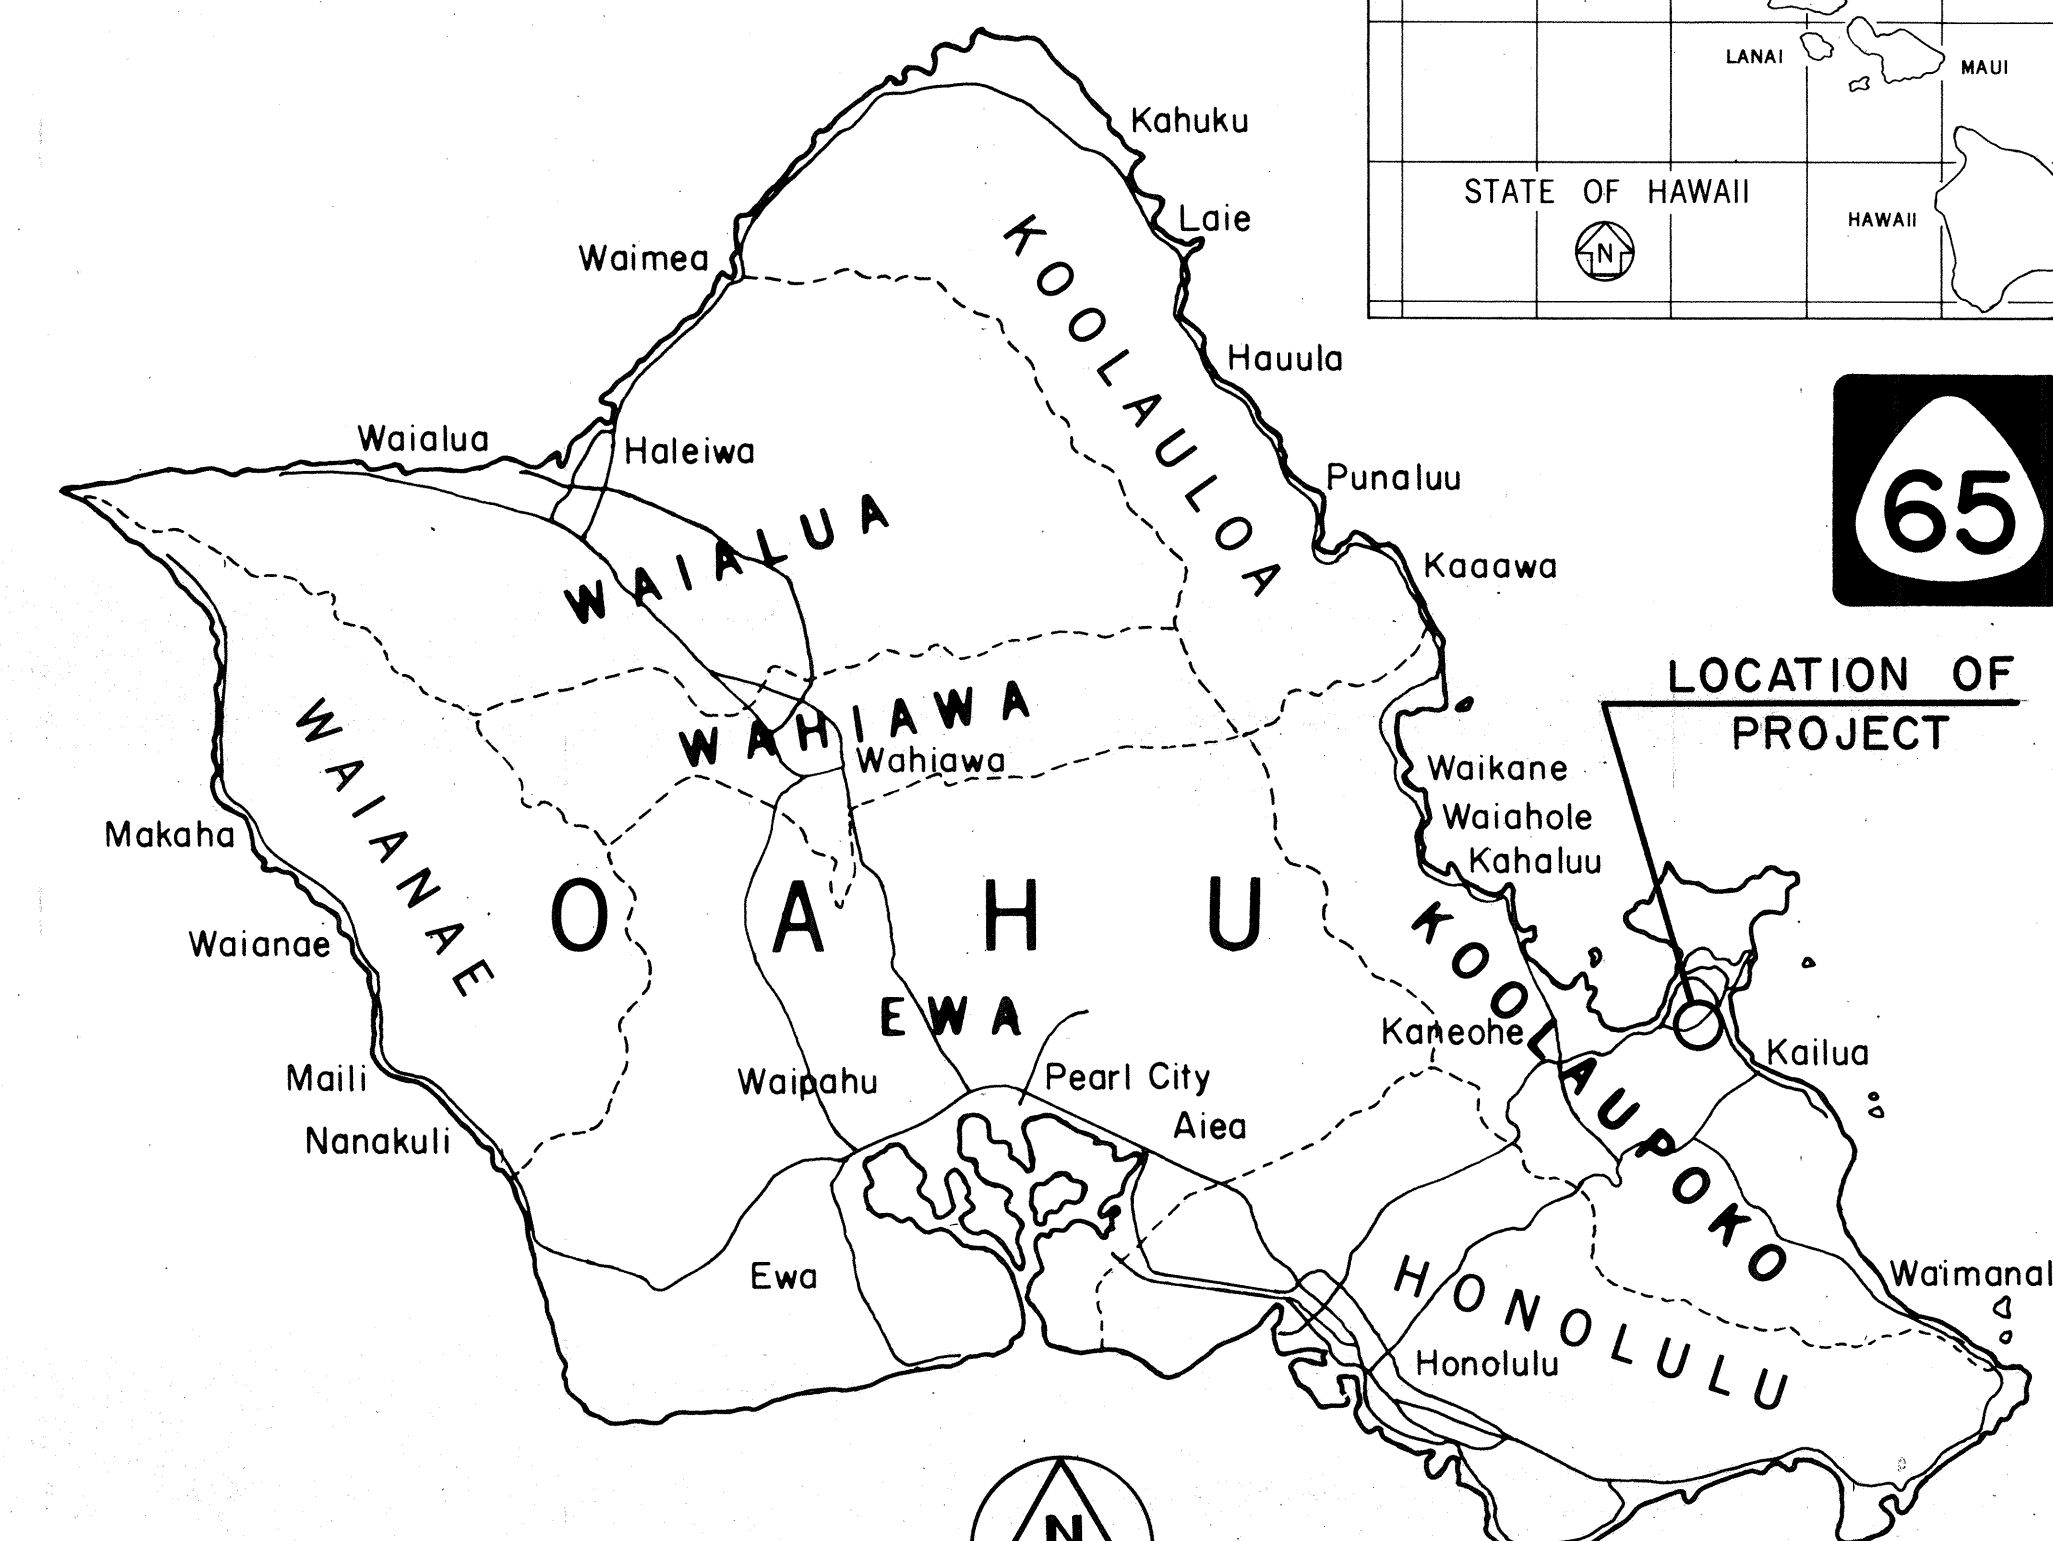

CHANGES MADE DURING CONSTRUCTION HAVE
BEEN INCORPORATED ON THESE PLANS EXCEPT
CHANGES IN THE ORIGINAL THEORETICAL
QUANTITIES. FOR ACTUAL QUANTITIES, REFER TO
PROJECT LEDGER AND/OR COMPUTATION BOOK.

<p>DEPARTMENT OF TRANSPORTATION STATE OF HAWAII</p>	
<p>APPROVED:</p> <p><i>[Signature]</i></p> <p>_____ DIR. OF TRANSPORTATION</p>	<p><i>11/10/83</i></p> <p>_____ DATE</p>

ALLAN T. NISHIMURA
DESIGNED BY
A. NISHIMURA
P. S. & E. BY
548-7490
PHONE
OCT., 1986
DATE