




FED. ROAD DIST. NO.	STATE	PROJ. NO.	FISCAL YEAR	SHEET NO.	TOTAL SHEETS
HAWAII	HAW.	65B-01-87M	1987	4	15

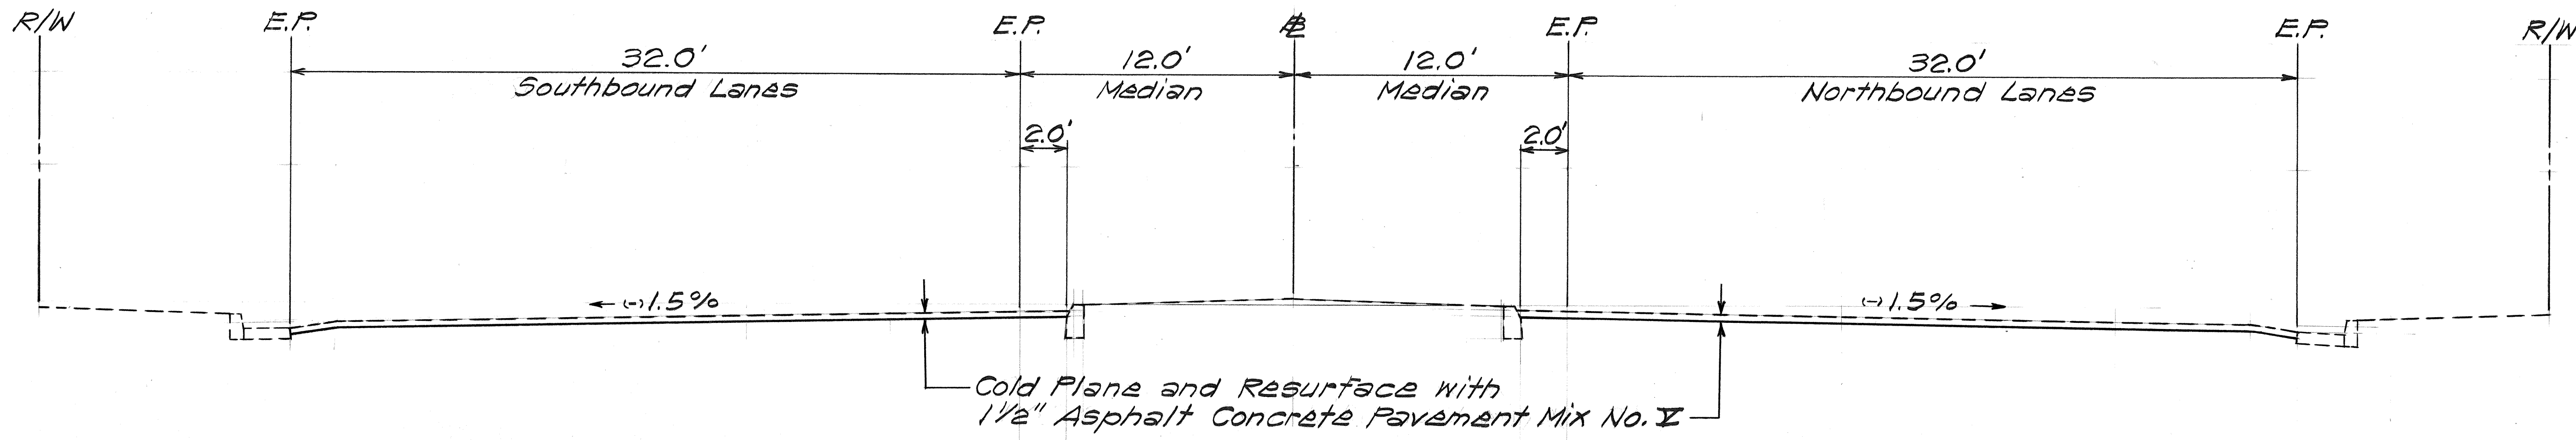


TYPICAL TANGENT SECTION
 Horiz. Scale: 1/4"=1'-0"
 Vert. Scale: Not to Scale

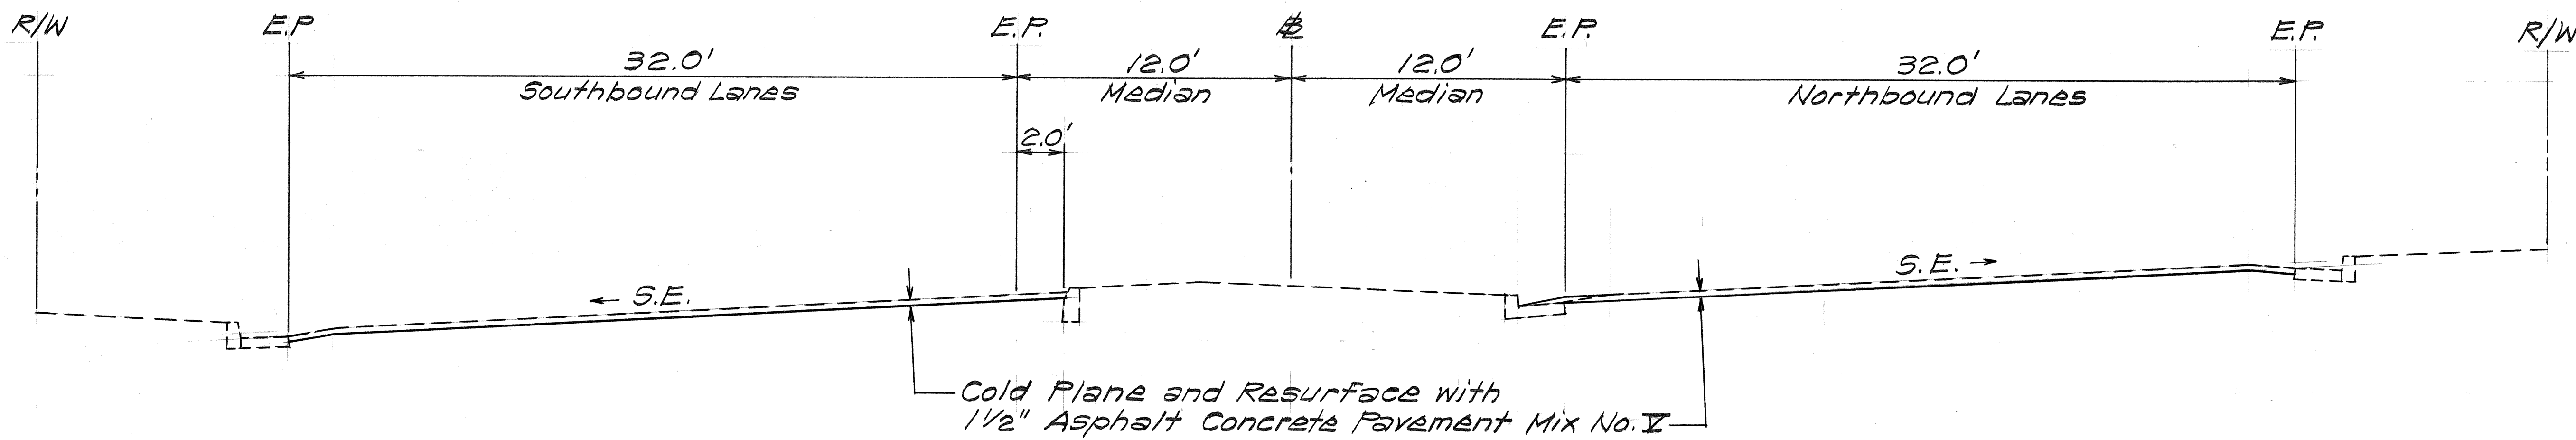

TYPICAL CURVE SECTION
 Horiz. Scale: 1/4"=1'-0"
 Vert. Scale: Not to Scale

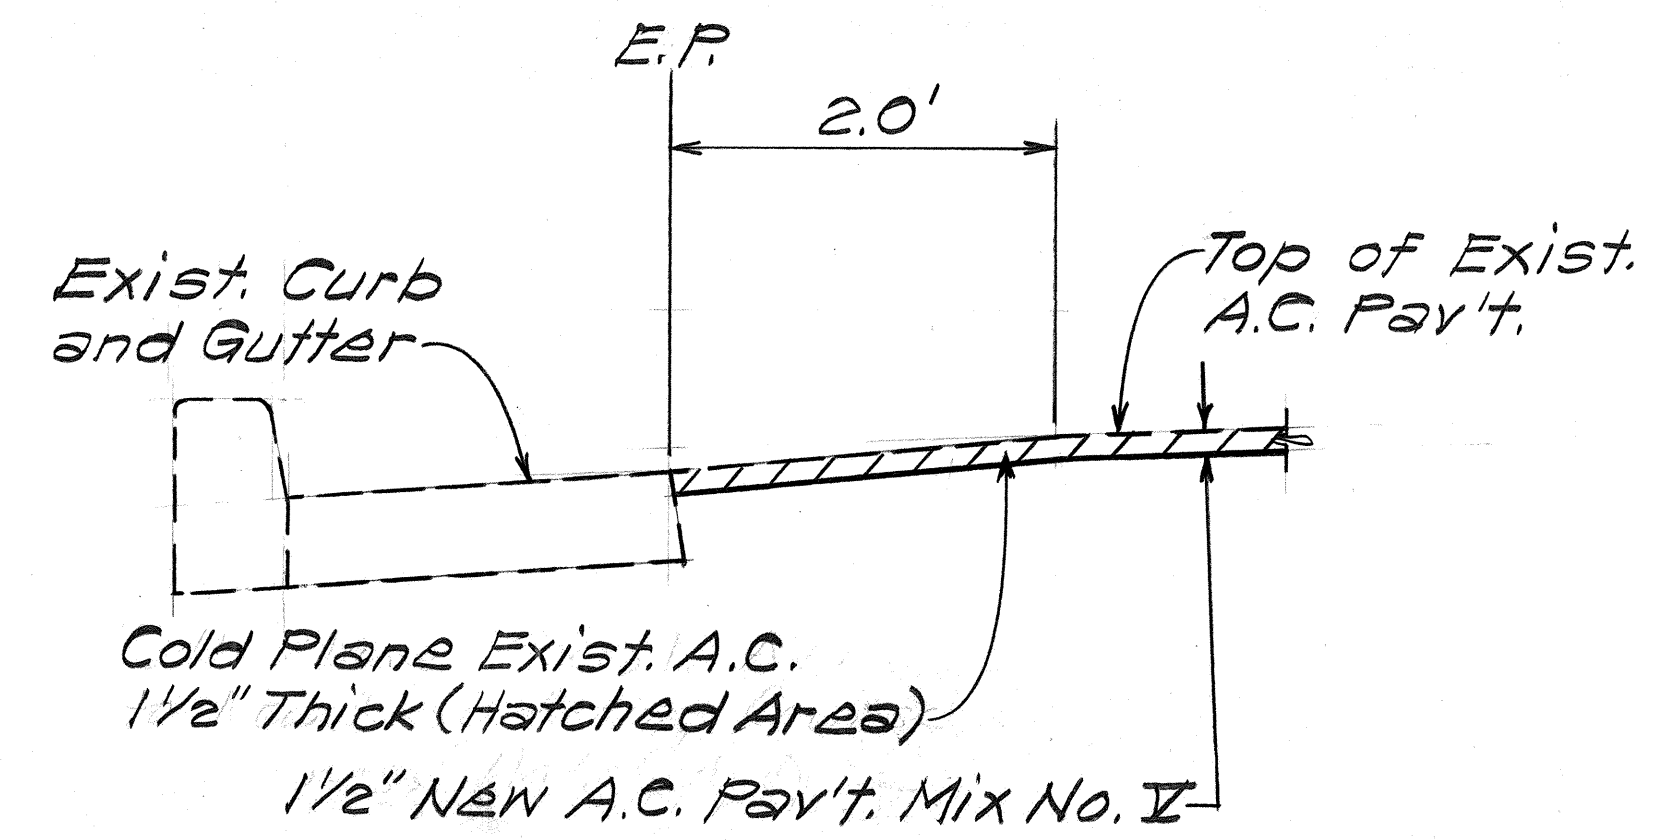

TYPICAL SECTION AT CURB AND GUTTER (SHOULDER SECTION)
 Scale: 1"=1'-0"

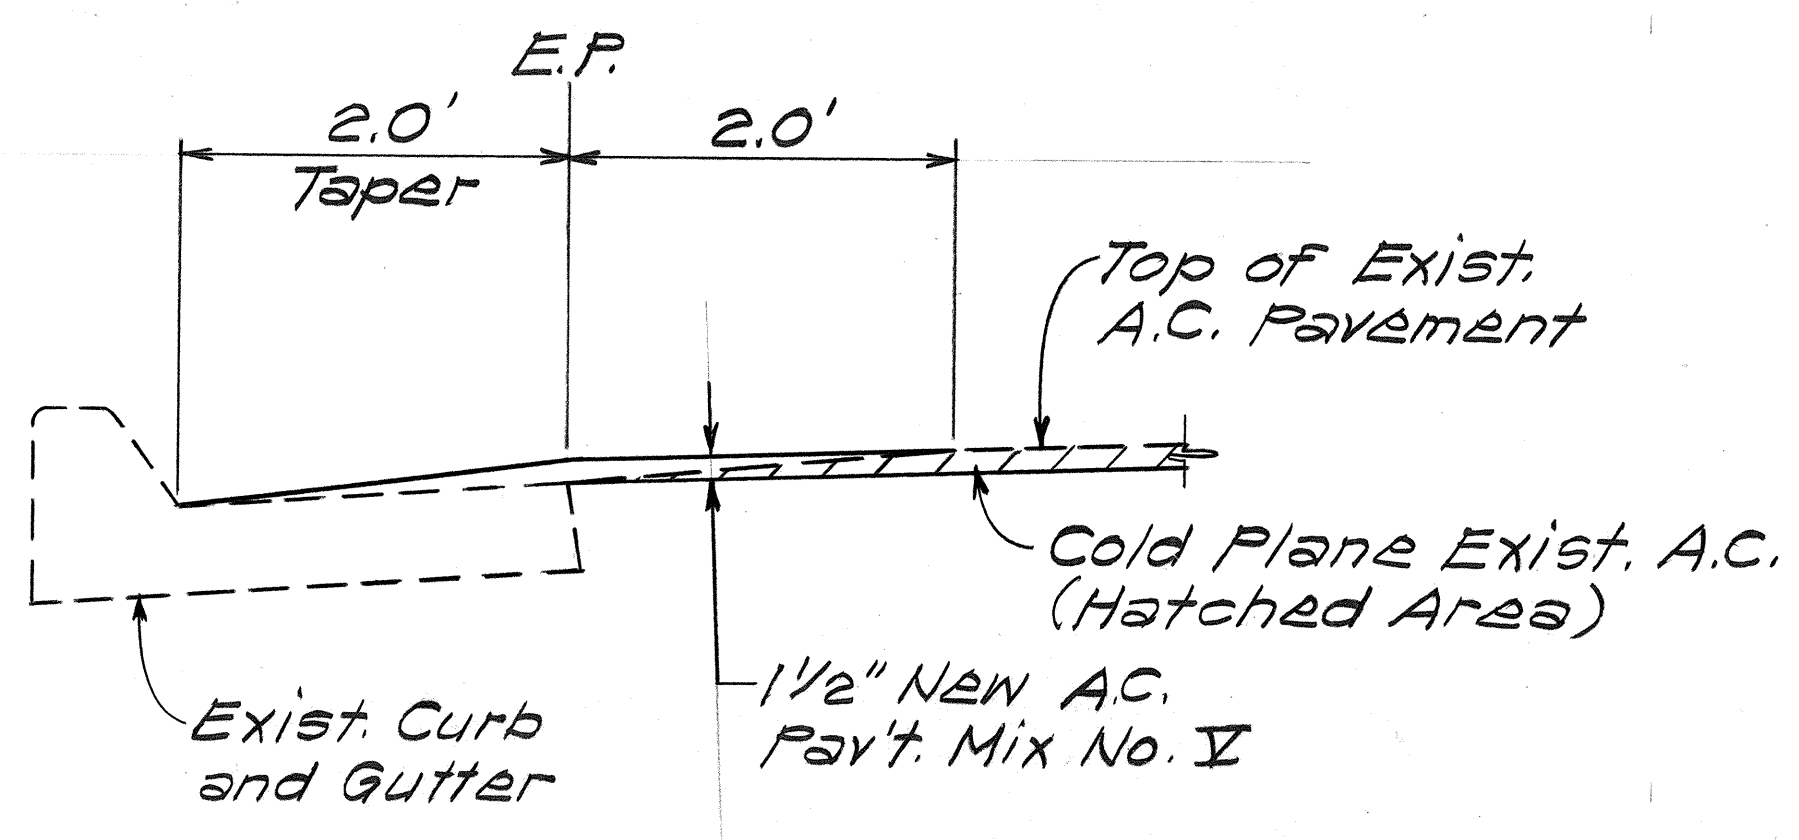

TYPICAL SECTION AT CURB AND GUTTER (MEDIAN SECTION)
 M.B. # STA. 1+48± TO M.B. # STA. 6+00±
 Scale: 1"=1'-0"

MOKAPU BOULEVARD


STATE OF HAWAII
DEPARTMENT OF TRANSPORTATION
HIGHWAYS DIVISION

TYPICAL SECTIONS


MOKAPU BOULEVARD AND
MOKAPU SADDLE ROAD RESURFACING
Proj. No. 65B-01-87M
Scale: As Shown Date: Sept, 1986
SHEET NO. 1 OF 3 SHEETS

SURVEY PLOTTED BY	DATE
DRAWN BY	
TRACED BY	
NOTED BY	
CHECKED BY	
NO.	


FED. ROAD DIST. NO.	STATE	PROJ. NO.	FISCAL YEAR	SHEET NO.	TOTAL SHEETS
HAWAII	HAW.	65B-01-87M	1987	5	15

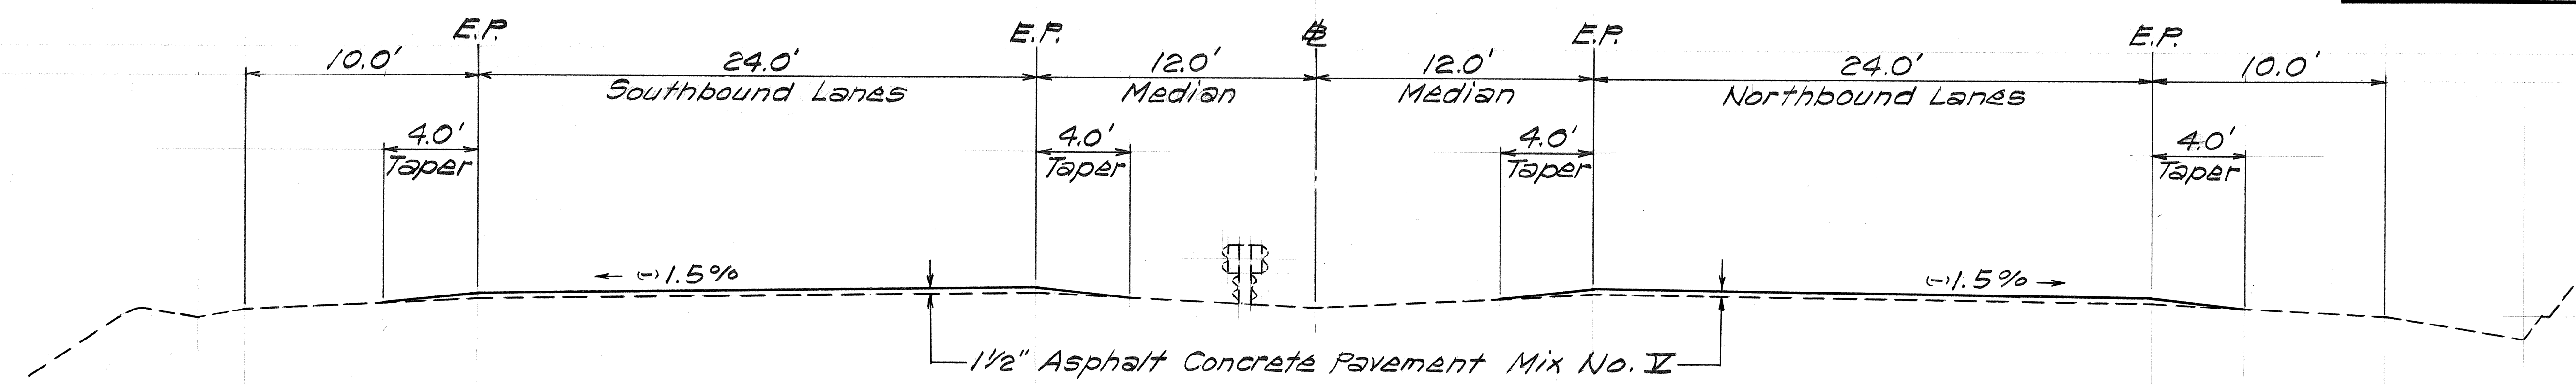


TYPICAL TANGENT SECTION
 Horiz. Scale: 1/4" = 1'-0"
 Vert. Scale: Not to Scale

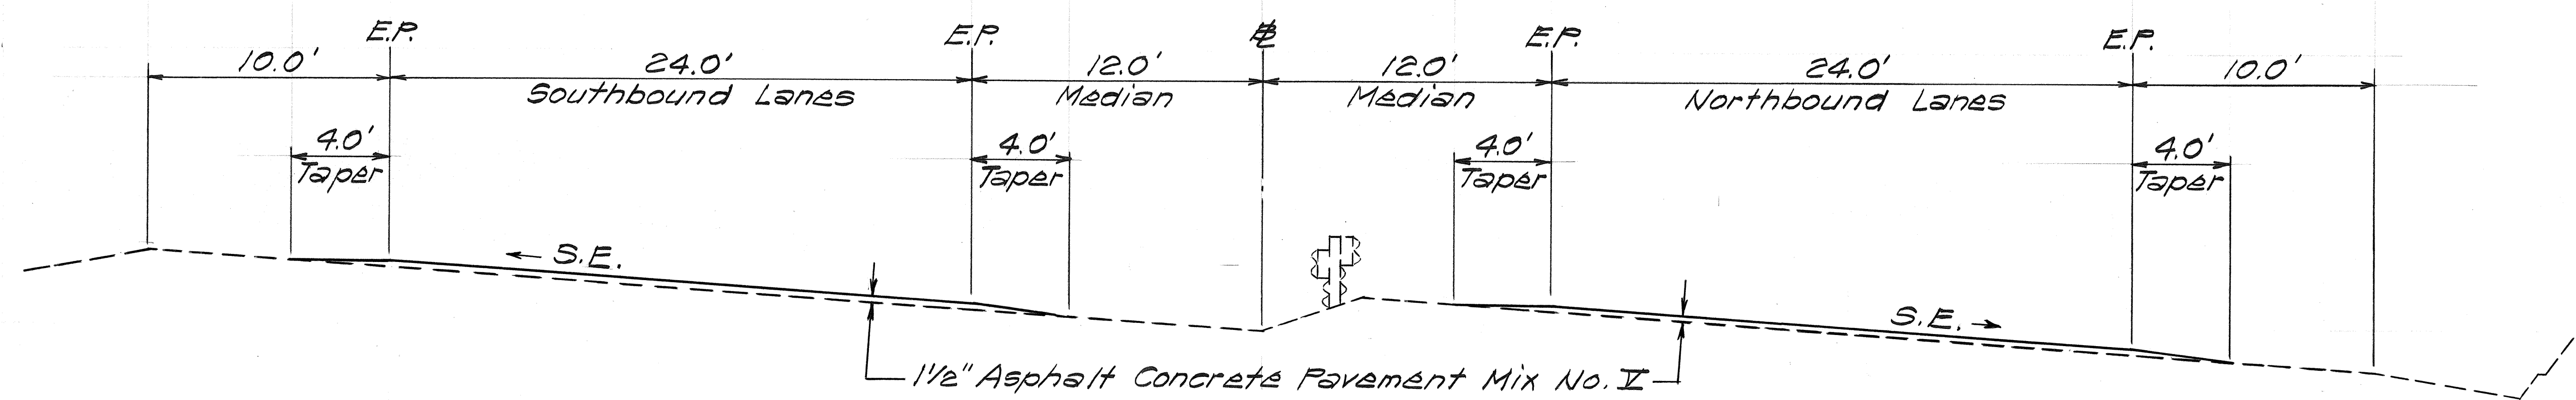

TYPICAL CURVE SECTION
 Horiz. Scale: 1/4" = 1'-0"
 Vert. Scale: Not to Scale

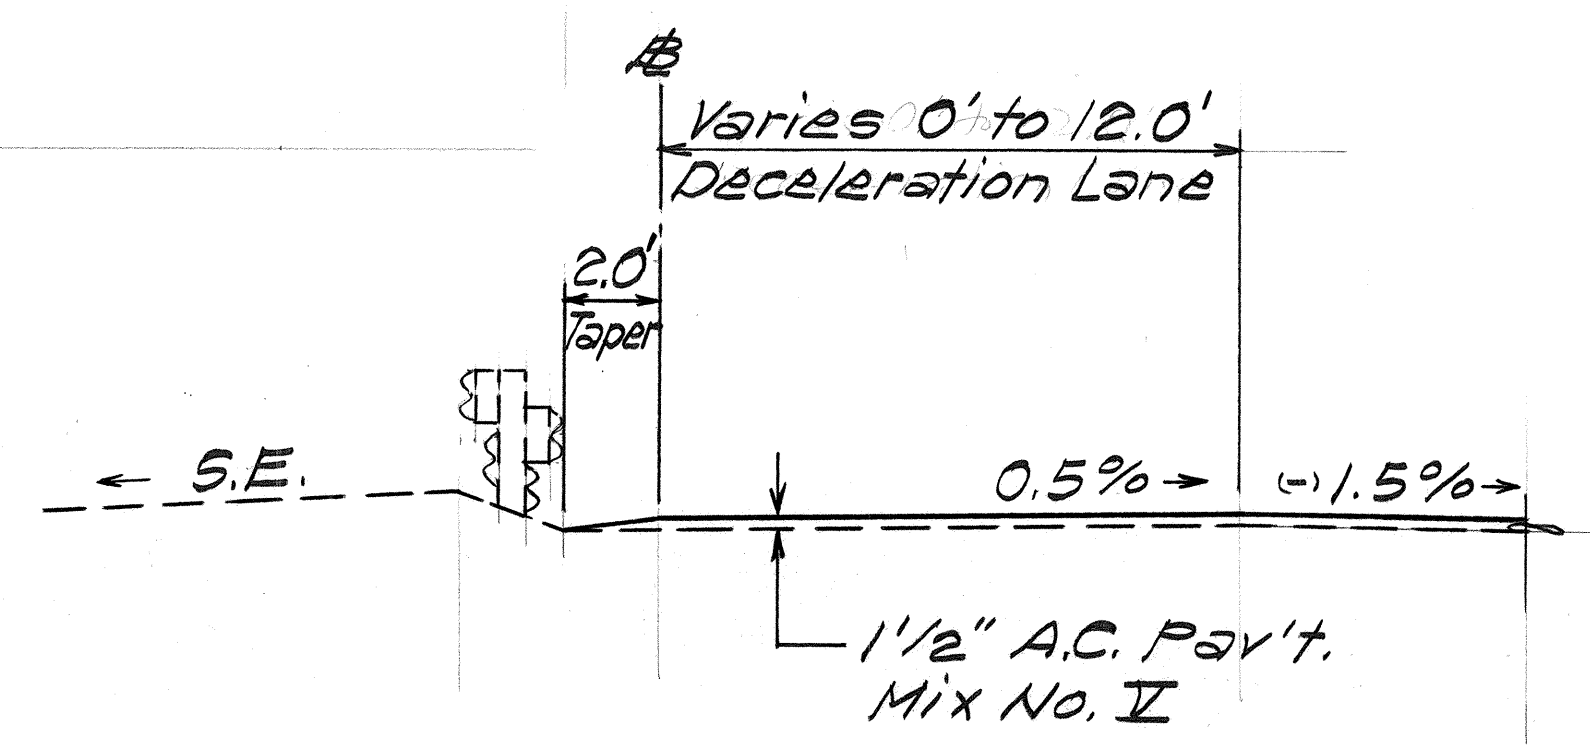

TYPICAL SECTION AT MEDIAN DECEL. LANE
 Horiz. Scale: 1/4" = 1'-0"
 Vert. Scale: Not to Scale

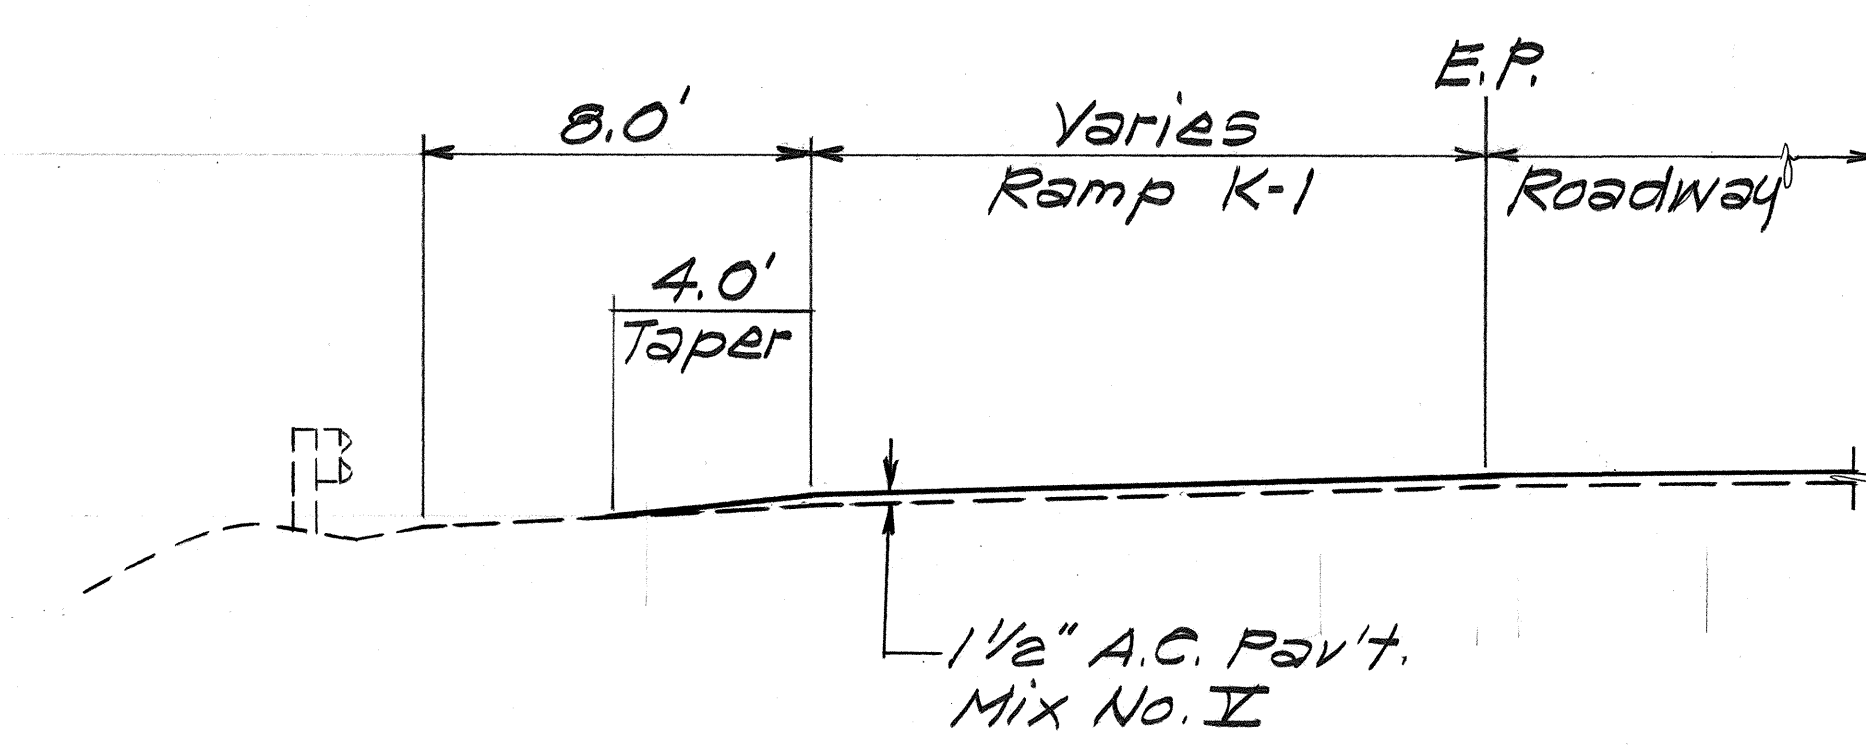

TYPICAL SECTION INTERSTATE RAMP K-1
 Horiz. Scale: 1/4" = 1'-0"
 Vert. Scale: Not to Scale

MOKAPU SADDLE ROAD


STATE OF HAWAII
 DEPARTMENT OF TRANSPORTATION
 HIGHWAYS DIVISION

TYPICAL SECTIONS


MOKAPU BOULEVARD AND
 MOKAPU SADDLE ROAD RESURFACING
 Proj. No. 65B-01-87M
 Scale: As Shown Date: Oct, 1986
 SHEET NO. 2 OF 3 SHEETS

SURVEY PLOTTED BY	DATE
DRAWN BY	
TRACED BY	
QUANTITIES BY	
CHECKED BY	
ORIGINAL PLAN	
NOTE BOOK	
No.	


FED. ROAD DIST. NO.	STATE	PROJ. NO.	FISCAL YEAR	SHEET NO.	TOTAL SHEETS
HAWAII	HAW.	65B-01-87M	1987	6	15

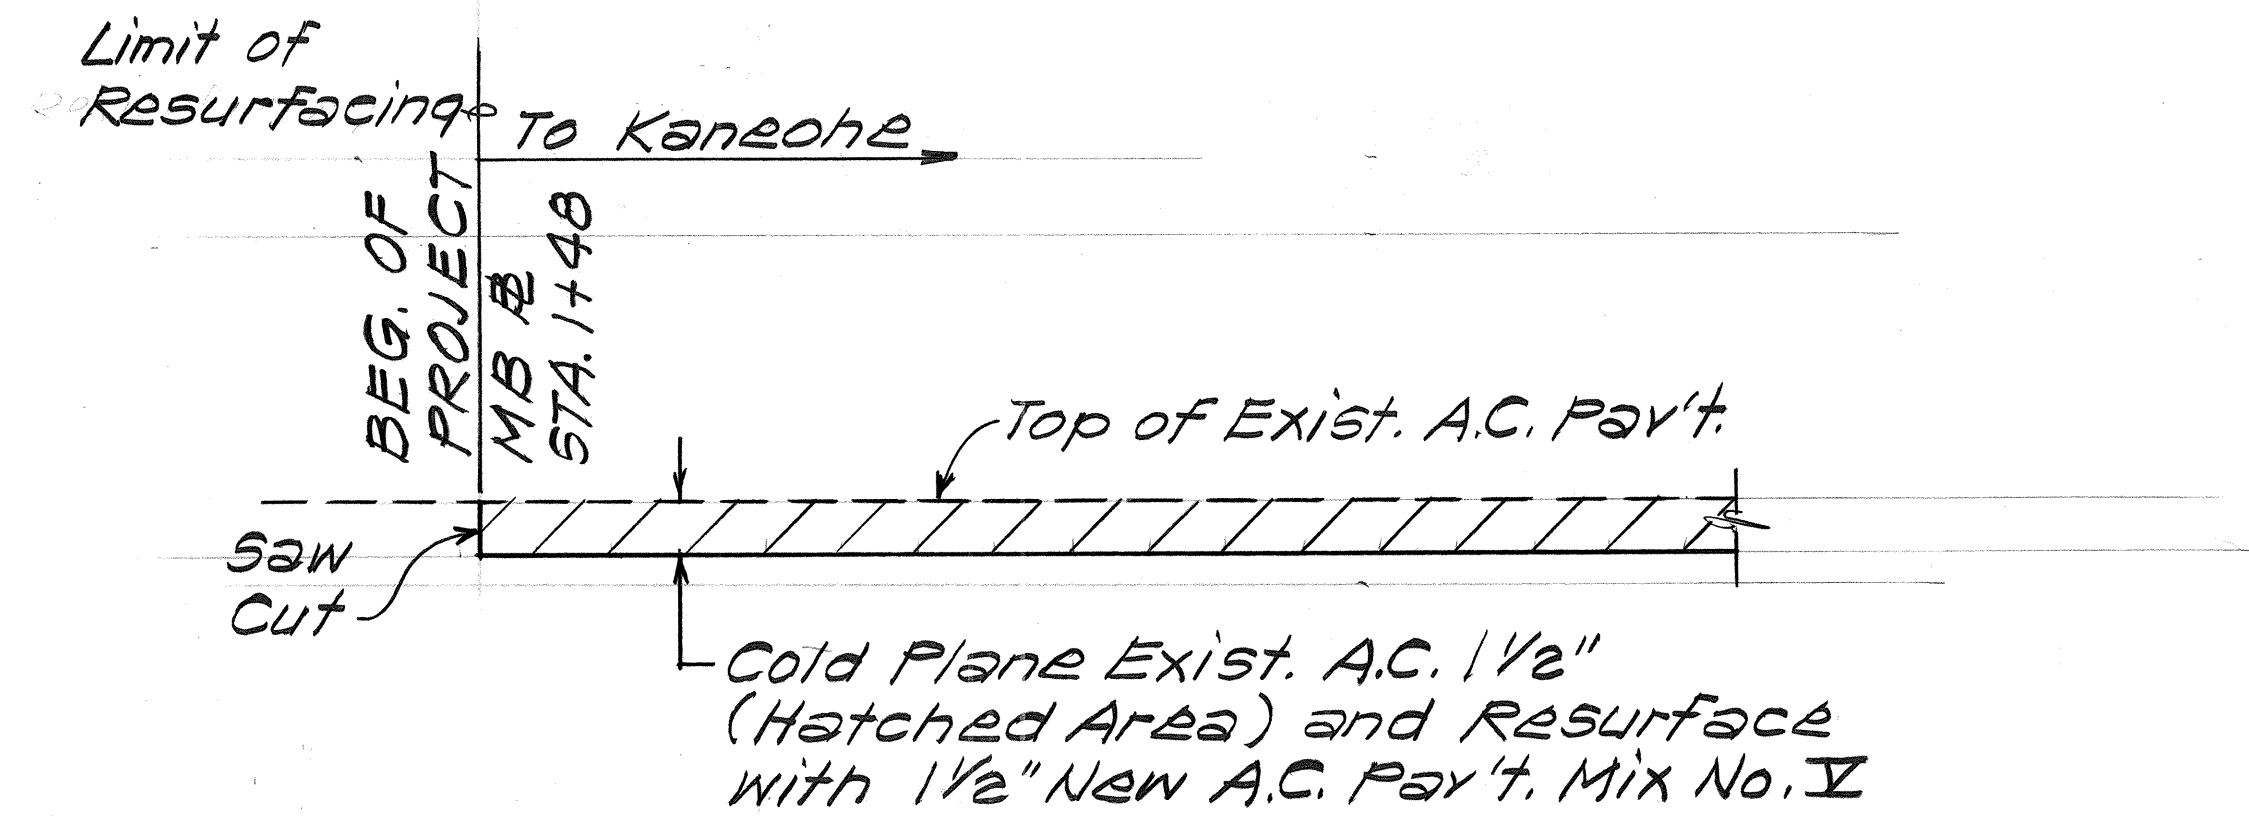


**COLD PLANING DETAIL
AT BEGINNING OF PROJECT**
Not to Scale

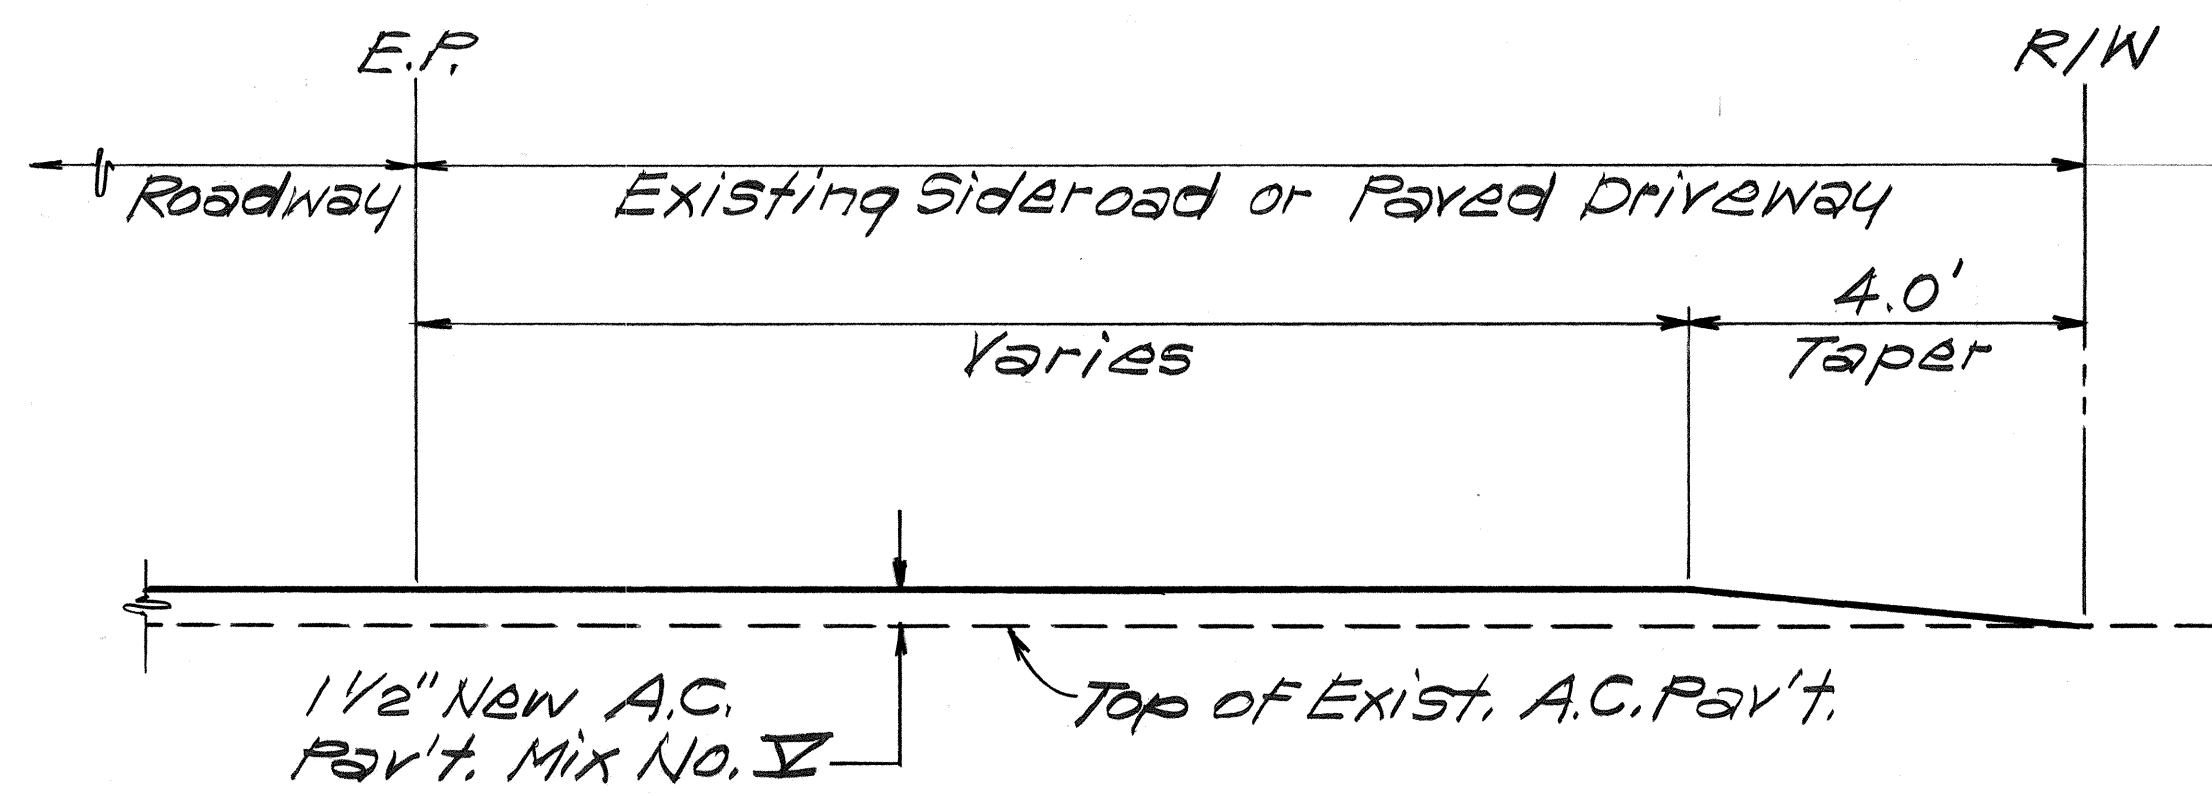


**RESURFACING AT PAVED SIDEROAD
OR PAVED DRIVEWAY DETAIL**
Not to Scale

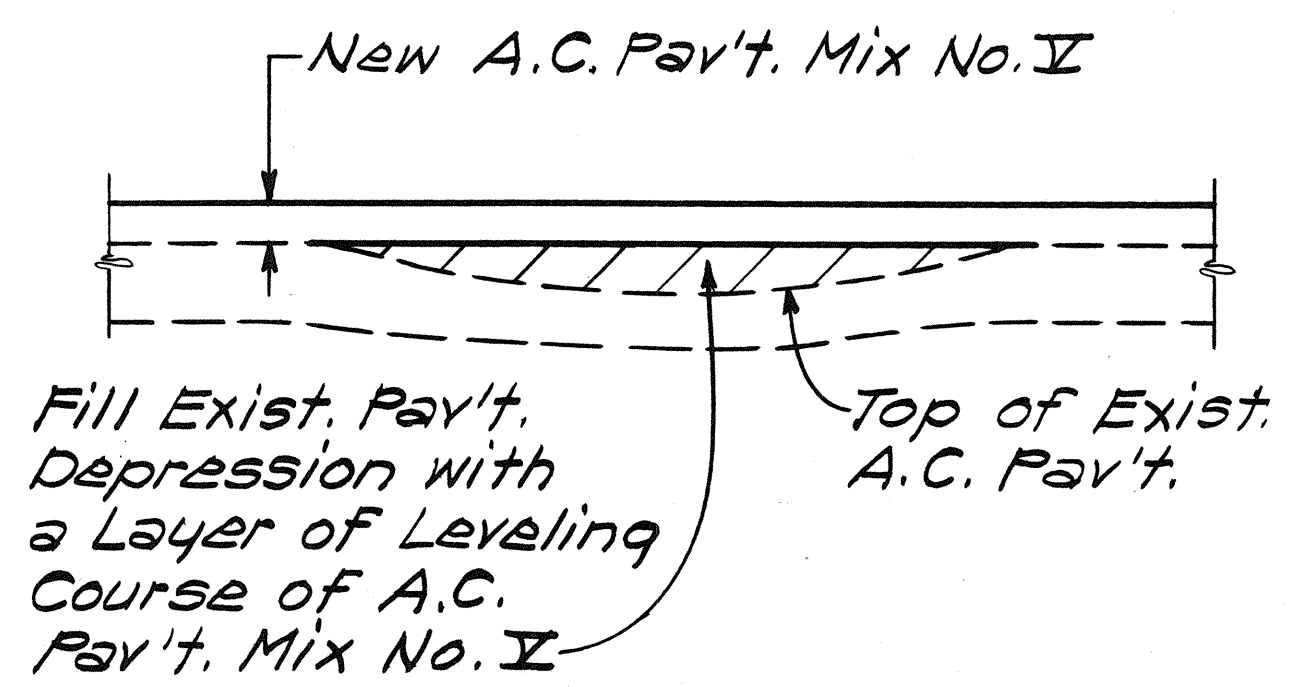


LEVELING COURSE DETAIL
Not to Scale

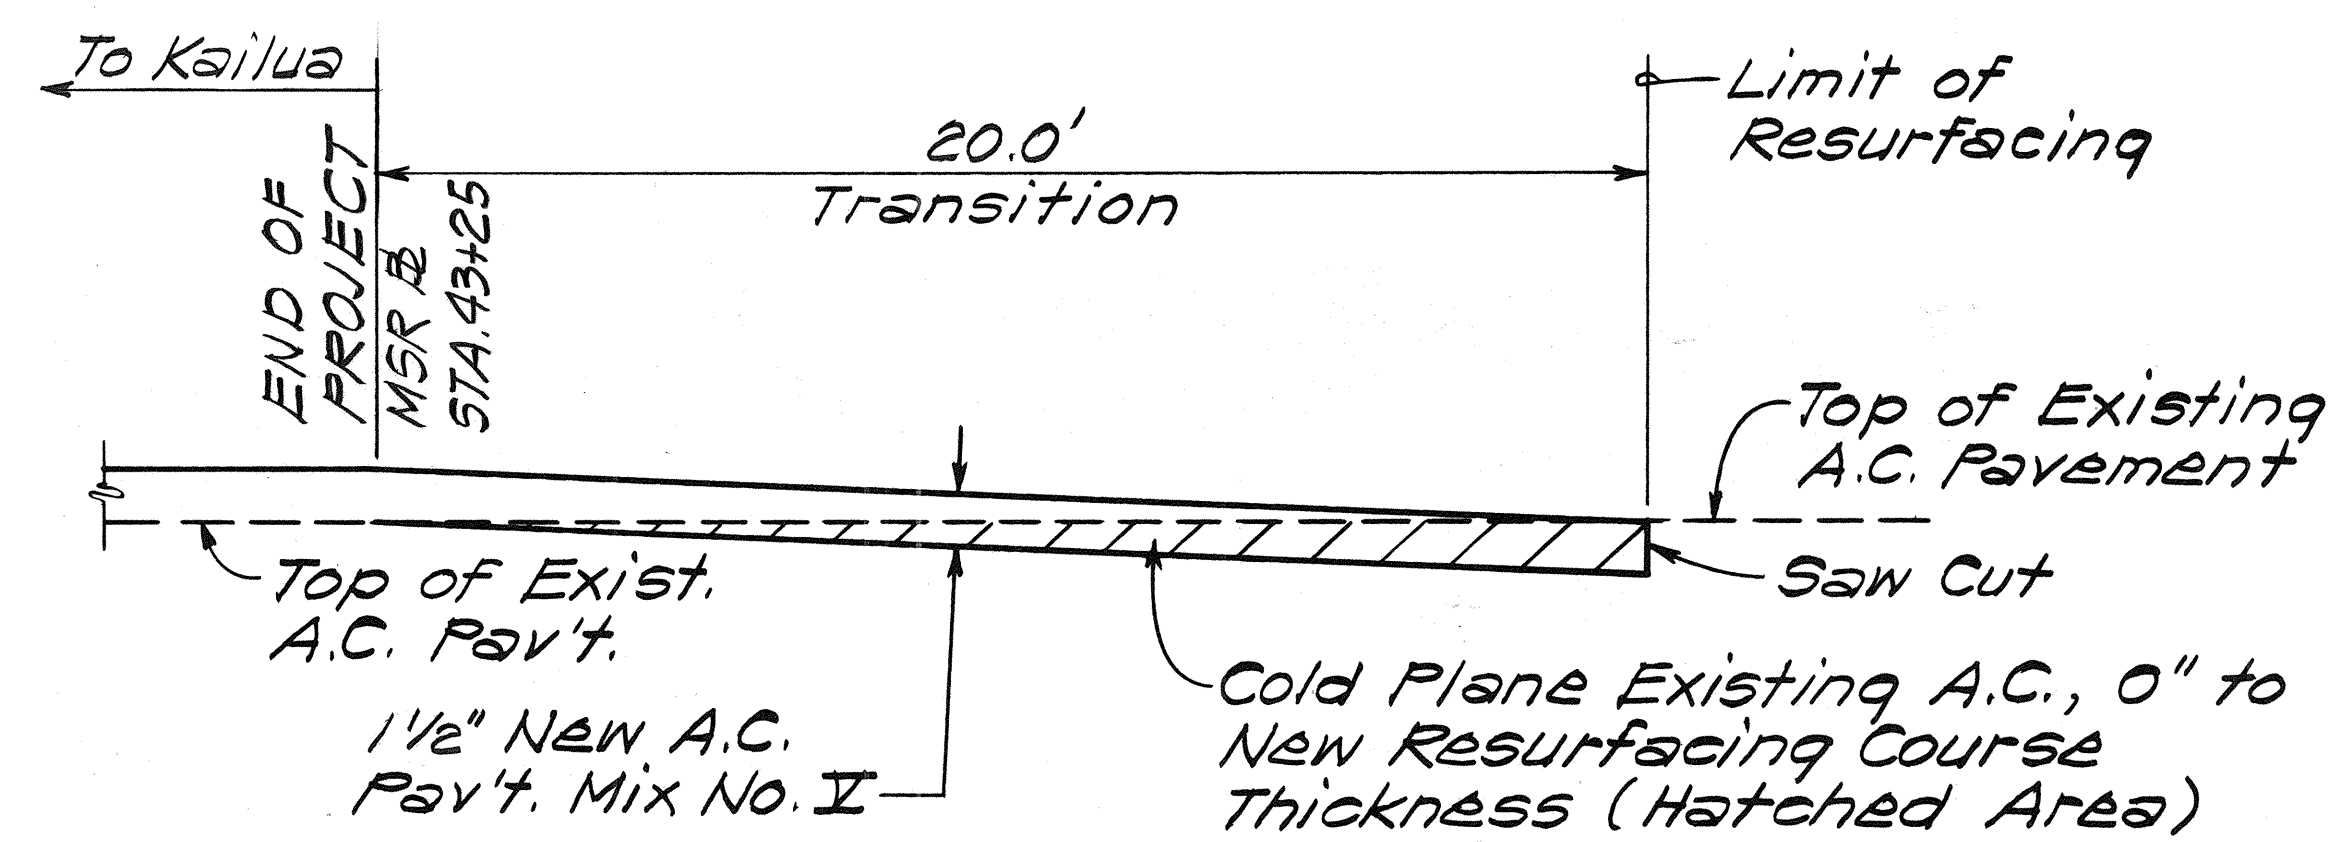

**COLD PLANING TRANSITION
AT END OF PROJECT**
Not to Scale

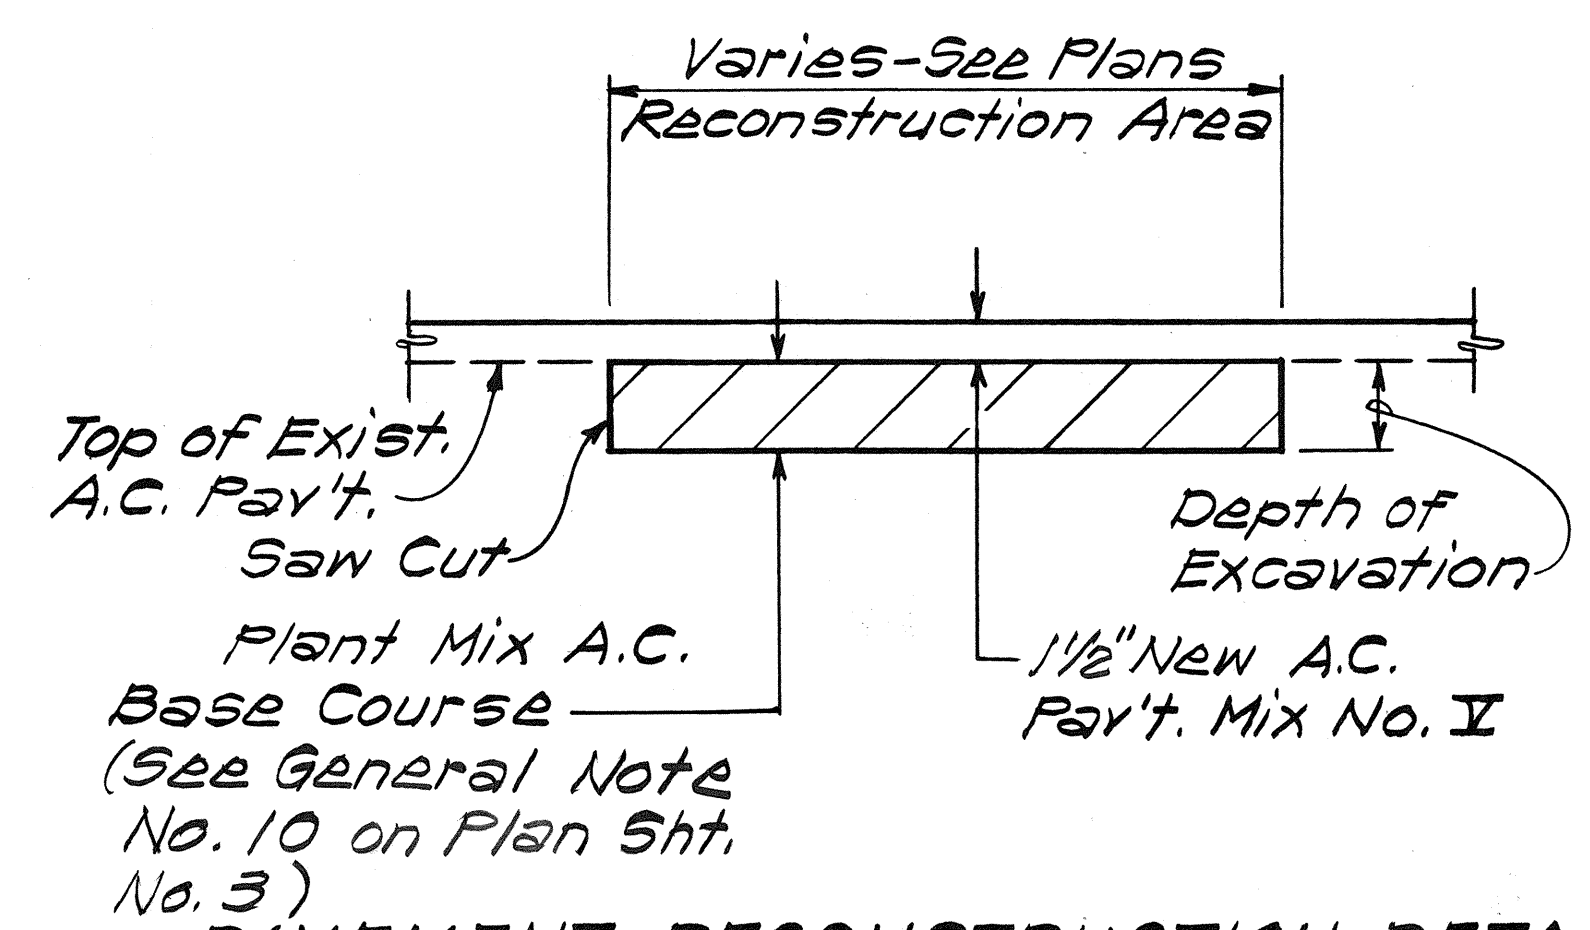

PAVEMENT RECONSTRUCTION DETAIL
Not to Scale

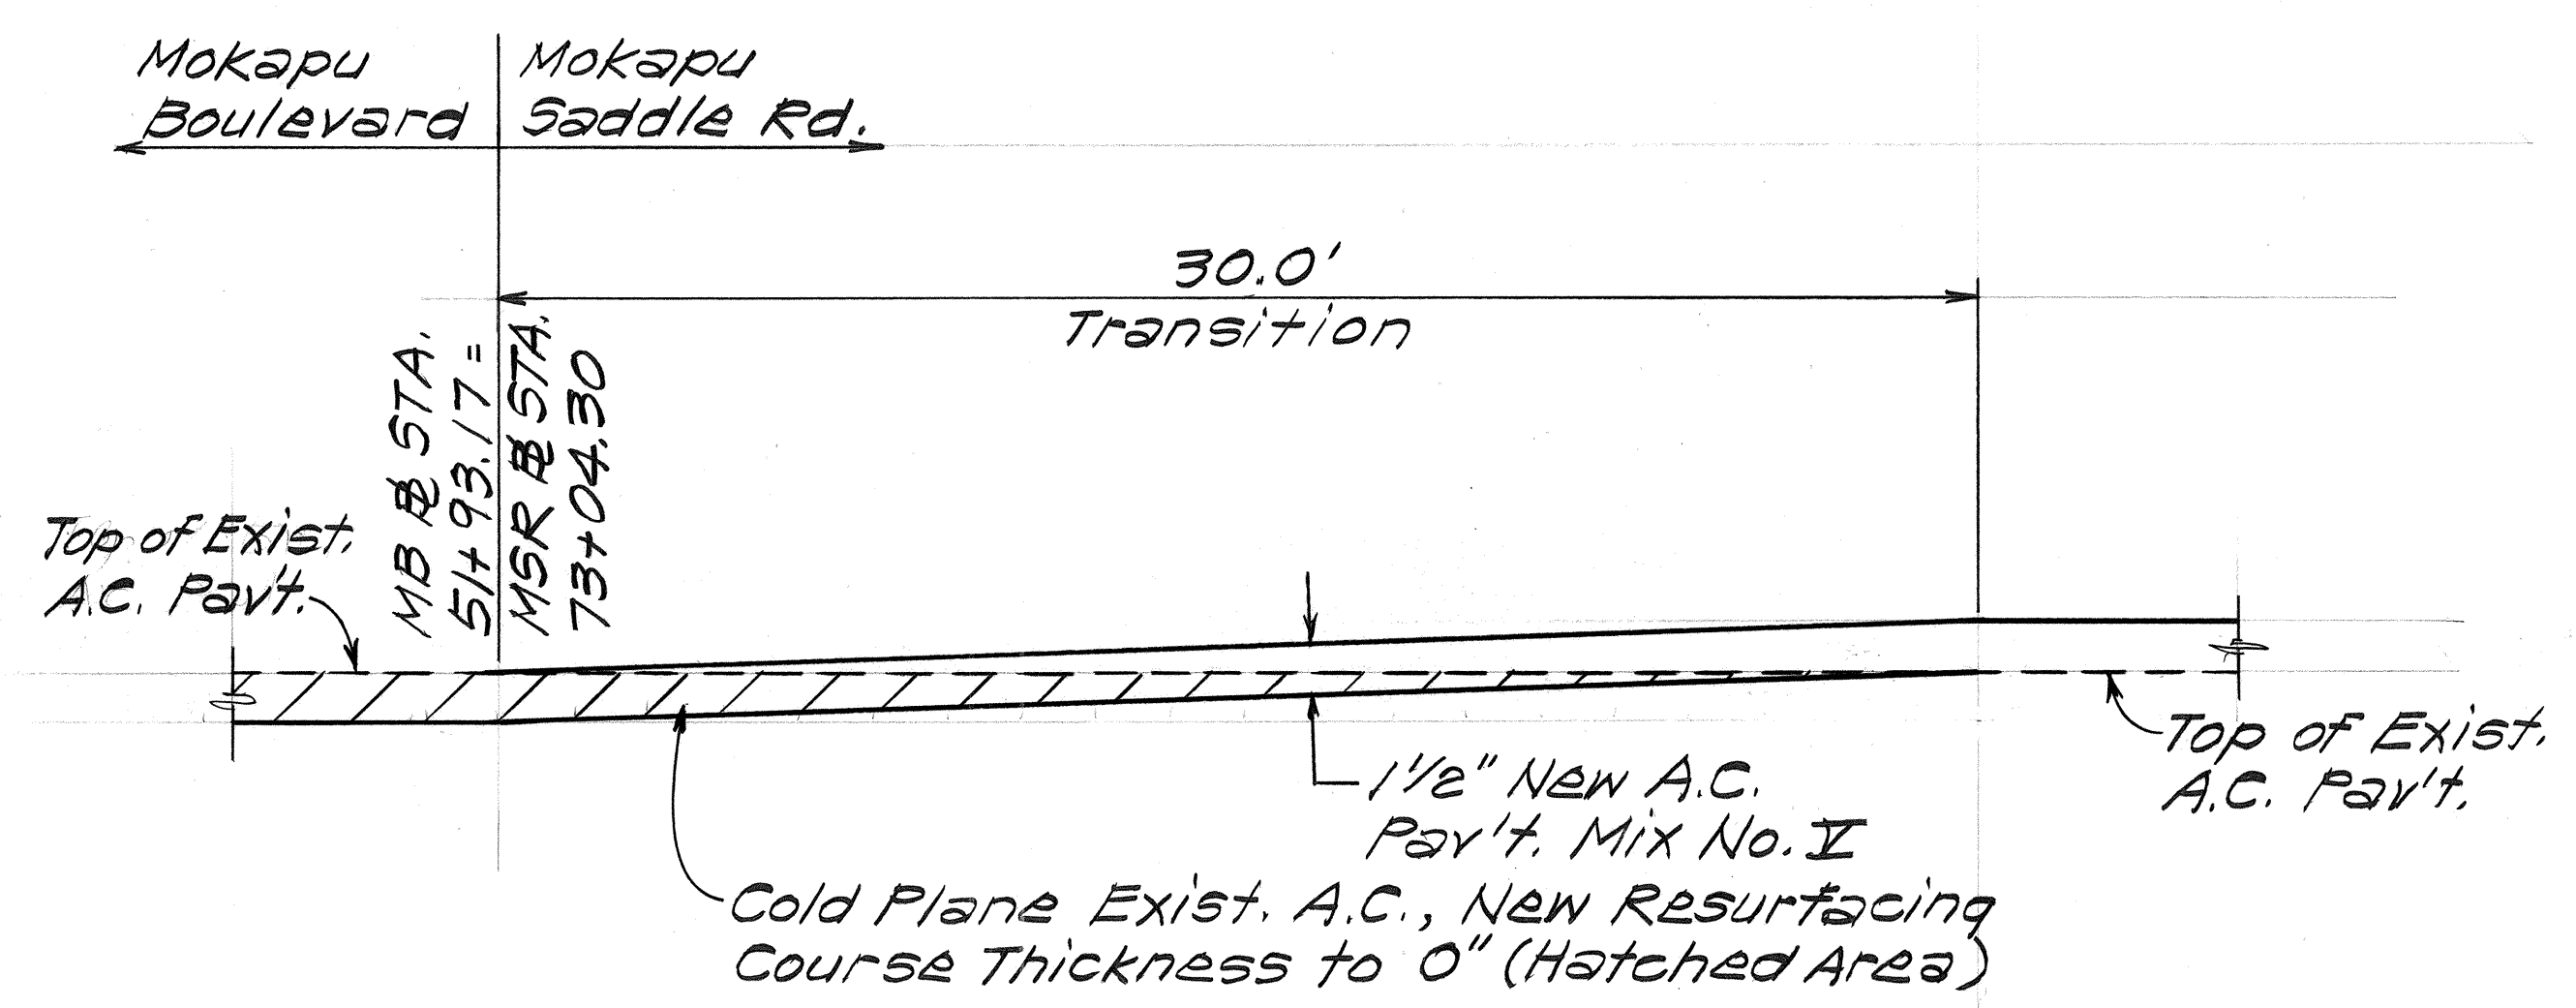

**COLD PLANING TRANSITION
AT MOKAPU BLVD. AND MOKAPU SADDLE RD.**
Not to Scale

STATE OF HAWAII

DEPARTMENT OF TRANSPORTATION

HIGHWAYS DIVISION

TYPICAL DETAILS

MOKAPU BOULEVARD AND MOKAPU SADDLE ROAD RESURFACING

Proj. No. 65B-01-87M

Not to Scale Date: Oct, 1986

SHEET No. 3 OF 3 SHEETS

SURVEY PLOTTED BY	DATE
DRAWN BY	
DESIGNED BY	
QUANTITIES BY	
CHECKED BY	
ORIGINAL PLAN	
NOTE BOOK	
NO.	