
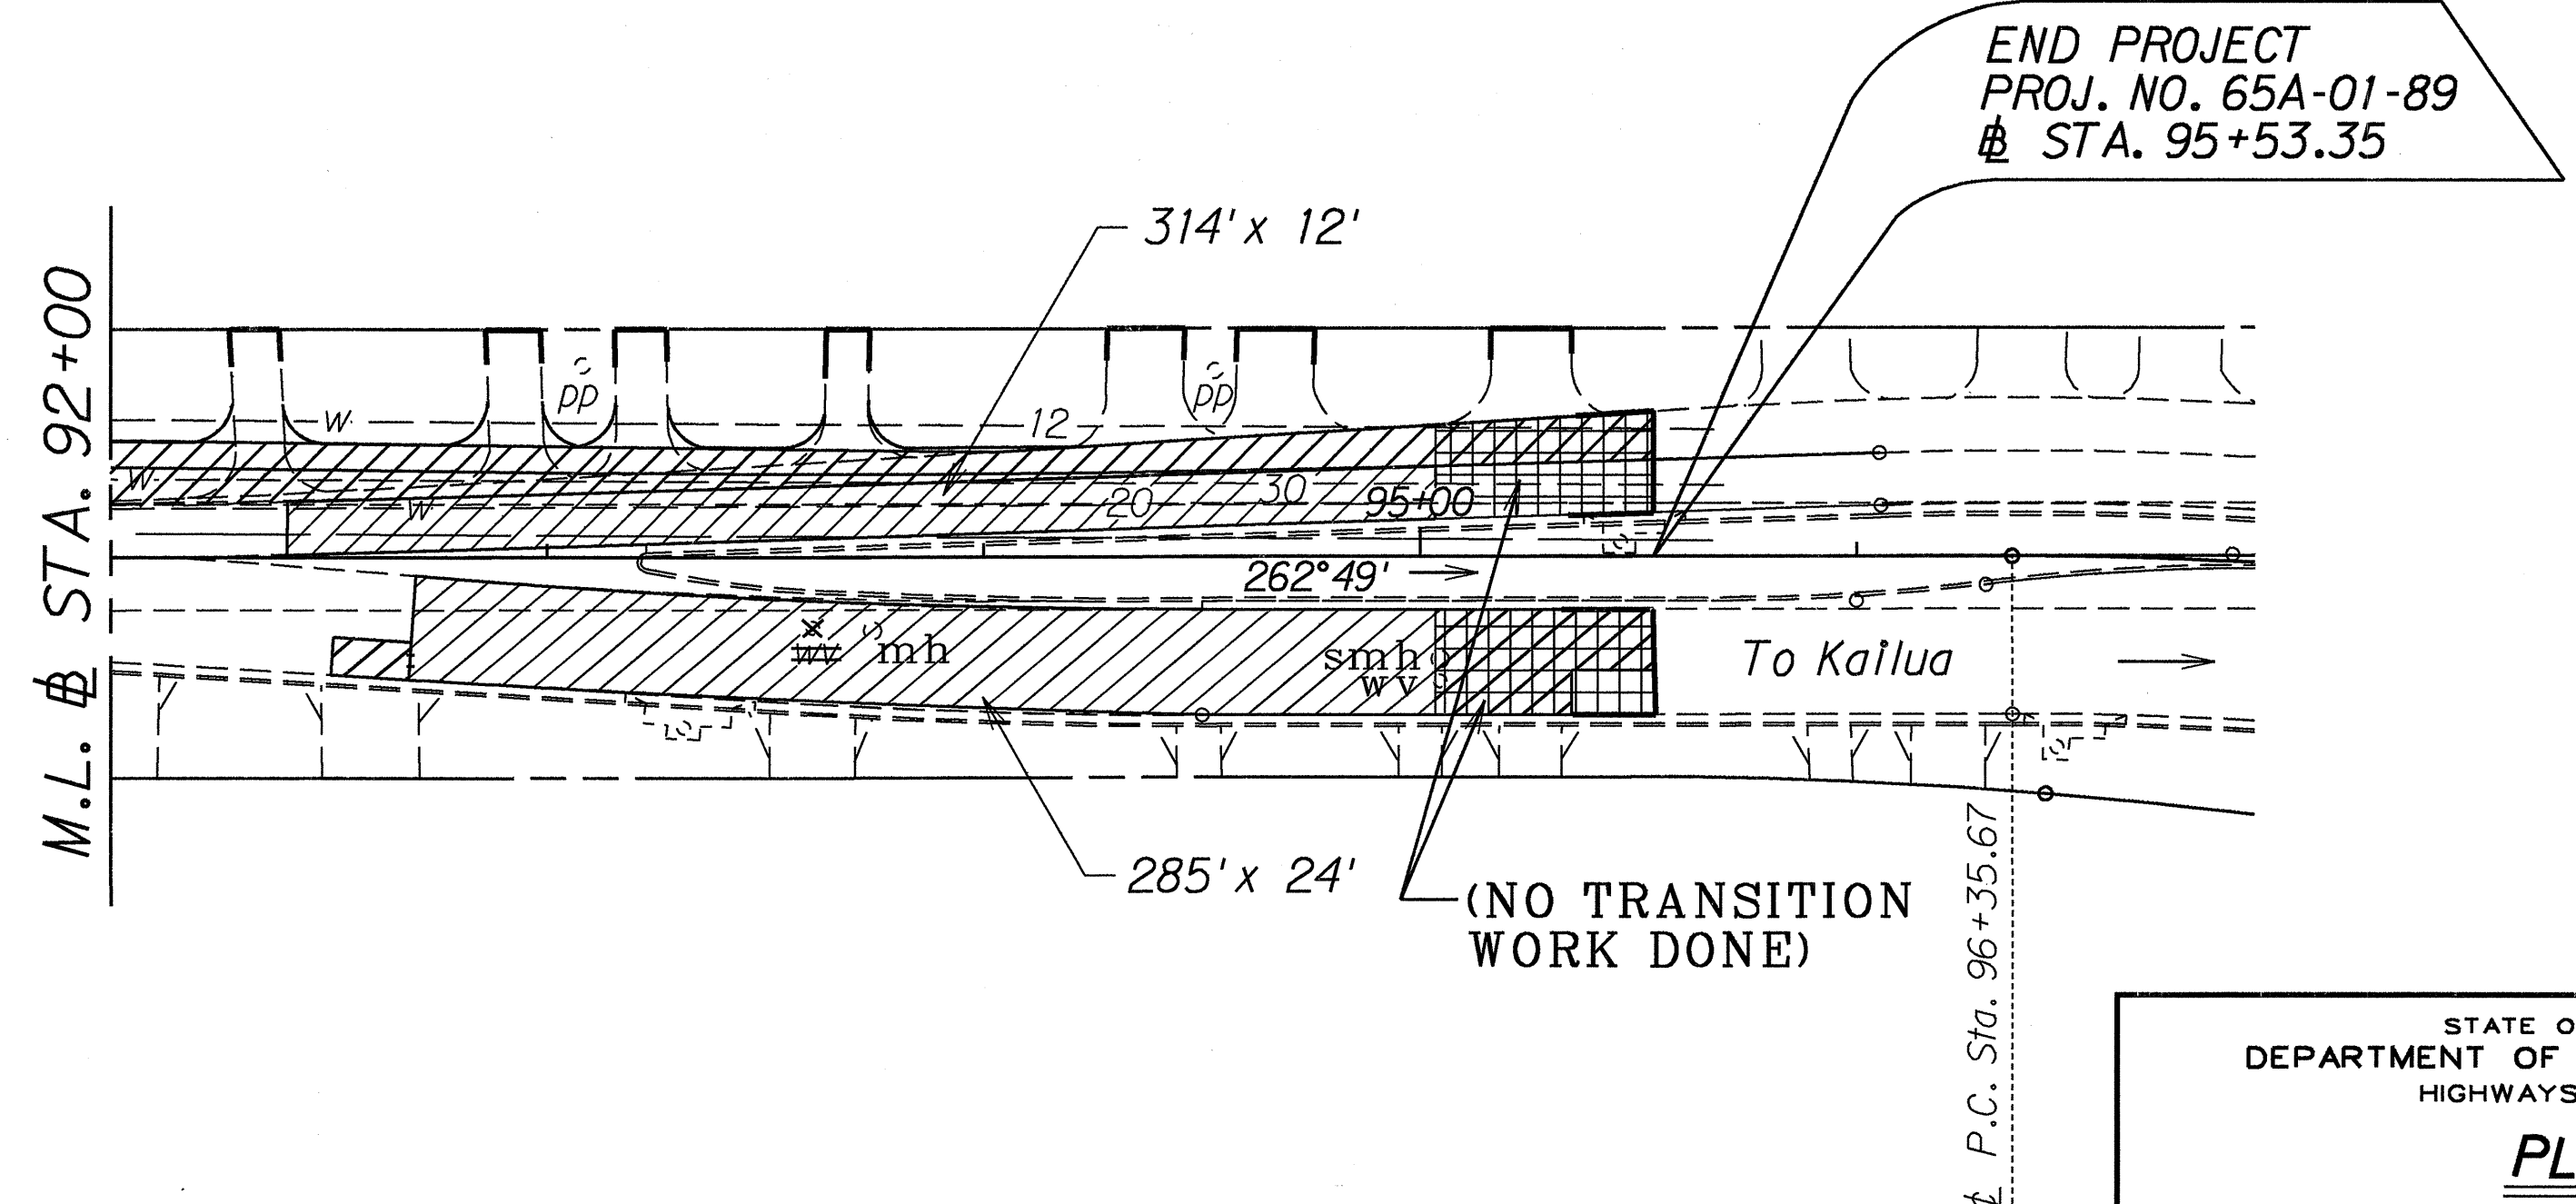


FED. ROAD DIST. NO.	STATE	PROJ. NO.	FISCAL YEAR	SHEET NO.	TOTAL SHEETS
HAWAII	HAW.	65A-01-89	1990	6	9

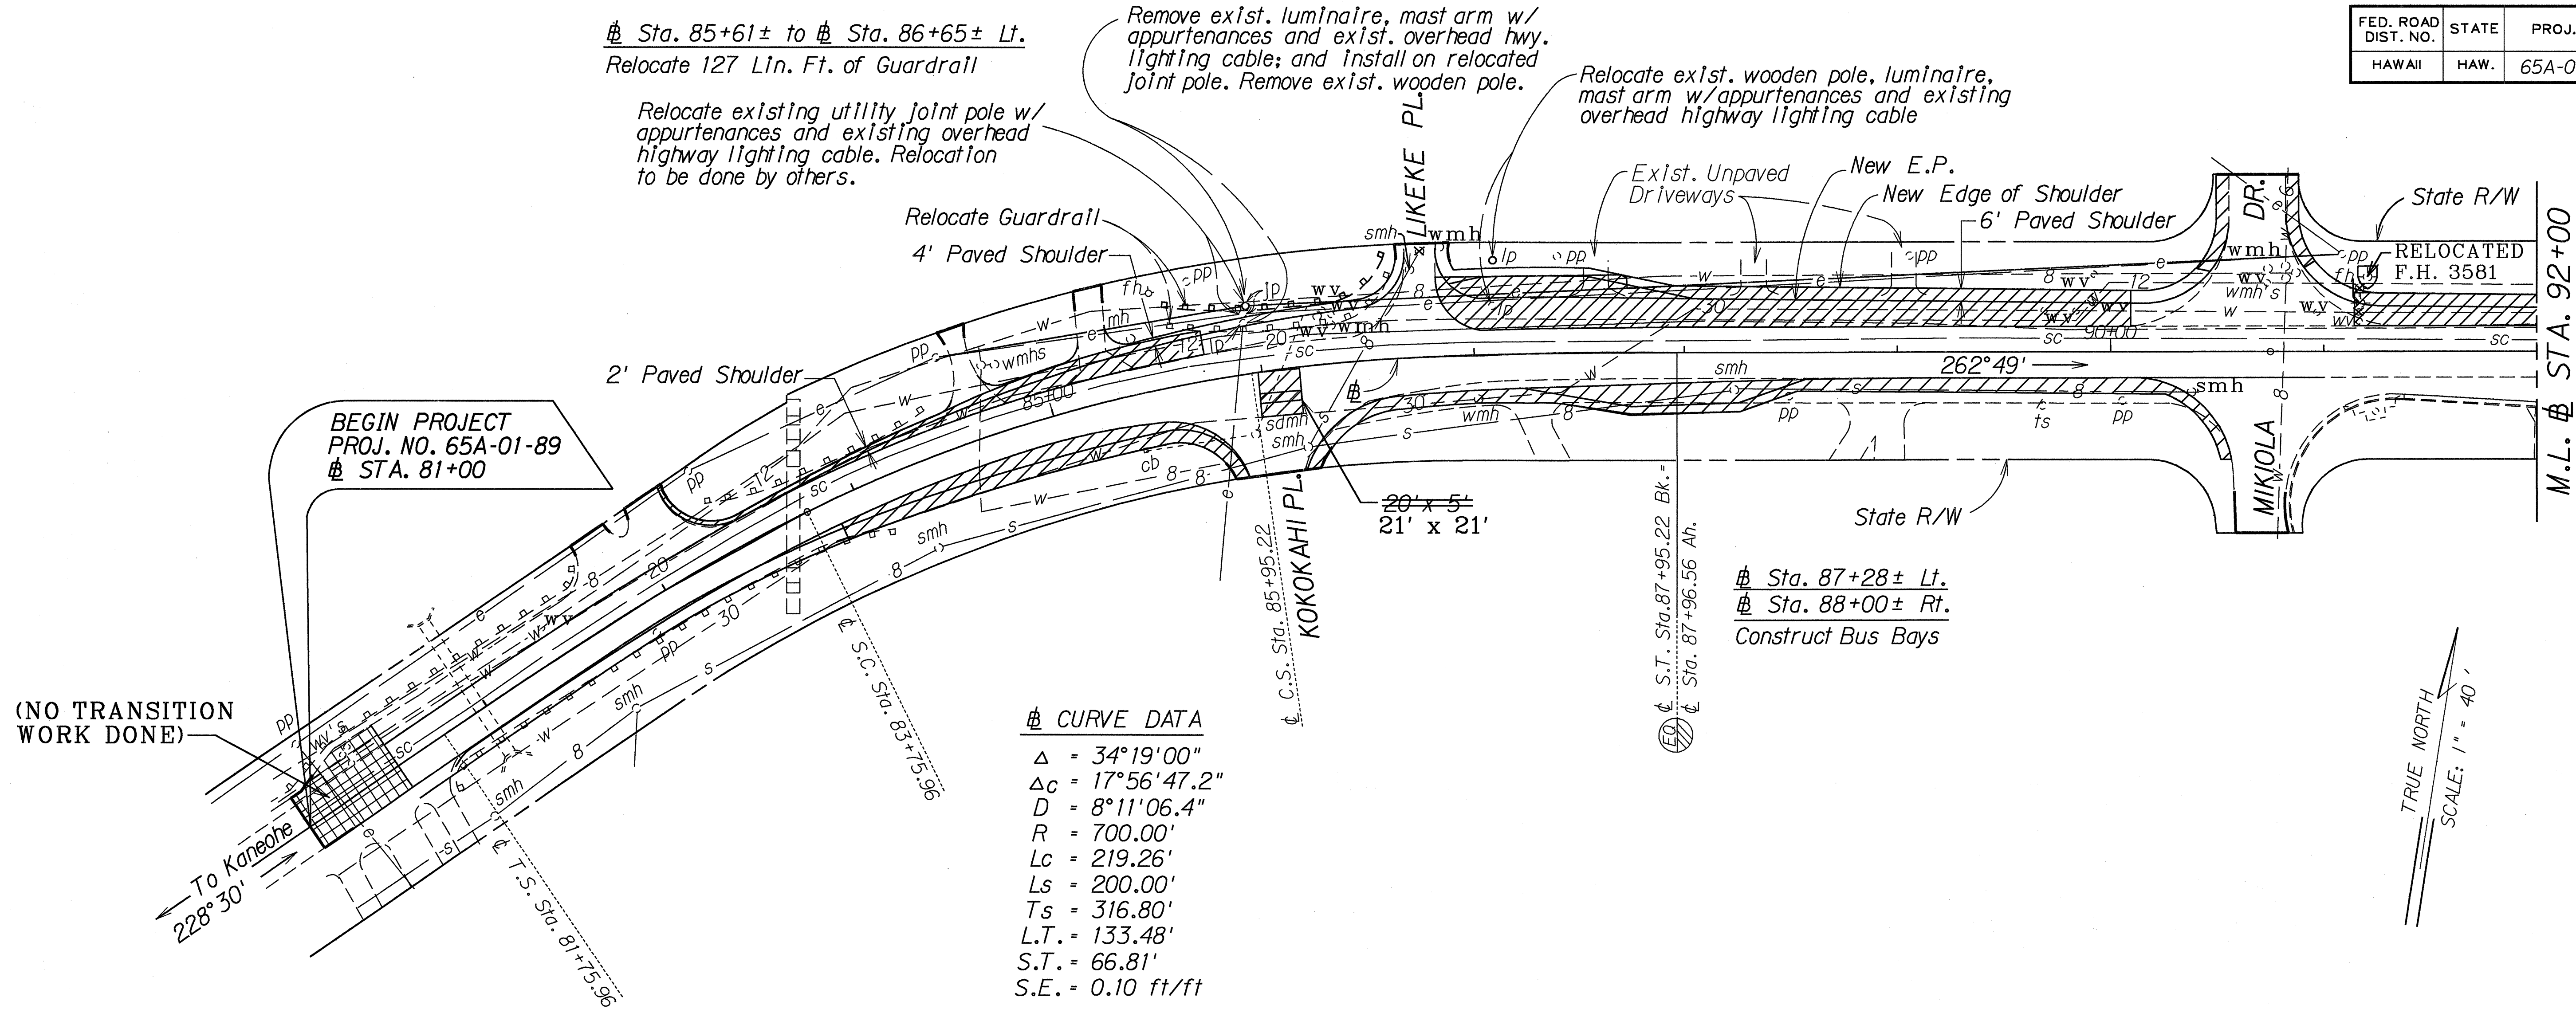

LEGEND FOR AS-BUILT POSTINGS	
	Squiggly line for as-built deletion
	Double line for as-built deletion
Roadway	Text for as-built posting

STATE OF HAWAII
DEPARTMENT OF TRANSPORTATION
HIGHWAYS DIVISION

PLAN

KANEOHE BAY DRIVE
Left Turn Lanes at Kokokahi Place,
Likeke Place and Mikiola Drive
PROJECT NO. 65A-01-89

Scale: 1" = 40' Date: June, 1990

SHEET No. 1 OF 1 SHEETS

AS-BUILT