



FED. ROAD DIST. NO.	STATE	PROJ. NO.	FISCAL YEAR	SHEET NO.	TOTAL SHEETS
HAWAII	HAW.	65A-01-89	1990	4	9

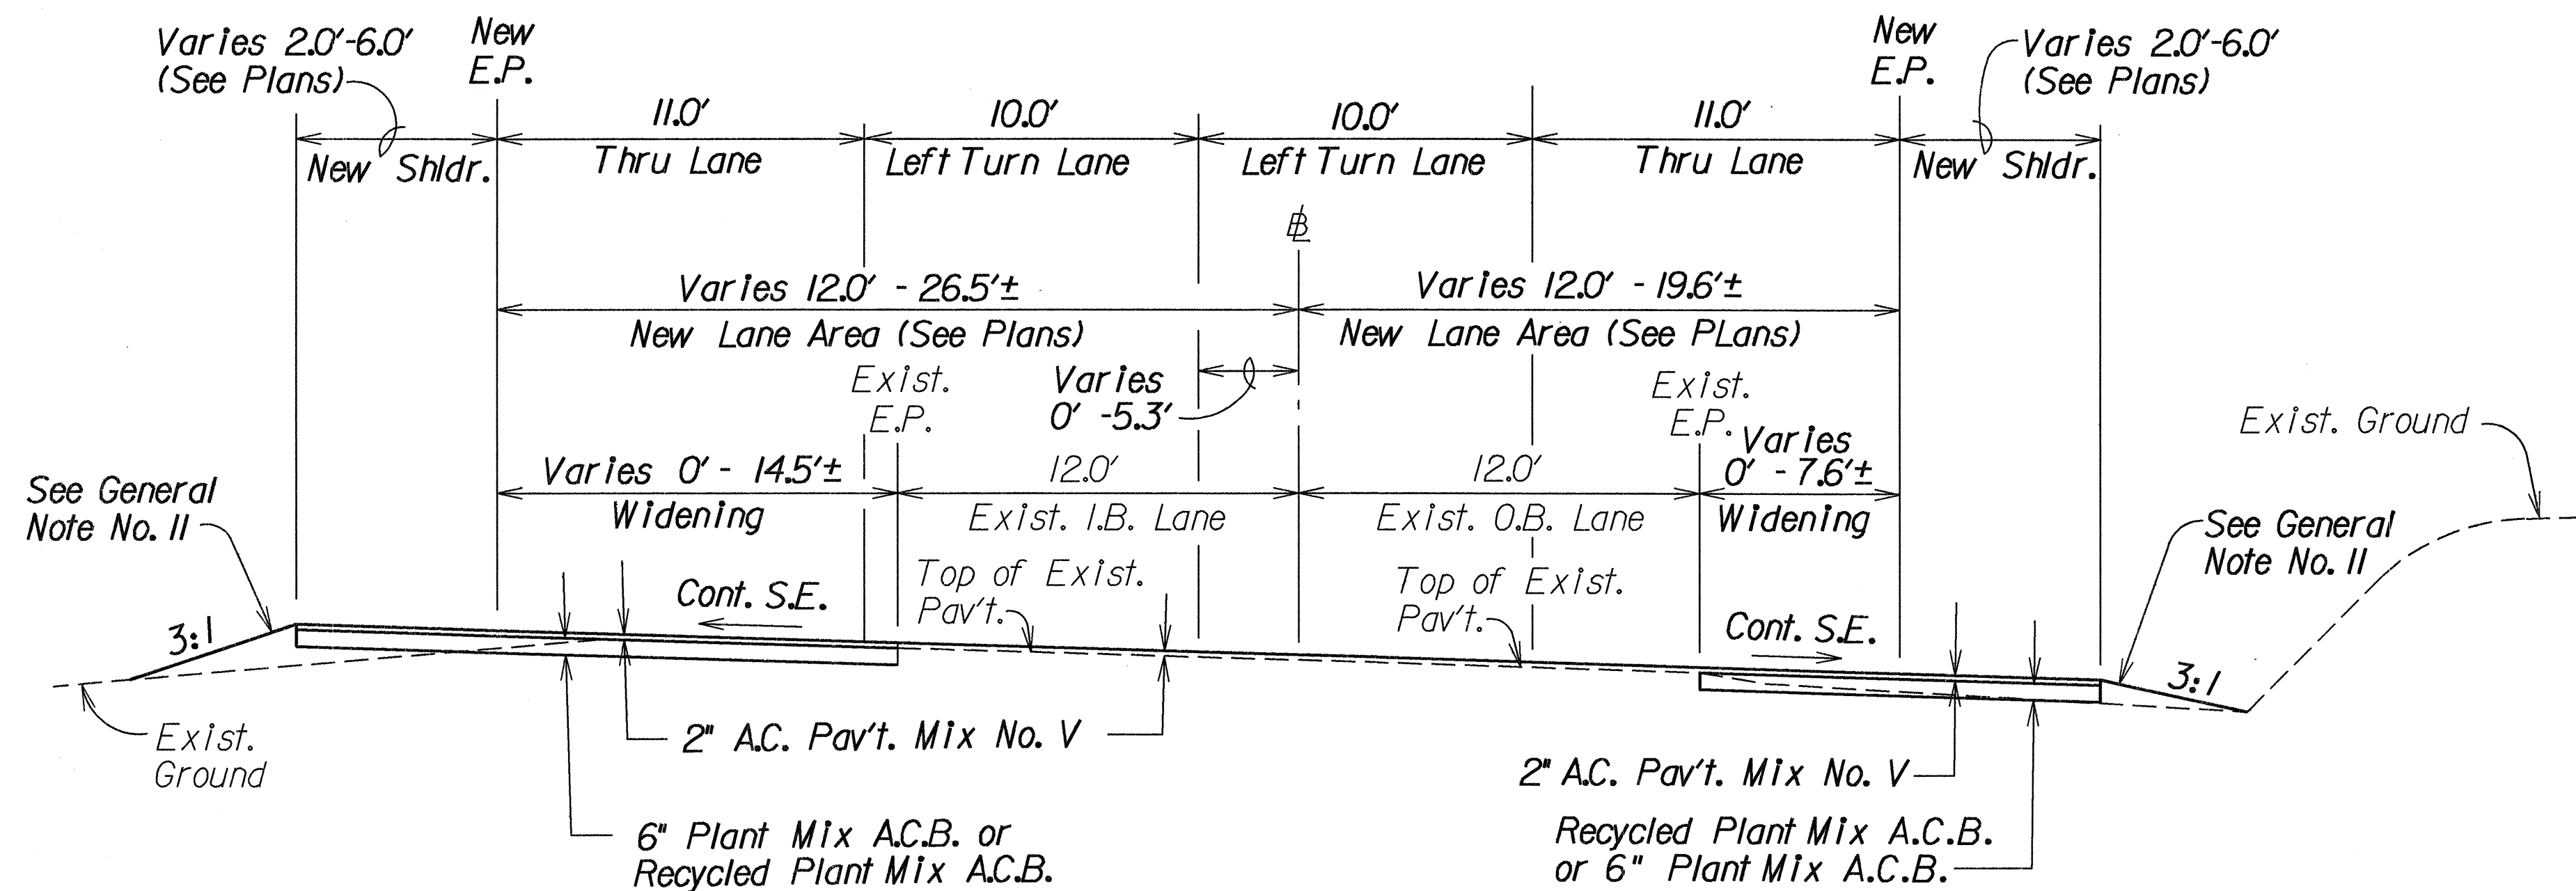


TYPICAL SUPERELEVATED SECTION

Scale: 1/4" = 1' - 0"

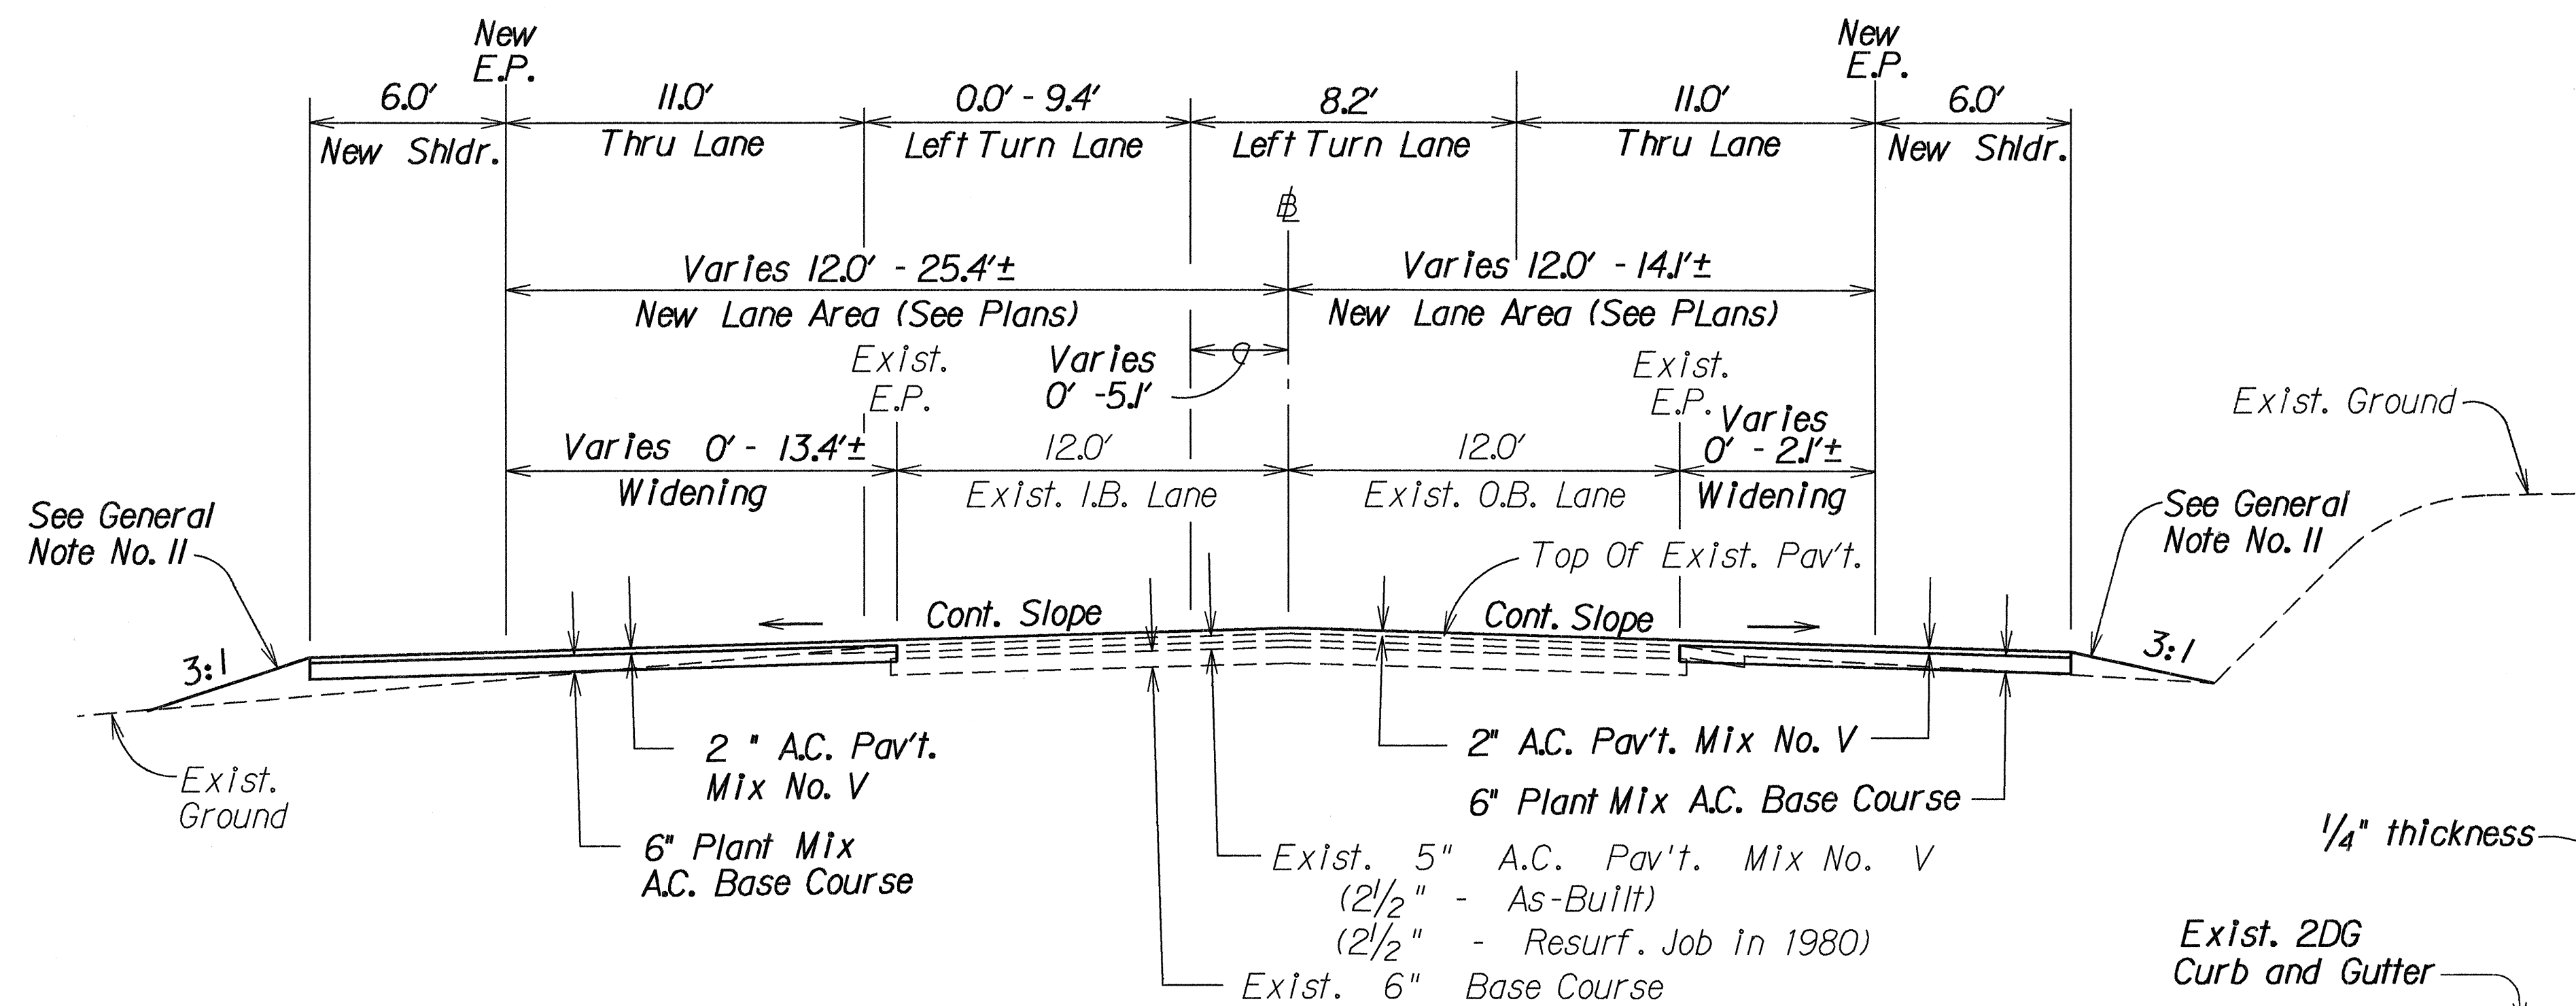

TYPICAL TANGENT SECTION


Scale: 1/4" = 1' - 0"

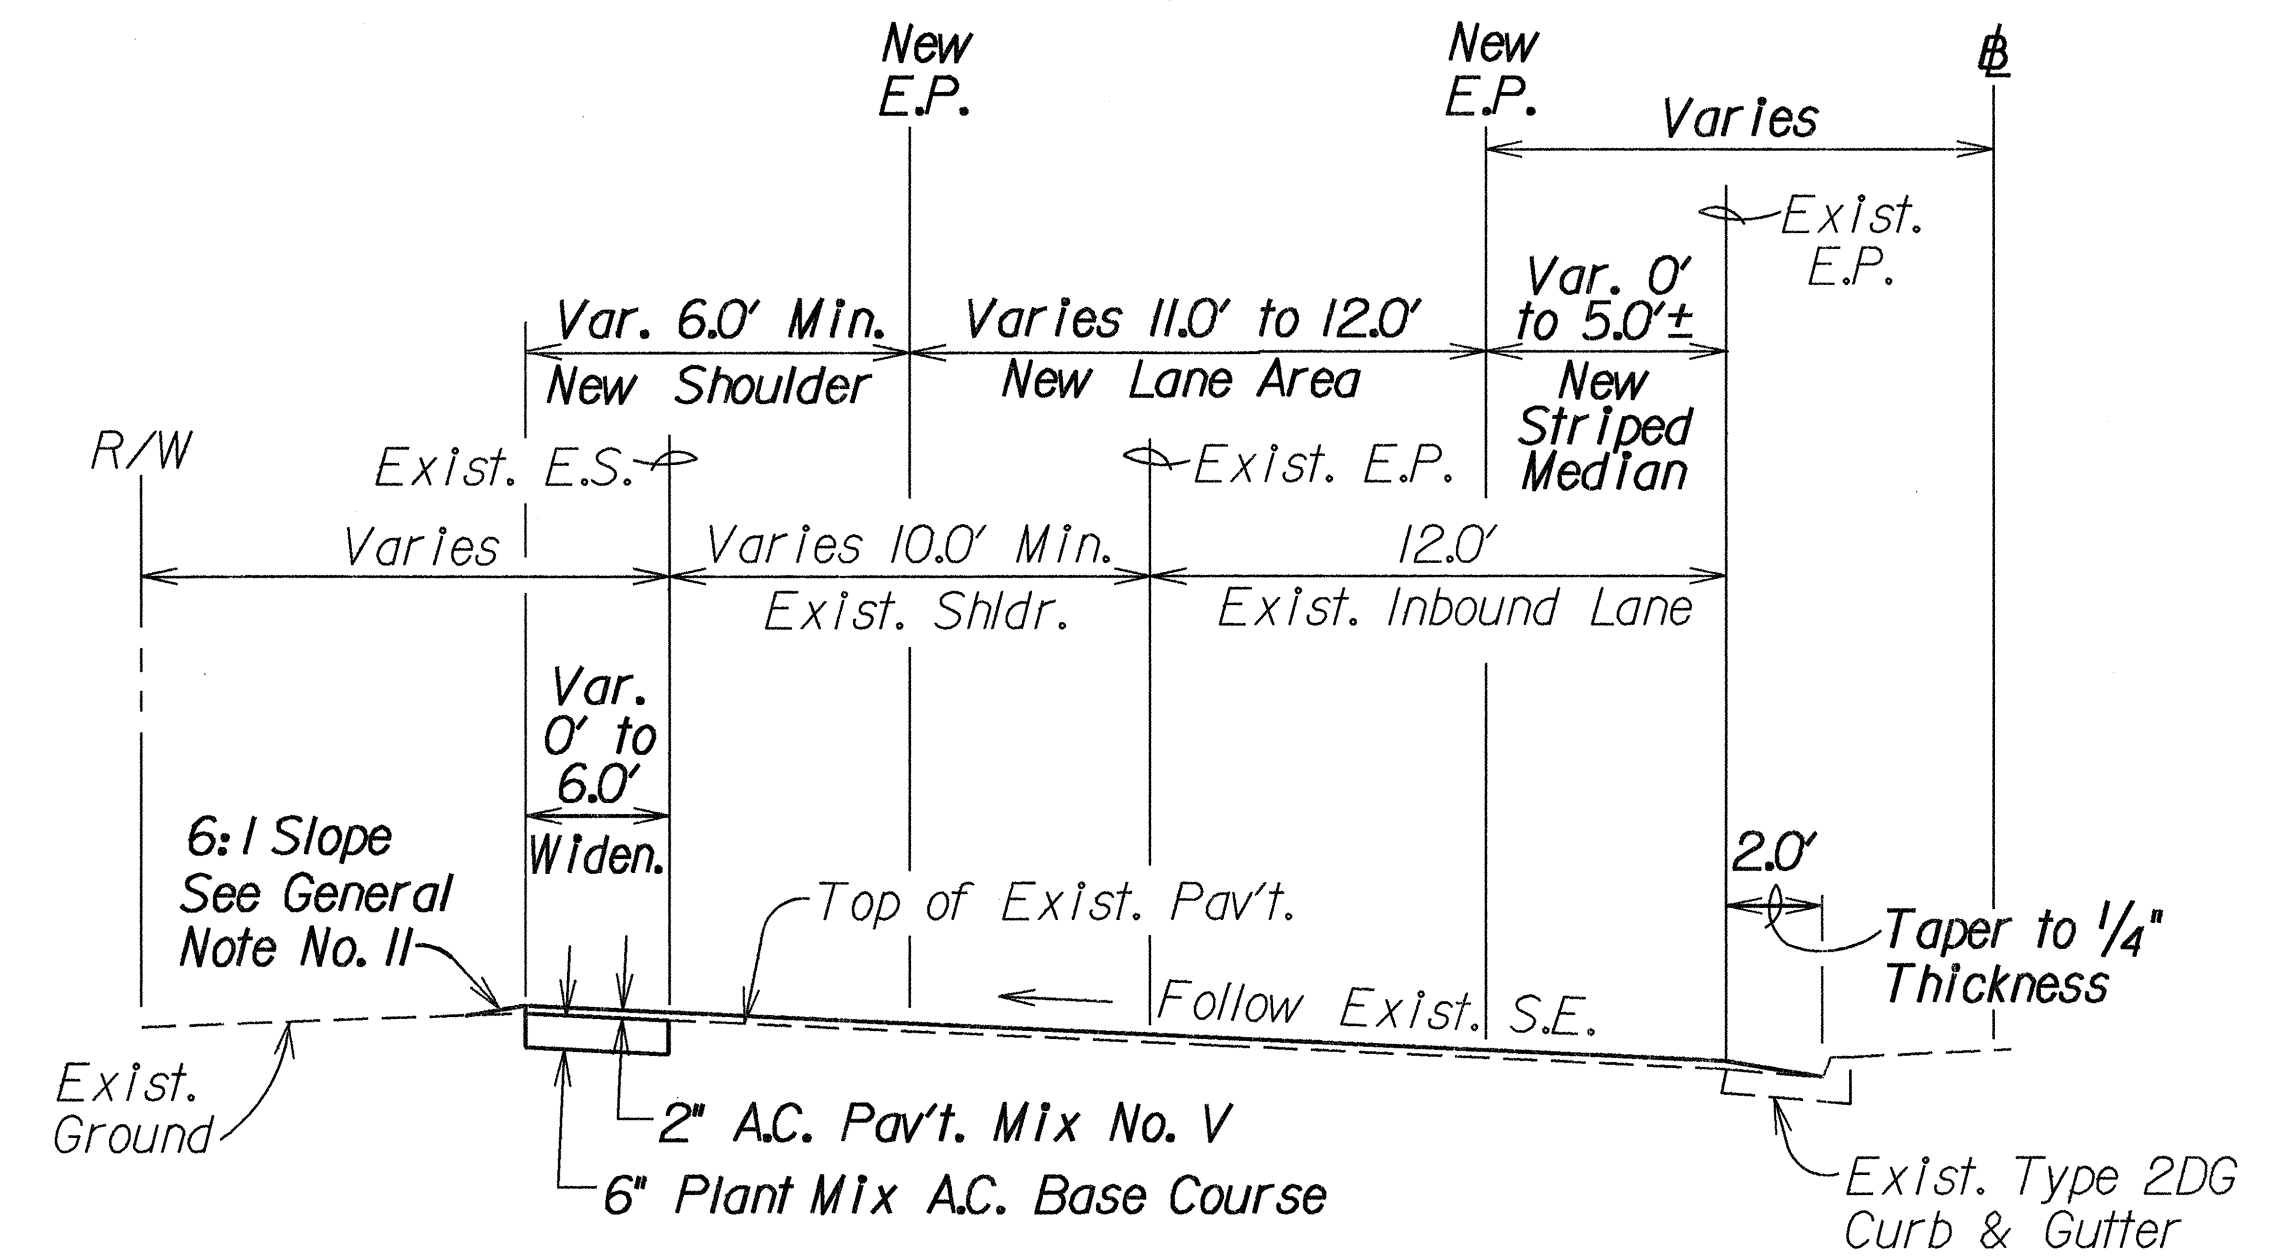

TYPICAL SECTION OF DIVIDED HIGHWAY (INBOUND)

STA. 93+21± TO STA. 95+53.35


Scale: 1/4" = 1' - 0"

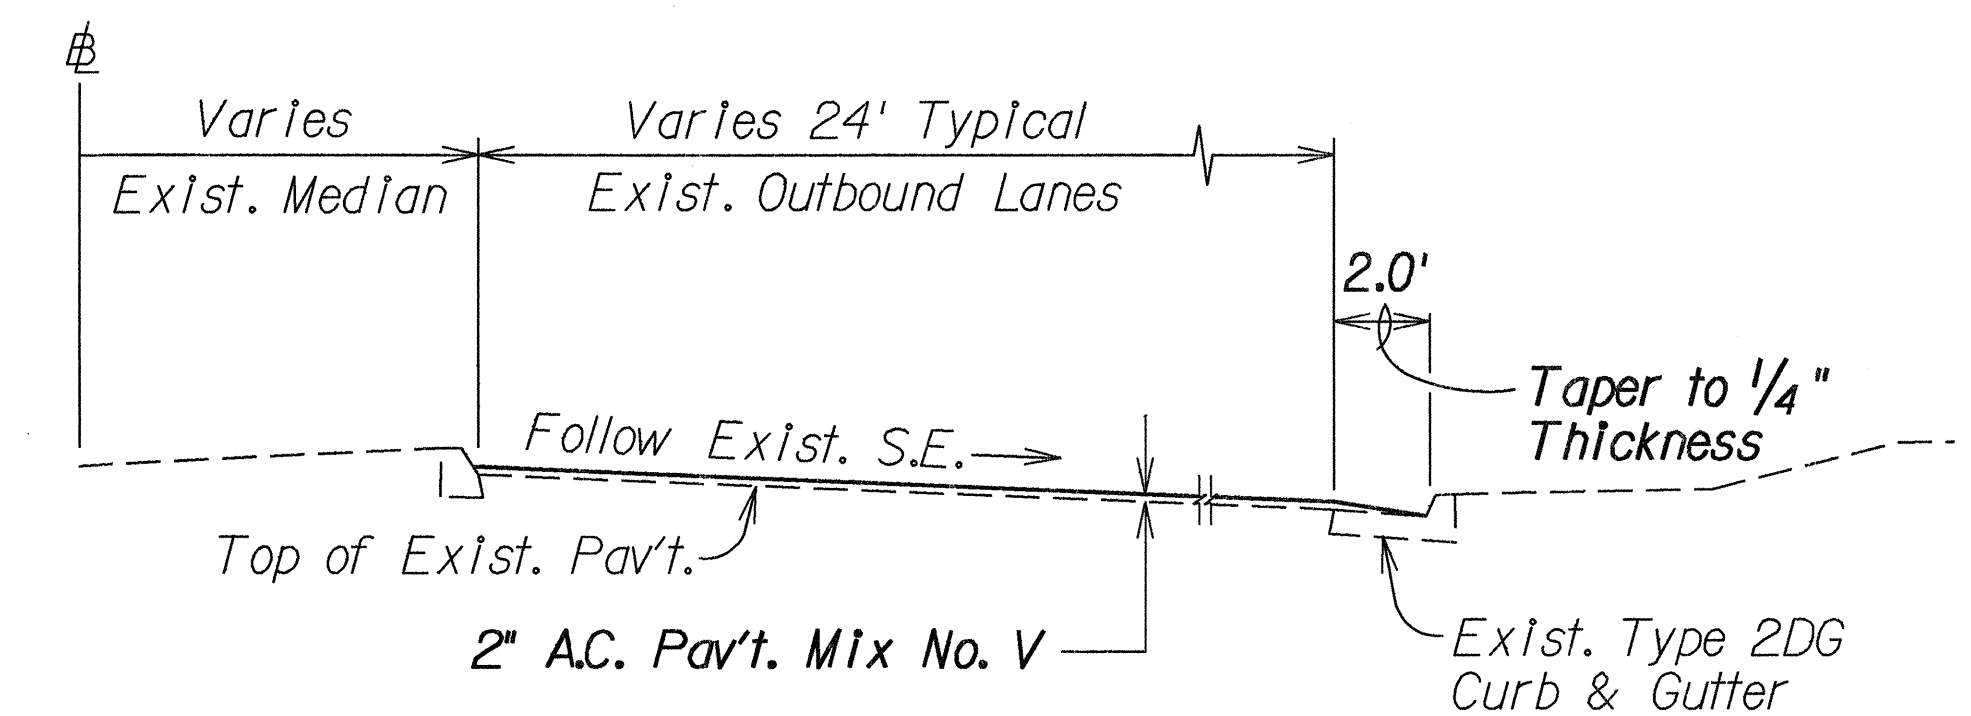

TYPICAL SECTION OF DIVIDED HIGHWAY (OUTBOUND)

STA. 93+21± TO STA. 95+53.35

Scale: 1/4" = 1' - 0"

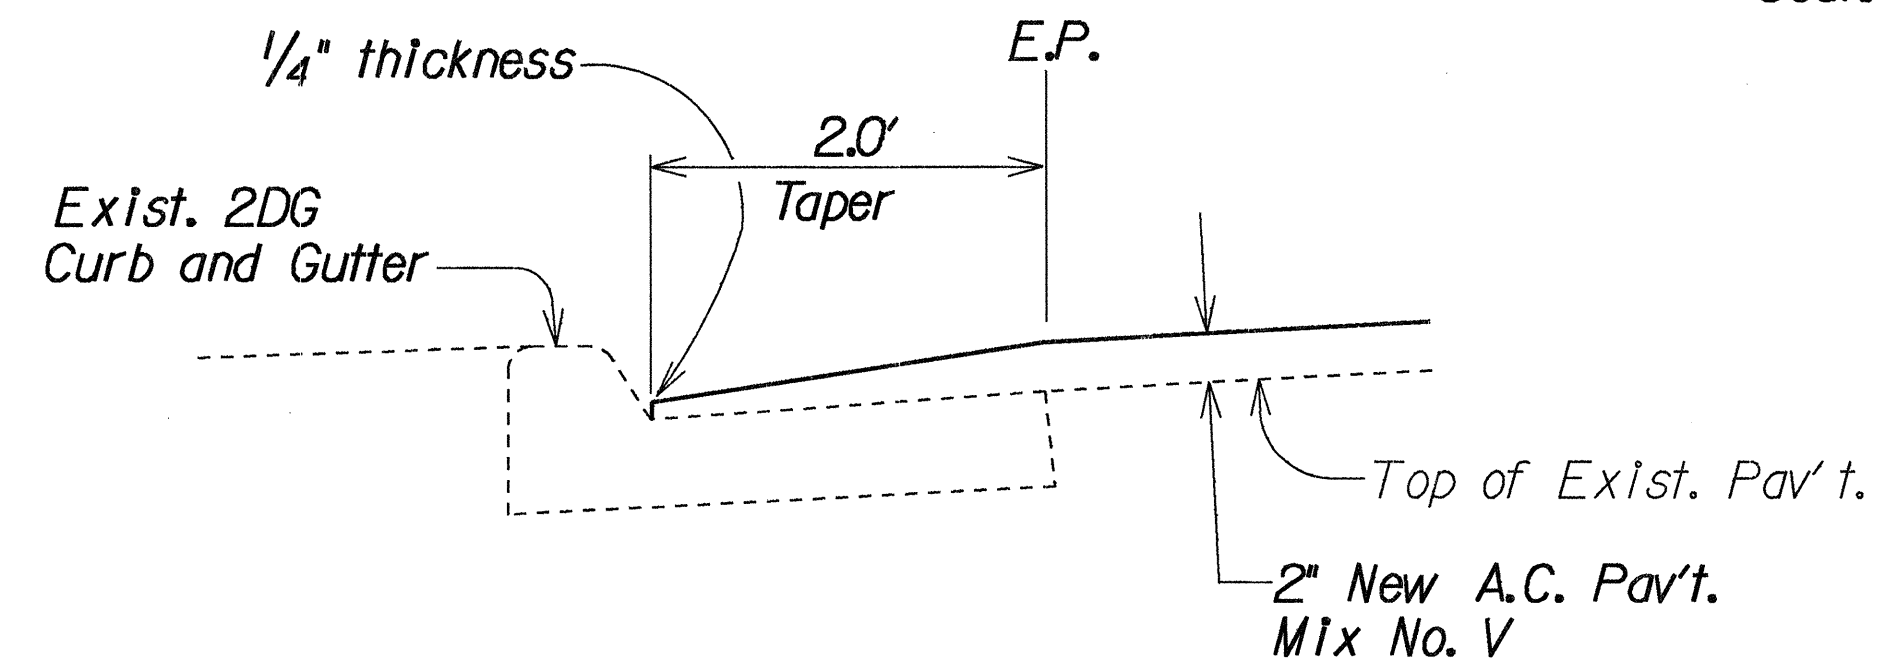


TYPICAL SECTION
A.C. PAV'T RESURFACING
AT CURB AND GUTTER DETAIL


Not To Scale

STATE OF HAWAII DEPARTMENT OF TRANSPORTATION HIGHWAYS DIVISION	
TYPICAL SECTIONS	
KANE OHE BAY DRIVE	
Left Turn Lanes at Kokokahi Place, Likeke Place and Mikiola Drive	
PROJECT NO. 65A-01-89	
Scale: As Shown	Date: June, 1990
SHEET No. 1 OF 2 SHEETS	


FED. ROAD DIST. NO.	STATE	PROJ. NO.	FISCAL YEAR	SHEET NO.	TOTAL SHEETS
HAWAII	HAW.	65A-01-89	1990	5	9

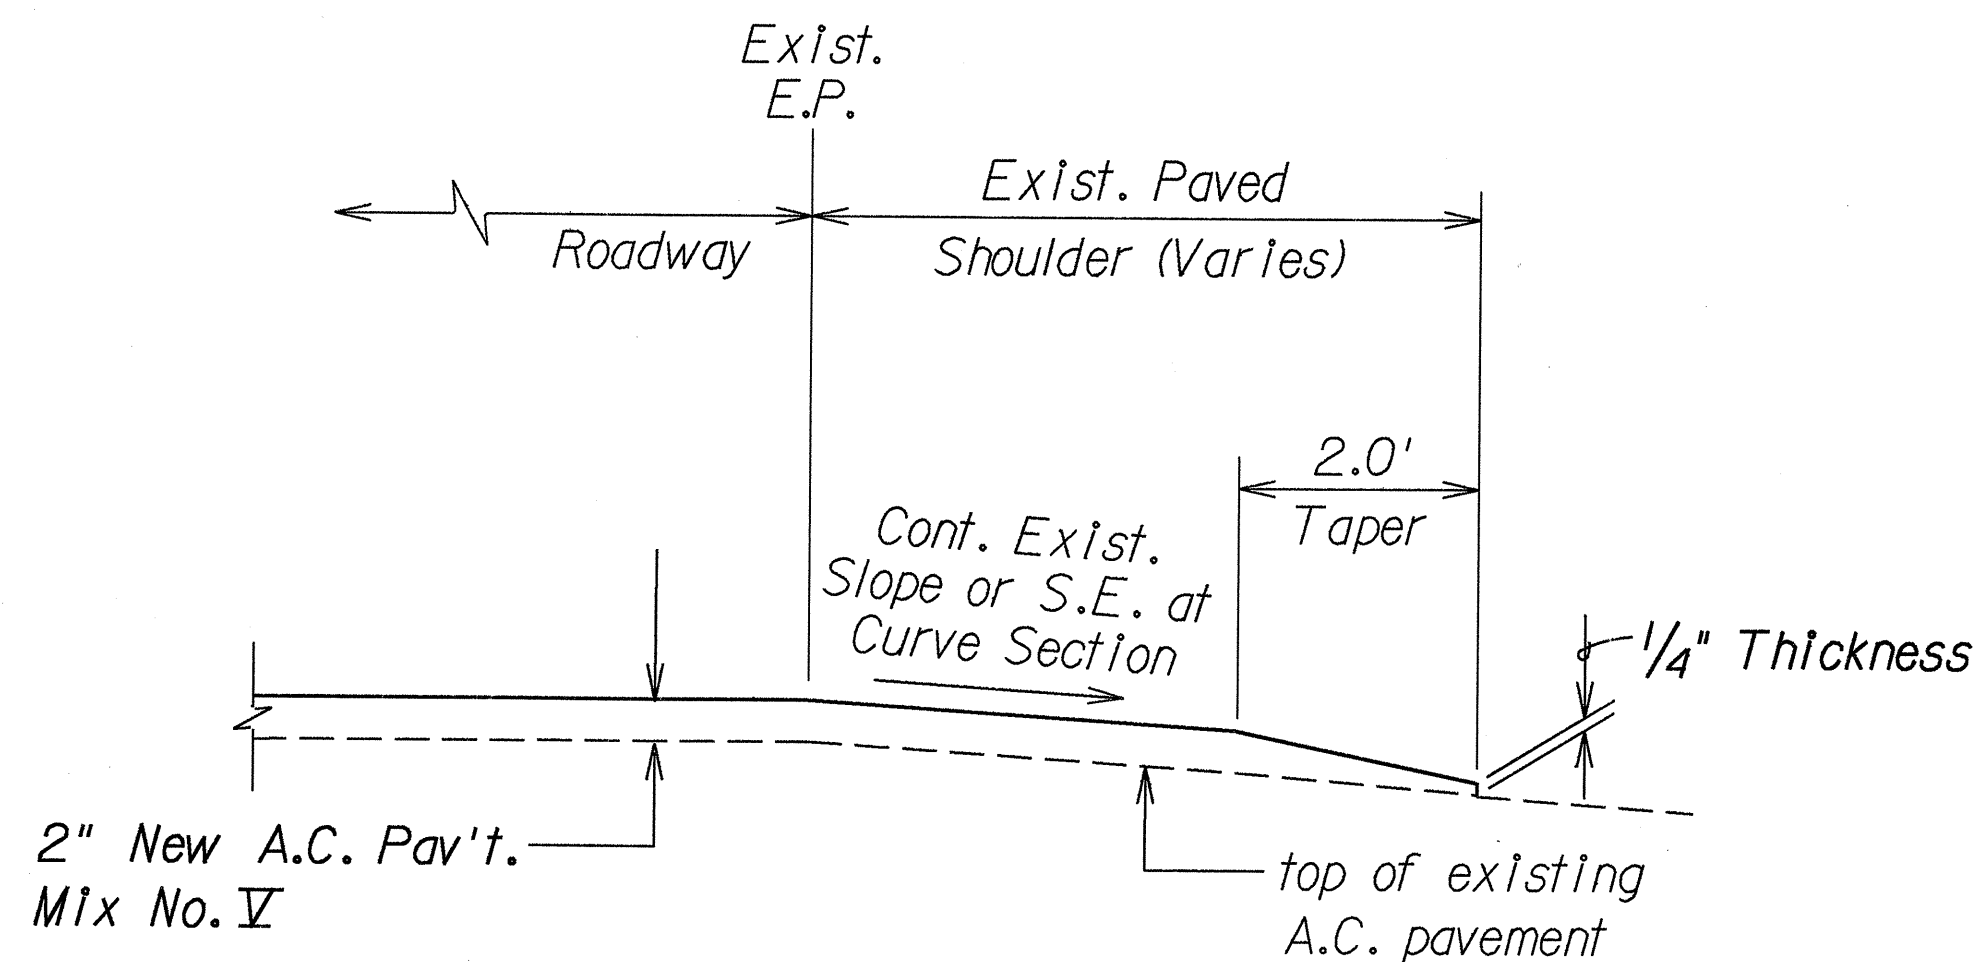


TYPICAL SECTION AT EXISTING PAVED SHOULDER
Not To Scale

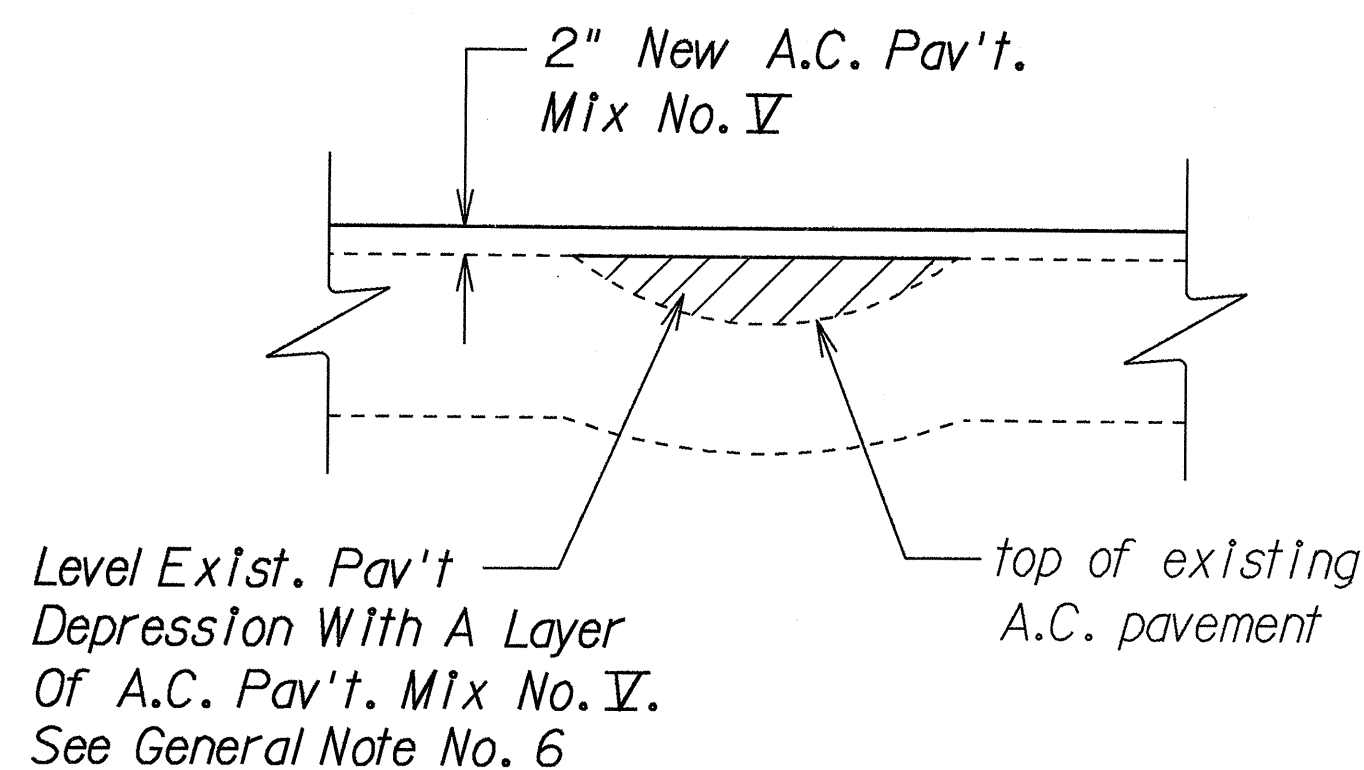


LEVELING COURSE DETAIL
Not To Scale

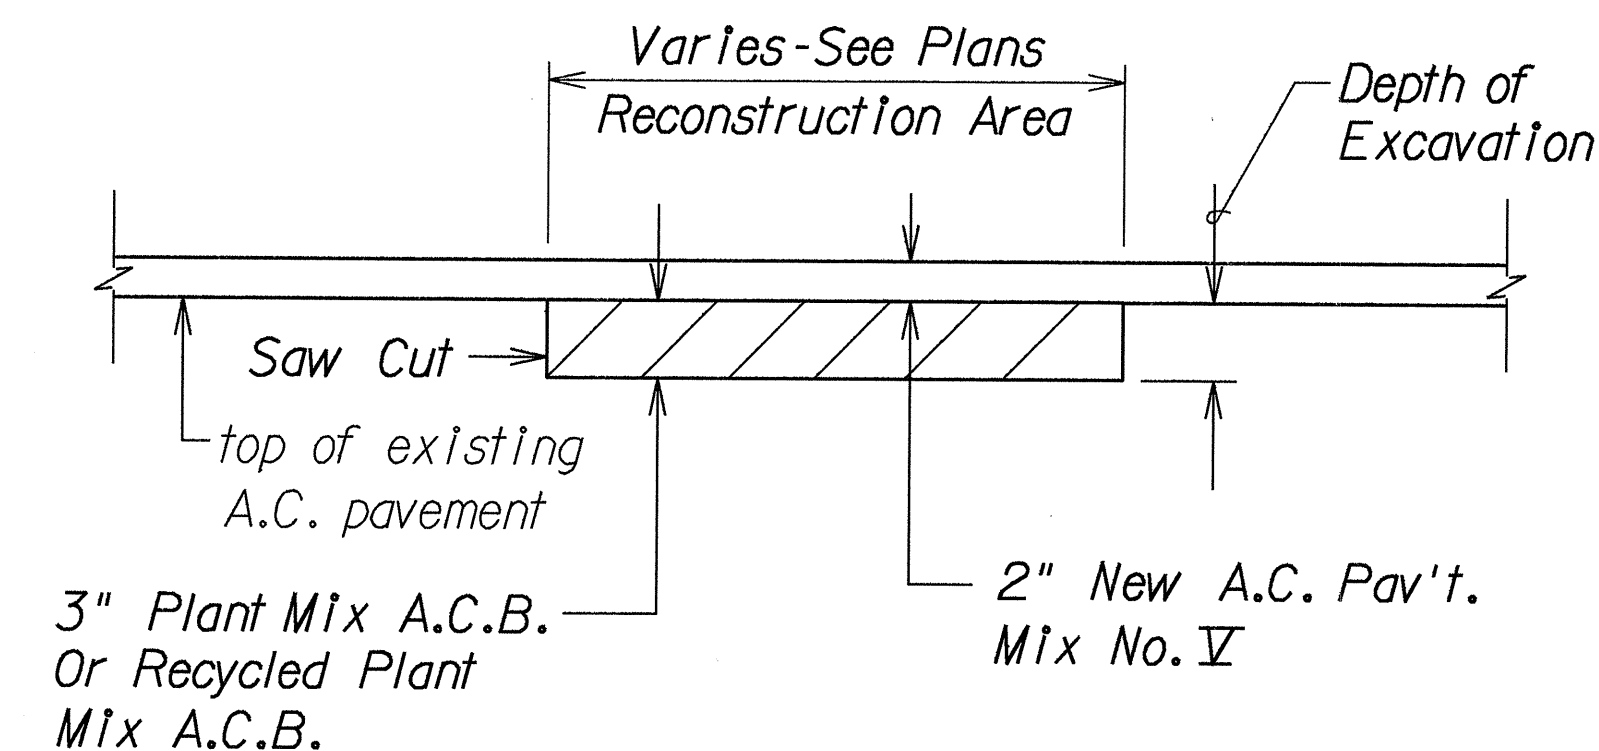


A.C. PAVEMENT RECONSTRUCTION DETAIL
Not To Scale

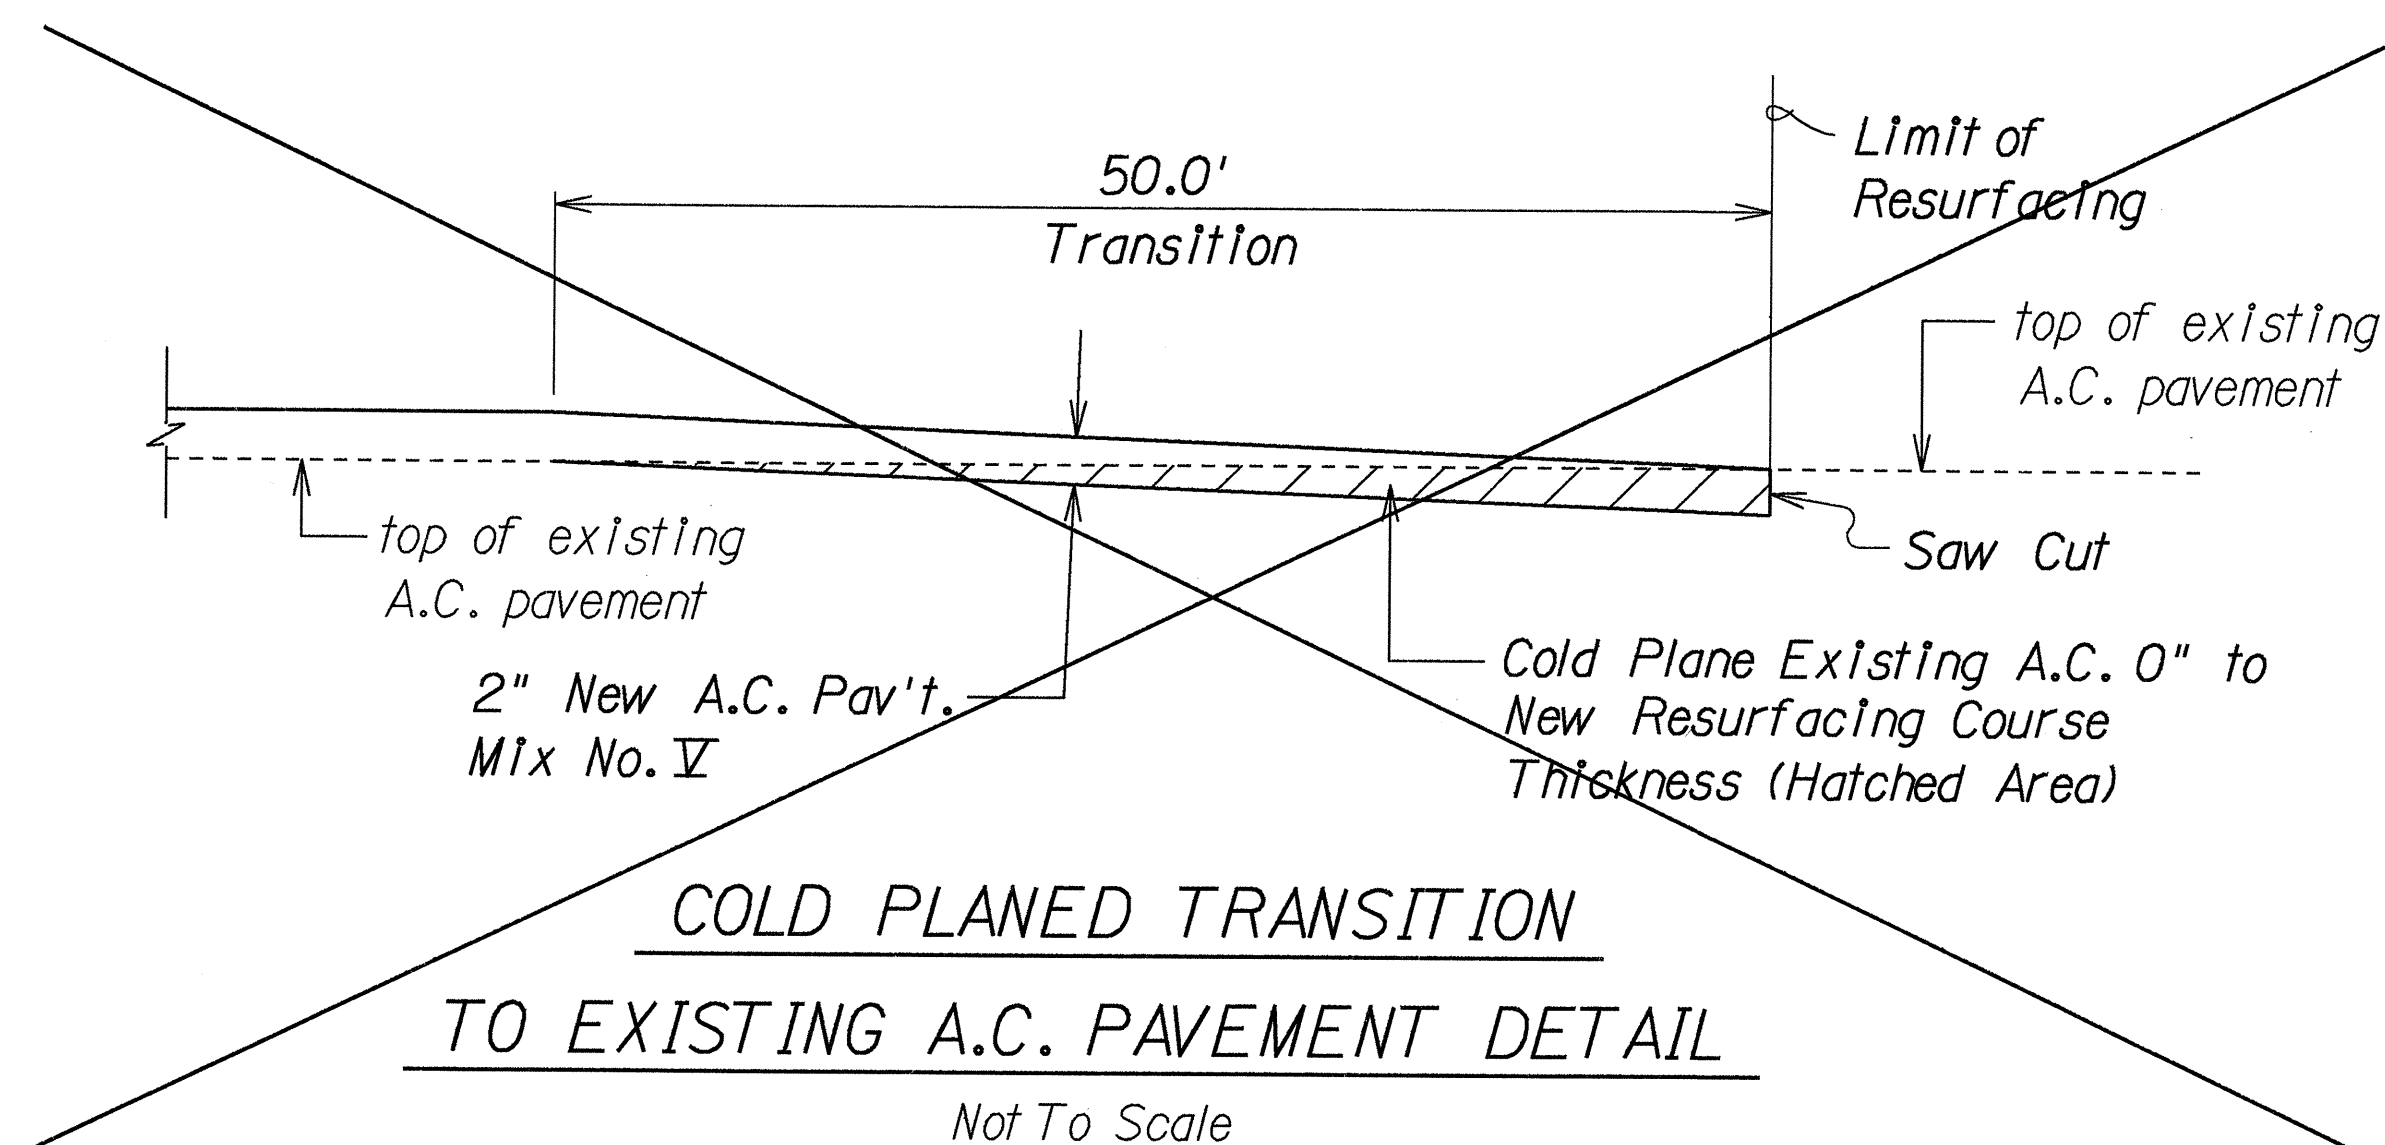


COLD PLANED TRANSITION TO EXISTING A.C. PAVEMENT DETAIL
Not To Scale

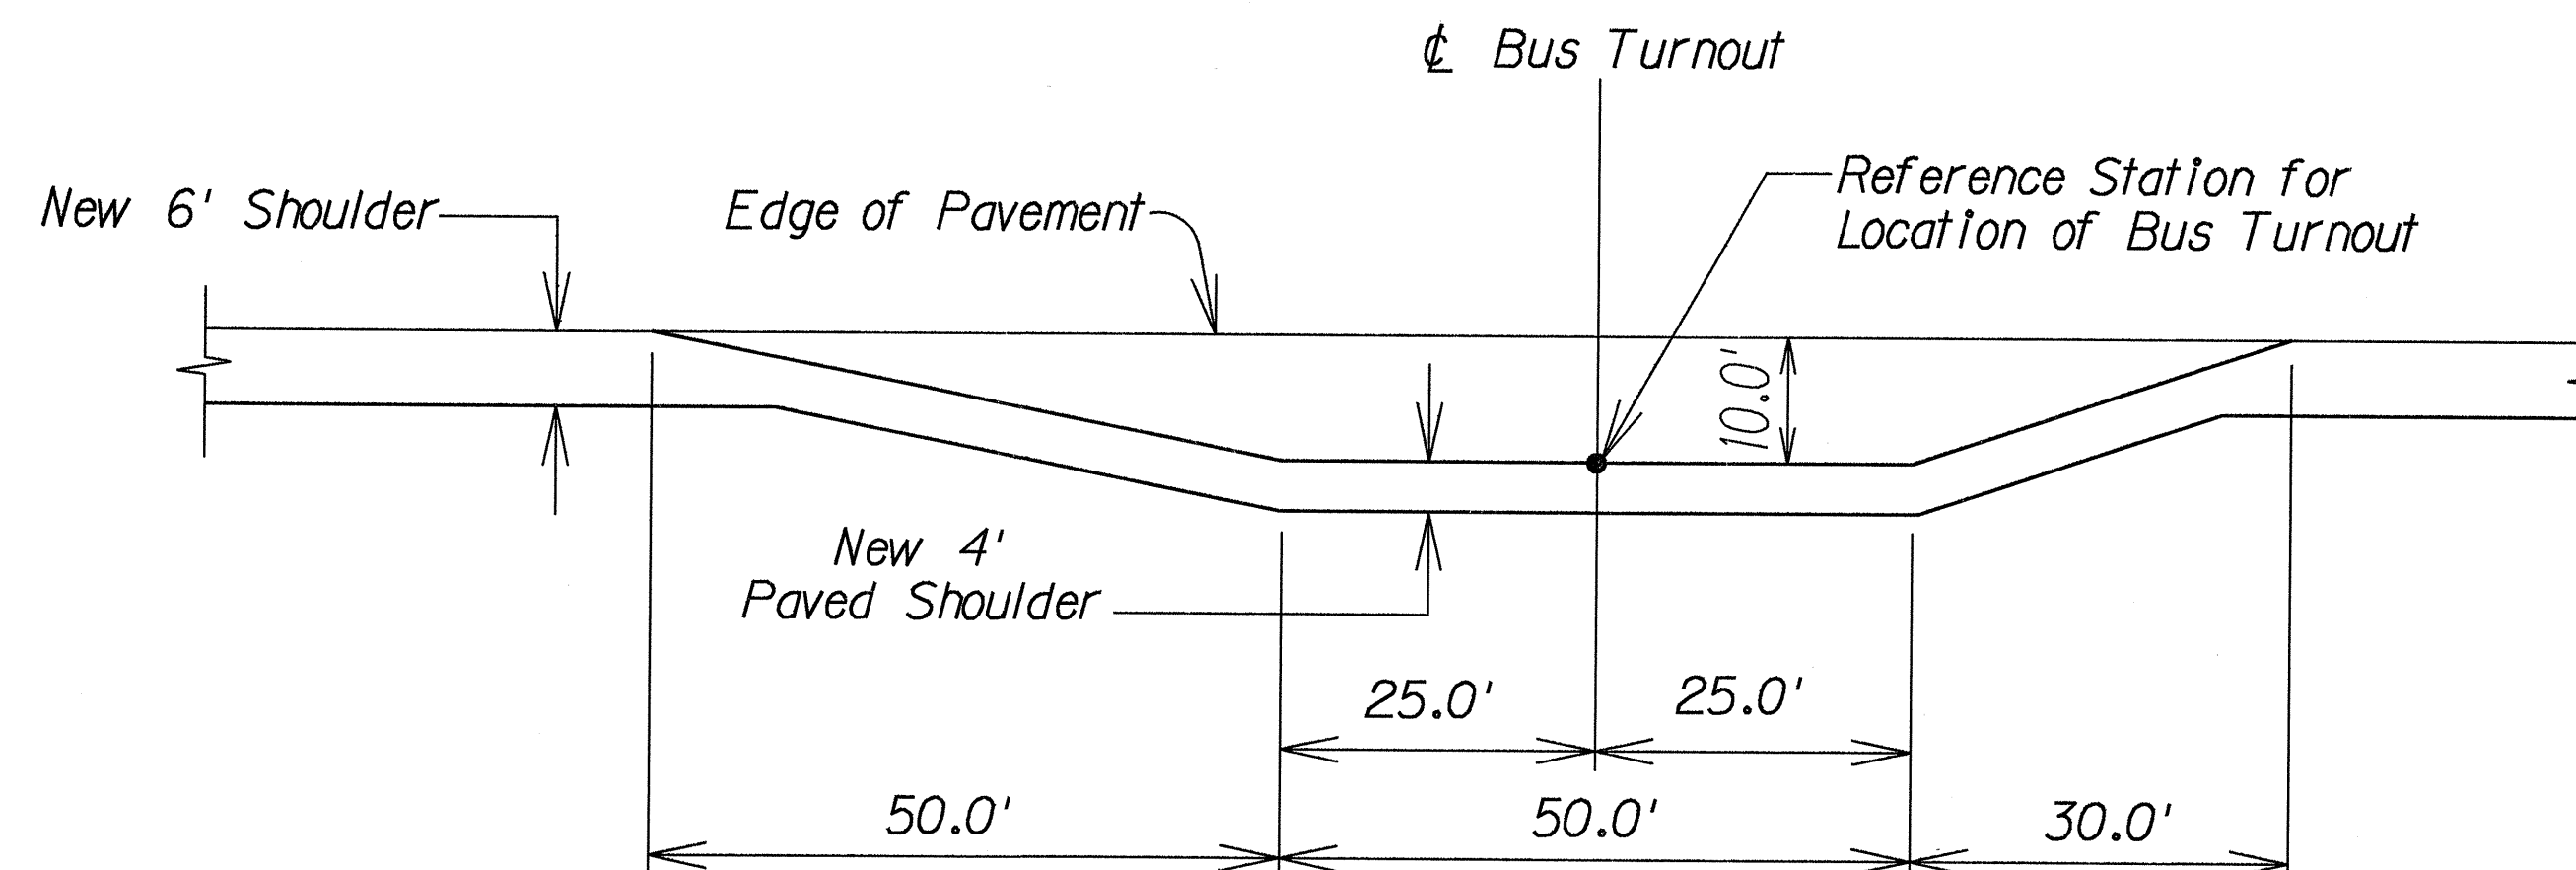

BUS BAY PLAN
Not To Scale

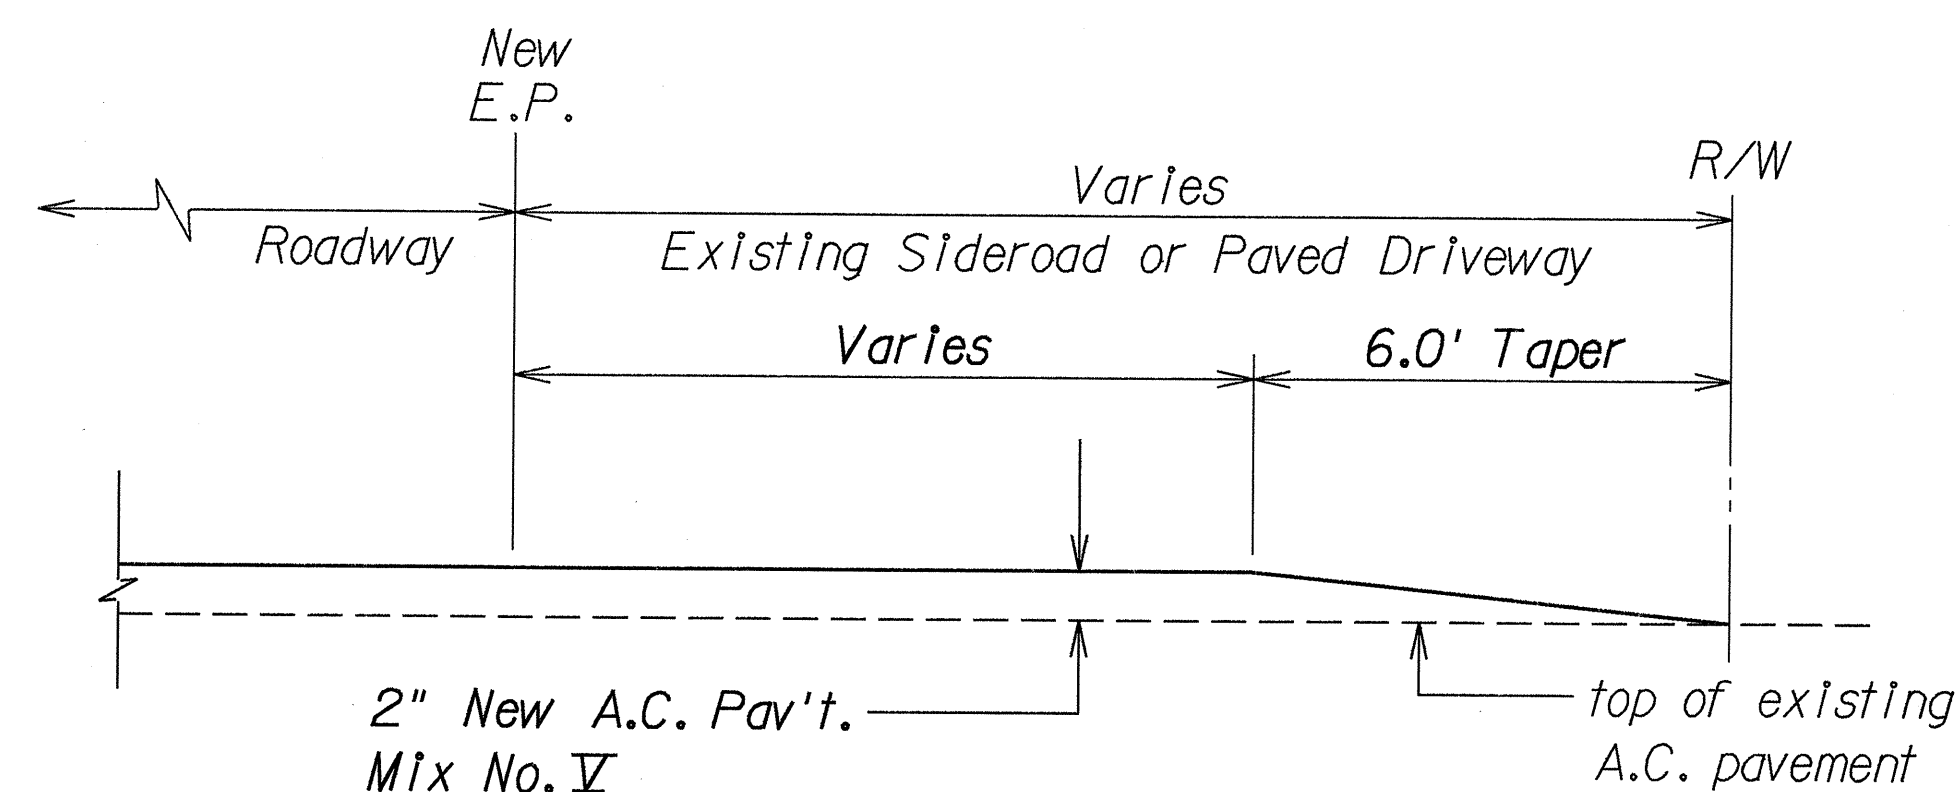

RESURFACING AT PAVED SIDEROAD OR PAVED DRIVEWAY DETAIL
Not To Scale

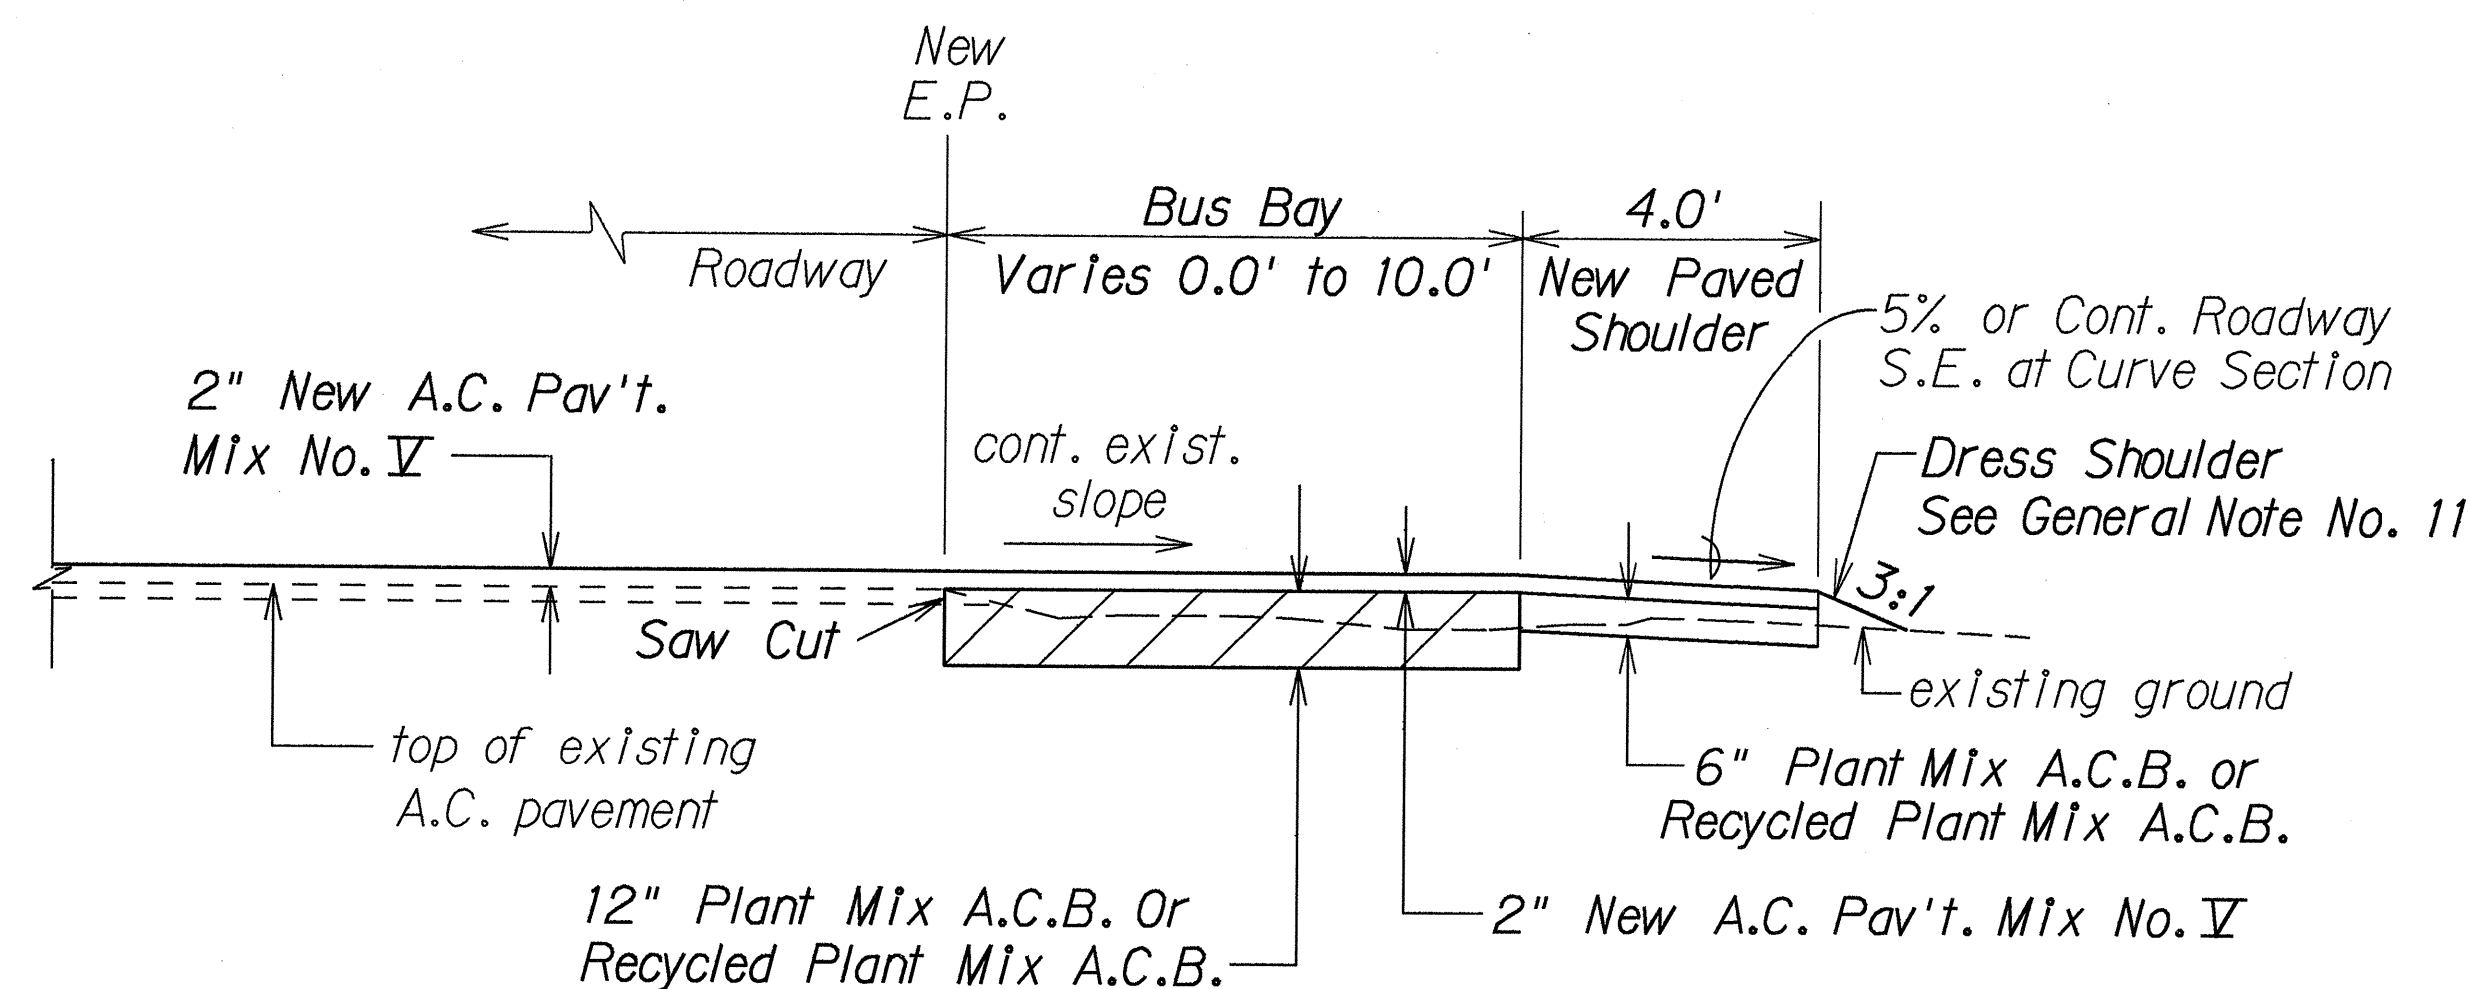

TYPICAL SECTION AT NEW BUS BAY
Not To Scale

LEGEND FOR AS-BUILT POSTINGS	
	Squiggly line for as-built deletion
	Double line for as-built deletion
	Text for as-built posting

STATE OF HAWAII DEPARTMENT OF TRANSPORTATION HIGHWAYS DIVISION	
TYPICAL SECTIONS & DETAILS	
KANE OHE BAY DRIVE Left Turn Lanes at Kokokahi Place, Likeke Place and Mikiola Drive PROJECT NO. 65A-01-89	
Scale: As Shown	Date: June, 1990
SHEET No. 2 OF 2 SHEETS	