
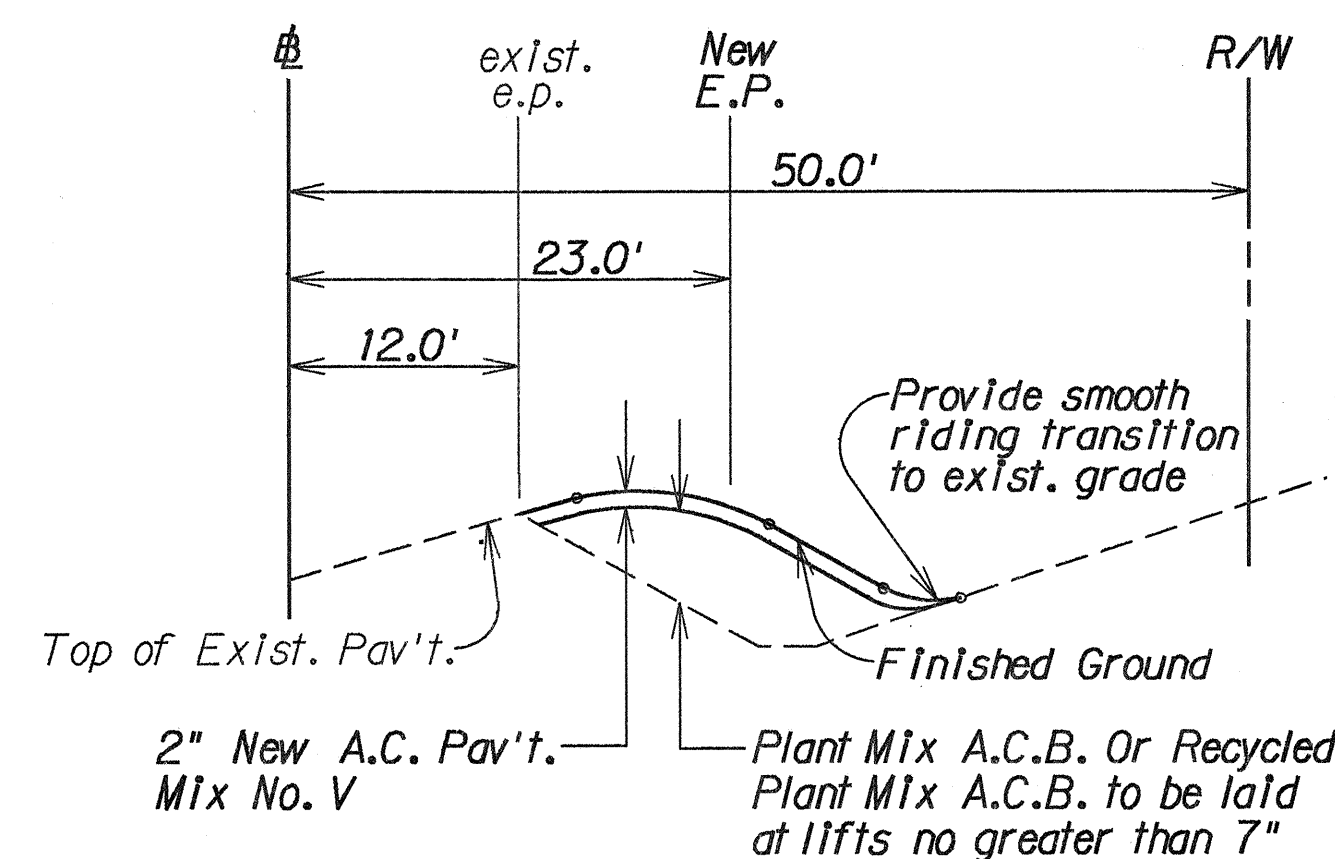


FED. ROAD DIST. NO.	STATE	PROJ. NO.	FISCAL YEAR	SHEET NO.	TOTAL SHEETS
HAWAII	HAW.	65A-03-90	1992	5	10

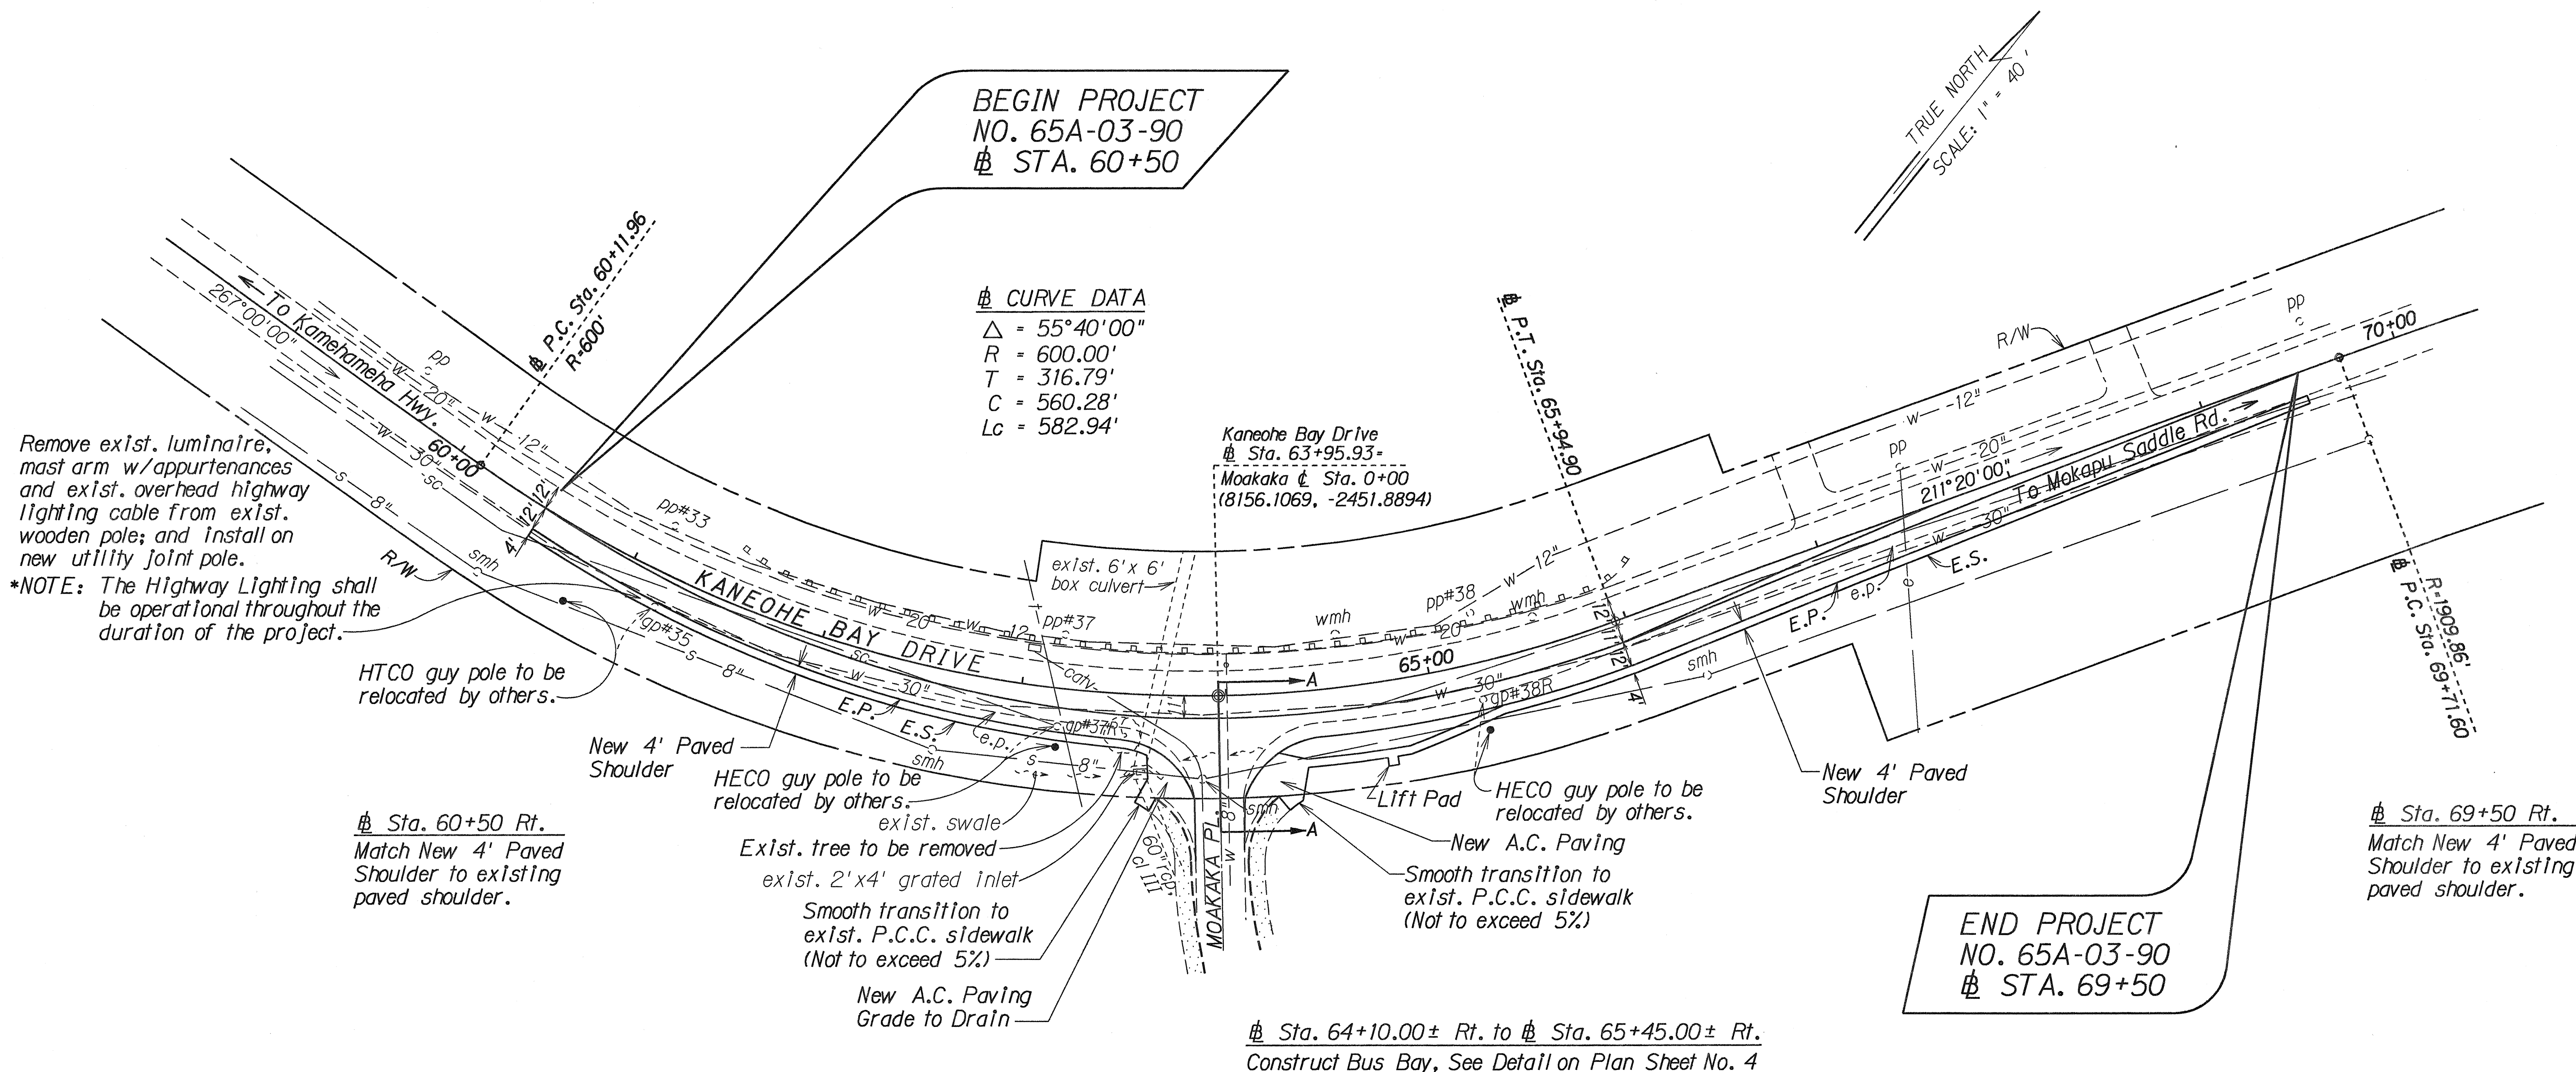

STATE OF HAWAII
DEPARTMENT OF TRANSPORTATION
HIGHWAYS DIVISION

PLAN

KANEOHE BAY DRIVE
Intersection Improvements at Moakaka Pl.
PROJECT NO. 65A-03-90

Scale: 1" = 40' Date: April, 1992

SHEET No. 1 OF 1 SHEETS