	INDEX TO DRAWINGS
SHEET NO.	DESCRIPTION
1	TITLE SHEET
2	STANDARD PLANS SUMMARY
3	GENERAL NOTES AND LEGEND
4	TYPICAL SECTIONS AND DETAILS
5	PLAN
6	PAVEMENT MARKING LEGEND
7	PAVEMENT MARKING AND SIGNING
8	PROFILE
9 - 10	CROSS SECTIONS
	1
1	
,	,
,	

**587-2244** PHONE

STATE OF HAWAII

DEPARTMENT OF TRANSPORTATION HIGHWAYS DIVISION HONOLULU, HAWAII PAS-BULT


PLANS FOR


## KANEOHE BAY DRIVE

INTERSECTION IMPROVEMENTS AT MOAKAKA PLACE

PROJECT NO. 65A - 03 - 90

DISTRICT OF KOOLAUPOKO ISLAND OF OAHU

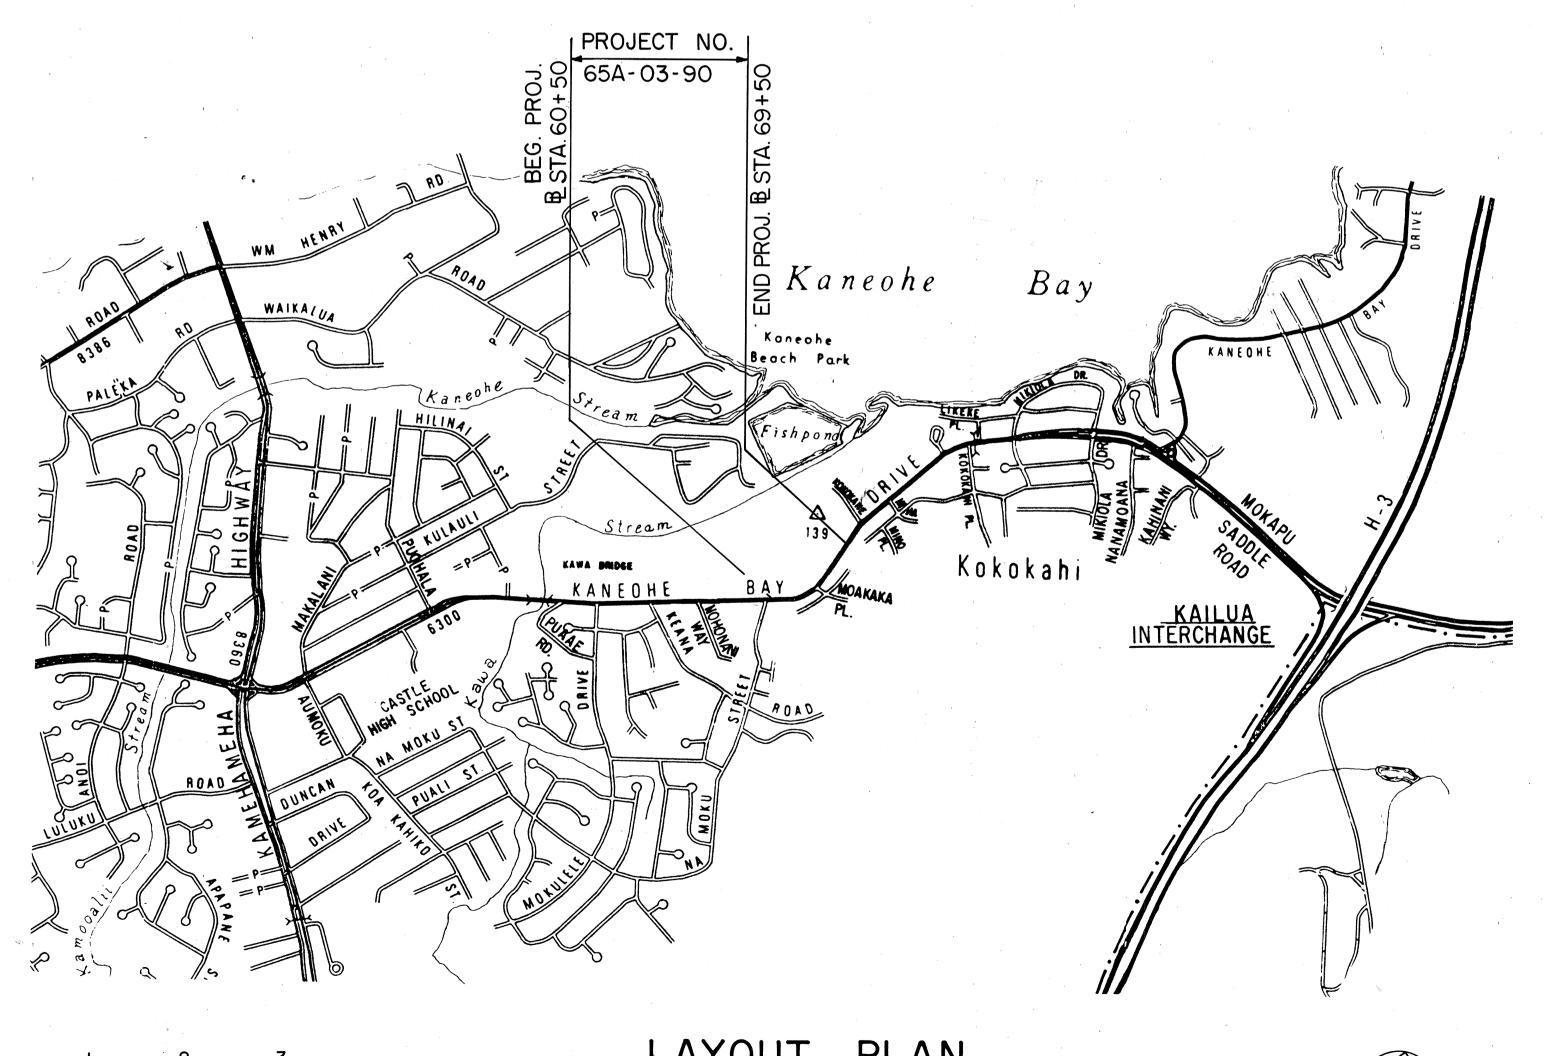

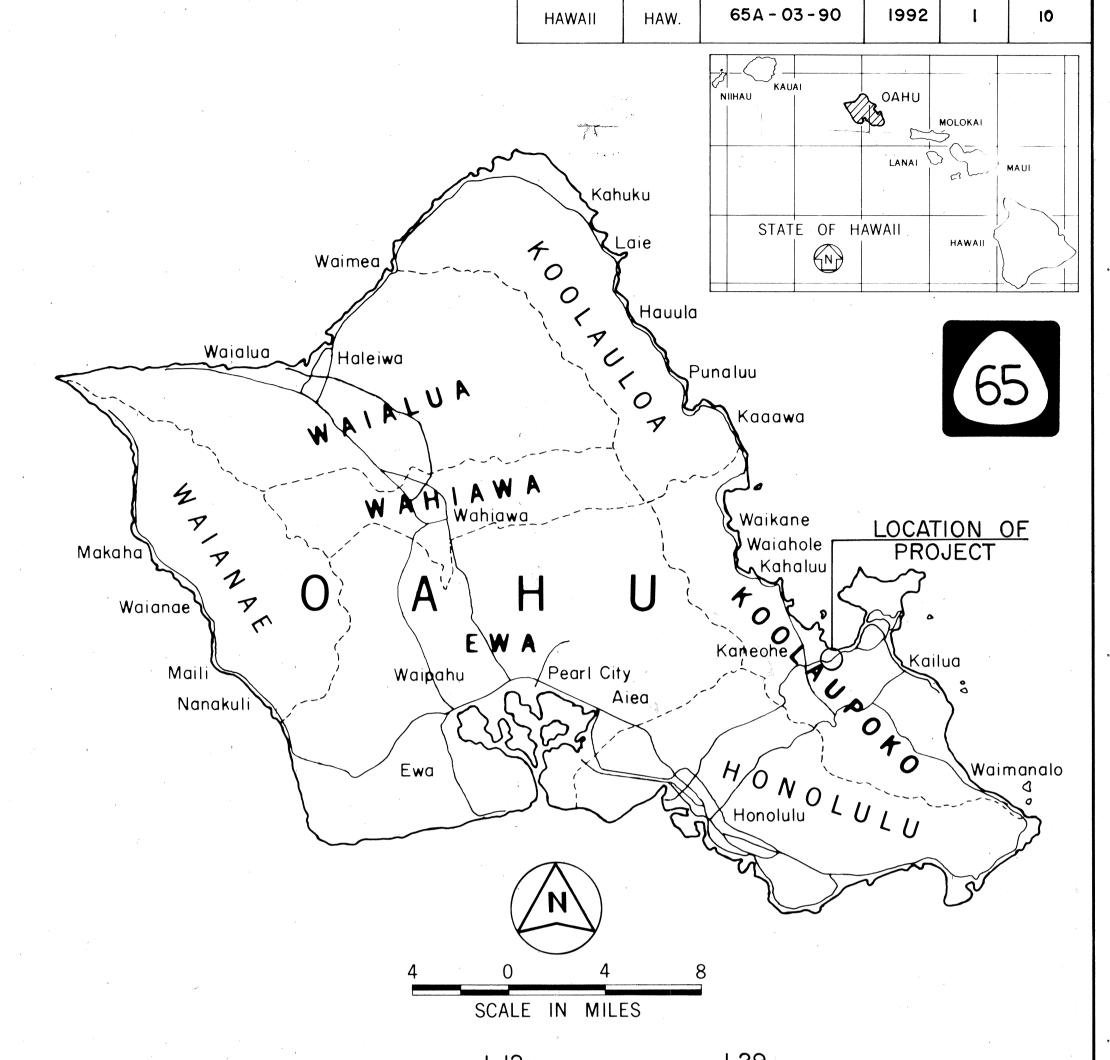

FED. ROAD DIST. NO.

MILE POST 1.12 TO MILE POST 1.29

THE ORIGINAL THEORETICAL QUANTITIES. FOR ACTUAL QUANTITIES, REFER TO PROJECT LEDGER AND/OR COMPUTATION BOOK.

RESIDENT ENGINEER

DEPARTMENT OF TRANSPORTATION STATE OF HAWAII APPROVED:

LAYOUT PLAN

LENGTH OF PROJECT.....O.17 MI.

