	in the second	
		INDEX TO DRAWINGS
SHEET	NO.	DESCRIPTION
1		TITLE SHEET
2		STANDARD PLANS SUMMARY
3		TRAFFIC LEGEND & NOTES
4		PAVEMENT MARKING & SIGNING PLAN
5		TRAFFIC SIGNAL LEGEND & NOTES
6		TRAFFIC SIGNAL DETAILS
7–8	3	TRAFFIC SIGNAL PLAN
9		SWING SIGN BRACKET DETAIL
10		LOOP DETECTOR DETAILS
	·	
		·

STATE OF HAWAII

DEPARTMENT OF TRANSPORTATION


HIGHWAYS DIVISION HONOLULU, HAWAII "AS-BUILT"

PLANS FOR

MOKAPU SADDLE ROAD


TRAFFIC SIGNALS AT KAPAA QUARRY ROAD FEDERAL AID PROJECT NO. STP-065-1(4)

> DISTRICT OF KOOLAUPOKO ISLAND OF OAHU

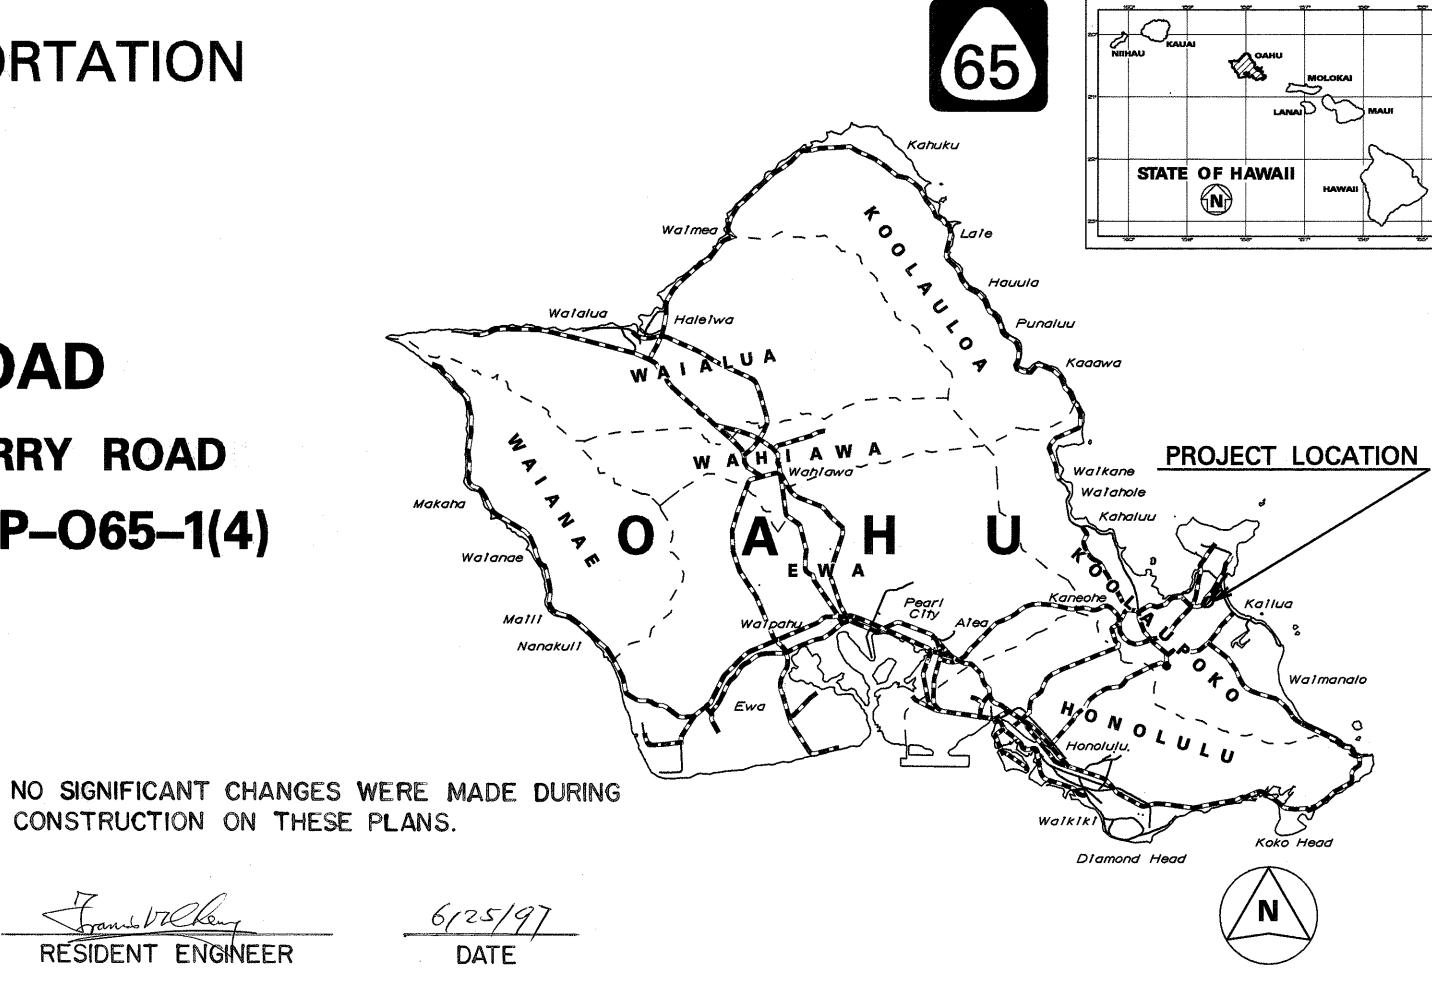

CONSTRUCTION ON THESE PLANS.

RESIDENT ENGINEER

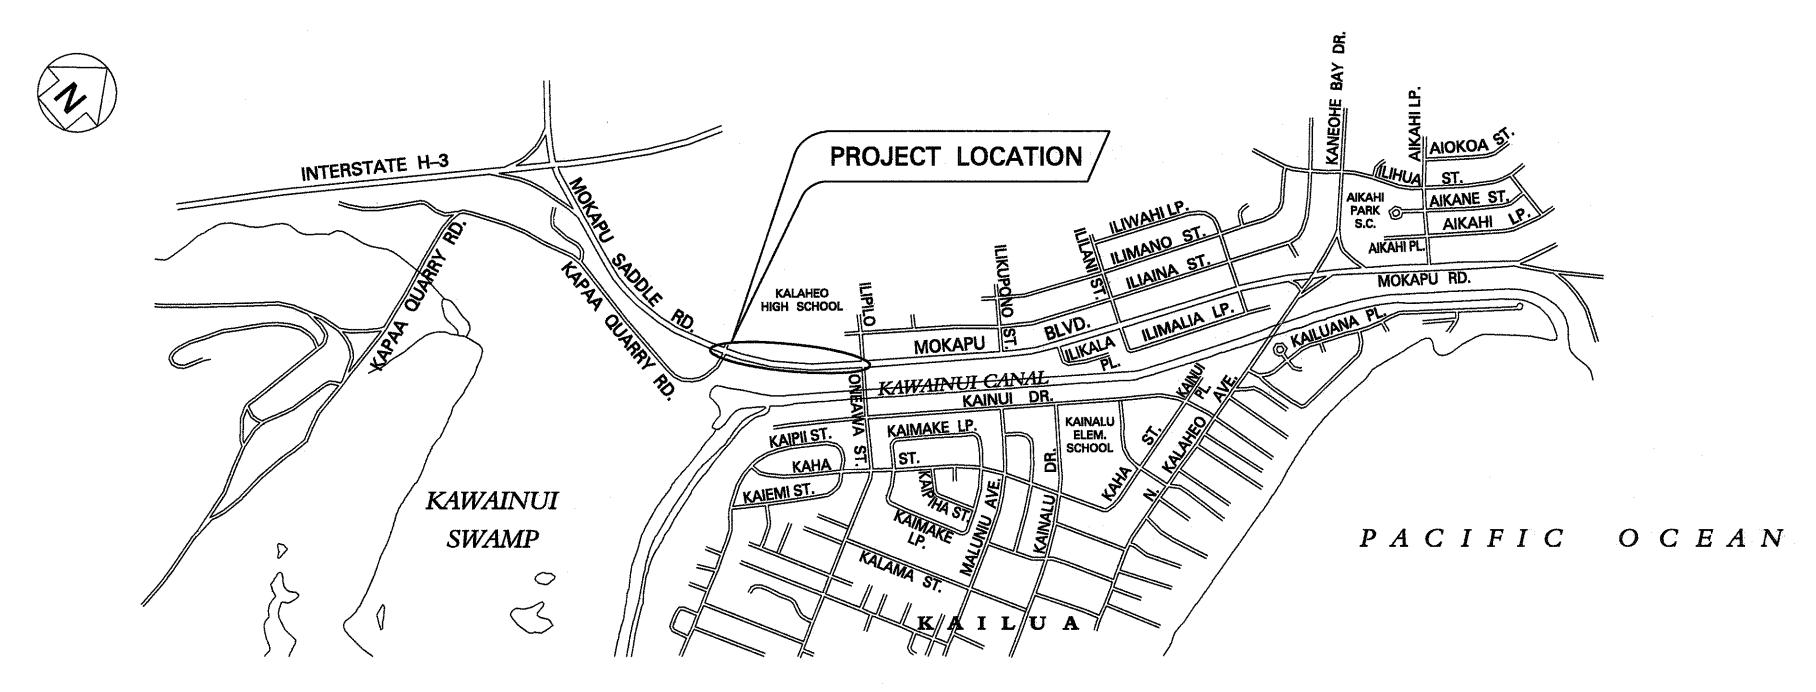

LAYOUT PLAN

SCALE IN THOUSAND FEET

---- FEDERAL AID PROJECTS PREVIOUSLY CONSTRUCTED OR UNDER CONSTRUCTION

SCALE IN MILES

FED. AID PROJ. NO.

HAW. STP-065-1(4)

FISCAL SHEET YEAR NO.

SHEETS

MILE POST 2.85 TO MILE POST 3.25

DESIGN DESIGNATION

_		
ADT	(1994)	2,391
ADT	(2014)4	8,587
DHV		,744
D .		19/51
T .		3.0 %
T ₂₄ .		l.0 %
V .	. <i>.</i>	10 M.P.H

DEPARTMENT OF TRANSPOR STATE OF HAWAII	RTATION
APPROVED:	
løgs Hayashid	5/1/95
DIR. OF TRANSPORTATION	DAT