






FED. ROAD DIST. NO.	STATE	FED. AID PROJ. NO.	FISCAL YEAR	SHEET NO.	TOTAL SHEETS
HAWAII	HAW.	STP-065-1(4)	1995	C.O. 6	10

- Notes:
1. Pedestal shall be hot-dipped galv. after fabrication.
 2. All fastening bolts, nuts & washers shall be stainless steel.
 3. Provide 4 ft. cl. in front of meter.
 4. * Sealable enclosure 6"Dx10"Wx12"H.

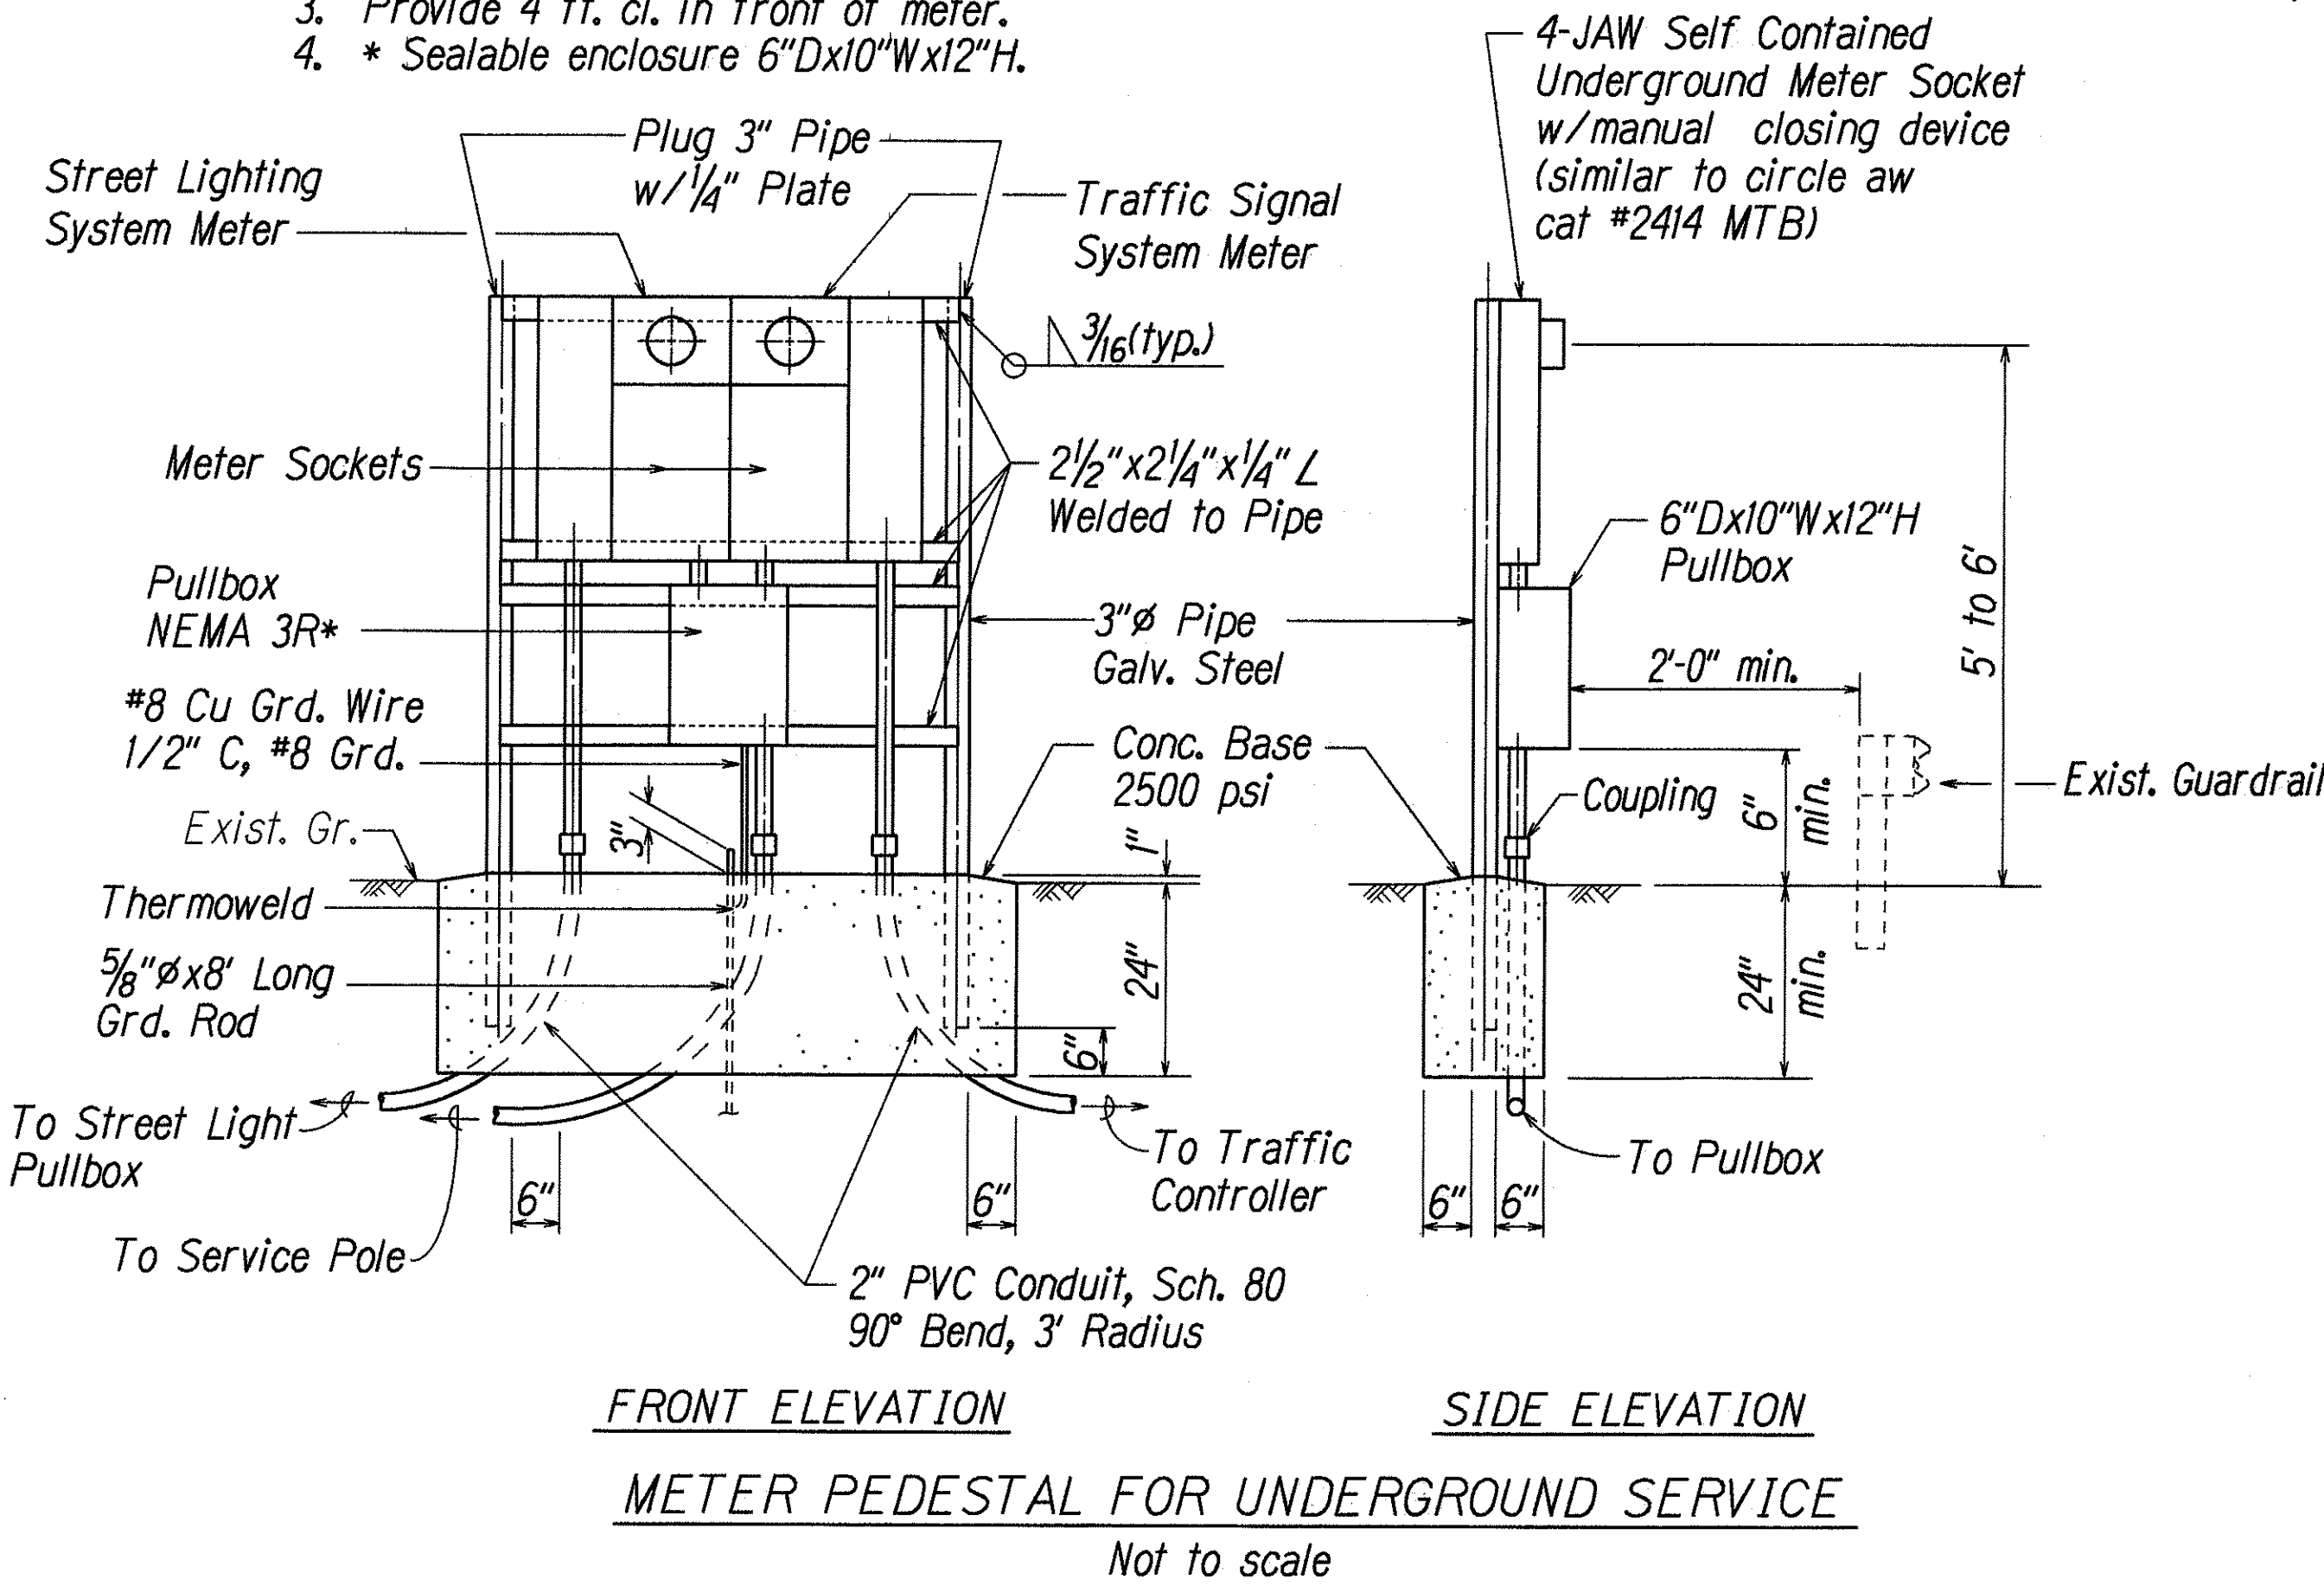

- NOTES:
1. Contractor shall make all electrical connections to controller, provide 2-IP50A breaker, ground and concrete-encased 2" conduit.
 2. All conduits to contain a polyolefin pull line (Jet Line cat. #232 or equivalent).
 3. The installation of the meter pedestal for underground service will not be paid for separately but considered incidental to the Meter Socket and Breaker (50 amps).

ELECTRICAL SERVICE DETAIL

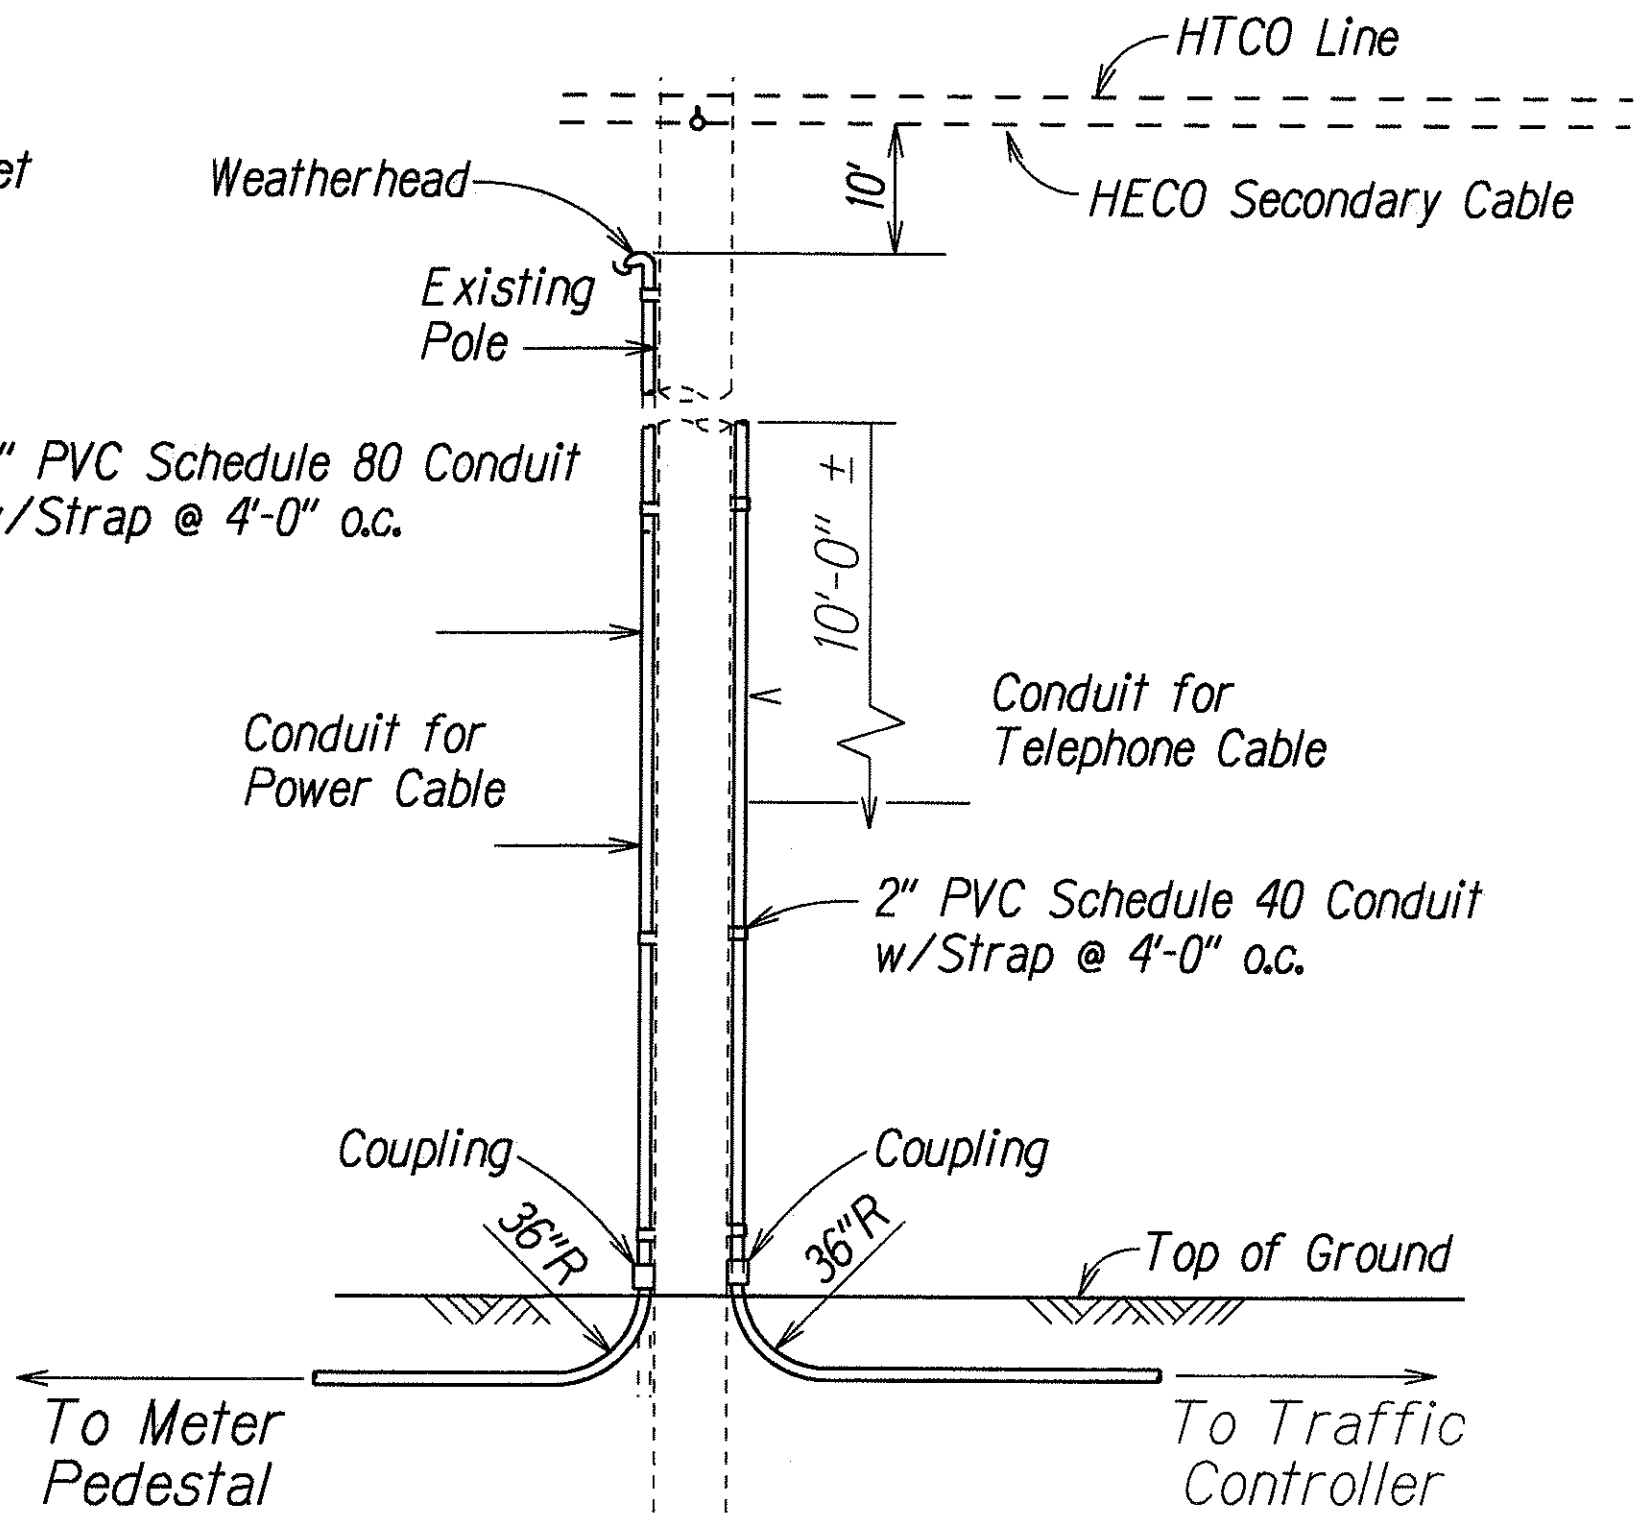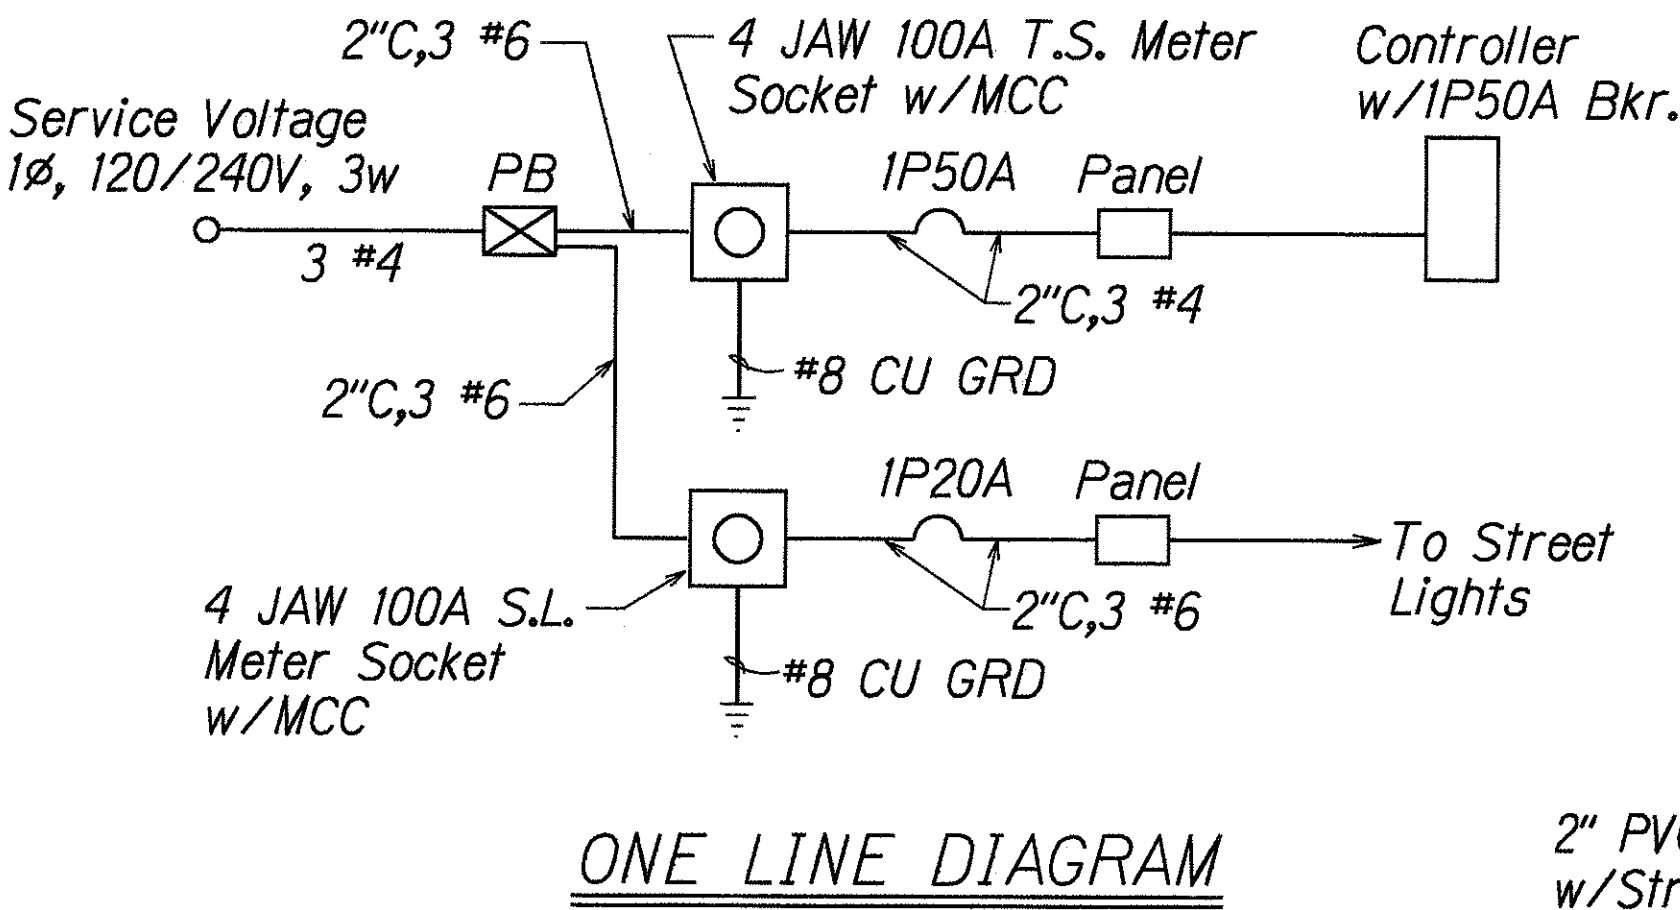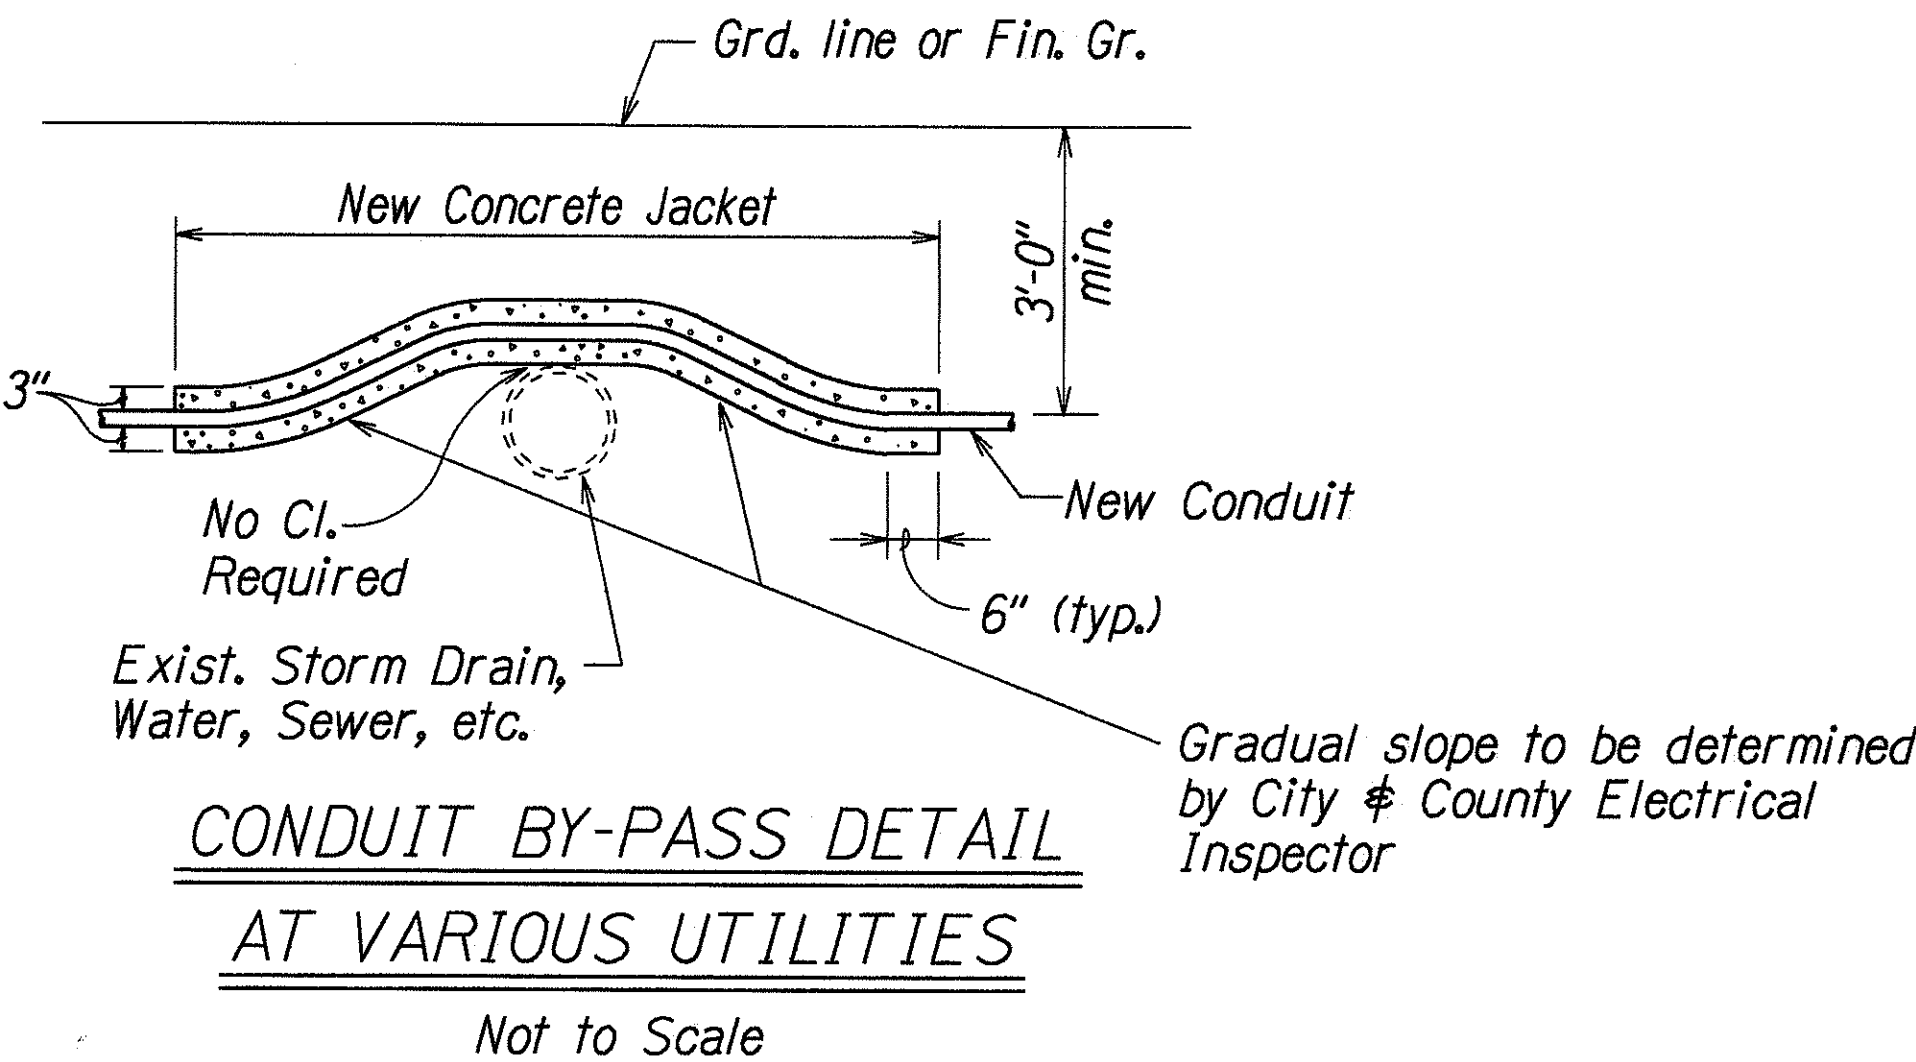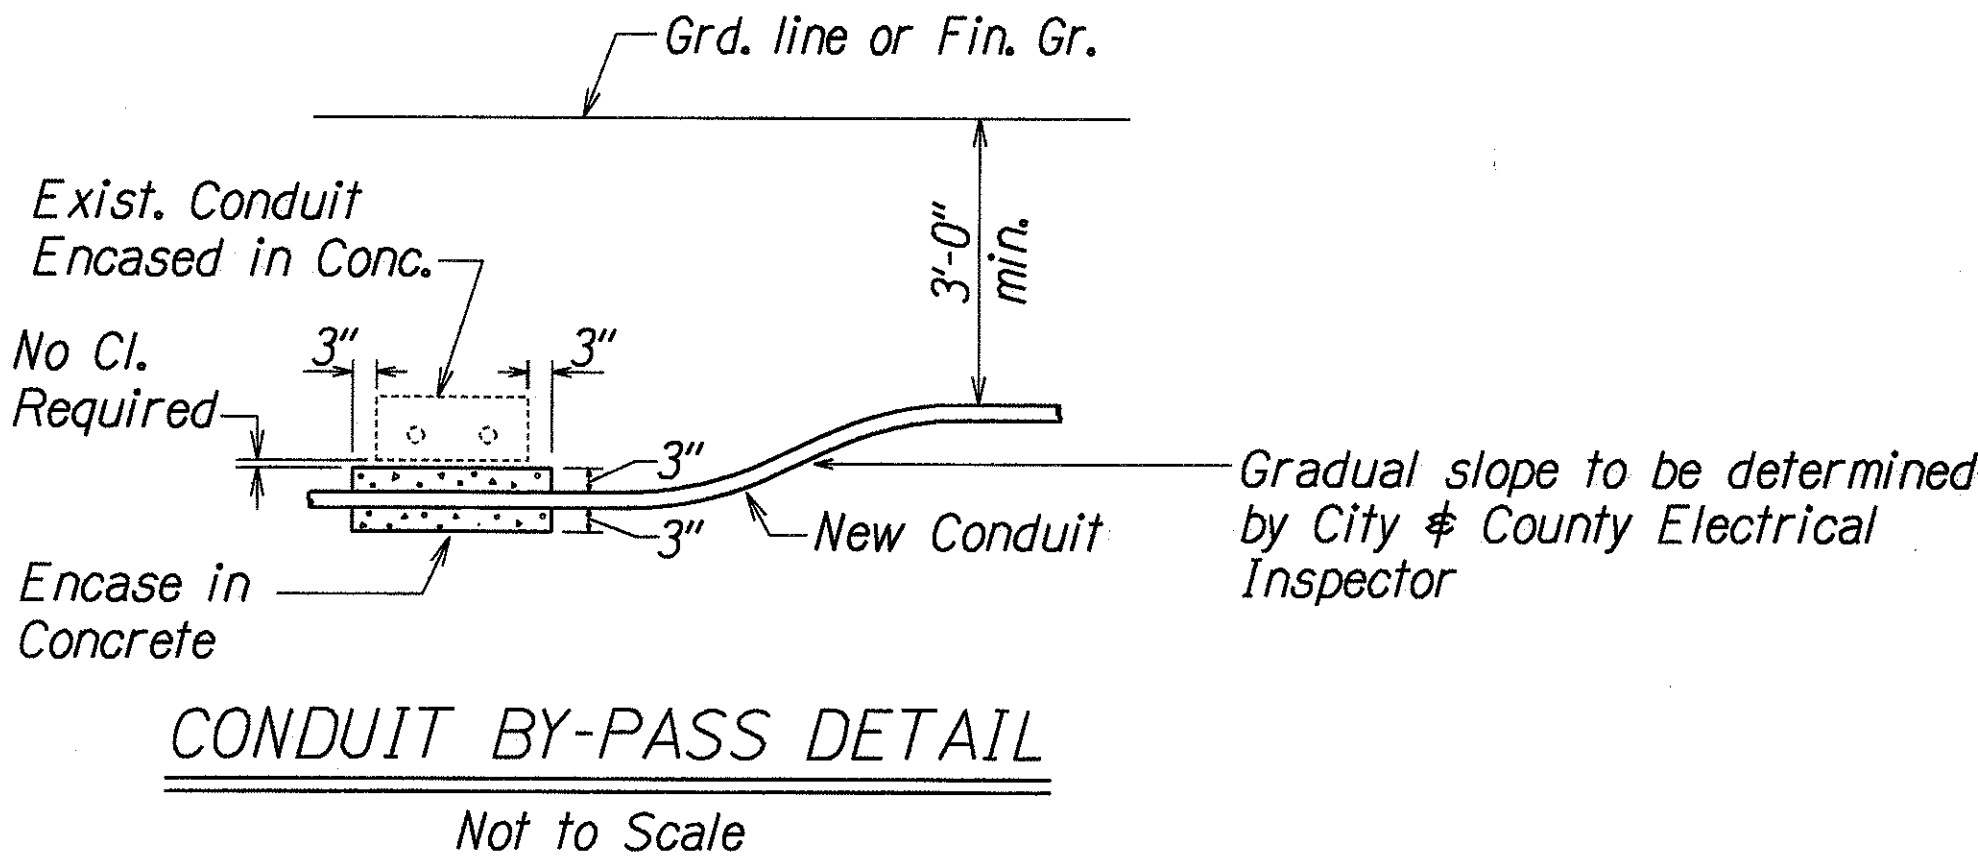

Sta. 64+00± Rt. (tp #26)

ELECTRICAL & TELEPHONE

SERVICE POLE DETAIL

Not to Scale

3/21/96 Revised Service Details, Conduit By-Pass Detail, and add one line Diagram Delete Pullbox near Service Pole

DATE REVISION

STATE OF HAWAII
DEPARTMENT OF TRANSPORTATION
HIGHWAYS DIVISION

TRAFFIC SIGNAL DETAILS

MOKAPU SADDLE ROAD

Traffic Signals at Kapaa Quarry Road

Fed. Aid Project No. STP-065-1(4)

Not to Scale Date: Apr., 1995

SHEET No. 1 OF 1 SHEETS