

INDEX TO DRAWINGS	
SHEET NO.	DESCRIPTION
1	TITLE SHEET
2	STANDARD PLANS SUMMARY
3	GENERAL NOTES AND LEGEND
4 - 9	PLANS AND DRAINAGE DETAILS

STATE OF HAWAII

DEPARTMENT OF TRANSPORTATION

HIGHWAYS DIVISION

HONOLULU, HAWAII

"AS-BUILT"

PLANS FOR

MOKAPU SADDLE ROAD

DRAINAGE IMPROVEMENTS

KANEOHE BAY DRIVE TO VICINITY OF




BOARD OF WATER SUPPLY ACCESS ROAD

FEDERAL-AID PROJECT NO. STP-065-1(5)

DISTRICT OF KOOLAUPOKO

ISLAND OF OAHU

FED. ROAD DIST. NO.	STATE	FED. AID PROJ. NO.	FISCAL YEAR	SHEET NO.	TOTAL SHEETS
HAWAII	HAW.	STP-065-1(5)	1997	1	9

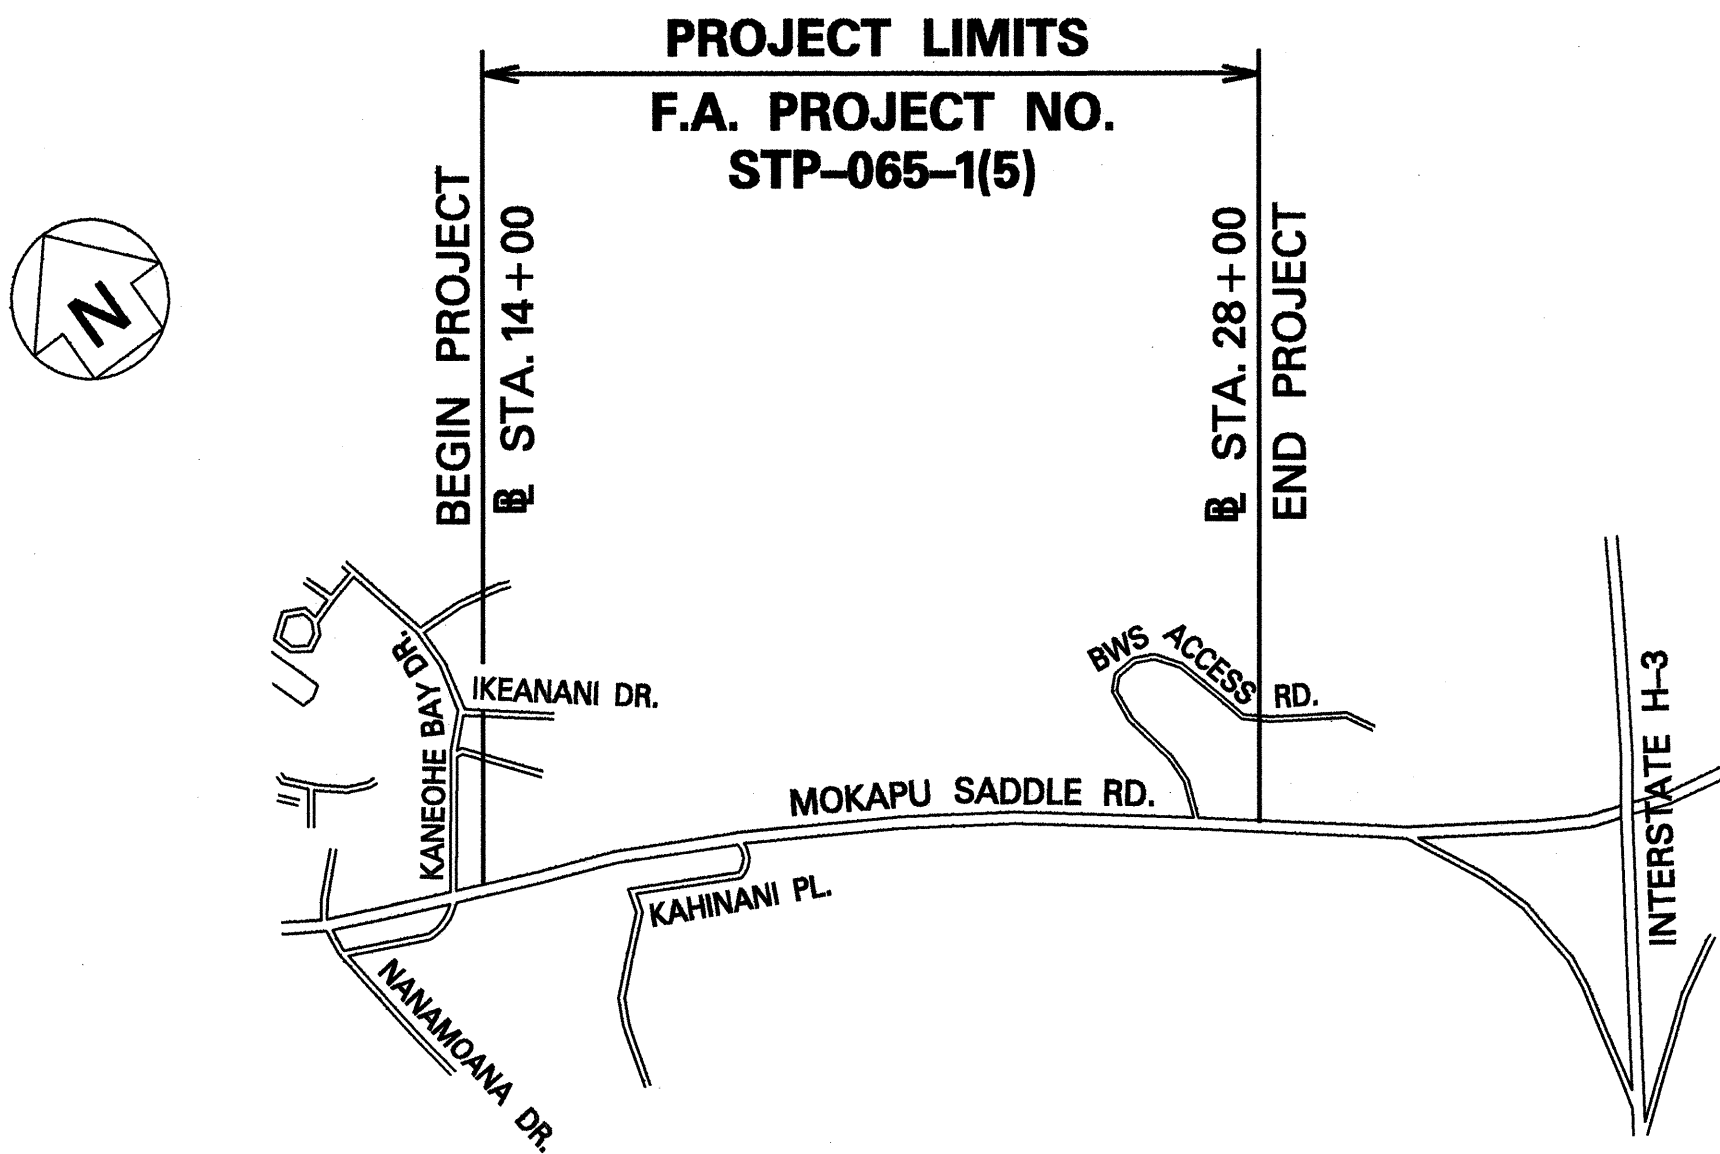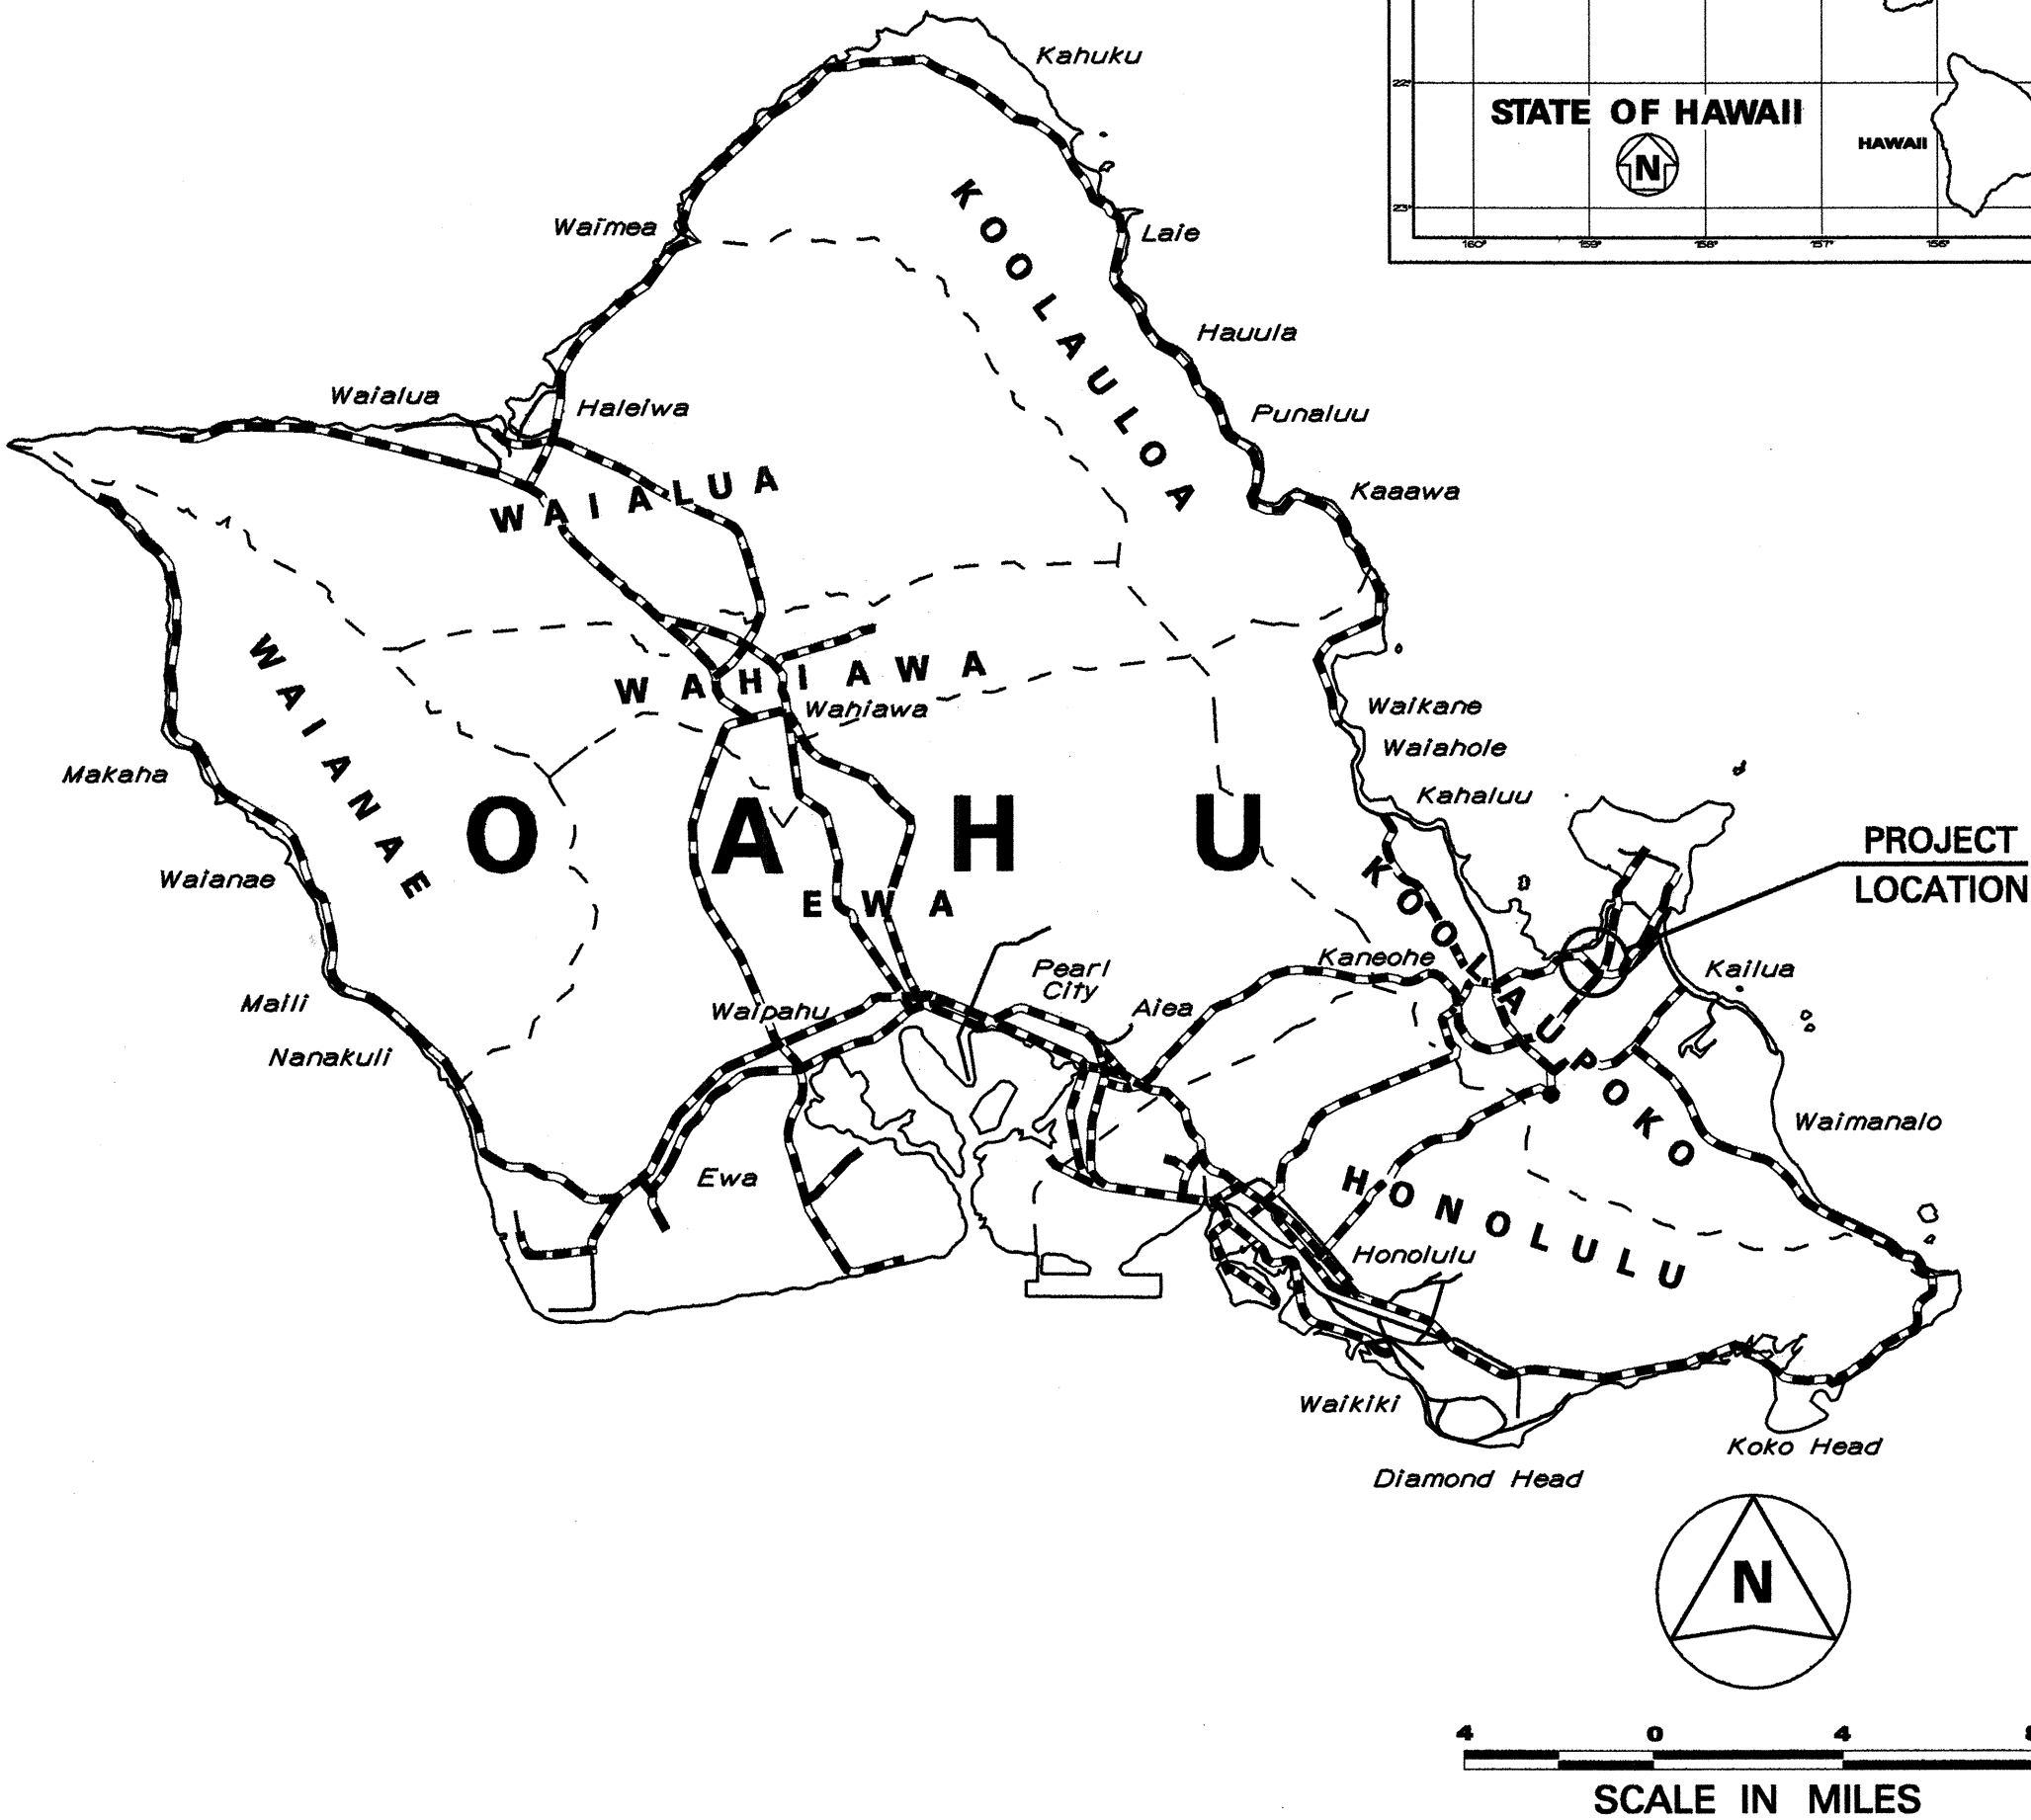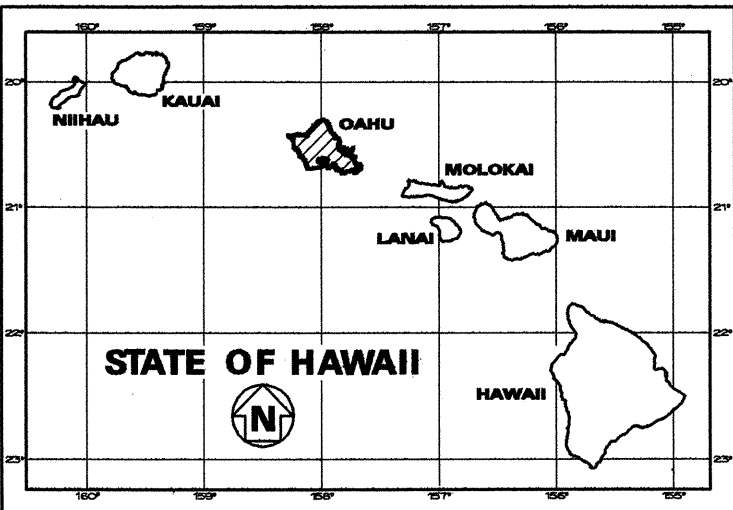

FEDERAL AID PROJECTS PREVIOUSLY CONSTRUCTED OR UNDER CONSTRUCTION

MILE POST 2.00 TO MILE POST 2.26

DESIGN DESIGNATION

ADT (1996)	19,830
ADT (2006)	21,500
DHV	1,720
D	50/50
T	8.0 %
V	35 M.P.H.

CHANGES MADE DURING CONSTRUCTION HAVE BEEN INCORPORATED ON THESE PLANS EXCEPT CHANGES IN THE ORIGINAL THEORETICAL QUANTITIES. FOR ACTUAL QUANTITIES, REFER TO PROJECT LEDGER AND/OR COMPUTATION BOOK.

RESIDENT ENGINEER

DATE

OCT. 1996

DATE

587-2250

PHONE

R. HIRONAKA

P.S. & E. BY


R. SAKAMOTO

DESIGNED BY

LAYOUT PLAN

GROSS LENGTH OF PROJECT 0.26 MILES

NET LENGTH OF PROJECT 0.26 MILES

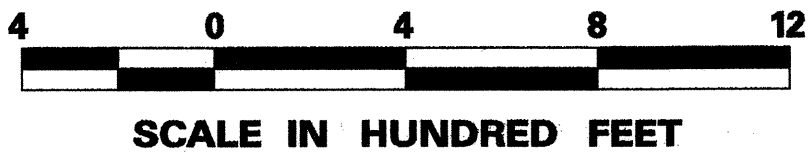

DEPARTMENT OF TRANSPORTATION STATE OF HAWAII	
APPROVED:	
	5/20/97
DIR. OF TRANSPORTATION	DATE