

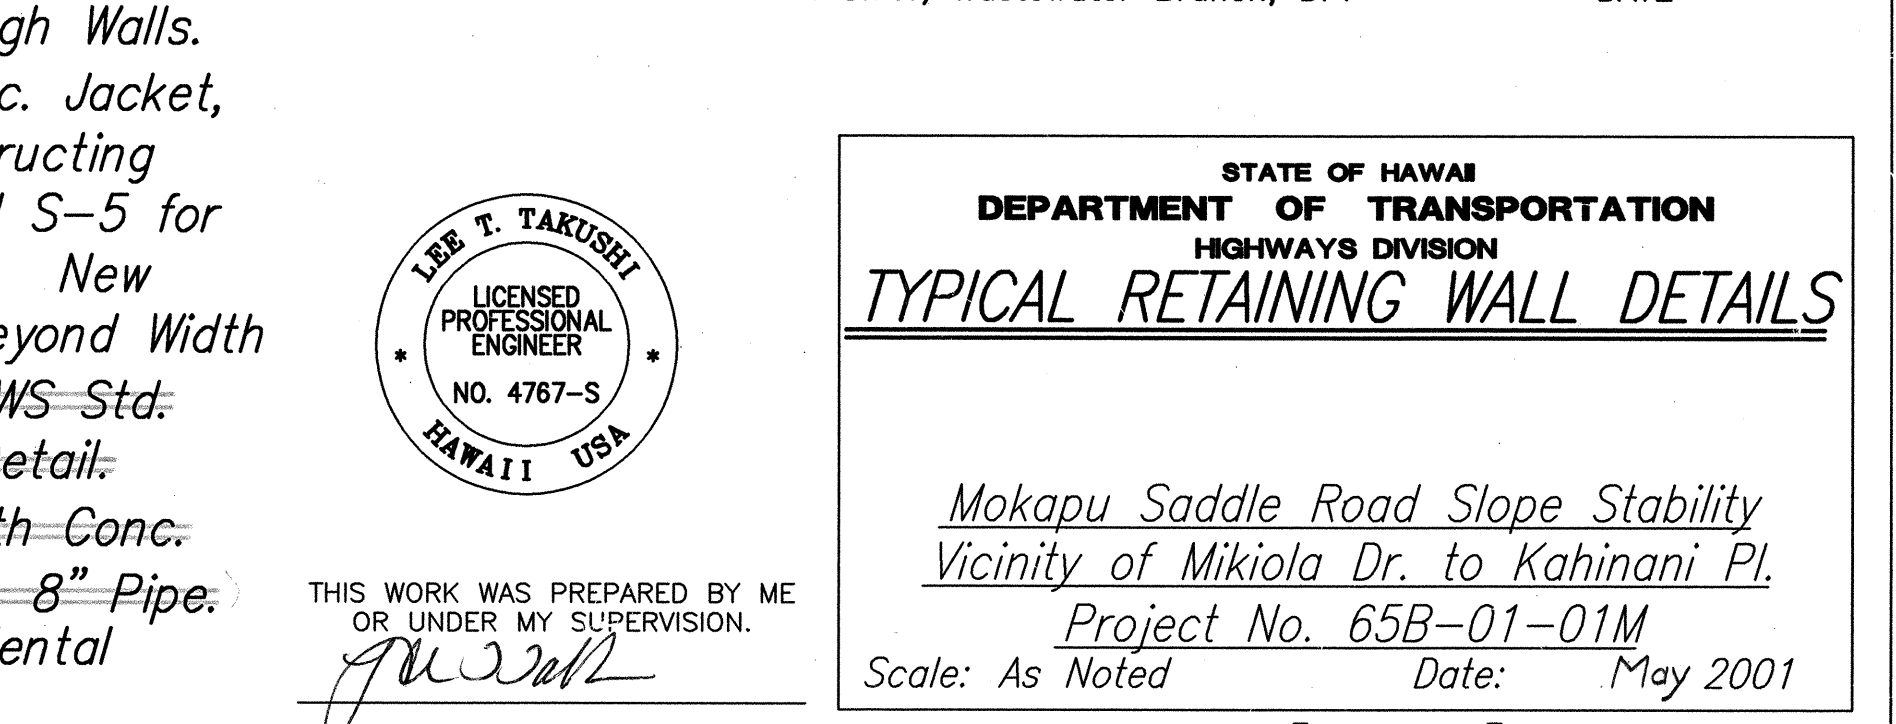
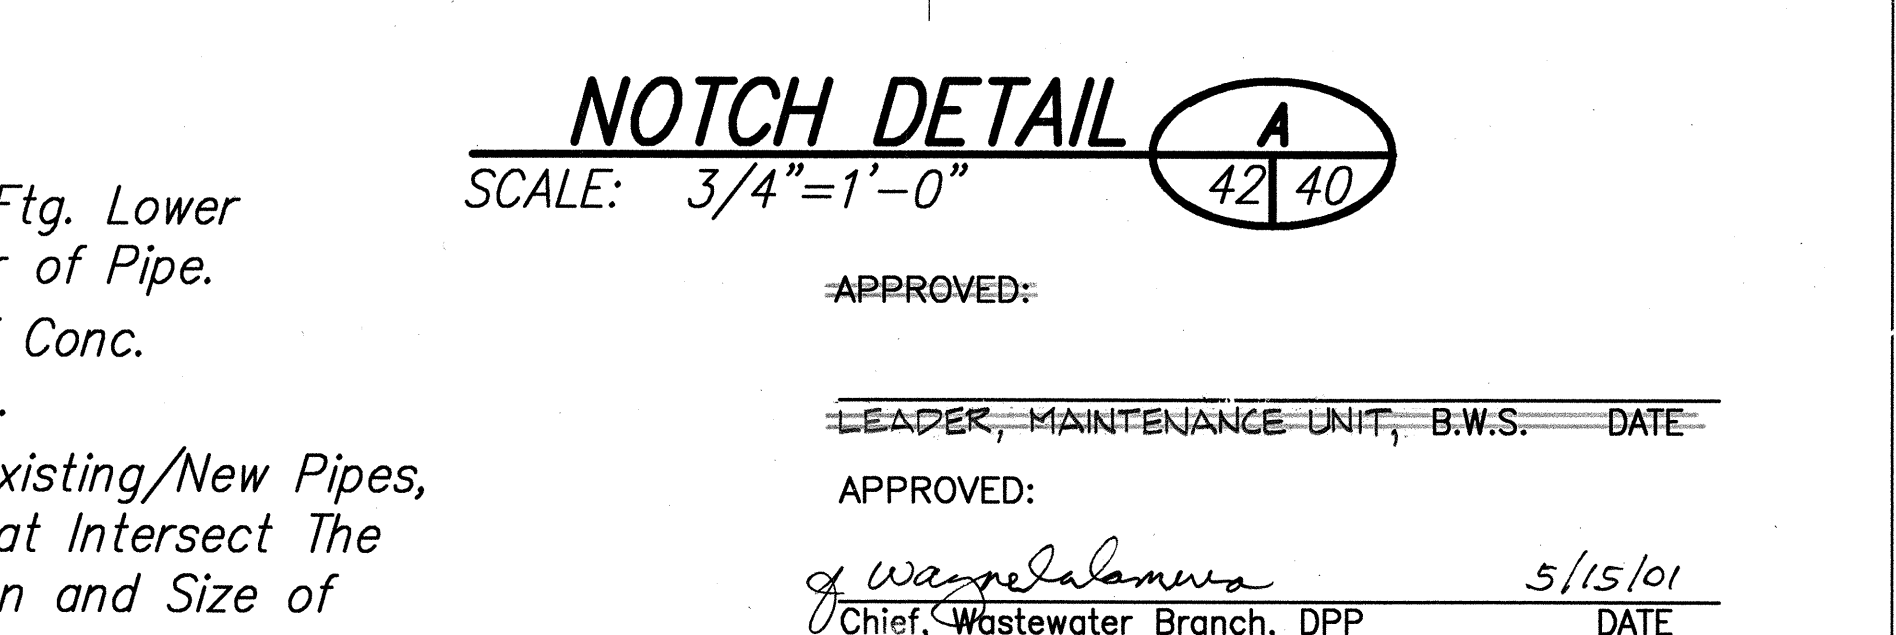
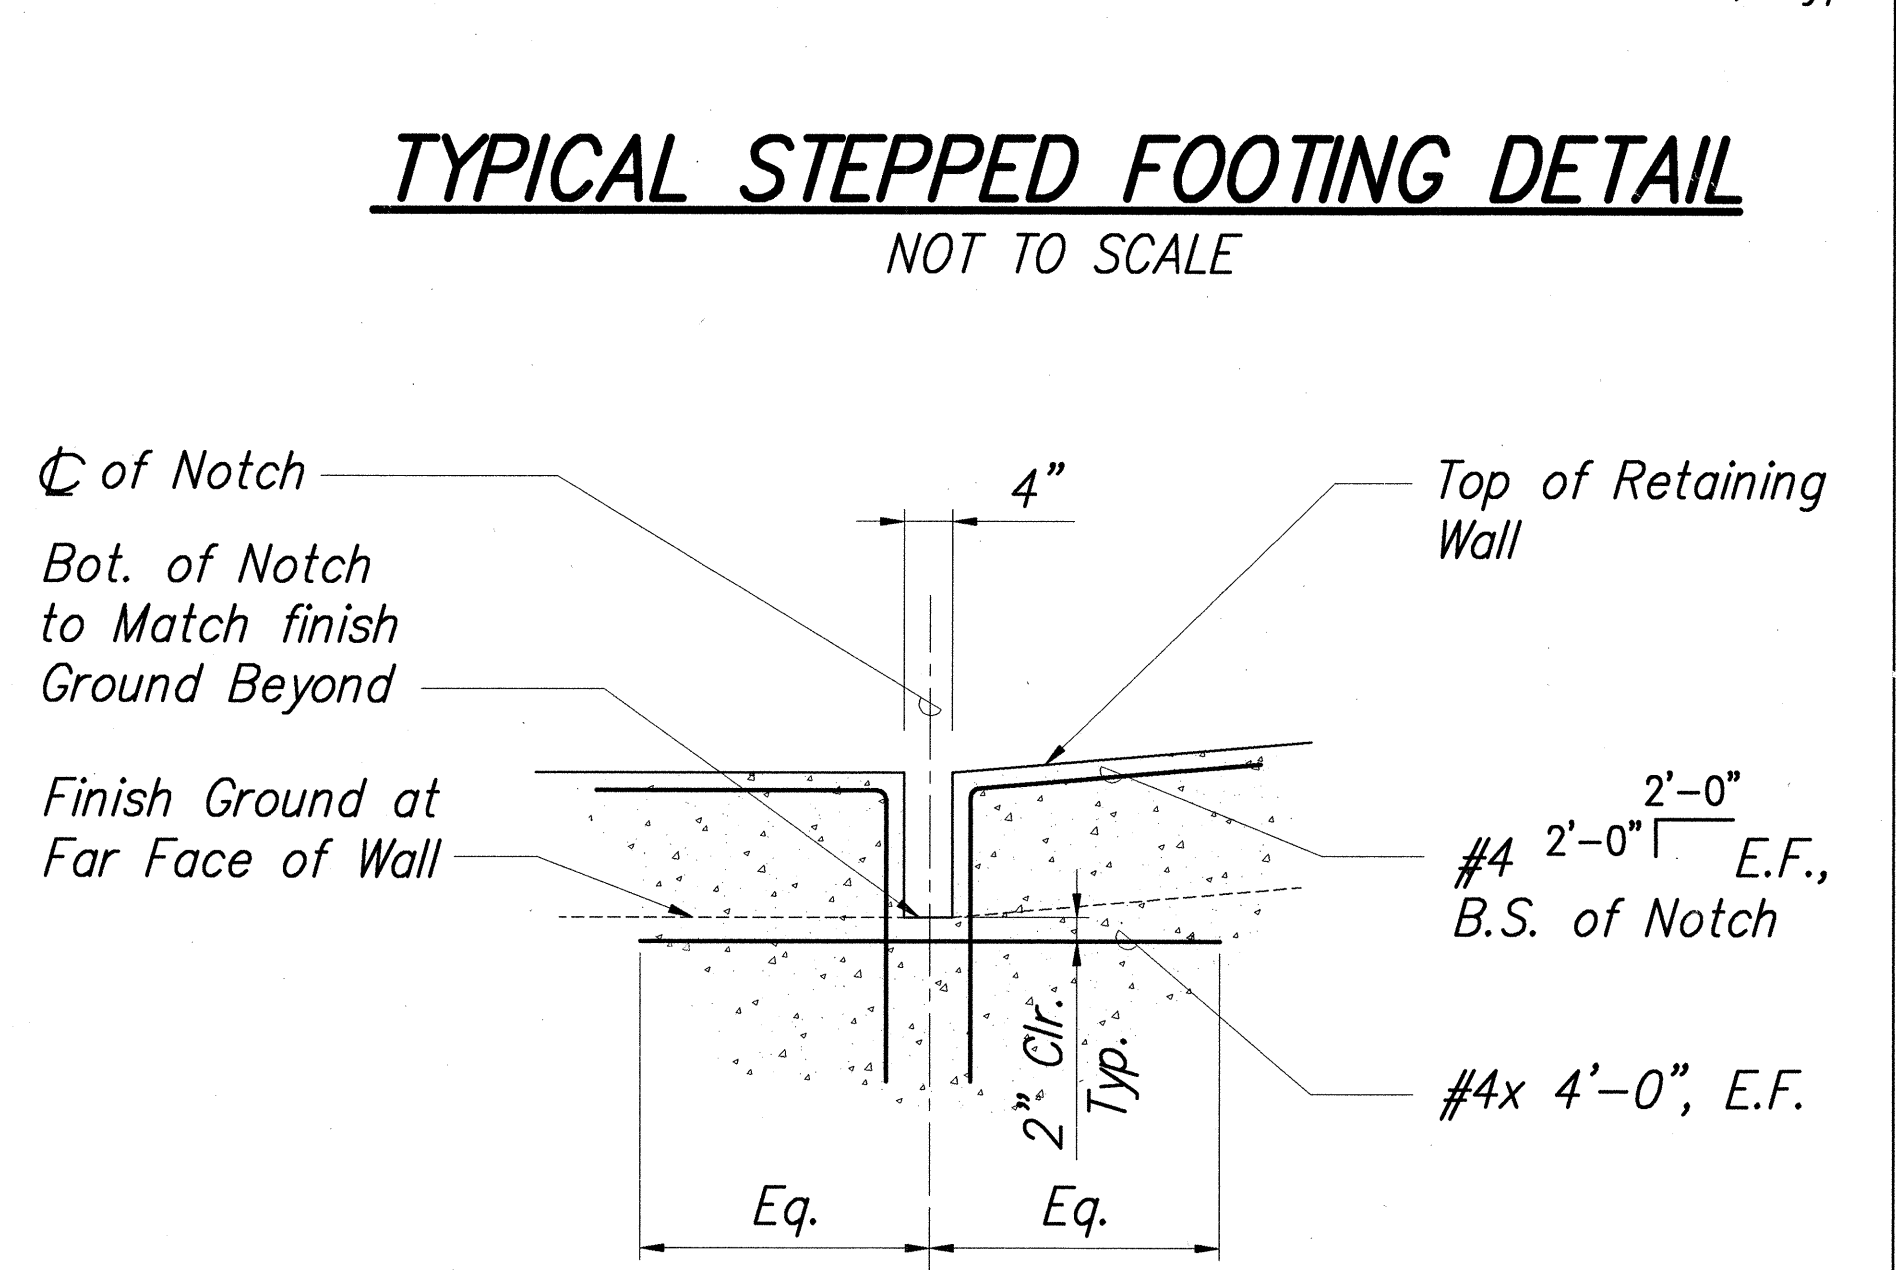
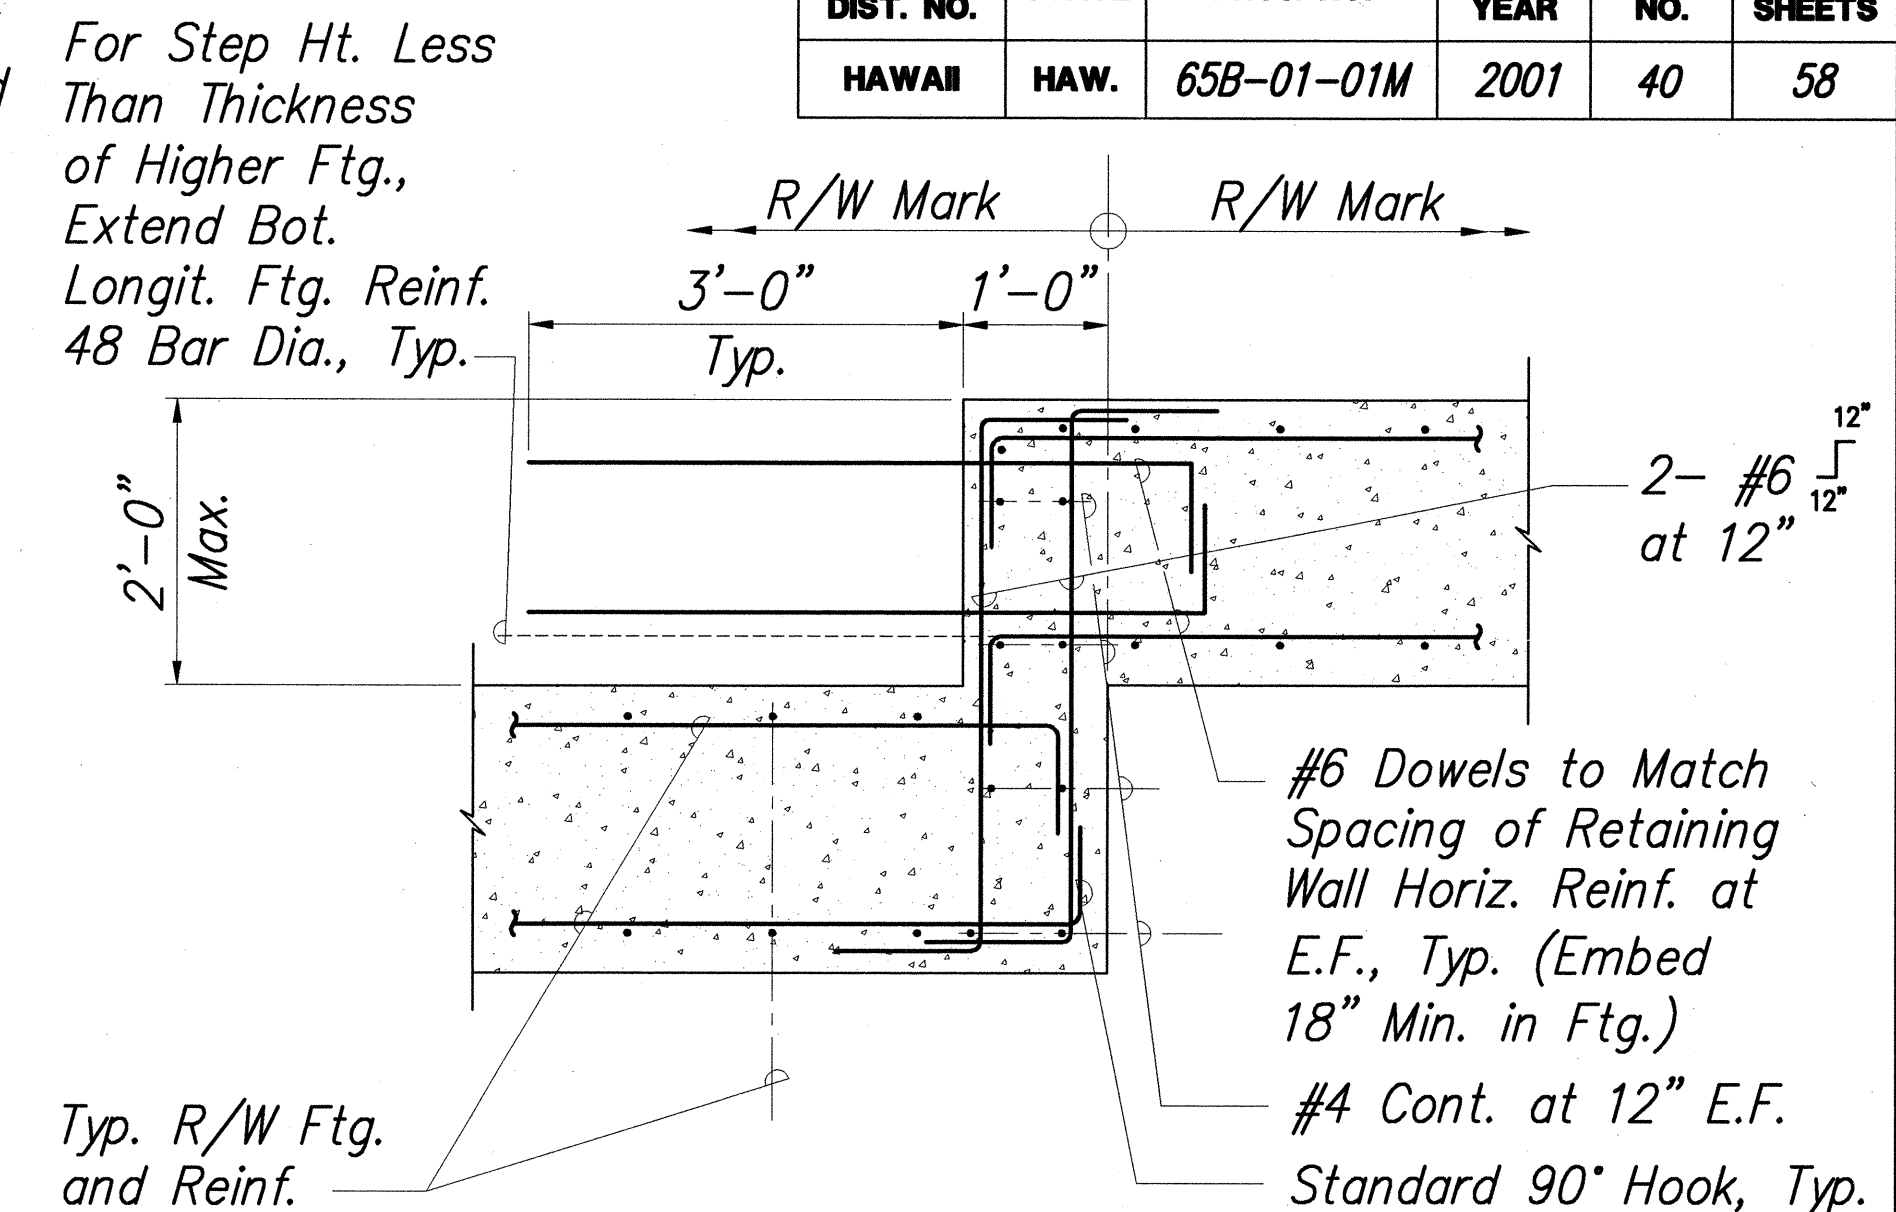
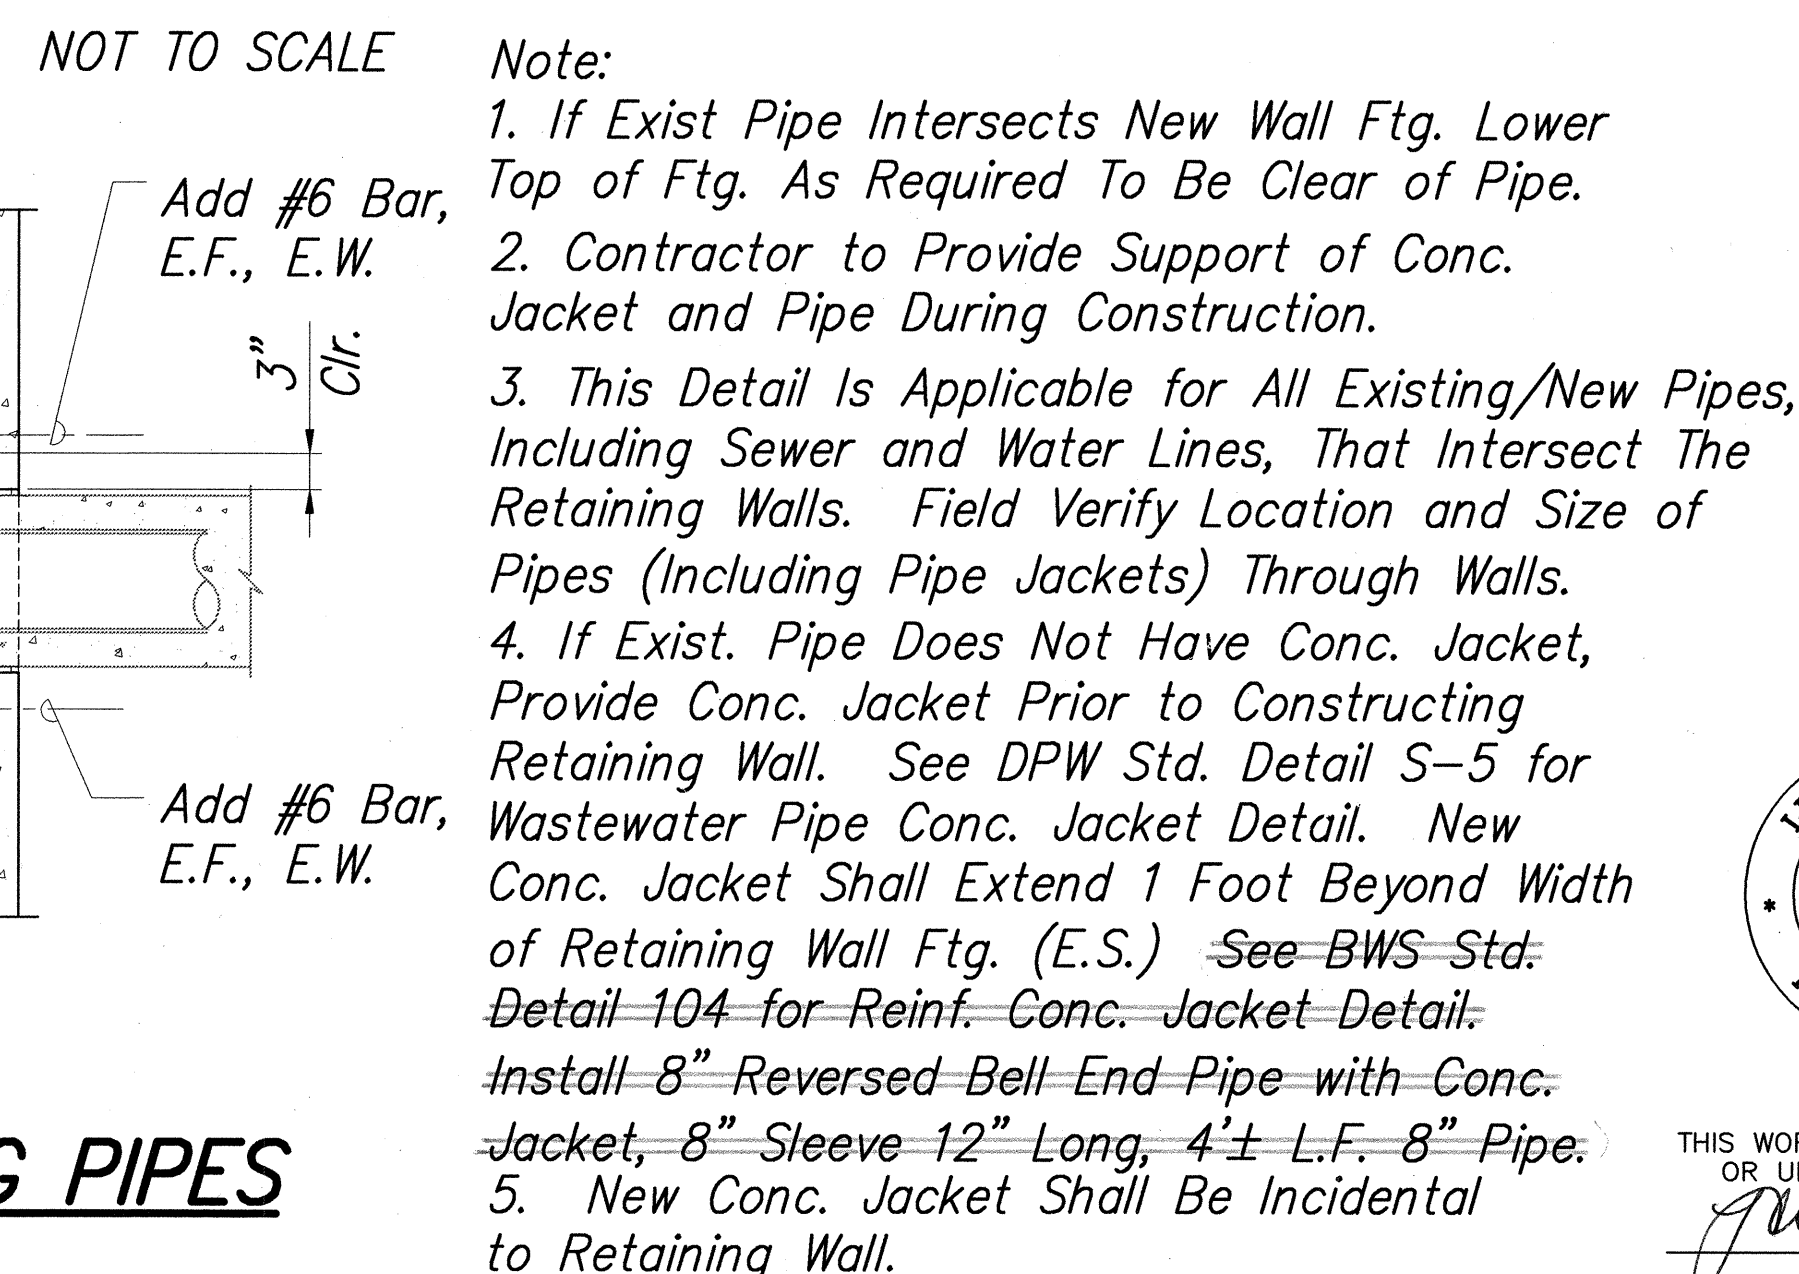
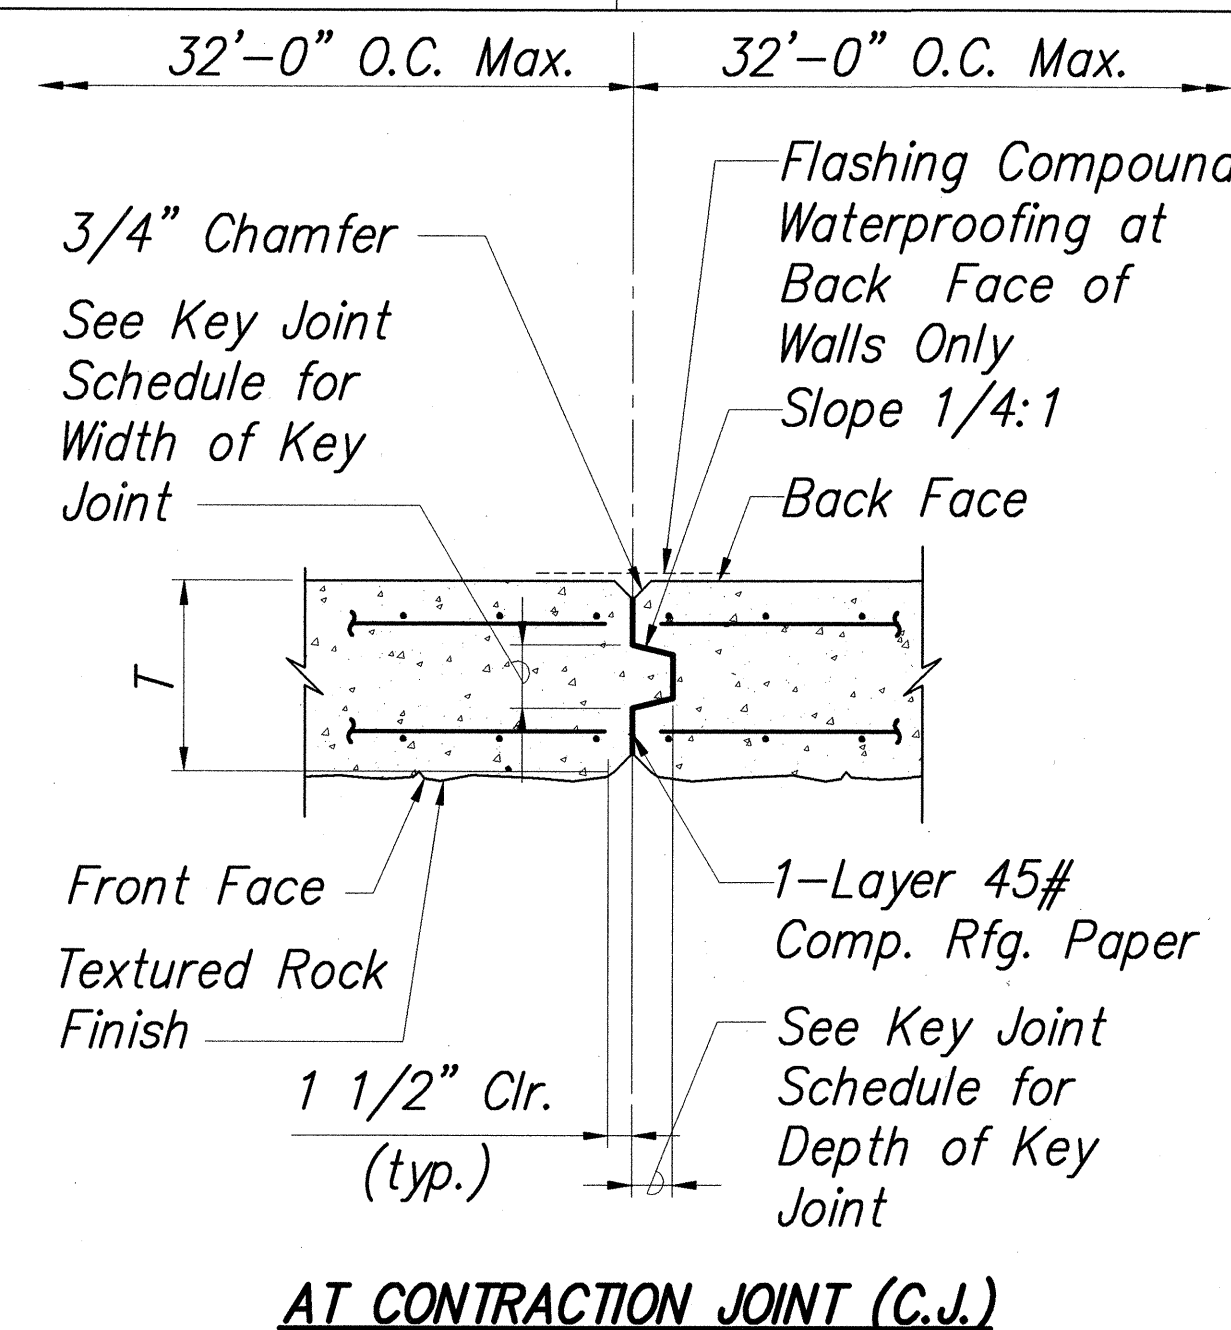
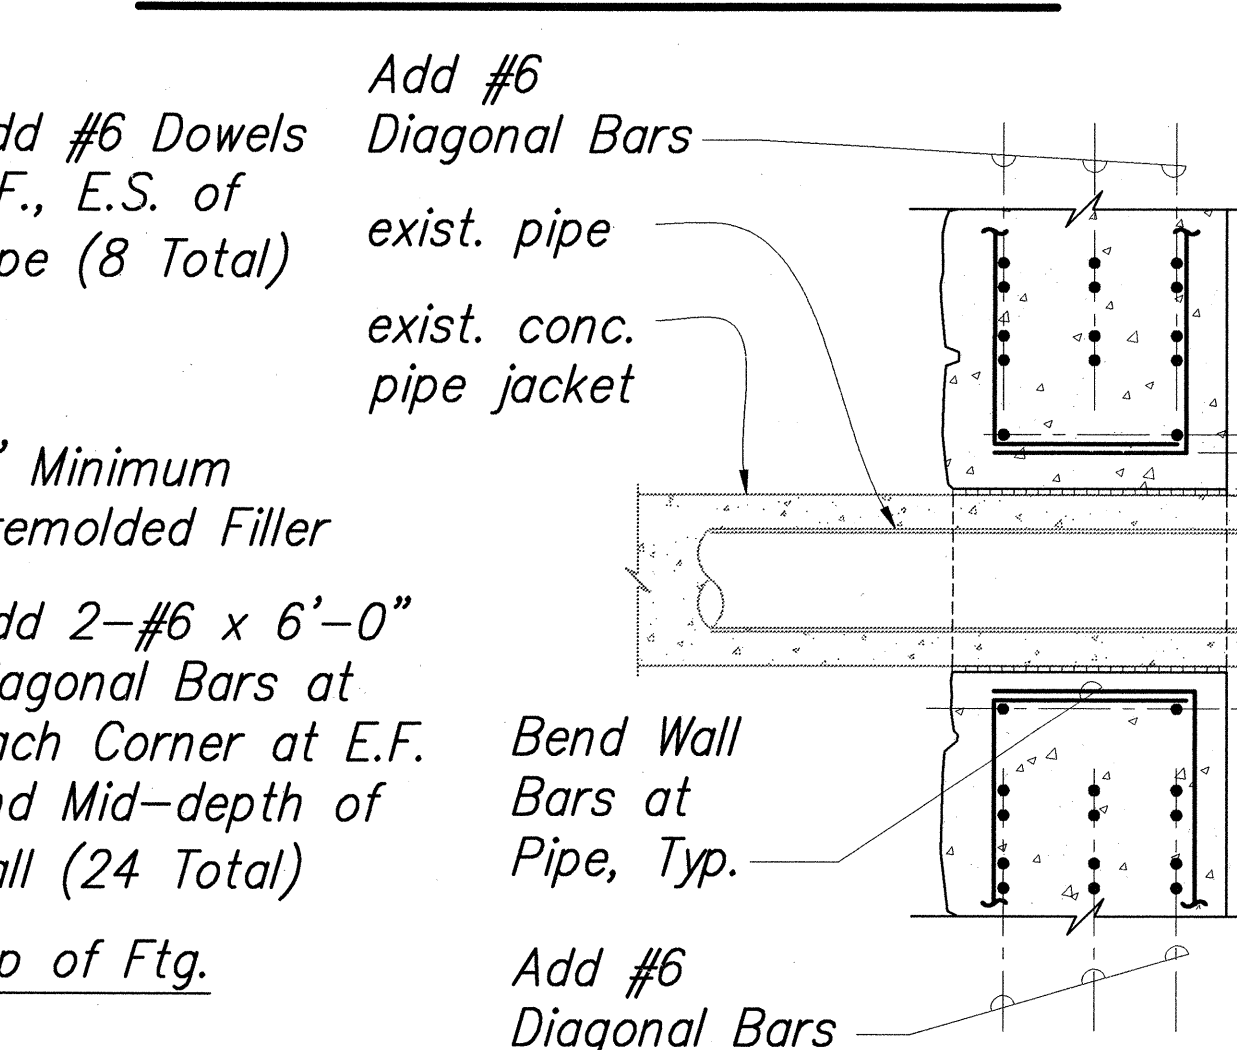
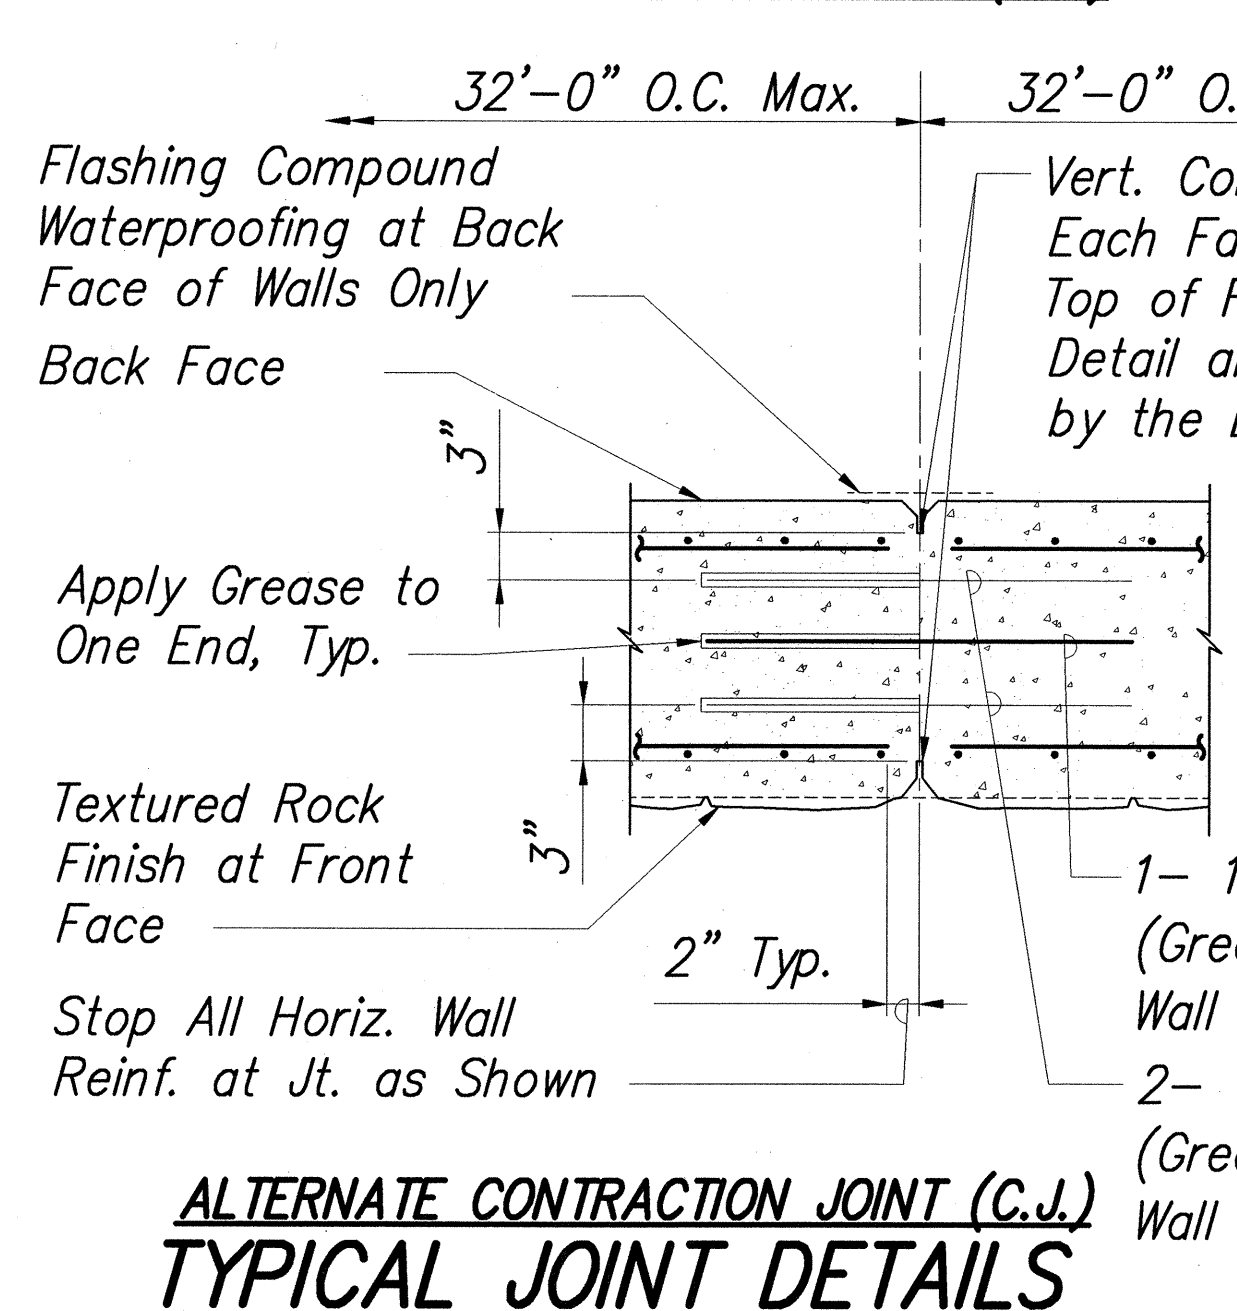
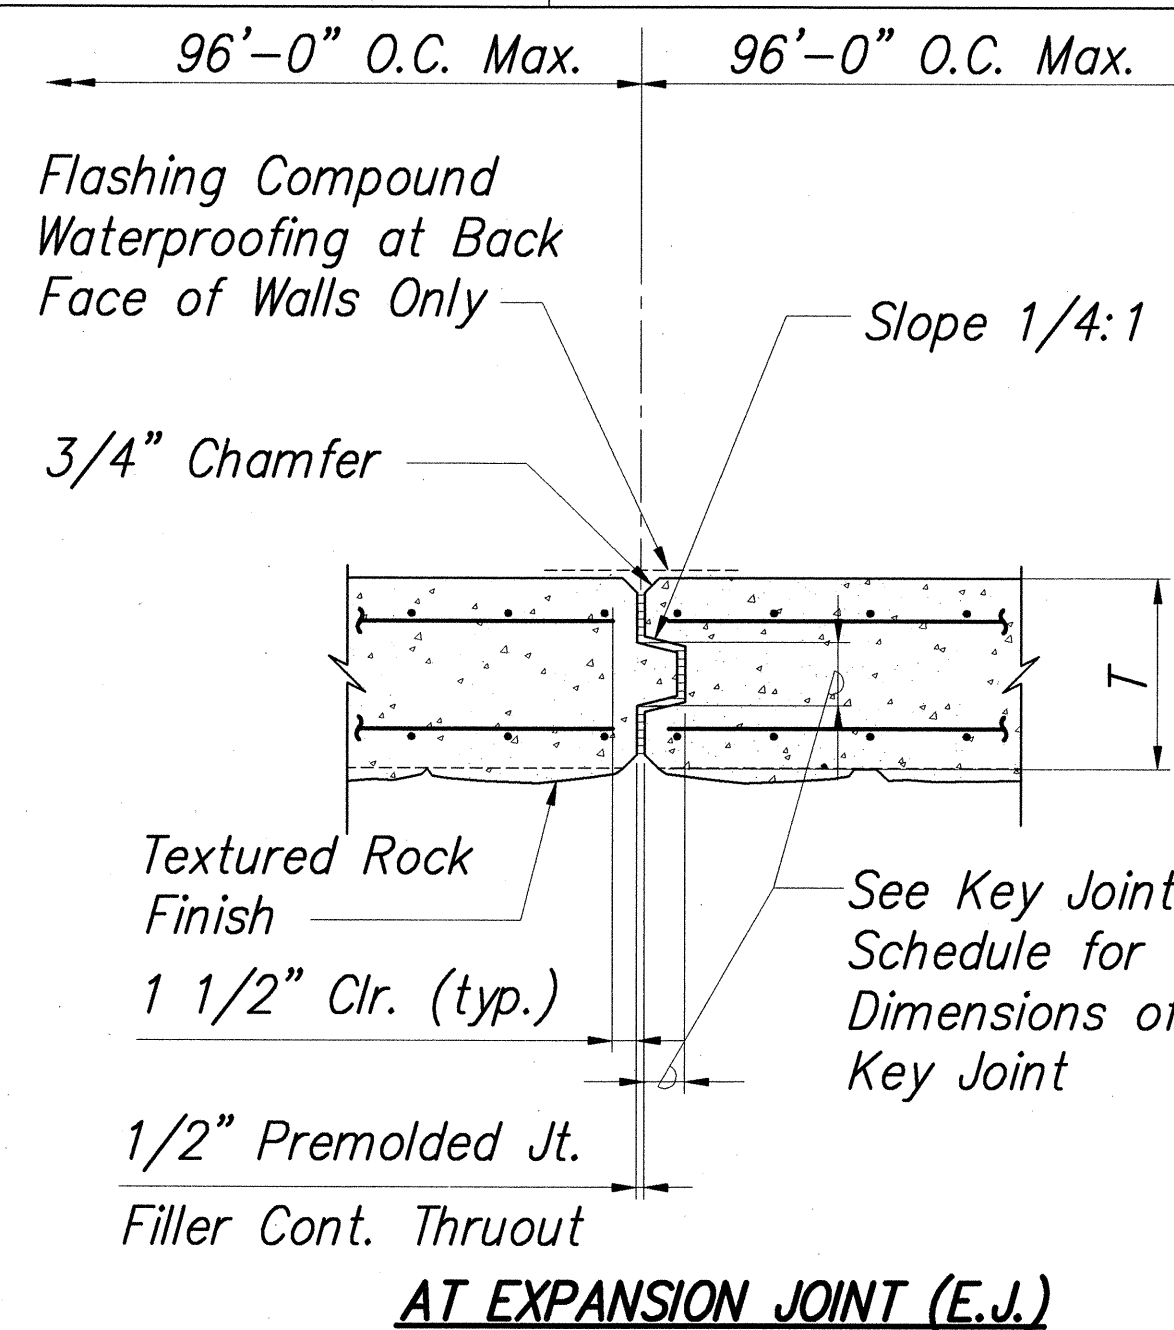
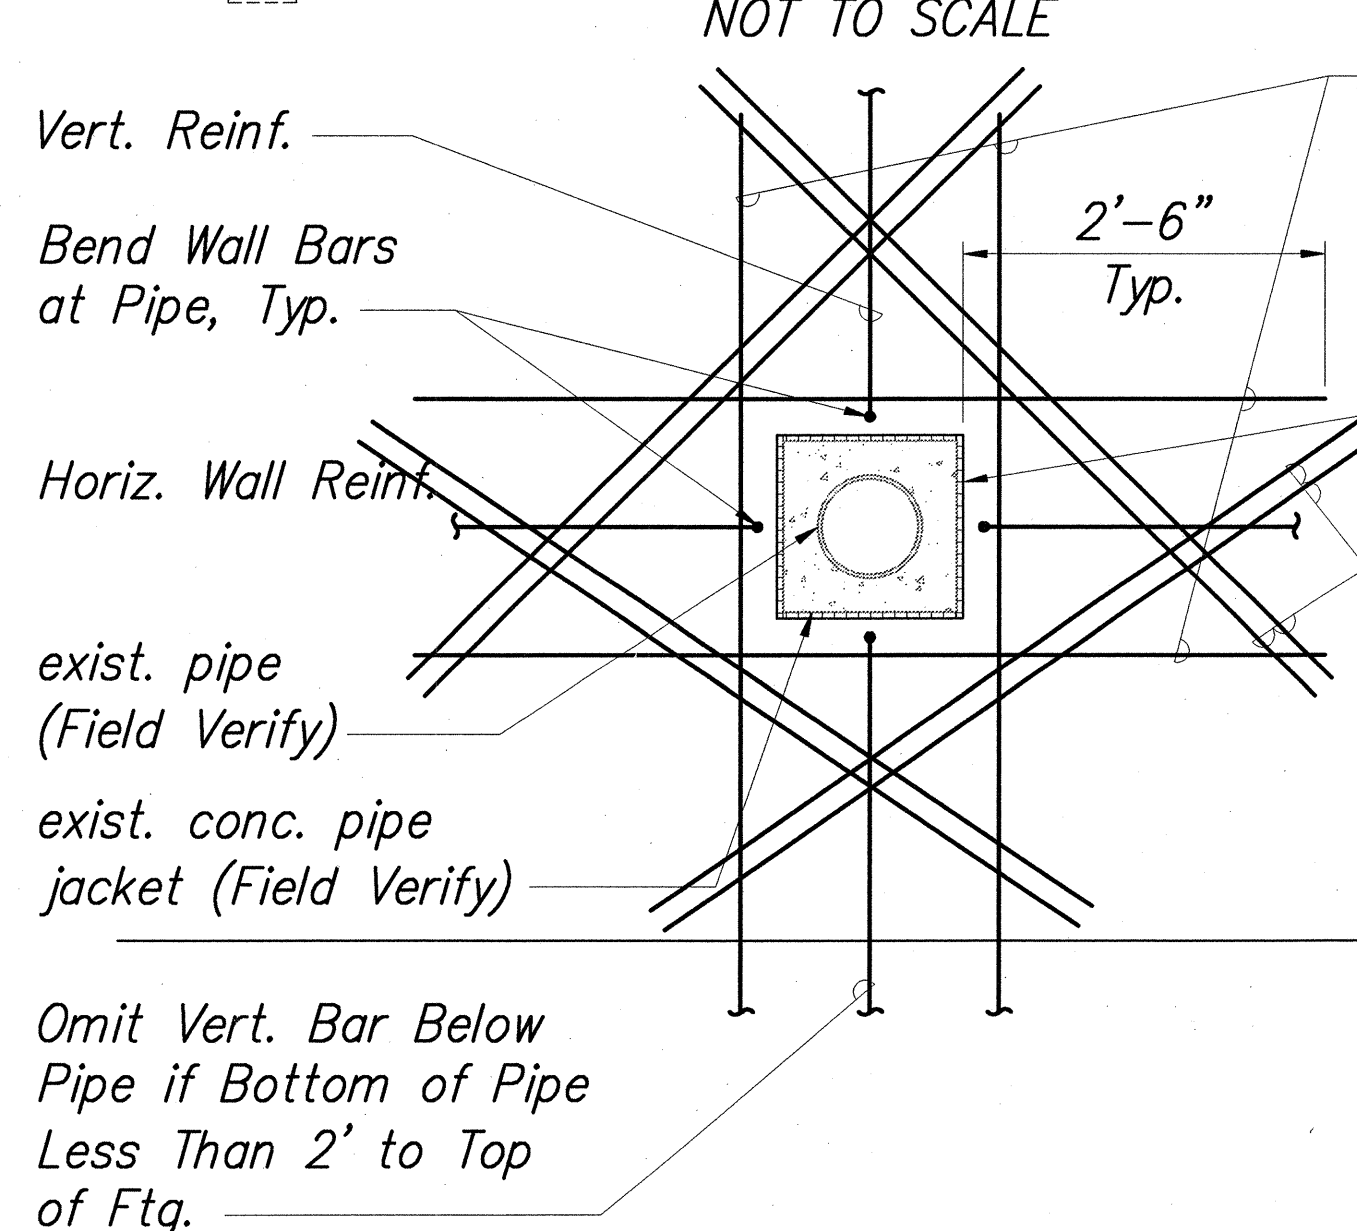
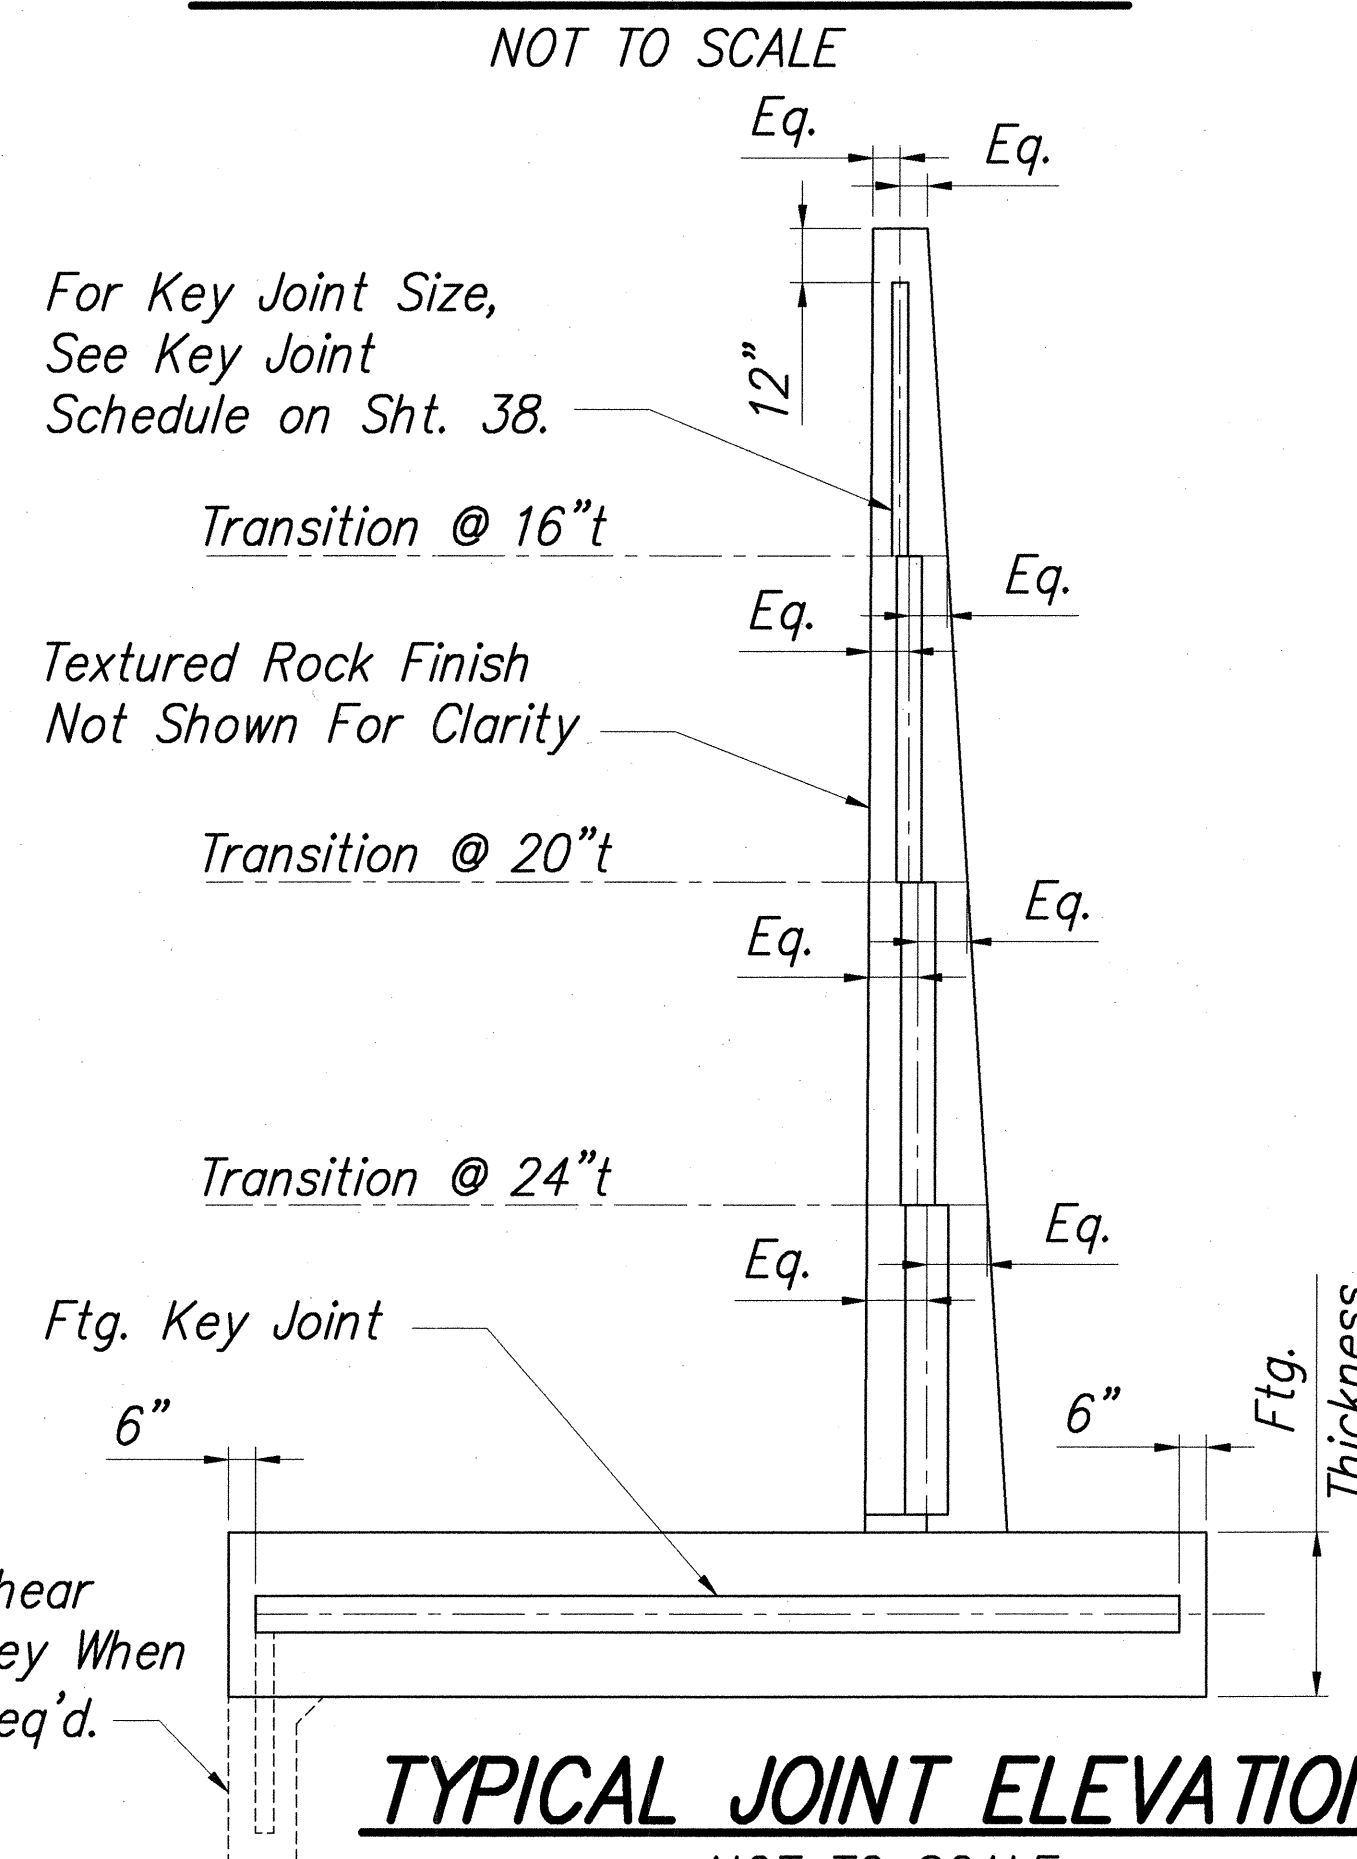


FED. ROAD DIST. NO.	STATE	PROJ. NO.	FISCAL YEAR	SHEET NO.	TOTAL SHEETS
HAWAII	HAW.	65B-01-01M	2001	40	58

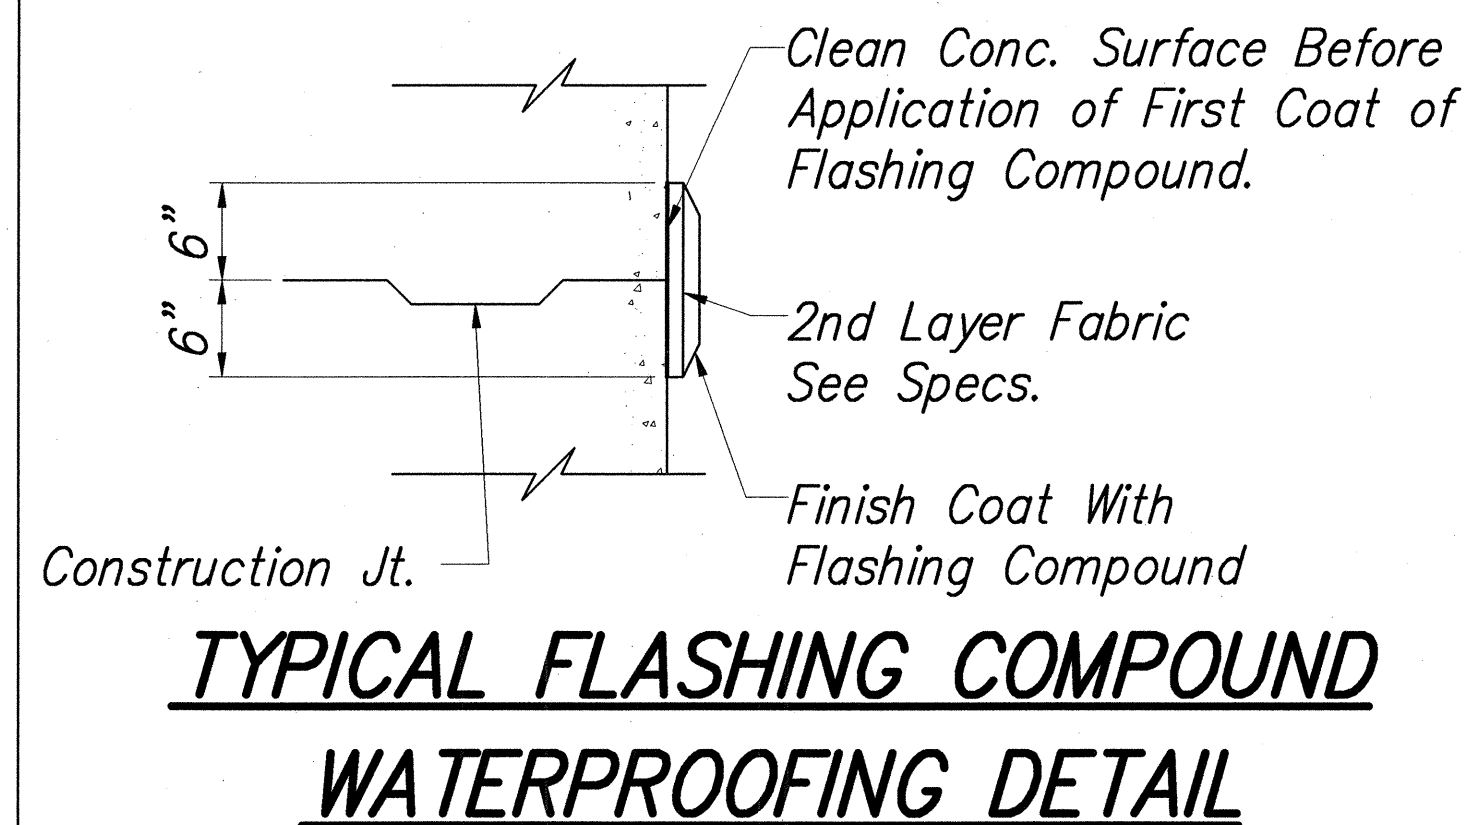

DATE	12/20/00
SURVEY PLOTTED BY	10:56
DRAWN BY	
DESIGNED BY	
CHECKED BY	
NOTE BOOK	
QUANTITIES BY	
ORIGINAL PLAN	

I:\1998\9800106\DWG\9800106_CHANGE_ORDER\S-38.DWG 12/20/00 10:56 DY

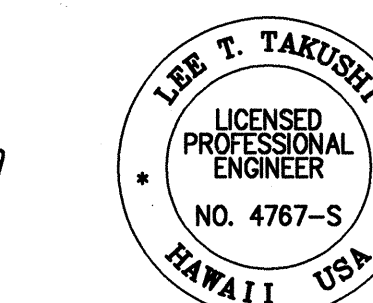

THIS WORK WAS PREPARED BY ME OR UNDER MY SUPERVISION.