
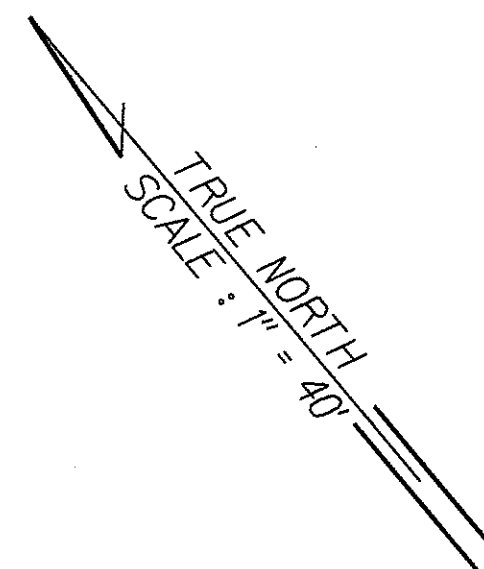


FED. ROAD DIST. NO.	STATE	FED. AID PROJ. NO.	FISCAL YEAR	SHEET NO.	TOTAL SHEETS
HAWAII	HAW.	STP-065-1(6)	2000	5	47

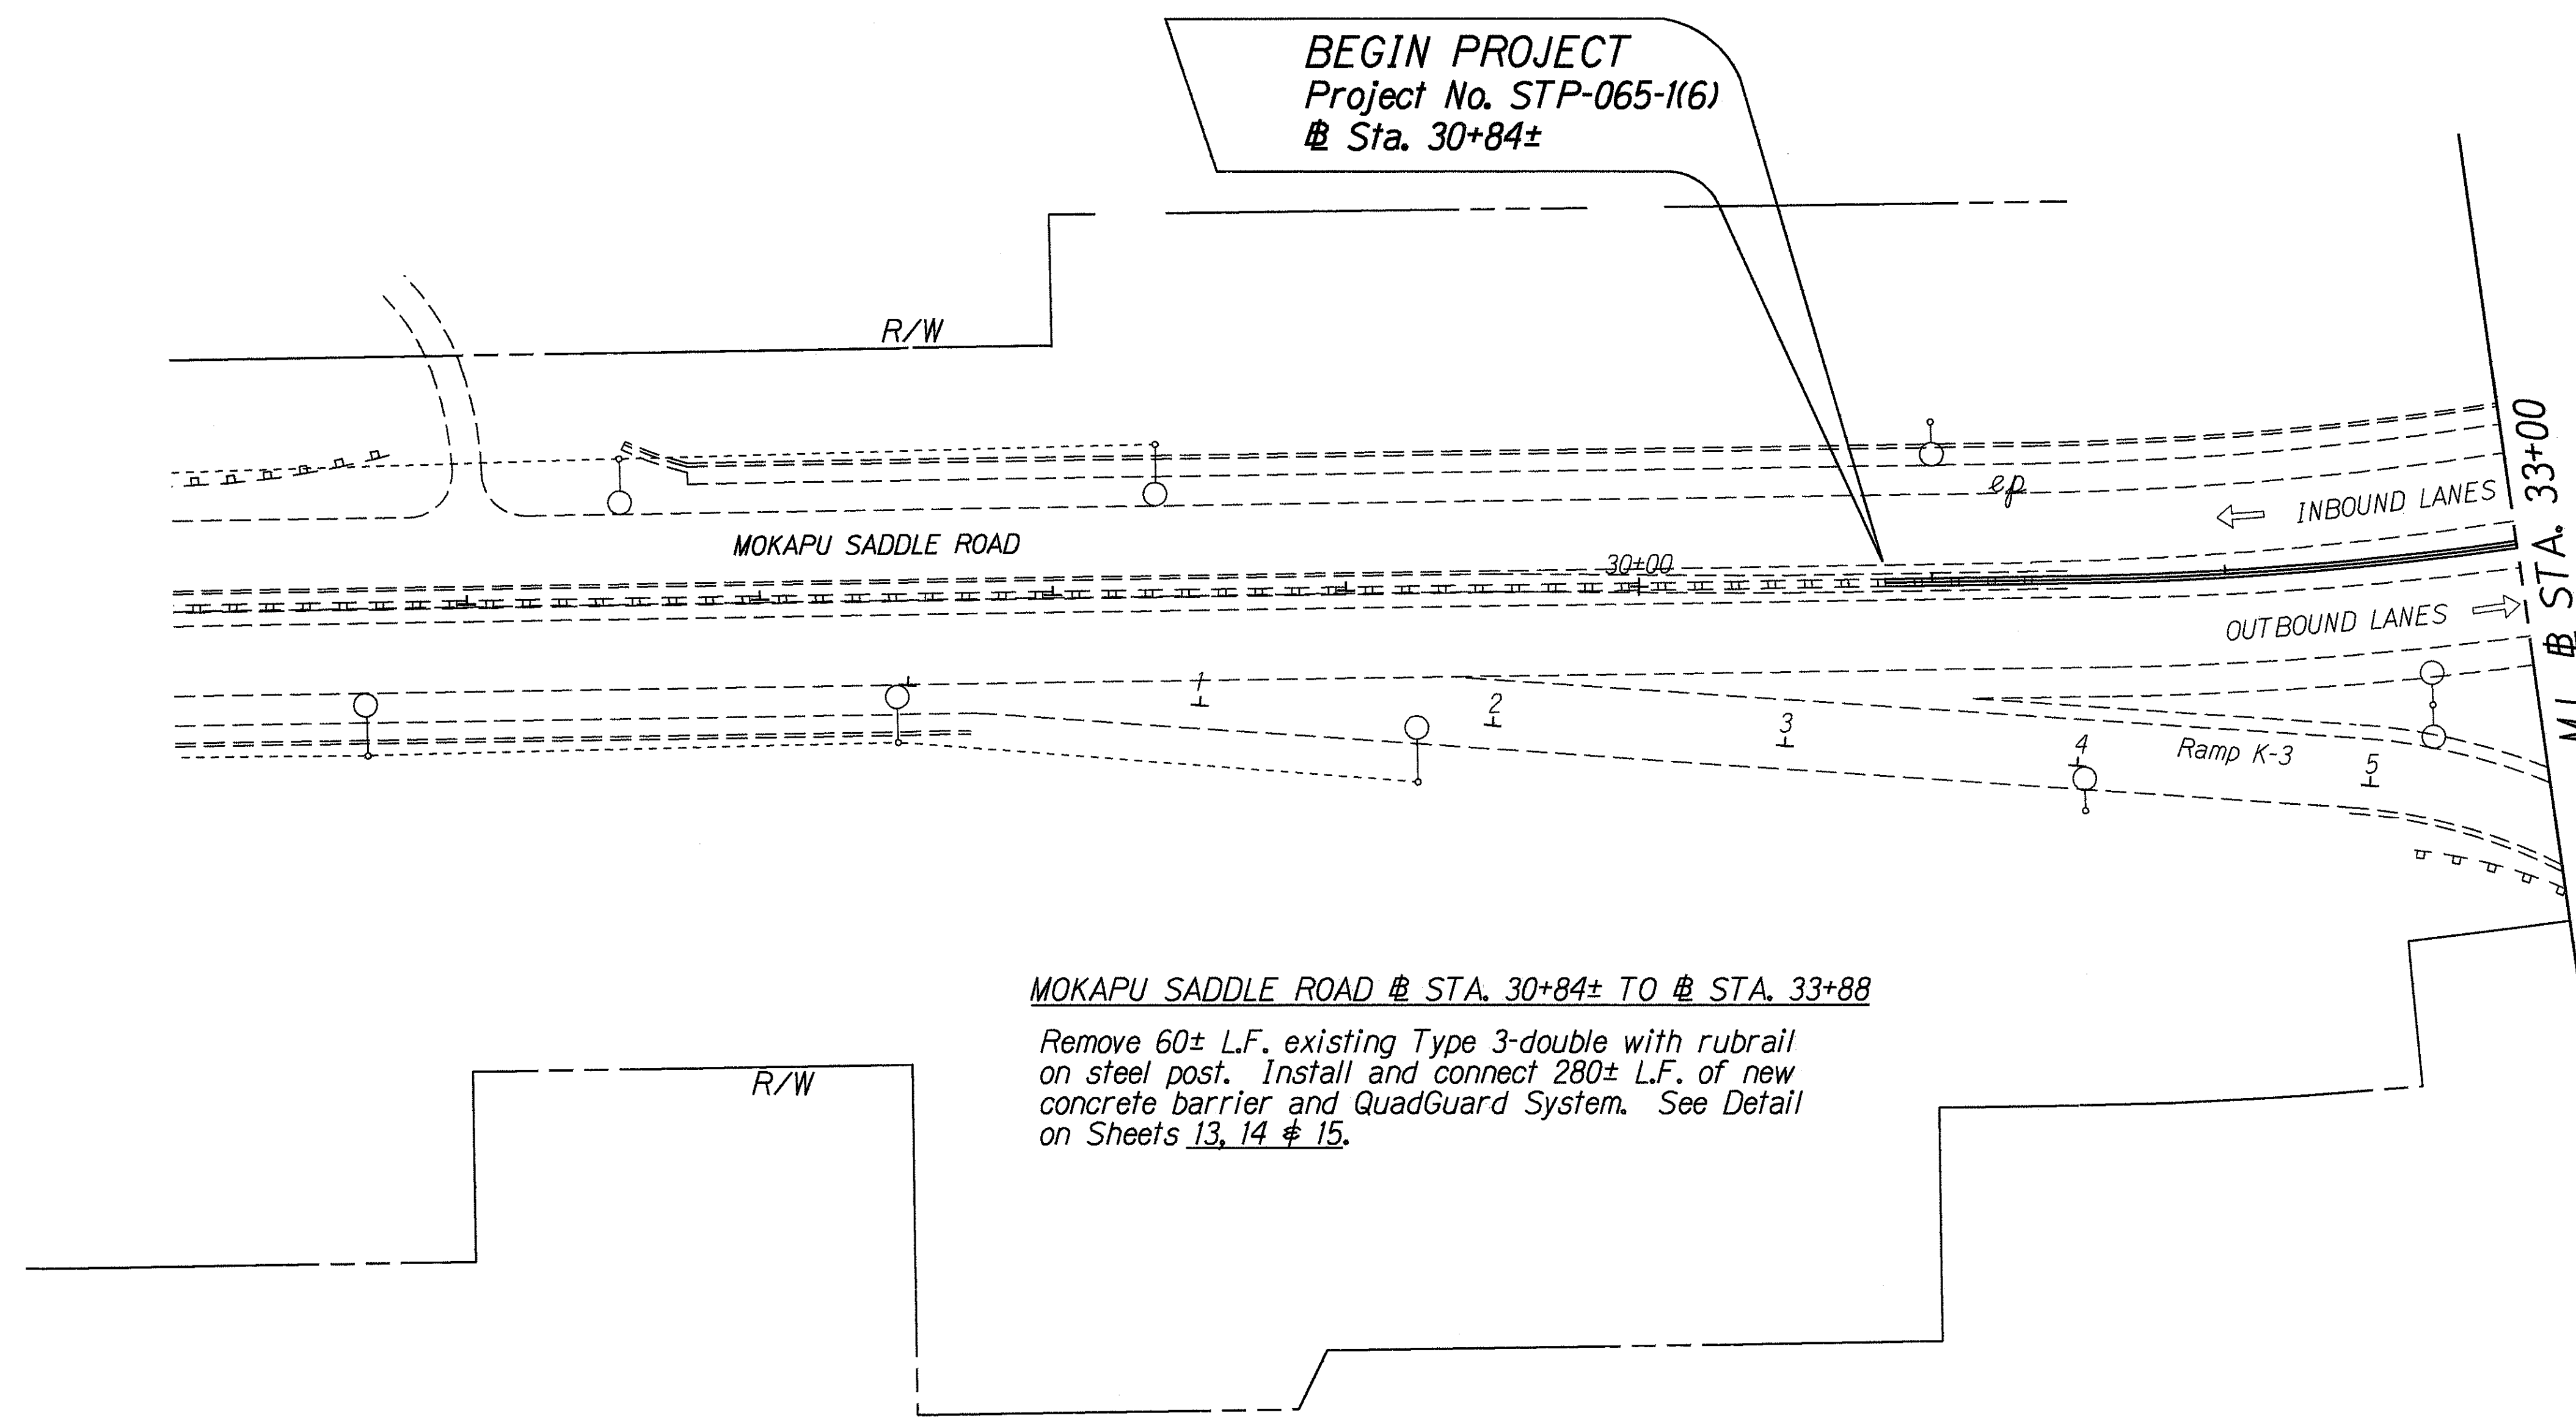

ORIGINAL PLAN	SURVEY PLOTTED BY	DATE
NOTES BOOK	DRAWN BY	3/27/99
102mg	Richard Alava	
2msftrp	CHECKED BY	

STATE OF HAWAII
DEPARTMENT OF TRANSPORTATION
HIGHWAYS DIVISION

ROADWAY PLAN


MOKAPU SADDLE ROAD
Traffic Signals at H-3 On-Ramp
Fed. Aid Project No. STP-065-1(6)

Scale: 1"=40' Date: April, 1999

SHEET No. 1 OF 2 SHEETS

FED. ROAD DIST. NO.	STATE	FED. AID PROJ. NO.	FISCAL YEAR	SHEET NO.	TOTAL SHEETS
HAWAII	HAW.	STP-065-1(6)	2000	C.O. 6	47

TRUE NORTH
SCALE: 1" = 40'

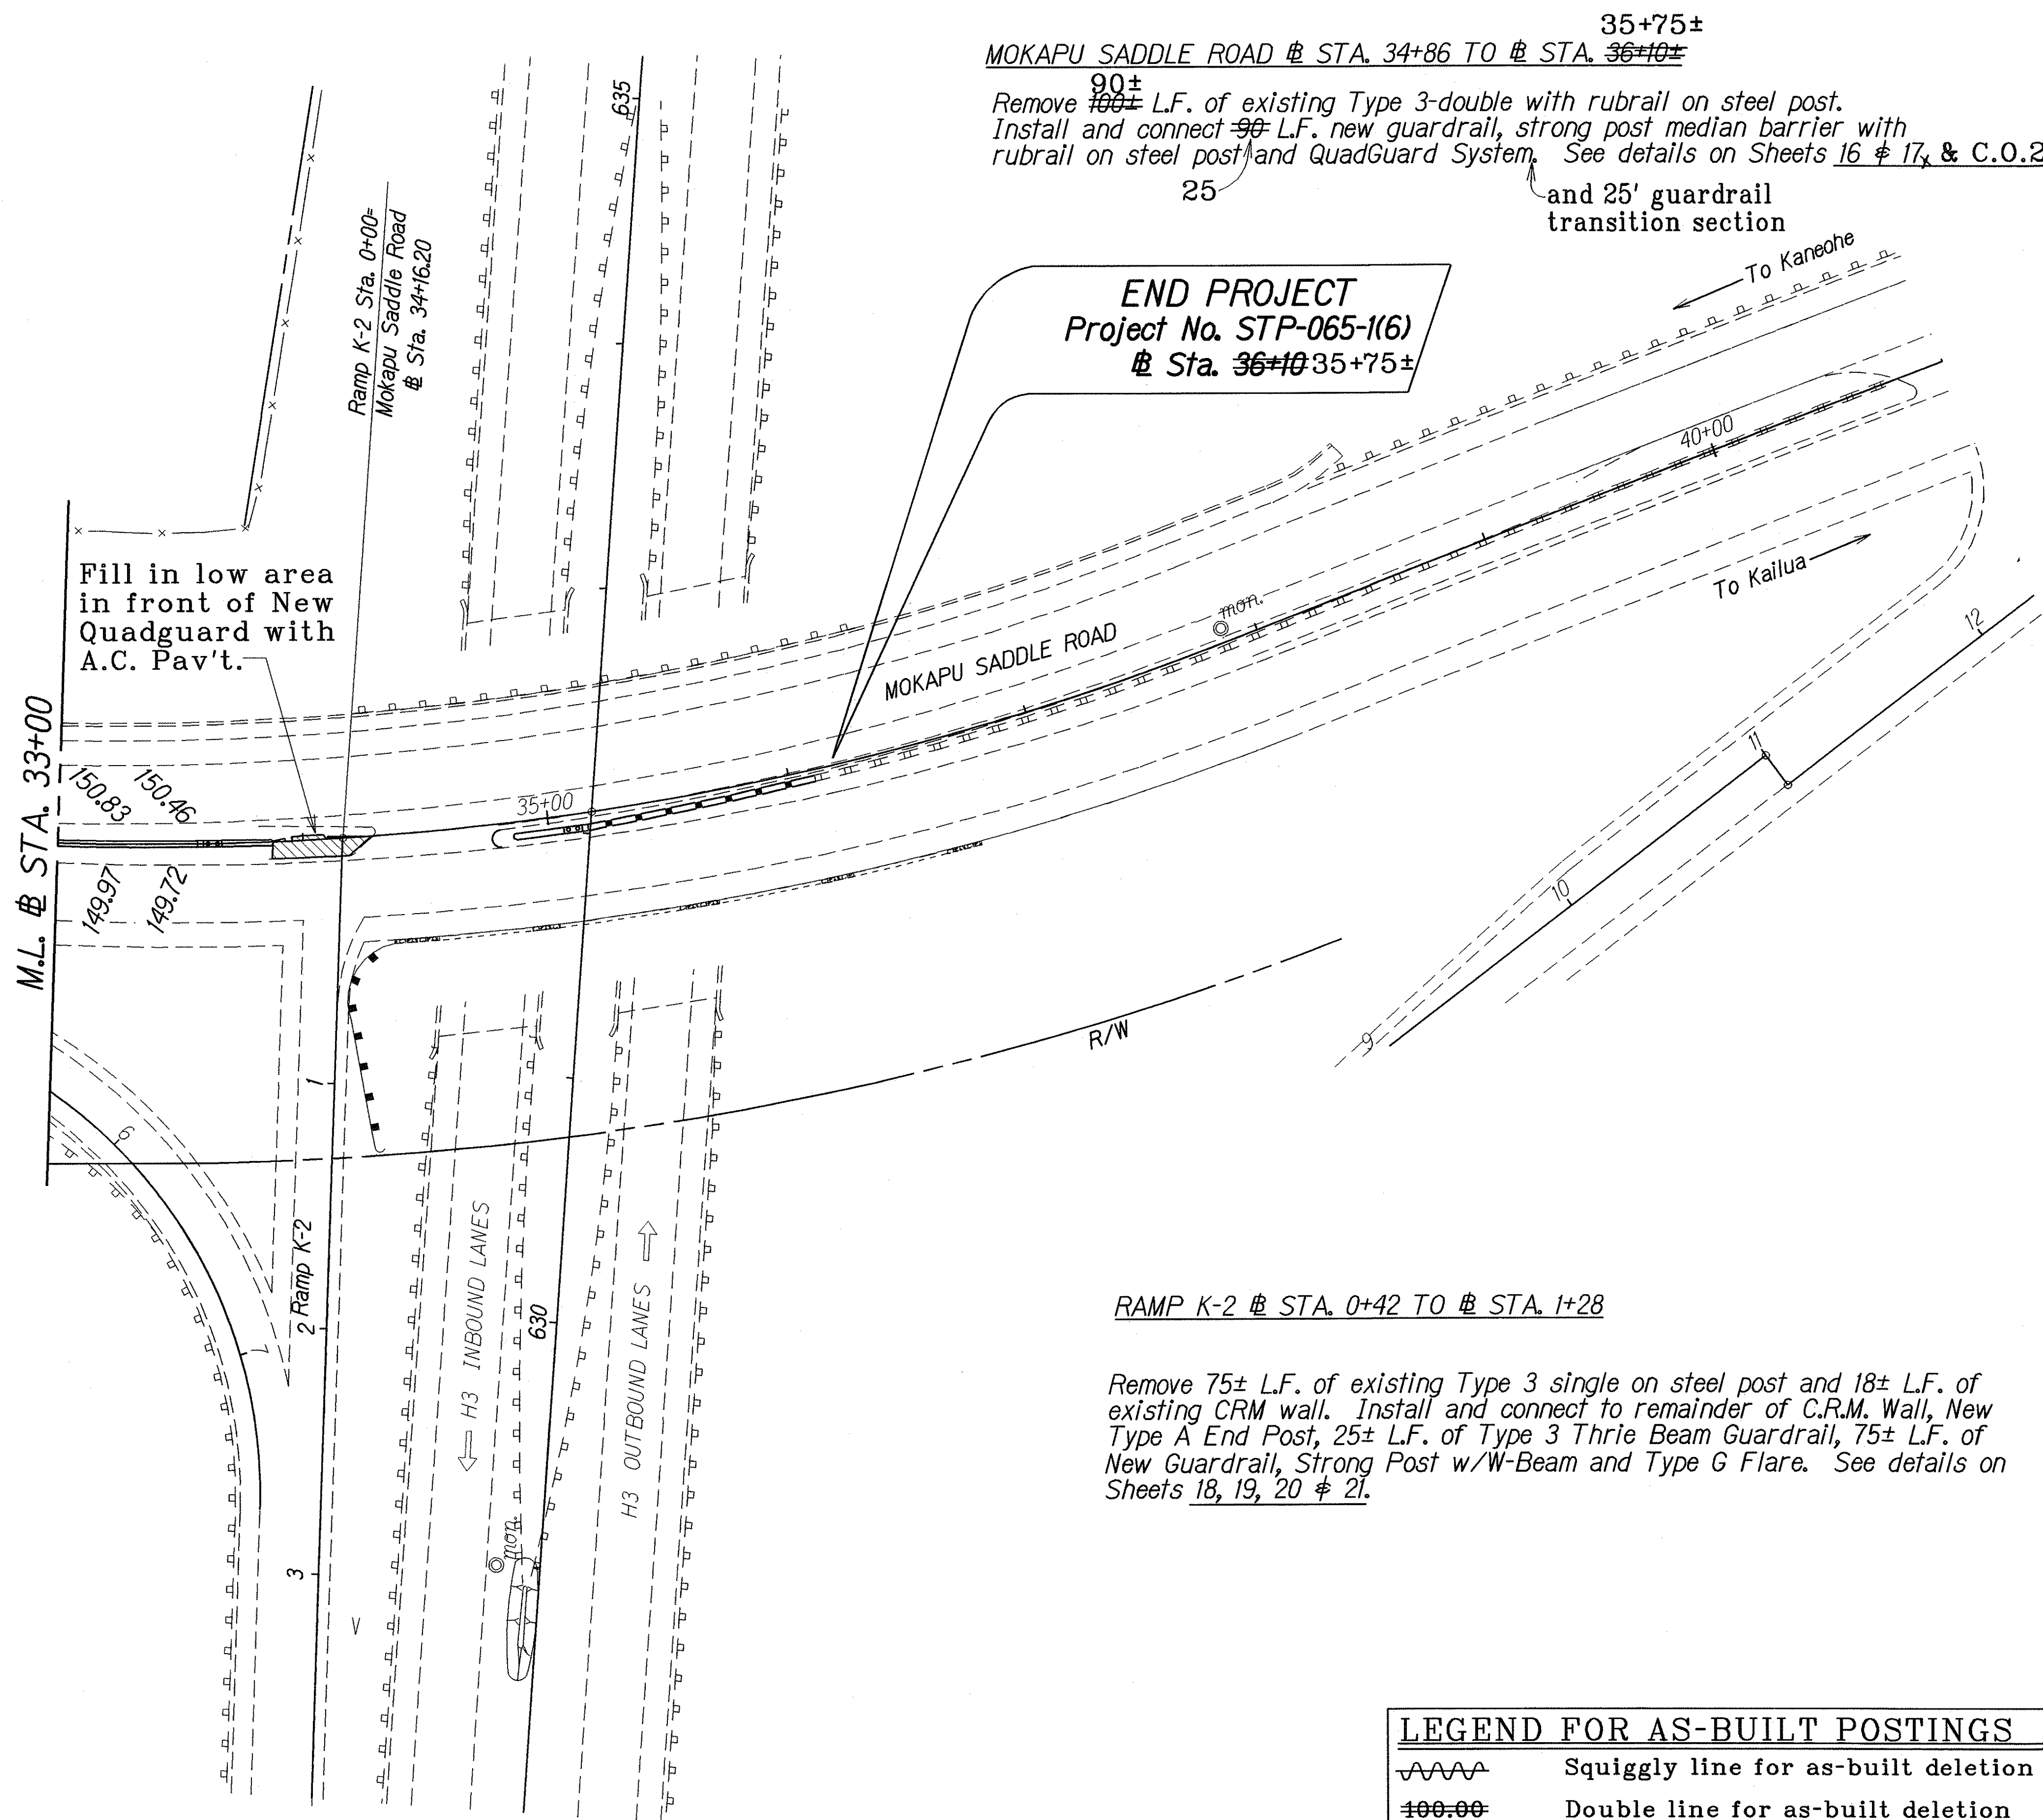

MOKAPU SADDLE ROAD @ STA. 34+86 TO @ STA. 35+75±
 Remove 90± L.F. of existing Type 3-double with rubrail on steel post.
 Install and connect 25± L.F. new guardrail, strong post median barrier with rubrail on steel post and QuadGuard System. See details on Sheets 16 & 17 & C.O.21S-1.
 and 25' guardrail transition section

END PROJECT
 Project No. STP-065-1(6)
 @ Sta. 35+75±

RAMP K-2 @ STA. 0+42 TO @ STA. 1+28

Remove 75± L.F. of existing Type 3 single on steel post and 18± L.F. of existing CRM wall. Install and connect to remainder of C.R.M. Wall, New Type A End Post, 25± L.F. of Type 3 Thrie Beam Guardrail, 75± L.F. of New Guardrail, Strong Post w/W-Beam and Type G Flare. See details on Sheets 18, 19, 20 & 21.

LEGEND FOR AS-BUILT POSTINGS	
	Squiggly line for as-built deletion
	Double line for as-built deletion
Roadway	Text for as-built posting

2/1/00

DATE

Provide roadway grades at concrete barrier locations starting at Sta. 30+75 and ending at Sta. 33+50

REVISION

STATE OF HAWAII
DEPARTMENT OF TRANSPORTATION
HIGHWAYS DIVISION

ROADWAY PLANS

MOKAPU SADDLE ROAD

Traffic Signals at H-3 On-Ramp

Fed. Aid Project No. STP-065-1(6)

Scale: 1"=40' Date: April, 1999

SHEET No. 2 OF 2 SHEETS

ORIGINAL PLAN	SURVEY PLOTTED BY	DATE
NOTE BOOK	DESIGNED BY	
10/1/99	QUANTITIES BY	
IN	CHECKED BY	

"AS-BUILT"

C.O. 6